


UNLESS OTHERWISE SPECIFIED USE THE FOLLOWING:

APPLIED PRACTICES	SURFACES	TOLERANCES ON MACHINED DIMENSIONS		
		FRACTIONS	DECIMALS	ANGLES
	✓	+	+	+

TITLE INSTALLATION  
 PENETRATION SEAL-MEDIUM VOLTAGE POWER  
 FIRST MADE FOR ELECTRICAL PENETRATION (COOPER STATION 1)


SEE 238X703NS FOR PART IDENTIFICATION

← REACTOR

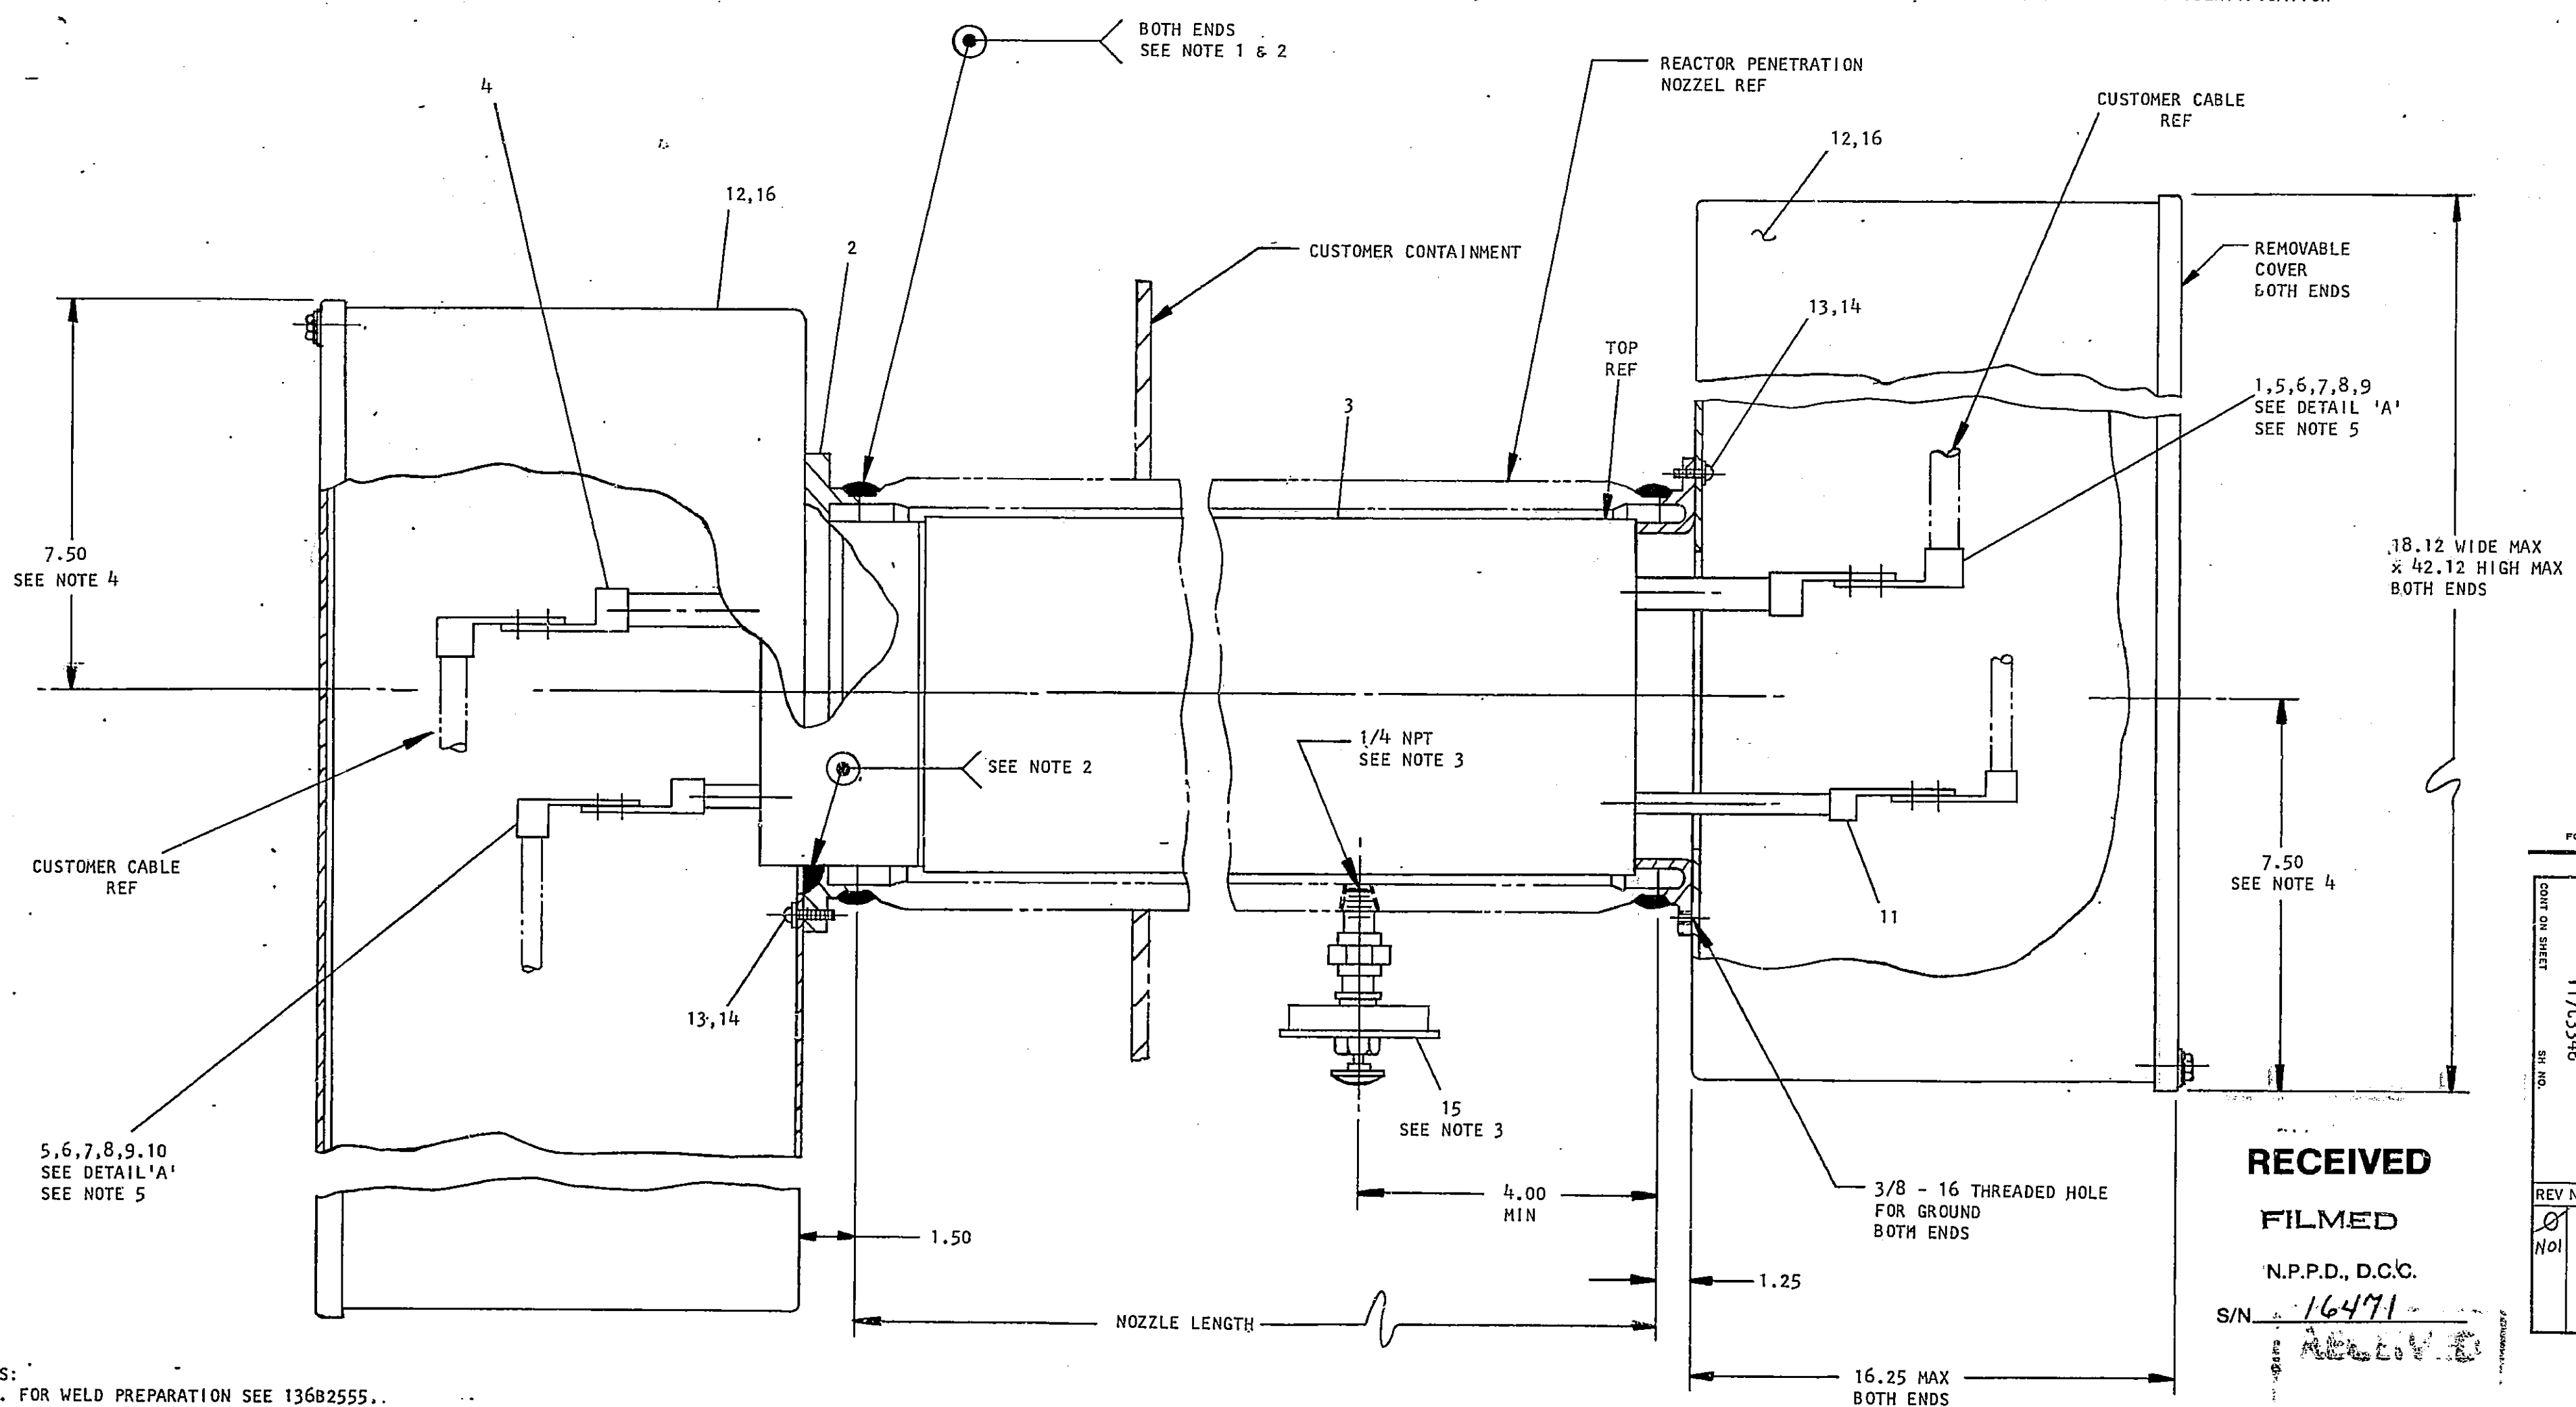

**RECEIVED**  
**FILMED**  
 N.P.P.D., D.C.C.  
 S/N 16471

- NOTES:
1. FOR WELD PREPARATION SEE 136B2555.
  2. WELD & INSPECT IN ACCORDANCE WITH ASME BOILER & PRESSURE VESSEL CODE SECTION III CLASS B.
  3. CUSTOMER TO LOCATE ITEM 15.
  4. BOXES SHOWN IN OPPOSITE VERTICAL POSITONS. THEY MAY BE LOCATED IN ANY OF FOUR POSITIONS IF DESIRED.
  5. CUSTOMER TO ARRANGE LOCATION OF SPLICES. BOLTS TO BE TORQUED TO 300-325 INCH LBS. (SEE DETAIL 'A' FOR ARRANGEMENT OF NUTS, BOLTS & WASHERS)
  6. SEE INSTALLATION MANUAL FOR METHOD OF CALCULATING ELECTRICAL CAPACITY.
  7. APPROX WEIGHT 450 LBS (LESS JCT BOXES)

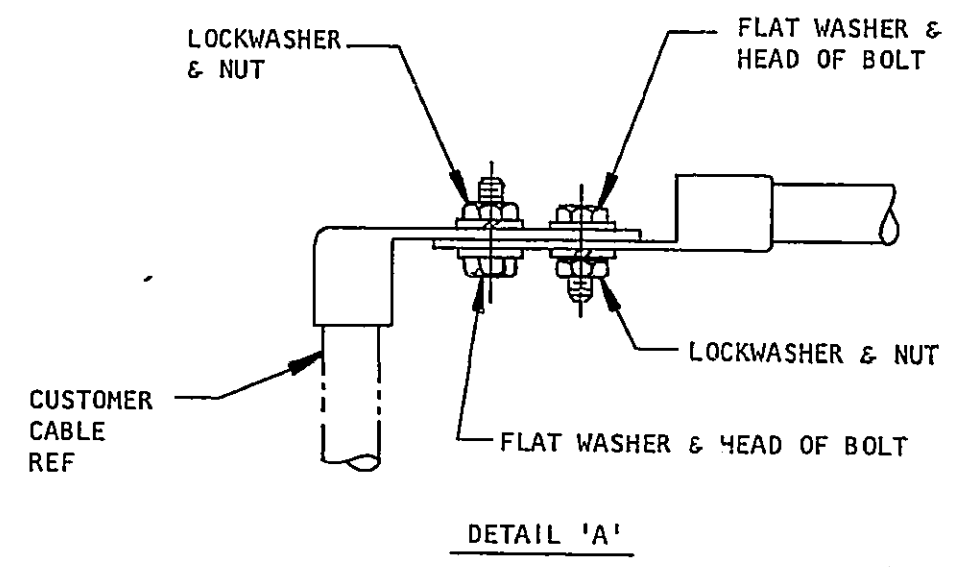

238X703NS GROUP NO.	NOZZLE NO.	NOZZLE LENGTH
1	XICIA	8'-0"
2	101C	8'-3"
2	101D	8'-3"
3	101F	8'-6"

NO INCORP TRANSFER REQUEST		NO INCORP CHANGE TO ORIGINAL	
ALL FUTURE REVISIONS BY N.P.P.D.		PRINTS TO	
NO	NO	A21	3
		24	73

MADE BY *G. Margherone* Apr 3, 70  
 APPROVALS *ORP*  
 ISSUED *G. Margherone* Apr 9, 70  
 NID SAN JOSE, CALIF. LOCATION  
 117C3346 SH NO.


UNLESS OTHERWISE SPECIFIED USE THE FOLLOWING:

APPLIED PRACTICES	SURFACES	TOLERANCES ON MACHINED DIMENSIONS		
		FRACTIONS	DECIMALS	ANGLES
	✓	+	+	+
		-	-	-

TITLE  
**INSTALLATION**  
 PENETRATION SEAL-INDICATION AND CONTROL  
 FIRST MADE FOR ELECTRICAL PENETRATION (COOPER STATION 1)

SEE 238X704NS FOR PART IDENTIFICATION


← REACTOR

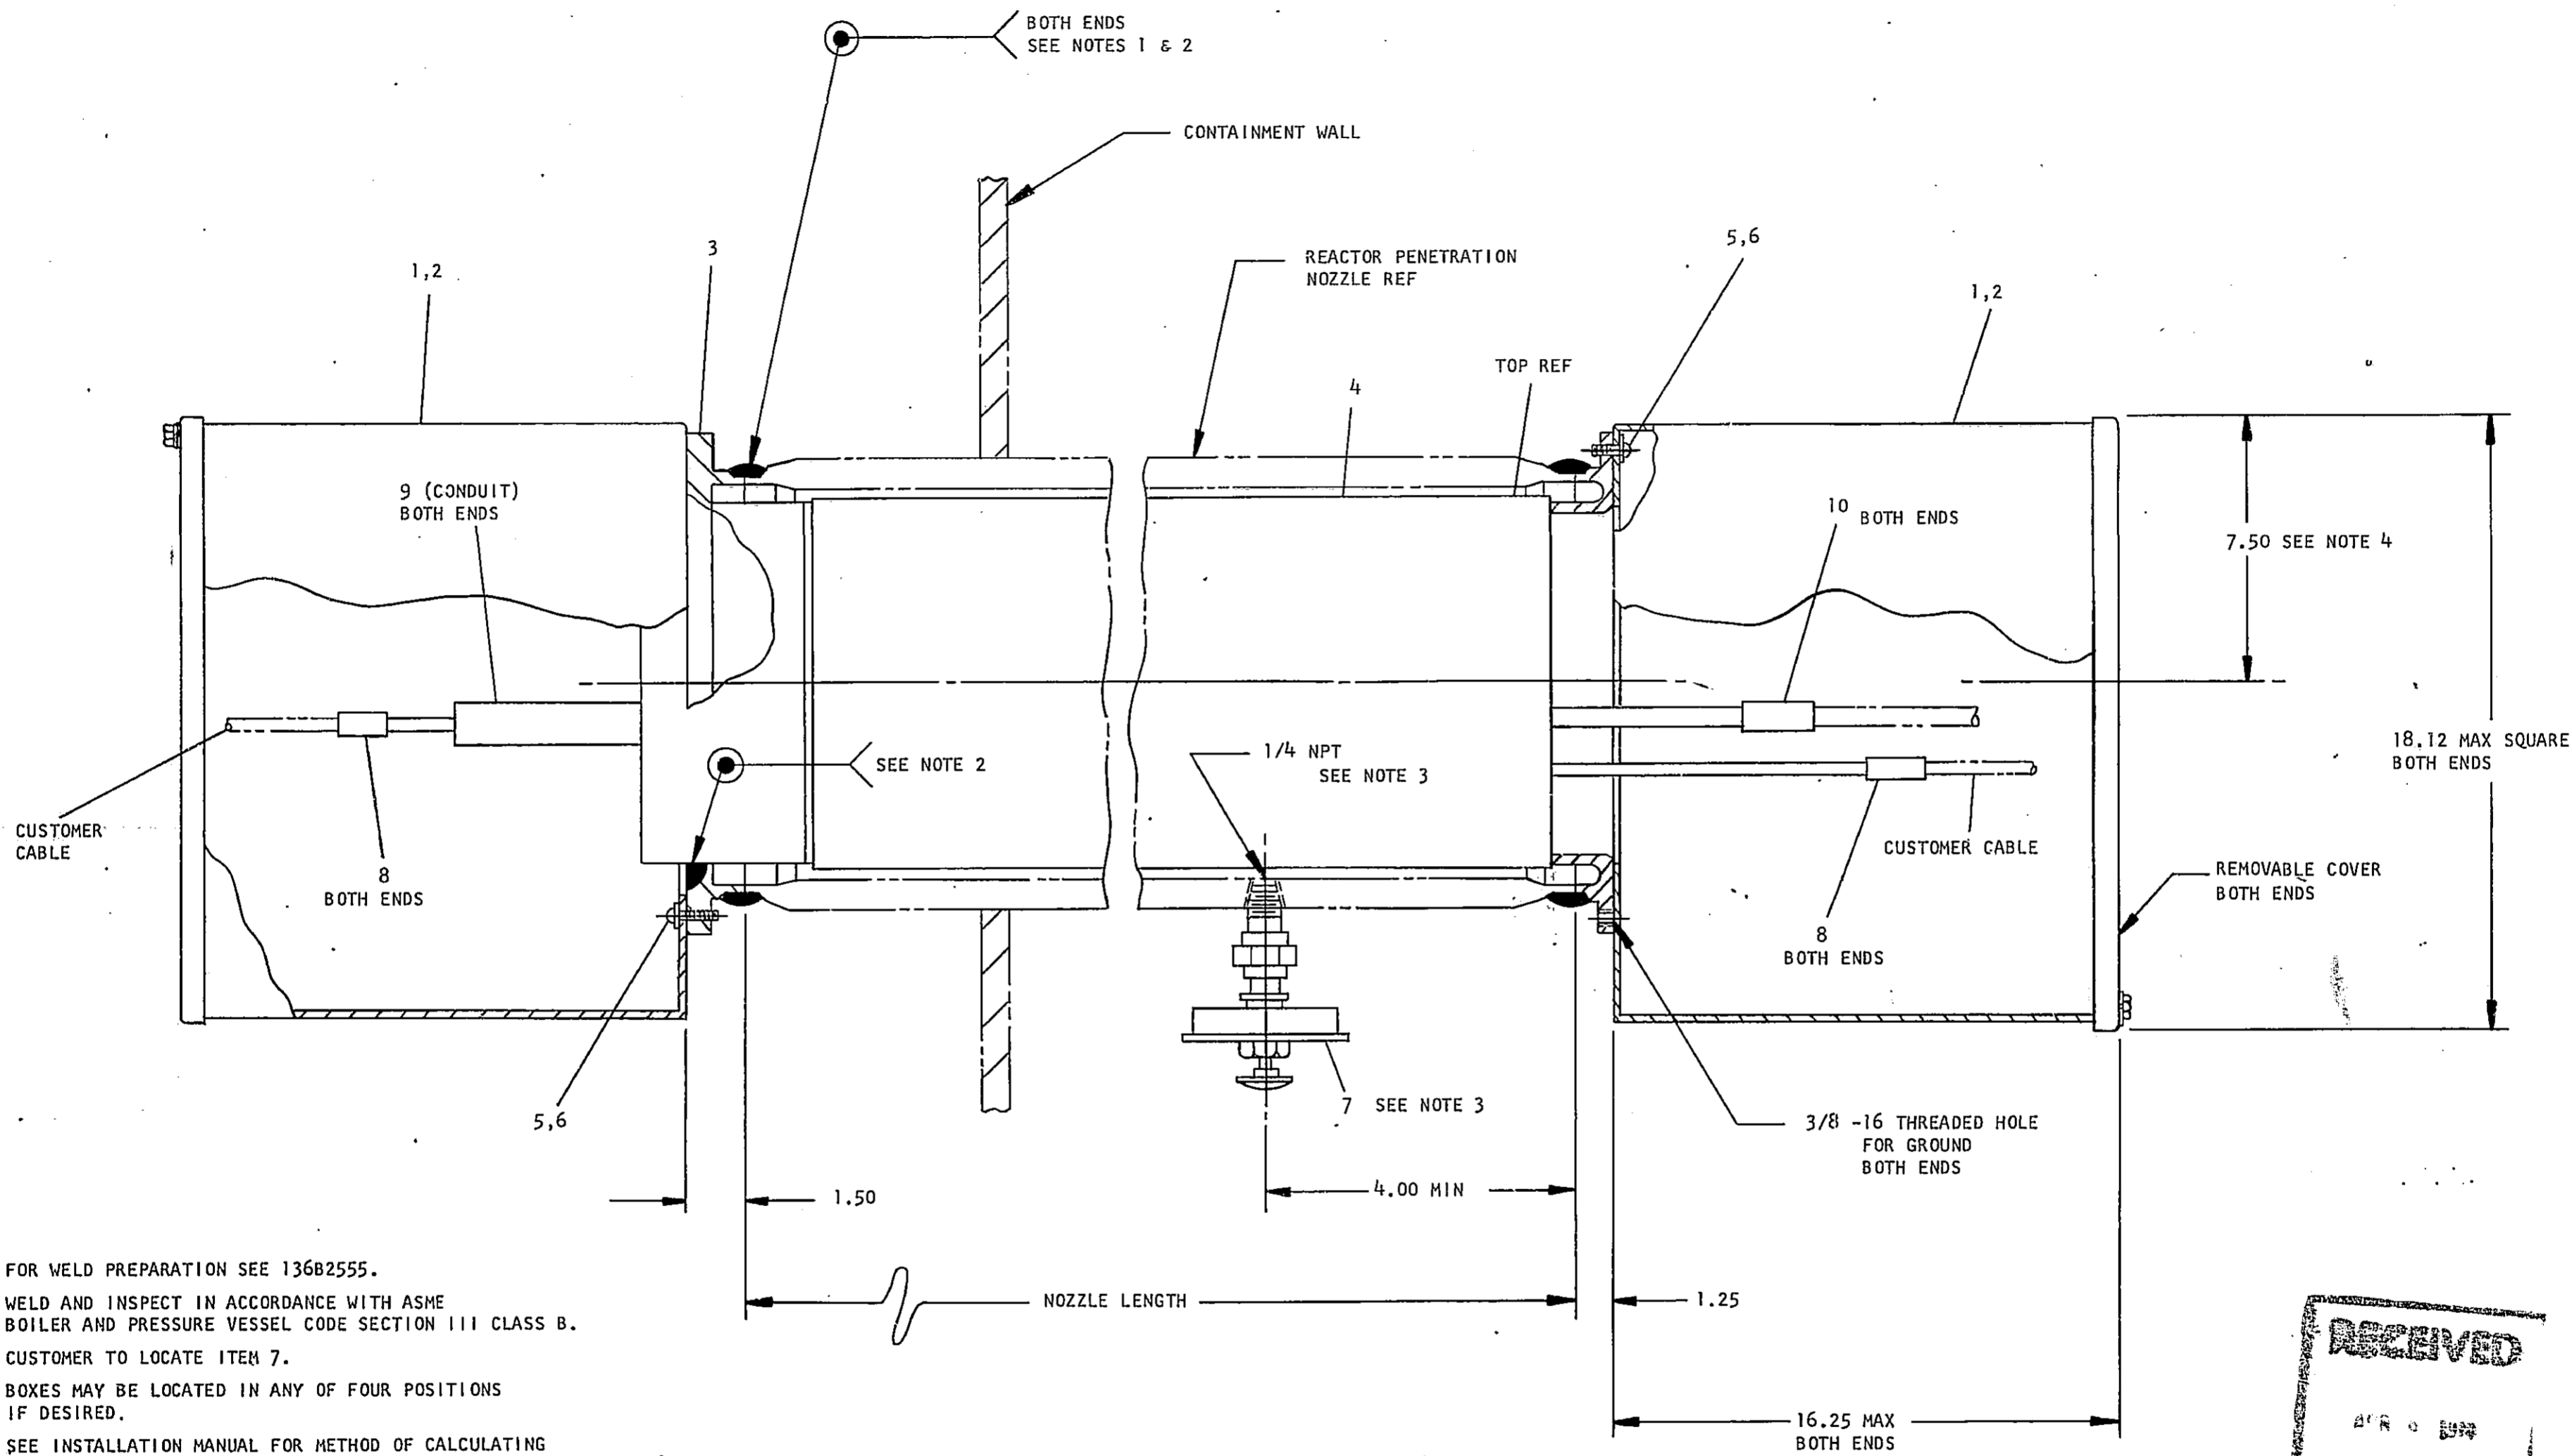

- NOTES:
- FOR WELD PREPARATION SEE 136B2555.
  - WELD AND INSPECT IN ACCORDANCE WITH ASME BOILER AND PRESSURE VESSEL CODE SECTION III CLASS B.
  - CUSTOMER TO LOCATE ITEM 7.
  - BOXES MAY BE LOCATED IN ANY OF FOUR POSITIONS IF DESIRED.
  - SEE INSTALLATION MANUAL FOR METHOD OF CALCULATING ELECTRICAL CAPACITY.
  - APPROX. WEIGHT 500 LBS (LESS JCT BOXES)


238X704NS GROUP NO.	NOZZLE NO.	NOZZLE LENGTH
1	X100A	7' - 10"
1	X100H	7' - 10"
2	X100G	8' - 3"
2	X102	8' - 3"

**RECEIVED**  
**FILMED**  
 N.P.P.D., D.C.C.  
 S/N 16467

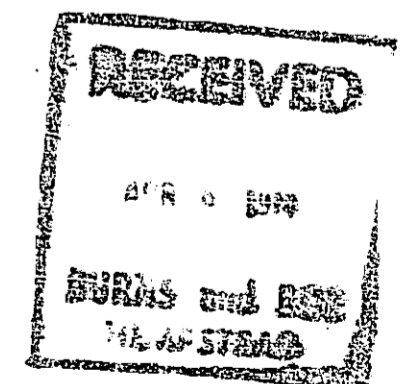

REVISIONS	PRINTS TO
1 MAY 22, 1970 E. Mangione TITLE WAS LOW VOLTAGE POWER ORK	A21 C 3 24 73

MADE BY E. Mangione ISSUED E. Mangione	APPROVALS APR 10, 1970 R. P. P. D. C. C.	NID SAN JOSE, CALIF	DIV OR DEPT LOCATION	117C3349 CONT ON SHEET	SH NO.
---	--	------------------------	-------------------------	---------------------------	--------

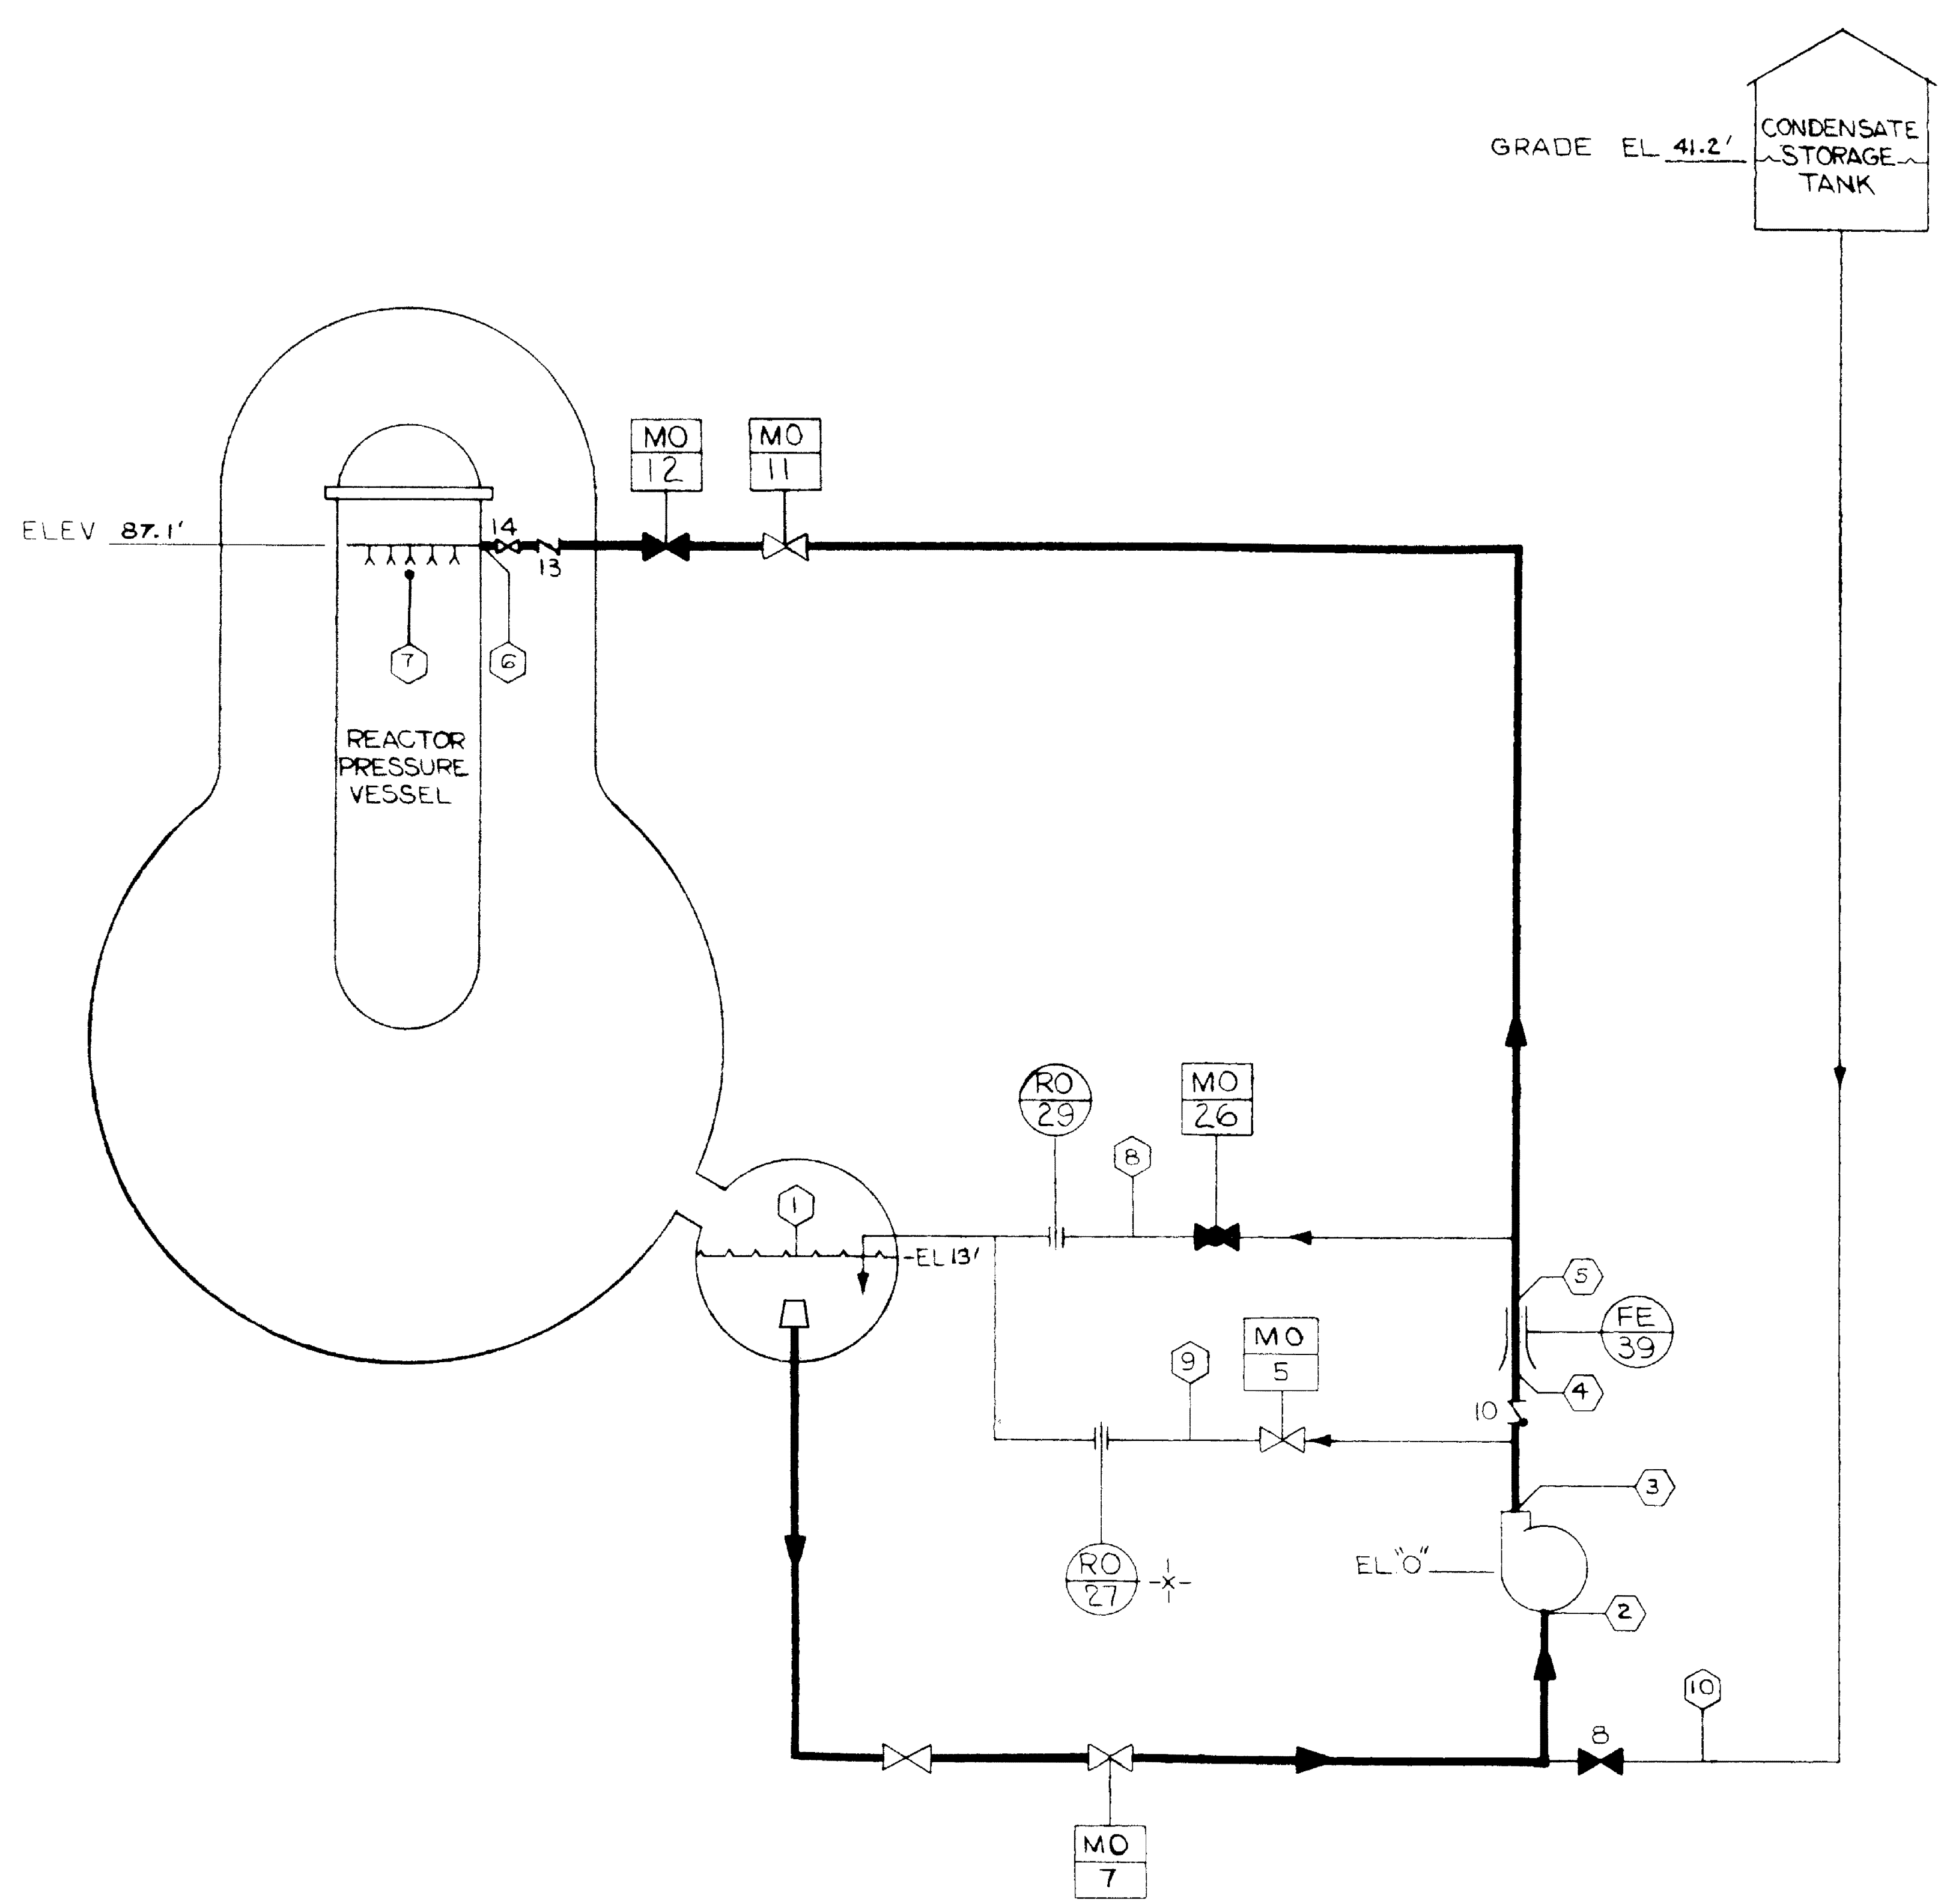

CONDITION I NORMAL SYSTEM TEST

LOCATION	1	2	3	4	5	6	7	8	9	10
FLOW - GPM	N/A	4720	←	→	4720	0	0	4720	0	0
PRESS - PSIA	14.7									
TEMP - °F	95	95	95	95	95			95		
NOTE		13	13	13	13			13		
ΔP - FT.		→ 625 ←				→ 834 ←				

← ΔP = 606.7 FT (SEE NOTE 8) →

CONDITION II TEST USING CONDENSATE STORAGE TANK

LOCATION	1	2	3	4	5	6	7	8	9	10
FLOW - GPM	N/A	6000	←	→	6000	0	0	6000	0	0
PRESS - PSIA	14.7						14.7			
TEMP - °F		90					90			90
NOTE		6.14					6.14			6.14
ΔP - FT.		→ 480 ←			→ 335 ←		→ 320 ←			

← ΔP = 84.7 FT (SEE NOTE 8) →

CONDITION III PUMP OPERATING ON BYPASS (ISOLATION VALVES CLOSED)

LOCATION	1	2	3	4	5	6	7	8	9	10
FLOW - GPM	N/A	475	475	0	0	0	0	0	475	0
PRESS - PSIA	14.7									
TEMP - °F	140	140	140						140	
NOTE										
ΔP - FT.		→ 790 ←								

CONDITION IV CORE SPRAY INJECTING AT REACTOR PRESS

LOCATION	1	2	3	4	5	6	7	8	9	10
FLOW - GPM	N/A	4720	←	→	4720	4625	0	0	0	0
PRESS - PSIA	29.6						140.1			
TEMP - °F	208.7						208.7			
NOTE		10					11			
ΔP - FT.		→ 625 ←			→ 834 ←		→ 198 ←			

← ΔP = 52.4 FT (SEE NOTE 8) →

- NOTES:
- ALL ELEVATIONS ARE WITH RESPECT TO PUMP & ELEVATION WHICH IS ASSUMED "0".
  - ALLOWANCE FOR SYSTEM PIPE FRICTION, VALVE & FITTING LOSSES ETC. ARE REFLECTED BY THE PRESSURES REPORTED IN THIS TABULATION. THIS ALLOWANCE IS BASED ON PRELIMINARY LAYOUTS & THE DATA & METHODS PRESENTED IN CRANE TECHNICAL PAPER 410 ASSUMING CLEAN PIPE EXCEPT FOR CARBON STEEL PIPE. FOR RUNS OF CARBON STEEL PIPE (NOT CARBON STEEL VALVES & FITTINGS) A MARGIN OF 20% ABOVE THE CLEAN FRICTION LOSS IS INCLUDED. PIPE FRICTION, VALVE & FITTING LOSSES ETC. MAY BE DISTRIBUTED THROUGHOUT SYSTEM AS REQUIRED BY FINAL SYSTEM LAYOUT CONSIDERATIONS AS LONG AS THE TOTAL DOES NOT EXCEED THAT INDICATED ON THIS DIAGRAM.
  - A.E. WILL BE RESPONSIBLE TO INSURE THAT THE PIPING LOSSES ARE WITH IN THE LIMITS SPECIFIED ON THIS DRAWING AND SHALL REPORT DEVIATION TO A.P.E.D.
  - THE BY-PASS FLOW IS APPROXIMATE AND WILL BE SPECIFIED BY THE PUMP VENDOR.
  - ONLY ONE CORE SPRAY LOOP IS SHOWN. THE SECOND LOOP IS IDENTICAL EXCEPT FOR S.W. INERTIE.
  - IN CONDITION II THE NET POSITIVE SUCTION HEAD (NPSH) AVAILABLE AT THE PUMP INLET (LOCATION 2) MUST BE GREATER THAN OR EQUAL TO 32 FT OR PUMP MANUFACTURE SPECIFIED NPSH.
  - PARTS ARE NUMBERED AS PER CORE SPRAY P & ID MPL #14.
  - THIS ΔP DOES NOT INCLUDE ELEVATION LOSSES OR GE SUPPLIED EQUIPMENT ΔP.
  - 
  - IN CONDITION IV THE NET POSITIVE SUCTION PRESSURE (NPSH) IS EVALUATED IN NEDC 97-044A.
  - 95 GPM THERMAL SLEEVE LEAKAGE.
  - THIS DRAWING REFLECTS THE AS BUILT CONFIGURATION PER BURNS & ROE CORE SPRAY SYSTEM P & ID, DRAWING #2045, REV 17.
  - TECHNICAL SPECIFICATION SURVEILLANCE REQUIRES A MINIMUM FLOW OF 4720 GPM AT 113 PSID. THIS ENSURES THAT THE ECCS ANALYSIS ASSUMED FLOW RATES ARE MET.
  - CONDITION II TESTS ARE NOT PERFORMED AS PART OF SURVEILLANCE TESTING PROGRAM.
  - CONDITION IV TEMPERATURE AND PRESSURE REFLECT DBA-LOCA CONDITIONS (NEDC 94-034C).

VALVE POSITIONS

CONDITION	VALVE NO.				
	5	7	8	12	26
I	C	O	C	C	P
II	C	C	O	C	C
III	O	O	C	C	C
IV	C	O	C	O	C

O - FULL OPEN  
 C - FULL CLOSED  
 P - PARTIALLY OPEN

FOR PREVIOUS REVISIONS, SEE SUPERSEDED CARDS.

REVISIONS BY N.P.P.D.					
NO.	REVISIONS	DFT	CHK	APP	DATE
NO6	EE 02-033 (DCN 02-0720)	BAC	RHG	KG	11-2-92

AS BUILT  
 454004929

SCAN/CADD DWG  
 DO NOT REVISE MANUALLY  
 CADD FILE: C0046340

INSTRUMENT FUNCTION (FIRST LETTER)	CONTROLLING (SECOND AND THIRD LETTER)										MEASURING (SECOND AND THIRD LETTER)										SEE NOTE 3
	RECORDING	INDICATING	NON-INDICATING	CONTROL VALVE	SUMMER	FUNCTION GENERATOR	RECORDER	INDICATOR	OBSERVATION GLASS	PRIMARY ELEMENT	TEST POINT	TRANSMITTER OR PREAMP	INTERGRATOR	AMPLIFIER	SAMPLER	INDICATING SWITCH	NON-INDICATING SWITCH	ALARMS	TRANSDUCER NON-INDICATING	TRANSDUCER INDICATING	
AIR	A	-	-	-	-	-	-	-	-	-	-	-	-	-	-	-	-	-	-	-	
CONDUCTIVITY	C	CR	CI	-	CCV	-	CR	CI	-	CE	CE	CT	-	-	CS	CI	CS	CA	-	-	
DENSITY	D	DR	DI	DC	DCV	-	DR	DI	-	DE	DI	DT	-	-	DS	DI	DS	DA	-	-	
DIFF. PRESS.	DP	DRP	DRP	DCP	DCPV	-	DRP	DRP	-	DEP	DRP	DT	-	-	DS	DRP	DRP	DRP	DRP	DRP	
FLOW	F	FR	FI	FC	FCV	FE	FR	FI	FE	FE	FT	FT	FT	FT	FS	FI	FS	FA	FM	FIM	
HYDROGEN	H <sub>2</sub>	-	-	-	-	-	H <sub>2</sub>	H <sub>2</sub>	-	H <sub>2</sub> E	-	-	-	-	-	-	-	-	-	-	
HYDROGEN ION CONC.	PH	PHRC	PHC	PHC	PHCV	-	PHR	PHI	-	PHC	PHC	-	-	PHAM	PHM	-	-	-	-	-	
LEVEL	L	LRC	LIC	LC	LCV	-	LR	LI	LG	-	LT	-	-	-	LS	LS	LA	LM	LIM	-	
MOISTURE	M	MRC	MIC	-	-	-	MR	MI	-	ME	MT	-	-	-	MS	MS	-	-	-	-	
NEUTRON FLUX	N	NRC	NIC	NC	-	-	NR	NI	-	NE	NR	NT	NO	NAM	-	-	NA	-	-	-	
OXYGEN	O <sub>2</sub>	-	-	-	-	-	O <sub>2</sub>	O <sub>2</sub>	-	O <sub>2</sub> E	-	-	-	-	-	-	-	-	-	-	
PRESSURE	P	PR	PI	PC	PCV	-	PR	PI	-	PE	PT	-	-	-	PS	PS	PA	PM	PIM	-	
POSITION	PO	-	-	-	-	-	PO	PO	-	PE	-	-	-	-	PS	PS	PA	PM	PIM	-	
RADIATION	R	-	-	-	-	-	RR	RI	-	RE	RR	-	-	RAM	RM	-	RA	-	-	-	
SPEED	S	SR	SI	SC	-	-	SR	SI	-	SE	-	-	-	-	-	-	-	-	-	-	
TEMPERATURE	T	TR	TI	TC	TCV	-	TR	TI	-	TE	TX	TT	TQ	-	TS	TS	TA	TM	TIM	-	
TIME	U	-	-	UC	-	-	UT	-	-	-	-	-	-	-	US	US	-	-	-	-	
TRANSDUCER	TR	-	-	-	-	-	TR	-	-	TDE	-	TBT	-	-	-	-	-	-	-	-	
VIBRATION	V	-	-	-	-	-	VR	-	-	VBI	-	-	-	-	VBS	VBS	-	-	-	-	
WEIGHT FACTOR	W	WR	WI	-	WV	-	-	-	-	-	-	-	-	-	-	-	-	-	-	-	

MISCELLANEOUS ABBREVIATIONS:


ADS	AUTOMATIC DEPRESSURIZATION
A/S	AIR SUPPLY
AW	ACID WASTE (CORROSIVE, CAUSTIC)
CIT	CONDUCTIVITY INDICATOR TRANSMITTER
CRD	CONTROL ROD DRIVE
CRDS	CONTROL ROD DRIVE HYDRAULIC SYSTEM
CRS	CONDUCTIVITY RECORDING SWITCH
CRW	CLEAN RADWASTE
IC	CYCLE TIMER
DRW	DIRTY RADWASTE
DS	DIFFERENTIAL TEMPERATURE SWITCH
E/P	CONVERTER (VOLTAGE/PNEUMATIC)
E/S	SPECIAL ELECTRIC POWER SUPPLY REQUIRED
F/D	FILTER DEMINERALIZER
FC	INDICATES CLOSURE ON AIR OR ELECTRICAL FAILURE
FI	FLOW INDICATOR TRANSMITTER
FO	INDICATES OPEN ON AIR OR ELECTRICAL FAILURE
FACS	FLOW RECORDING CONTROLLER SWITCH
HCU	HYDRAULIC CONTROL UNIT
HE	HEAT EXCHANGER
IP	CONVERTER (CURRENT/PNEUMATIC)
LC	LOCK CLOSED
L/DAS	LEVEL & DENSITY RECORDER SWITCH
LHM	LIMIT SWITCH
LIS	LEVEL INDICATOR RECORDING SWITCH
LO	LOCK OPEN
LRS	LEVEL RECORDING SWITCH
MSIV	MAIN STEAM ISOLATION VALVE
MV/I	MILLIVOLT TO CURRENT CONVERTER
NC	NORMALLY CLOSED
ND	NORMALLY DE-ENERGIZED
NE	NORMALLY ENERGIZED
NO	NORMALLY OPEN
NSS	NUCLEAR STEAM SUPPLY SYSTEM
NW	NORMAL WASTE (CONVENTIONAL)

MISCELLANEOUS ABBREVIATIONS:

ABCV	REACTOR BUILDING CLOSED COOLING WATER
ABDT	REACTOR BUILDING EQUIPMENT DRAIN TANK
RM	REMOTE MANUAL
RHC	REMOTE MANUAL CONTROL
RMS	REMOTE MANUAL SWITCH
RPS	REACTOR PROTECTION SYSTEM
RPV	REACTOR PRESSURE VESSEL
SS	SELECTOR SWITCH
SSA	SELECTIVE SWITCH AUTOMATIC
SR	SQUARE ROOT CONVERTOR
TBCW	TURBINE BUILDING CLOSED COOLING WATER
TARS	TURBIDITY RECORDER SWITCH
IDS	TIME DELAY SWITCH
TOOS	TORQUE OVERLOAD SWITCH
TORS	TORQUE RECORDER SWITCH
TOT	TORQUE TRANSMITTER
TRS	TEMPERATURE RECORDER SWITCH


NOTES:

- ALL SOLENOID VALVES SHOWN IN DE-ENERGIZED POSITION. "NE"-SOLENOID IS NORMALLY ENERGIZED DURING PLANT OPERATION.
- SYMBOLS INACTIVE FOR NEW DESIGN.
- FOR THE TYPE OF TRANSDUCER (SWITCH OR TRANSMITTER) REFER TO THE PARTICULAR SYSTEM MASTER PARTS LIST.

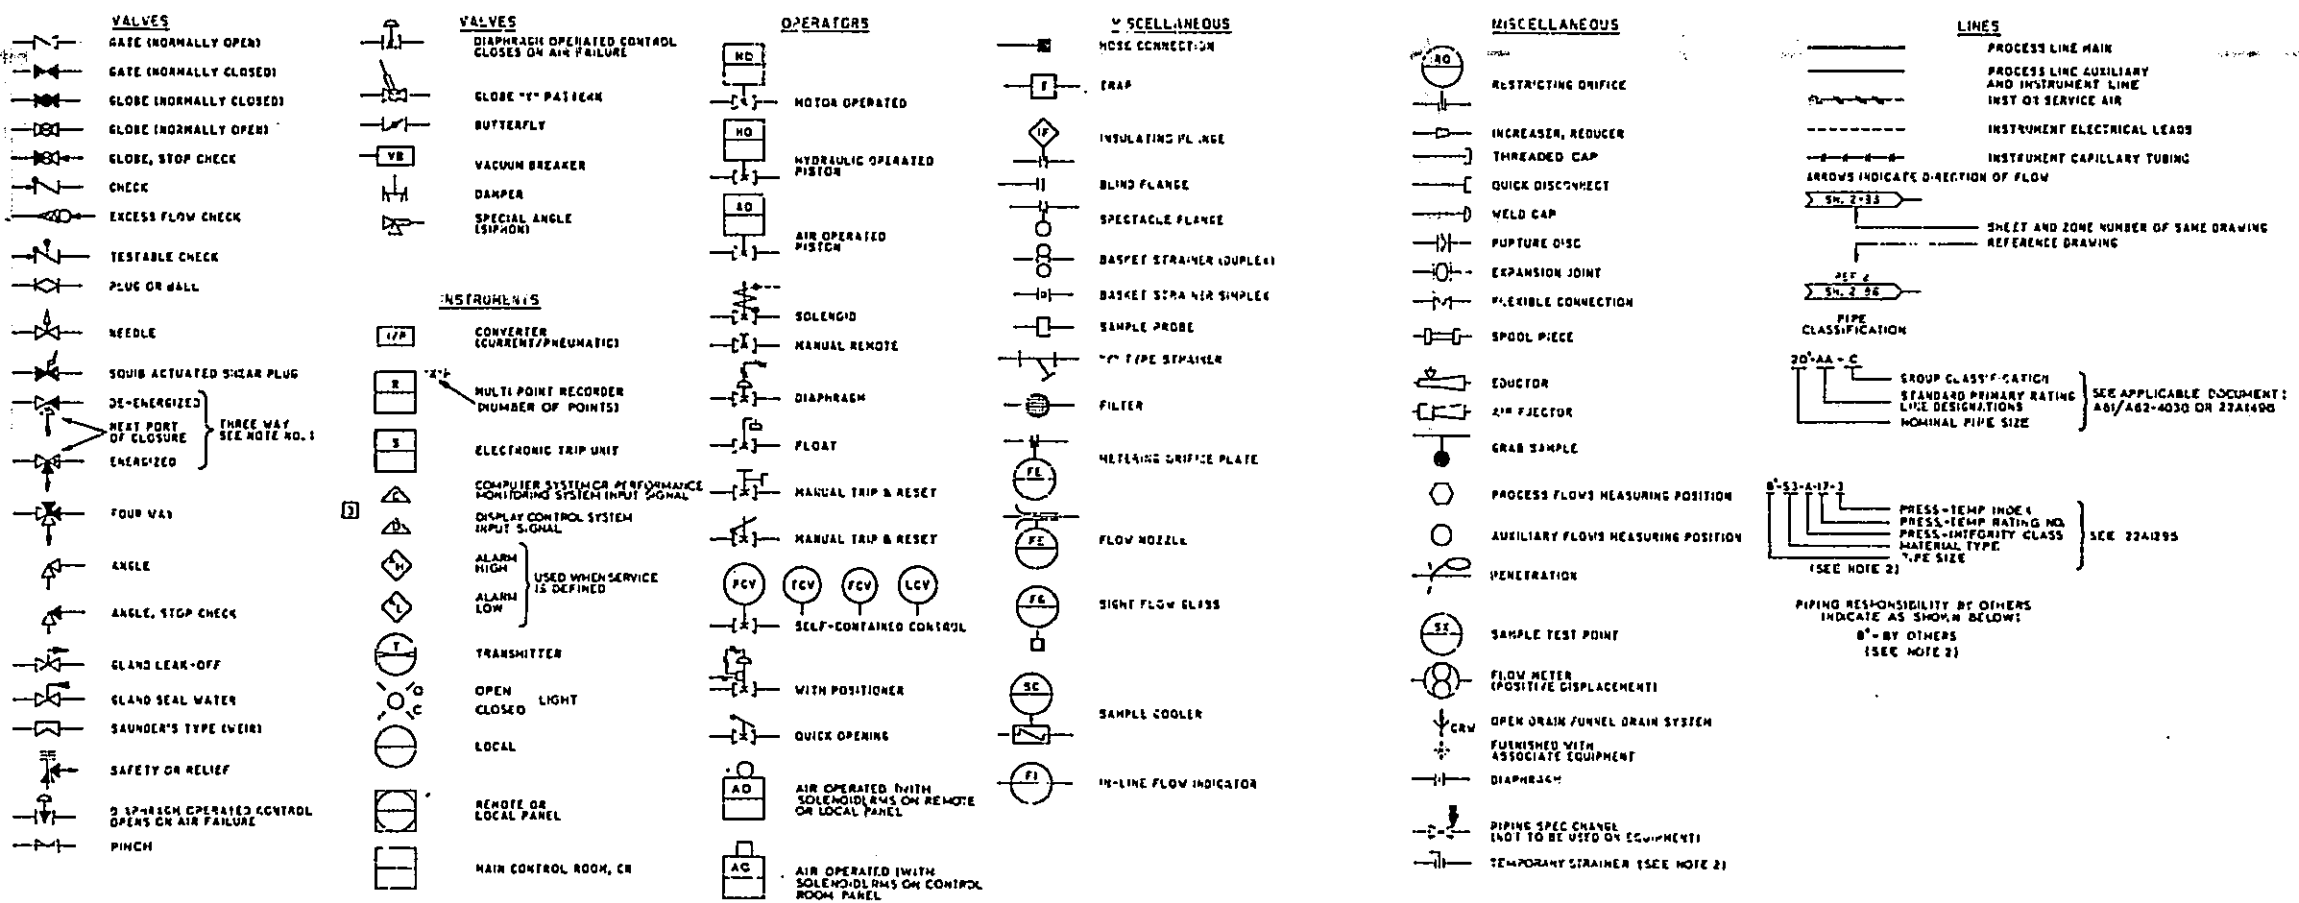

AS BUILT

DATE	BY	CHECKED	DATE
1978567			

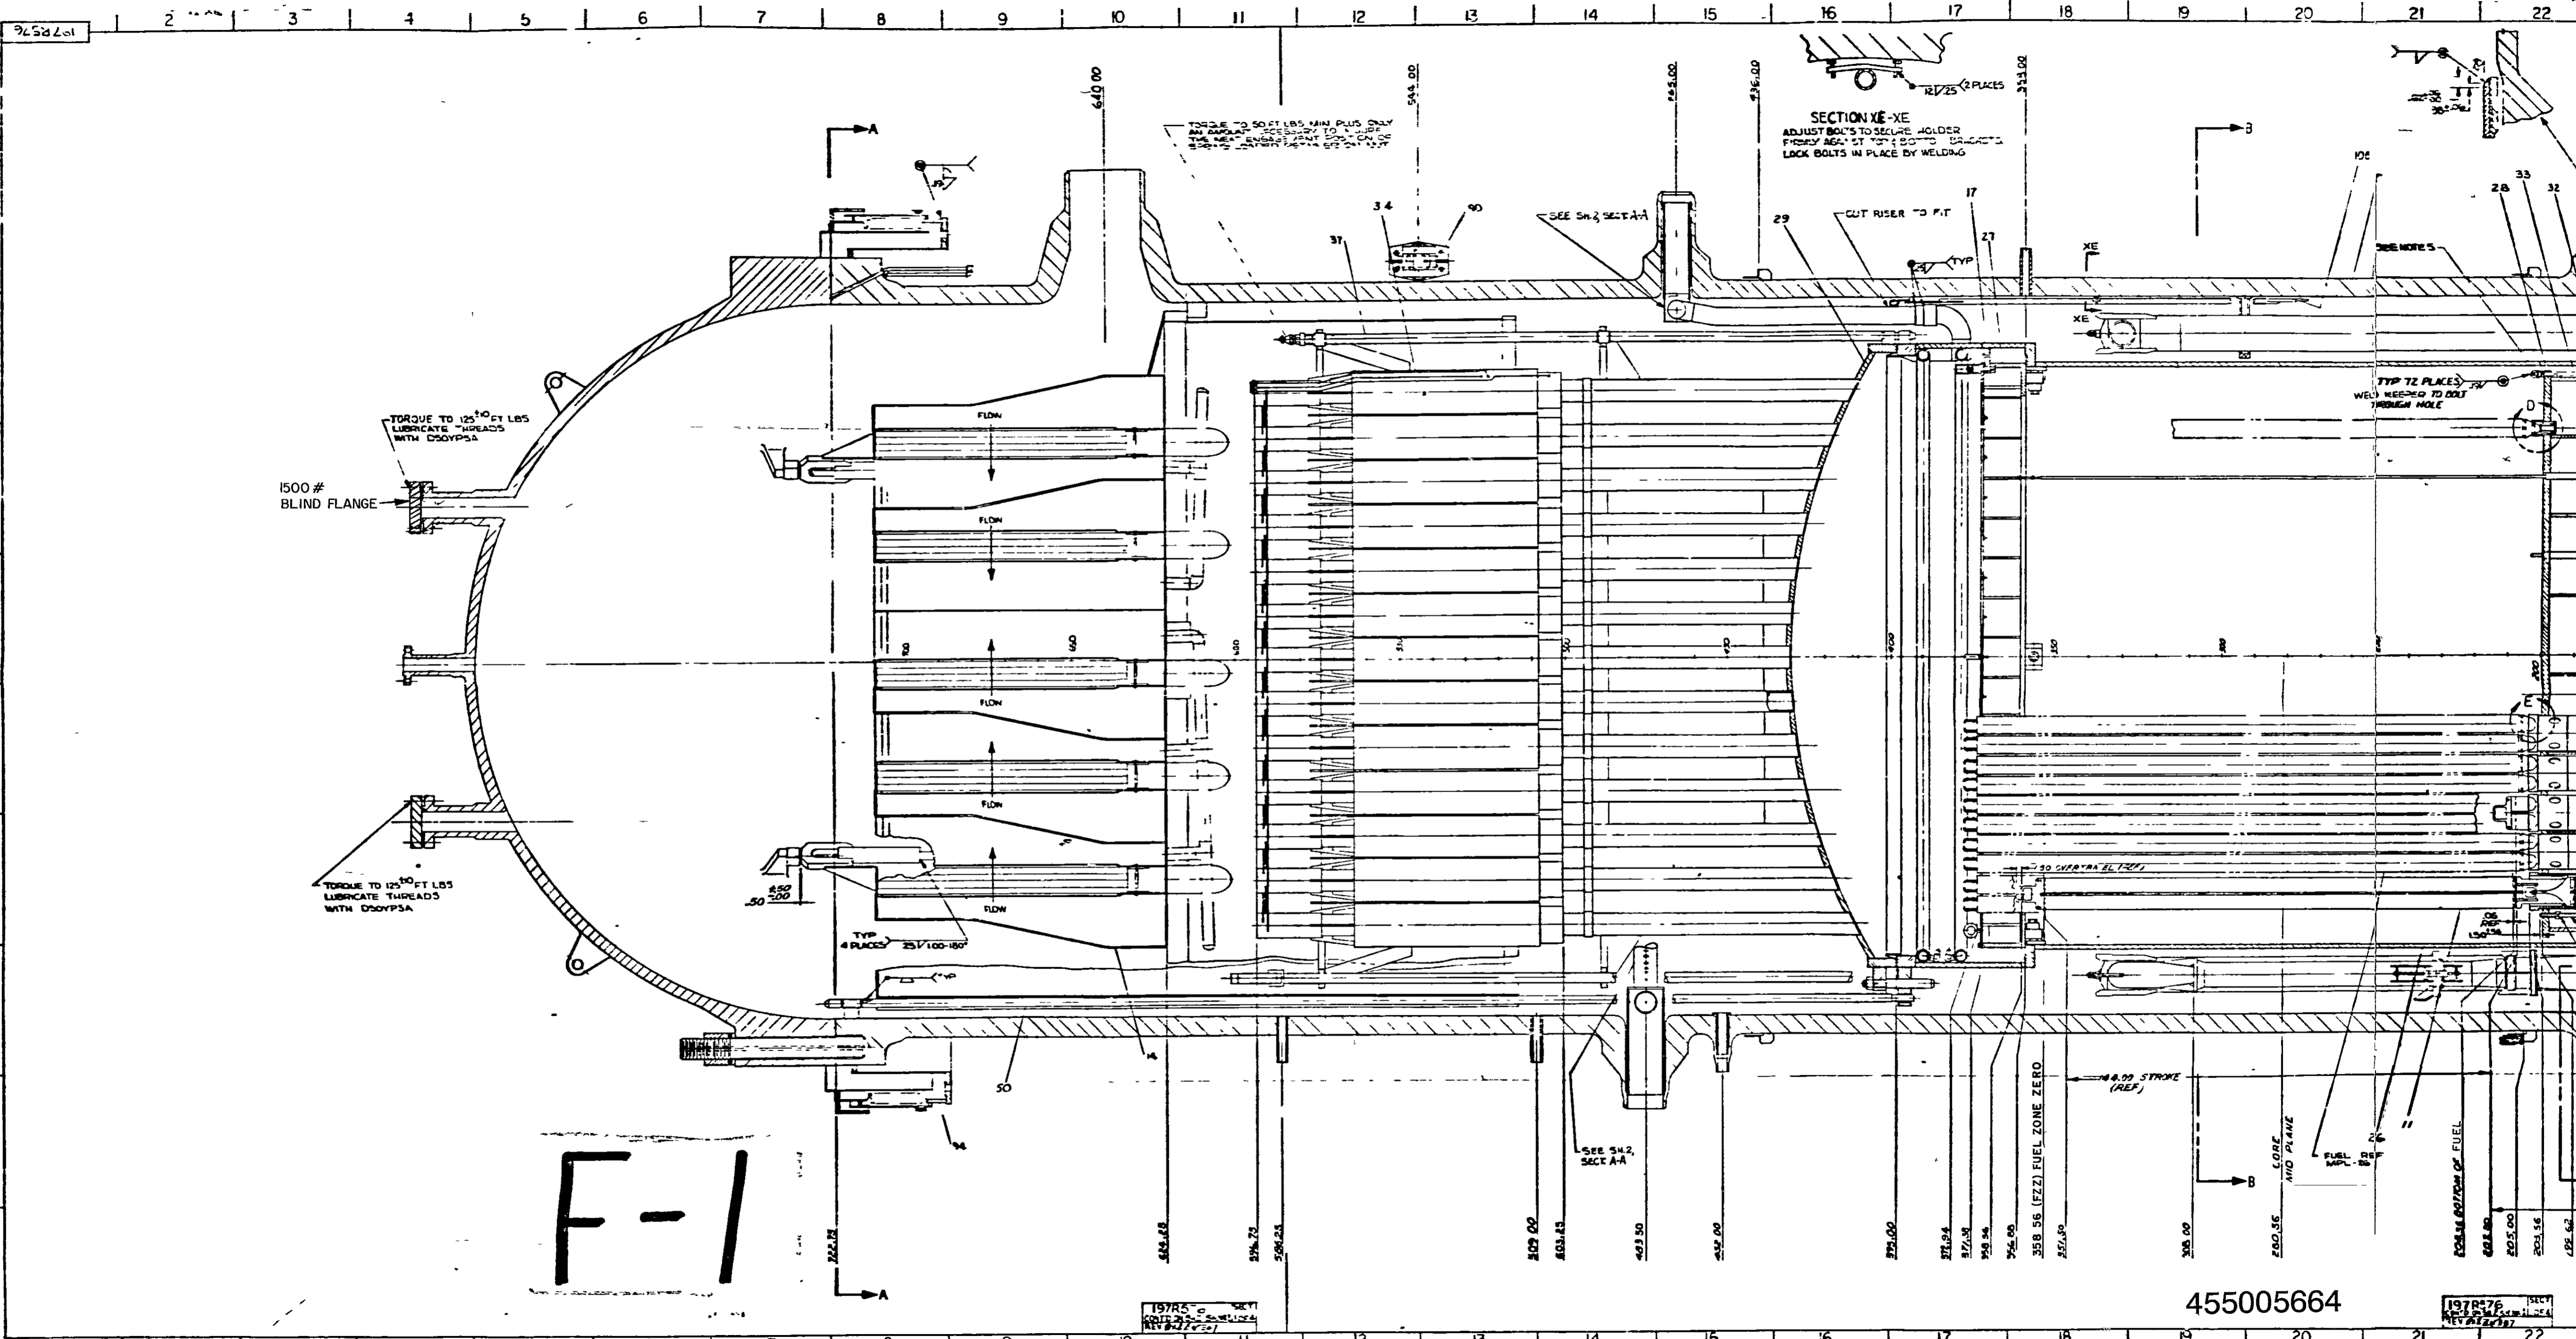

197R76

TORQUE TO 125<sup>10</sup> FT LBS  
LUBRICATE THREADS  
WITH D50YPSA

1500 #  
BLIND FLANGE

TORQUE TO 125<sup>10</sup> FT LBS  
LUBRICATE THREADS  
WITH D50YPSA

TORQUE TO 50 FT LBS MIN PLUS ONLY  
AND BAPOLAR ACCESSORY TO  
THE NEXT HIGHER TIGHTENING TORQUE  
WHEN THE NEXT HIGHER TORQUE IS NOT

SECTION XE-XE  
ADJUST BOLTS TO SECURE HOLDER  
FIRMLY AGAINST TOP OF COVER. BRACKET  
LOCK BOLTS IN PLACE BY WELDING


TYP 72 PLACES  
WELD KEPT TO DOT  
THROUGH HOLE

F-1

197R76  
REV 2-77

455005664

197R76  
REV 2-77

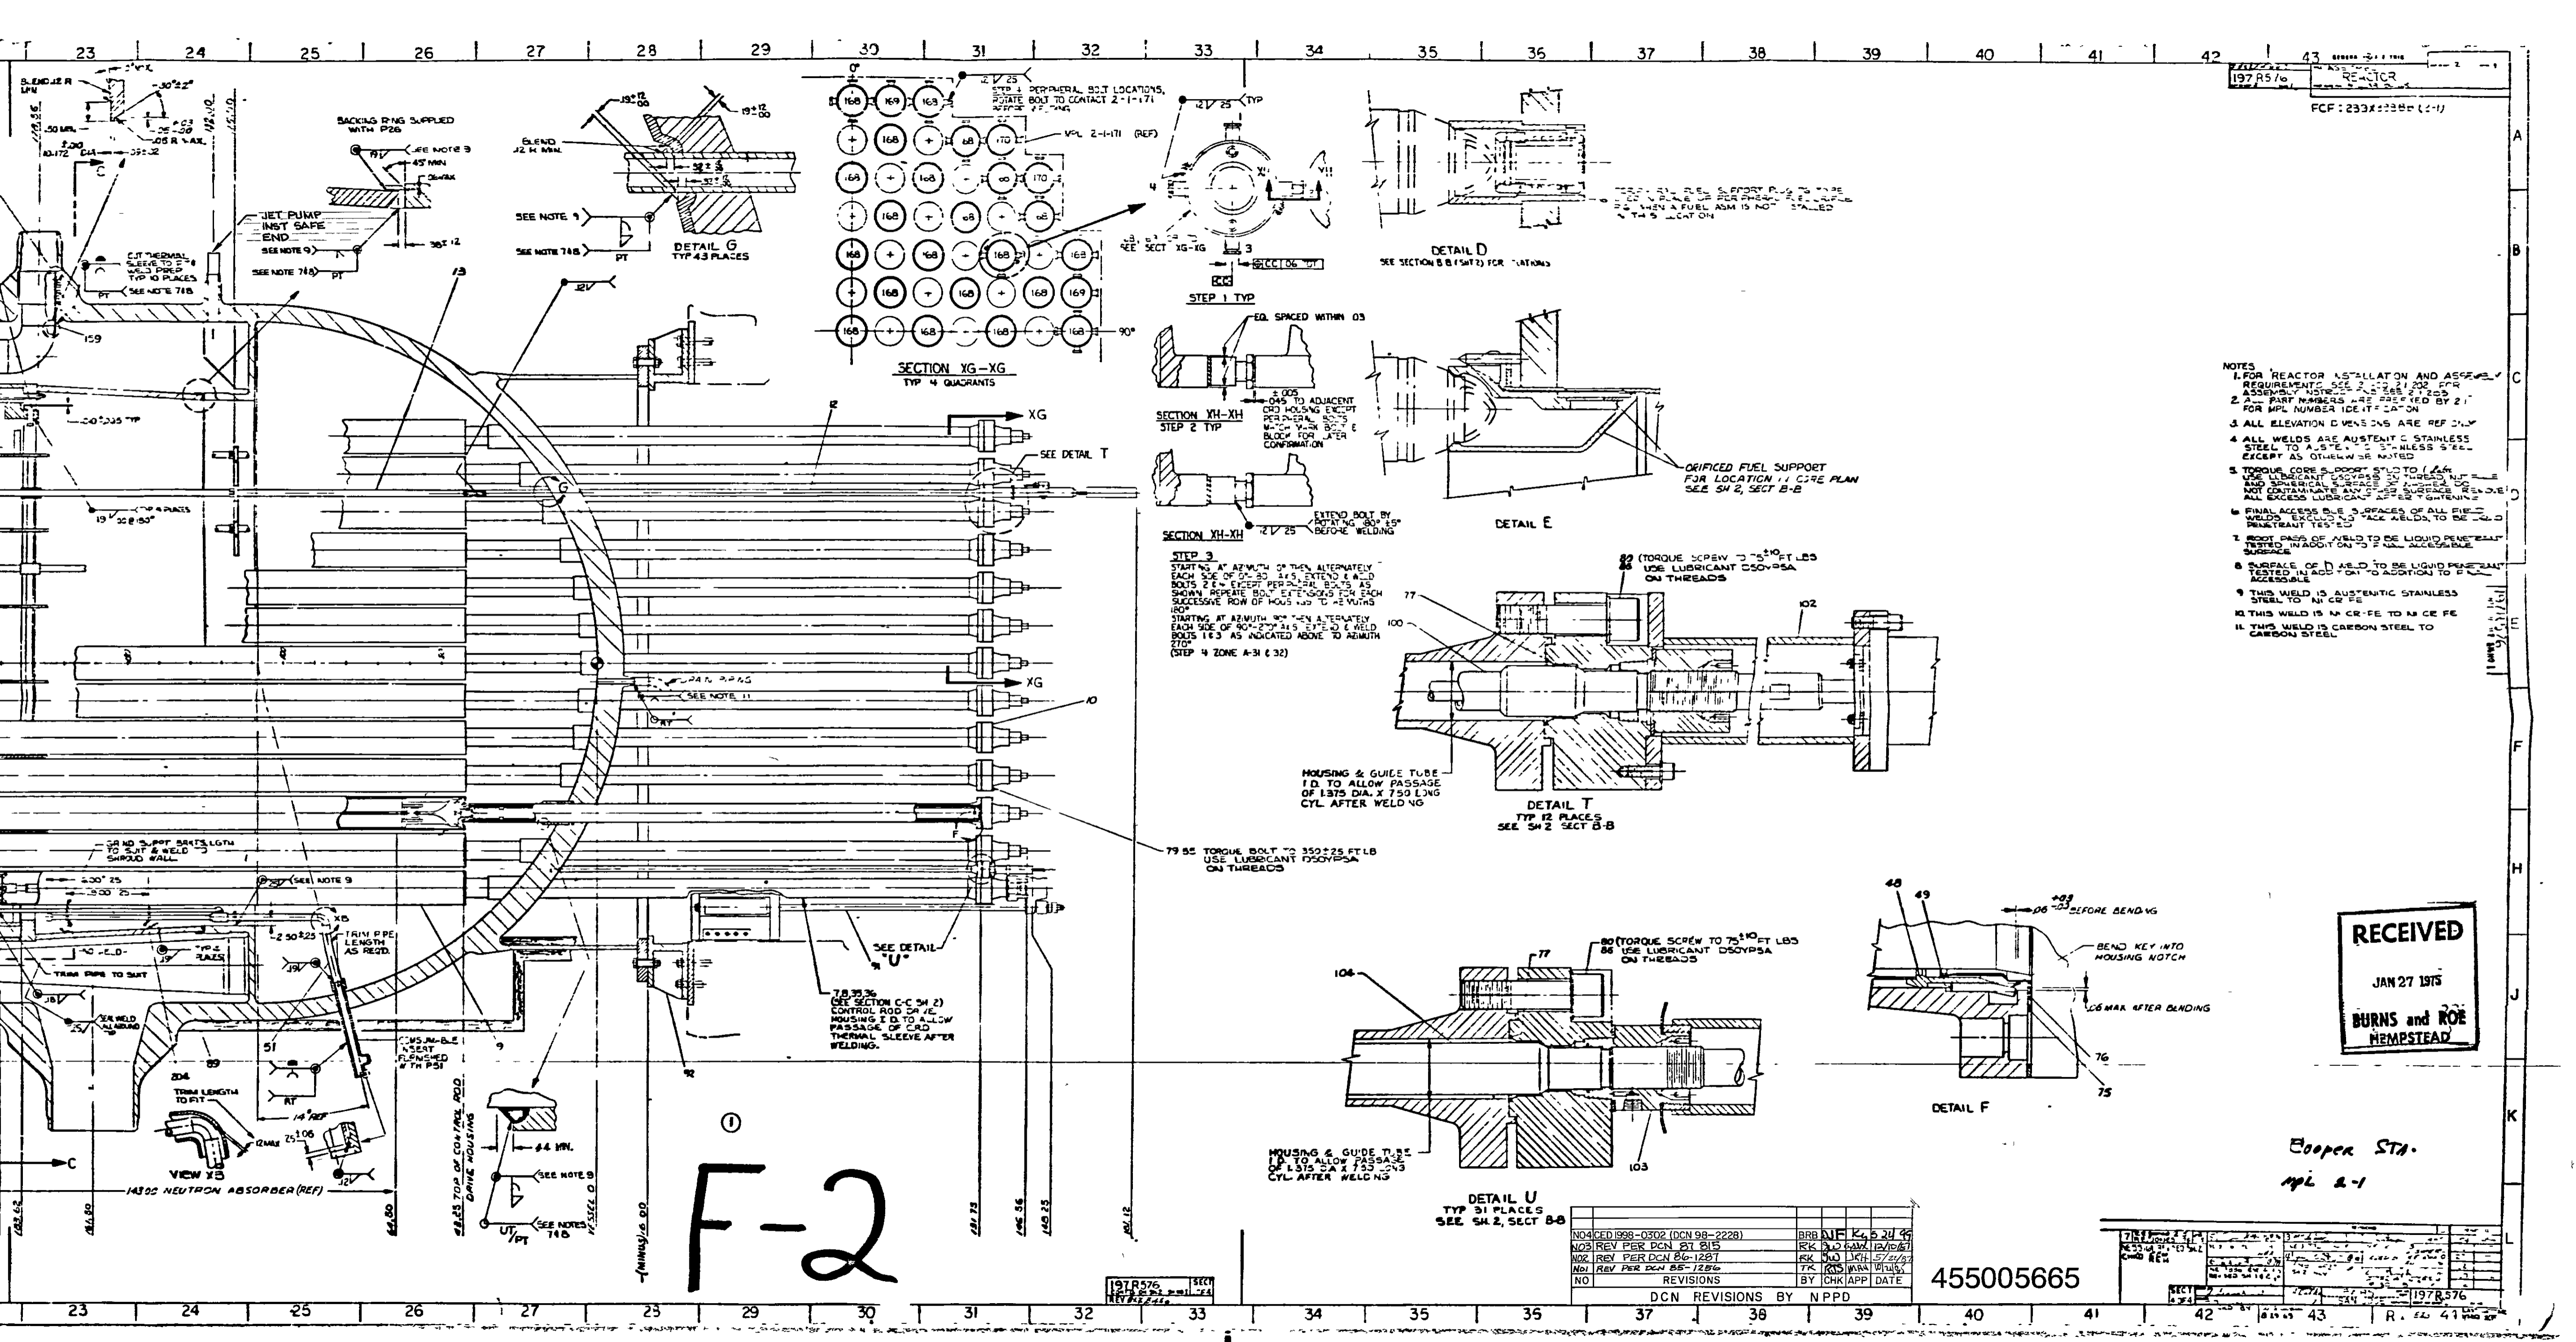

- NOTES
1. FOR REACTOR INSTALLATION AND ASSEMBLY REQUIREMENTS SEE 2-303 21-202 FOR ASSEMBLY NOTES AND 2-303 21-203 FOR MPL NUMBER IDENTIFICATION
  2. ALL PART NUMBERS ARE PREFIXED BY 21 FOR MPL NUMBER IDENTIFICATION
  3. ALL ELEVATION DIMENSIONS ARE REF ONLY
  4. ALL WELDS ARE AUSTENITIC STAINLESS STEEL TO A.S.T.E. C 316 UNLESS STATED EXCEPT AS OTHERWISE NOTED
  5. TORQUE CORE SUPPORT BOLTS TO 75<sup>10</sup> FT LBS USE LUBRICANT D50YPSA ON THREADS AND SPHERICAL SURFACES OF BOLTS DO NOT CONTAMINATE ANY OTHER SURFACE REMOVE ALL EXCESS LUBRICANT AFTER TIGHTENING
  6. FINAL ACCESSIBLE SURFACES OF ALL FIELD WELDS EXCLUDING TACK WELDS, TO BE LIQUID PENETRANT TESTED IN ADDITION TO FINAL ACCESSIBLE SURFACE
  7. ROOT PASS OF WELD TO BE LIQUID PENETRANT TESTED IN ADDITION TO FINAL ACCESSIBLE SURFACE
  8. SURFACE OF WELD TO BE LIQUID PENETRANT TESTED IN ADDITION TO FINAL ACCESSIBLE SURFACE
  9. THIS WELD IS AUSTENITIC STAINLESS STEEL TO A.S.T.E. C 316
  10. THIS WELD IS IN CR-Fe TO IN CR-Fe
  11. THIS WELD IS CARBON STEEL TO CARBON STEEL

RECEIVED  
JAN 27 1975  
BURNS and ROE  
HEMPSTEAD

Cooper STA.  
MPL 2-1

F-2

NO	REVISIONS	BY	CHK	APP	DATE
NO4	CD 1968-0302 (DCN 98-2228)	BRB	DLF	K	5 30 68
NO3	REV PER DCN 81-815	RSK	RD	KAM	12/10/67
NO2	REV PER DCN 80-1281	RSK	RD	DLH	5/22/67
NO1	REV PER DCN 85-1286	TK	MS	WMA	10/10/65

455005665


SECTION	DATE	BY	CHK	APP	DATE
197R576	1975	BRB	DLF	K	5 30 68








STA NO	"A"	"B"	"C"	"D"	TRAP	"E"	"F"	"G"	"H"	"J"	"K"	"L"	"M"
1	CONT ON 2002 SH2 ZONE B-7	197AV	133	131	1"S-57	132	2"MS-1 CONT ON 2005 SH1 ZONE D-5	197	IA-AV14	116	NA	177	2"MS-1
2	CONT ON 2002 SH2 ZONE D-5	198AV	136	134	1"S-57	135	2"MS-1 CONT ON 2005 SH1 ZONE D-5	198	IA-AV15	40	663	NA	2"MS-1
3	CONT ON 2002 SH2 ZONE E-7	199AV	139	137	1"S-57	138	2"MS-1 CONT ON 2005 SH1 ZONE D-5	199	IA-AV16	36	872	NA	2"MS-1
4	CONT ON 2002 SH2 ZONE C-6	AV	ES-63	ES-61	3/4"S-58	ES-62	2"CH-4 CONT ON 2005 SH1 ZONE H-11	ES-200	IA-AV17	NA	NA	NA	2"AS-2
5	CONT ON 2002 SH2 ZONE B-8	AV	ES-66	ES-64	3/4"S-58	ES-65	2"CH-4 CONT ON 2005 SH1 ZONE H-11	ES-201	IA-AV18	NA	NA	NA	2"AS-2
6	CONT ON 2002 SH2 ZONE D-8	AV	ES-69	ES-67	3/4"S-58	ES-68	2"CH-4 CONT ON 2005 SH1 ZONE H-11	ES-202	IA-AV19	NA	NA	NA	2"AS-2
6A	CONT ON 2002 SH2 ZONE C-7	AV	ES-274	ES-272	3/4"S-58	ES-273	2"CH-4 CONT ON 2005 SH1 ZONE H-11	ES-201	IA-2009	NA	NA	NA	2"AS-2

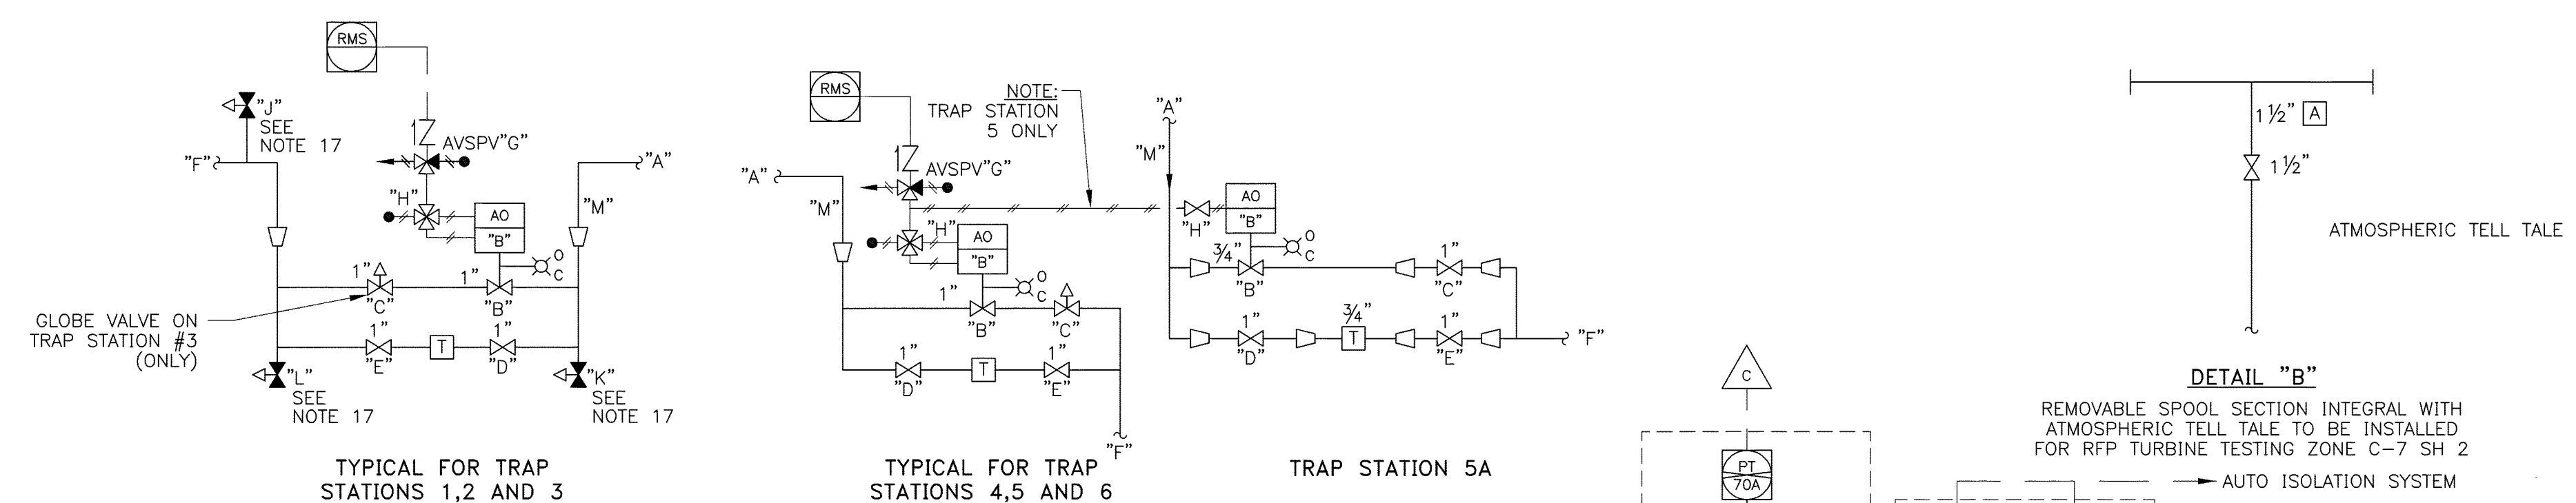

- NOTES:**
- UNLESS OTHERWISE INDICATED ALL PRESSURE AND OR FLOW INSTRUMENT ROOT LINES SHALL BE 3/4" ROOT VALVES SHALL BE 3/4"x253X LINE UP TO AND INCLUDING ROOT VALVE SHALL BE FURNISHED AND INSTALLED UNDER CONTRACT E-69-4.
  - MOISTURE SEPARATOR SAFETY VALVES FURNISHED BY WEST. ELEC. CORP. MOUNTED BY MECH. PIPING CONTRACTOR.
  - FOR REACTOR FEED PUMP TURBINE PIPING DRAINS SEE DWG 2005.
  - FOR DETAILS ON CONDENSER CONNECTION REFER TO CORRESPONDING DESIGNATIONS MS & DD. CO. DWG DC-93877 GA SH.3.
  - ALL MS-1, MS-1C, BS-2 & BS-2C PIPING SYSTEMS SHOWN HEREON SHALL BE CLASS IV-P POWER CLASSIFICATION.
  - UNLESS NOTED OTHERWISE ALL PIPING & EQUIPMENT FURNISHED BY WESTINGHOUSE (WITH TURBINE GEN.) SHALL BE INSTALLED BY TURBINE GENERATOR ERECTION CONTRACTOR.
  - AT SAMPLING POINTS, PROBES AND PIPING TO AND INCLUDING ROOT VALVES SHALL BE FURNISHED AND INSTALLED UNDER CONTRACT E-69-1. PROBES SHALL BE FURNISHED AND INSTALLED IN ACCORDANCE WITH CONTRACT PARA 34.2 AND DRAWING SP-07211 FIG. 1B. CONTINUATION OF SAMPLE PIPING BY E-70-3.
  - ALL VALVE NUMBERS IN PARENTHESIS ( ) ARE NUMBERS TO BE USED IN OPERATING PROCEDURES. THESE NUMBERS ARE ASSIGNED BY NPPD AND WILL NOT BE SHOWN ON PIPING DRAWINGS.
  - ALL ITEMS MARKED WITH **AS-BUILT** ARE NOT SHOWN PIPING DRAWINGS.
  - A SPEED CONTROL VALVE EXISTS BETWEEN THE ACTUATOR AND SOLENOID PILOT VALVE FOR THE INDICATED TRAP STATIONS:

TRAP STATION	SOLENOID VALVE	SPEED CONTROL VALVE
4	IA-AV17	IA-1657
5	IA-AV18	IA-1658
6	IA-AV19	IA-1659
11	MS-SPV194	IA-1660
12	MS-SPV191	IA-1661

- THE START UP POSITION FOR VALVES MS-V-60,61,62,63,65,66,67,68 ASSUMES RED SET IN SERVICE.
- REF HONEYWELL DWG 1550-X301 FOR INSTR PIPING AND VALVE INSTALLATION AT INSTR RACK IR-1C.
- REF HONEYWELL DWG 1550-X103 FOR INSTR PIPING AND VALVE INSTALLATION AT INSTR RACK IR-1E.
- ALL VALVES ARE IN THE MS SYSTEM UNLESS OTHERWISE DESIGNATED.
- WHERE LINES INTERCONNECT AND ARE CONTINUED ON OTHER DRAWINGS, ZONE NUMBERS ARE APPROXIMATE ONLY.
- BOUNDARY VALVE - REF. TO CALC. NEDC 00-029, ENG. EVAL. EE 01-147 & DWG CNS-MS-43 FOR IDENTIFICATION OF THE MSV LEAKAGE PATHWAY TO THE CONDENSER BOUNDARIES & SEISMIC QUALIFICATIONS.

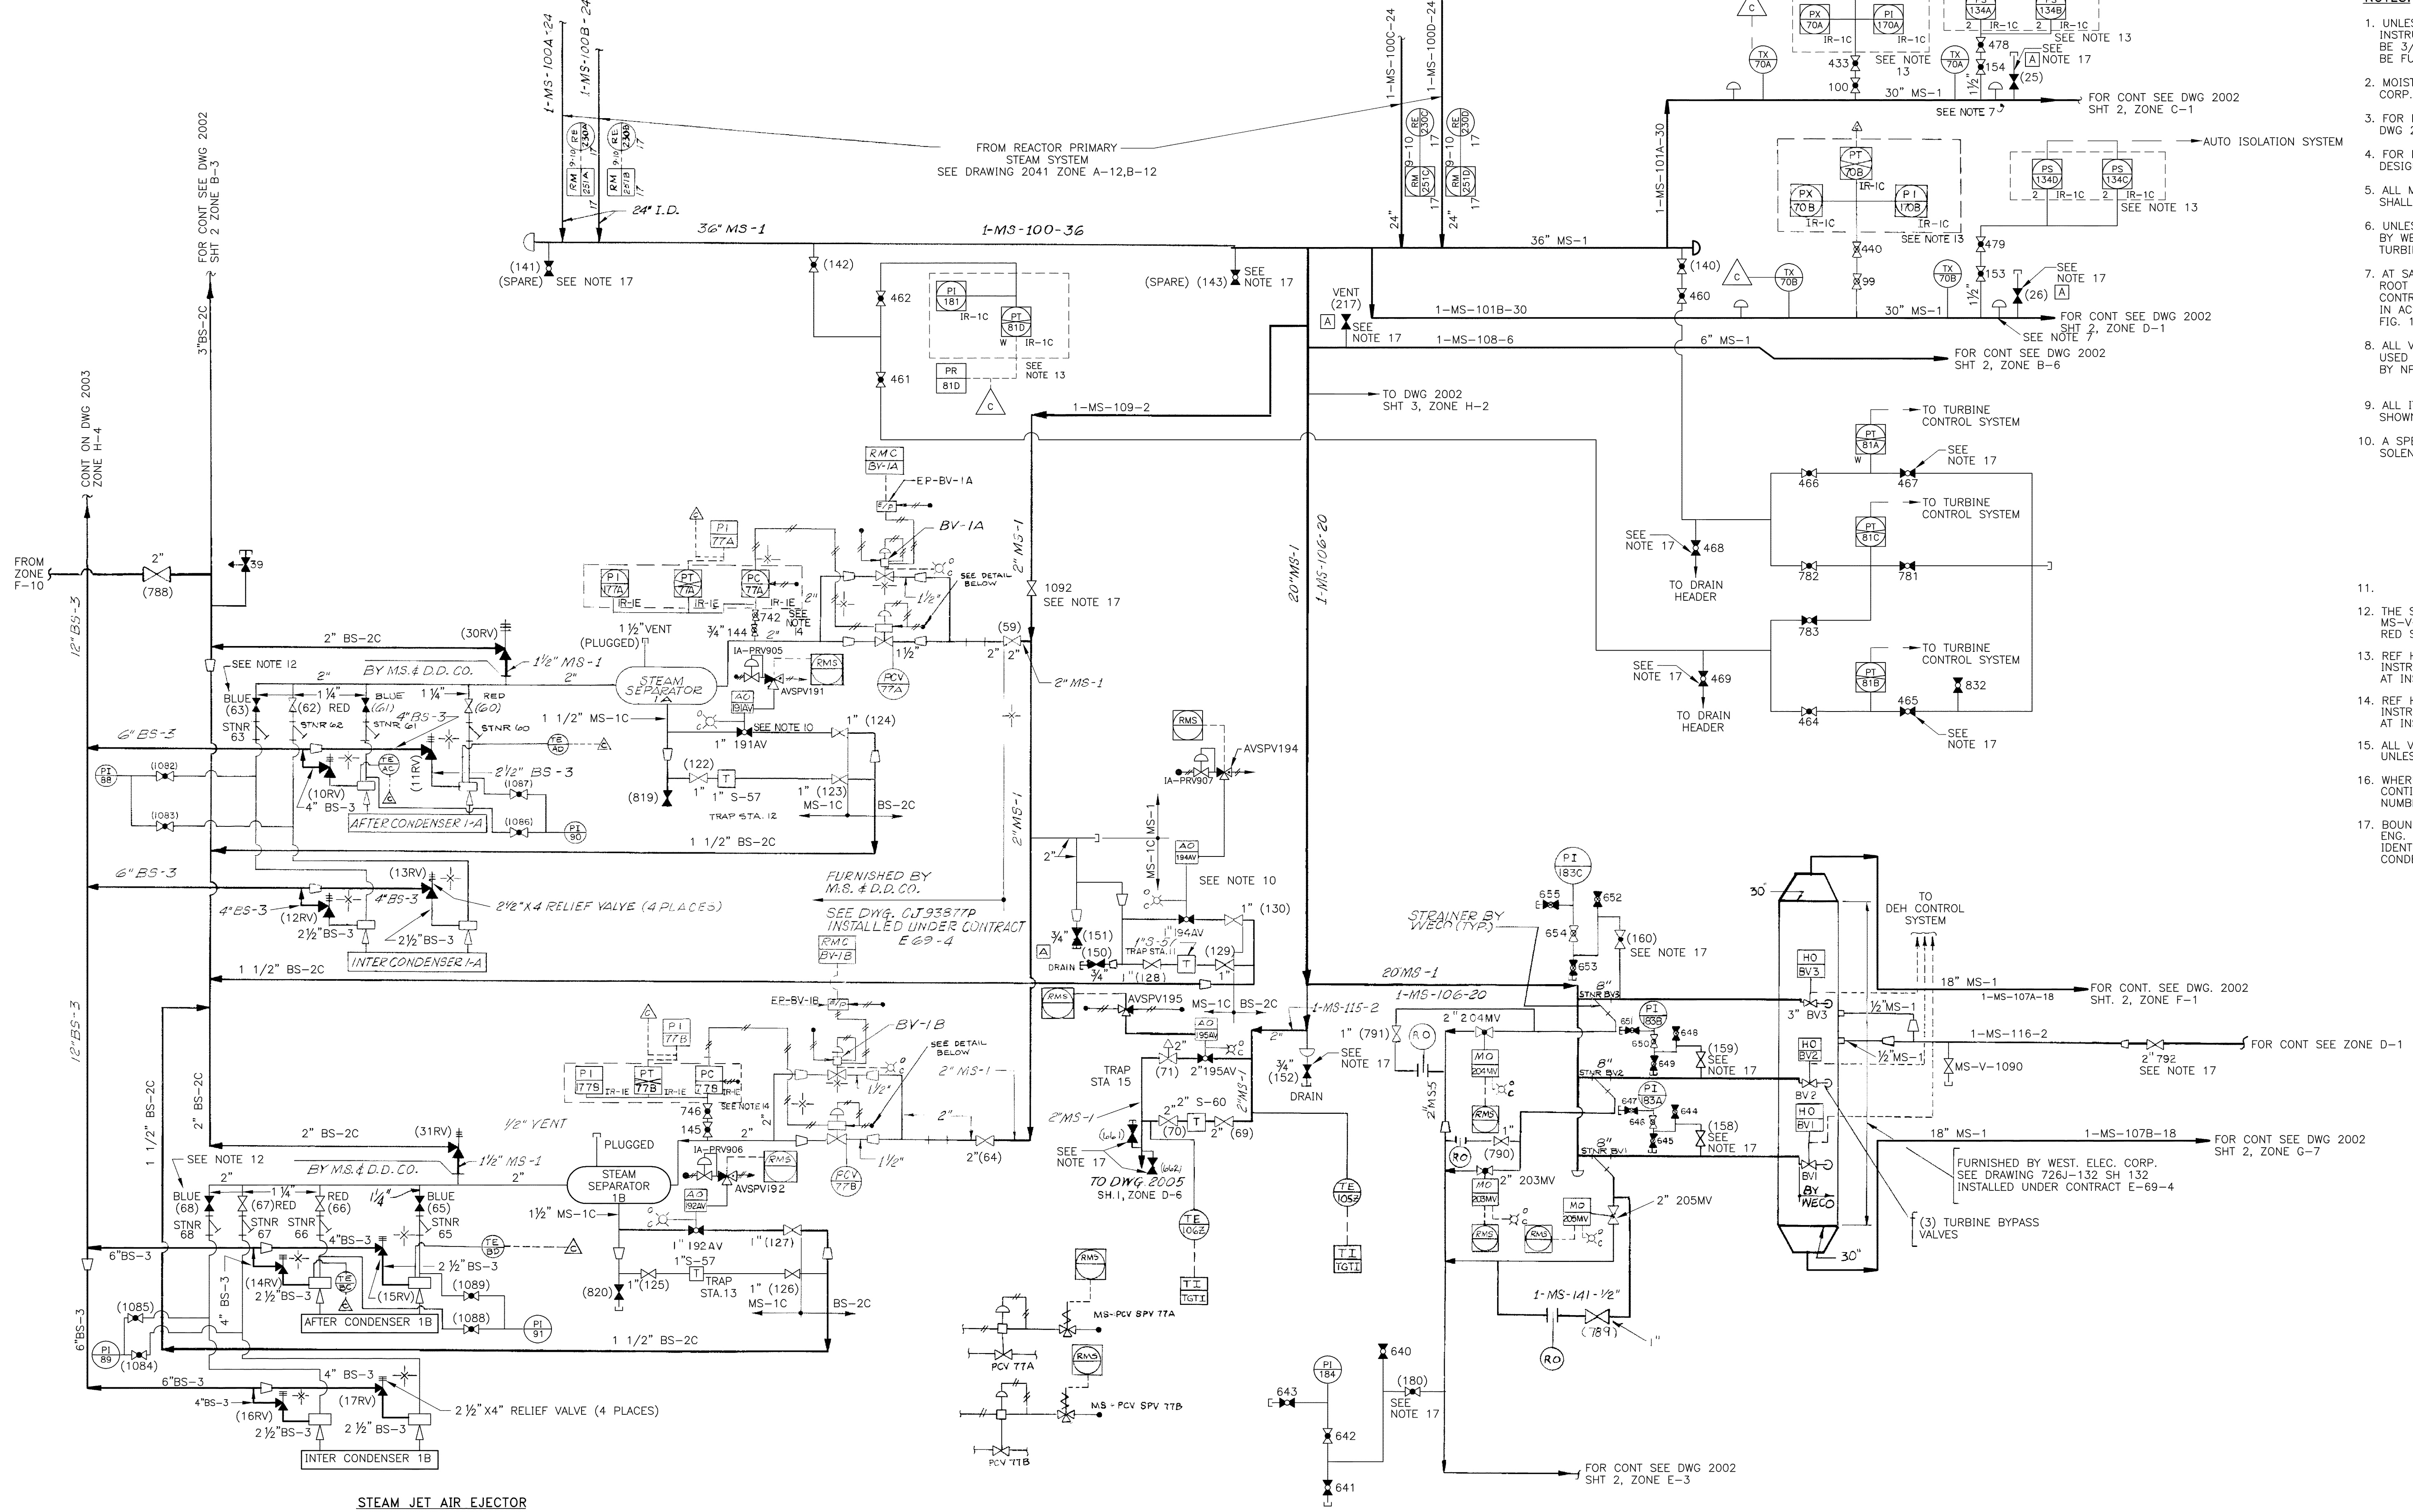

STEAM JET AIR EJECTOR


REVISIONS TO THIS DRAWING  
REQUIRES A REVISION TO THE  
CORRESPONDING ISOKEY.

FOR PREVIOUS REVISIONS, SEE SUPERSEDED CARDS.







NO.	DESCRIPTION	DFT DATE	ENG
AB/48/DR-2017-0273		06/10/30/18	D/WALKER

SIGNIFICANT NUMBER	GROUP						DATE	DRAWN	HYF	DATE	CHECKED	DATE	APPROVED	DATE	BY	DATE	FILED						
																		BURNS & ROE					
																		2002 SH 1					
<p align="center"><b>FLOW DIAGRAM</b> <b>MAIN, EXHAUST &amp; AUXILIARY STEAM SYSTEMS</b> <b>COOPER NUCLEAR STATION</b></p>																							

**AS BUILT**  
454003580  
STATUS: Release  
STATUS DATE: 10/30/2018  
DIS APPROVED: DTWALEN  
VER: AB REV: 48 SIZE: F

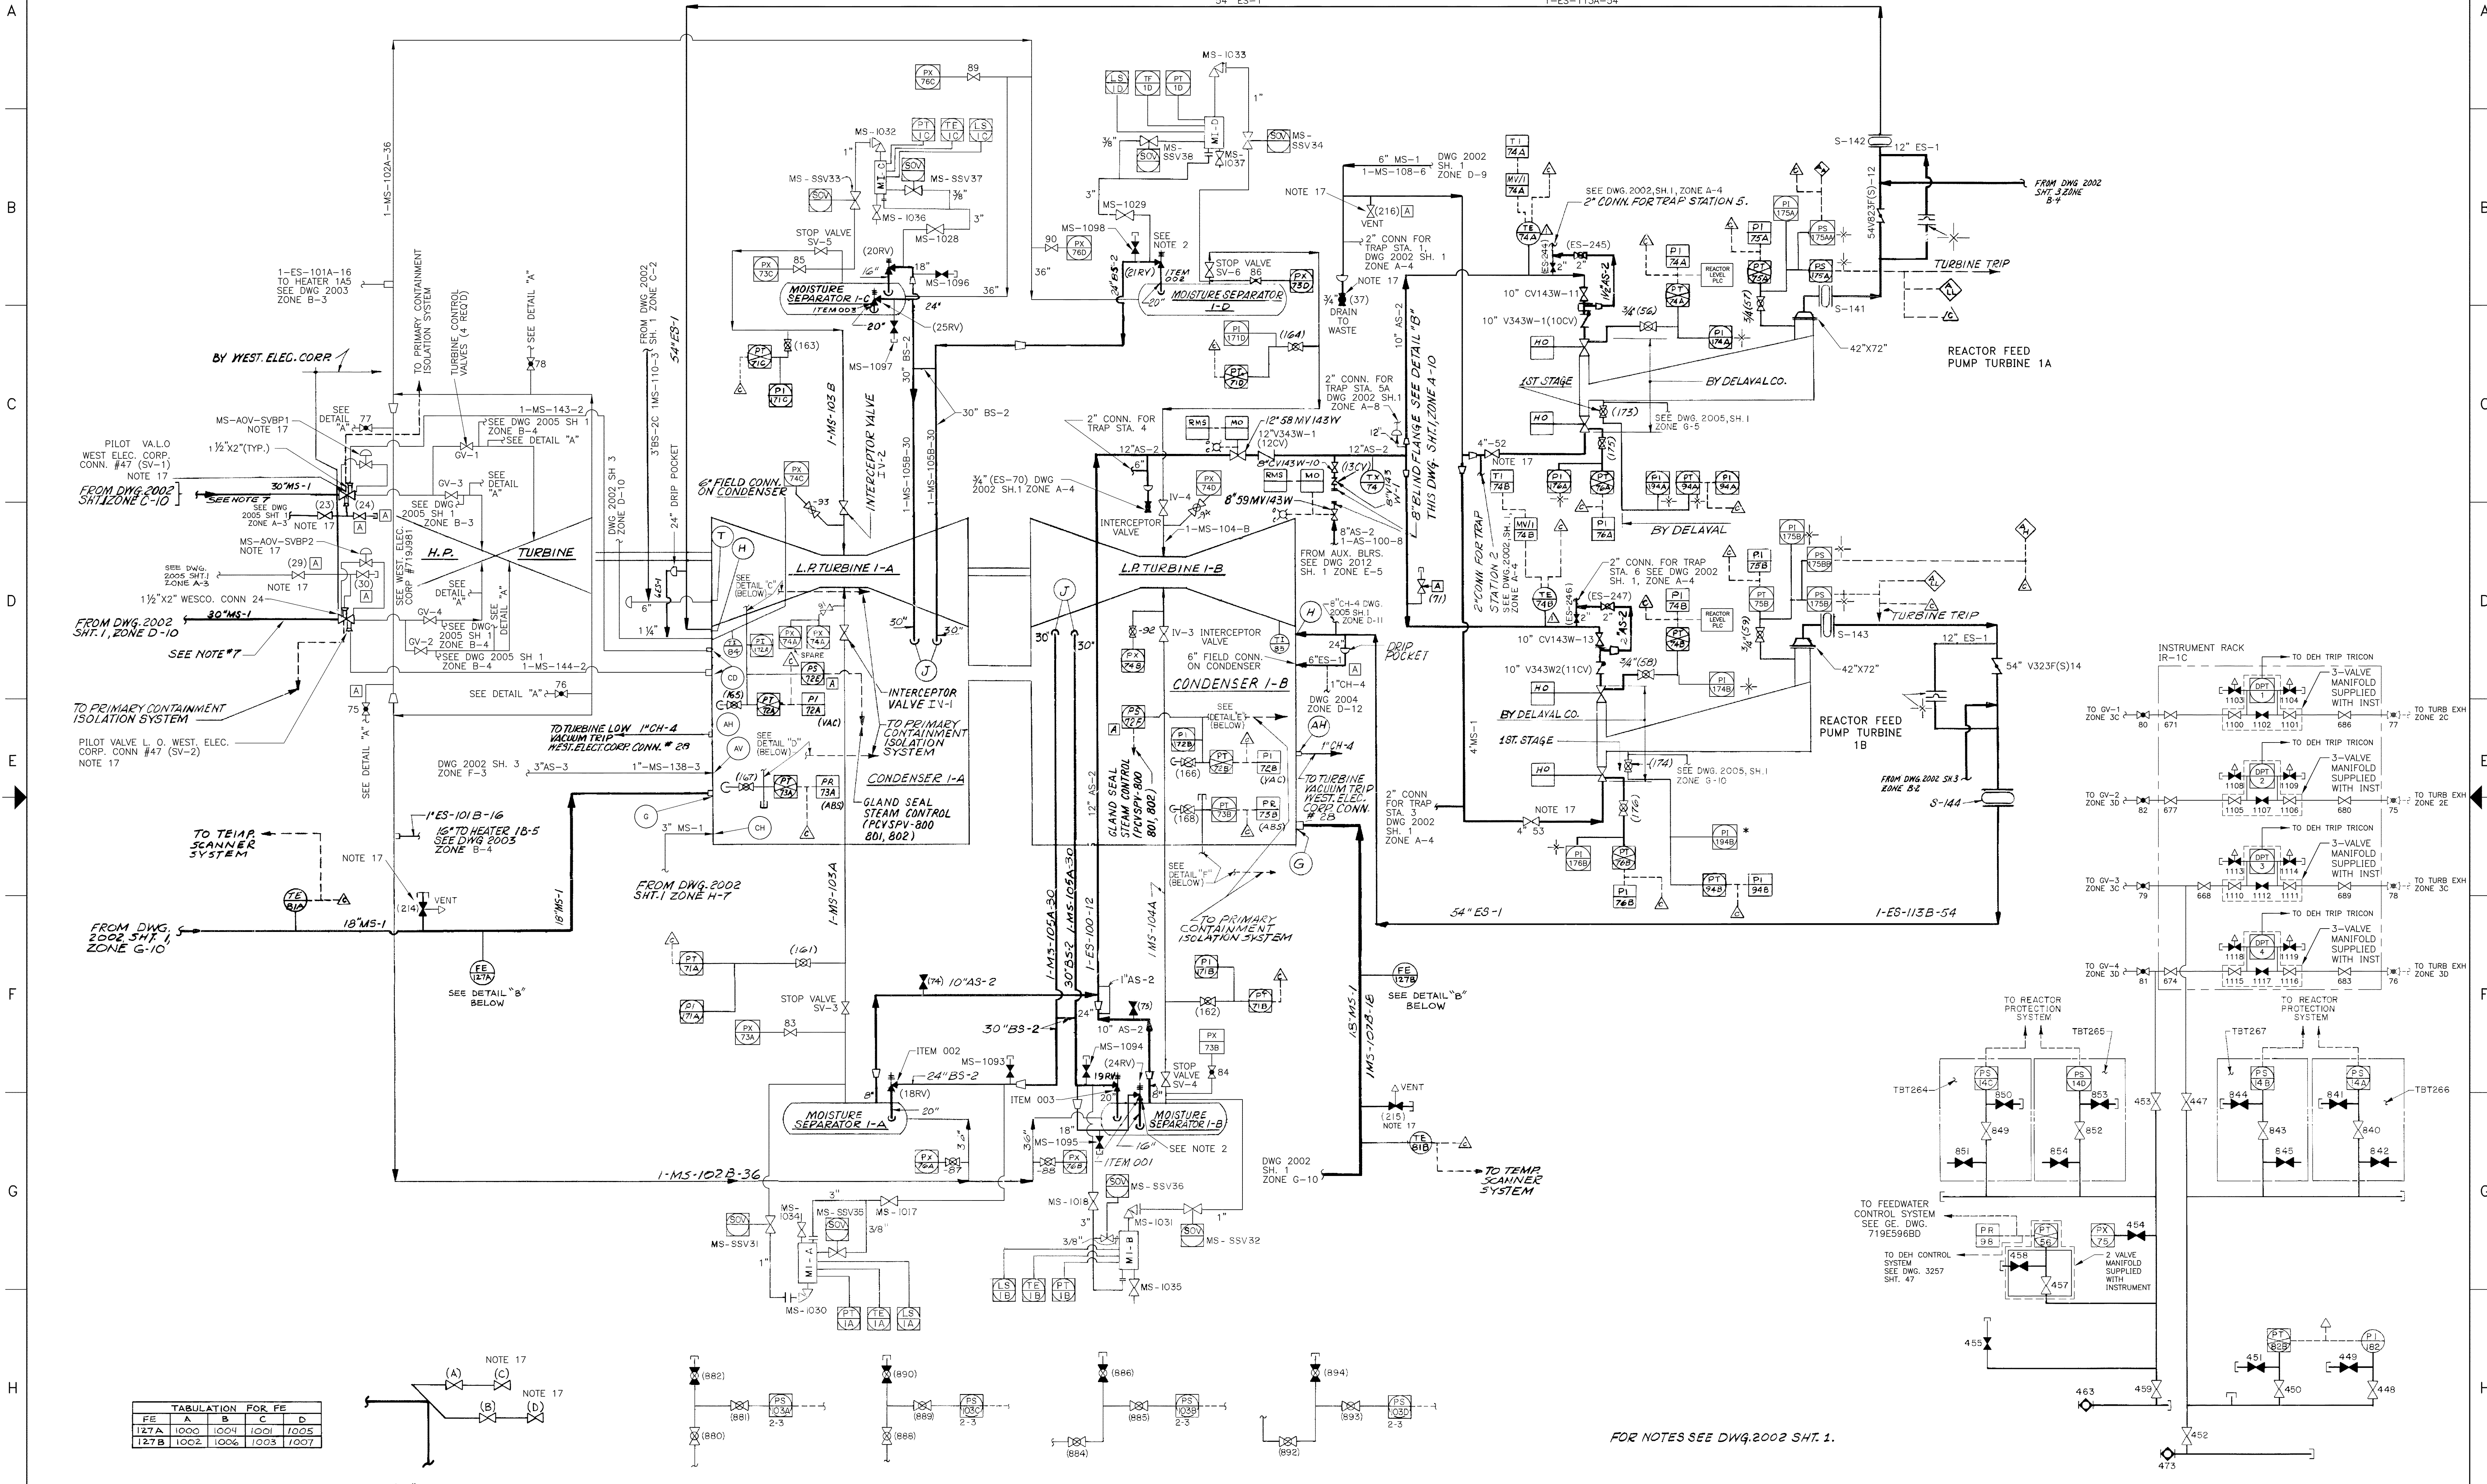

TABULATION FOR FE				
FE	A	B	C	D
127A	1000	1004	1001	1005
127B	1002	1006	1003	1007

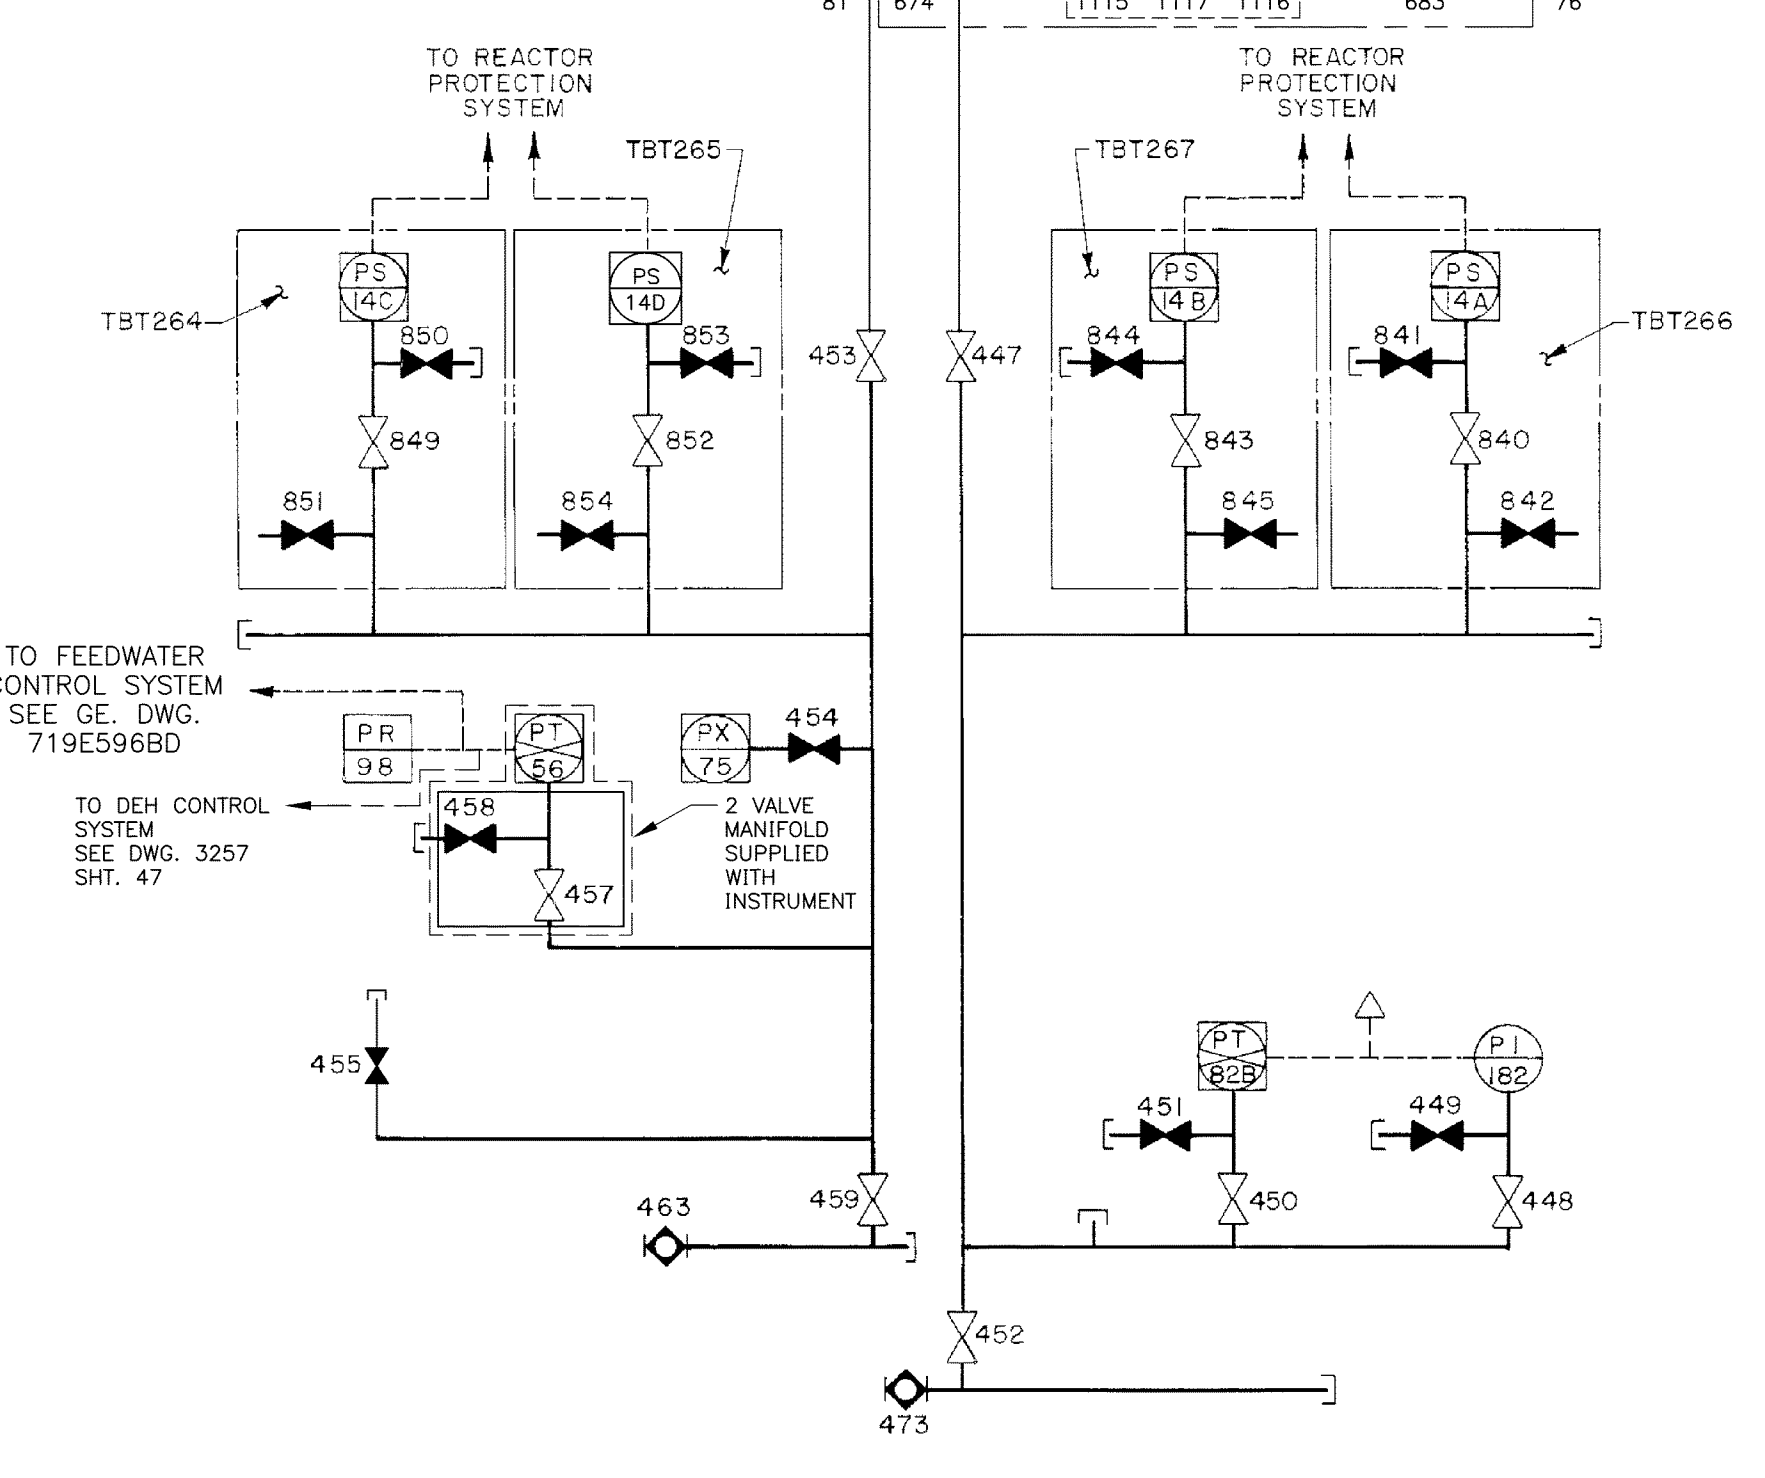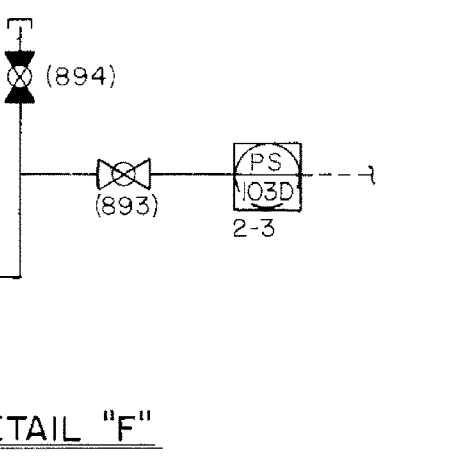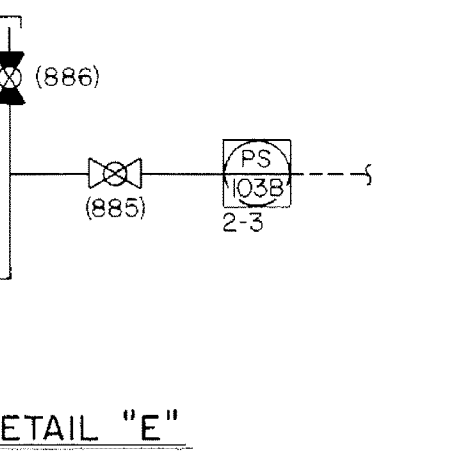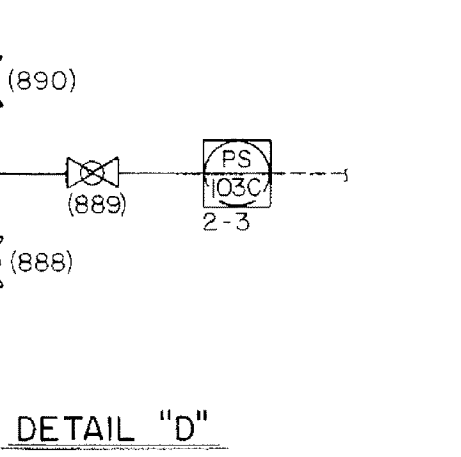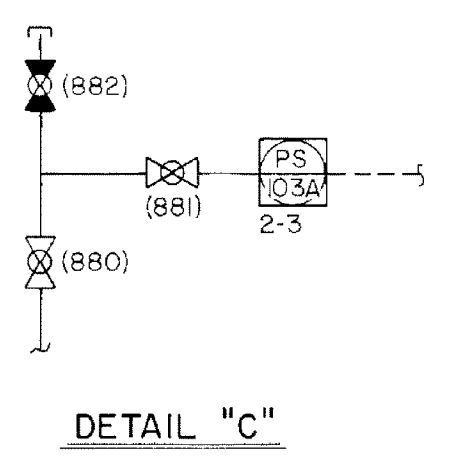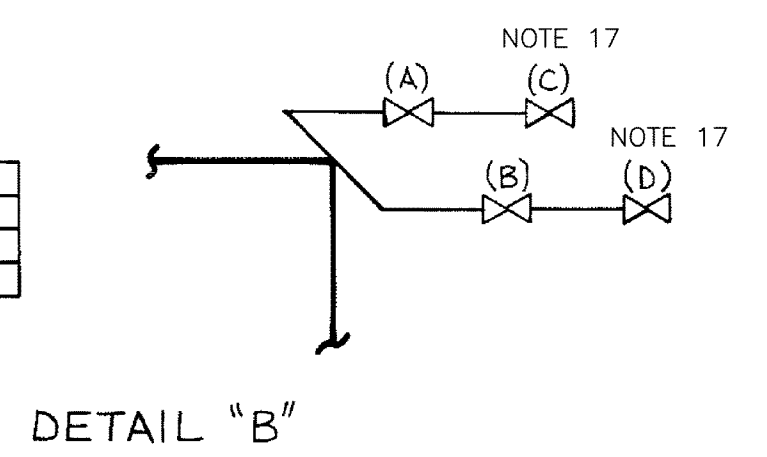


REVISIONS TO THIS DRAWING REQUIRES A REVISION TO THE CORRESPONDING ISOKEY.

FOR PREVIOUS REVISIONS, SEE SUPERSEDED CARDS.


NO.	DESCRIPTION	DPT	DATE	ENG.
127A	1000	1004	1001	1005
127B	1002	1006	1003	1007

SIGNIFICANT NUMBER	1	2	3	4	5	6
	GROUP					
DRAWN	HFY	DATE	02/25/02			
CHECKED		DATE				
APPROVED		DATE				
FILED						
COOPER NUCLEAR STATION FLOW DIAGRAM MAIN, EXHAUST & AUXILIARY STEAM SYSTEMS				BURNS & ROE		
2002 SH 2				AS BUILT 454003682		
				STATUS: Release STATUS DATE: 10/30/2018 DS APPROVED: DTWALEN VER: AF REV: 42 SIZE: F		

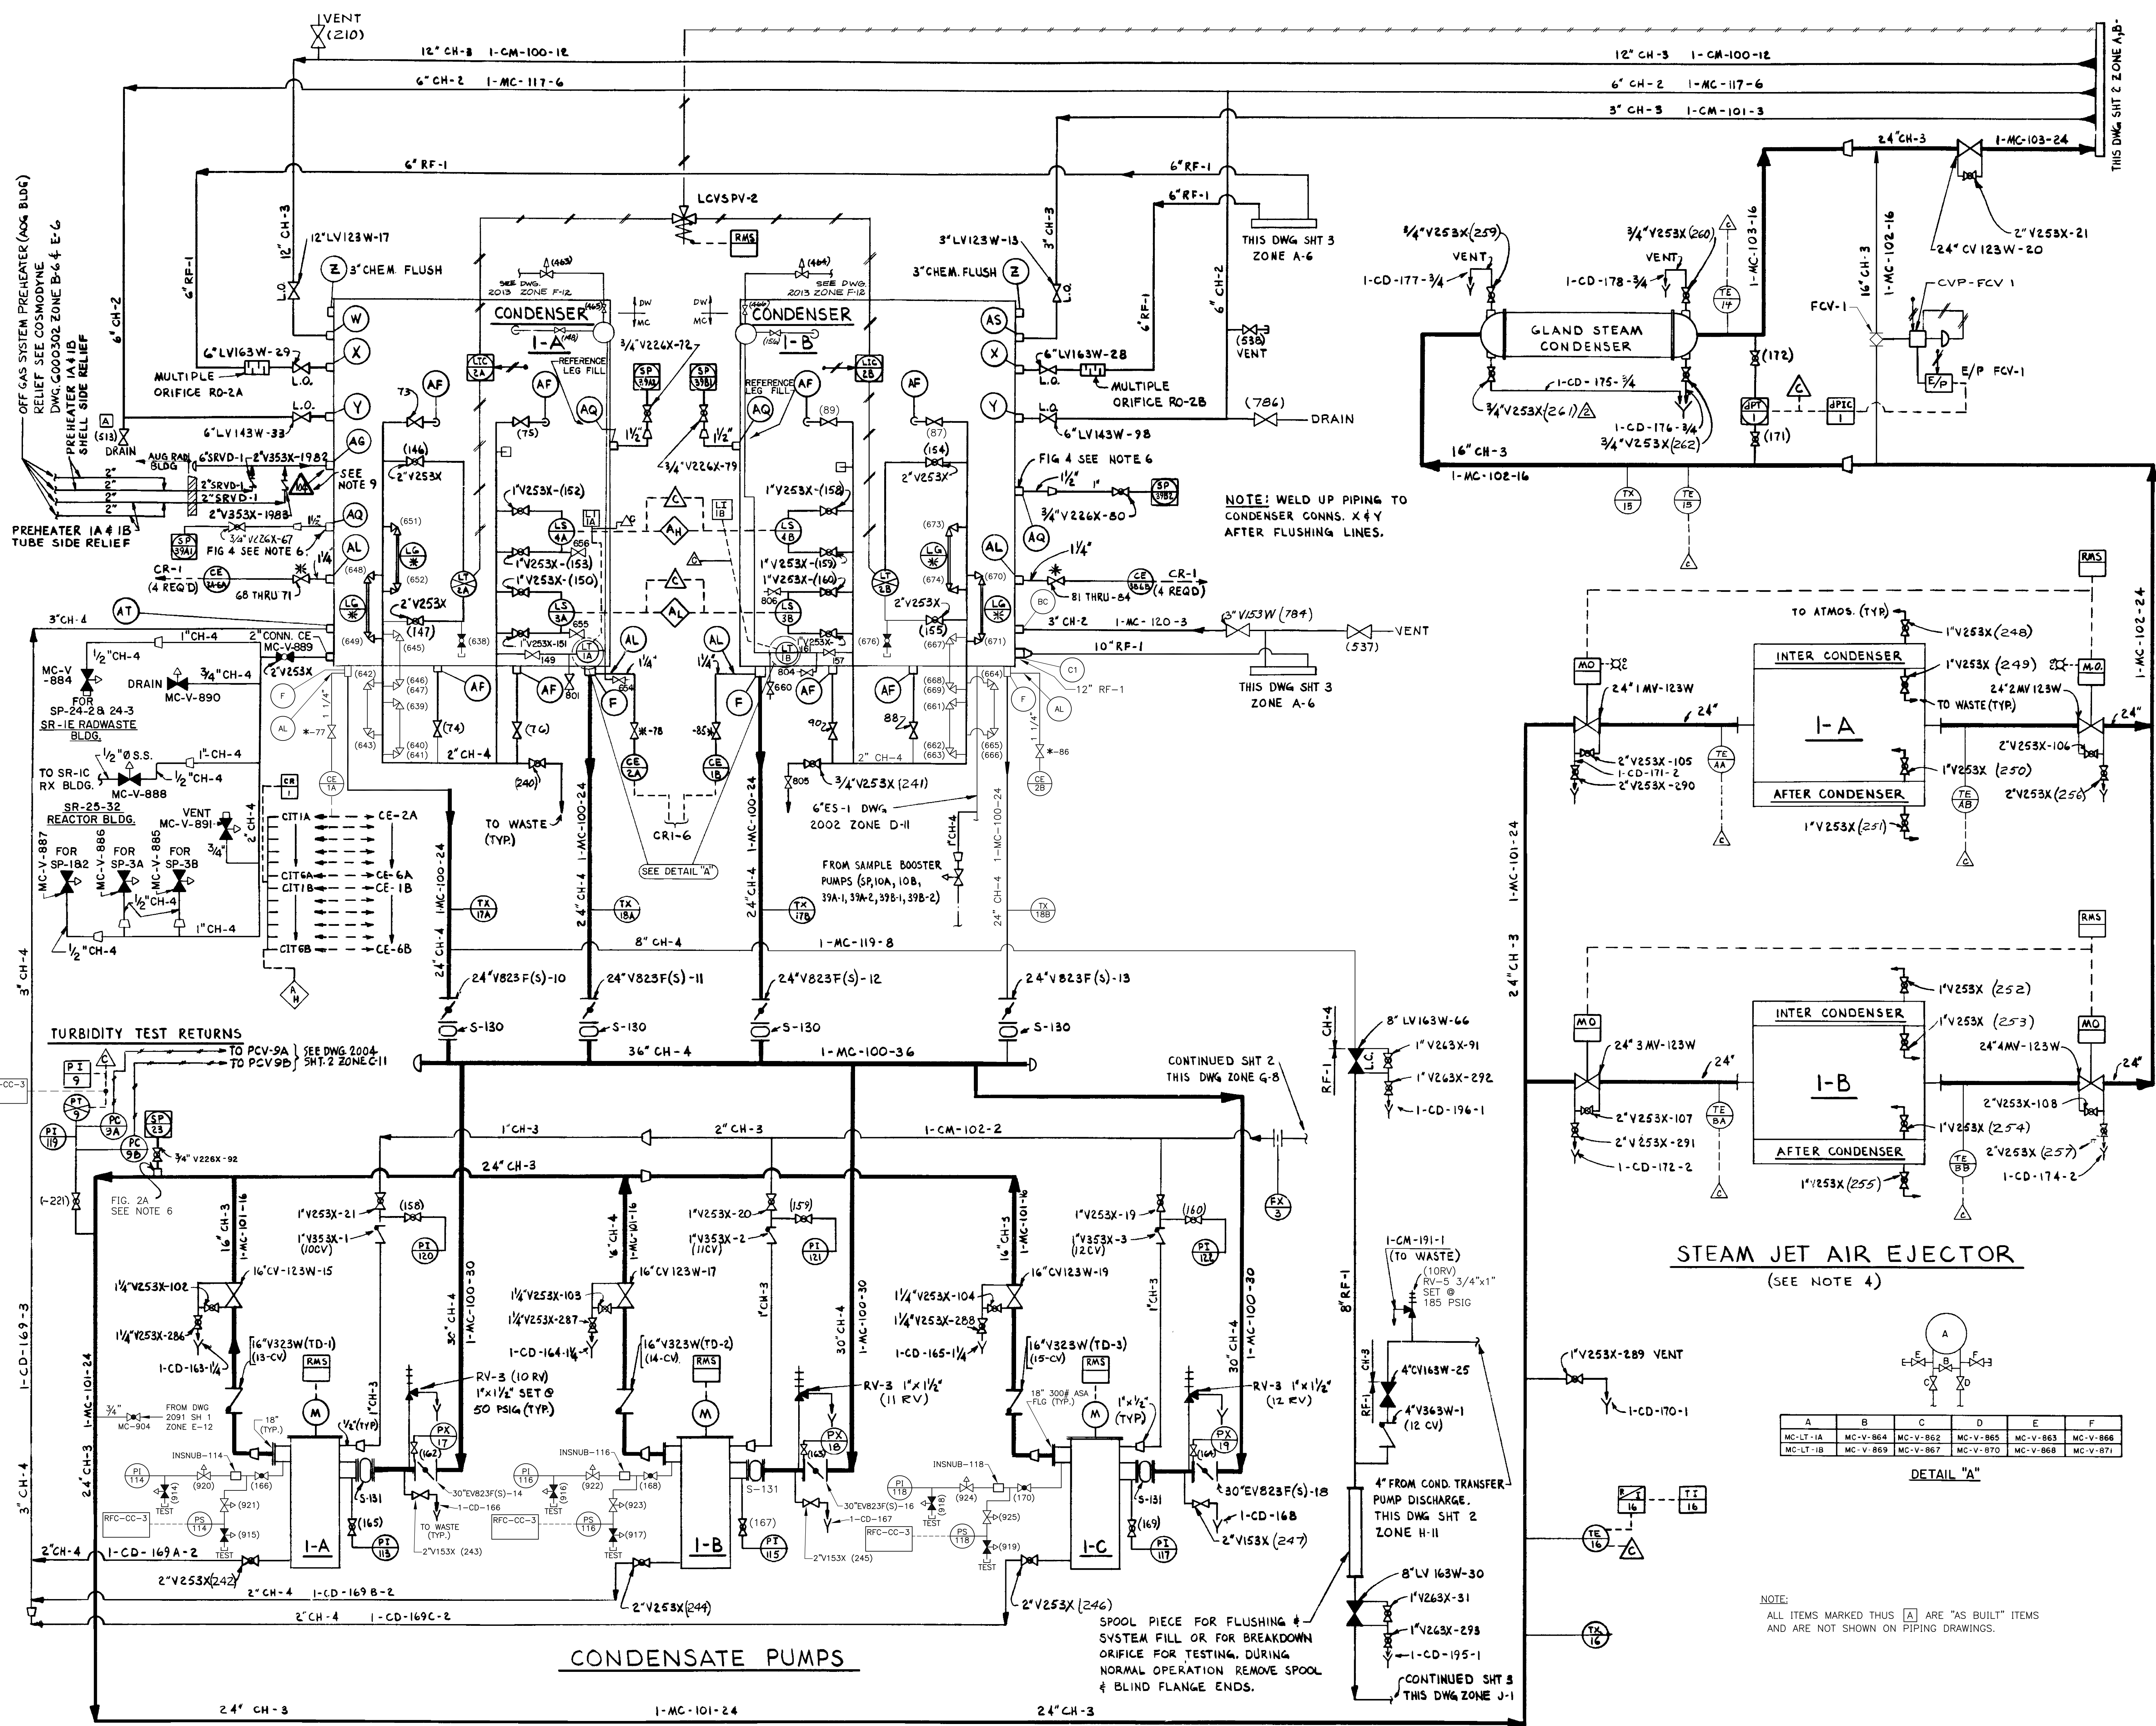

- NOTES:**
1. BYPASS VALVES SHALL BE PROVIDED FOR GLOBE & GATE VALVES AS FOLLOWS: FOR 8" & LARGER SIZES IN 300LB CLASS & HIGHER; FOR 12" & LARGER SIZES IN 150 LB CLASS.
  2. UNLESS OTHERWISE INDICATED ALL PRESSURE AND/OR FLOW INSTRUMENT ROOT LINES SHALL BE 3/4" V253X, ROOT VALVES SHALL BE 3/4" V253X, EXCEPT THAT FOR RF SYSTEM ROOT VALVES SHALL BE 3/4" V263X, LINE UP TO AND INCLUDING ROOT VALVES SHALL BE FURNISHED AND INSTALLED UNDER CONTRACT E-69-4.
  3. ALL TEMPERATURE TEST AND PROTECTING WELL PENETRATIONS SHALL BE 1/2" DIA. UNLESS OTHERWISE NOTED.
  4. FOR DETAILS ON CONDENSER CONNS. REFER TO CORRESPONDING DESIGNATIONS M S & DD CO DWG DC 93877 GA SH3.
  5. ALL VENT & DRAIN PIPING DOWNSTREAM OF THE LAST ROOT VALVE FROM THE MAIN PIPING SYSTEM OR EQUIPMENT, SHALL CONFORM TO "V-1" & "DR-5" RESPECTIVELY. STRONG BACK & OTHER INSTRUMENT PIPING ON THE CONDENSER & CONDENSATE TANK SHALL CONFORM TO "CH-4" PIPING.
  6. AT SAMPLING POINTS, CONNECTIONS, PROBES AND ROOT VALVES SHALL BE FURNISHED & INSTALLED UNDER CONTRACT E-69-4. PROBES SHALL BE FURNISHED AND INSTALLED IN ACCORDANCE WITH CONTRACT PARA 3.4.2 & DWG SP-07211 FIG. NO. AS NOTED. CONTINUATION OF SAMPLING PIPING BY E-70-3.
  7. ALL VENT AND DRAIN VALVE NUMBERS ARE CONDENSATE VALVE NUMBERS.
  8. ALL VALVE NUMBERS IN PARENTHESIS ( ) ARE NUMBERS TO BE USED IN OPERATING PROCEDURES. THESE NUMBERS ARE ASSIGNED BY NPPD AND WILL NOT BE SHOWN ON PIPING DWGS.
  9. Δ'S WHERE SHOWN WITH NUMBERS REPRESENT POINTS OF CONNECTION TO EXISTING SYSTEMS. E-79-98 SPECIFICATION DEFINES WORK FROM THIS POINT.

**STEAM JET AIR EJECTOR**  
(SEE NOTE 4)

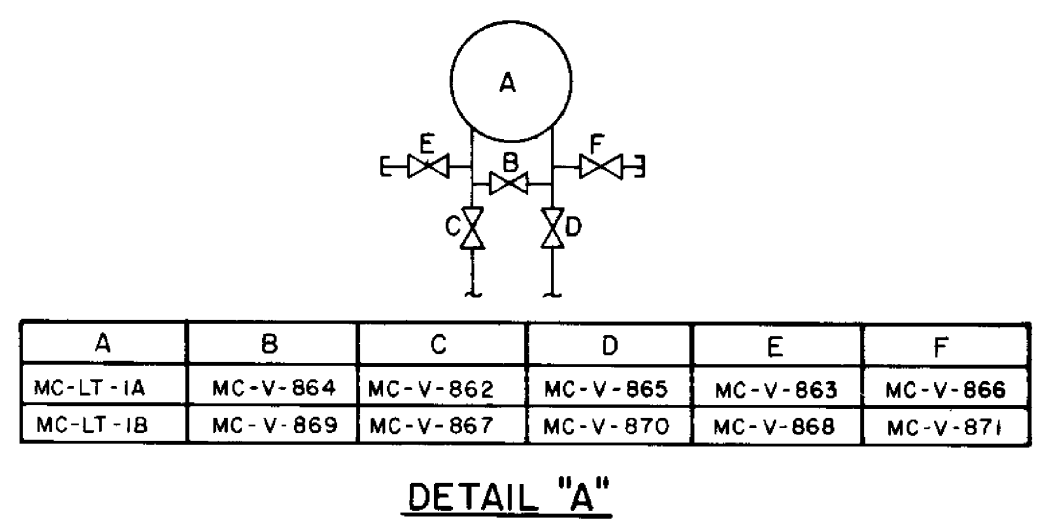

A	B	C	D	E	F
MC-V-884	MC-V-884	MC-V-882	MC-V-885	MC-V-883	MC-V-886
MC-V-887	MC-V-889	MC-V-887	MC-V-870	MC-V-868	MC-V-871

NOTE:  
ALL ITEMS MARKED THUS [A] ARE "AS BUILT" ITEMS AND ARE NOT SHOWN ON PIPING DRAWINGS.

REVISIONS TO THIS DRAWING  
REQUIRES A REVISION TO THE  
CORRESPONDING ISOKEY.

**CONDENSATE PUMPS**

SPOOL PIECE FOR FLUSHING & SYSTEM FILL OR FOR BREAKDOWN ORIFICE FOR TESTING. DURING NORMAL OPERATION REMOVE SPOOL & BLIND FLANGE ENDS.

**AS BUILT**  
454003582  
STATUS: Release  
STATUS DATE: 11/01/2016  
DS APPROVED: T2STEVE  
VER: AB REV: 36 SIZE: F

FOR PREVIOUS REVISIONS, SEE SUPERSEDED CARDS.						NO.	DESCRIPTION	DFT	DATE	ENG
VERSIONS/REVISIONS BY N.P.P.D.						AB/38	DR-2016-0575		11/17/16	T2STEVE

SIGNATURE	DATE
DJF	2/10/99

NO.	DESCRIPTION	DFT	DATE	ENG
1				

GROUP	1	2	3	4	5	6


APPROVED	DATE	FILED

NO.	DATE	DESCRIPTION
1	2/10/99	ISSUED

**FLOW DIAGRAM**  
CONDENSATE & FEED WATER  
SYSTEMS  
COOPER NUCLEAR STATION

**BURNS & ROE**  
2004 SH 1

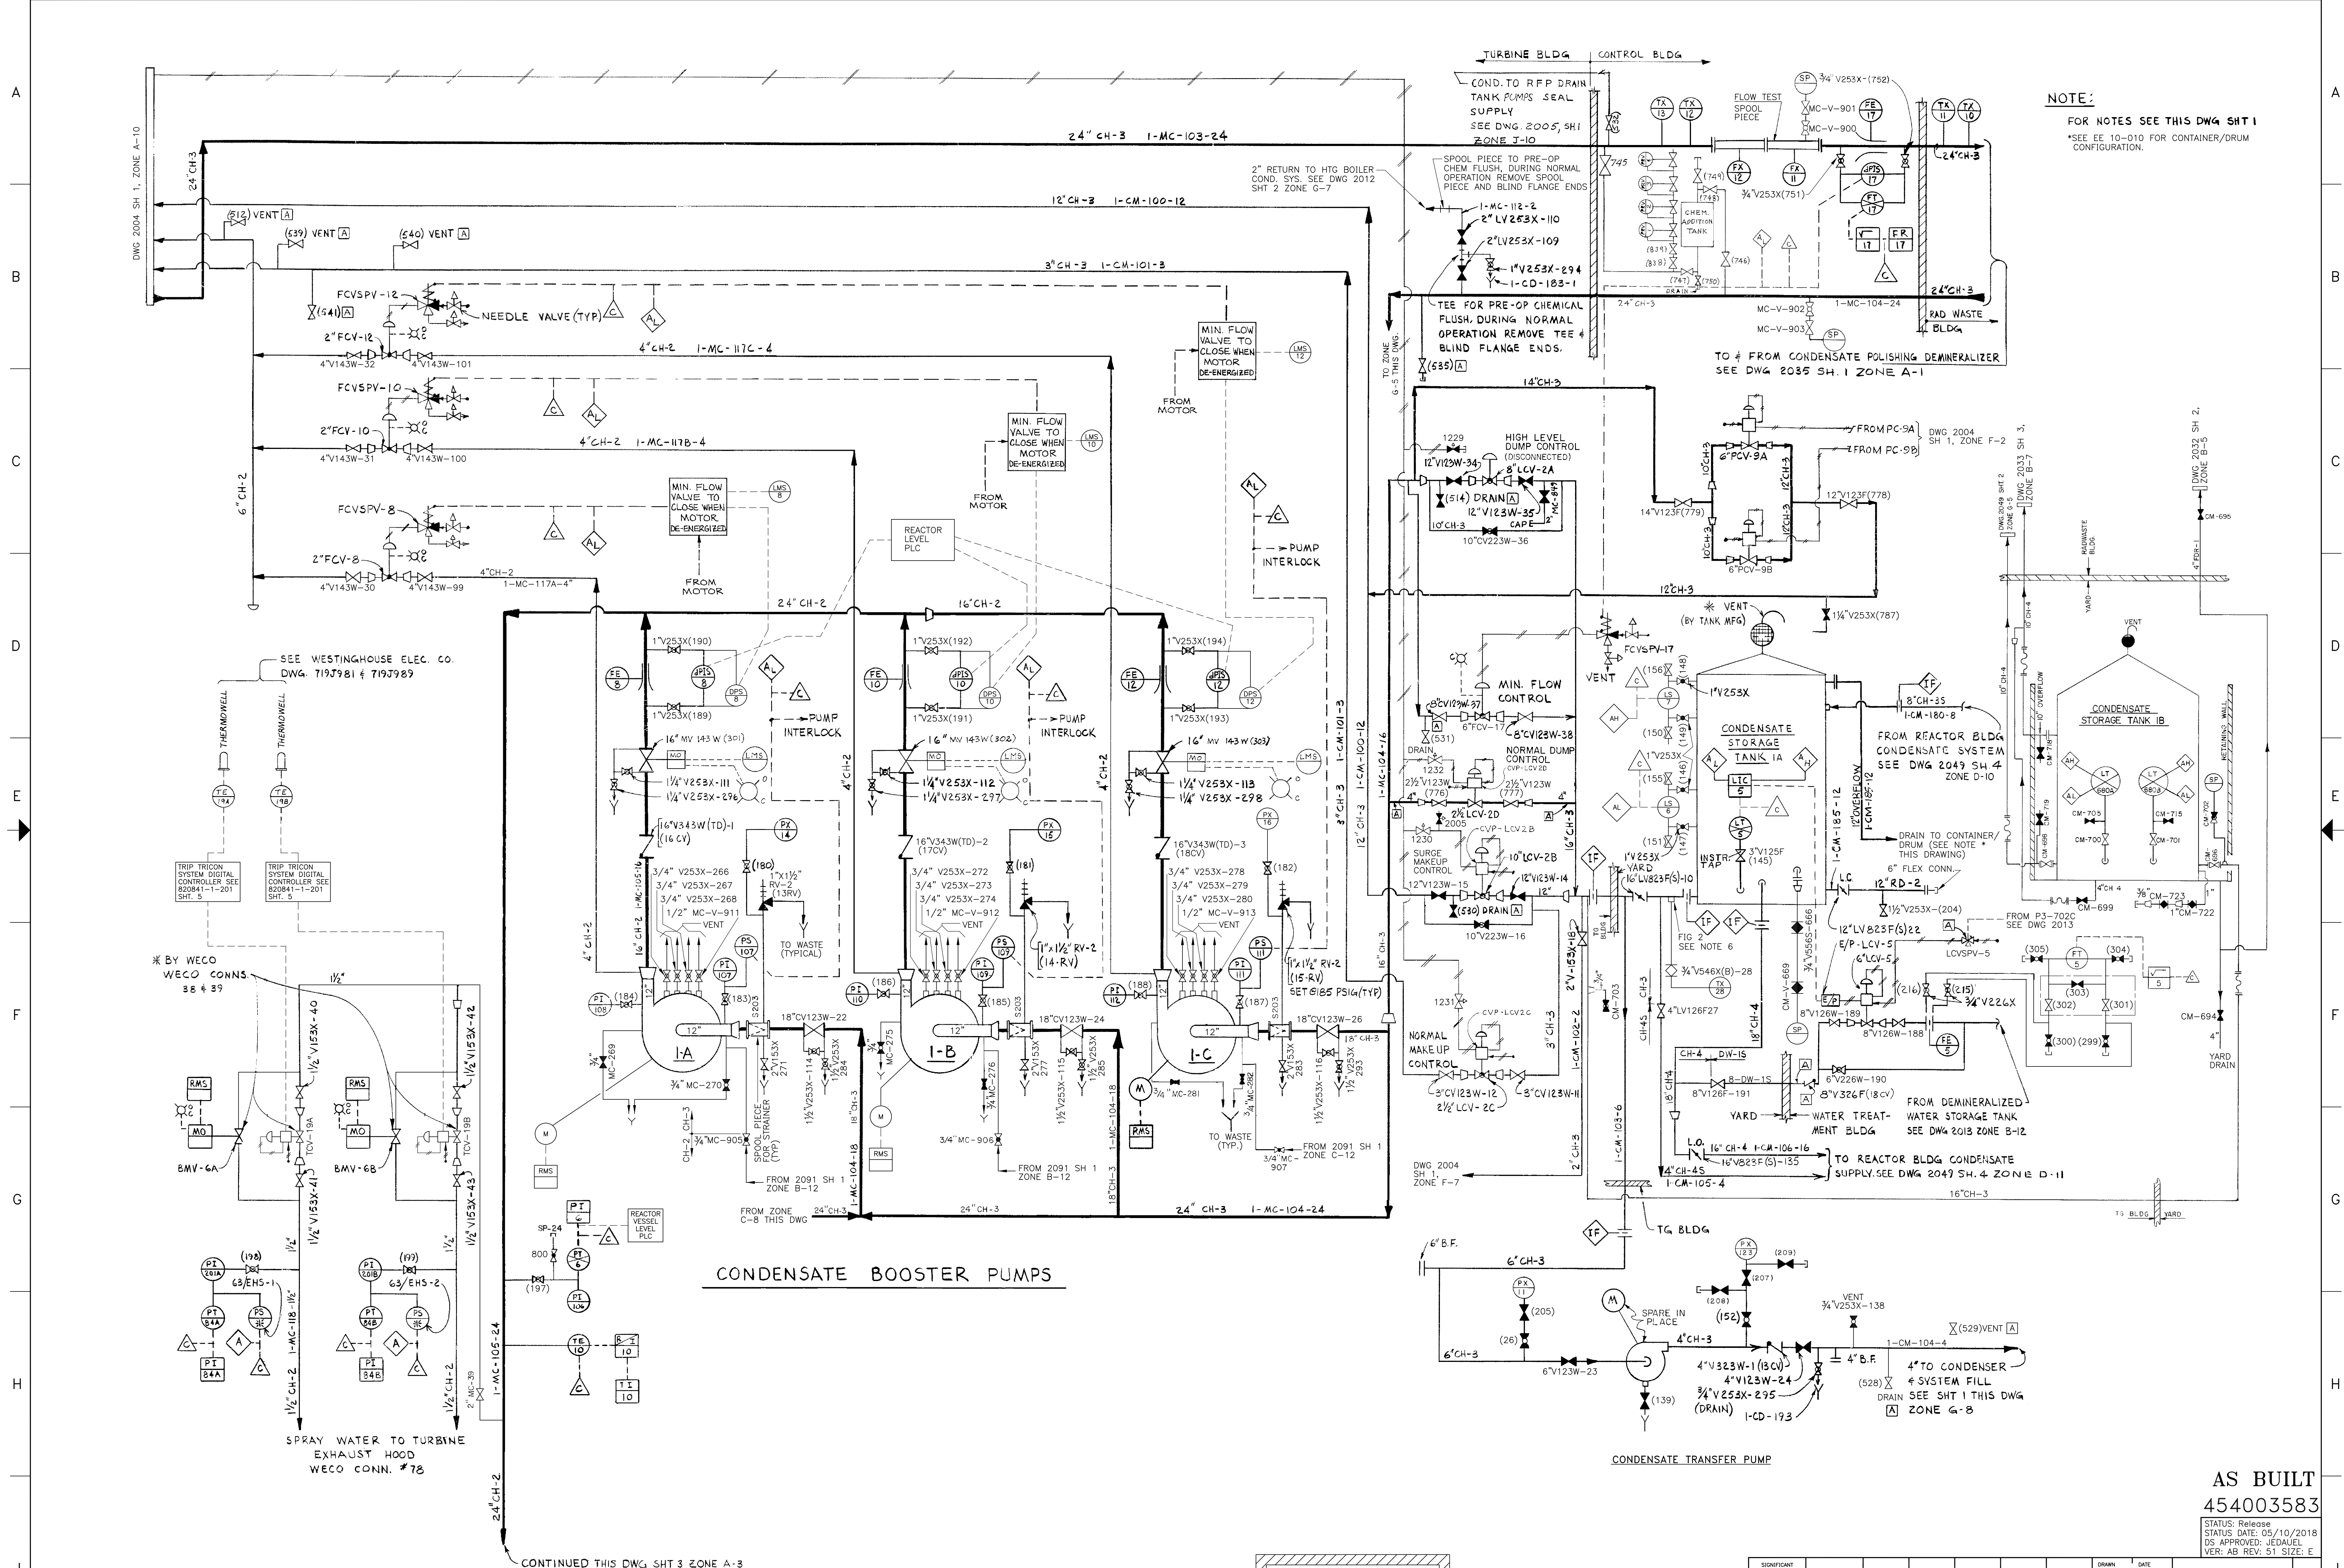

**NOTE:**  
FOR NOTES SEE THIS DWG SHT 1  
\*SEE EE 10-010 FOR CONTAINER/DRUM CONFIGURATION.

**CONDENSATE BOOSTER PUMPS**

**CONDENSATE TRANSFER PUMP**

REVISIONS TO THIS DRAWING  
REQUIRES A REVISION TO THE  
CORRESPONDING ISOKEY.

FOR PREVIOUS REVISIONS, SEE SUPERSEDED CARDS.

NO.	DESCRIPTION	DATE	ENG.
282	08-2017-0197	08/25/2017	ROCKEL

REVISION NUMBER	DATE	BY	CHKD
1	10/10/01		

COOPER NUCLEAR STATION  
FLOW DIAGRAM  
CONDENSATE &  
FEEDWATER SYSTEMS

DATE	10/10/01
DESIGNED BY	
CHECKED BY	
APPROVED BY	
DATE	
FILED	


BURNS & ROE

2004 SH 2

DATE FILED: 10/10/01

**AS BUILT**  
454003583  
STATUS: Release  
STATUS DATE: 05/10/2018  
DS APPROVED: JEDAUDEL  
VER: AB REV: 51 SIZE: E

CONTINUED THIS DWG. SHT 3 ZONE A-3

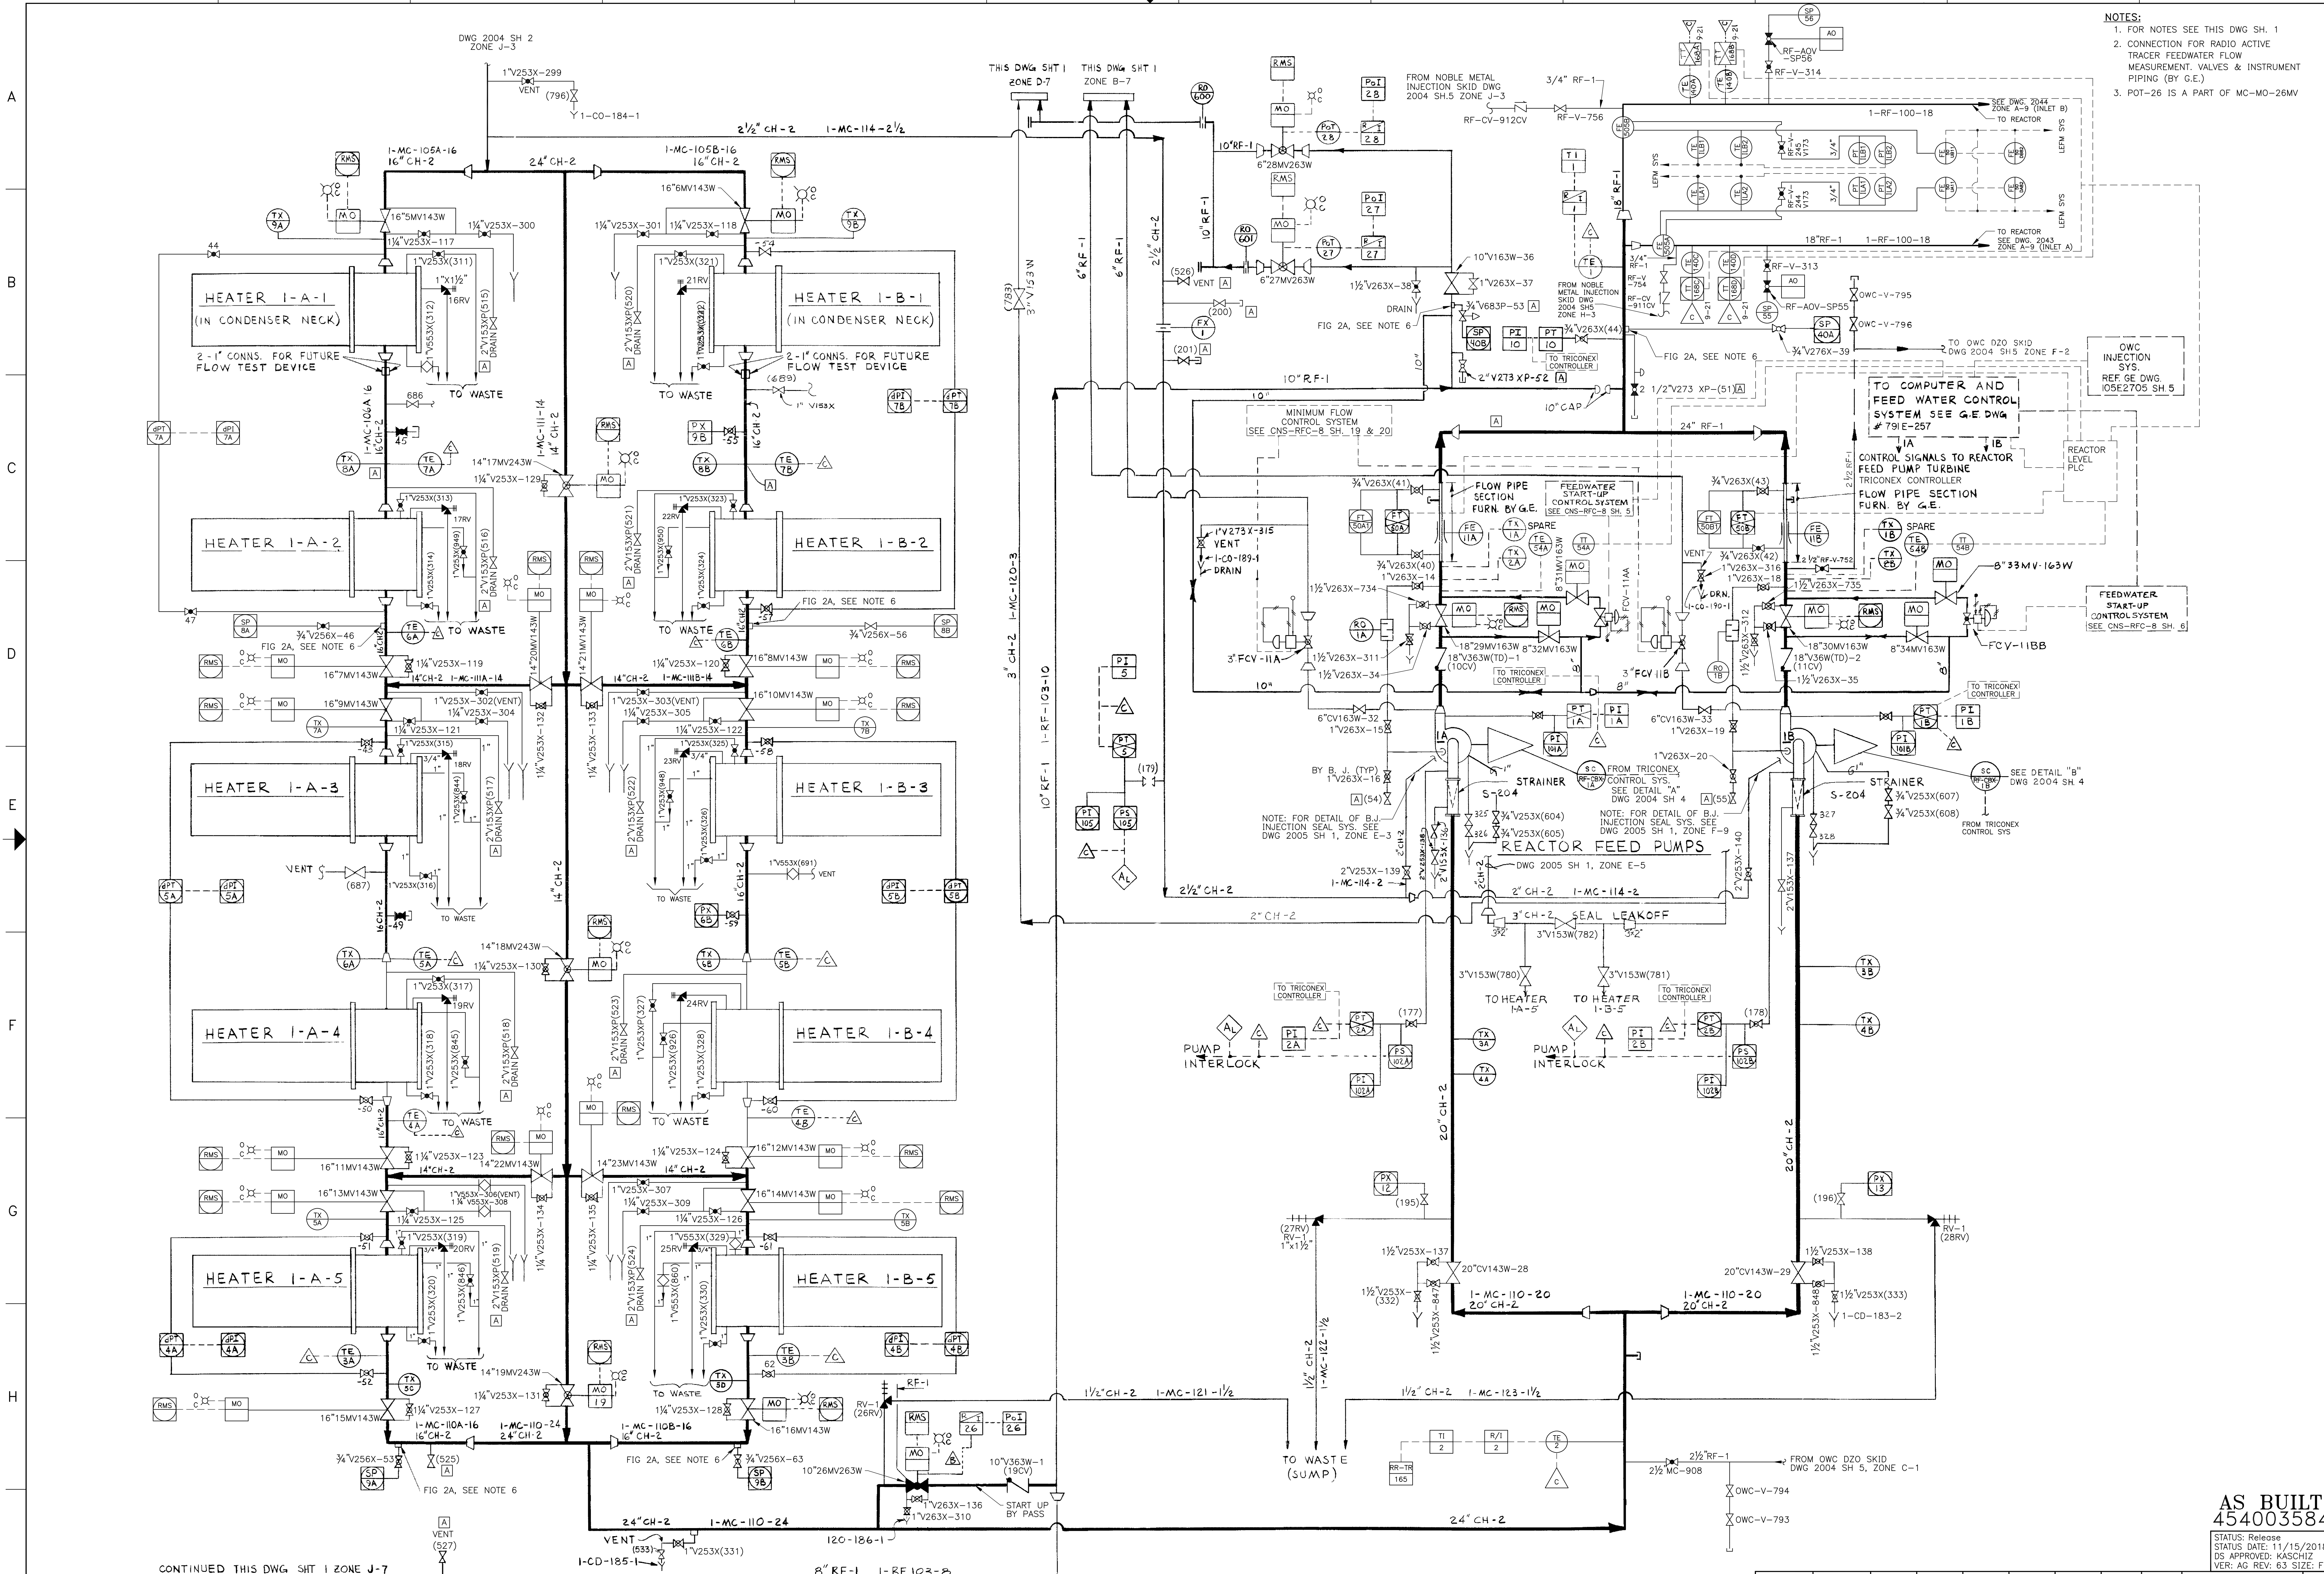

- NOTES:**
- FOR NOTES SEE THIS DWG. SH. 1
  - CONNECTION FOR RADIO ACTIVE TRACER FEEDWATER FLOW MEASUREMENT VALVES & INSTRUMENT PIPING (BY G.E.)
  - POT-26 IS A PART OF MC-MO-26MV

REVISIONS TO THIS DRAWING REQUIRES A REVISION TO THE CORRESPONDING ISOKEY.

FOR PREVIOUS REVISIONS, SEE SUPERSEDED CARDS.


VERSIONS/REVISIONS BY N.P.P.D.			
NO.	DESCRIPTION	DFT	DATE
AB/28DR-2015-0555		DJB	1/27/15
AC/29DR-2016-0539		RAM	10/17/16
AD/30DR-2018-0252		DJB	1/15/18
AE/31DR-2018-0230		DJB	1/15/18
AF/32DR-2018-0231		DJB	1/15/18
AG/33DR-2018-0253		DJB	1/15/18

SIGNIFICANT NUMBER		DATE	
1	2	10/15/01	
GROUP		DATE	
1	2		
COOPER NUCLEAR STATION		BURNS & ROE	
FLOW DIAGRAM		APPROVED	
CONDENSATE & FEEDWATER SYSTEMS		DATE	
		FILED	
		2004 SH 3	

**AS BUILT**  
454003584

STATUS: Release  
STATUS DATE: 11/15/2018  
DS APPROVED: KASCHIZ  
VER: AG REV: 63 SIZE: F

CONTINUED THIS DWG. SHT 1 ZONE J-7

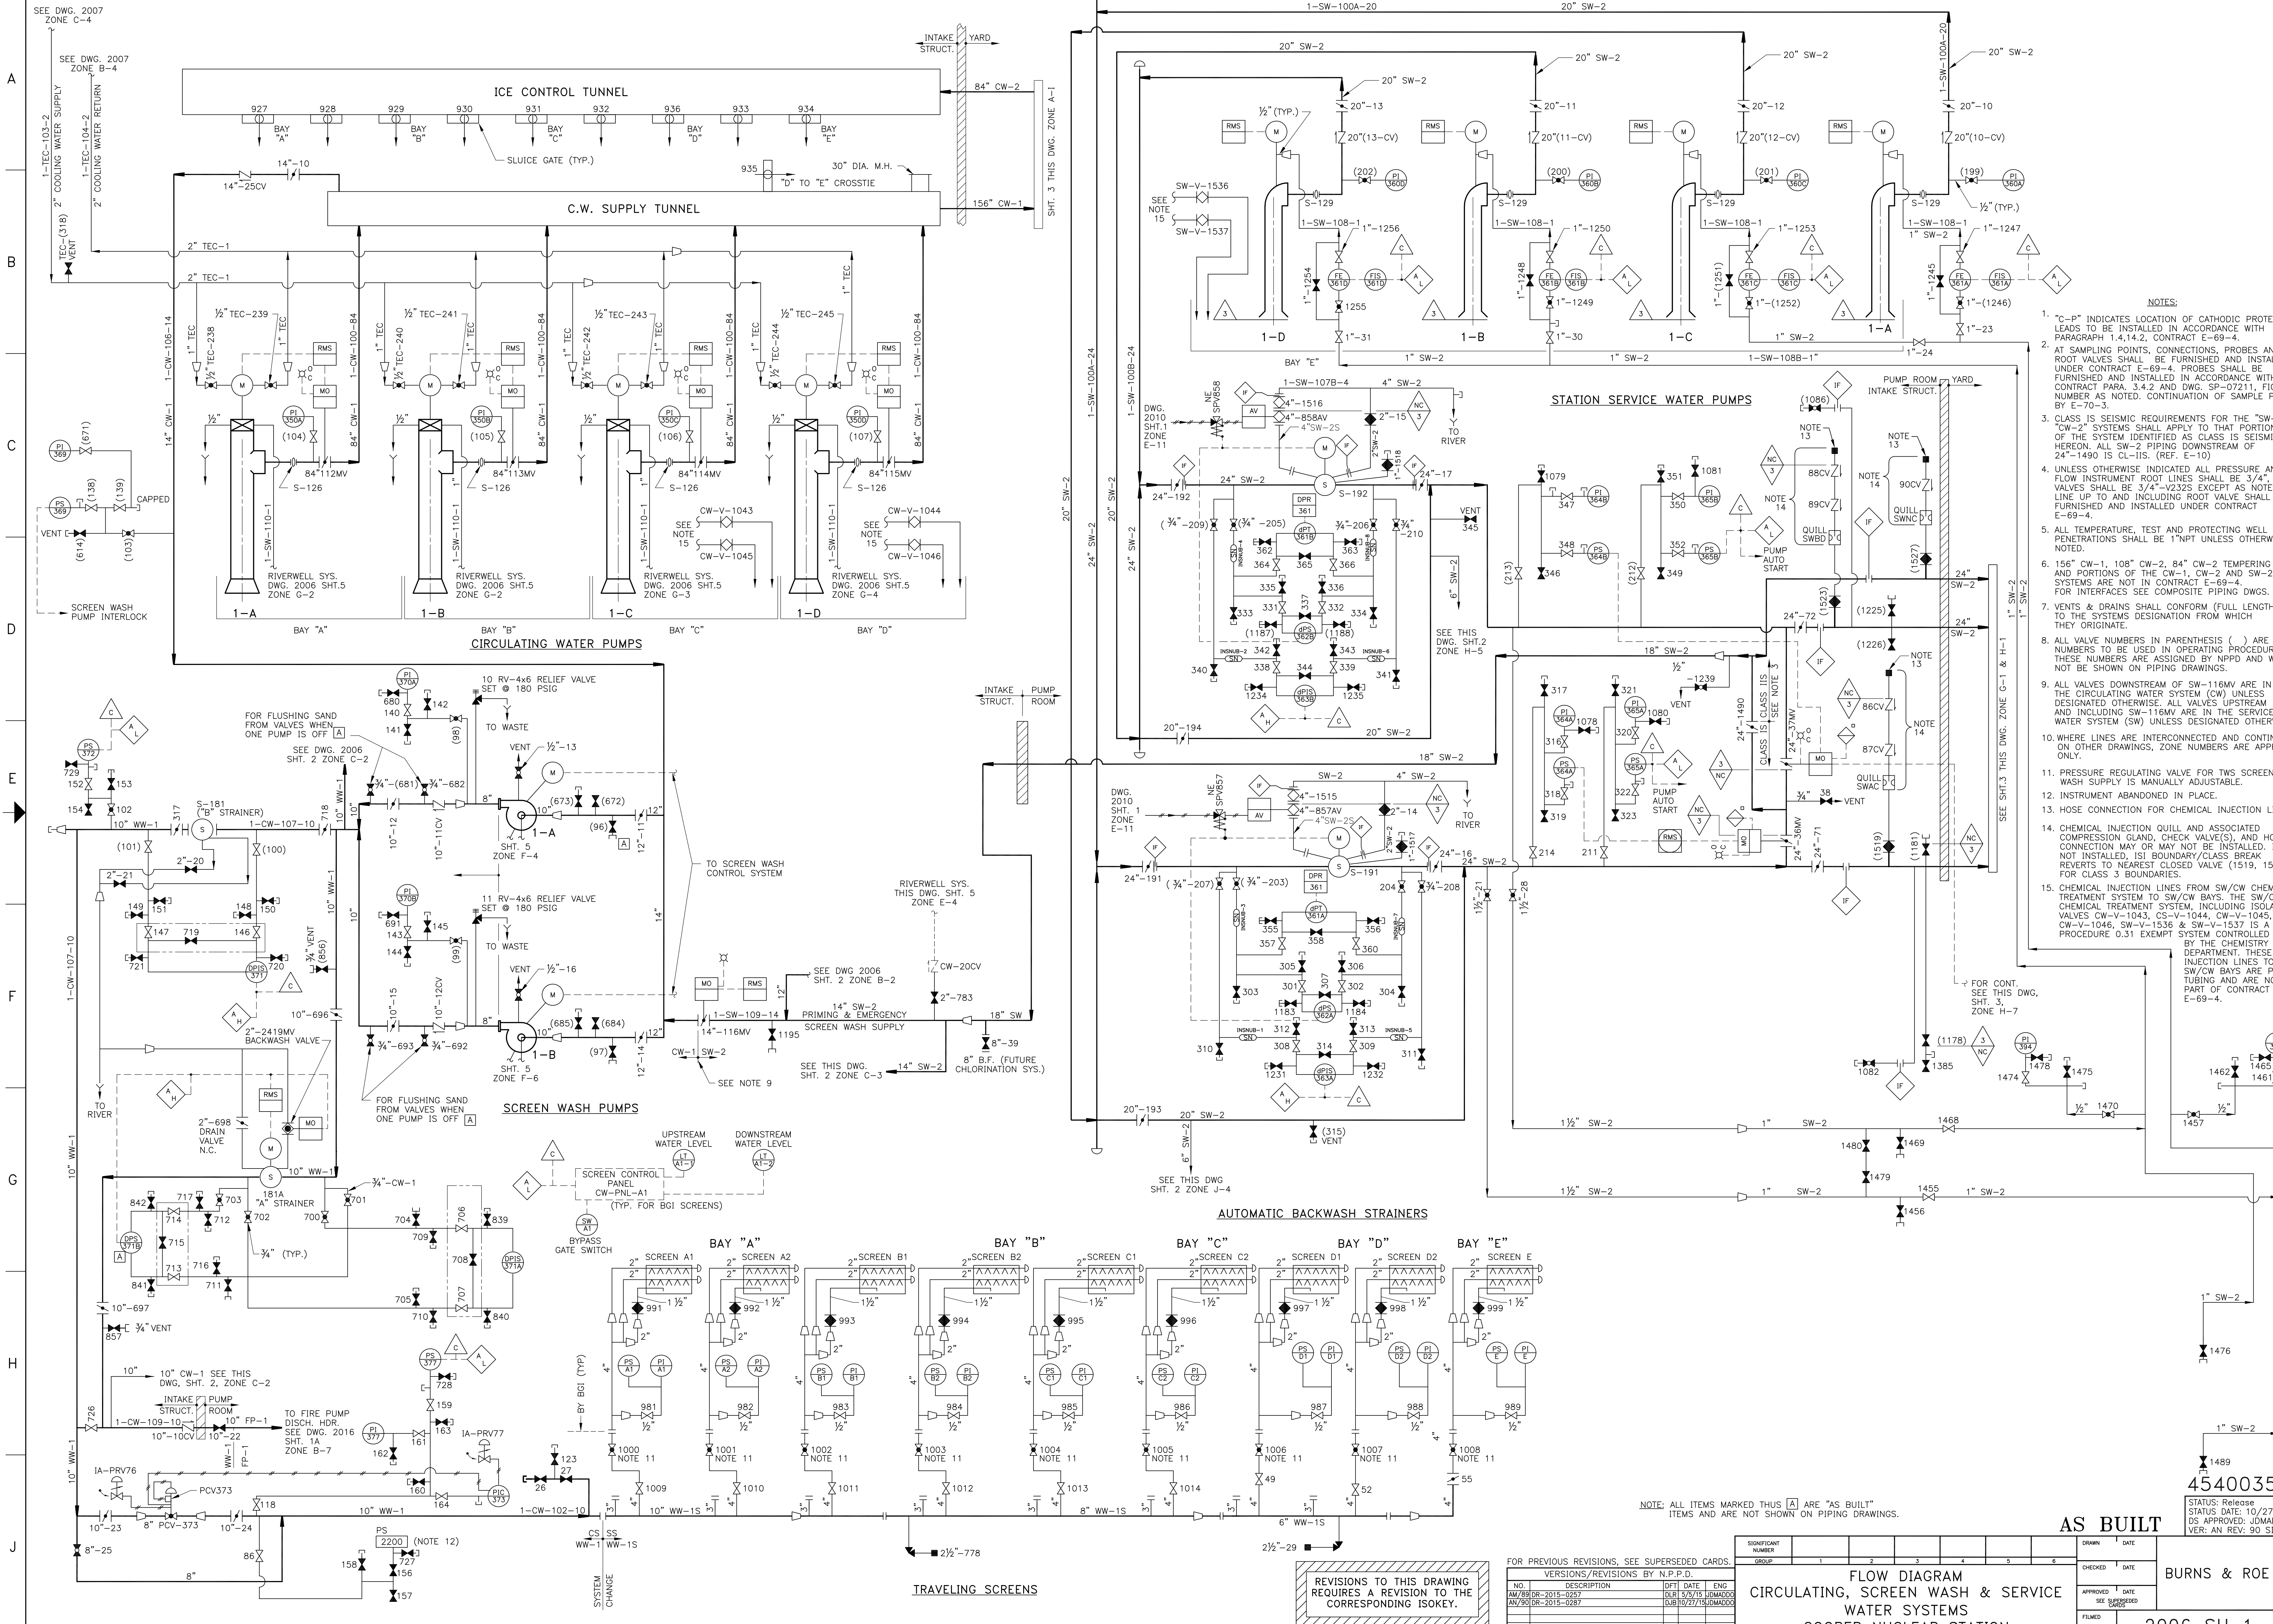

- NOTES:**
- "C-P" INDICATES LOCATION OF CATHODIC PROTECTION LEADS TO BE INSTALLED IN ACCORDANCE WITH PARAGRAPH 1.4.14.2, CONTRACT E-69-4.
  - AT SAMPLING POINTS, CONNECTIONS, PROBES AND ROOT VALVES SHALL BE FURNISHED AND INSTALLED UNDER CONTRACT E-69-4. PROBES SHALL BE FURNISHED AND INSTALLED IN ACCORDANCE WITH CONTRACT PARA. 3.4.2 AND DWG. SP-07211, FIG. NUMBER AS NOTED. CONTINUATION OF SAMPLE PIPING BY E-70-3.
  - CLASS IS SEISMIC REQUIREMENTS FOR THE "SW-2" & "CW-2" SYSTEMS SHALL APPLY TO THAT PORTION OF THE SYSTEM IDENTIFIED AS CLASS IS SEISMIC HEREON. ALL SW-2 PIPING DOWNSTREAM OF 24"-1490 IS CL-IIS. (REF. E-10)
  - UNLESS OTHERWISE INDICATED ALL PRESSURE AND/OR FLOW INSTRUMENT ROOT LINES SHALL BE 3/4" ROOT VALVES SHALL BE 3/4"-V2325 EXCEPT AS NOTED. LINE UP TO AND INCLUDING ROOT VALVE SHALL BE FURNISHED AND INSTALLED UNDER CONTRACT E-69-4.
  - ALL TEMPERATURE, TEST AND PROTECTING WELL PENETRATIONS SHALL BE 1"NPT UNLESS OTHERWISE NOTED.
  - 156" CW-1, 108" CW-2, 84" CW-2 TEMPERING LINE AND PORTIONS OF THE CW-1, CW-2 AND SW-2 SYSTEMS ARE NOT IN CONTRACT E-69-4. FOR INTERFACES SEE COMPOSITE PIPING DWGS.
  - VENTS & DRAINS SHALL CONFORM (FULL LENGTH) TO THE SYSTEMS DESIGNATION FROM WHICH THEY ORIGINATE.
  - ALL VALVE NUMBERS IN PARENTHESIS ( ) ARE NUMBERS TO BE USED IN OPERATING PROCEDURES. THESE NUMBERS ARE ASSIGNED BY NPFD AND WILL NOT BE SHOWN ON PIPING DRAWINGS.
  - ALL VALVES DOWNSTREAM OF SW-116W ARE IN THE CIRCULATING WATER SYSTEM (CW) UNLESS DESIGNATED OTHERWISE. ALL VALVES UPSTREAM AND INCLUDING SW-116W ARE IN THE SERVICE WATER SYSTEM (SW) UNLESS DESIGNATED OTHERWISE.
  - WHERE LINES ARE INTERCONNECTED AND CONTINUED ON OTHER DRAWINGS, ZONE NUMBERS ARE APPROX. ONLY.
  - PRESSURE REGULATING VALVE FOR TWS SCREEN WASH SUPPLY IS MANUALLY ADJUSTABLE.
  - INSTRUMENT ABANDONED IN PLACE.
  - HOSE CONNECTION FOR CHEMICAL INJECTION LINE.
  - CHEMICAL INJECTION QUILL AND ASSOCIATED COMPRESSION GLAND, CHECK VALVE(S), AND HOSE CONNECTION MAY OR MAY NOT BE INSTALLED. IF NOT INSTALLED, ISI BOUNDARY/CLASS BREAK REVERTS TO NEAREST CLOSED VALVE (1519, 1523) FOR CLASS 3 BOUNDARIES.
  - CHEMICAL INJECTION LINES FROM SW/CW CHEMICAL TREATMENT SYSTEM TO SW/CW BAYS, THE SW/CW CHEMICAL TREATMENT SYSTEM, INCLUDING ISOLATION VALVES CW-V-1043, CS-V-1044, CW-V-1045, CW-V-1046, SW-V-1536 & SW-V-1537 IS A PROCEDURE 0.31 EXEMPT SYSTEM CONTROLLED BY THE CHEMISTRY DEPARTMENT. THESE INJECTION LINES TO THE SW/CW BAYS ARE PLASTIC TUBING AND ARE NOT PART OF CONTRACT E-69-4.

REVISIONS TO THIS DRAWING REQUIRES A REVISION TO THE CORRESPONDING ISOKEY.

FOR PREVIOUS REVISIONS, SEE SUPERSEDED CARDS.

VERSIONS/REVISIONS BY N.P.P.D.			
NO.	DESCRIPTION	DFTI	DATE
1	AS BUILT	DR	10/27/2015
2	AS BUILT	DR	10/27/2015

SIGNIFICANT NUMBER	GROUP	DRAWN DATE						CHECKED DATE	APPROVED DATE	FILED	STATUS
		1	2	3	4	5	6				
454003586											AS BUILT

**FLOW DIAGRAM  
CIRCULATING, SCREEN WASH & SERVICE  
WATER SYSTEMS  
COOPER NUCLEAR STATION**

2006 SH 1


BURNS & ROE

NOTE: ALL ITEMS MARKED THIS [A] ARE "AS BUILT" ITEMS AND ARE NOT SHOWN ON PIPING DRAWINGS.

- NOTES:**
1. IN BAYS "A" THRU "D" JETS J-2 AND J-4 ARE MANUALLY OPERATED ONLY. J-2 AND J-4 JETS SHALL NORMALLY BE STANDBY.
  2. J-4A JETS IN "E" BAY ARE REDUNDANT. ONE IS NORMALLY IN SERVICE, THE OTHER IS STANDBY.
  3. J-4B JETS IN "E" BAY ARE REDUNDANT SUCH THAT ONE REMOVABLE JET IS NORMALLY IN SERVICE, THE OTHER REMOVABLE JET IS STANDBY. THE PERMANENT J-4B JET IS LAST DITCH BACK UP IN THE EVENT THAT BOTH REMOVABLE JETS ARE NOT OPERABLE AND SHALL NORMALLY BE IN STANDBY.
  4. J-3 SPARGER JETS ARE LOCATED AT THE BOOT SECTIONS OF THE TRAVELING WATER SCREENS (REF BGI DWG D-J04-258-103).
  5. ALL WW-1 INSTRUMENT PIPING AND ROOT VALVES (EXCEPT FX ITEMS) TO BE 3/4" SIZE V-232S.
  6. ALL WW-1S PIPING INSTALLED IN THE TRAVELING WATER SCREENS SHALL CONFORM TO BRACKETT GREEN USA INC. SPECIFICATIONS.

7. ALL 2" SIZE AND SMALLER GLOBE VALVES IN WW-1, SW-1, CA-1, CW-1 TO BE V-232S TYPE VALVES, EXCEPT FOR TRAVELING WATER SCREENS.
8. CONNECTIONS ARE PROVIDED FOR POSSIBLE FUTURE VACUUM PRIMING SYSTEM.
9. DELETED  
RELOCATED BY DISTRICT TO ANY AVAILABLE (PX) CONNECTION  
AFTER PLANT IS IN OPERATION. EACH (PI) SHALL BE INSTALLED WITH A UNION.
10. ALL BUTTERFLY VALVES, EXCEPT THOSE COVERED BY NOTES 11, 12 & 16 ARE DUCTILE IRON ASTM A-395 WITH LUG TYPE BODY.
11. VALVES ARE CAST IRON WITH LUG TYPE ENDS.
12. VALVES ARE SPAN TYPE, CAST STEEL, CLASS IS RATED.

13. ALL VALVES NUMBERS SHOWN IN PARENTHESIS ( ) ARE NUMBERS TO BE USED IN OPERATING PROCEDURES. THESE NUMBERS ARE ASSIGNED BY NPPD AND WILL NOT BE SHOWN ON PIPING DRAWINGS.
14. FOR THE BRACKETT GREEN USA INC. TRAVELING SCREEN INSTALLATION, THE FOLLOWING IS APPLICABLE: SCREEN WASH SPARGER SOLENOID VALVE LOGIC OPERATION WILL ALLOW SPARGING WITH THE J-3 JETS WITH THE CORRESPONDING TRAVELING WATER SCREEN RUNNING OR OFF. THE SCREEN CAN RUN WITH THE JETS OFF.
15. WHERE LINES ARE INTERCONNECTED AND CONTINUED ON OTHER DRAWINGS, ZONE NUMBERS ARE APPROXIMATE ONLY.
16. SPARGER JET J-3 ISOLATION VALVES AOV-10AV, AOV-11AV, AOV-12AV, AOV-13AV, AOV-14AV, AOV-15AV, AOV-16AV, AOV-18AV AND AOV-17AV ARE A351 STEEL CASTING.

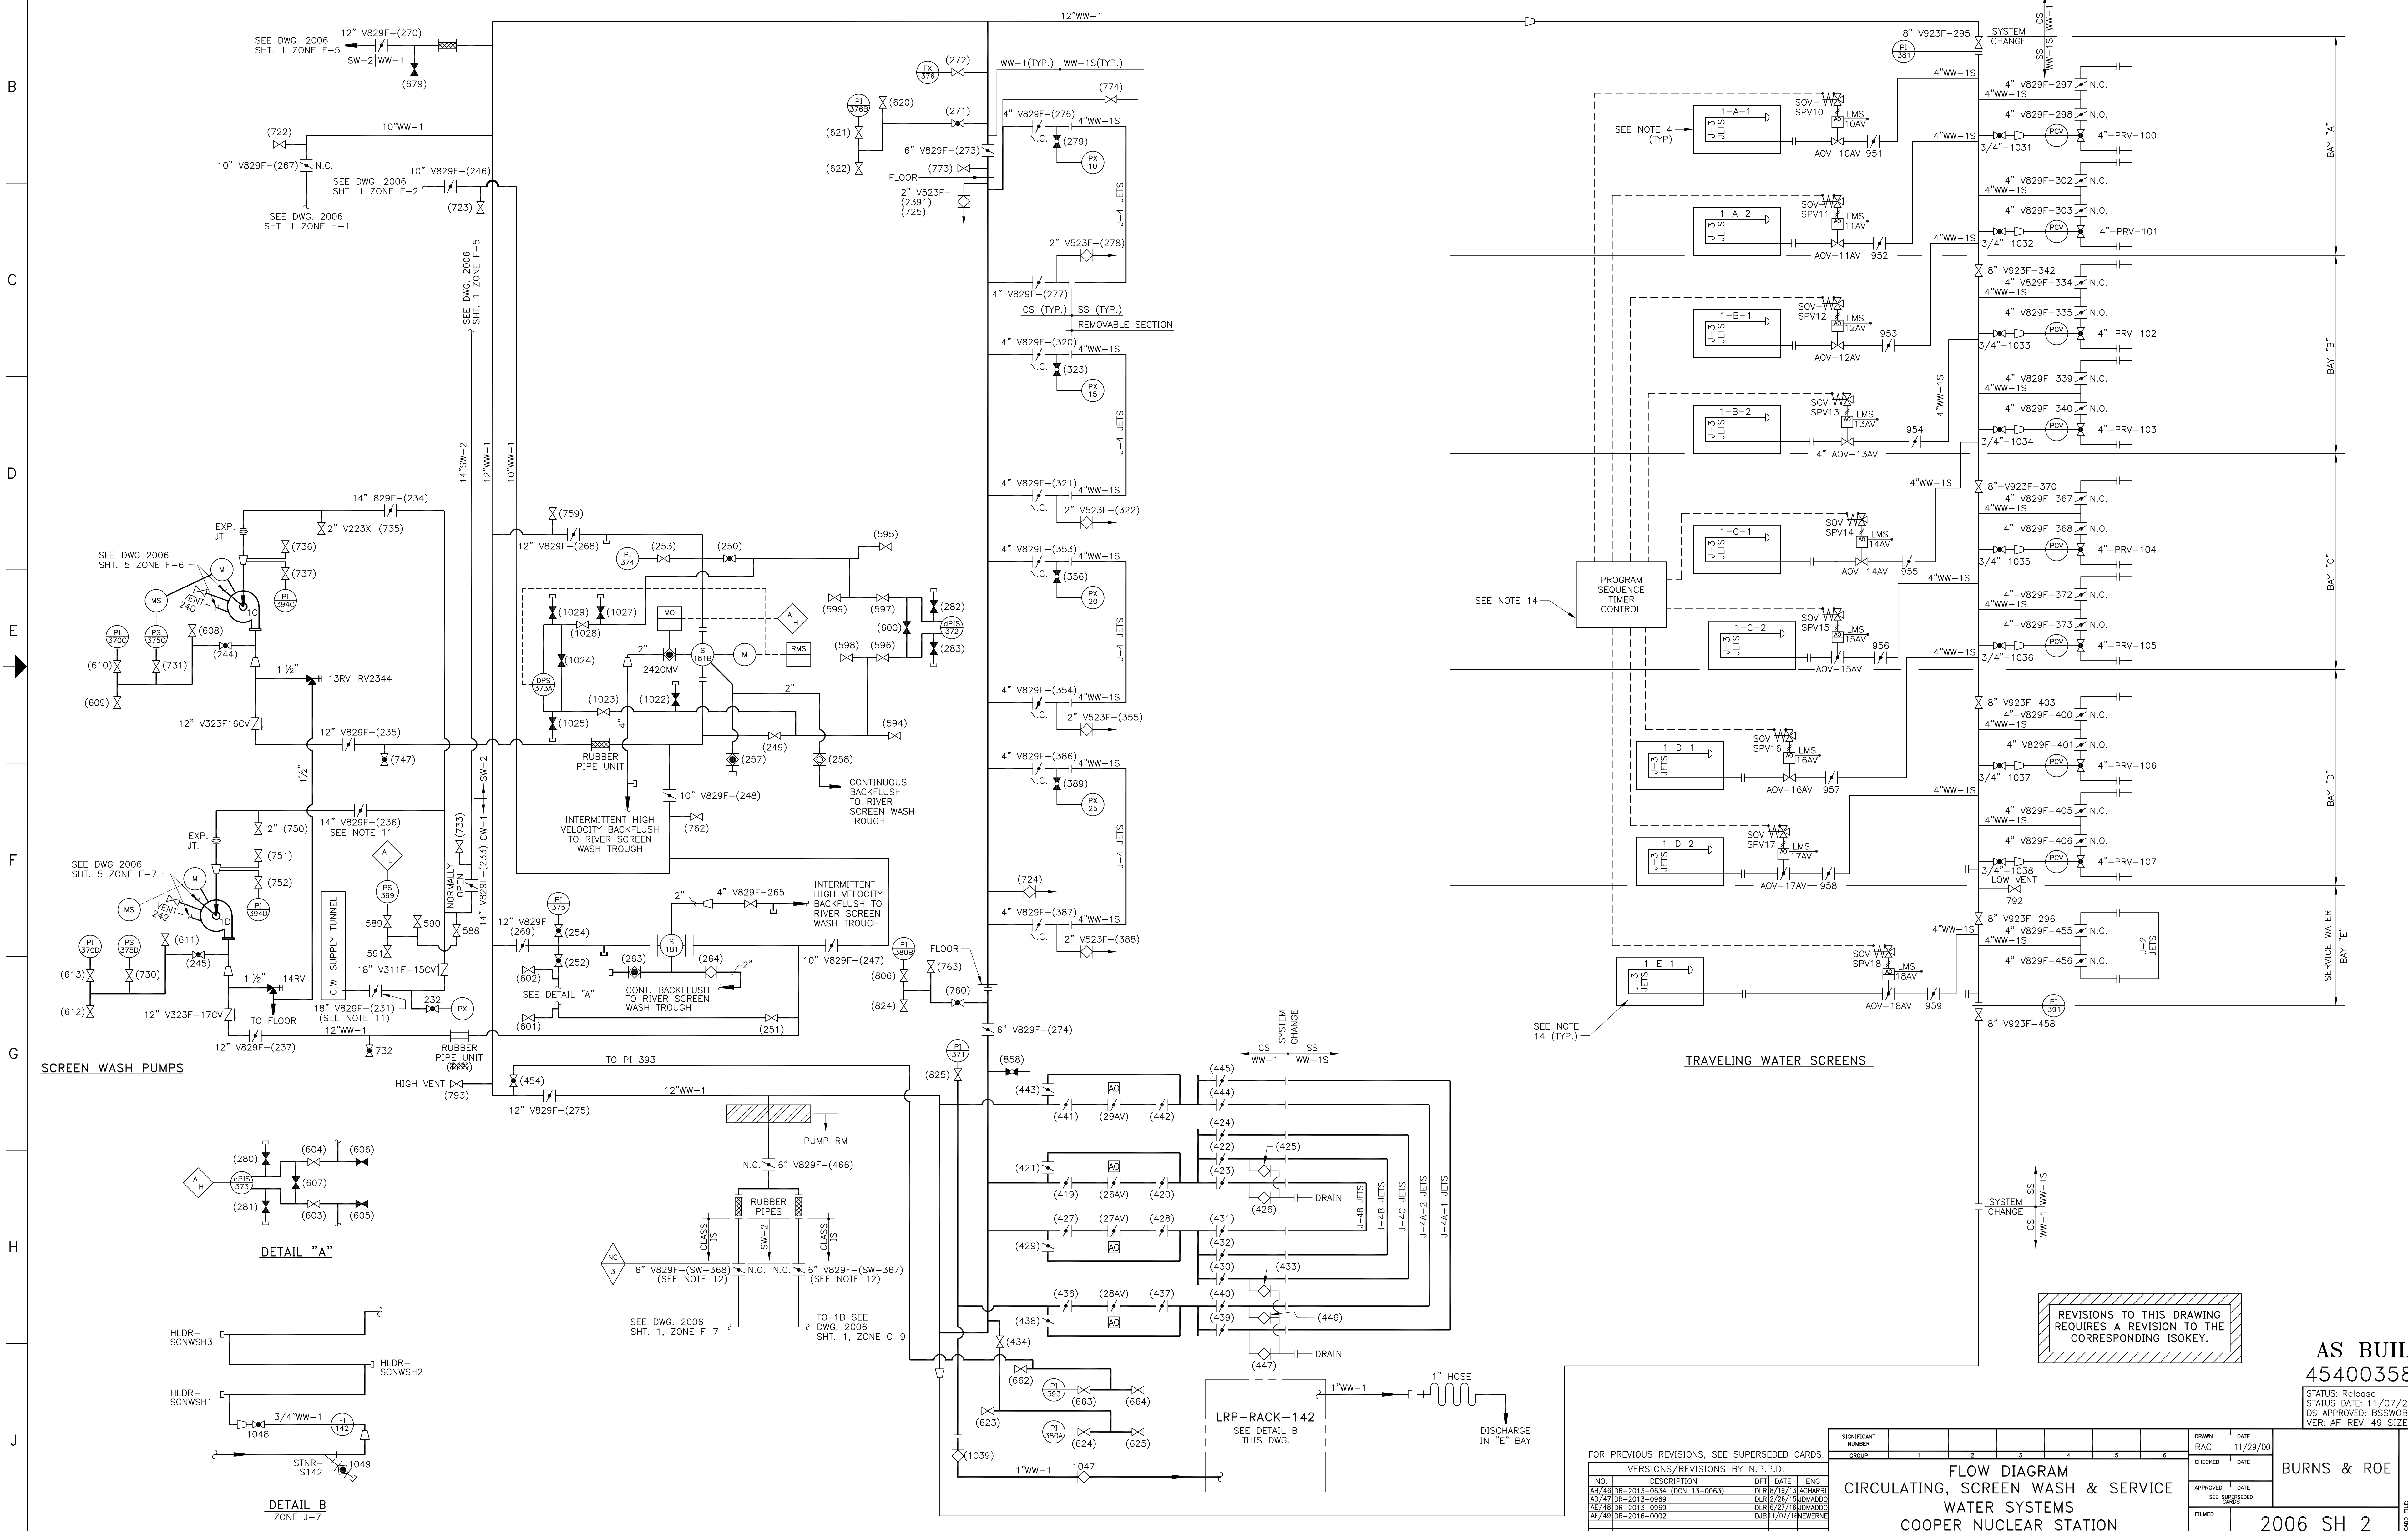

FOR PREVIOUS REVISIONS, SEE SUPERSEDED CARDS.

NO.	DESCRIPTION	DFT	DATE	ENG
AB/748	DR-2013-0634 (DCN 13-0063)		08/18/13	ACHARRI
BA/710	DR-2013-0969		08/22/13	BLUMMACK
AL/481	DR-2013-0969		08/22/13	BLUMMACK
AF/491	DR-2016-0002		08/17/16	TRINER

SIGNIFICANT NUMBER	GROUP						DRAWN RAC	DATE 11/29/00	CHECKED	DATE	APPROVED	DATE	SEE SUPERSEDED	FILMED	BURNS & ROE
	1	2	3	4	5	6									
<b>FLOW DIAGRAM</b> <b>CIRCULATING, SCREEN WASH &amp; SERVICE</b> <b>WATER SYSTEMS</b> <b>COOPER NUCLEAR STATION</b>															
<b>2006 SH 2</b>												<b>AS BUILT</b> <b>454003587</b> <small>STATUS: Release          STATUS DATE: 11/07/2016          DS APPROVED: BSSWOBO          VER: AF REV: 49 SIZE: F</small>			


REVISIONS TO THIS DRAWING  
REQUIRES A REVISION TO THE  
CORRESPONDING ISOKEY.

LRP-RACK-142  
SEE DETAIL B  
THIS DWG.

**DETAIL "A"**

**DETAIL B**  
ZONE J-7

DWG NO. C0017989

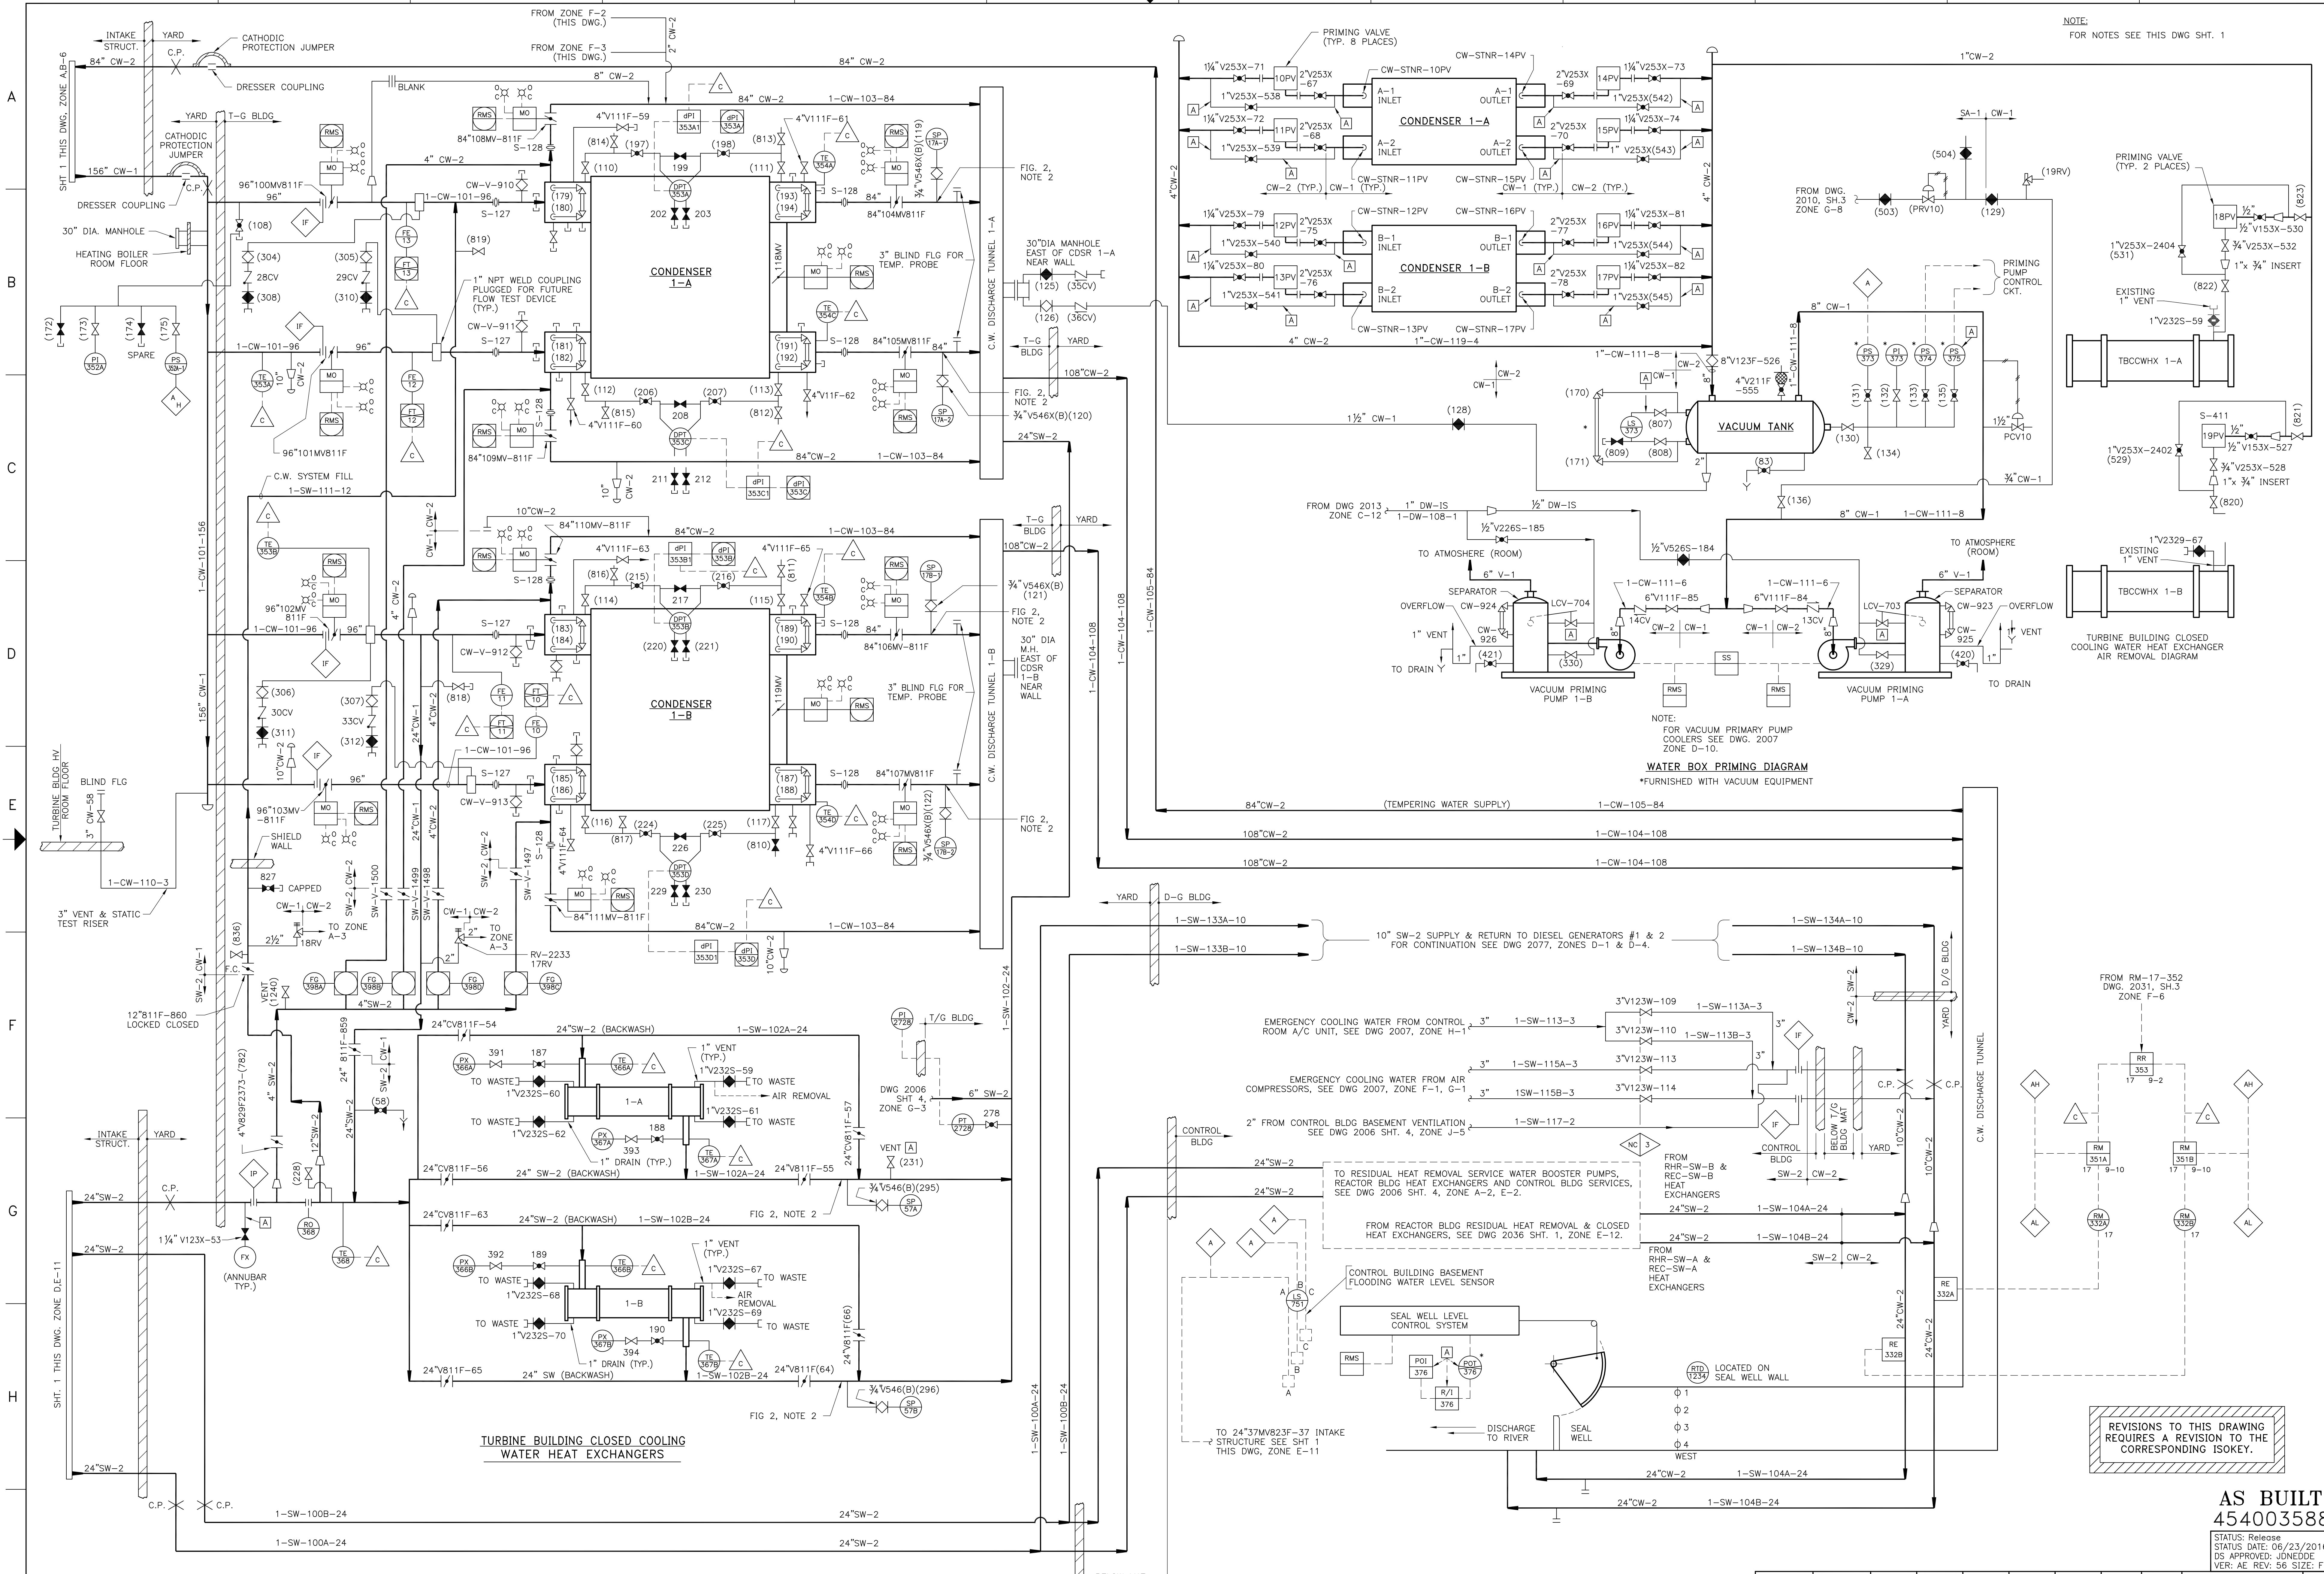

NOTE:  
FOR NOTES SEE THIS DWG. SHT. 1

NOTE:  
FOR VACUUM PRIMARY PUMP COOLERS SEE DWG. 2007 ZONE D-10.  
**WATER BOX PRIMING DIAGRAM**  
\*FURNISHED WITH VACUUM EQUIPMENT

REVISIONS TO THIS DRAWING  
REQUIRES A REVISION TO THE  
CORRESPONDING ISOKEY.

**AS BUILT**  
454003588

STATUS: Release  
STATUS DATE: 06/23/2016  
DS APPROVED: JDNEDDE  
VER: AE REV: 56 SIZE: F

FOR PREVIOUS REVISIONS, SEE SUPERSSEDED CARDS.

VERSIONS/REVISIONS BY N.P.P.D.			
NO.	DESCRIPTION	DFT DATE	ENG
AD/24/DR-2014-0486	10CN 12-0917	06/16/77	kkukker
DP/25/DR-2014-0486	10CN 12-0889	06/10/79	kkukker
AL/24/DR-2015-0002		03/26/25	jjjedede

SIGNIFICANT NUMBER	GROUP	1	2	3	4	5	6
RAC							
CHECKED							
DATE							
APPROVED							
DATE							
FILED							


**FLOW DIAGRAM  
CIRCULATING, SCREEN WASH & SERVICE  
WATER SYSTEMS  
COOPER NUCLEAR STATION**

**BURNS & ROE**

2006 SH 3


NO. 0017290



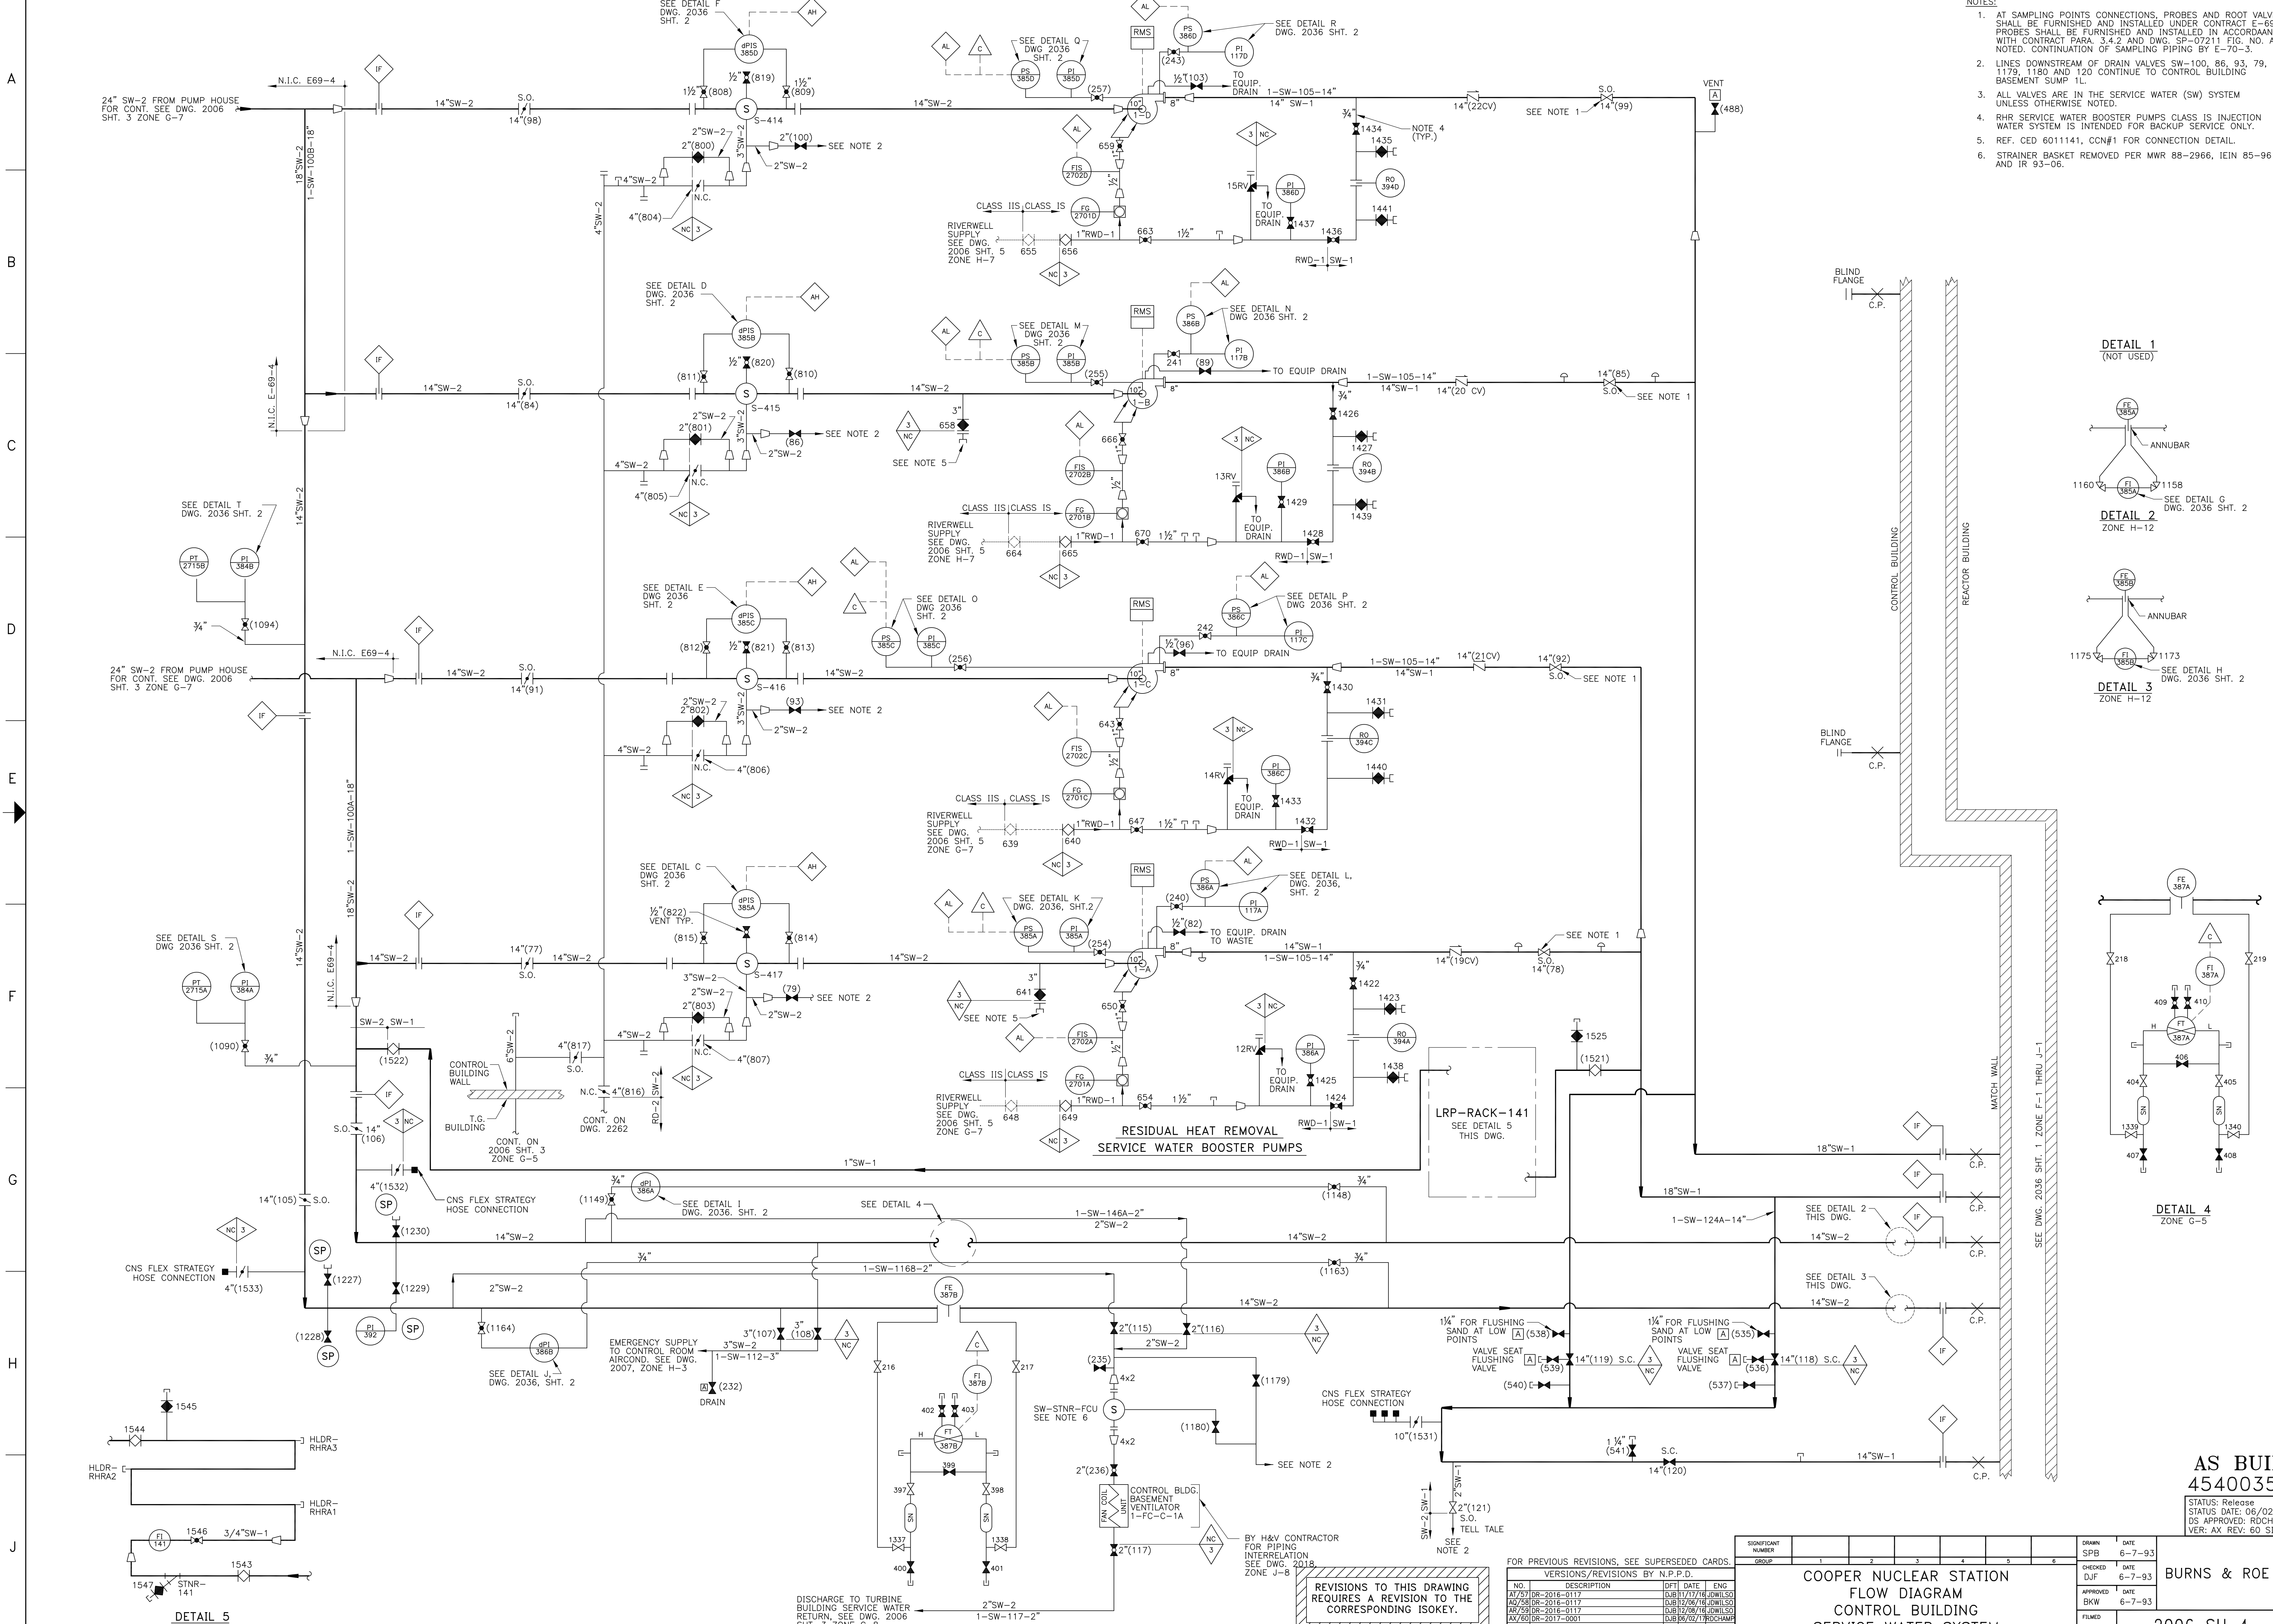


- NOTES:
1. AT SAMPLING POINTS CONNECTIONS, PROBES AND ROOT VALVES SHALL BE FURNISHED AND INSTALLED UNDER CONTRACT E-69-4. PROBES SHALL BE FURNISHED AND INSTALLED IN ACCORDANCE WITH CONTRACT PARA. 3.4.2 AND DWG. SP-07211 FIG. NO. AS NOTED. CONTINUATION OF SAMPLING PIPING BY E-70-3.
  2. LINES DOWNSTREAM OF DRAIN VALVES SW-100, 86, 93, 79, 1179, 1180 AND 120 CONTINUE TO CONTROL BUILDING BASEMENT SUMP 1L.
  3. ALL VALVES ARE IN THE SERVICE WATER (SW) SYSTEM UNLESS OTHERWISE NOTED.
  4. RHR SERVICE WATER BOOSTER PUMPS CLASS IS INJECTION WATER SYSTEM IS INTENDED FOR BACKUP SERVICE ONLY.
  5. REF. CED 601141, CEN#1 FOR CONNECTION DETAIL.
  6. STRAINER BASKET REMOVED PER MWR 88-2966, IEN 85-96 AND IR 93-06.




DETAIL 1 (NOT USED)

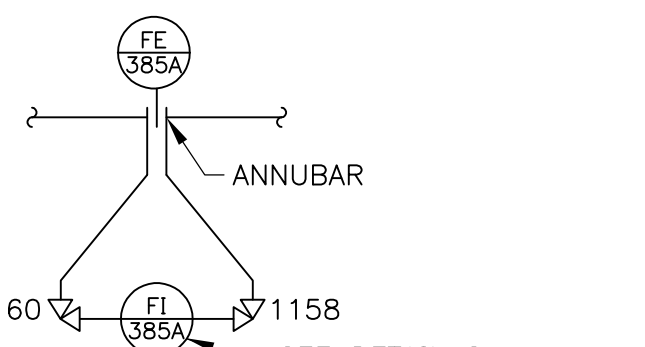


DETAIL 2 ZONE H-12

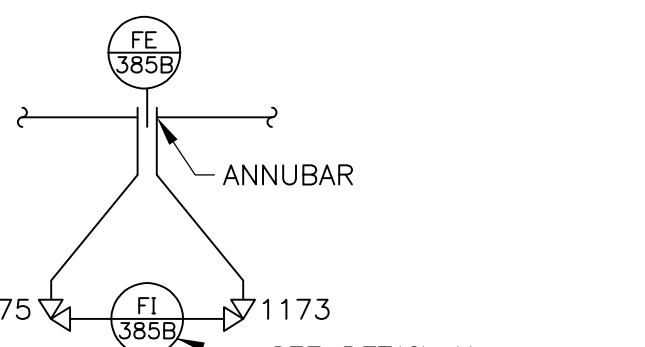

DETAIL 3 ZONE H-12

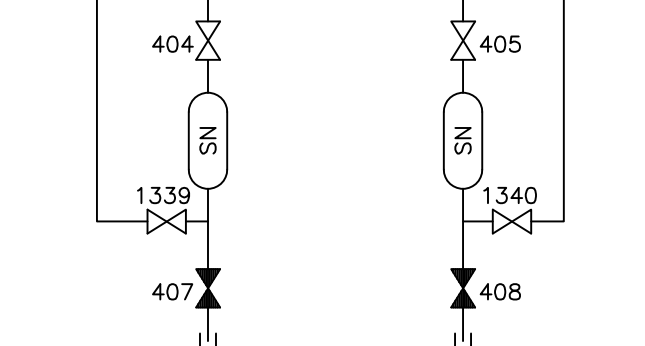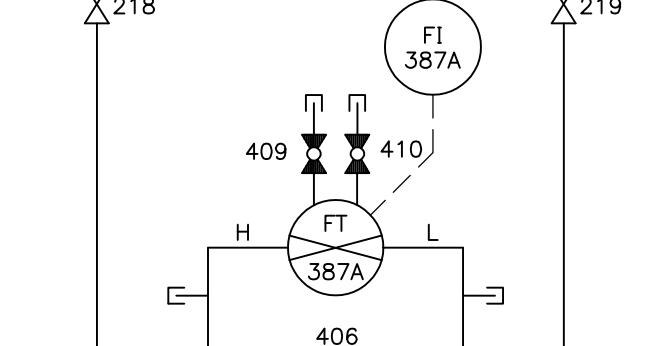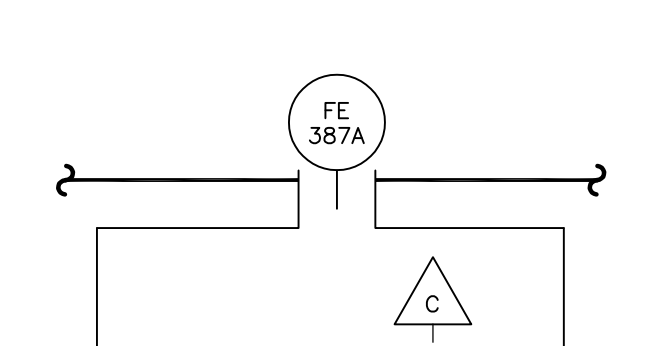

DETAIL 4 ZONE G-5

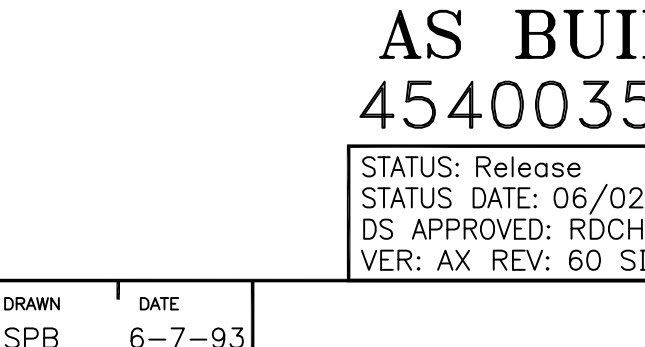

DETAIL 4 ZONE G-5

AS BUILT  
454003589

STATUS: Release  
STATUS DATE: 06/02/2017  
DS APPROVED: RDCHAMP  
VER: AX REV: 60 SIZE: F

REVISIONS TO THIS DRAWING  
REQUIRES A REVISION TO THE  
CORRESPONDING ISOKEY.

FOR PREVIOUS REVISIONS, SEE SUPERSEDED CARDS.


NO.	DESCRIPTION	DFT	DATE	ENG
01/27/08	DR-2016-0117		01/27/08	JWILSON
02/28/08	DR-2016-0117		02/28/08	JWILSON
04/29/08	DR-2016-0117		04/29/08	JWILSON
06/20/08	DR-2017-0001		06/20/08	RDCHAMP

SIGNIFICANT NUMBER	GROUP						DRAWN	DATE	APPROVED
	1	2	3	4	5	6			
							SPB	6-7-93	BURNS & ROE
							CHKD	6-7-93	
							APPRD	6-7-93	
							FILED		

COOPER NUCLEAR STATION  
FLOW DIAGRAM  
CONTROL BUILDING  
SERVICE WATER SYSTEM

2006 SH 4

DATE: 06/02/2017

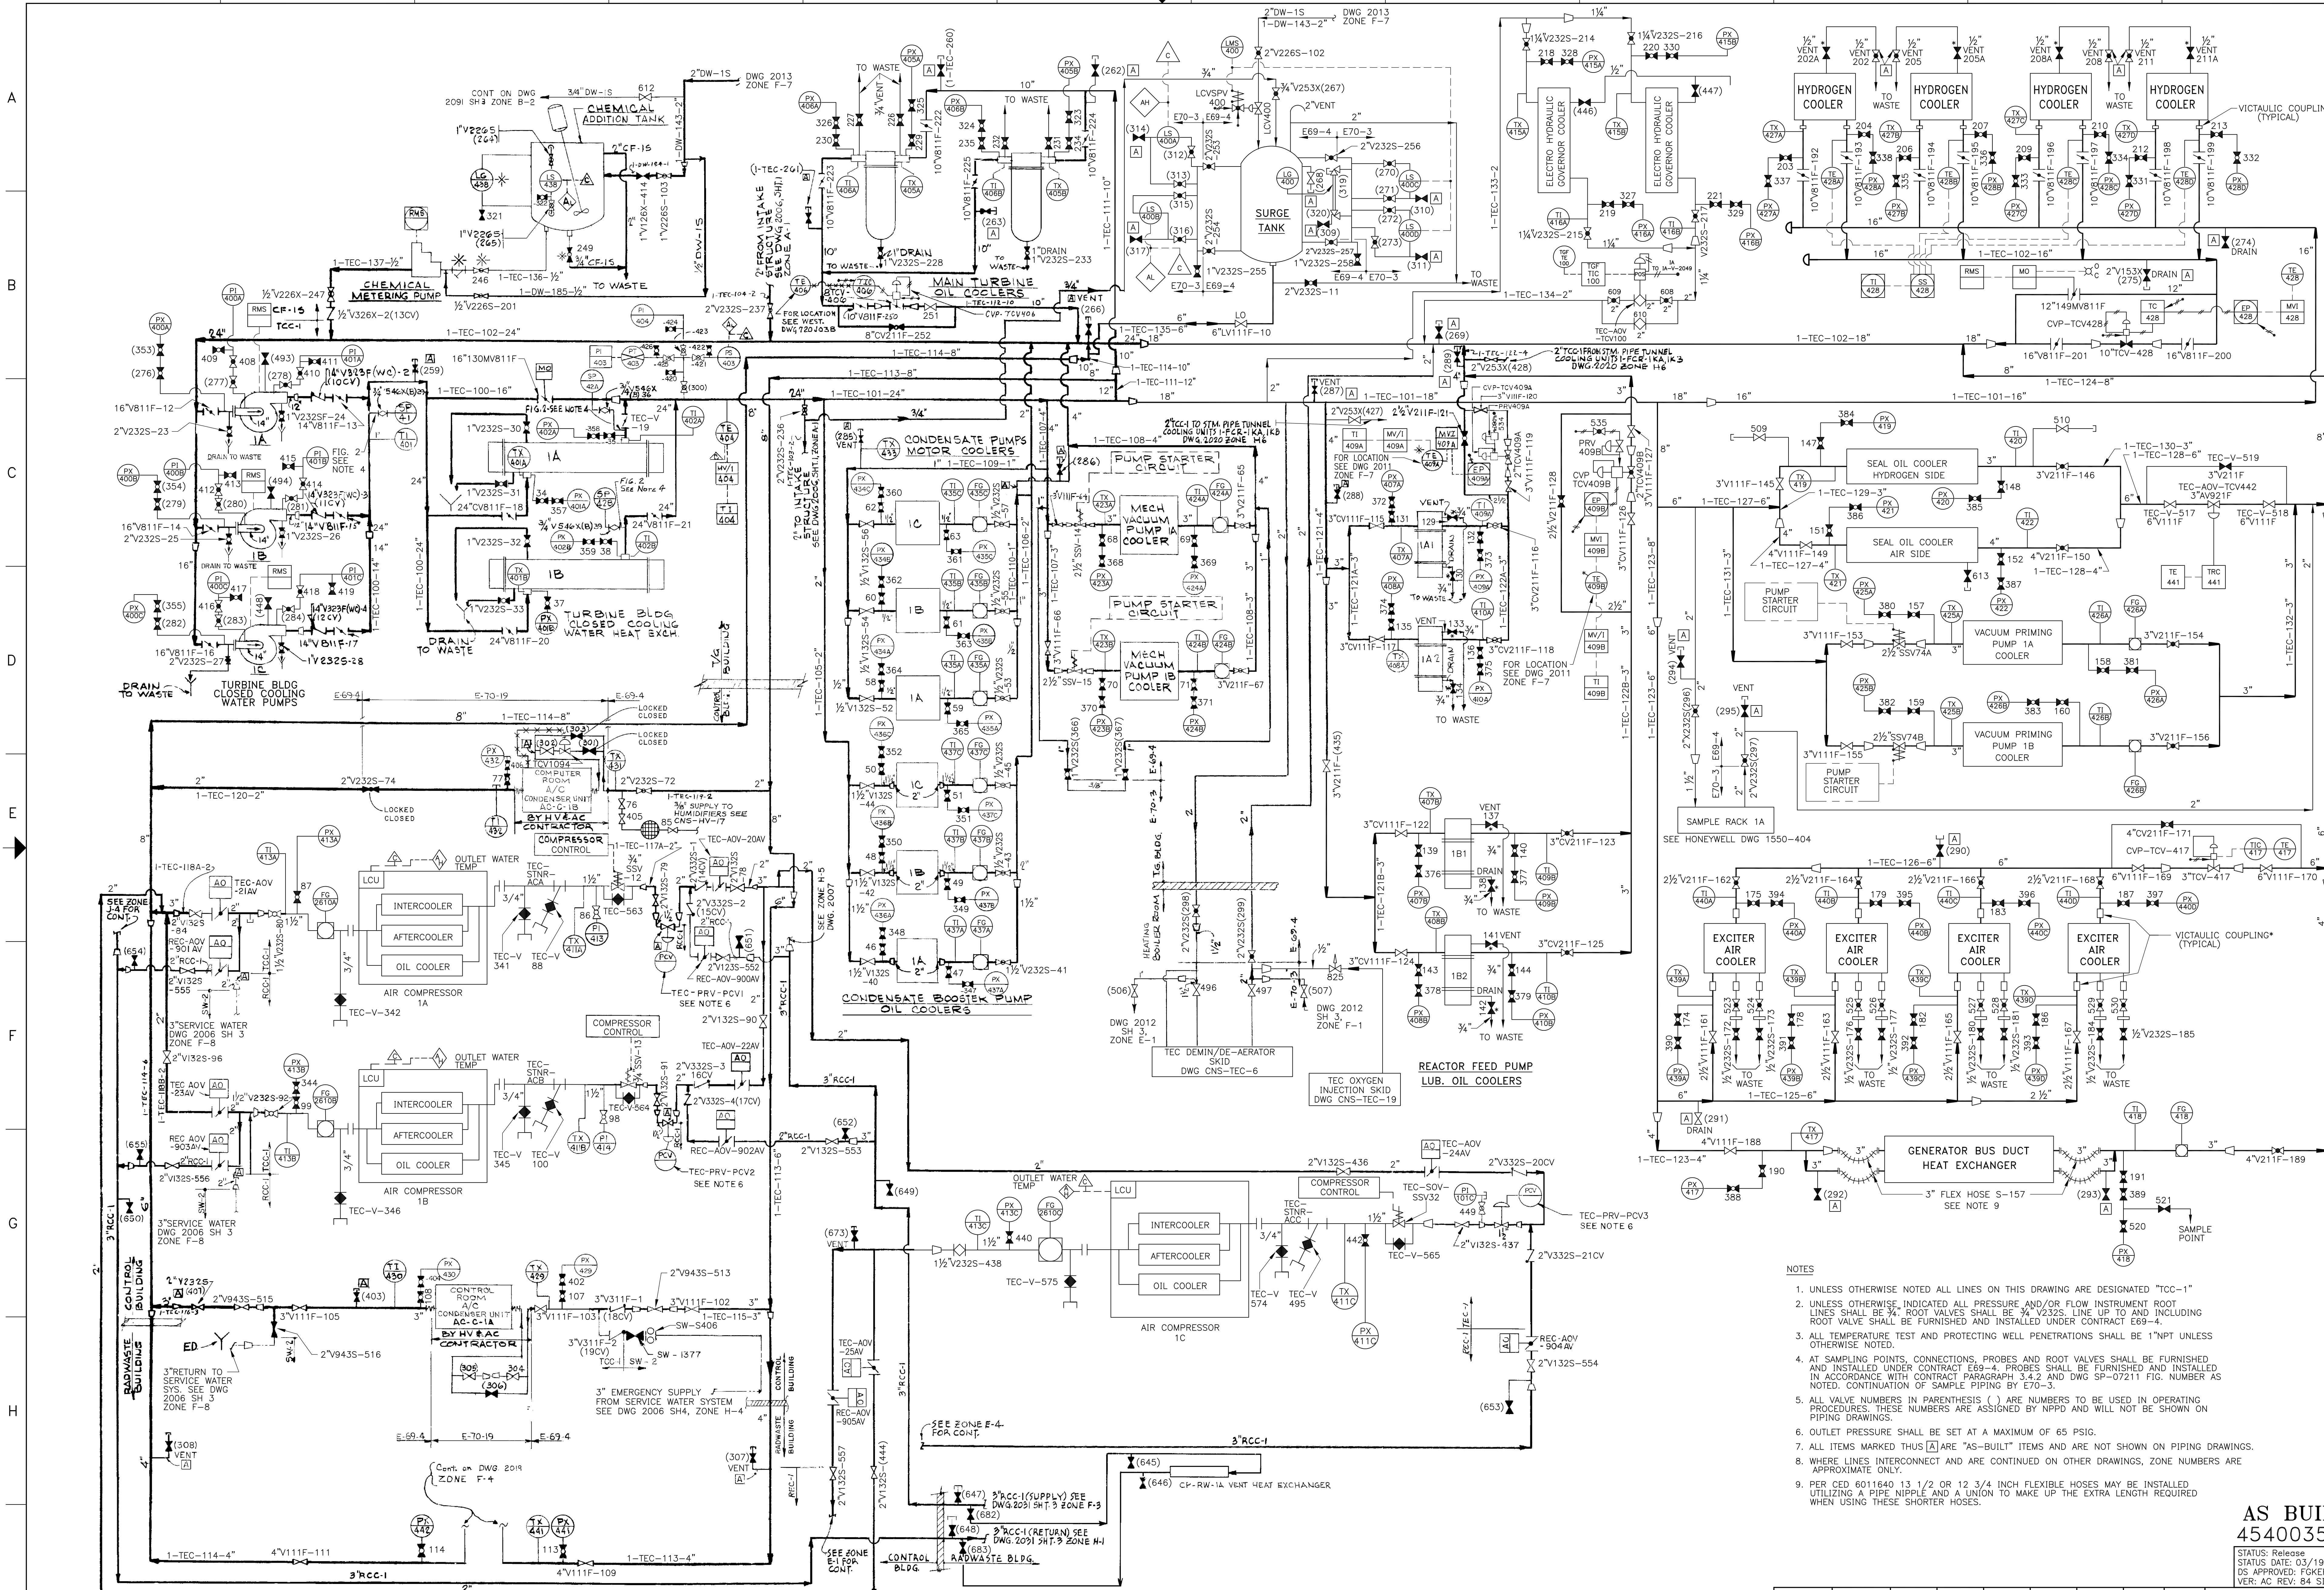

- NOTES**
1. UNLESS OTHERWISE NOTED ALL LINES ON THIS DRAWING ARE DESIGNATED "TCC-1"
  2. UNLESS OTHERWISE INDICATED ALL PRESSURE AND/OR FLOW INSTRUMENT ROOT LINES SHALL BE 3/4" ROOT VALVES SHALL BE 3/4" V2325 LINE UP TO AND INCLUDING ROOT VALVE SHALL BE FURNISHED AND INSTALLED UNDER CONTRACT E69-4.
  3. ALL TEMPERATURE TEST AND PROTECTING WELL PENETRATIONS SHALL BE 1" NPT UNLESS OTHERWISE NOTED.
  4. AT SAMPLING POINTS, CONNECTIONS, PROBES AND ROOT VALVES SHALL BE FURNISHED AND INSTALLED UNDER CONTRACT E69-4. PROBES SHALL BE FURNISHED AND INSTALLED IN ACCORDANCE WITH CONTRACT PARAGRAPH 3.4.2 AND DWG SP-07211 FIG. NUMBER AS NOTED. CONTINUATION OF SAMPLE PIPING BY E70-3.
  5. ALL VALVE NUMBERS IN PARENTHESIS ( ) ARE NUMBERS TO BE USED IN OPERATING PROCEDURES. THESE NUMBERS ARE ASSIGNED BY NPPD AND WILL NOT BE SHOWN ON PIPING DRAWINGS.
  6. OUTLET PRESSURE SHALL BE SET AT A MAXIMUM OF 65 PSIG.
  7. ALL ITEMS MARKED THUS [A] ARE "AS-BUILT" ITEMS AND ARE NOT SHOWN ON PIPING DRAWINGS.
  8. WHERE LINES INTERCONNECT AND ARE CONTINUED ON OTHER DRAWINGS, ZONE NUMBERS ARE APPROXIMATE ONLY.
  9. PER CED 8011640 1.3 1/2 OR 1.2 3/4 INCH FLEXIBLE HOSES MAY BE INSTALLED UTILIZING A PIPE NIPPLE AND A UNION TO MAKE UP THE EXTRA LENGTH REQUIRED WHEN USING THESE SHORTER HOSES.


REVISIONS TO THIS DRAWING  
REQUIRES A REVISION TO THE  
CORRESPONDING ISOKEY.

FOR PREVIOUS REVISIONS, SEE SUPERSEDED CARDS.

VERSIONS/REVISIONS BY N.P.D.			
NO.	DESCRIPTION	DFT DATE	ENG
02/24/07	DR-2015-0002	03/19/15	FOK/NER

SIGNATURE NUMBER		DATE		GROUP	
1	2	3	4	5	6
COOPER NUCLEAR STATION FLOW DIAGRAM TURBINE BUILDING CLOSED COOLING WATER SYSTEM			BURNS & ROE		
2007			DATE: 08/05/02		
APPROVED: [Signature]			DATE: [ ]		
FILMED: [ ]			DATE: [ ]		

**AS BUILT**  
454003590  
STATUS: Release  
STATUS DATE: 03/19/2015  
DS APPROVED: FOK/NER  
VER: AC REV: 84 SIZE: F

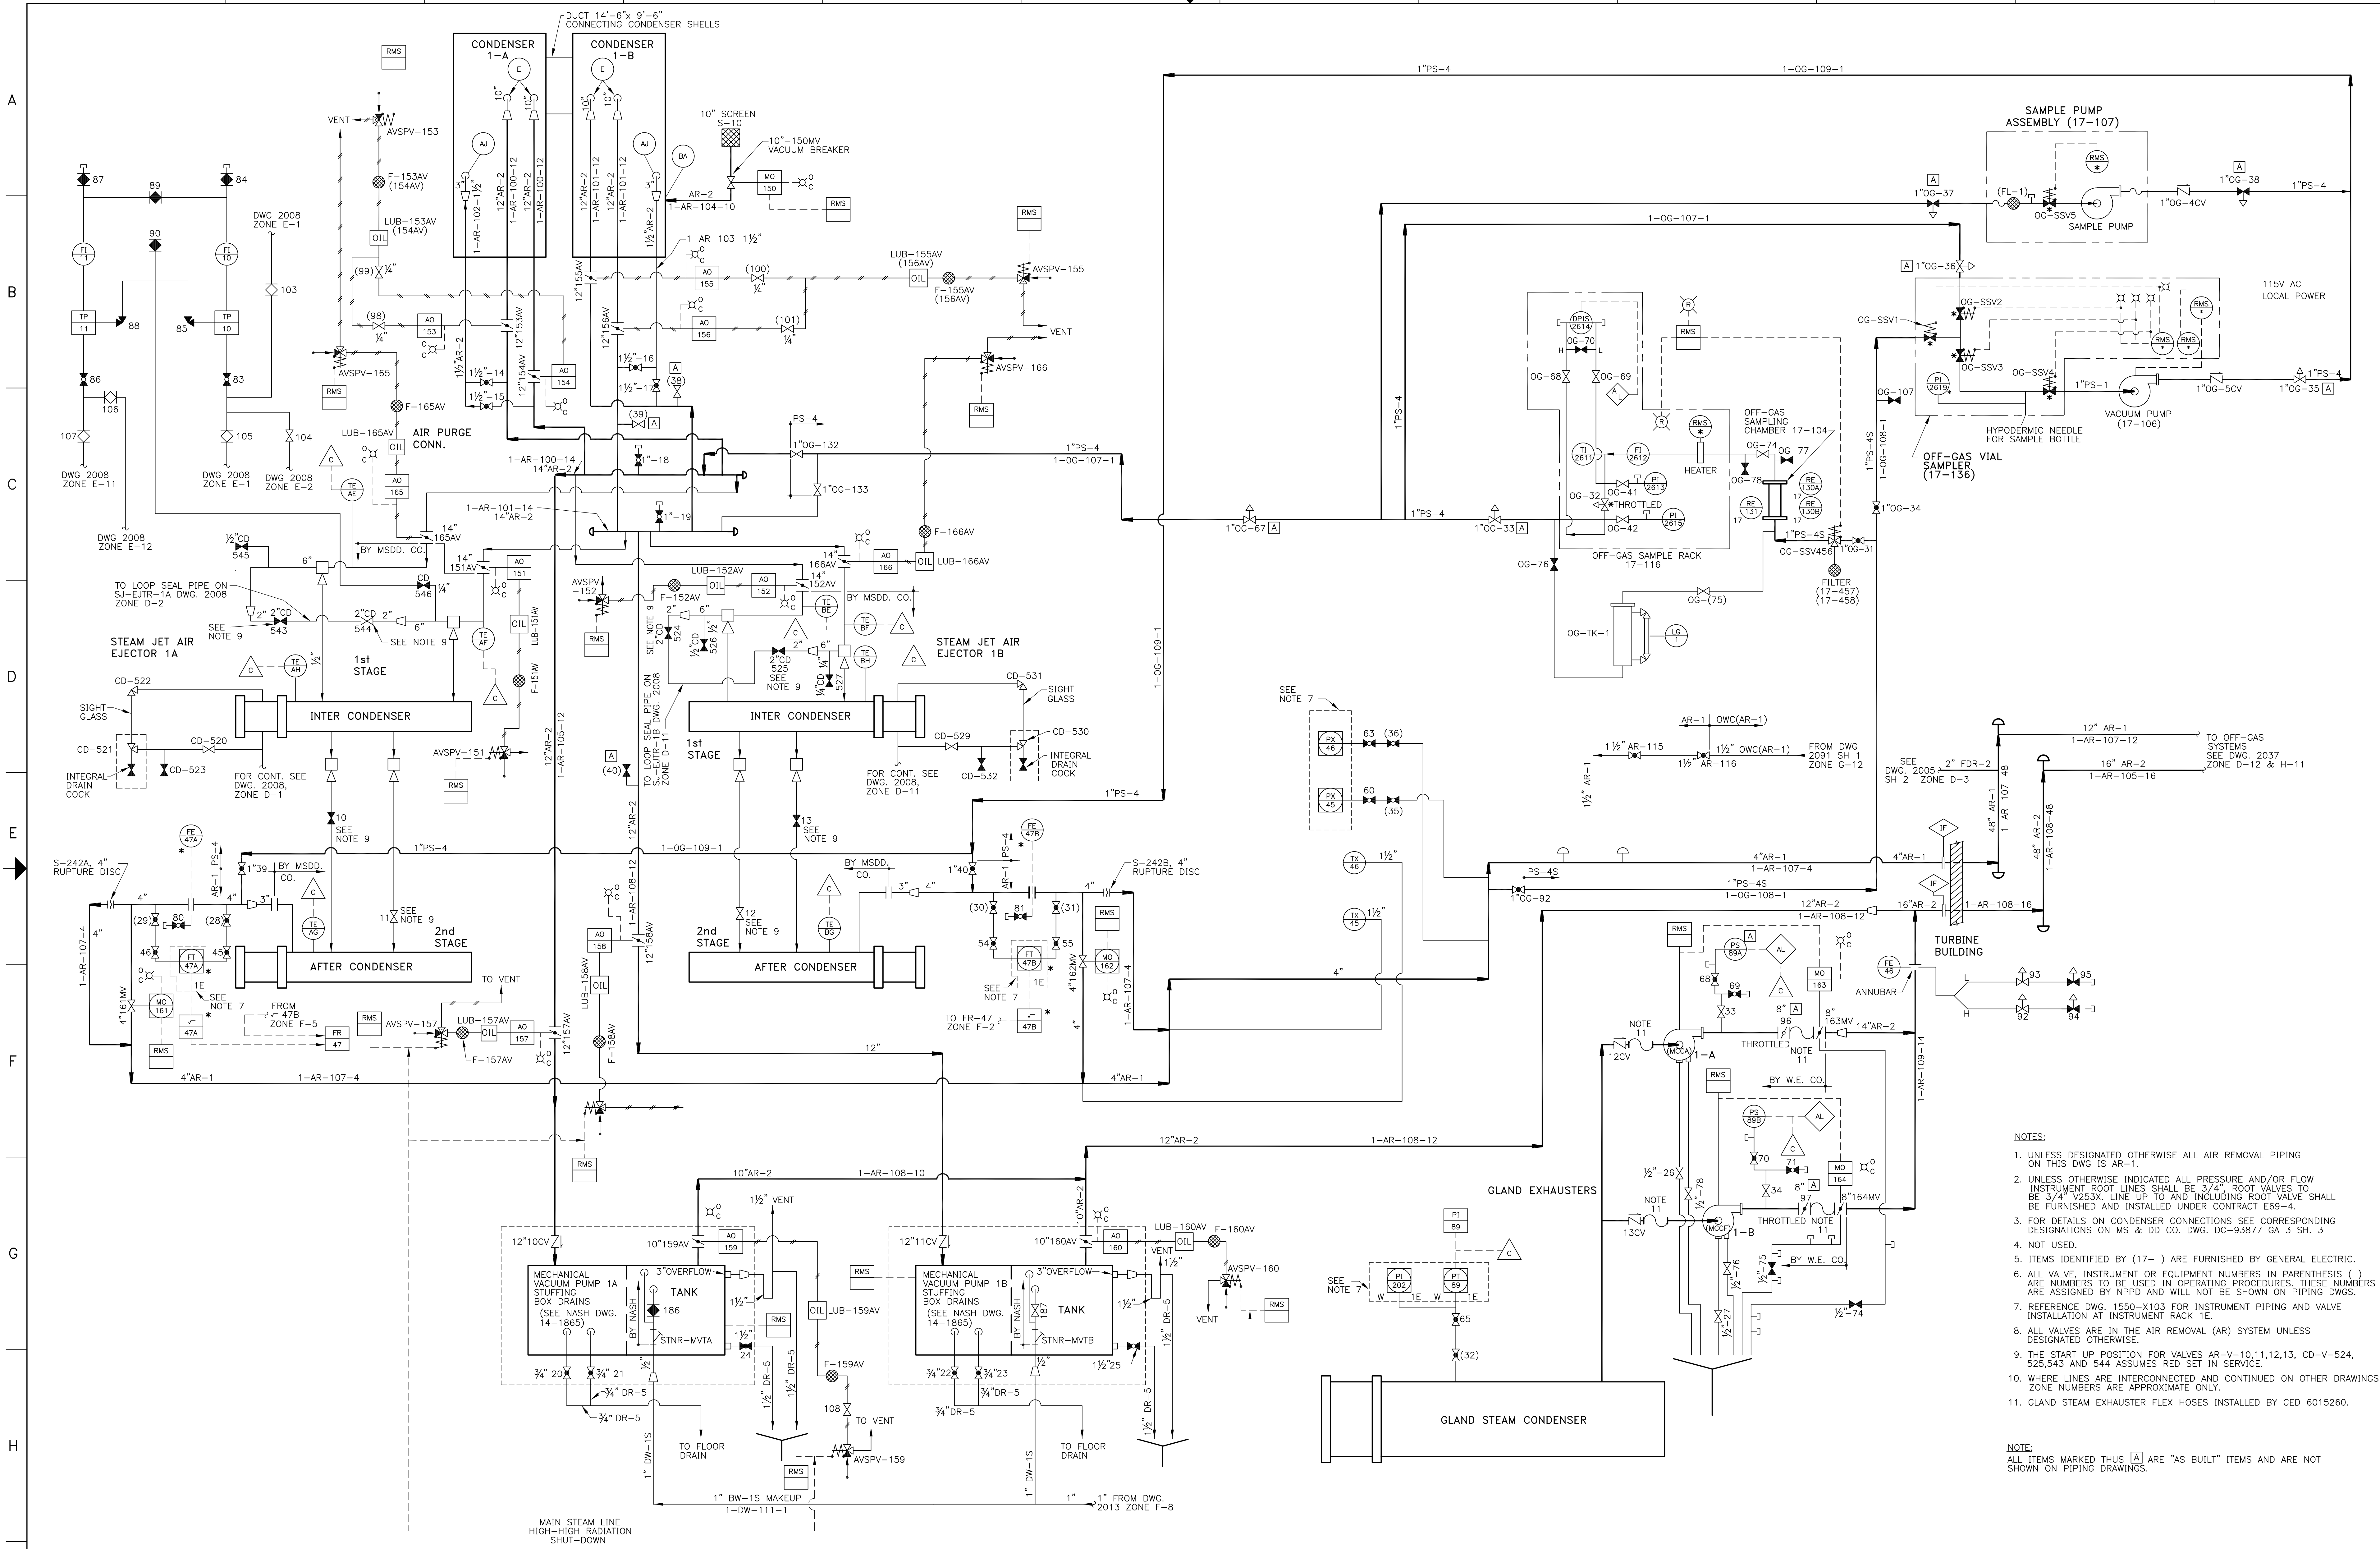

- NOTES:**
1. UNLESS DESIGNATED OTHERWISE ALL AIR REMOVAL PIPING ON THIS DWG IS AR-1.
  2. UNLESS OTHERWISE INDICATED ALL PRESSURE AND/OR FLOW INSTRUMENT ROOT LINES SHALL BE 3/4" ROOT VALVES TO BE 3/4" V253X. LINE UP TO AND INCLUDING ROOT VALVE SHALL BE FURNISHED AND INSTALLED UNDER CONTRACT E59-4.
  3. FOR DETAILS ON CONDENSER CONNECTIONS SEE CORRESPONDING DESIGNATIONS ON MS & DD CO. DWG. DC-93877 GA 3 SH. 3
  4. NOT USED.
  5. ITEMS IDENTIFIED BY (17- ) ARE FURNISHED BY GENERAL ELECTRIC.
  6. ALL VALVE, INSTRUMENT OR EQUIPMENT NUMBERS IN PARENTHESIS ( ) ARE NUMBERS TO BE USED IN OPERATING PROCEDURES. THESE NUMBERS ARE ASSIGNED BY NPPD AND WILL NOT BE SHOWN ON PIPING DWGS.
  7. REFERENCE DWG. 1550-X103 FOR INSTRUMENT PIPING AND VALVE INSTALLATION AT INSTRUMENT RACK 1E.
  8. ALL VALVES ARE IN THE AIR REMOVAL (AR) SYSTEM UNLESS DESIGNATED OTHERWISE.
  9. THE START UP POSITION FOR VALVES AR-V-10,11,12,13, CD-V-524, 525,543 AND 544 ASSUMES RED SET IN SERVICE.
  10. WHERE LINES ARE INTERCONNECTED AND CONTINUED ON OTHER DRAWINGS, ZONE NUMBERS ARE APPROXIMATE ONLY.
  11. GLAND STEAM EXHAUSTER FLEX HOSES INSTALLED BY CED 6015260.

**NOTE:**  
ALL ITEMS MARKED THUS [A] ARE "AS BUILT" ITEMS AND ARE NOT SHOWN ON PIPING DRAWINGS.

REVISIONS TO THIS DRAWING  
REQUIRES A REVISION TO THE  
CORRESPONDING ISOKEY.

FOR PREVIOUS REVISIONS, SEE SUPERSEDED CARDS.


REVISIONS BY N.P.P.D.			
NO.	REVISIONS	DFT	CHK APP DATE
N29	CED 6015260 (DCN 04-1046)	KG	KG RGA 9/20/05
N30	CED 6015260 (DCN 04-1085)	KG	KG DLT 11/17/08
N31	CED 6015260 (DCN 07-2400)	KG	KG DLT 05/18/09
N32	CR 2009-03730 (DCN 09-0604)	KG	KG DLR 05/18/09

SIGNIFICANT NUMBER		1	2	3	4	5	6	7	8	9	10	11	12
DRAWN		RRT 1/21/02											
CHECKED													
APPROVED		DATE											
FILMED													
COOPER NUCLEAR STATION FLOW DIAGRAM AIR REMOVAL SYSTEM												BURNS & ROE	
2009												N32	

AS BUILT  
454003592

NO.	REVISIONS

NO. 11  
C0017909

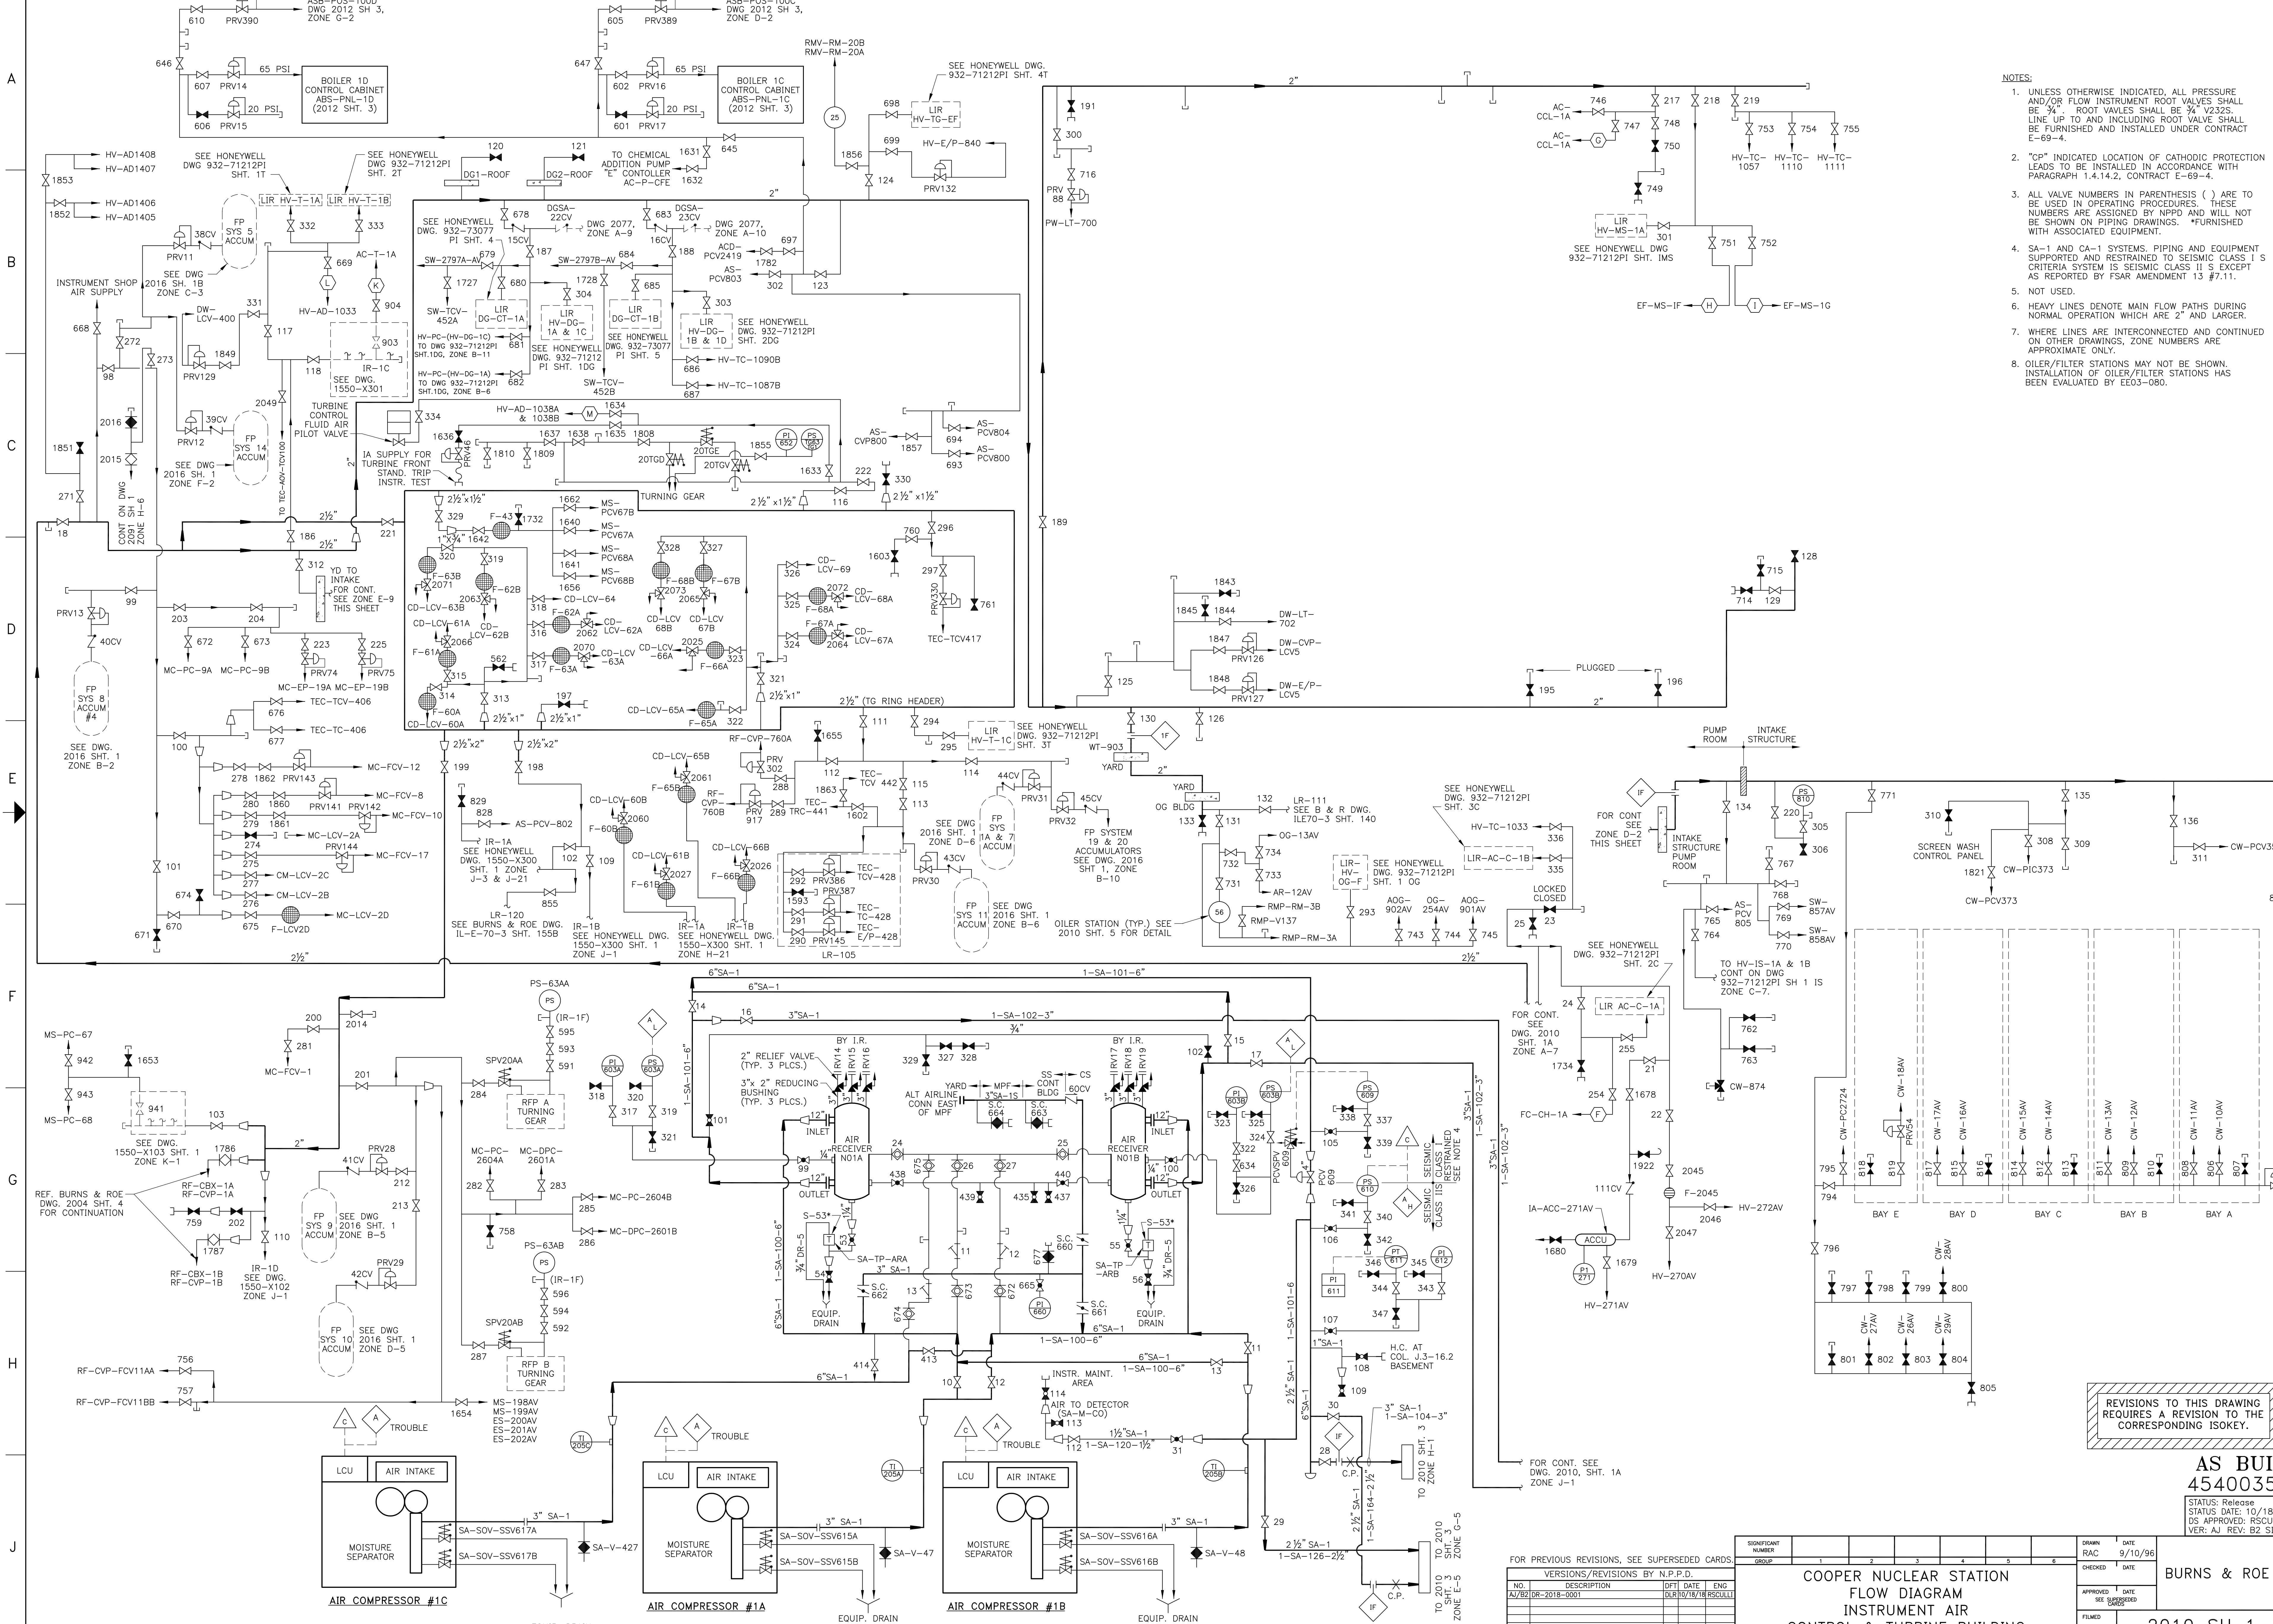

- NOTES:**
- UNLESS OTHERWISE INDICATED, ALL PRESSURE AND/OR FLOW INSTRUMENT ROOT VALVES SHALL BE 3/4" . ROOT VALVES SHALL BE 3/4" V2325 LINE UP TO AND INCLUDING ROOT VALVE SHALL BE FURNISHED AND INSTALLED UNDER CONTRACT E-69-4.
  - "CP" INDICATED LOCATION OF CATHODIC PROTECTION LEADS TO BE INSTALLED IN ACCORDANCE WITH PARAGRAPH 1.4.14.2, CONTRACT E-69-4.
  - ALL VALVE NUMBERS IN PARENTHESIS ( ) ARE TO BE USED IN OPERATING PROCEDURES. THESE NUMBERS ARE ASSIGNED BY NPPD AND WILL NOT BE SHOWN ON PIPING DRAWINGS. \*FURNISHED WITH ASSOCIATED EQUIPMENT.
  - SA-1 AND CA-1 SYSTEMS, PIPING AND EQUIPMENT SUPPORTED AND RESTRAINED TO SEISMIC CLASS 1 S CRITERIA SYSTEM IS SEISMIC CLASS II S EXCEPT AS REPORTED BY FSAR AMENDMENT 13 #7.11.
  - NOT USED.
  - HEAVY LINES DENOTE MAIN FLOW PATHS DURING NORMAL OPERATION WHICH ARE 2" AND LARGER.
  - WHERE LINES ARE INTERCONNECTED AND CONTINUED ON OTHER DRAWINGS, ZONE NUMBERS ARE APPROXIMATE ONLY.
  - OILER/FILTER STATIONS MAY NOT BE SHOWN. INSTALLATION OF OILER/FILTER STATIONS HAS BEEN EVALUATED BY EEO3-080.

REVISIONS TO THIS DRAWING REQUIRES A REVISION TO THE CORRESPONDING ISOKEY.

**AS BUILT**  
454003593

STATUS: Release  
DATE: 10/18/2018  
DS APPROVED: RSCULLI  
VER: AJ REV: B2 SIZE: F


SIGNIFICANT NUMBER			
GROUP	1	2	3
NO.	1	2	3
DESCRIPTION			
DATE			
ENG			
RESULT			

FOR PREVIOUS REVISIONS, SEE SUPERSEDED CARDS		DATE	9/10/96
VERSIONS/REVISIONS BY N.P.P.D.		CHECKED	
NO.	DESCRIPTION	DATE	
1			
2			
3			

COOPER NUCLEAR STATION		BURNS & ROE	
FLOW DIAGRAM		2010 SH 1	
INSTRUMENT AIR		C0017910	
CONTROL & TURBINE BUILDING			



CONTINUED ON 2010 SHEET 1 ZONE J-8

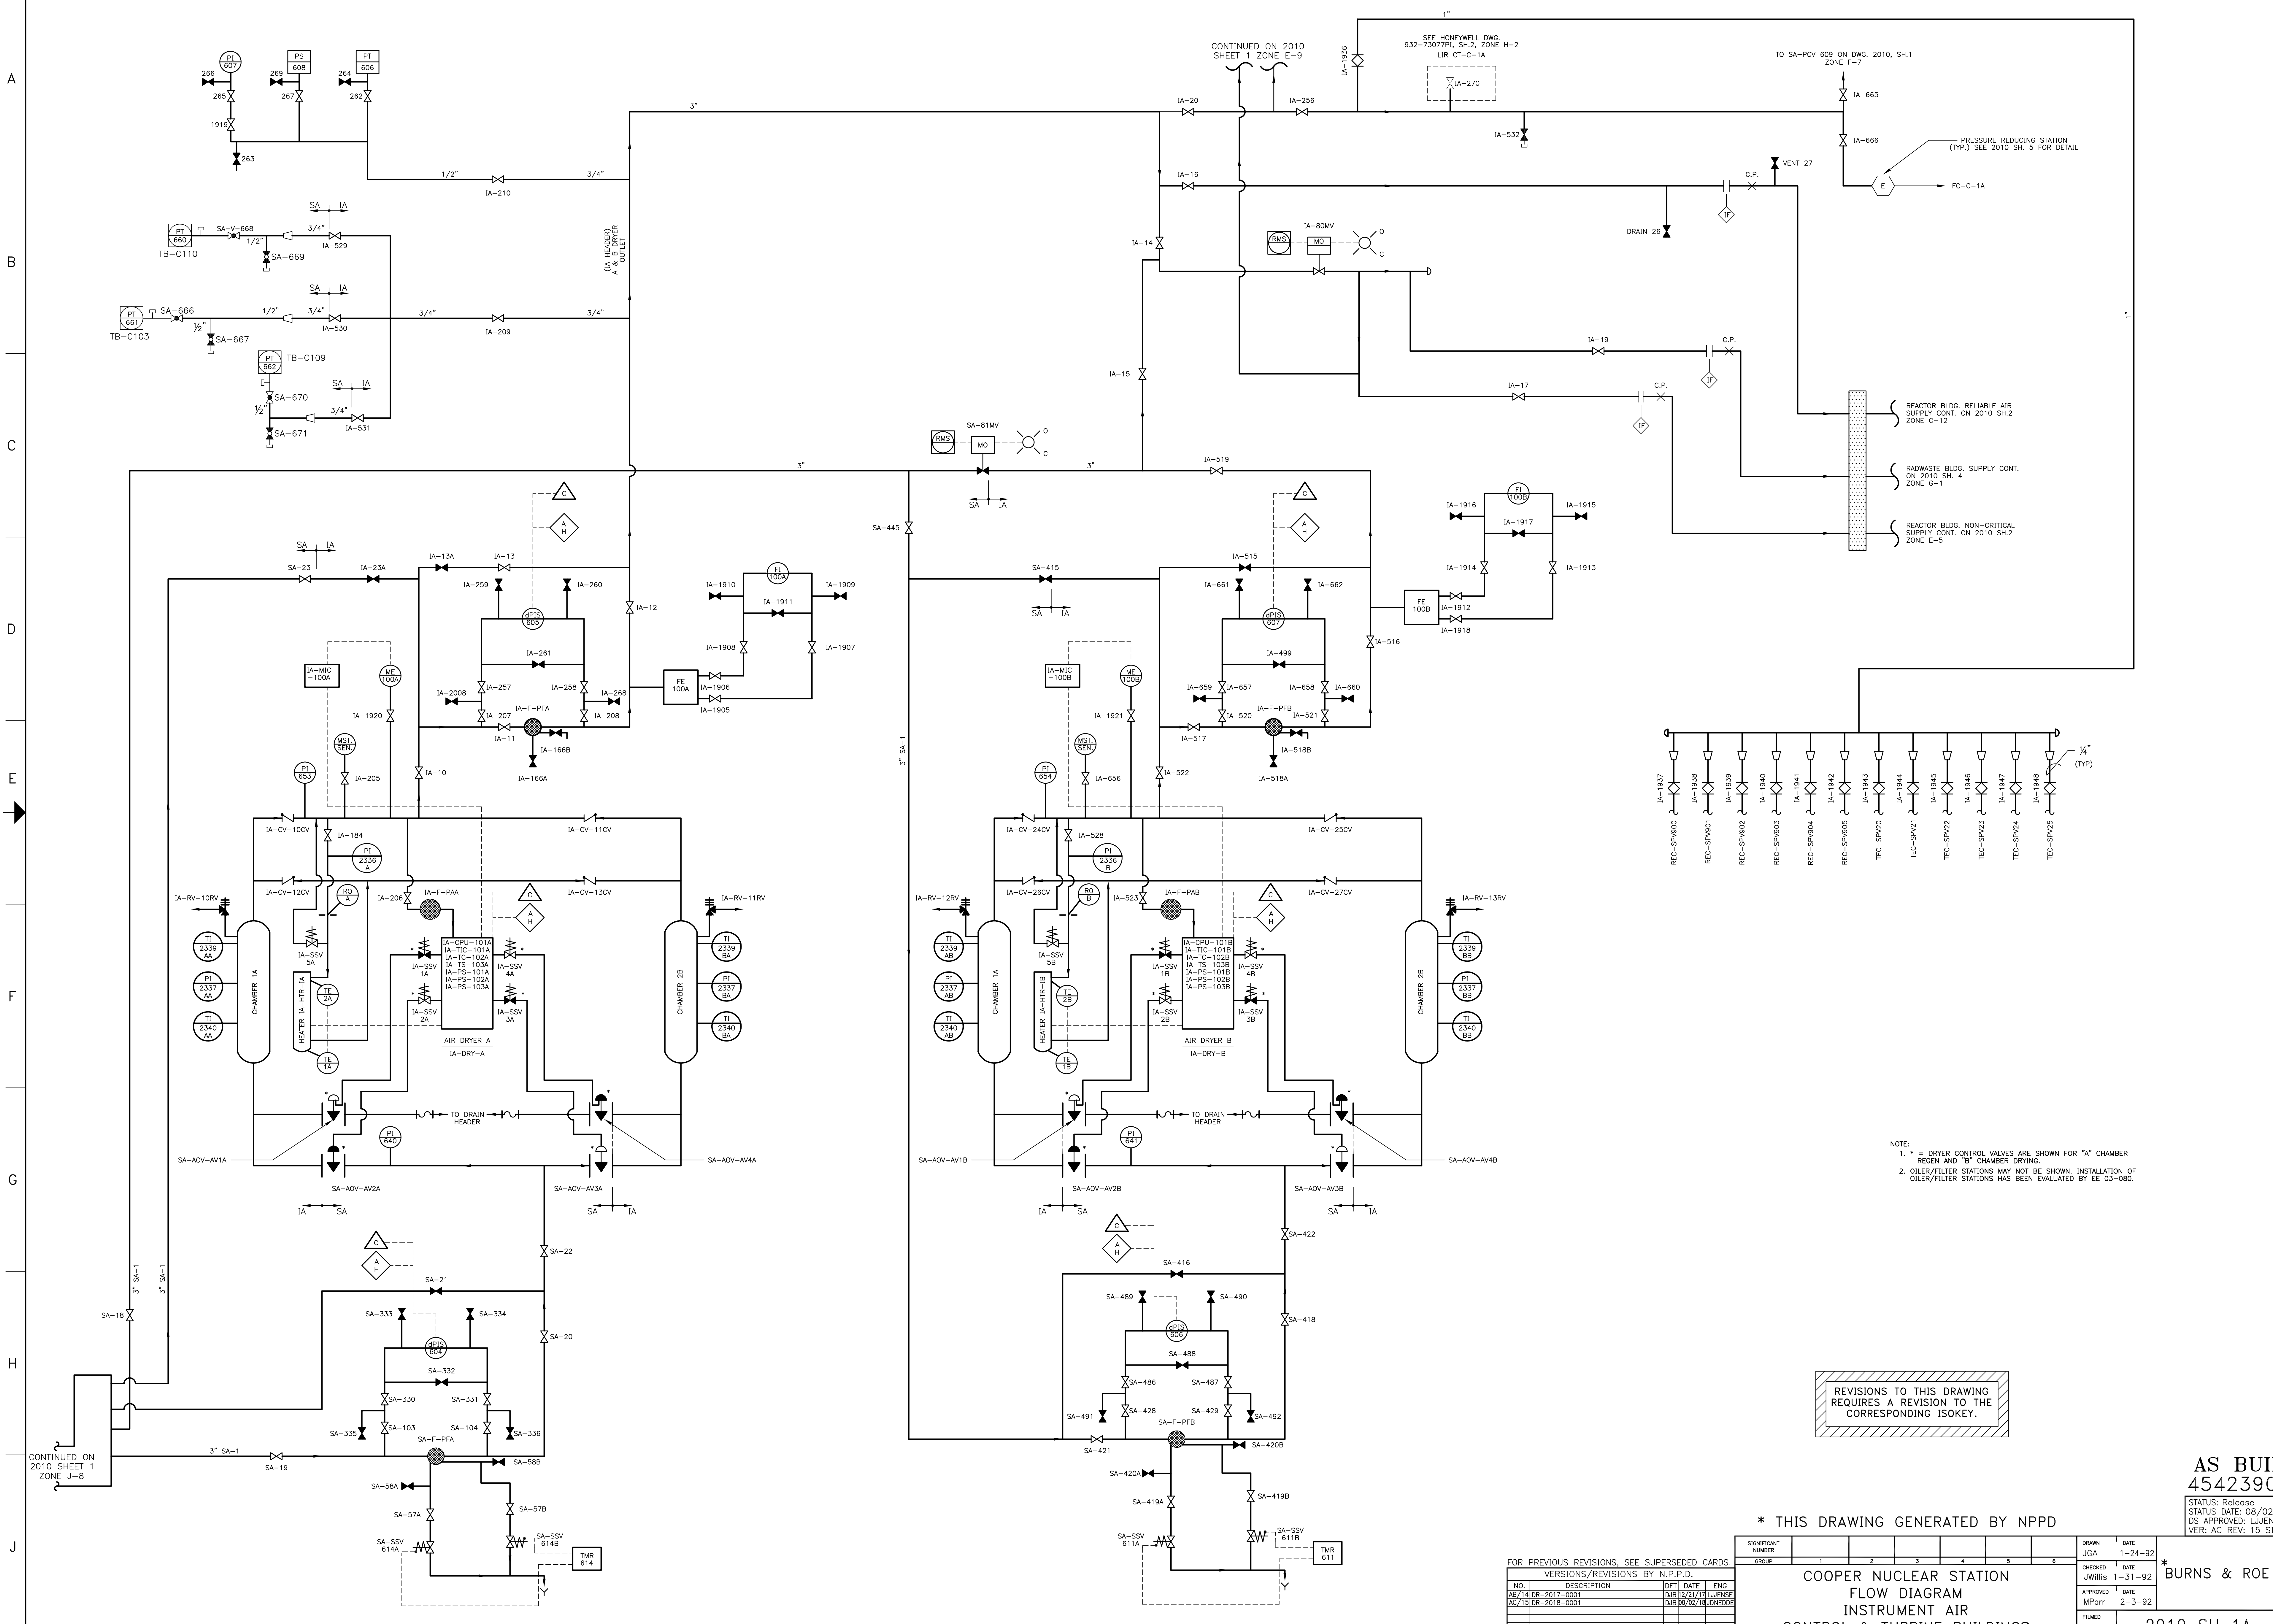CONTINUED ON 2010 SHEET 1 ZONE E-9

SEE HONEYWELL DWG. 932-75077/PI, SH-2, ZONE H-2 LIR CT-C-1A

TO SA-PCV 609 ON DWG. 2010, SH.1 ZONE F-7

PRESSURE REDUCING STATION (TYP.) SEE 2010 SH. 5 FOR DETAIL

REACTOR BLDG. RELIABLE AIR SUPPLY CONT. ON 2010 SH.2 ZONE C-12  
 RADWASTE BLDG. SUPPLY CONT. ON 2010 SH. 4 ZONE C-1  
 REACTOR BLDG. NON-CRITICAL SUPPLY CONT. ON 2010 SH.2 ZONE E-5

NOTE:  
 1. \* = DRYER CONTROL VALVES ARE SHOWN FOR "A" CHAMBER REGEN AND "B" CHAMBER DRYING.  
 2. OILER/FILTER STATIONS MAY NOT BE SHOWN. INSTALLATION OF OILER/FILTER STATIONS HAS BEEN EVALUATED BY EE 03-080.

REVISIONS TO THIS DRAWING REQUIRES A REVISION TO THE CORRESPONDING ISOKEY.

AS BUILT  
 454239099

STATUS: Release  
 STATUS DATE: 08/02/2018  
 DS APPROVED: LJJENSE  
 VER: AC REV: 15 SIZE: F

\* THIS DRAWING GENERATED BY NPPD

FOR PREVIOUS REVISIONS, SEE SUPERSEDED CARDS.

VERSIONS/REVISIONS BY N.P.P.D.			
NO.	DESCRIPTION	DFT DATE	ENG
AB/74	DR-2017-0001	DJB 12/21/17	LJENSE
BC/75	DR-2018-0001	DJB 08/02/18	LJENSE


SIGNIFICANT NUMBER	GROUP	1	2	3	4	5	6	DATE	DATE	DATE	DATE
								1-24-92	1-31-92	2-3-92	
JGA											
JWH											
MP											
FILED											

COOPER NUCLEAR STATION  
 FLOW DIAGRAM  
 INSTRUMENT AIR  
 CONTROL & TURBINE BUILDINGS

2010 SH 1A

BURNS & ROE

2010 SH 1A

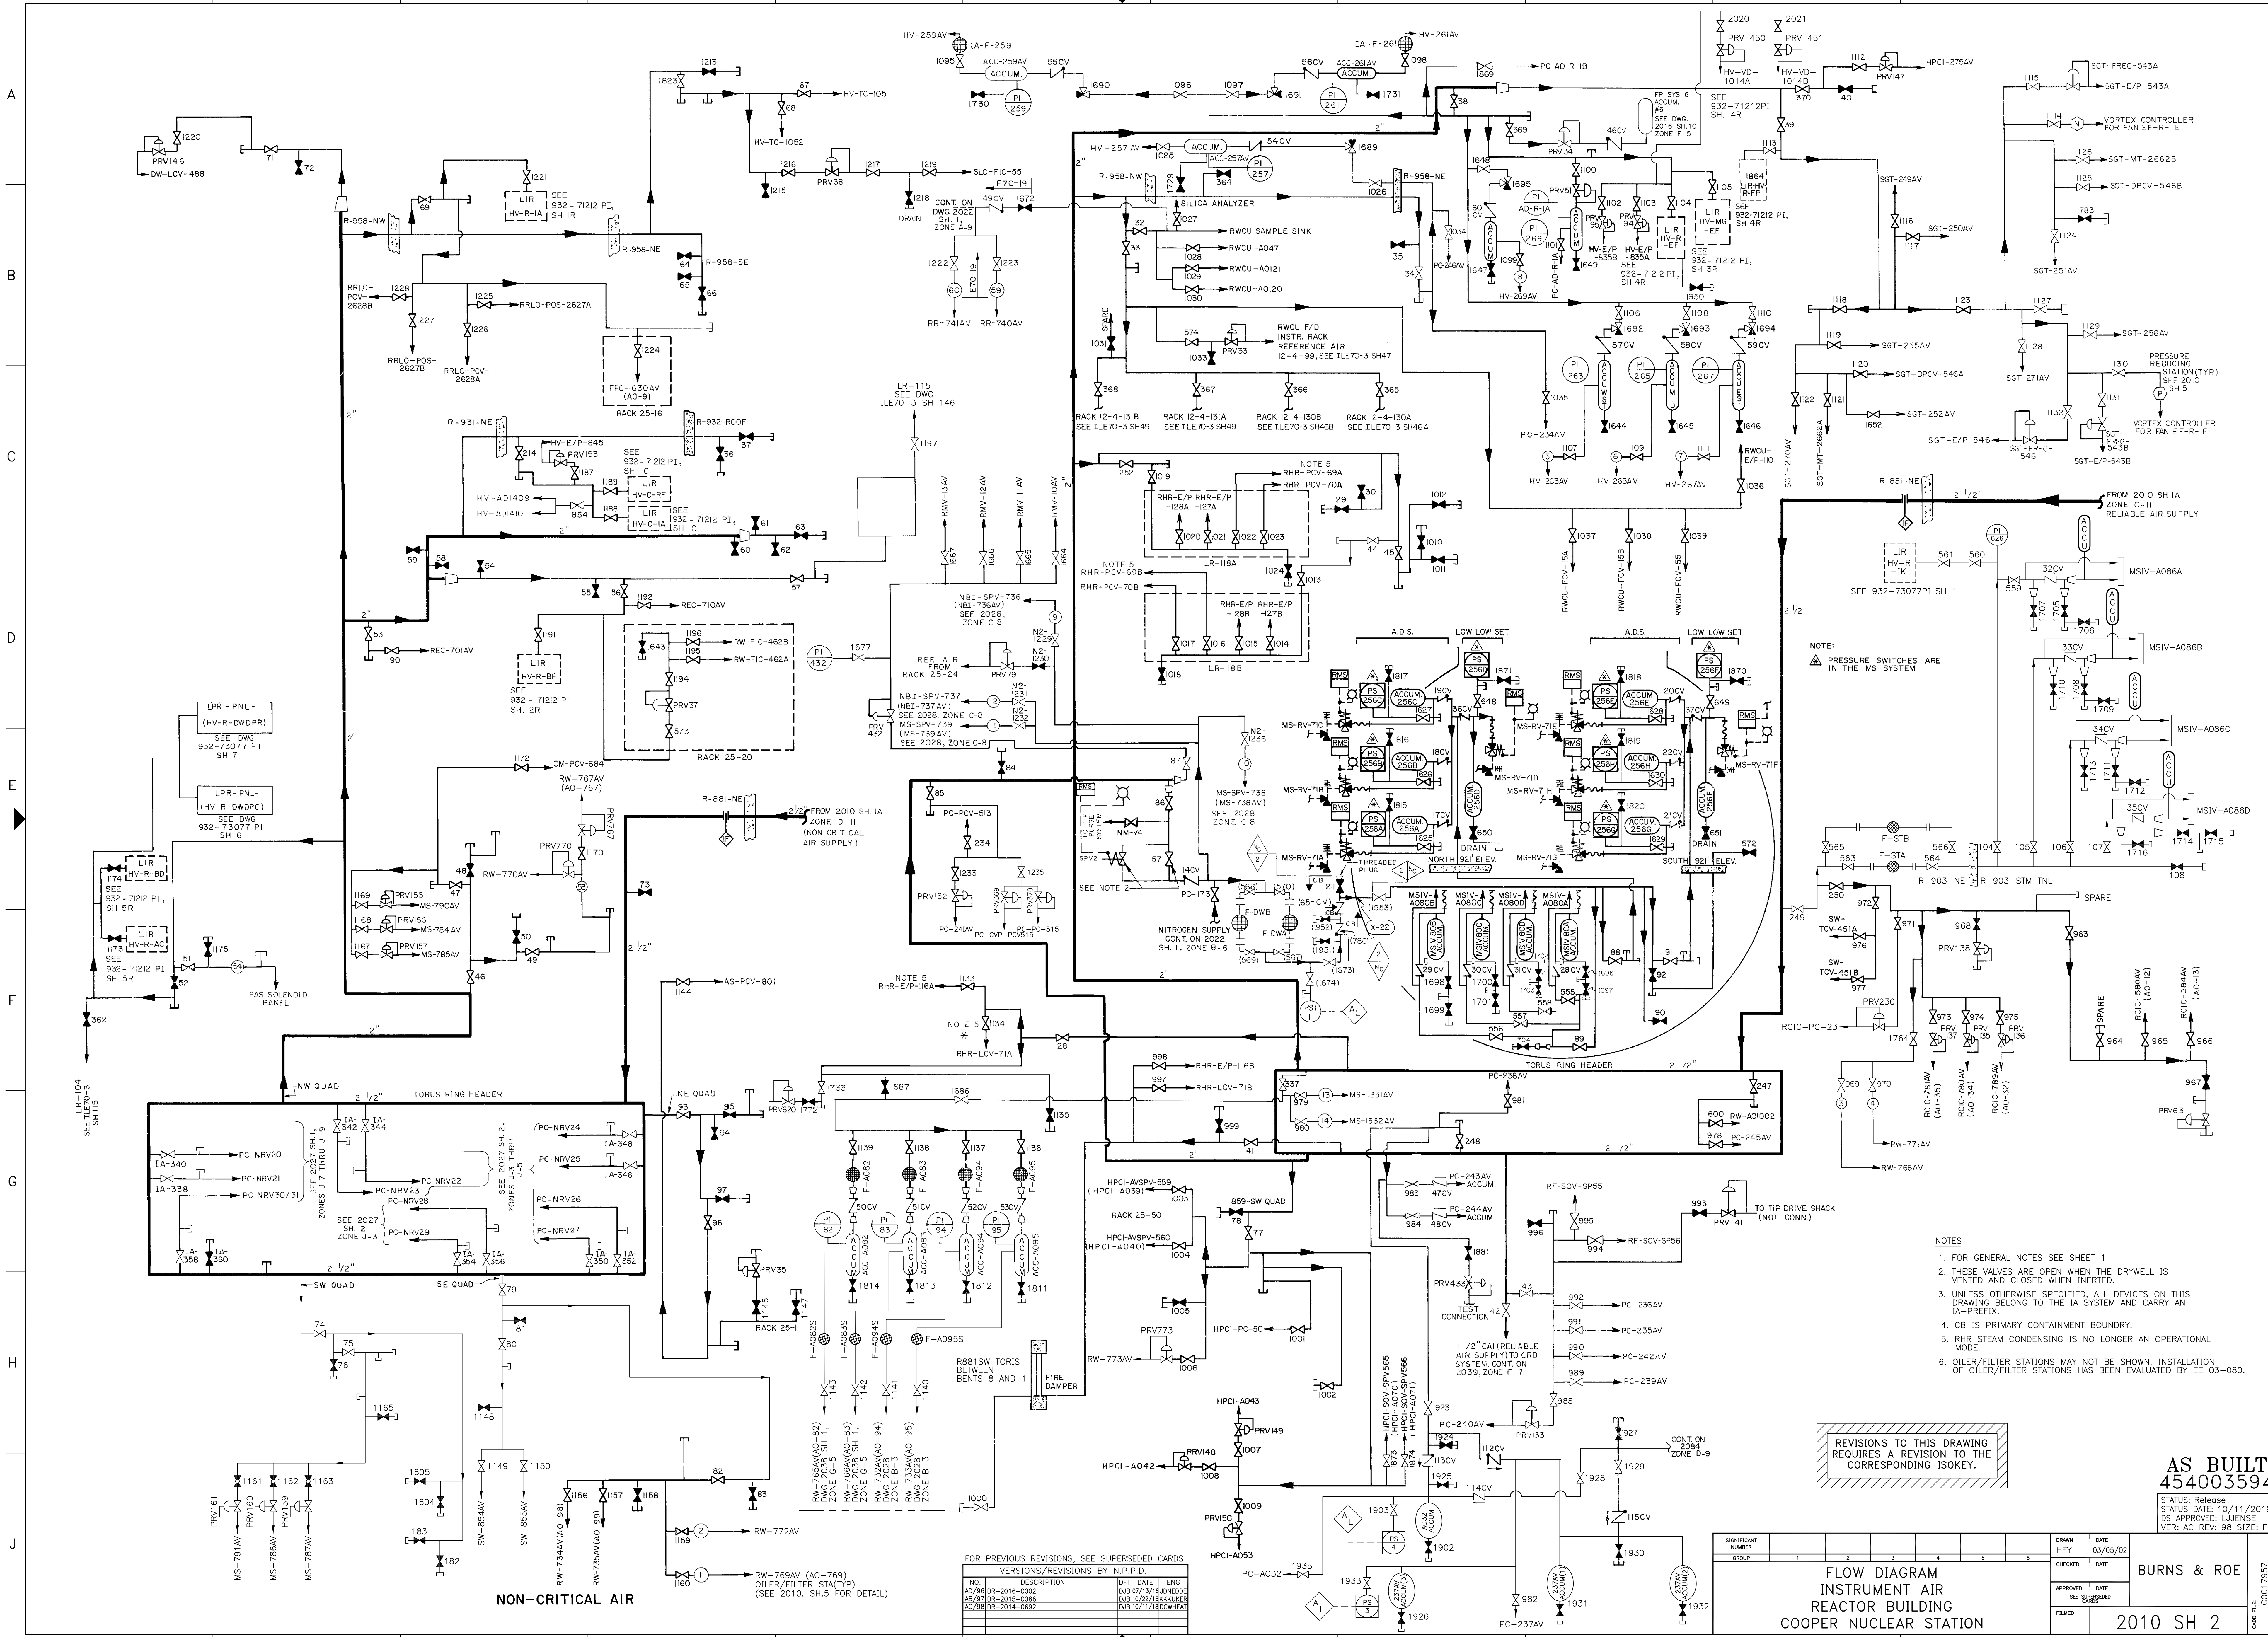

- NOTES
1. FOR GENERAL NOTES SEE SHEET 1
  2. THESE VALVES ARE OPEN WHEN THE DRYWELL IS VENTED AND CLOSED WHEN INERTED.
  3. UNLESS OTHERWISE SPECIFIED, ALL DEVICES ON THIS DRAWING BELONG TO THE IA SYSTEM AND CARRY AN IA-PREFIX.
  4. CB IS PRIMARY CONTAINMENT BOUNDARY.
  5. RHR STEAM CONDENSING IS NO LONGER AN OPERATIONAL MODE.
  6. OILER/FILTER STATIONS MAY NOT BE SHOWN. INSTALLATION OF OILER/FILTER STATIONS HAS BEEN EVALUATED BY EE 03-080.

REVISIONS TO THIS DRAWING REQUIRES A REVISION TO THE CORRESPONDING ISOKEY.

FOR PREVIOUS REVISIONS, SEE SUPERSEDED CARDS.

NO.	DESCRIPTION	DATE	ENG
01	ISSUED FOR CONSTRUCTION	03/05/02	LFJ
02	REVISED FOR CONSTRUCTION	03/05/02	LFJ
03	REVISED FOR CONSTRUCTION	03/05/02	LFJ
04	REVISED FOR CONSTRUCTION	03/05/02	LFJ
05	REVISED FOR CONSTRUCTION	03/05/02	LFJ

SIGNIFICANT NUMBER		DATE	
1	2	3	4
GROUP	HY	DATE	DATE
1	03/05/02	DATE	DATE
APPROVED	DATE	DATE	DATE
FILED	DATE	DATE	DATE


**FLOW DIAGRAM  
INSTRUMENT AIR  
REACTOR BUILDING  
COOPER NUCLEAR STATION**

**AS BUILT  
454003594**  
STATUS: Release  
STATUS DATE: 10/11/2018  
DS APPROVED: LUJENSE  
VER: AC REV: 98 SIZE: F

**BURNS & ROE**

**2010 SH 2**

DATE: 03/05/02  
DRAWN: LFJ  
CHECKED: LFJ  
APPROVED: LFJ  
FILED: LFJ

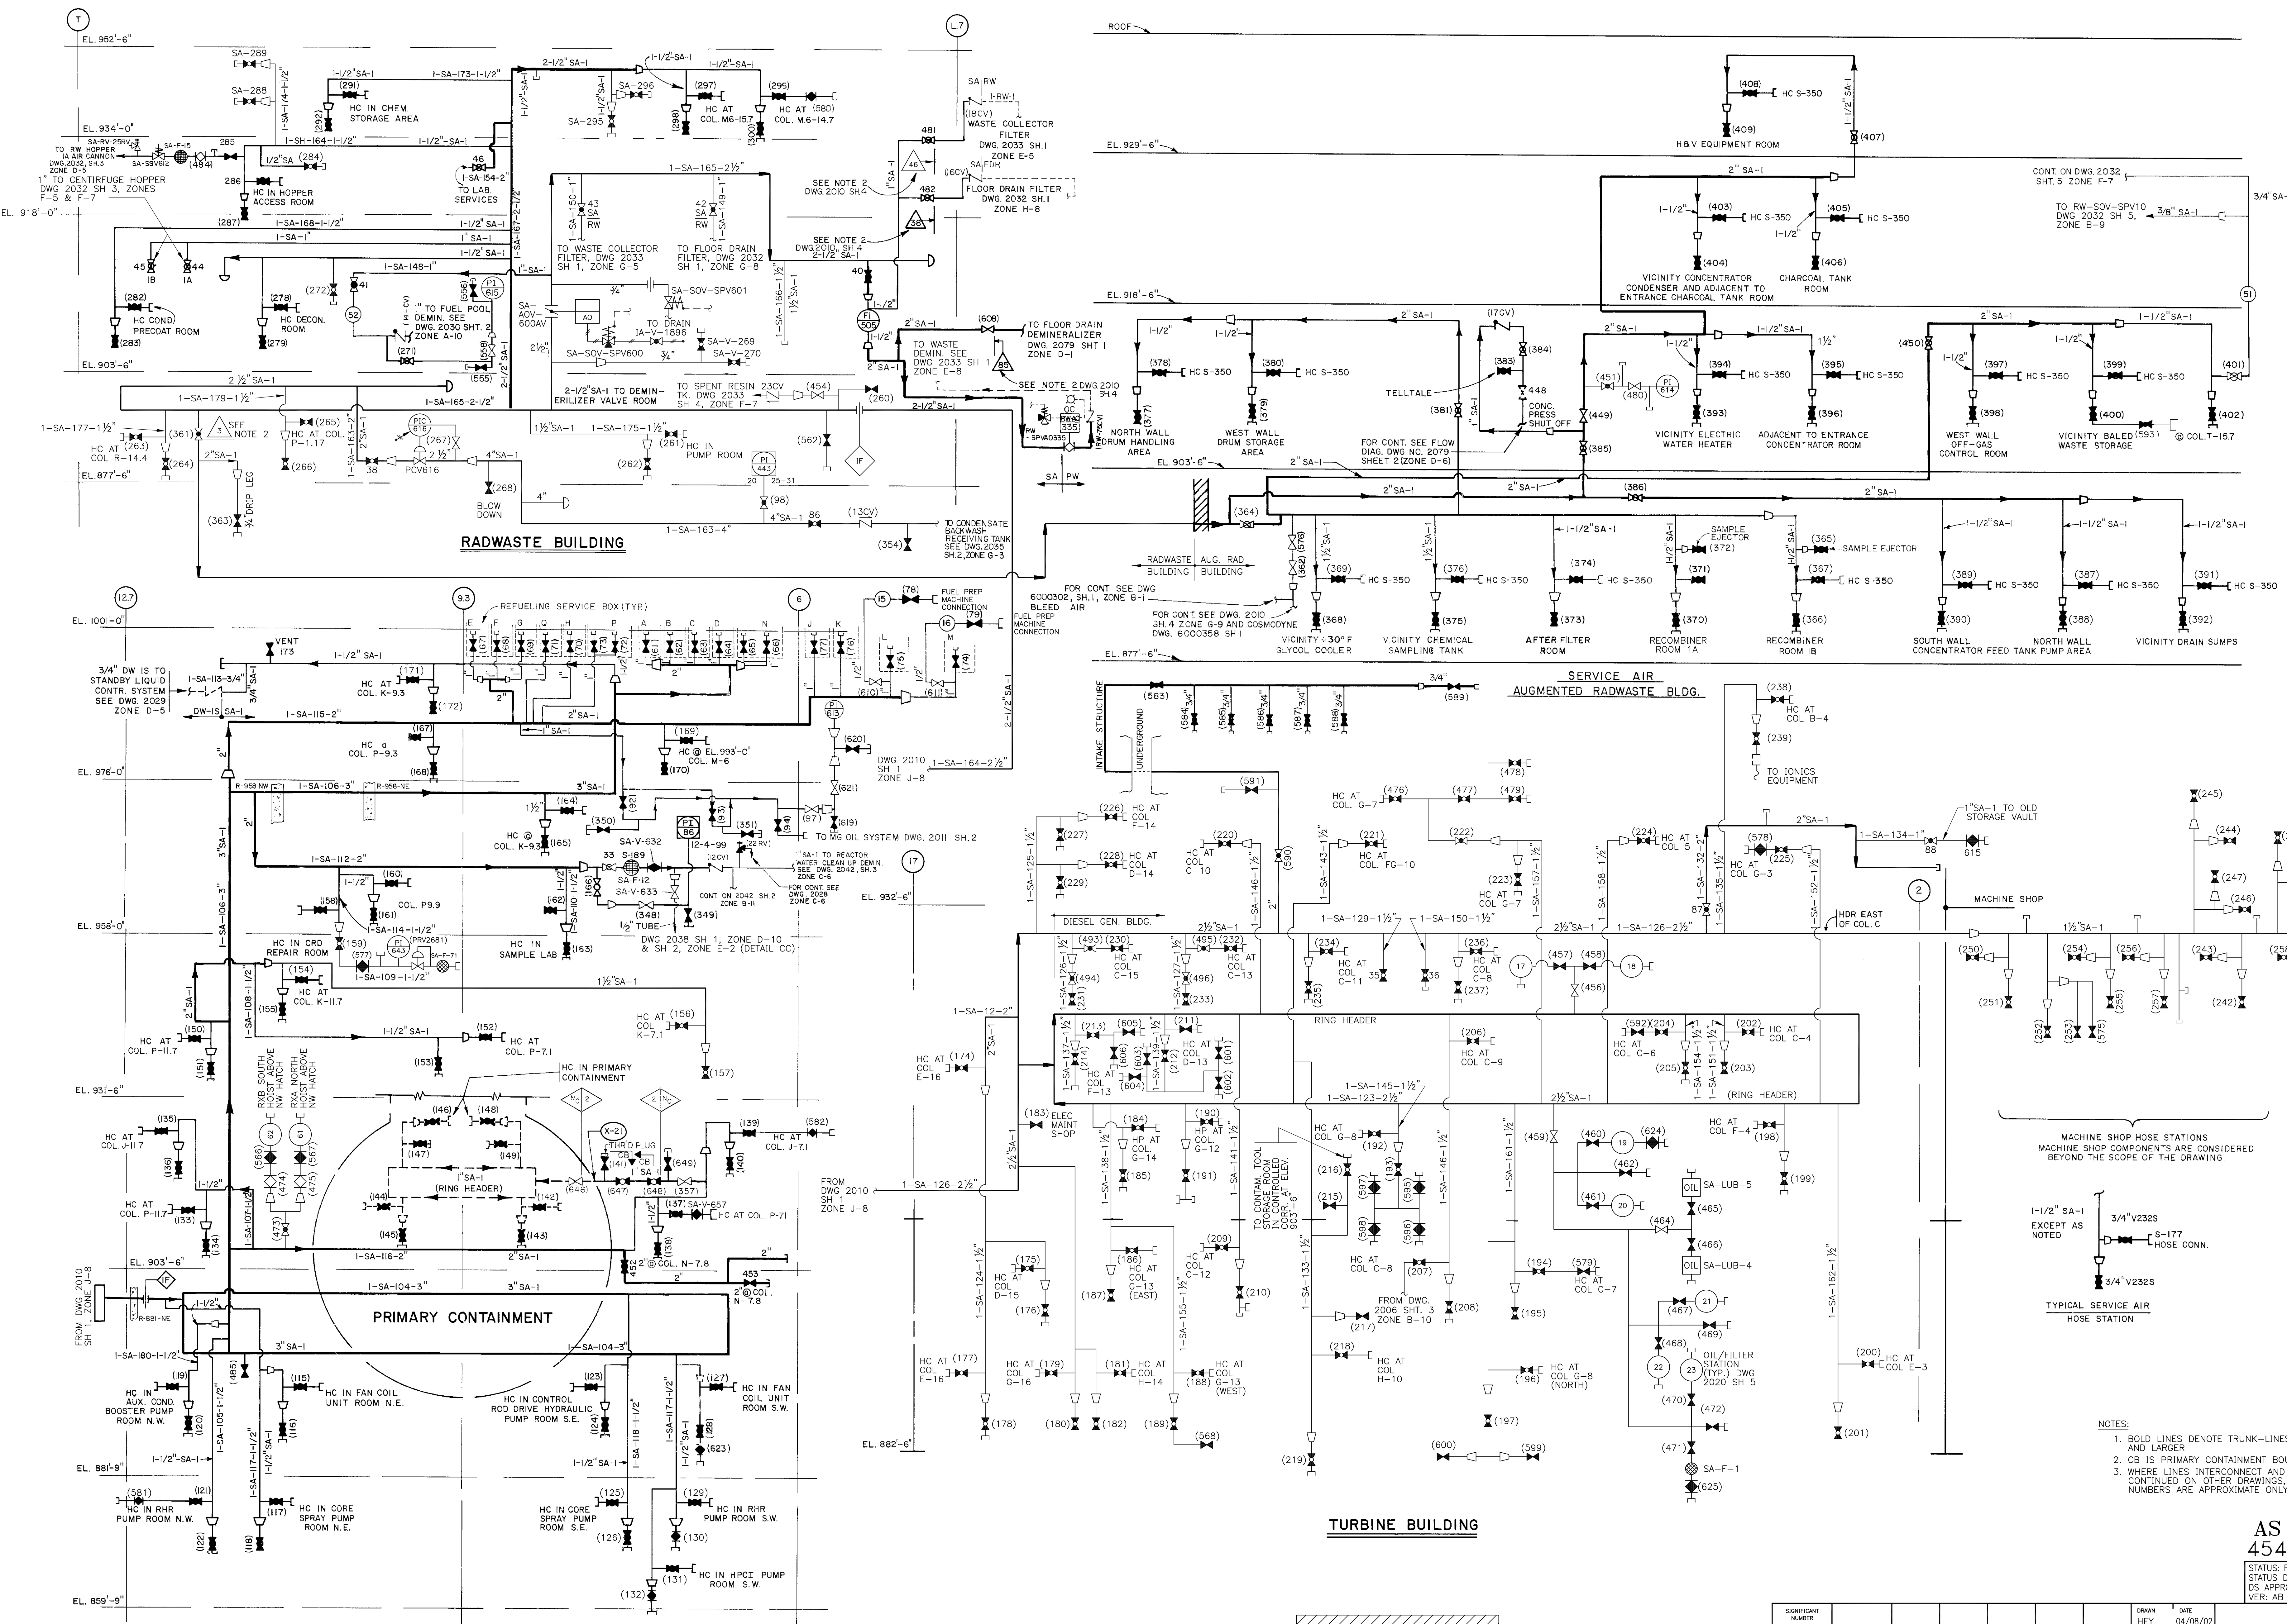

**REACTOR BUILDING**

**RADWASTE BUILDING**

**TURBINE BUILDING**

REVISIONS TO THIS DRAWING  
REQUIRES A REVISION TO THE  
CORRESPONDING ISOKEY.

FOR PREVIOUS REVISIONS, SEE SUPPLEMENTARY CARDS.

VERSIONS/REVISIONS BY N.P.P.D.			
NO.	DESCRIPTION	DATE	ENG.
AB/181	DR-2018-0001	DJB/03/08/18	RDCHAMP

SIGNIFICANT NUMBER	1	2	3	4	5	6
	GROUP					
DRAWN	HYF					
	DATE 04/08/02					
CHECKED	DATE					
	DATE					
APPROVED	DATE					
	DATE					
FILMED	DATE					
	DATE					

**FLOW DIAGRAM SERVICE AIR**

COOPER NUCLEAR STATION

2010 SH 3


AS BUILT  
454003595


STATUS: Release  
STATUS DATE: 03/06/2018  
DS APPROVED: RDCHAMP  
VER: AB REV: 48 SIZE: F

BURNS & ROE

2010 SH 3

- NOTES:
- BOLD LINES DENOTE TRUNK-LINES 2" AND LARGER
  - CB IS PRIMARY CONTAINMENT BOUNDARY
  - WHERE LINES INTERCONNECT AND ARE CONTINUED ON OTHER DRAWINGS, ZONE NUMBERS ARE APPROXIMATE ONLY.

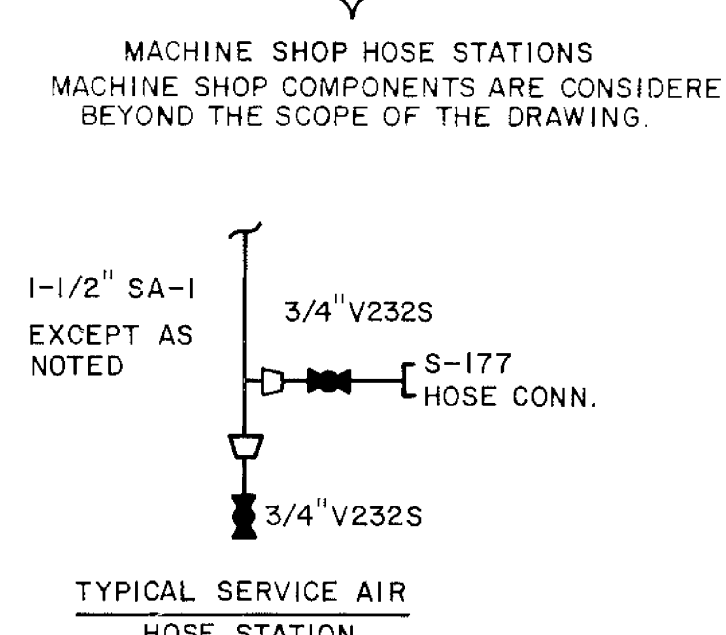

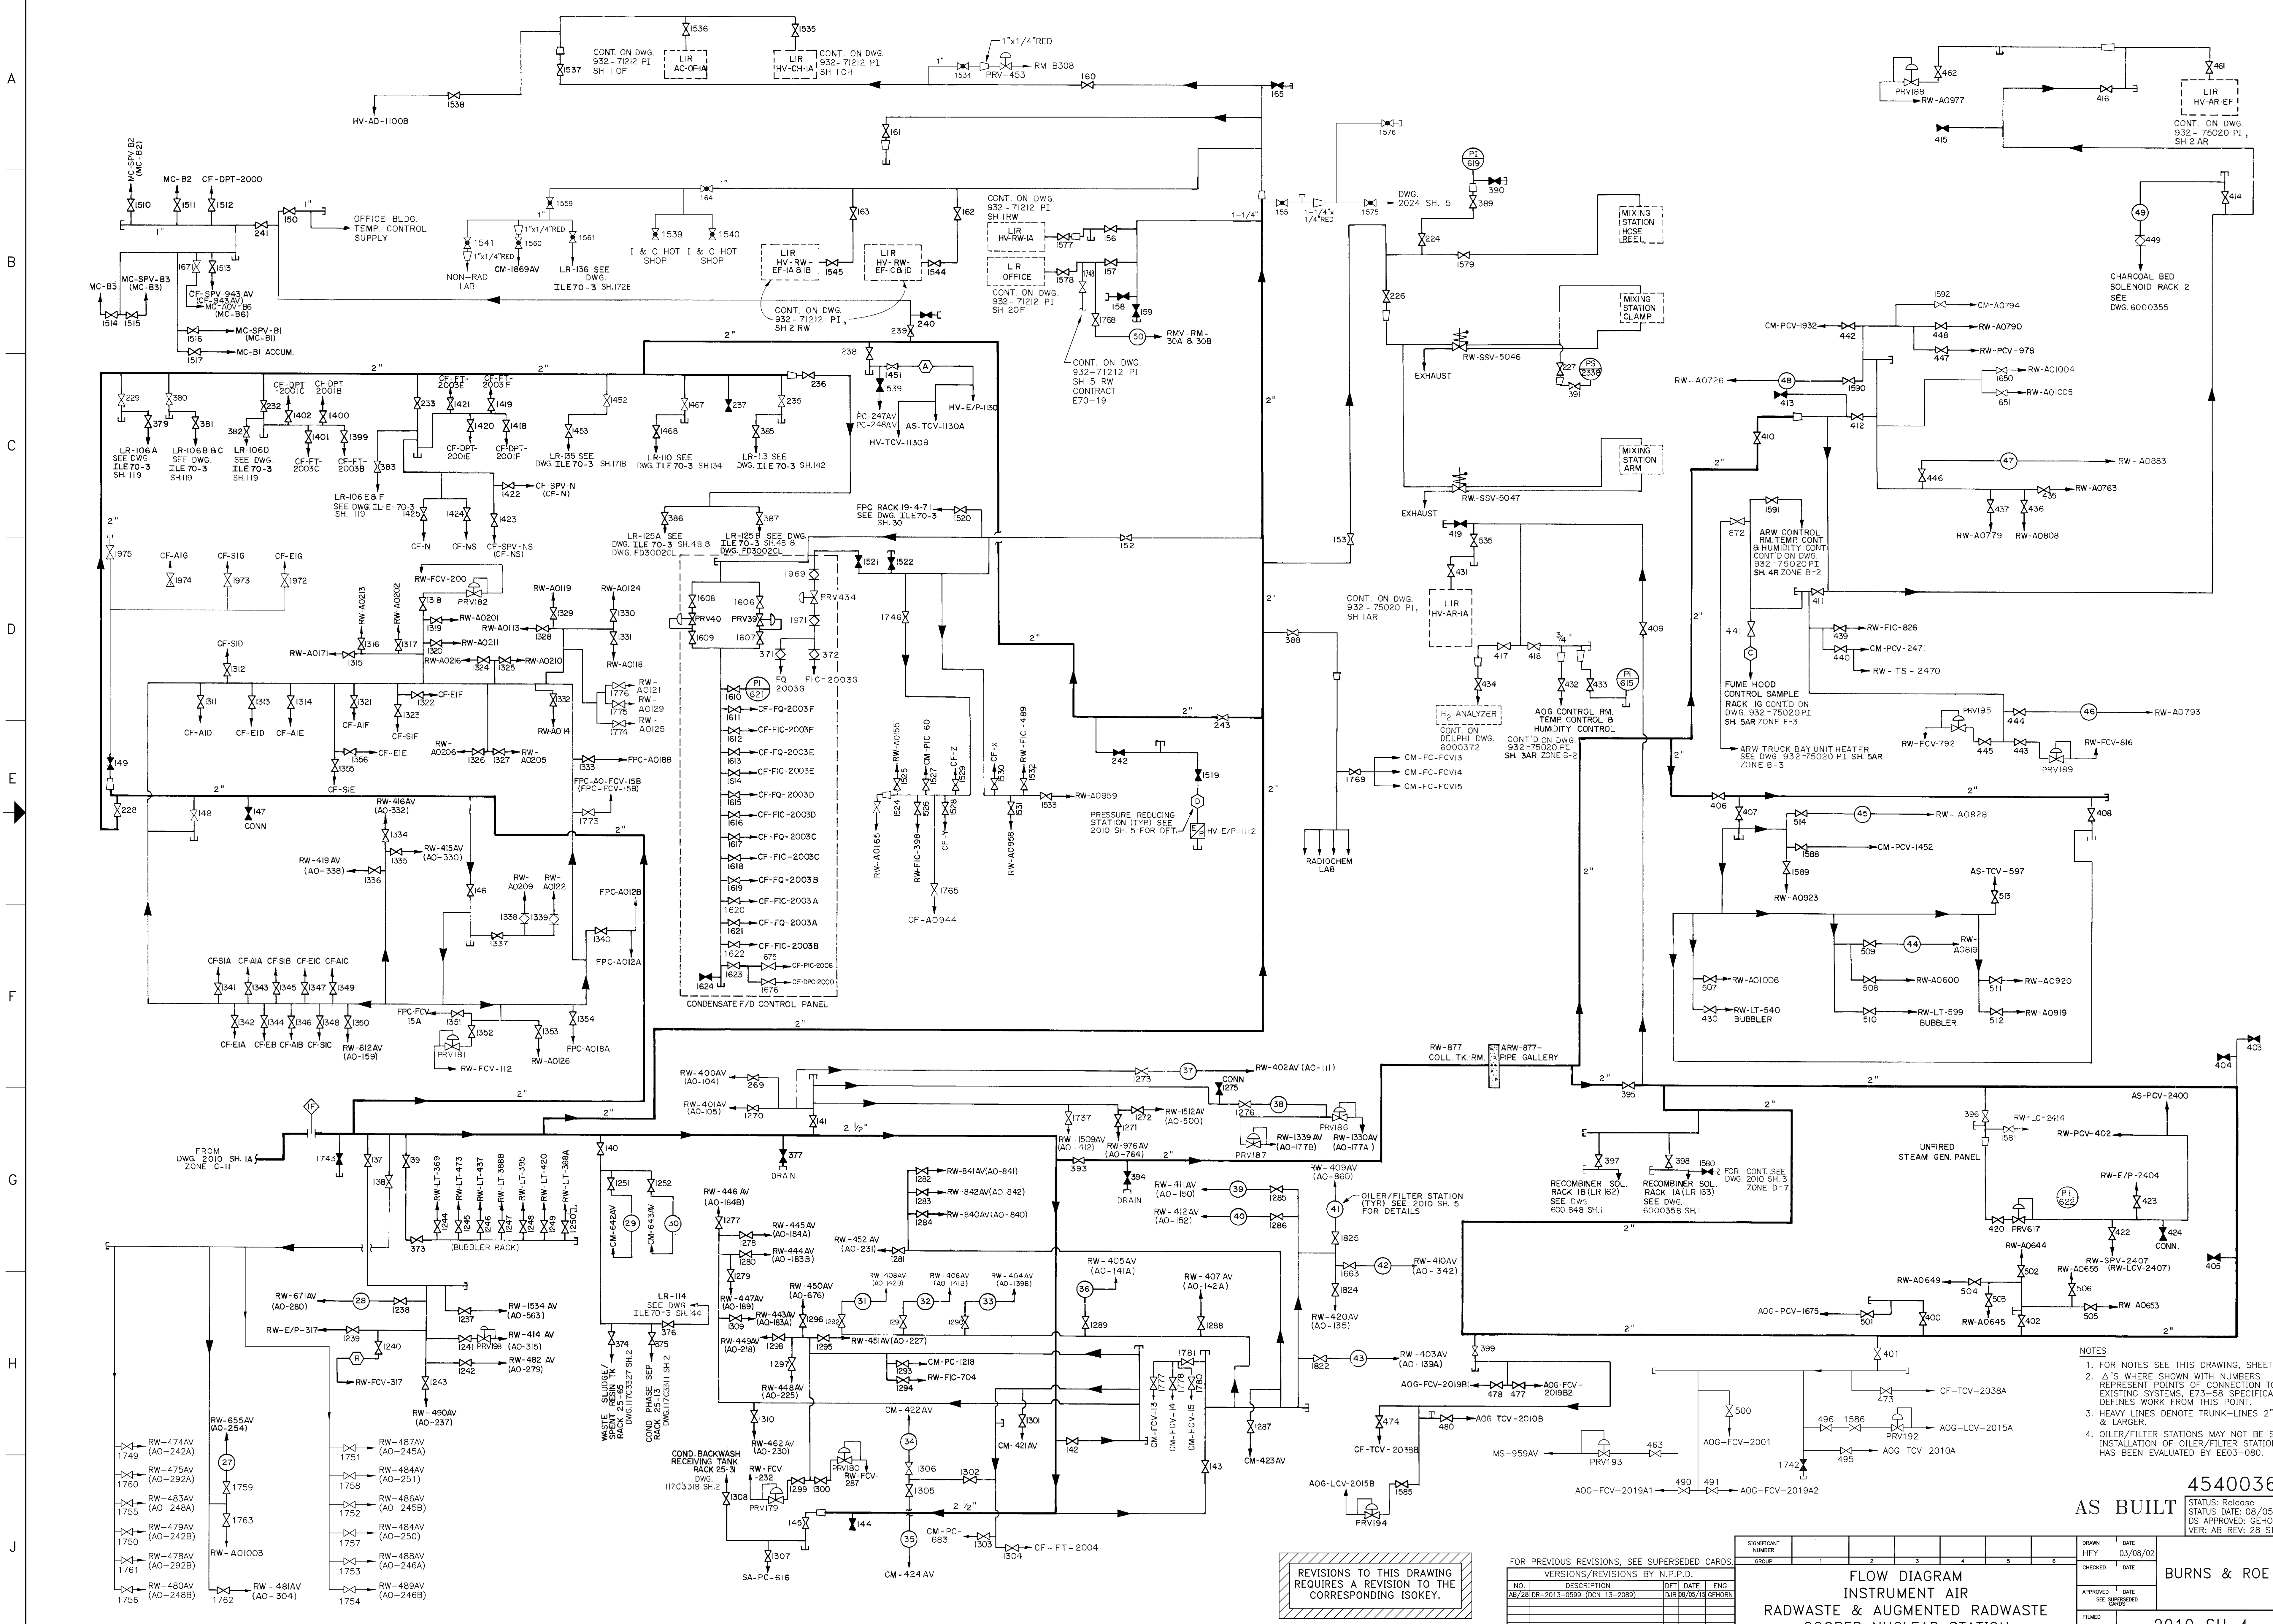

- NOTES
1. FOR NOTES SEE THIS DRAWING, SHEET 1.
  2. Δ'S WHERE SHOWN WITH NUMBERS REPRESENT POINTS OF CONNECTION TO EXISTING SYSTEMS, E73-58 SPECIFICATION DEFINES WORK FROM THIS POINT.
  3. HEAVY LINES DENOTE TRUNK-LINES 2" & LARGER.
  4. OILER/FILTER STATIONS MAY NOT BE SHOWN. INSTALLATION OF OILER/FILTER STATIONS HAS BEEN EVALUATED BY E03-080.

REVISIONS TO THIS DRAWING  
REQUIRES A REVISION TO THE  
CORRESPONDING ISOKEY.

FOR PREVIOUS REVISIONS, SEE SUPERSEDED CARDS

VERSIONS/REVISIONS BY N.P.D.			
NO.	DESCRIPTION	DATE	ENG.
AB/28	DR-2013-0599 (DCN 13-2089)	DJB/08/05/18	GEHORN

SIGNIFICANT NUMBER	DATE						DRAWN	DATE	CHECKED	DATE	APPROVED	DATE
	1	2	3	4	5	6						
							HFY	03/08/02				

**FLOW DIAGRAM  
INSTRUMENT AIR  
RADWASTE & AUGMENTED RADWASTE  
COOPER NUCLEAR STATION**


**AS BUILT** STATUS: Release  
STATUS DATE: 08/05/2015  
DS APPROVED: GEHORN  
VER: AB REV: 28 SIZE: F

**BURNS & ROE**


2010 SH 4

454003666



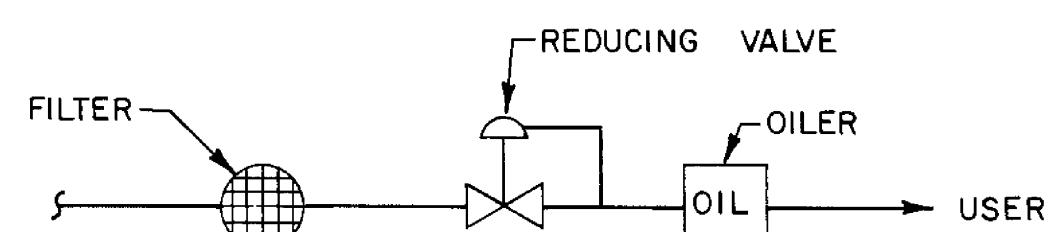

**TYPICAL OILER / FILTER STATION**

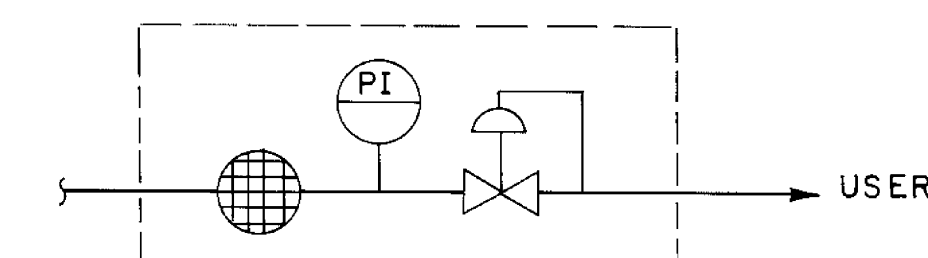

**PRESSURE REDUCING STATION**

STATION #	FILTER	PRV	OILER	2010 SHT.	NOTES
1	F-769 AV	PRV769	N/A	2	
2	N/A	PRV772	N/A		
3	F-768 AV	PRV768	N/A		
4	N/A	PRV771	N/A		
5	F-263	N/A	LUB-263 AV		
6	F-265		LUB-265 AV		
7	F-267		LUB-267 AV		
8	F-269	N/A	LUB-269 AV		
9	F-736 AV	PRV 84	N/A		
10	F-738 AV	PRV 85			
11	F-739	PRV 62			
12	F-737	PRV 61	N/A		
13		PRV 151			
14	F-1332AV	PRV 165	LUB-1332AV	2	
15	F-10	PRV 2690	LUB-11	3	A
16	F-11	PRV 2691	LUB-12		
17	F-7	N/A	LUB-6		
18	F-8		LUB-7		
19	F-6		LUB-9		
20	F-5		LUB-8		
21	F-4		LUB-3		
22	F-3		LUB-2		
23	F-2	N/A	LUB-1	3	A
24	DELETED				
25	F-45	PRV 131	N/A	1	
26	F-LMC	N/A	LUB-LMC	4	
27	F-655AV		LUB-655 AV	1	
28	F-671 AV		LUB-671 AV		
29	F-642AV		LUB-642AV		
30	F-643AV		LUB-643AV		
31	F-408AV		LUB-408AV		
32	F-406AV		LUB-406AV		
33	F-404AV		LUB-404AV		
34	F-422AV		LUB-422AV		
35	F-424AV		LUB-424AV		
36	F-405AV		LUB-405AV		
37	F-402AV		LUB-402AV		
38	F-1330AV		LUB-1330 AV		
39	F-411AV		LUB-411AV		
40	F-412AV		LUB-412AV		
41	F-409AV		LUB-409AV		
42	F-410 AV		LUB-410 AV		
43	F-403AV	N/A	LUB-403AV		
44	F-978AV	PRV 81	LUB-A0819		
45	F-966AV	PRV 83	LUB-A0828		
46	F-980AV	PRV 82	LUB-A0793		
47	F-740	PRV 619	N/A		
48	F-984AV	PRV 80	LUB-A0726		
49	N/A	N/A	LUB-SR2		
50	F-30AB	PRV 618	N/A	1	
51	F-56	N/A	N/A	3	A
52	F-9	N/A	N/A	3	A
53	F-767 / 770AV	N/A	N/A	2	
54	F-PAS	PRV36	N/A	2	
56	F-NHR	PRVNHR	N/A	1	
57	F-31	PRV113	N/A	1	
58	F-9	PRV 2689	N/A	3	A
59	F-740AV	PRV740	N/A	2	C,D
60	F-741AV	PRV741	N/A	2	C,D
61	F-68	FREG 19	LUB-55	3	A
62	F-69	FREG 20	LUB-56	3	A

THIS TABLE DOES NOT INCLUDE ALL OILER/FILTER STATIONS. INSTALLATION OF OILER/FILTER STATIONS HAS BEEN EVALUATED BY EE 03-080.

REVISION 1 TO ENGINEER EVALUATION EE 03-080 AUTHORIZES SECURING, DRAINING AND MAINTAINING EMPTY ALL CNS AOV OILERS.

STATION #	CIC NUMBER	2010 SHT.
A	HV-PC-(AC-RW-1B)	4
C	HV-PC-(EF-AR-1C)	4
D	HV-PC-ARW	4
E	HV-PC-(FC-C-1A)	1A
F	HV-PC-(FC-CH-1A)	1
G	HV-PC-(AC-CCL-1A)	
H	HV-PC-(EF-MS-1F)	
I	HV-PC-(EF-MS-1G)	
K	HV-PC-(AC-T-1A)	
L	HV-PC-(EF-T-1E)	
M	HV-PC-(RF-T-1A/1B)	1
N	HV-PC-(EF-R-1E)	2
P	HV-PC-(EF-R-1F)	2
R	IA-PC-317	4

**NOTES**


- A. DEVICES ASSOCIATED WITH THIS STATION BELONG TO THE SA SYSTEM.
- B. REF. DWG. INGERSOL RAND I0750K\* F-28389-D.
- C. LOCATIONS OF FILTER & REDUCING VALVE ARE REVERSED.
- D. E70-19 BOUNDARY IS AT THE REDUCING VALVE'S OUTLET.

AS BUILT

454237341

STATUS: Release  
 STATUS DATE: 01/31/2018  
 DS APPROVED: JAFORBE  
 VER: AD REV: 25 SIZE: F

FOR PREVIOUS REVISIONS, SEE SUPERSEDED CARDS.						GROUP	1	2	3	4	5	6	DRAWN	DATE	03/08/02
VERSIONS/REVISIONS BY N.P.P.D.						NO.	DESCRIPTION	DFT	DATE	ENG			CHECKED	DATE	
						AB/23	DR 2013-0591_454237341		08/22/13	JEGASS			APPROVED	DATE	
						PC/24	DR 2015-0092		08/12/15	JAFORBE			DATE	DATE	
						AD/25	DR 2017-0482		08/17/18	JAFORBE			DATE	DATE	
						COOPER NUCLEAR STATION FLOW DIAGRAM INSTRUMENT & SERVICE AIR MISCELLANEOUS DETAILS						BURNS & ROE			
						2010 SH 5						2010 SH 5			

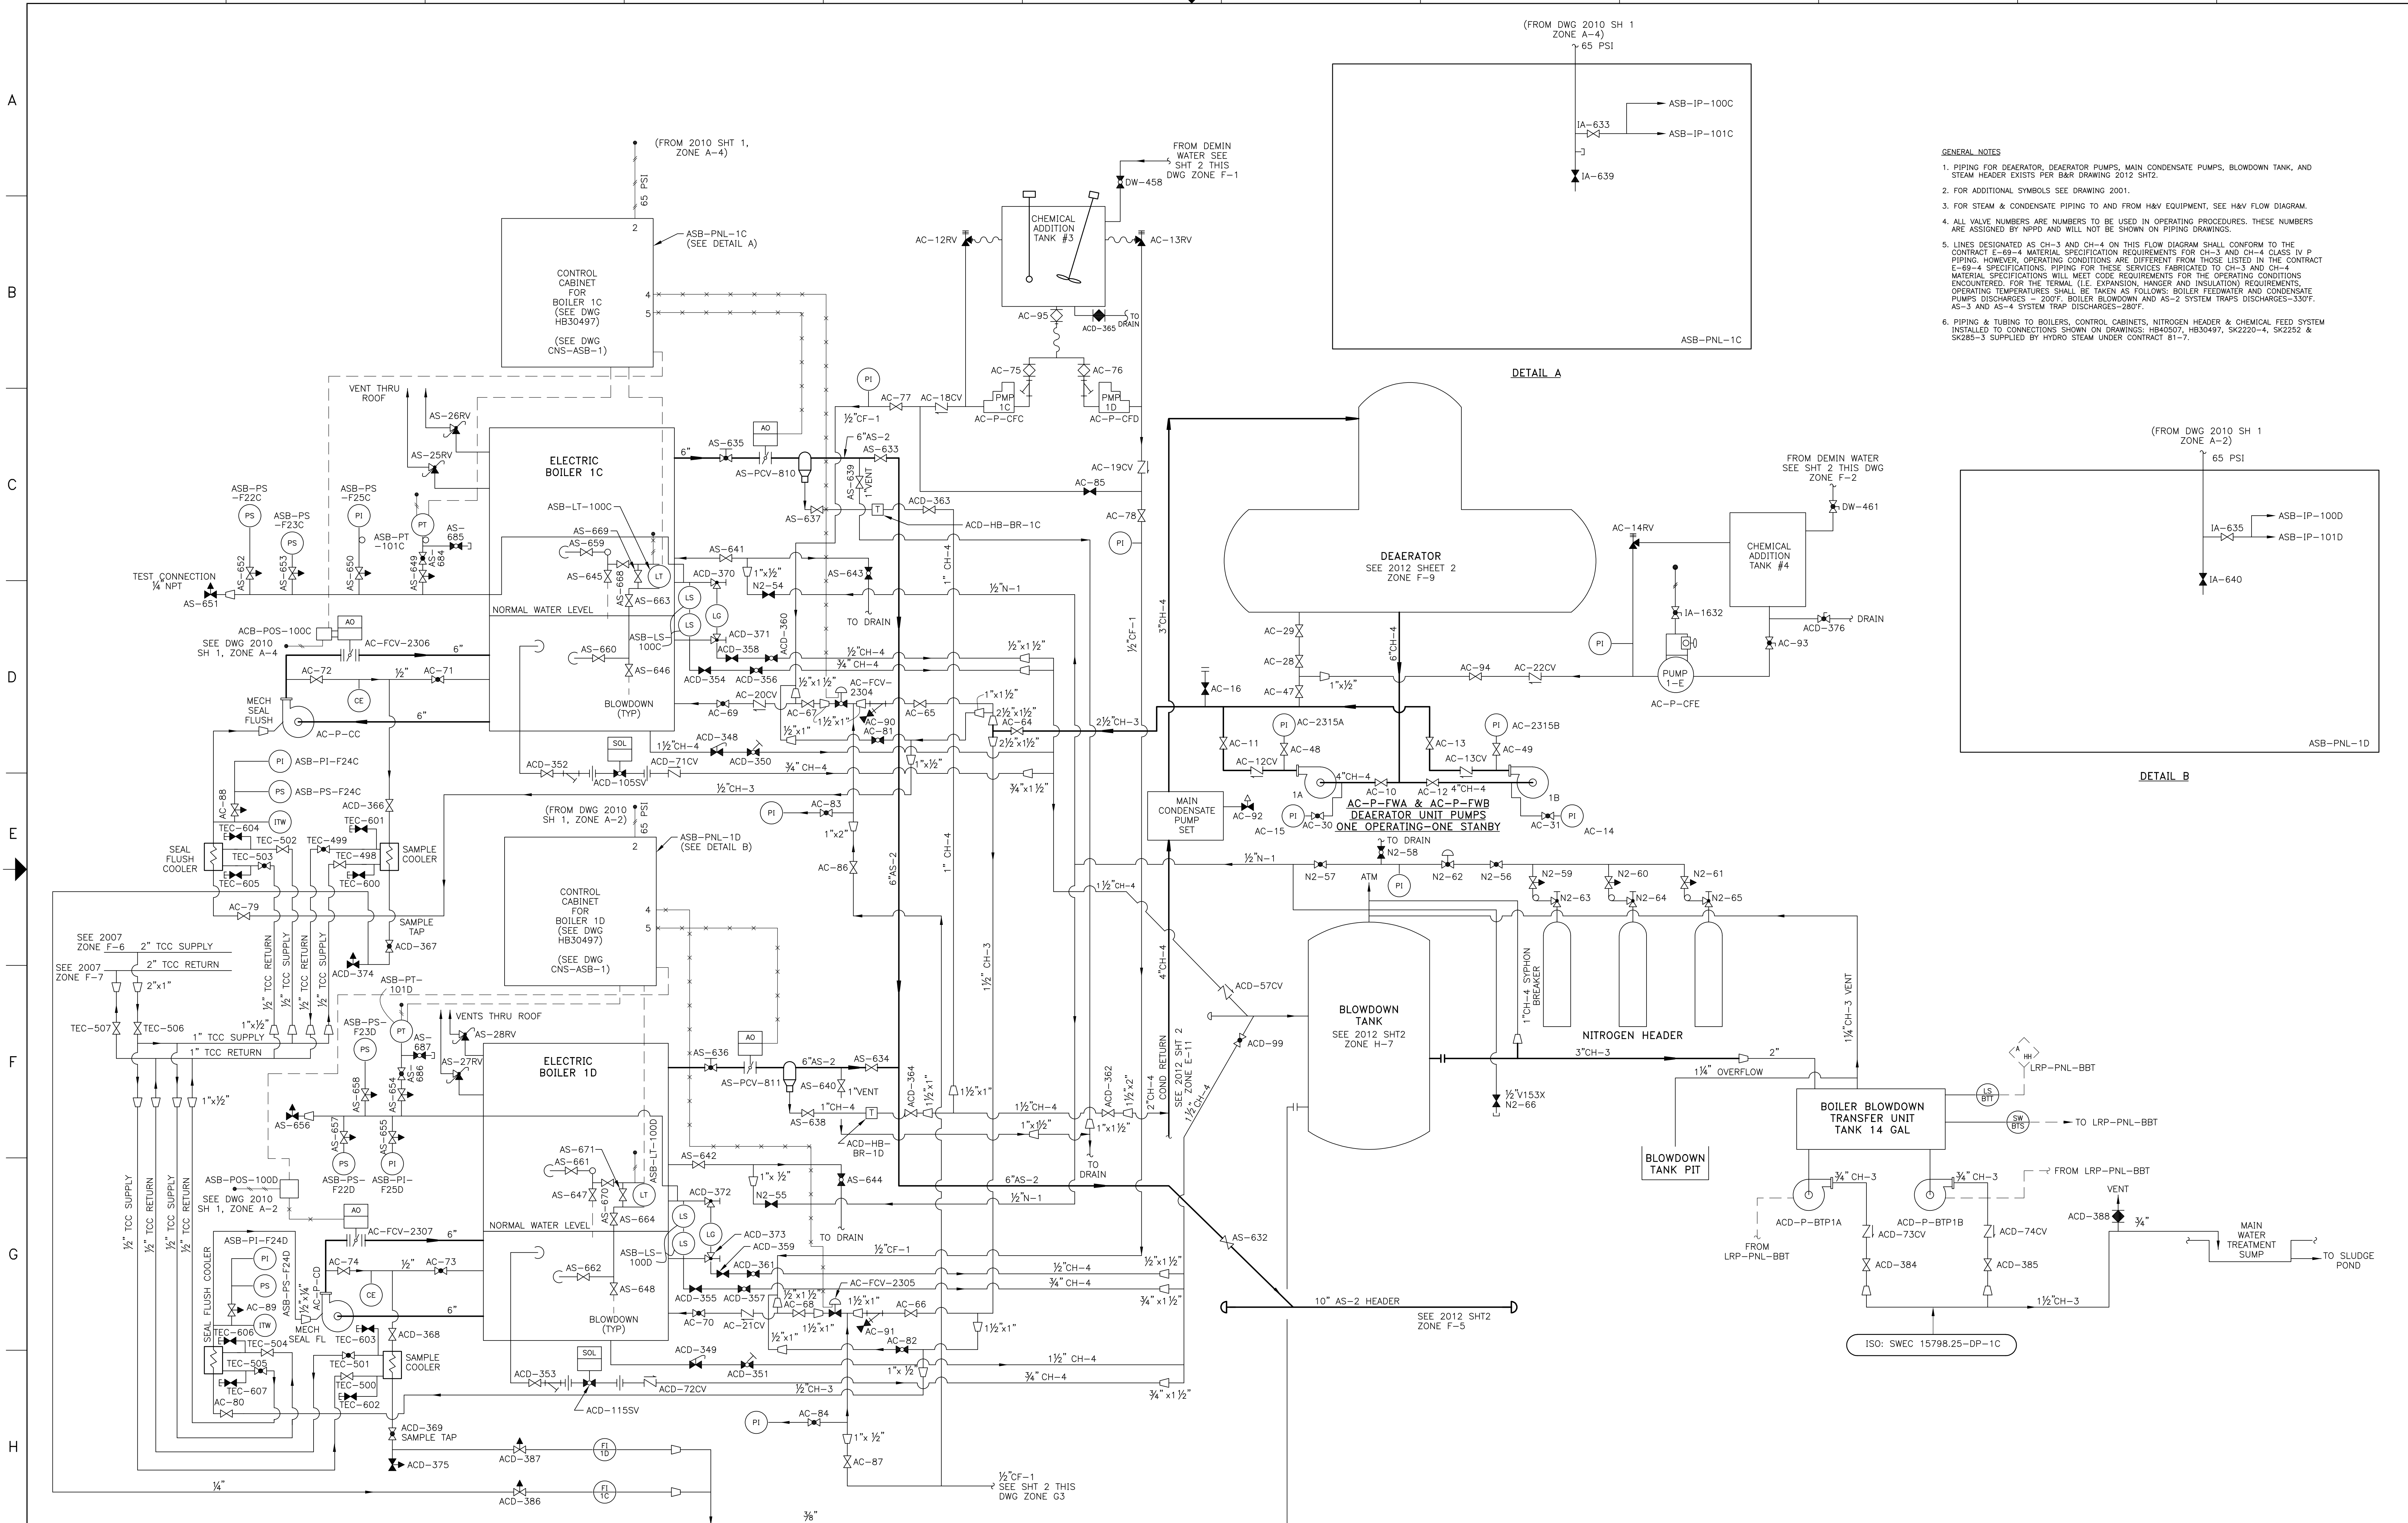

- GENERAL NOTES**
1. PIPING FOR DEAERATOR, DEAERATOR PUMPS, MAIN CONDENSATE PUMPS, BLOWDOWN TANK, AND STEAM HEADER EXISTS PER BAR DRAWING 2012 SHT2.
  2. FOR ADDITIONAL SYMBOLS SEE DRAWING 2001.
  3. FOR STEAM & CONDENSATE PIPING TO AND FROM H&V EQUIPMENT, SEE H&V FLOW DIAGRAM.
  4. ALL VALVE NUMBERS ARE NUMBERS TO BE USED IN OPERATING PROCEDURES. THESE NUMBERS ARE ASSIGNED BY NPPD AND WILL NOT BE SHOWN ON PIPING DRAWINGS.
  5. LINES DESIGNATED AS CH-3 AND CH-4 ON THIS FLOW DIAGRAM SHALL CONFORM TO THE CONTRACT E-69-4 MATERIAL SPECIFICATION REQUIREMENTS FOR CH-3 AND CH-4 CLASS IV P PIPING. HOWEVER, OPERATING CONDITIONS ARE DIFFERENT FROM THOSE LISTED IN THE CONTRACT E-69-4 SPECIFICATIONS. PIPING FOR THESE SERVICES FABRICATED TO CH-3 AND CH-4 MATERIAL SPECIFICATIONS WILL MEET CODE REQUIREMENTS FOR THE OPERATING CONDITIONS ENCOUNTERED. FOR THE TERNAL (I.E. EXPANSION, HANGER AND INSULATION) REQUIREMENTS, OPERATING TEMPERATURES SHALL BE TAKEN AS FOLLOWS: BOILER FEEDWATER AND CONDENSATE PUMPS DISCHARGES - 200F; BOILER BLOWDOWN AND AS-2 SYSTEM TRAPS DISCHARGES-330F; AS-3 AND AS-4 SYSTEM TRAP DISCHARGES-280F.
  6. PIPING & TUBING TO BOILERS, CONTROL CABINETS, NITROGEN HEADER & CHEMICAL FEED SYSTEM INSTALLED TO CONNECTIONS SHOWN ON DRAWINGS: HB40507, HB30497, SK2220-4, SK2252 & SK285-3 SUPPLIED BY HYDRO STEAM UNDER CONTRACT 81-7.

**AS BUILT**  
**454204639**  
 STATUS: Release  
 STATUS DATE: 09/29/2015  
 DS APPROVED: AJFISK  
 VER: AB REV: 23 SIZE: F

FOR PREVIOUS REVISIONS, SEE SUPERSEDED CARDS.

VERSIONS/REVISIONS BY N.P.P.D.			
NO.	DESCRIPTION	DFTI	DATE
AB/23	DR-2015-0267	DUB	09/29/15

SIGNIFICANT NUMBER	GROUP	1	2	3	4	5	6


DRAWN	DATE	8/3/04
CHECKED	DATE	
APPROVED	DATE	
FILED	DATE	

**BURNS & ROE**

**2012 SH 3**

**FLOW DIAGRAM**  
**ELECTRIC HEATING BOILER SYSTEM**  
**COOPER NUCLEAR STATION**

30036737

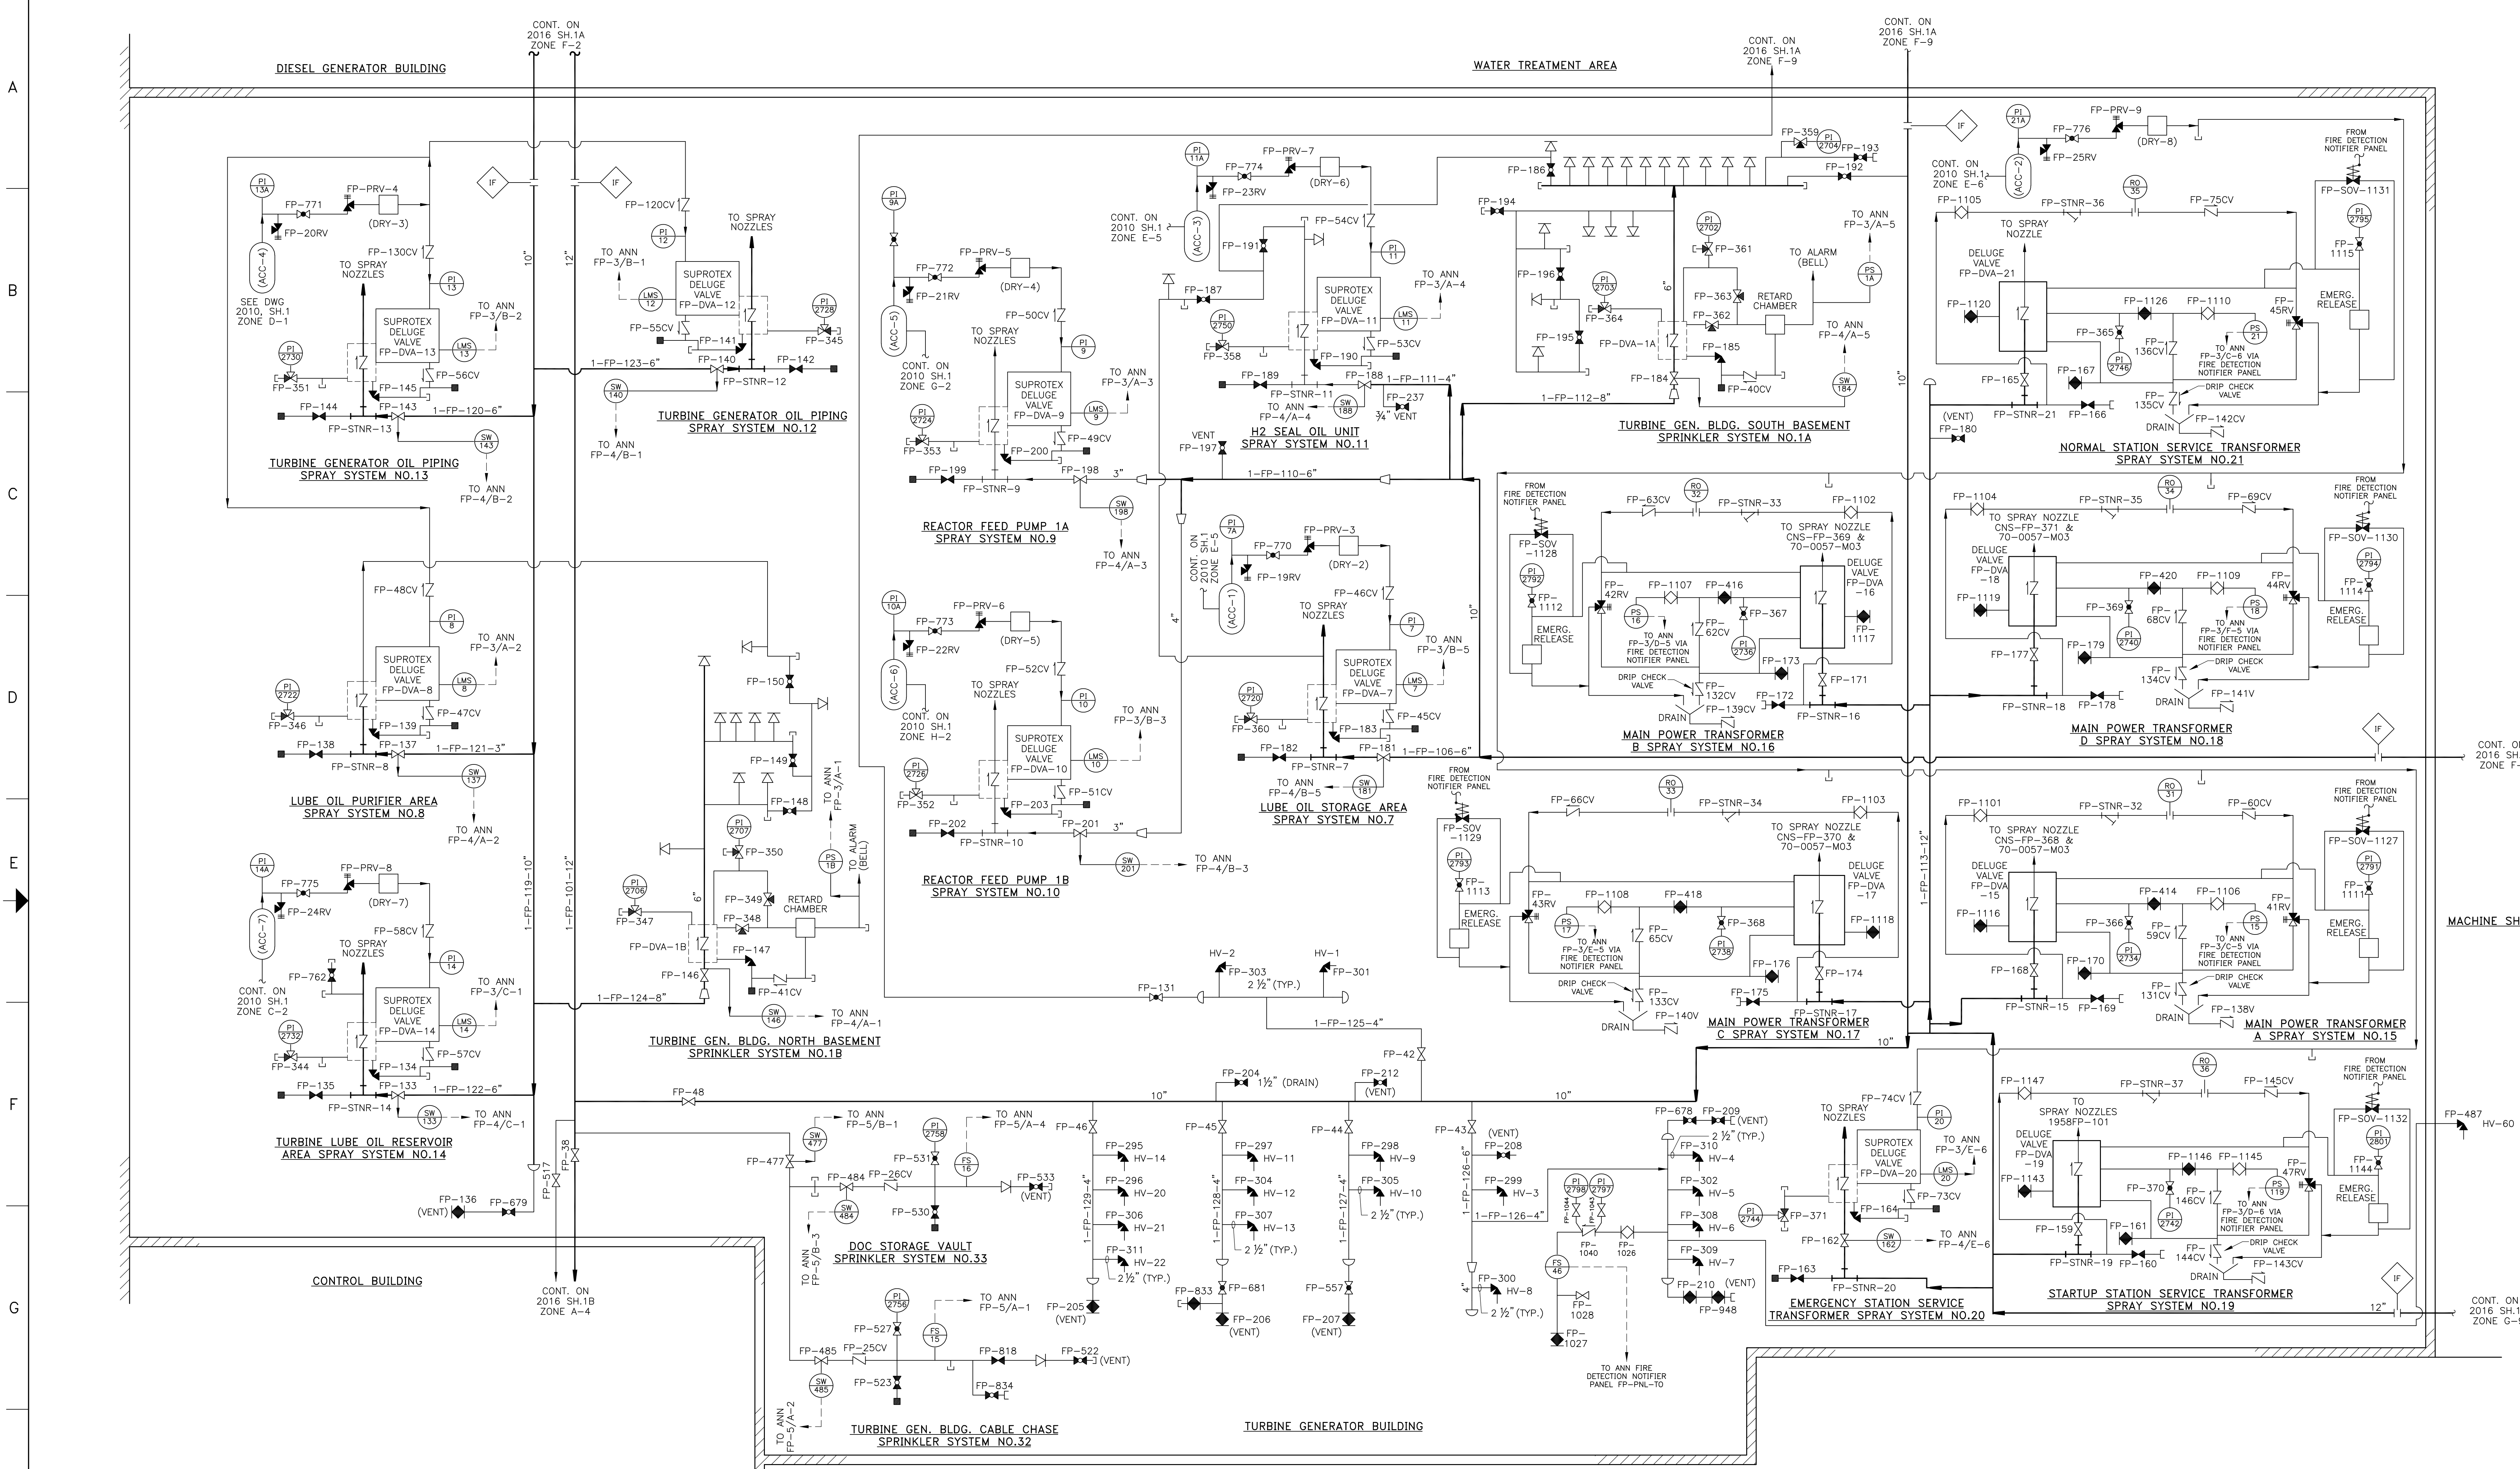

REFERENCE DWGS BY ASCOA SPRINKLER & SPRAY SYSTEMS

SYSTEM NO	ASCOA DWG NUMBER
1A	34-1243SH - SHT 1,2
1B	34-1243SH - SHT 3
2	34-1243SH - SHT 6
3	34-1243SH - SHT 6
4	34-1243SH - SHT 12
5	34-1243SH - SHT 13
6	34-1243SH - SHT 13
7	34-1243SH - SHT 1,4
8	34-1243SH - SHT 2,3,4
9	34-1243SH - SHT 2
10	34-1243SH - SHT 2
11	34-1243SH - SHT 1,4
12	34-1243SH - SHT 5,12
13	34-1243SH - SHT 6,12
14	34-1243SH - SHT 5,7
15	34-1243SH - SHT 8,9,10
16	34-1243SH - SHT 8,9,10
17	34-1243SH - SHT 8,9,10
18	34-1243SH - SHT 8,9,10
19	F.E. MORAN DWGS. 1958FP-101, 1958FP-102
20	34-1243SH - SHT 8,10,11
21	34-1243SH - SHT 8,11,1
22	34-1243SH - SHT 18
23	34-1243SH - SHT 18

NOTES:

- UNLESS OTHERWISE SHOWN, ALL PIPING ON THIS DIAGRAM IS DESIGNATED "FP-1".
- ALL PIPING SYSTEM FABRICATION SHALL BE PER THE CLASSIFICATION SHOWN ON THE MATERIAL SPECIFICATION SHEETS AND SPECIFICATION E-69-4.
- ALL VALVES IN FP-1 SHALL BE 175# F.U. SPECIAL.
- SUFFIX (PI) DESIGNATES POST INDICATOR VALVE.
- AUTOMATIC SPRINKLER CORPORATION OF AMERICA ABBREVIATED AS ASCOA WHEN IDENTIFYING SPRINKLER AND SPRAY SYSTEMS DRAWING NUMBERS.
- REACTOR BUILDING AND CONTROL BUILDING FIRE PROTECTION PIPING SYSTEM AND SPRINKLERS ARE SUPPORTED FOR CLASS II RESTRAINED CRITERIA. INTAKE STRUCTURE FIRE PROTECTION PIPING SYSTEMS ARE SUPPORTED FOR BARGE IMPACT CRITERIA.
- ALL VALVE NUMBERS IN PARENTHESIS( ) ARE NUMBERS TO BE USED IN OPERATING PROCEDURES. THESE NUMBERS ARE ASSIGNED BY NPPD AND WILL NOT BE SHOWN ON PIPING DRAWINGS.
- VALVES ARE UNDERWRITERS APPROVED.
- △'S WHERE SHOWN WITH NUMBERS REPRESENT POINTS OF CONNECTION TO EXISTING SYSTEMS E-73-58 SPECIFICATION DEFINES WORK FROM THIS POINT.
- ALL VALVES ARE IN THE FIRE PROTECTION (FP) SYSTEM UNLESS DESIGNATED OTHERWISE.
- △ INDICATES ONE OR MORE SPRINKLER HEADS IN LINE.
- WHERE LINES ARE INTERCONNECTED AND CONTINUED ON OTHER DRAWINGS, ZONE NUMBERS ARE APPROXIMATE ONLY.

REVISIONS TO THIS DRAWING  
REQUIRES A REVISION TO THE  
CORRESPONDING ISOKEY.

FOR PREVIOUS REVISIONS, SEE SUPERSEDED CARDS.

NO.	DESCRIPTION	DFT DATE	ENG
AB/7010R-2014-0592		DJB/10/16/MBNIENA	


AS BUILT  
454003604  
STATUS: Release  
STATUS DATE: 10/16/2016  
DS APPROVED: MBNIENA  
VER: AB REV: 70 SIZE: F

SIGNIFICANT NUMBER	GROUP	1	2	3	4	5	6	DRAWN	DATE

FLOW DIAGRAM  
FIRE PROTECTION  
TURBINE GENERATOR BUILDING  
COOPER NUCLEAR STATION

CHECKED	DATE	APPROVED	DATE	FILED

BURNS & ROE  
2016 SH 1  
C0018087

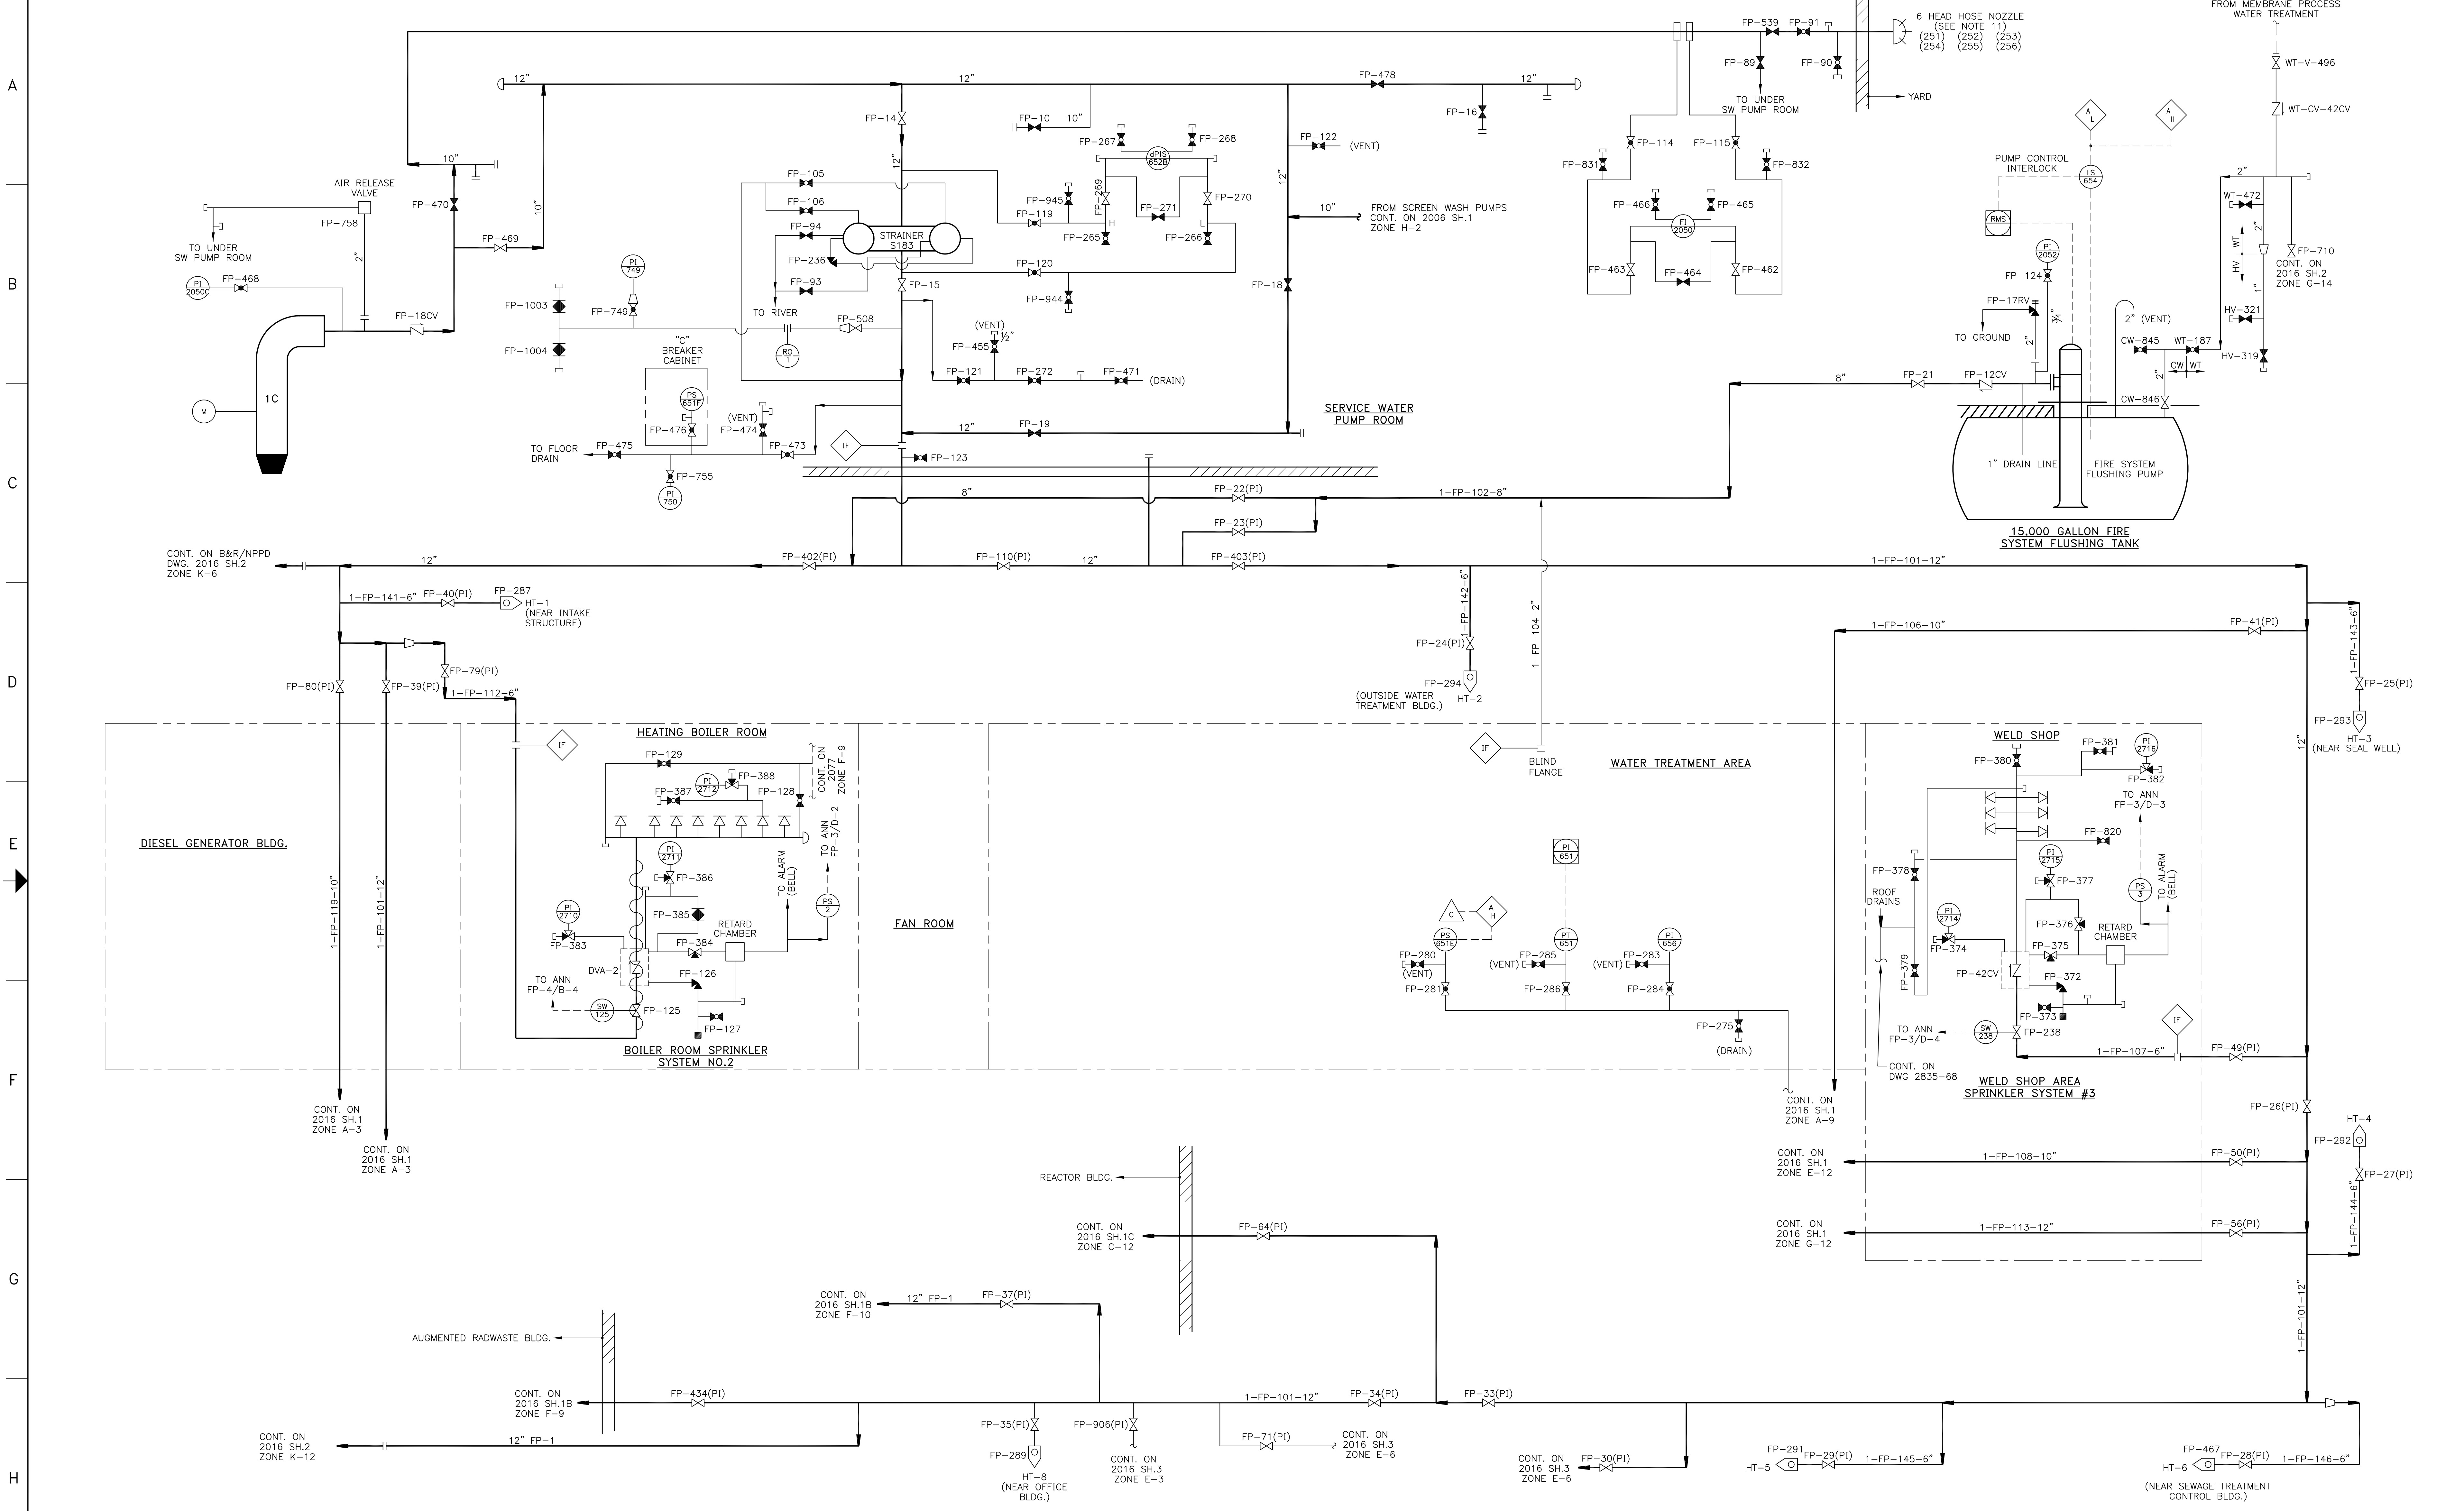

- NOTES:**
- UNLESS OTHERWISE SHOWN, ALL PIPING ON THIS DIAGRAM IS DESIGNATED "FP-1".
  - ALL PIPING SYSTEM FABRICATION SHALL BE PER THE CLASSIFICATION SHOWN ON THE MATERIAL SPECIFICATION SHEETS AND SPECIFICATION E-69-4.
  - ALL VALVES IN FP-1 SHALL BE 175# F.U. SPECIAL.
  - SUFFIX (PI) DESIGNATES POST INDICATOR VALVE.
  - AUTOMATIC SPRINKLER CORPORATION OF AMERICA ABBREVIATED AS ASCOA WHEN IDENTIFYING SPRINKLER AND SPRAY SYSTEMS DRAWING NUMBERS.
  - REACTOR BUILDING AND CONTROL BUILDING FIRE PROTECTION PIPING SYSTEM AND SPRINKLERS ARE SUPPORTED FOR CLASS 1S RESTRAINED CRITERIA. INTAKE STRUCTURE FIRE PROTECTION PIPING SYSTEMS ARE SUPPORTED FOR BARGE IMPACT CRITERIA.
  - ALL VALVE NUMBERS IN PARENTHESIS ( ) ARE NUMBERS TO BE USED IN OPERATING PROCEDURES. THESE NUMBERS ARE ASSIGNED BY NPPD AND WILL NOT BE SHOWN ON PIPING DRAWINGS.
  - VALVES ARE UNDERWRITERS APPROVED.
  - △'S WHERE SHOWN WITH NUMBERS REPRESENT POINTS OF CONNECTION TO EXISTING SYSTEMS E-73-58 SPECIFICATION DEFINES WORK FROM THIS POINT.
  - ALL VALVES ARE IN THE FIRE PROTECTION (FP) SYSTEM UNLESS DESIGNATED OTHERWISE.
  - ALL VALVES ON THE 6 HEADED HOSE NOZZLE ARE CLOSED.
  - △ INDICATES ONE OR MORE SPRINKLER HEADS IN LINE.
  - WHERE LINES ARE INTERCONNECTED AND CONTINUED ON OTHER DRAWINGS, ZONE NUMBERS ARE APPROXIMATE ONLY.
  - HEAT TRACE

REVISIONS TO THIS DRAWING  
REQUIRES A REVISION TO THE  
CORRESPONDING ISOKEY.

**AS BUILT**  
454243820

STATUS: Release  
DATE: 04/20/2016  
DS APPROVED: NEWERNE  
VER: AB REV: 09 SIZE: F

VERSIONS/REVISIONS BY N.P.P.D.				
NO.	DESCRIPTION	DFT	DATE	ENG
AB/09	OR-2016-0002		04/20/16	NEWERNE


SIGNATURE			
NO.	DATE	GROUP	INITIALS
1			
2			
3			
4			
5			
6			

FLOW DIAGRAM FIRE PROTECTION SERVICE BLDG'S & YARD COOPER NUCLEAR STATION		
CHECKED KG	DATE 5-28-99	DRAWN RGA
APPROVED DDK	DATE 6-3-99	
FILMED		

2016 SH. 1A

0018088

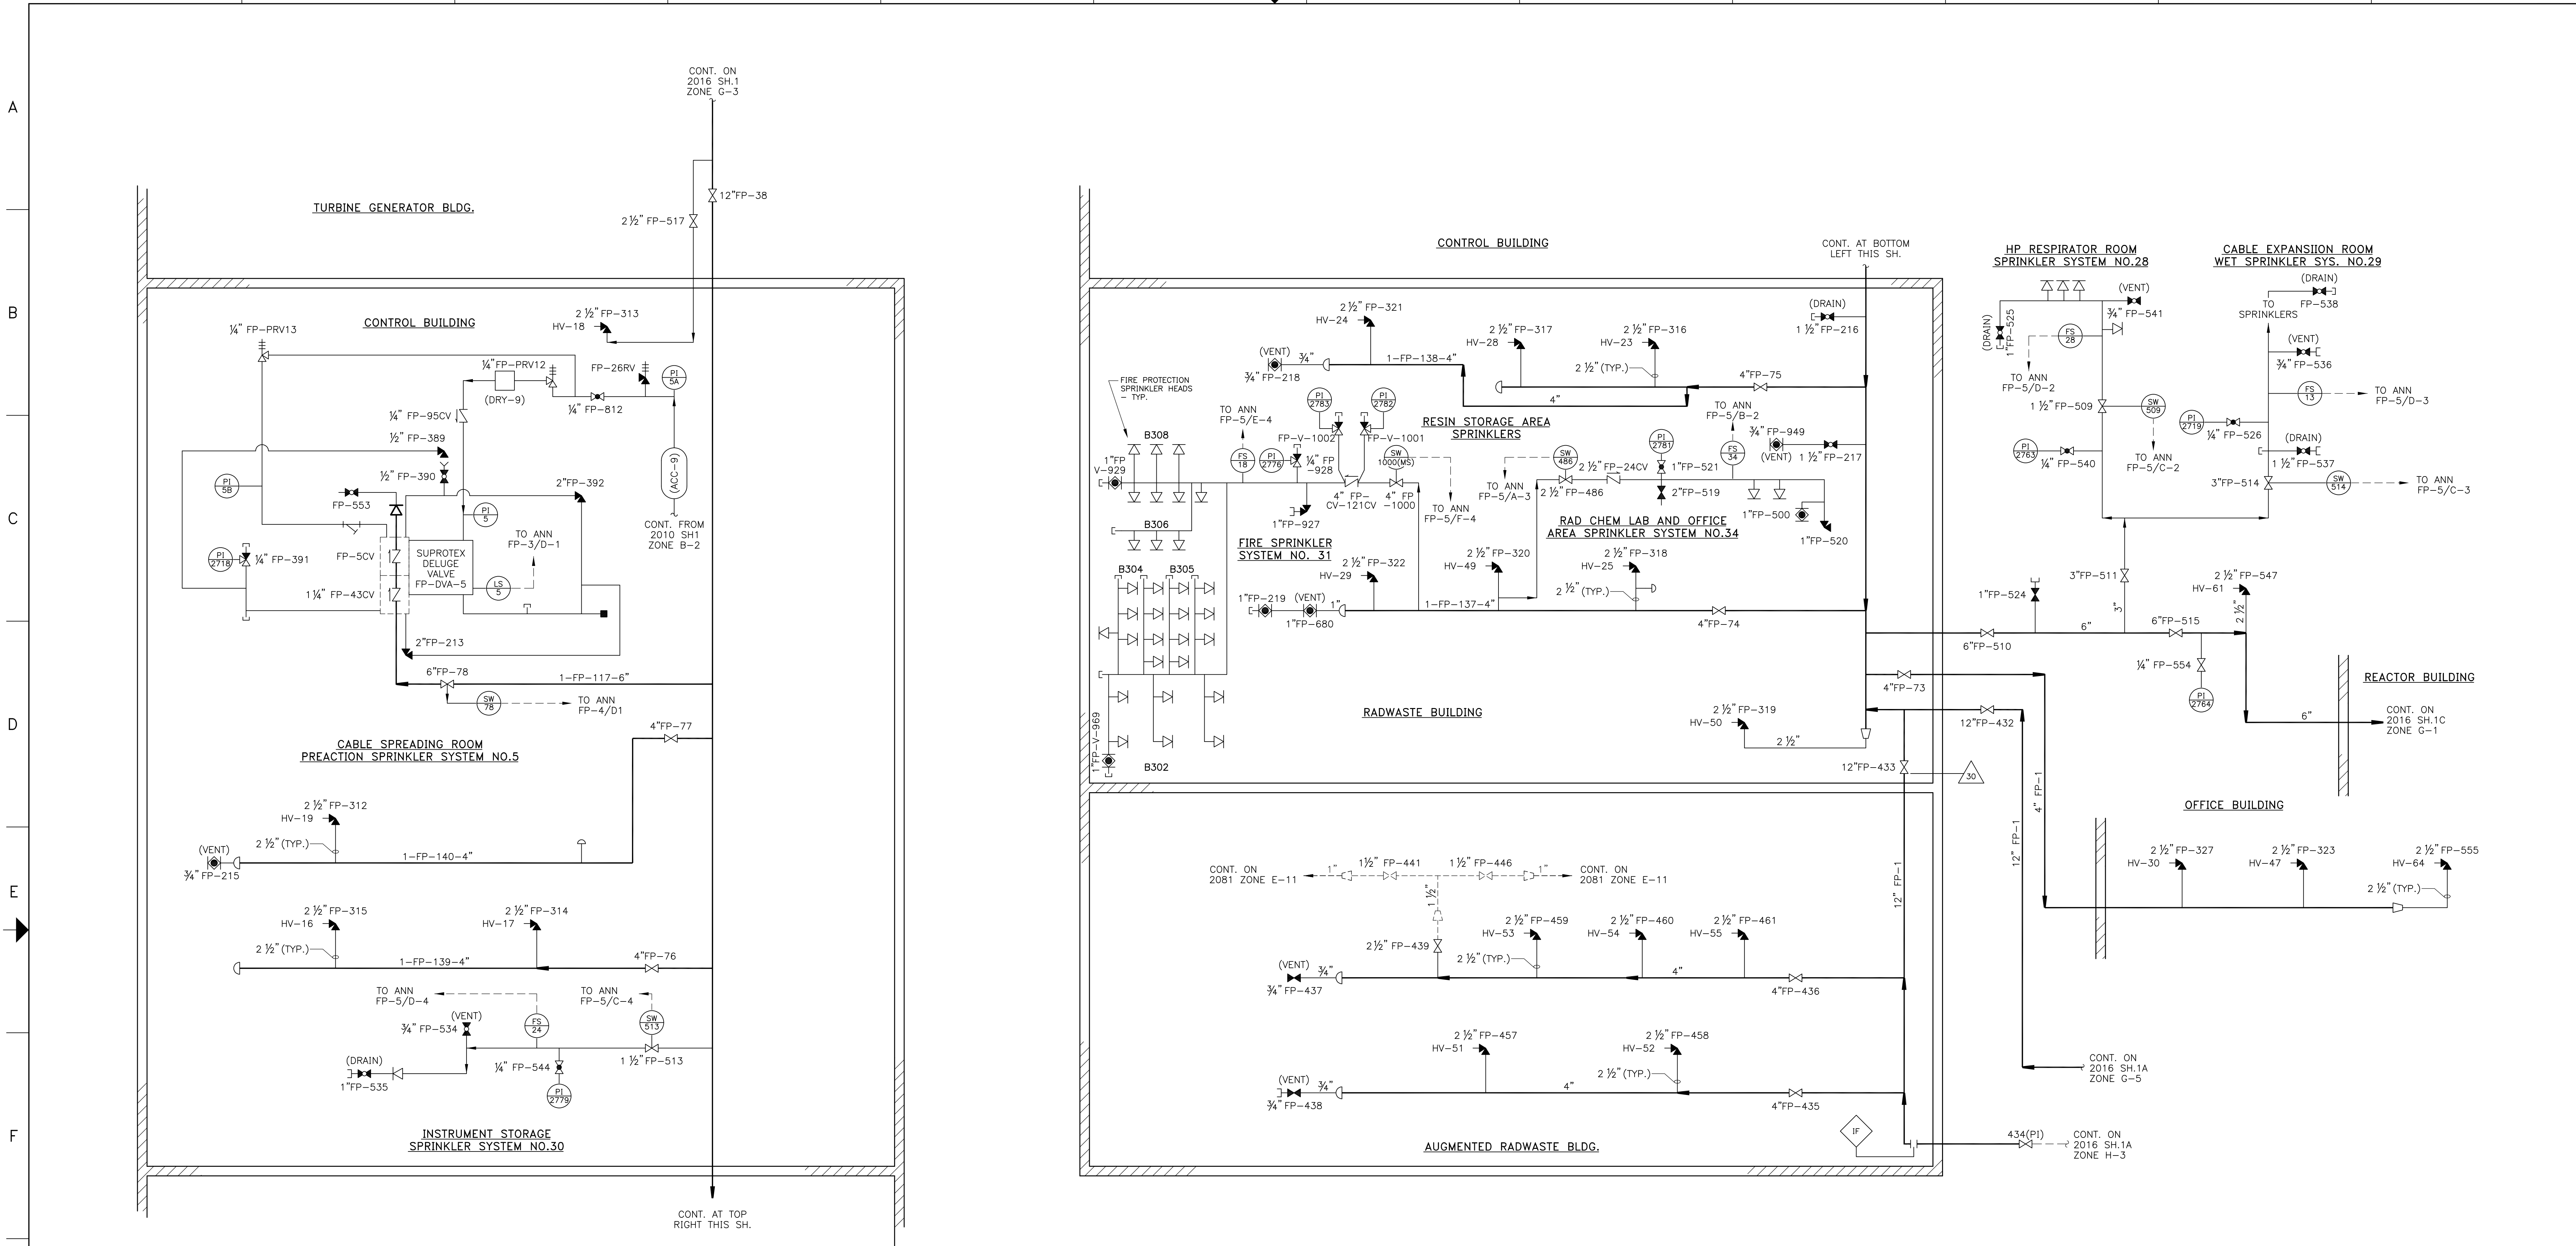

**NOTES:**

- UNLESS OTHERWISE SHOWN, ALL PIPING ON THIS DIAGRAM IS DESIGNATED "FP-1".
- ALL PIPING SYSTEM FABRICATION SHALL BE PER THE CLASSIFICATION SHOWN ON THE MATERIAL SPECIFICATION SHEETS AND SPECIFICATION E-69-4.
- ALL VALVES IN FP-1 SHALL BE 175# F.U. SPECIAL.
- SUFFIX (PI) DESIGNATES POST INDICATOR VALVE.
- AUTOMATIC SPRINKLER CORPORATION OF AMERICA ABBREVIATED AS ASCOA WHEN IDENTIFYING SPRINKLER AND SPRAY SYSTEMS DRAWING NUMBERS.
- REACTOR BUILDING AND CONTROL BUILDING FIRE PROTECTION PIPING SYSTEM AND SPRINKLERS ARE SUPPORTED FOR CLASS IS RESTRAINED CRITERIA. INTAKE STRUCTURE FIRE PROTECTION PIPING SYSTEMS ARE SUPPORTED FOR BARGE IMPACT CRITERIA.
- ALL VALVE NUMBERS IN PARENTHESIS ( ) ARE NUMBERS TO BE USED IN OPERATING PROCEDURES, THESE NUMBERS ARE ASSIGNED BY NPPD AND WILL NOT BE SHOWN ON PIPING DRAWINGS.
- VALVES ARE UNDERWRITERS APPROVED.
- △'S WHERE SHOWN WITH NUMBERS REPRESENT POINTS OF CONNECTION TO EXISTING SYSTEMS E-73-58 SPECIFICATION DEFINES WORK FROM THIS POINT.
- ALL VALVES ARE IN THE FIRE PROTECTION (FP) SYSTEM UNLESS DESIGNATED OTHERWISE.
- ▽ INDICATES ONE OR MORE SPRINKLER HEADS IN LINE.
- WHERE LINES ARE INTERCONNECTED AND CONTINUED ON OTHER DRAWINGS, ZONE NUMBERS ARE APPROXIMATE ONLY.

REVISIONS TO THIS DRAWING  
REQUIRES A REVISION TO THE  
CORRESPONDING ISOKEY.

**AS BUILT**  
454243821

STATUS: Release  
STATUS DATE: 05/08/2018  
DS APPROVED: DCWHEAT  
VER: AC REV: 05 SIZE: F

FOR PREVIOUS REVISIONS, SEE SUPERSEDED CARDS.


VERSIONS/REVISIONS BY N.P.P.D.			
NO.	DESCRIPTION	DFT	DATE
AB/04	DR-2013-0599 (DCN 13-2034)	DUR	4/22/15
AC/05	DR-2018-0001	DUR	05/08/18

SIGNIFICANT NUMBER	GROUP	1	2	3	4	5	6	7	8	9	10	11	12
GROUP	1												
DATE	6-7-95												
CHECKED	4-8-99												
APPROVED	5-25-99												
FILED													

COOPER NUCLEAR STATION  
FLOW DIAGRAM  
FIRE PROTECTION  
CONT. RDW & ARDW BLDG.'S

BURNS & ROE  
2016 SH 1B

NO. 0018089

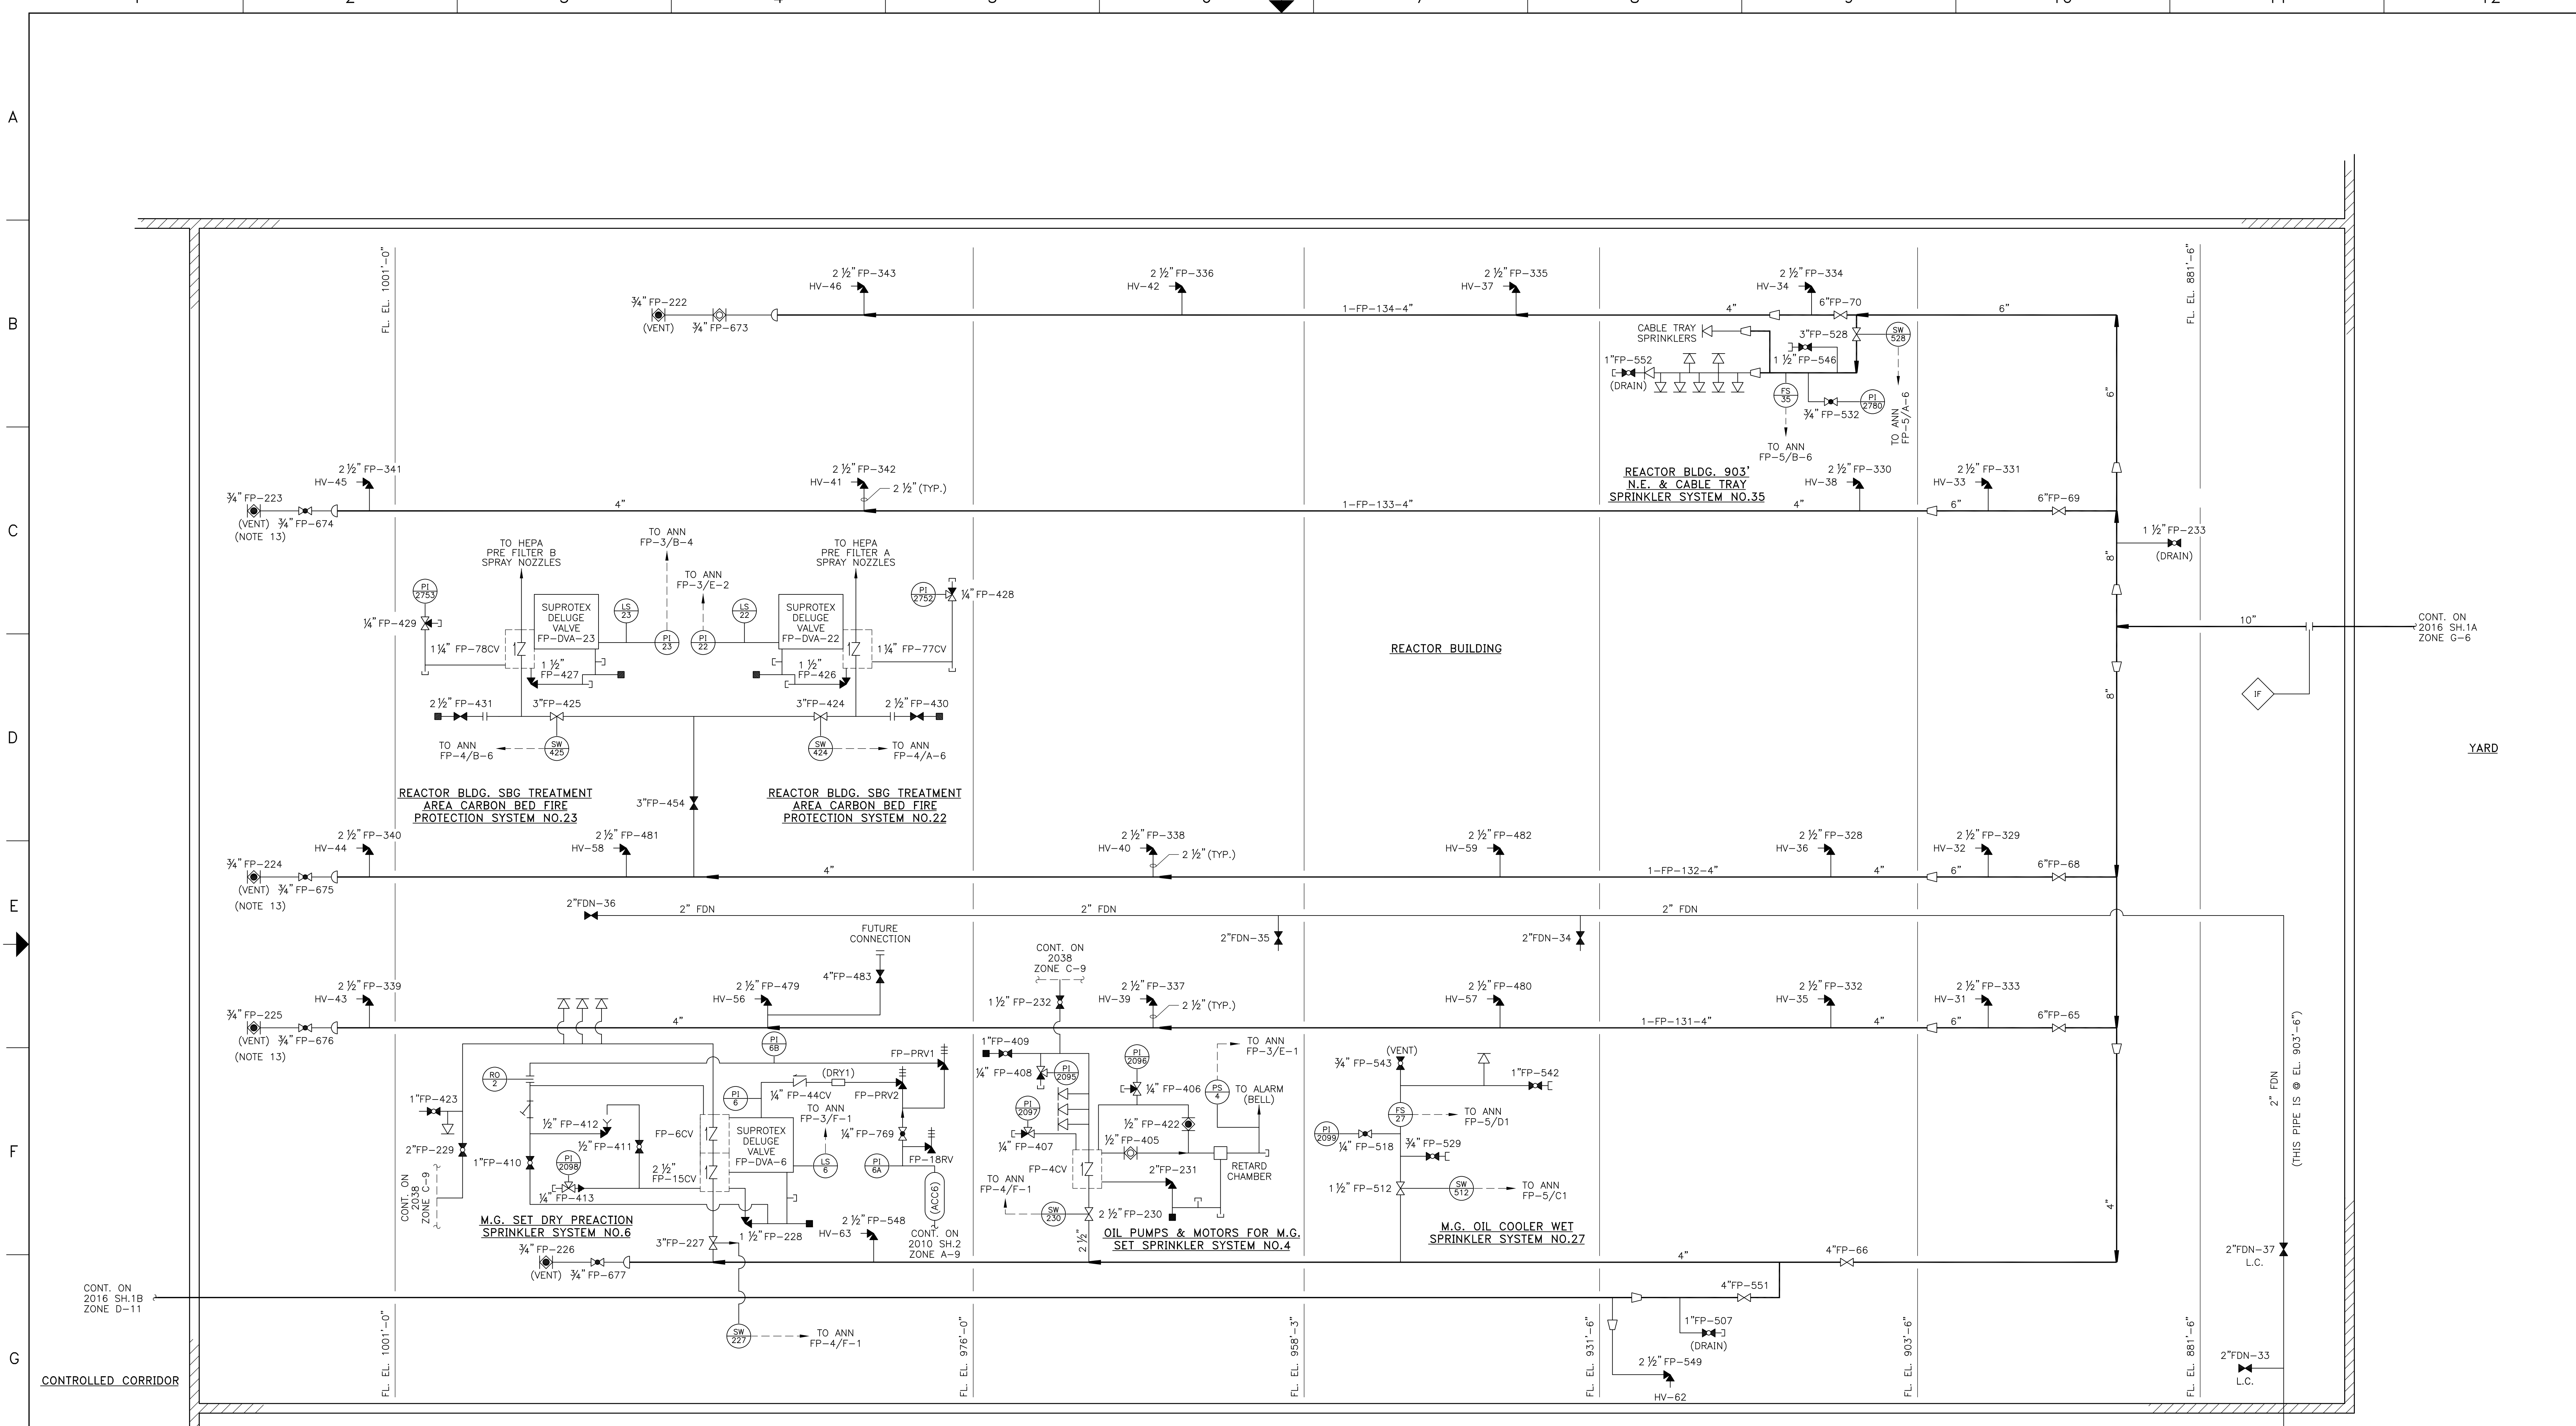

**NOTES:**

- UNLESS OTHERWISE SHOWN, ALL PIPING ON THIS DIAGRAM IS DESIGNATED "FP-1".
- ALL PIPING SYSTEM FABRICATION SHALL BE PER THE CLASSIFICATION SHOWN ON THE MATERIAL SPECIFICATION SHEETS AND SPECIFICATION E-69-4.
- ALL VALVES IN FP-1 SHALL BE 175# F.U. SPECIAL.
- SUFFIX (PI) DESIGNATES POST INDICATOR VALVE.
- AUTOMATIC SPRINKLER CORPORATION OF AMERICA ABBREVIATED AS ASCOA WHEN IDENTIFYING SPRINKLER AND SPRAY SYSTEMS DRAWING NUMBERS.
- REACTOR BUILDING AND CONTROL BUILDING FIRE PROTECTION PIPING SYSTEM AND SPRINKLERS ARE SUPPORTED FOR CLASS II RESTRAINED CRITERIA. INTAKE STRUCTURE FIRE PROTECTION PIPING SYSTEMS ARE SUPPORTED FOR BARGE IMPACT CRITERIA.
- ALL VALVE NUMBERS IN PARENTHESIS( ) ARE NUMBERS TO BE USED IN OPERATING PROCEDURES. THESE NUMBERS ARE ASSIGNED BY NPPD AND WILL NOT BE SHOWN ON PIPING DRAWINGS.
- VALVES ARE UNDERWRITERS APPROVED.
- △'S WHERE SHOWN WITH NUMBERS REPRESENT POINTS OF CONNECTION TO EXISTING SYSTEMS E-73-58 SPECIFICATION DEFINES WORK FROM THIS POINT.
- ALL VALVES ARE IN THE FIRE PROTECTION (FP) SYSTEM UNLESS DESIGNATED OTHERWISE.
- △ INDICATES ONE OR MORE SPRINKLER HEAD IN LINE.
- WHERE LINES ARE INTERCONNECTED AND CONTINUED ON OTHER DRAWINGS, ZONE NUMBERS ARE APPROXIMATE ONLY.
- NITROGEN MAY BE PRESENT PER CED 1998-060. (REF. SER 98-003, CR 2003-2282 & EC 5174833).

REVISIONS TO THIS DRAWING  
REQUIRES A REVISION TO THE  
CORRESPONDING ISOKEY.

**AS BUILT**  
454243822

STATUS: Release  
STATUS DATE: 04/02/2018  
DS APPROVED: LJJENSE  
VER: AB REV: 04 SIZE: F

\* THIS DRAWING GENERATED BY NPPD

NO.	DESCRIPTION	DFT	DATE	ENG
AB/04	DR-2015-0578		04/02/18	LJJENSE


GROUP	1	2	3	4	5	6
SIGNIFICANT NUMBER						

DATE	DATE	DATE	DATE
6-7-95	4-8-99	5-25-99	

\* BURNS & ROE


**FLOW DIAGRAM  
FIRE PROTECTION  
REACTOR BUILDING  
COOPER NUCLEAR STATION**

2016 SH 1C

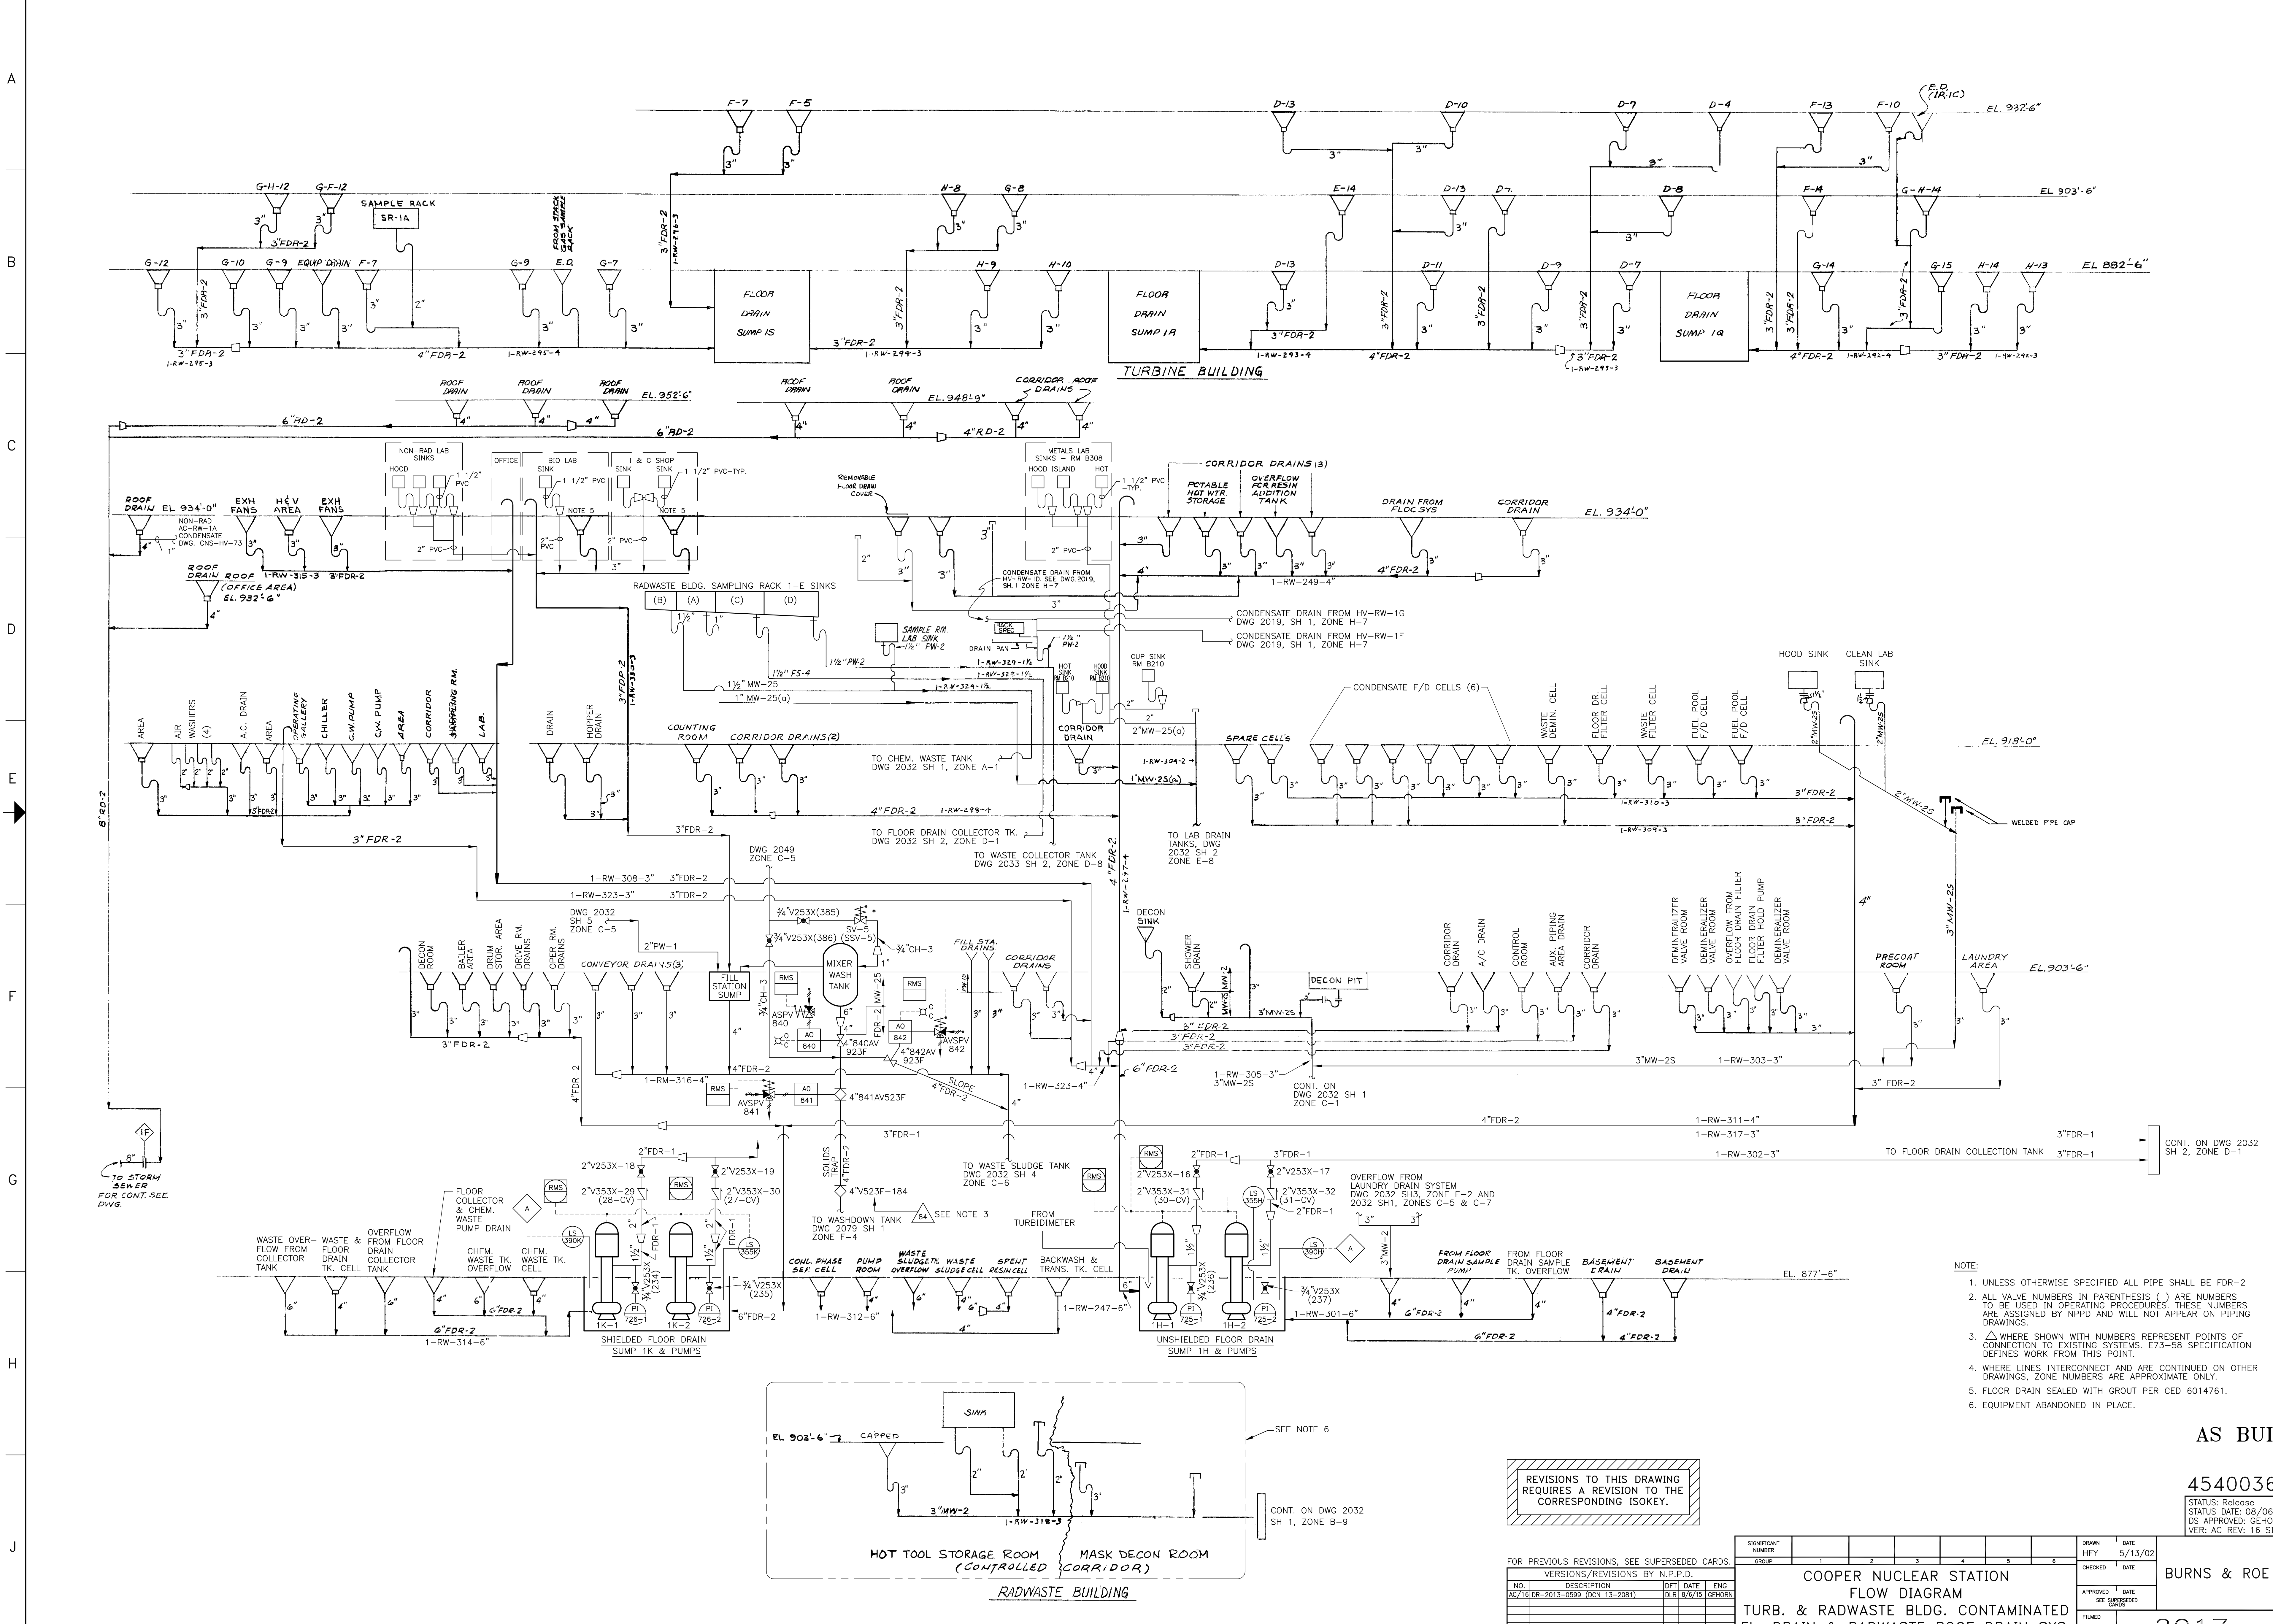

- NOTE:
1. UNLESS OTHERWISE SPECIFIED ALL PIPE SHALL BE FDR-2
  2. ALL VALVE NUMBERS IN PARENTHESIS ( ) ARE NUMBERS TO BE USED IN OPERATING PROCEDURES. THESE NUMBERS ARE ASSIGNED BY NPPD AND WILL NOT APPEAR ON PIPING DRAWINGS.
  3. △ WHERE SHOWN WITH NUMBERS REPRESENT POINTS OF CONNECTION TO EXISTING SYSTEMS. E73-58 SPECIFICATION DEFINES WORK FROM THIS POINT.
  4. WHERE LINES INTERCONNECT AND ARE CONTINUED ON OTHER DRAWINGS, ZONE NUMBERS ARE APPROXIMATE ONLY.
  5. FLOOR DRAIN SEALED WITH GROUT PER CED 6014761.
  6. EQUIPMENT ABANDONED IN PLACE.

REVISIONS TO THIS DRAWING  
REQUIRES A REVISION TO THE  
CORRESPONDING ISOKEY.

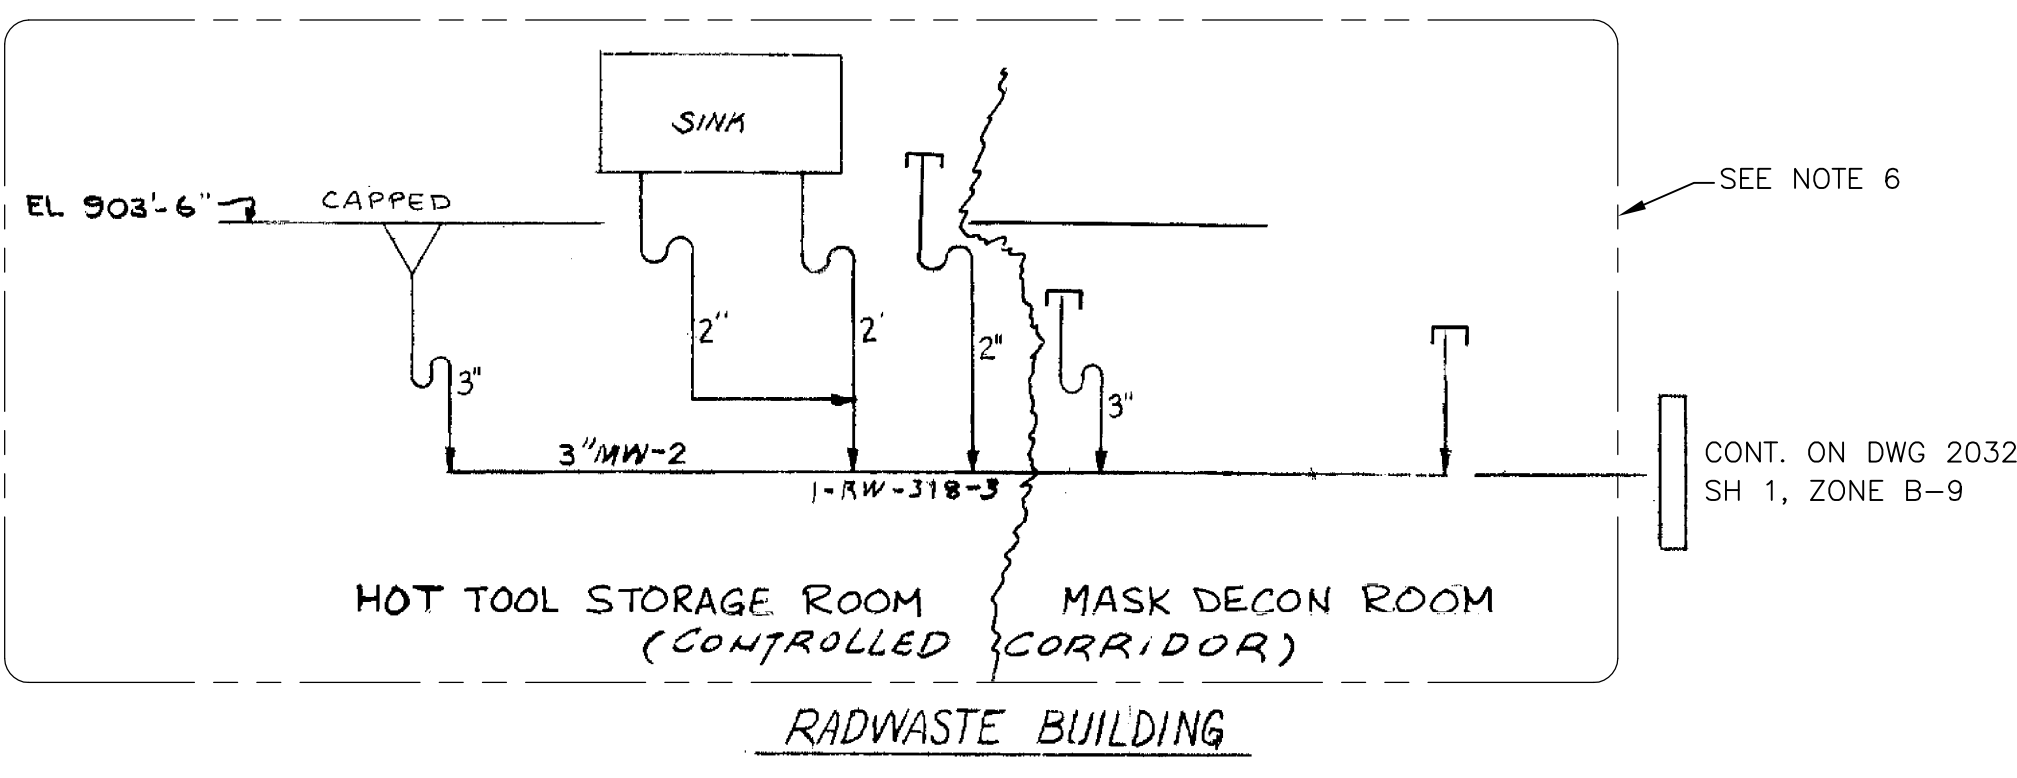

AS BUILT

454003605

STATUS: Release  
STATUS DATE: 08/06/2015  
DS APPROVED: GEHORN  
VER: AC REV: 16 SIZE: F


FOR PREVIOUS REVISIONS, SEE SUPERSEDED CARDS.		SIGNIFICANT NUMBER		DRAWN		DATE	
NO.	DESCRIPTION	GROUP	1	2	3	4	5
AC/78	DR-2013-0599 (DCN 13-2081)						

VERSIONS/REVISIONS BY N.P.P.D.				DRAWN		DATE	
NO.	DESCRIPTION	DFT	DATE	HYF	5/13/02		
		DLR	8/6/75	GEHORN			

COOPER NUCLEAR STATION				DRAWN		DATE	
TURB. & RADWASTE BLDG. CONTAMINATED				HYF		5/13/02	
FL. DRAIN & RADWASTE ROOF DRAIN SYS.				CHECKED		DATE	
				APPROVED		DATE	
				FILMED		DATE	
				BURNS & ROE			
				2017			



- NOTES**
- FOR GENERAL NOTES REFER TO DWG 2014, SH. 2.
  - FOR ELECTRIC SHOP & NON-CRIT SWGR RM SEE SARGENT & LUNDY DWG. M-111.
  - FLOW QUANTITIES ARE DESIGN FLOW QUANTITIES.
  - SEE BURNS & ROE H&V DUCT LAYOUT DRAWINGS FOR FIRE DAMPER CIP NOS.
  - ESSENTIAL CONTROL BLDG. VENTILATION DUCTWORK SUPPORT LOCATIONS ARE DEPICTED ON DWG. CNS-HV-47, 48 & 49.
- NOTE: ALL ITEMS MARKED THUS ARE "AS BUILT" ITEMS AND ARE NOT SHOWN ON PIPING DRAWINGS.

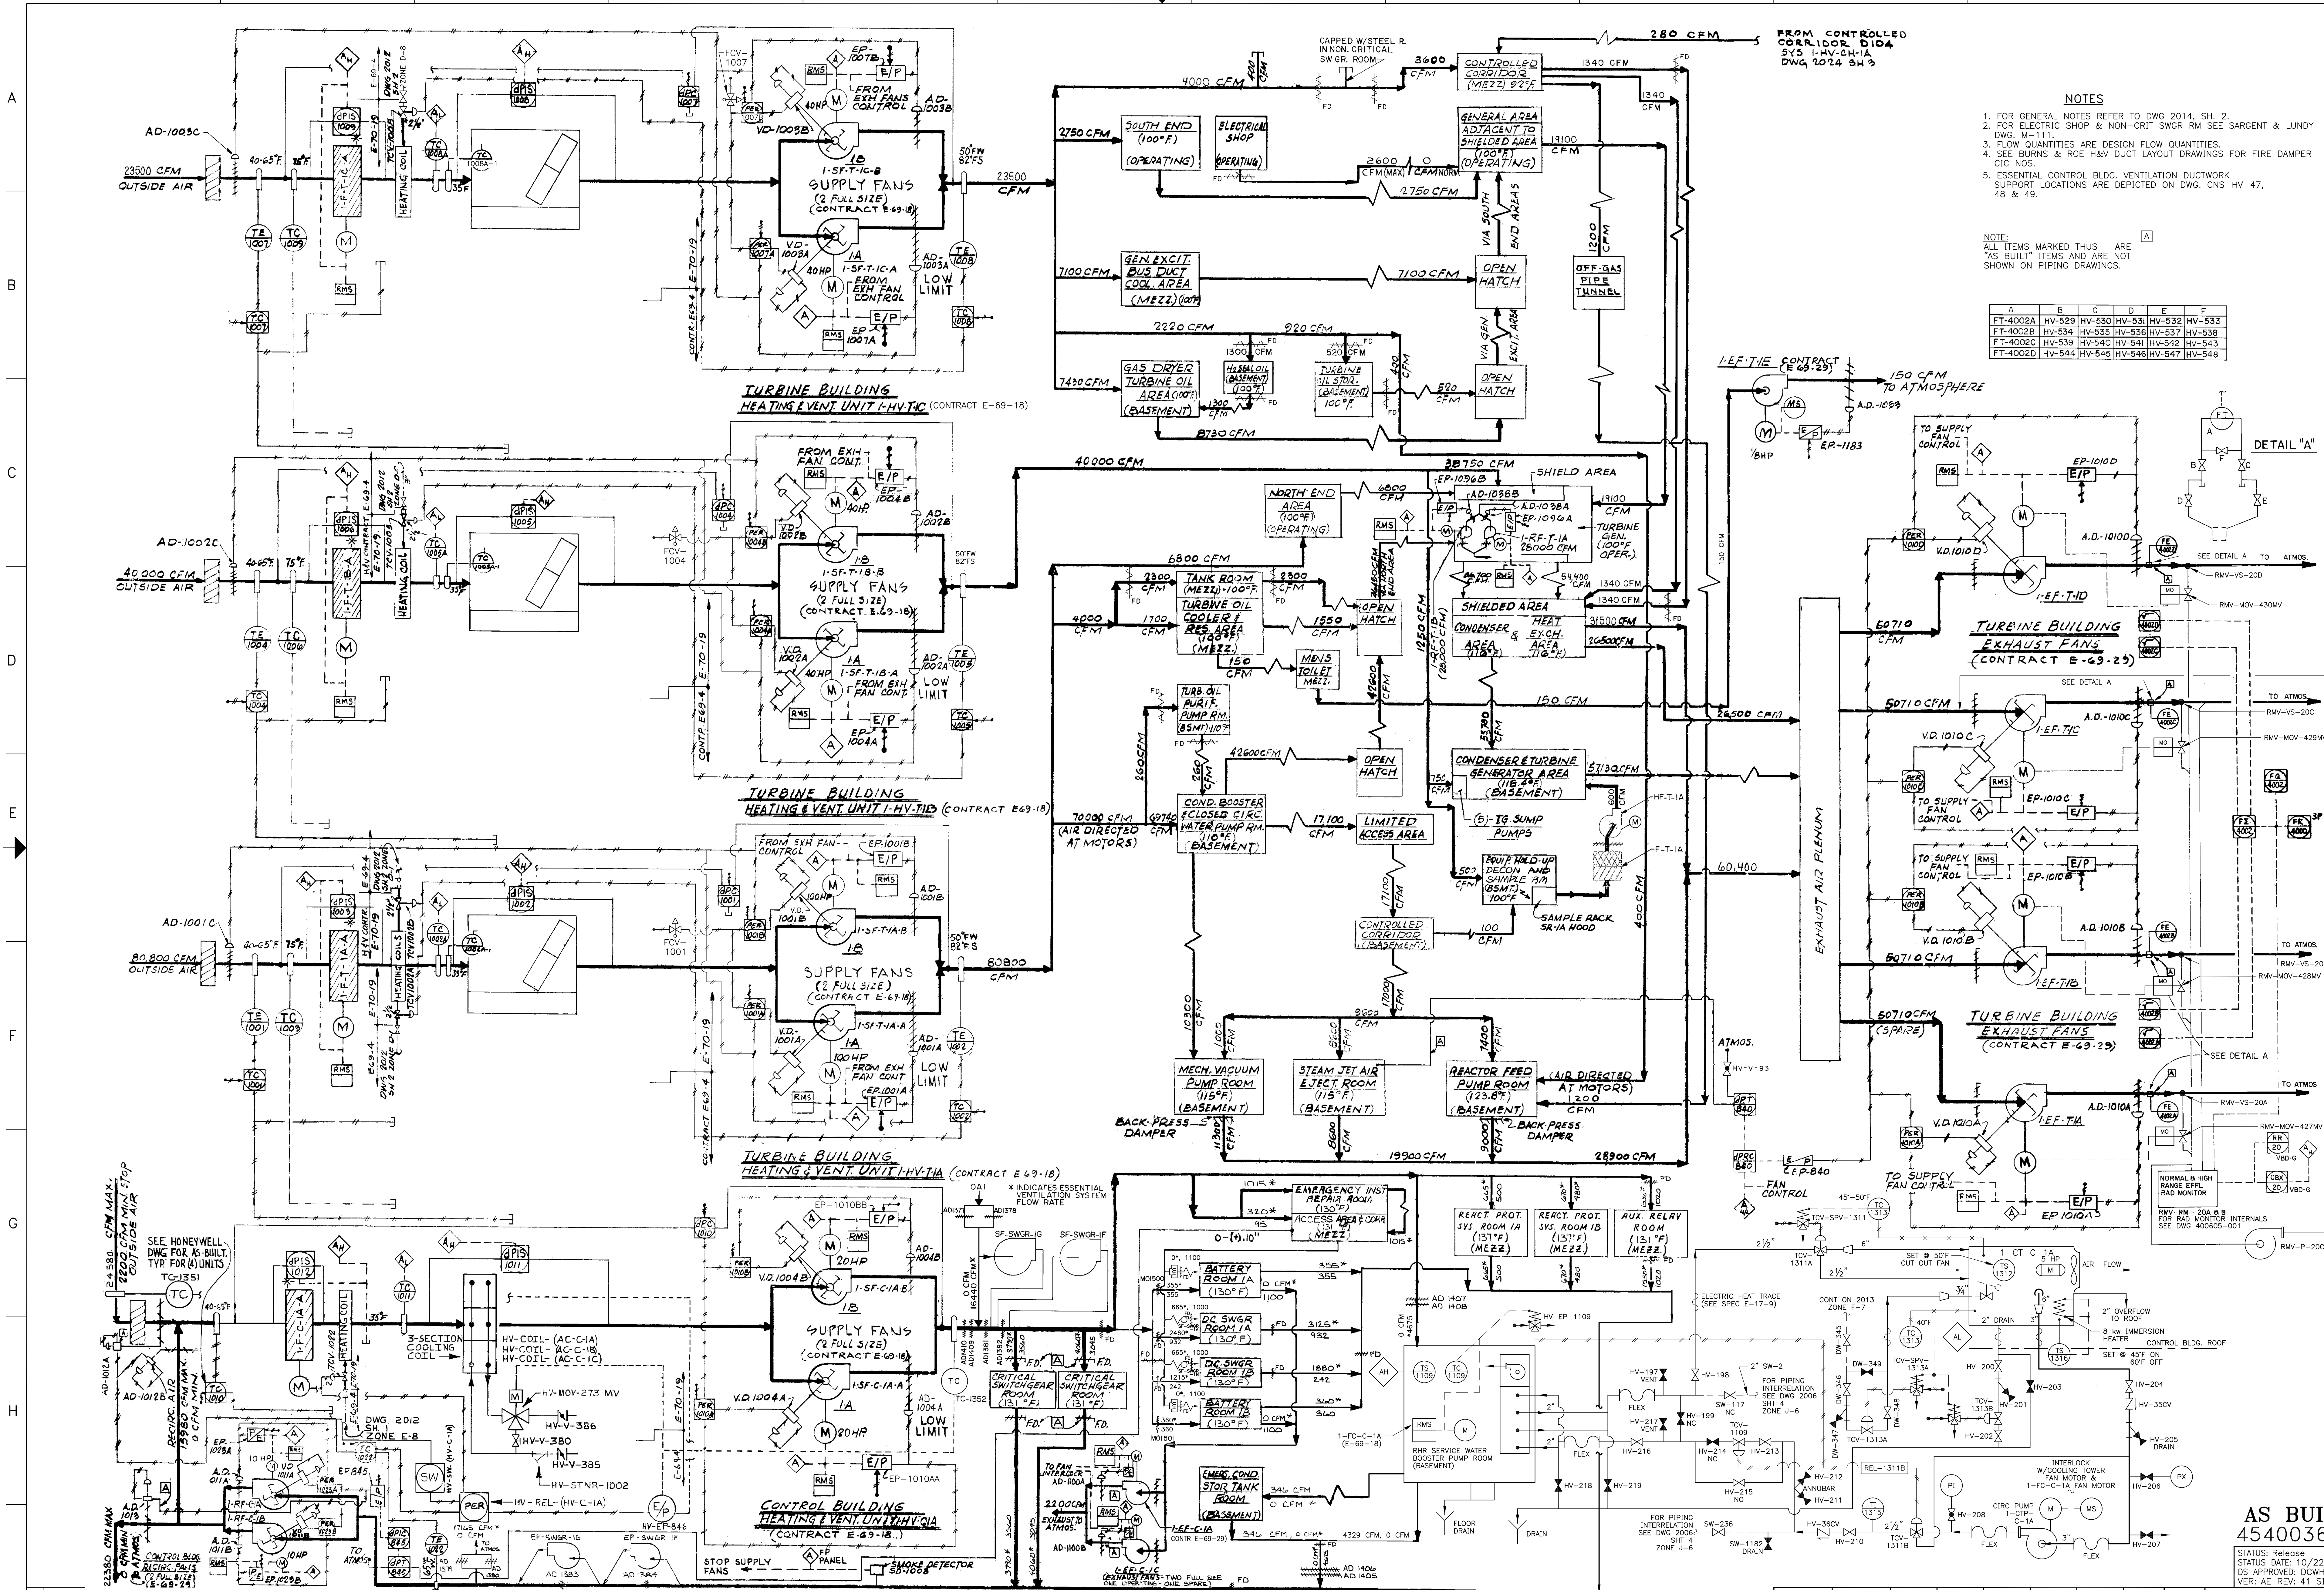A	B	C	D	E	F
FT-4002A	HV-529	HV-530	HV-531	HV-532	HV-533
FT-4002B	HV-534	HV-535	HV-536	HV-537	HV-538
FT-4002C	HV-539	HV-540	HV-541	HV-542	HV-543
FT-4002D	HV-544	HV-545	HV-546	HV-547	HV-548

**AS BUILT**  
454003606  
STATUS: Release  
DATE: 10/22/2018  
DS APPROVED: DCWHEAT  
VER: AE REV: 41 SIZE: F

VERSIONS/REVISIONS BY N.P.P.D.			SIGNIFICANT NUMBER	
NO.	DESCRIPTION	DFT	DATE	ENG
AB/29/DR-2013-0968			10/23/2013	TRK/RAJ
10/23/2013-0968			10/23/2013	TRK/RAJ
10/23/2013-0968			10/23/2013	TRK/RAJ
10/23/2013-0968			10/23/2013	TRK/RAJ

NO.	DESCRIPTION	DATE	GROUP
1		3/27/03	RG
2			
3			
4			
5			
6			
7			
8			
9			
10			
11			
12			


**FLOW DIAGRAM**  
**TURBINE GENERATOR BLDG & CONTROL**  
**BLDG HEATING & VENTILATING**  
**COOPER NUCLEAR STATION**

APPROVED: DATE: 10/22/2018  
FILMED: DATE: 10/22/2018

2018


BURNS & ROE



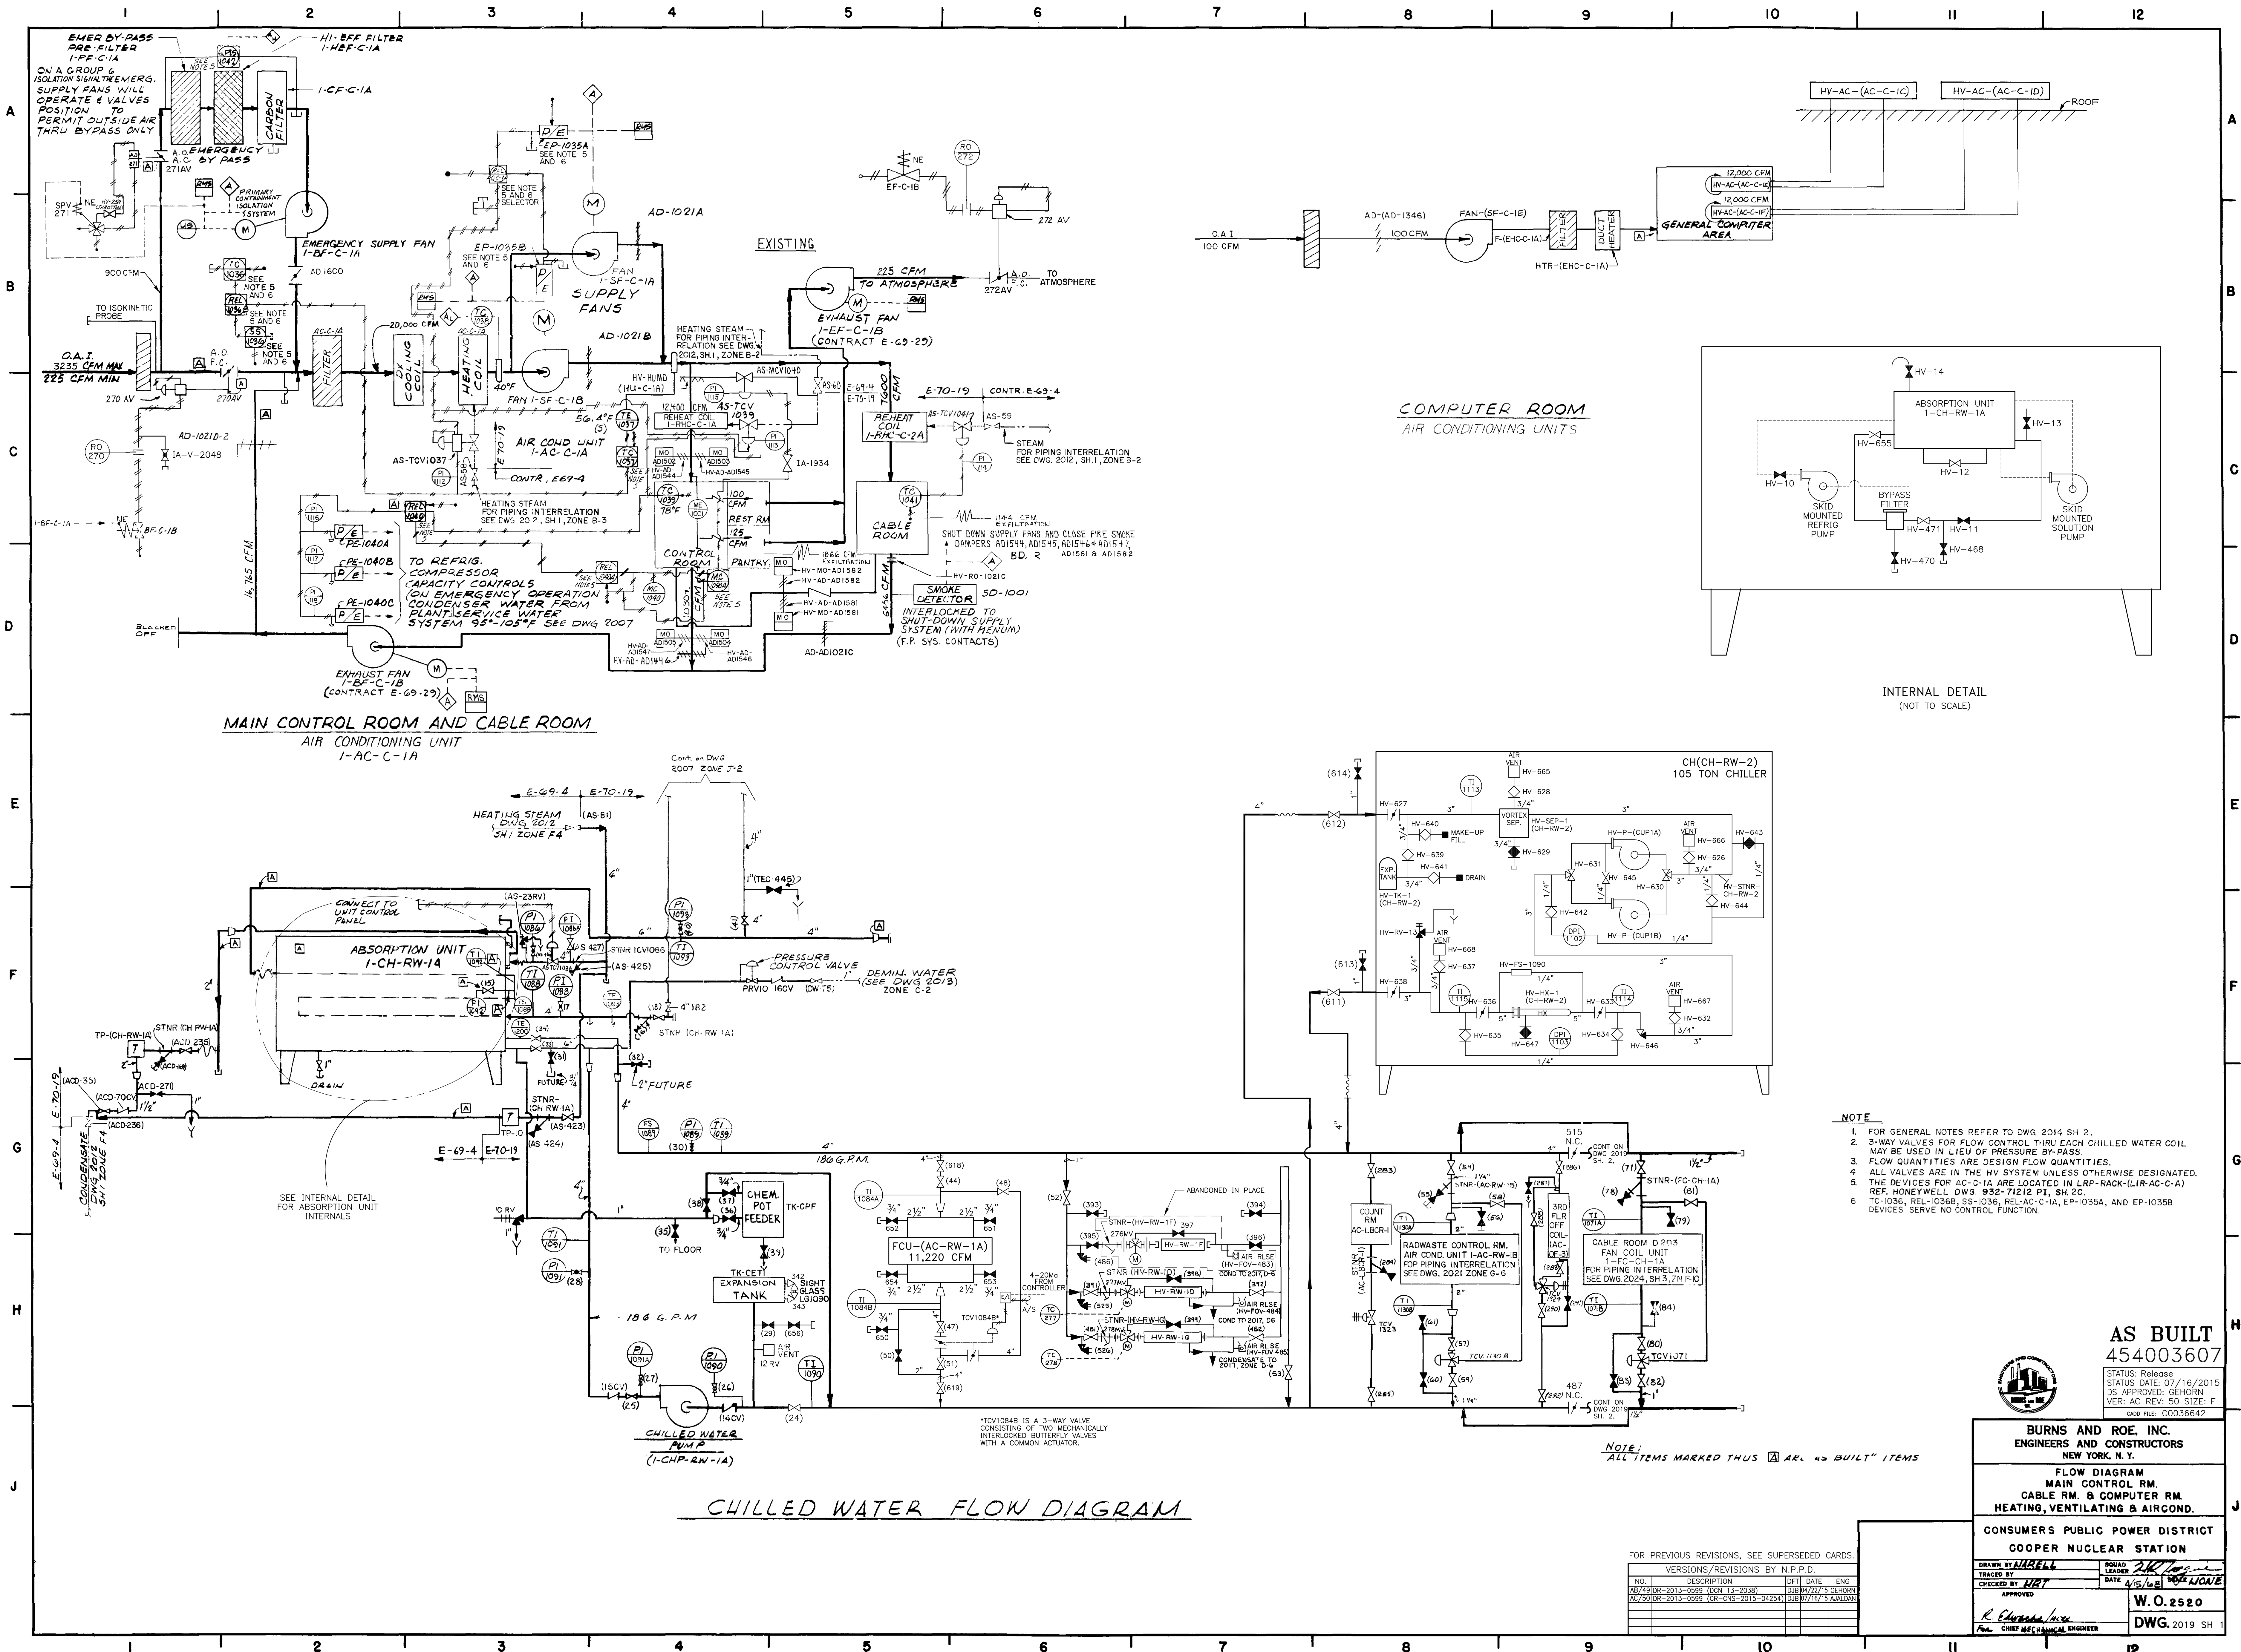


MAIN CONTROL ROOM AND CABLE ROOM  
AIR CONDITIONING UNIT  
I-AC-C-1A

COMPUTER ROOM  
AIR CONDITIONING UNITS

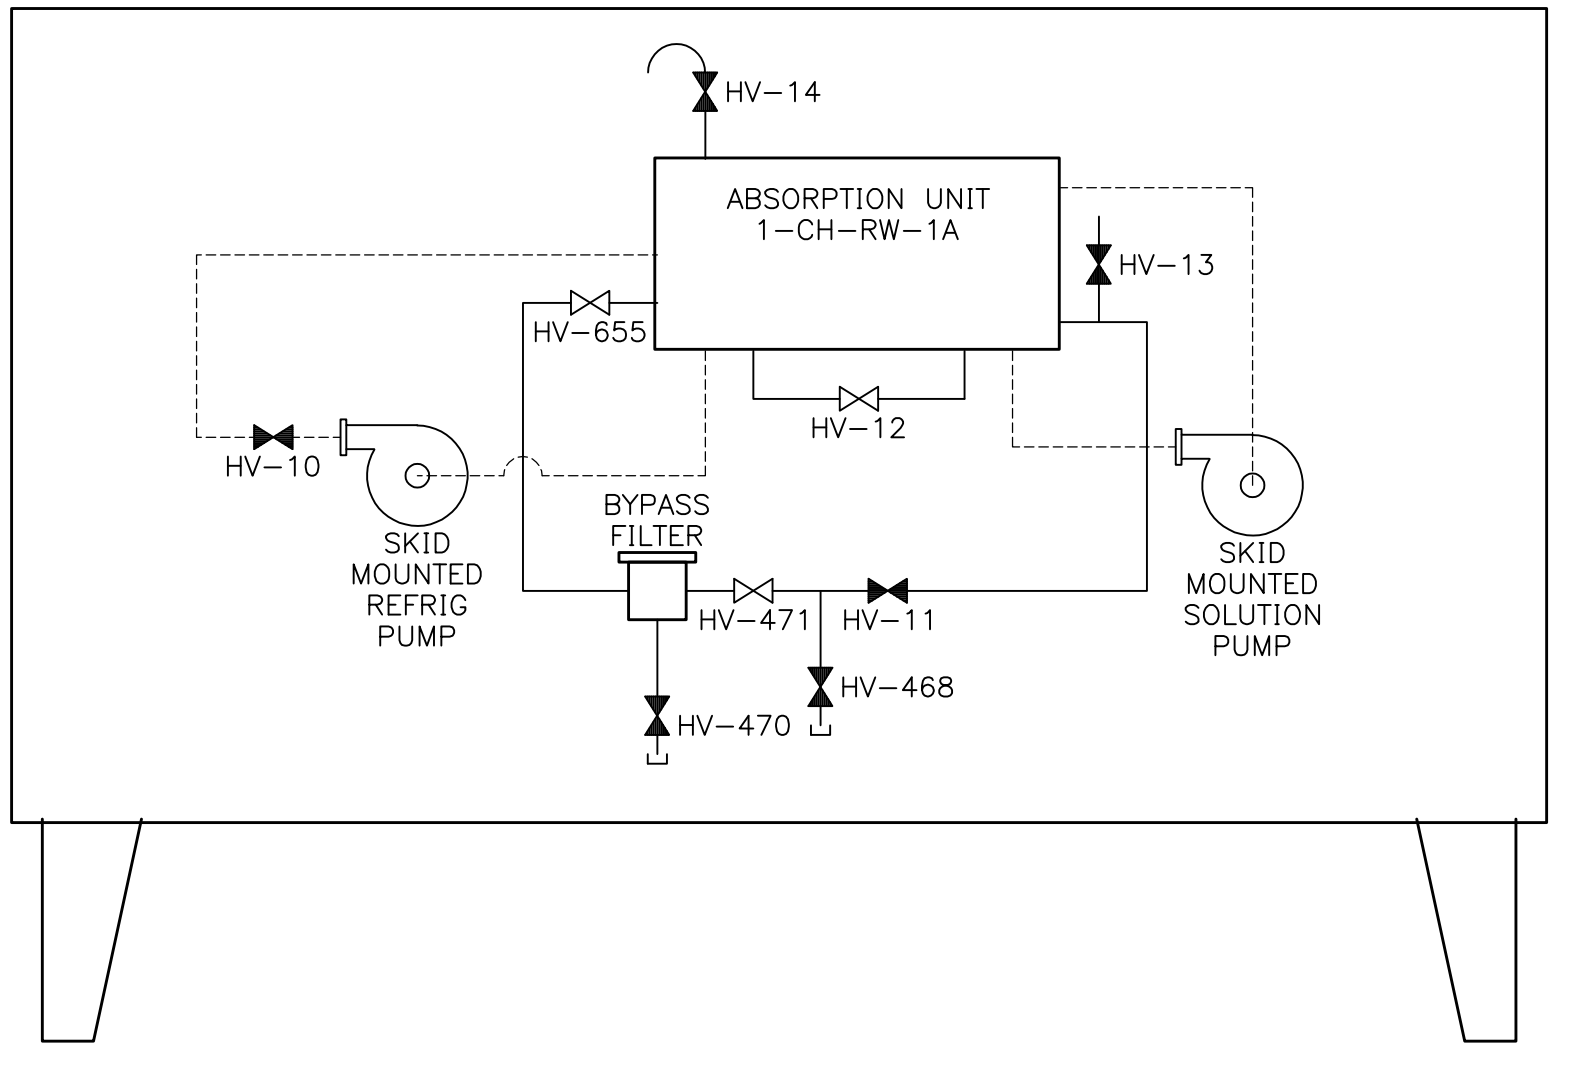

INTERNAL DETAIL  
(NOT TO SCALE)

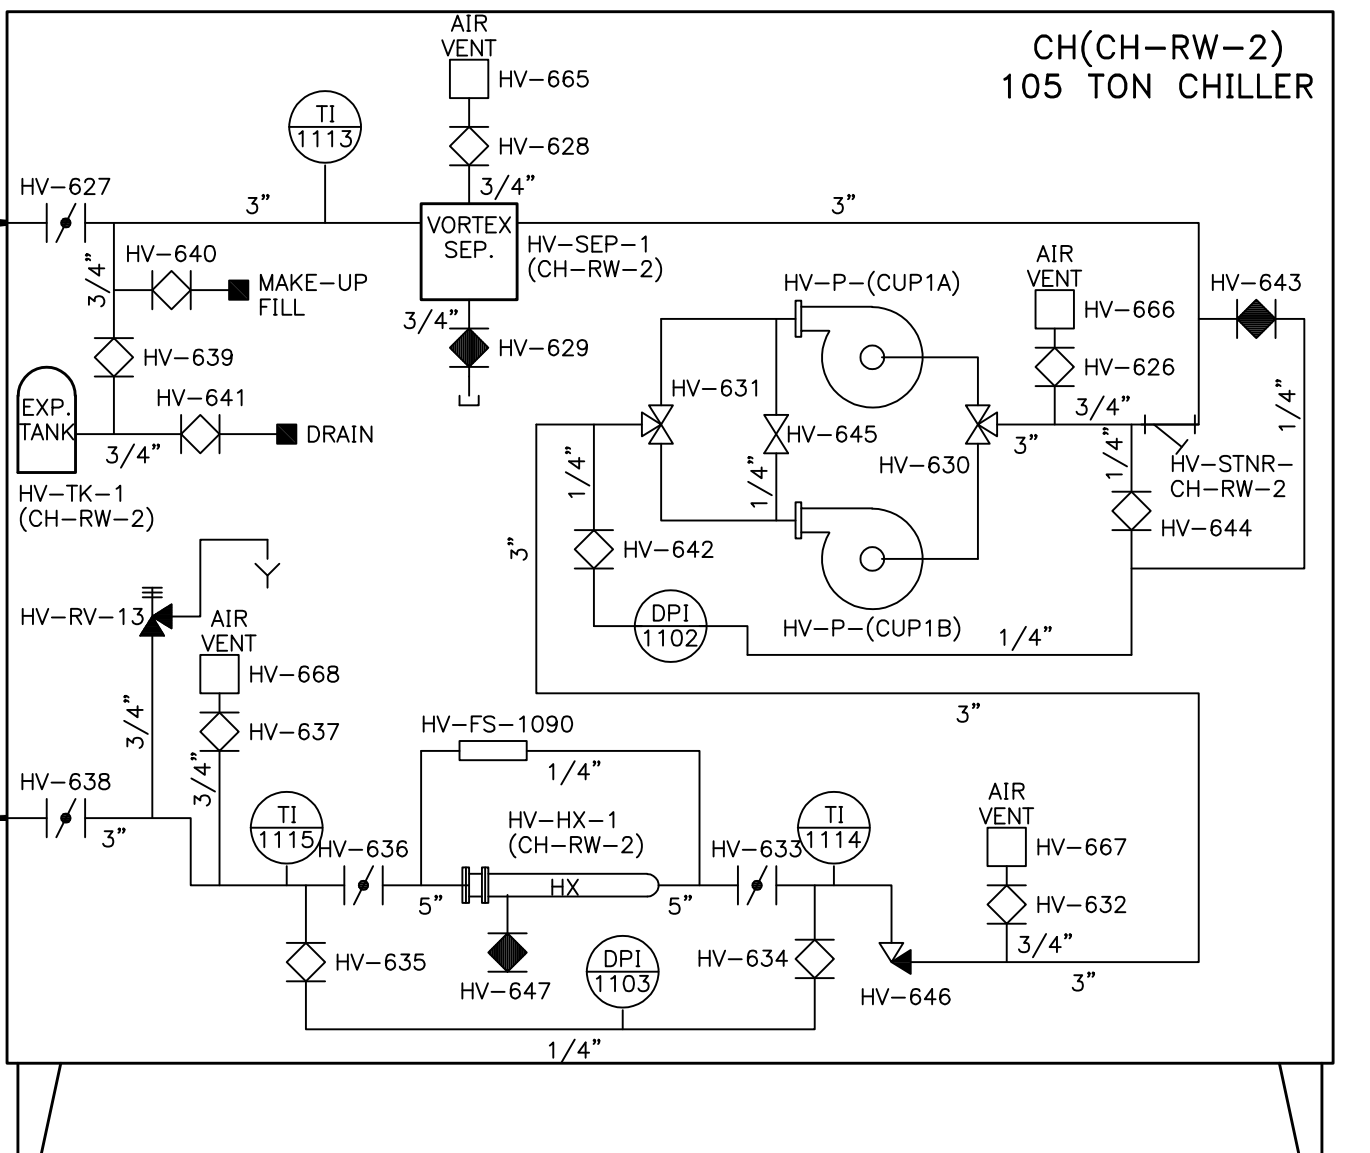

- NOTE**
- 1. FOR GENERAL NOTES REFER TO DWG. 2014 SH 2.
  - 2. 3-WAY VALVES FOR FLOW CONTROL THRU EACH CHILLED WATER COIL MAY BE USED IN LIEU OF PRESSURE BY-PASS.
  - 3. FLOW QUANTITIES ARE DESIGN FLOW QUANTITIES.
  - 4. ALL VALVES ARE IN THE HV SYSTEM UNLESS OTHERWISE DESIGNATED.
  - 5. THE DEVICES FOR AC-C-1A ARE LOCATED IN LRP-RACK (LIR-AC-C-1A) REF. HONEYWELL DWG. 932-71212 PI, SH 2C.
  - 6. TC-1036, REL-1036B, SS-1036, REL-AC-C-1A, EP-1035A, AND EP-1035B DEVICES SERVE NO CONTROL FUNCTION.

CHILLED WATER FLOW DIAGRAM

AS BUILT  
454003607



BURNS AND ROE, INC.  
ENGINEERS AND CONSTRUCTORS  
NEW YORK, N. Y.







FLOW DIAGRAM  
MAIN CONTROL RM.  
CABLE RM. & COMPUTER RM.  
HEATING, VENTILATING & AIRCOND.

CONSUMERS PUBLIC POWER DISTRICT  
COOPER NUCLEAR STATION

FOR PREVIOUS REVISIONS, SEE SUPERSEDED CARDS.

NO.	DESCRIPTION	DATE	ENG.
1	AS BUILT	07/16/2015	W.O.2520

DRAWN BY: ABEL  
CHECKED BY: HET  
APPROVED: W.O.2520  
DWG. 2019 SH 1

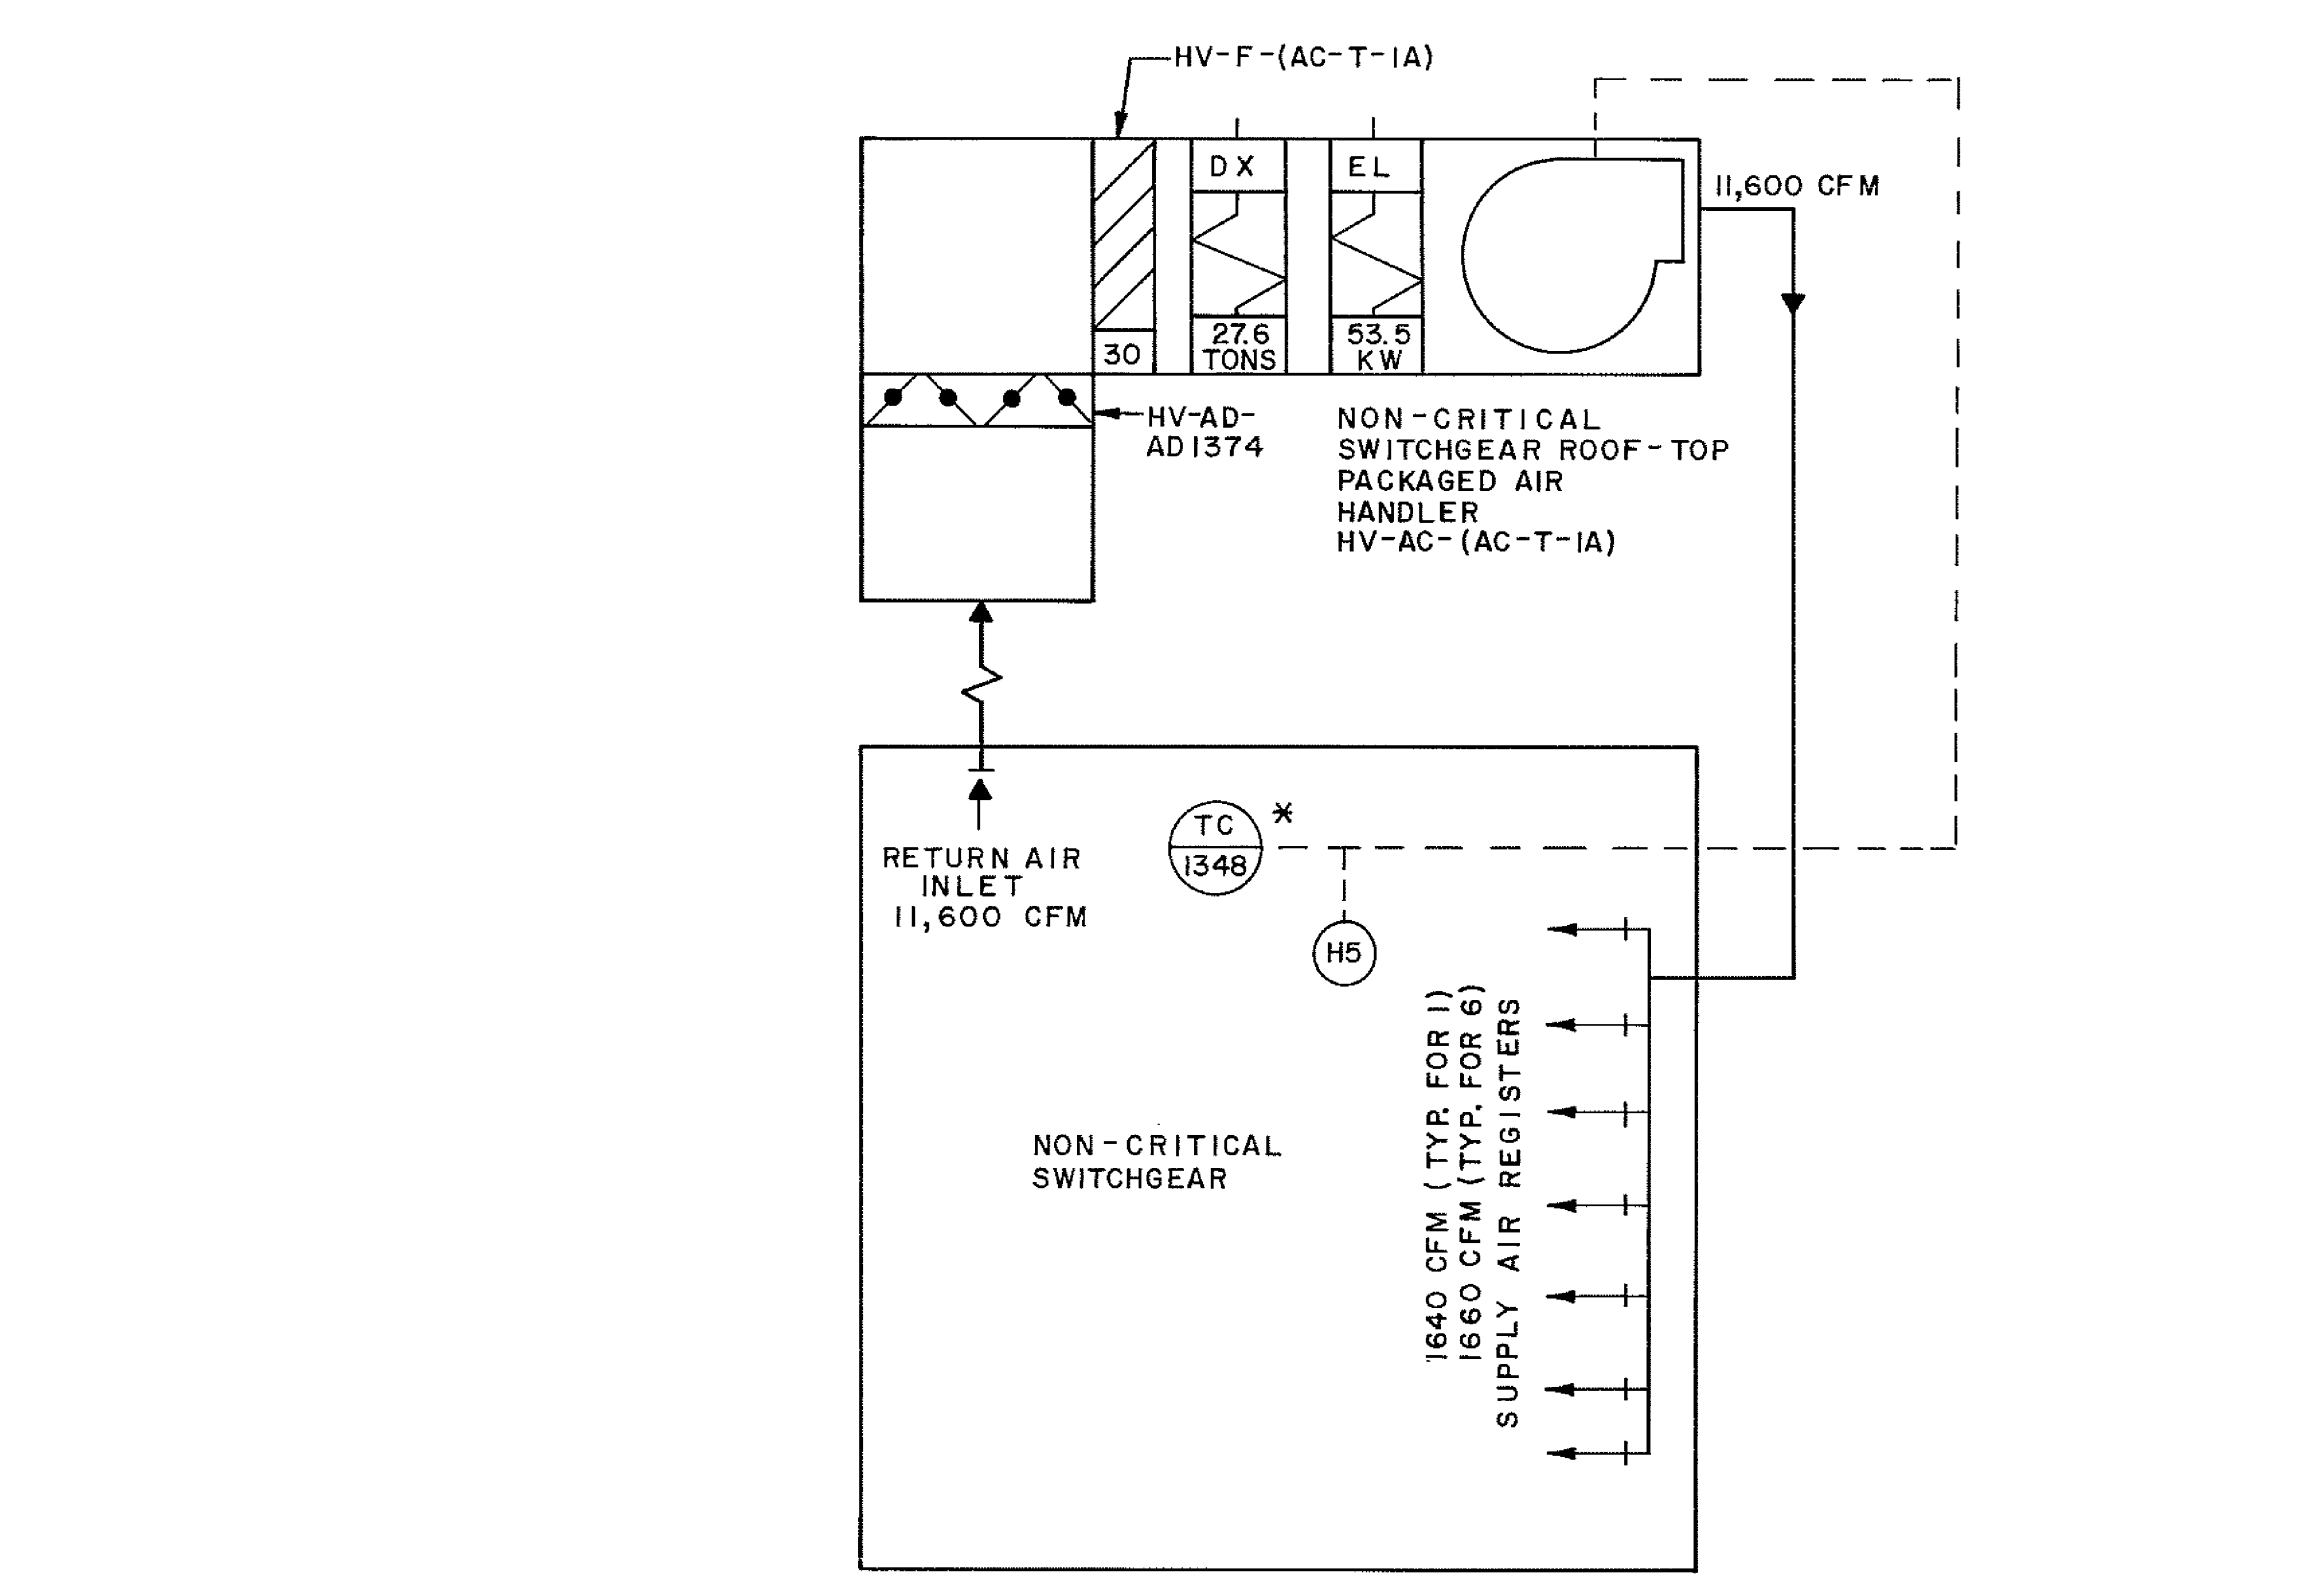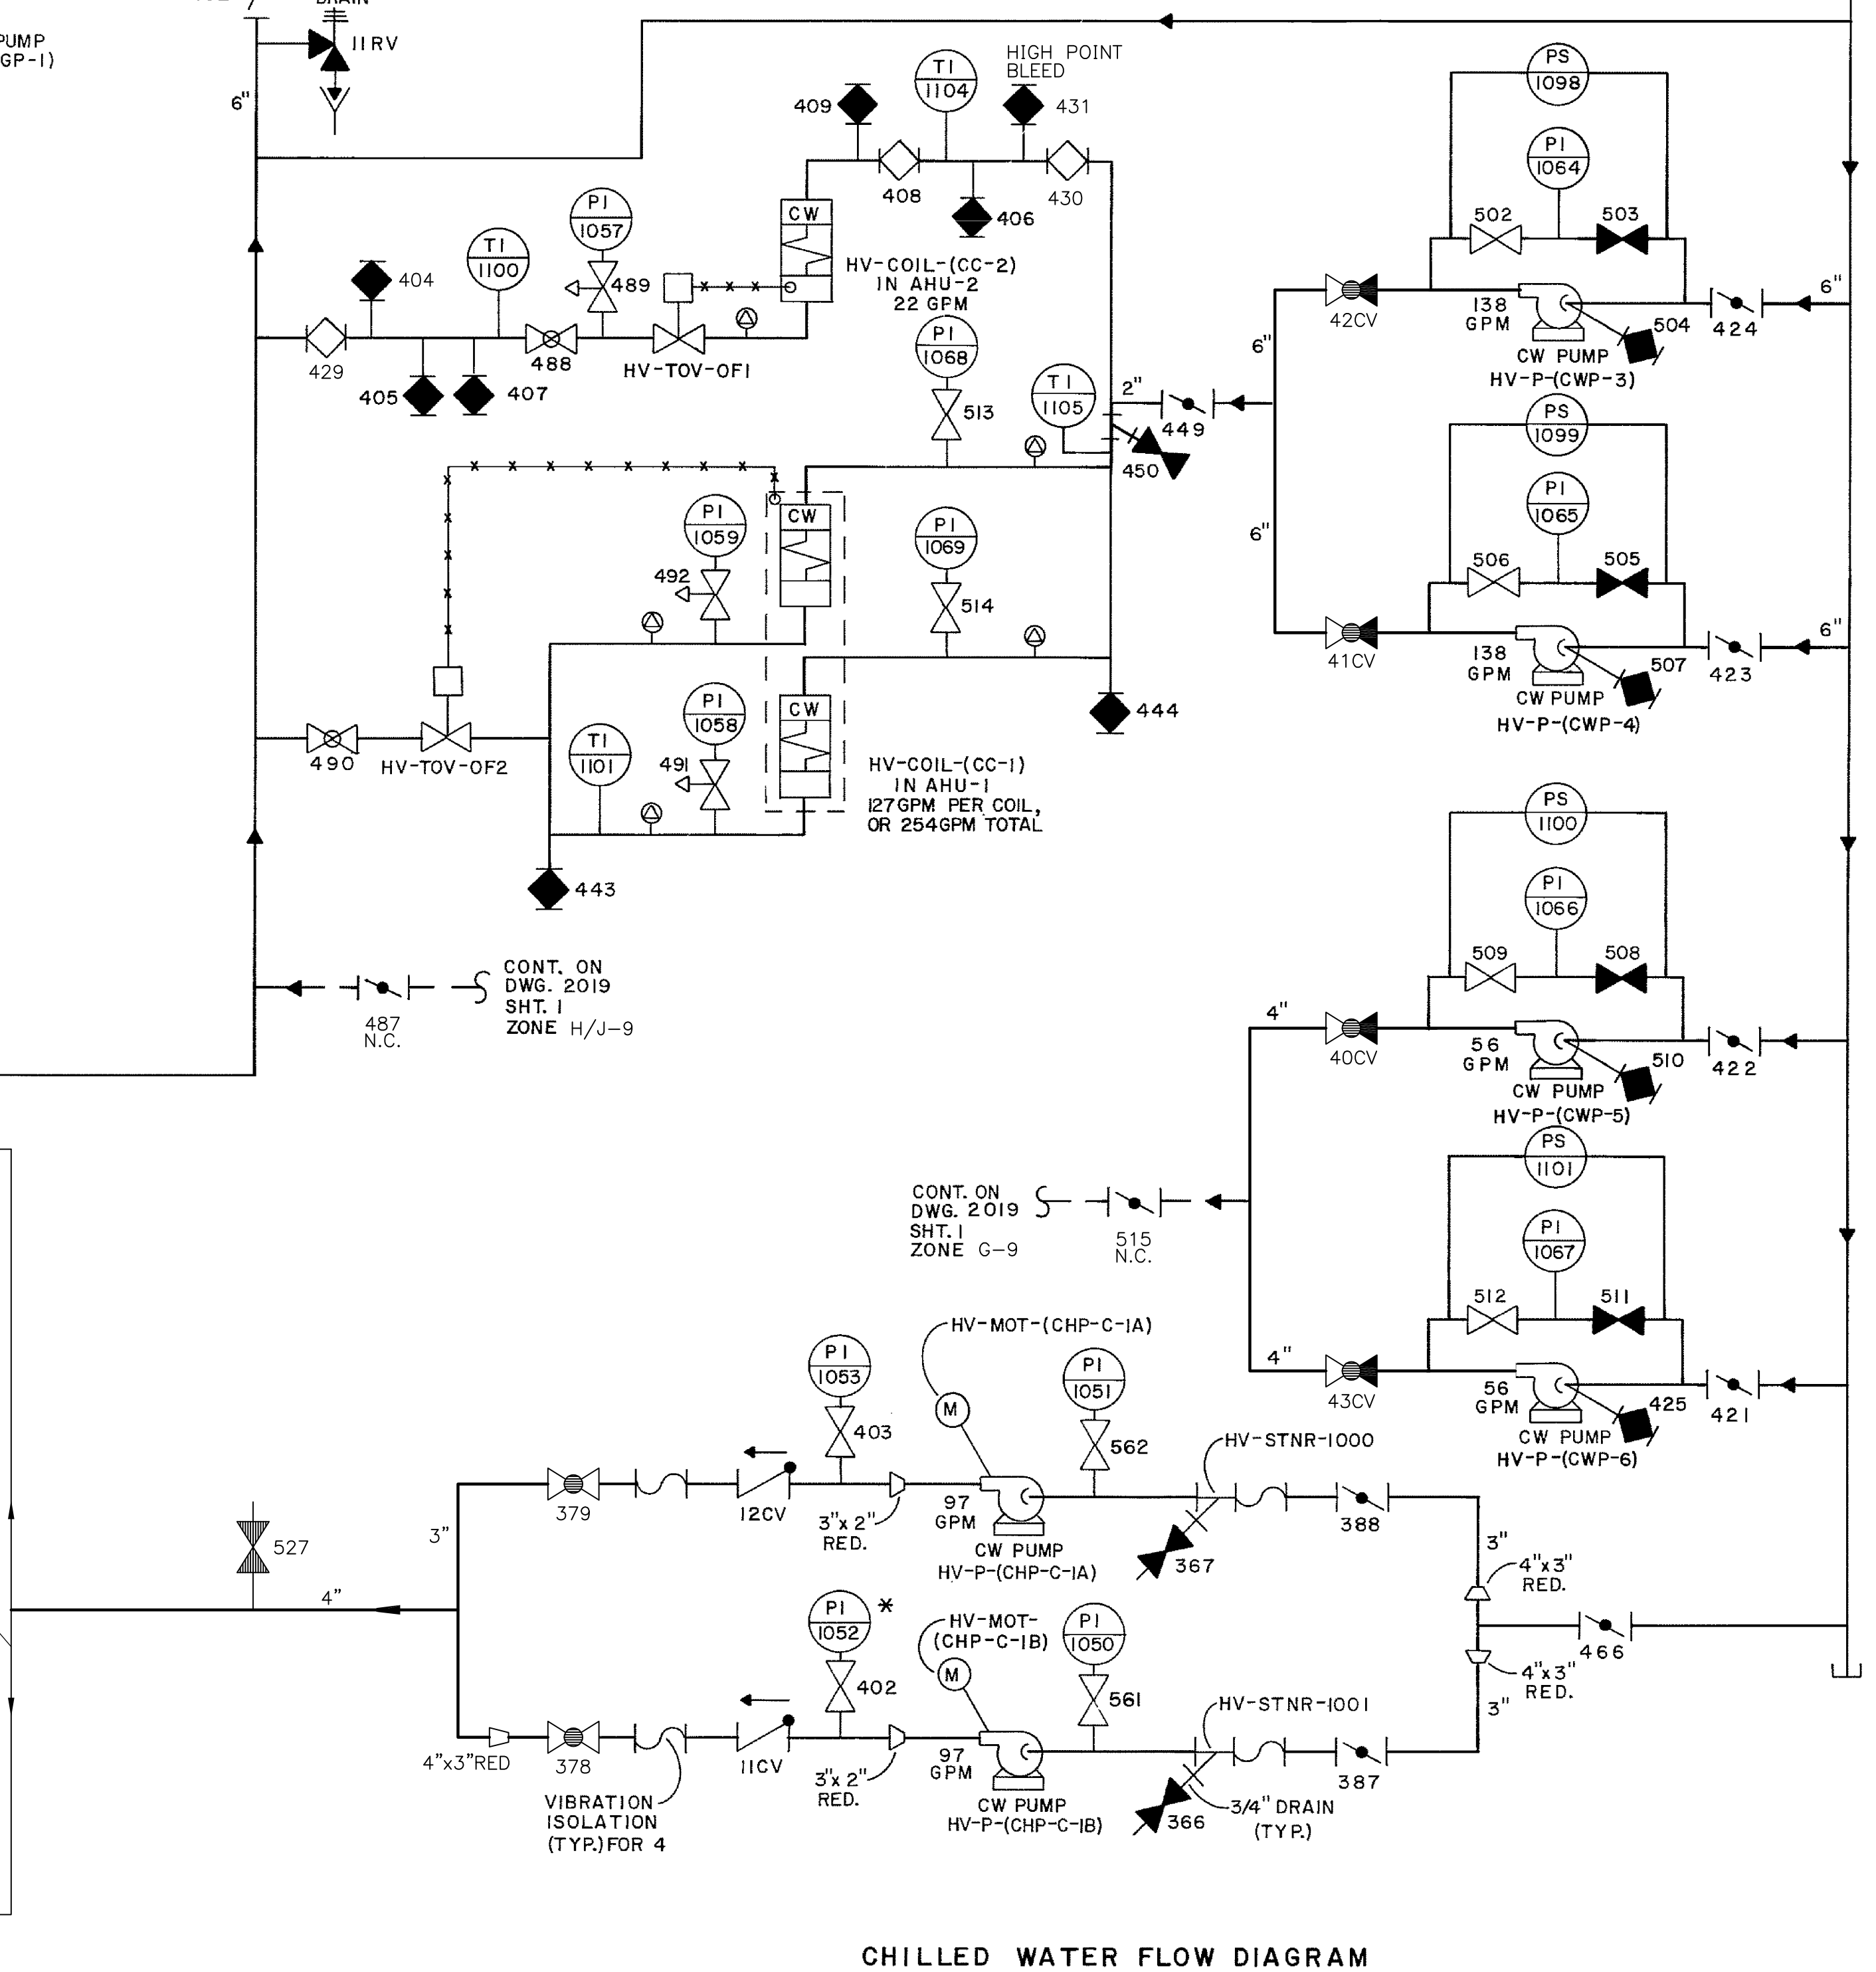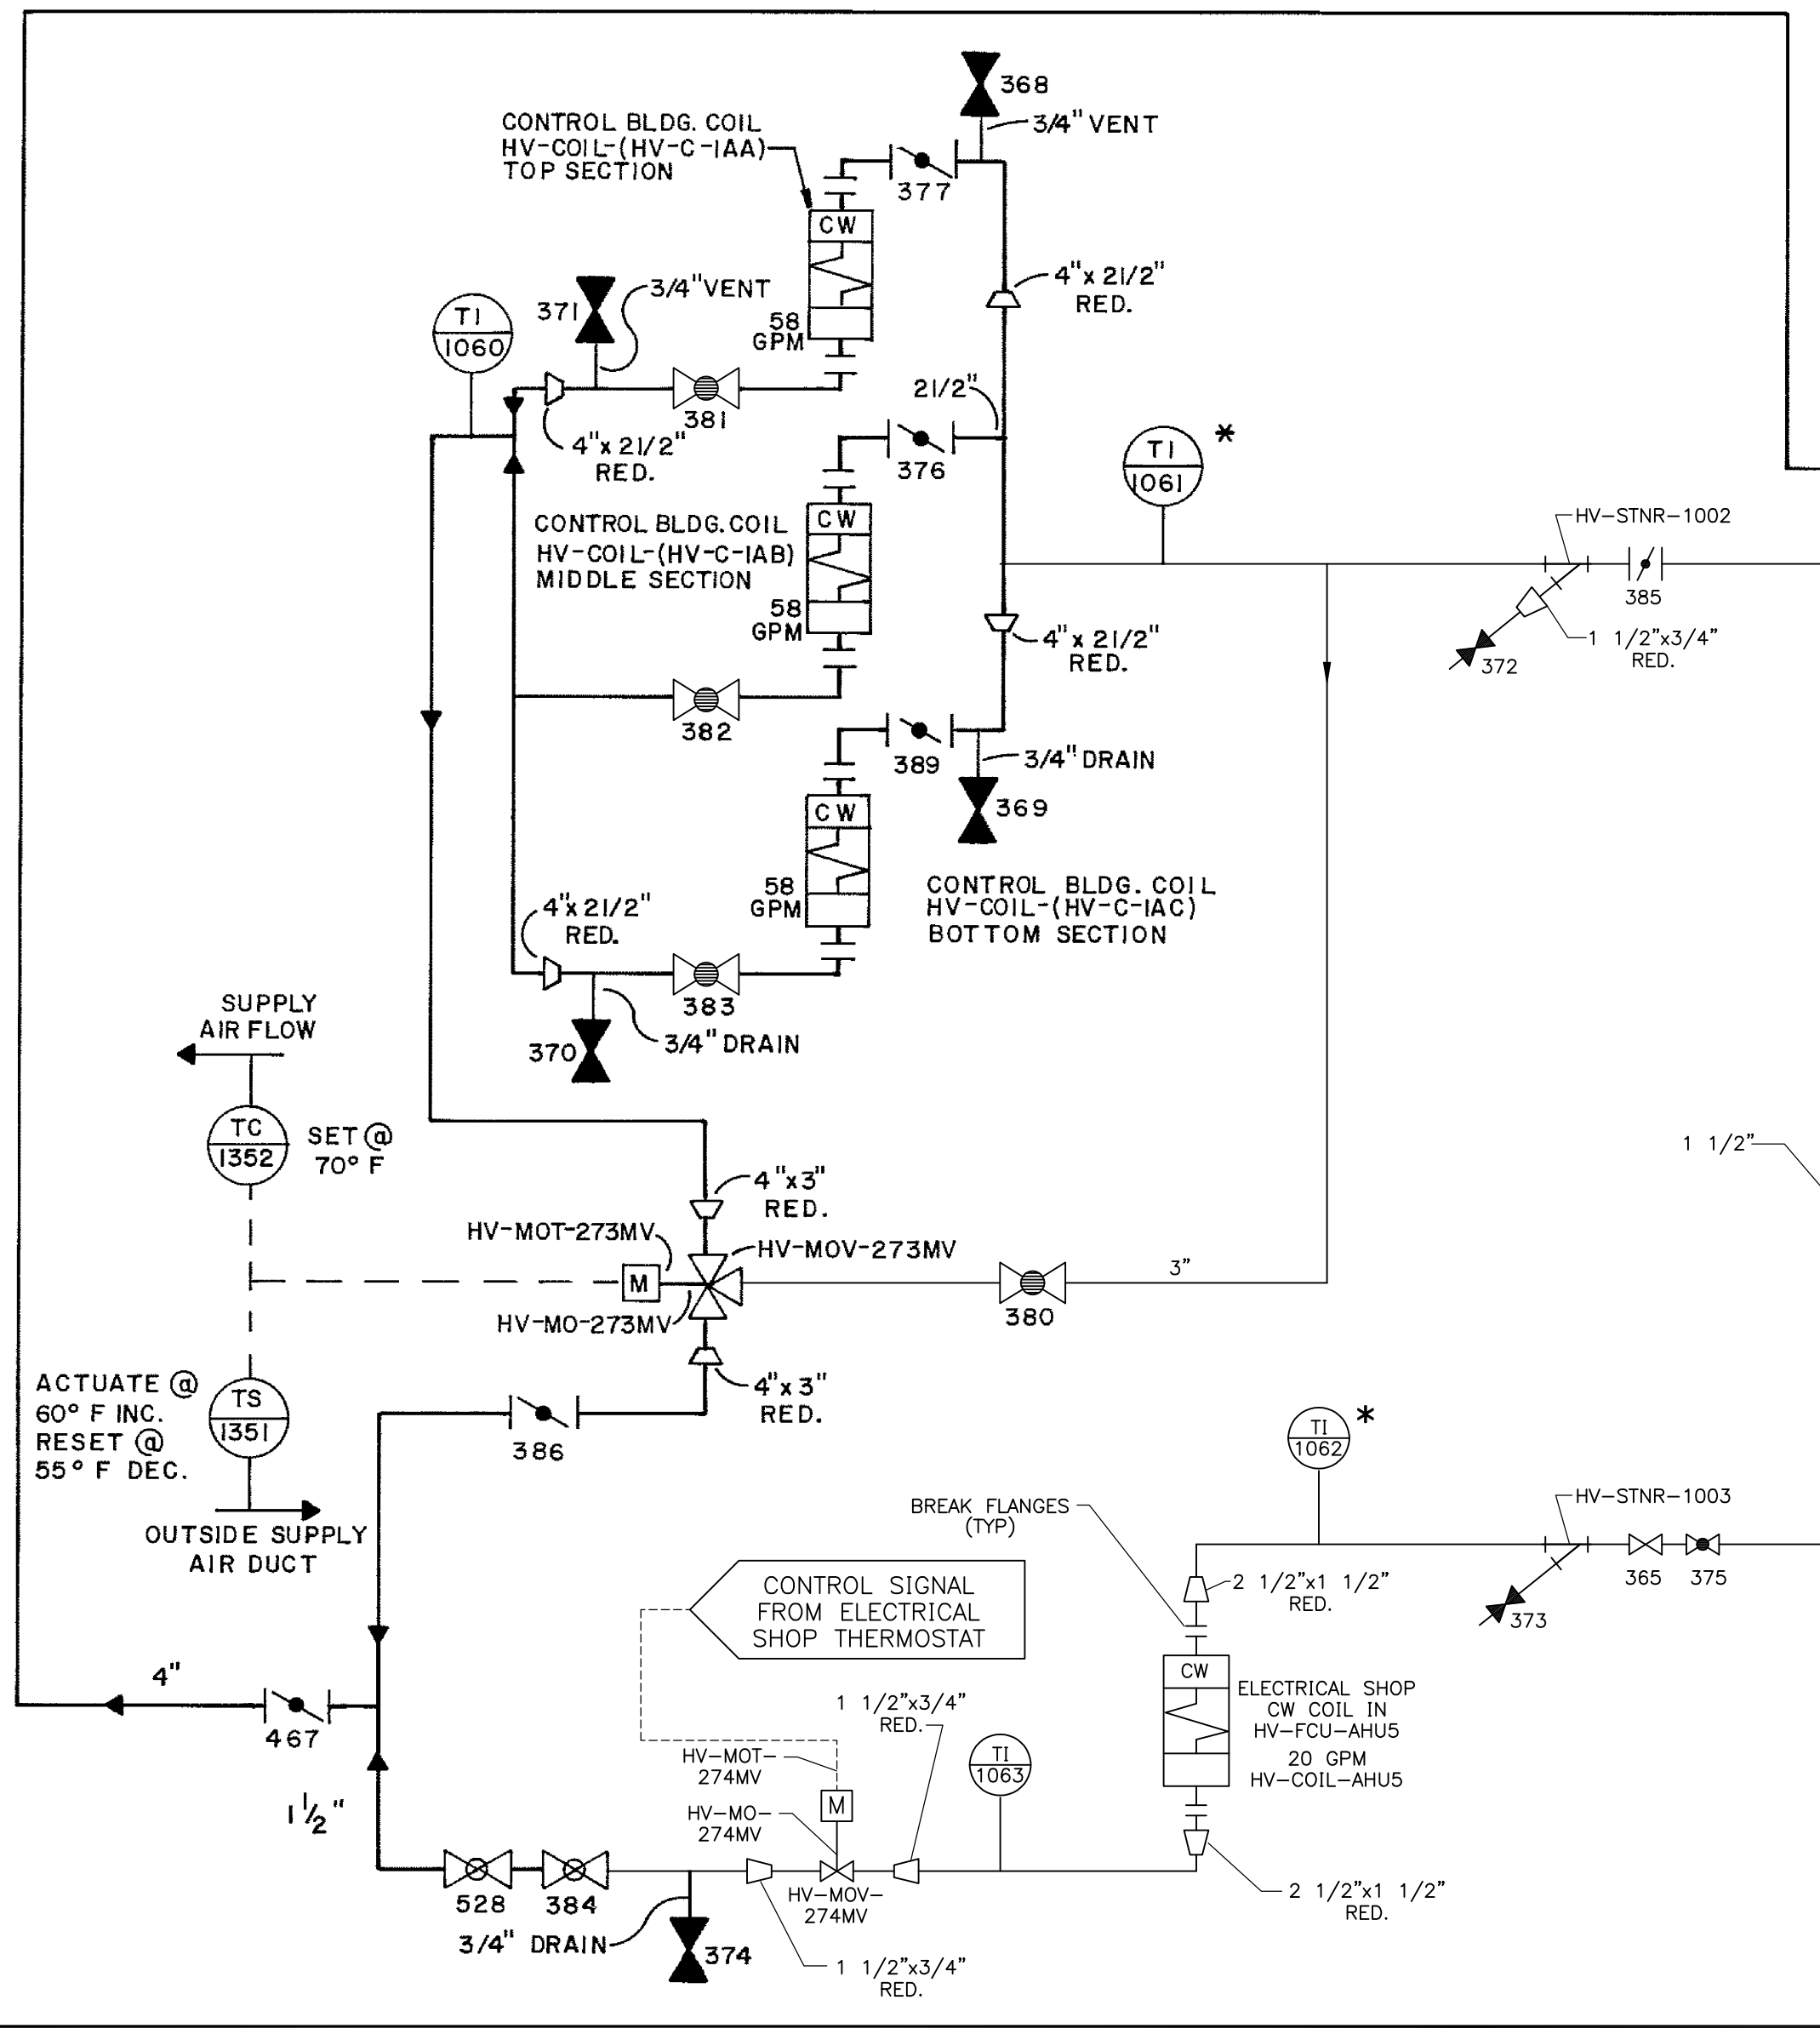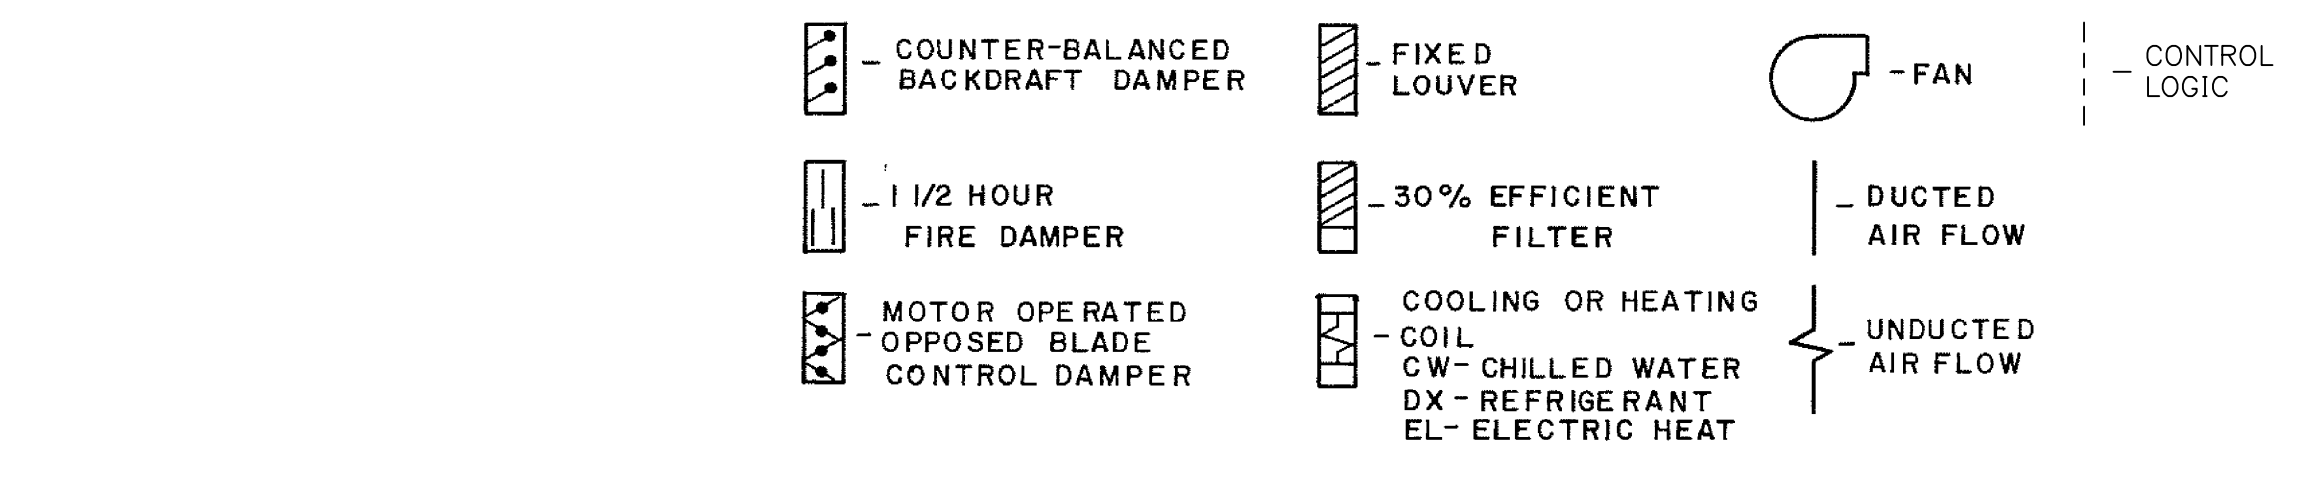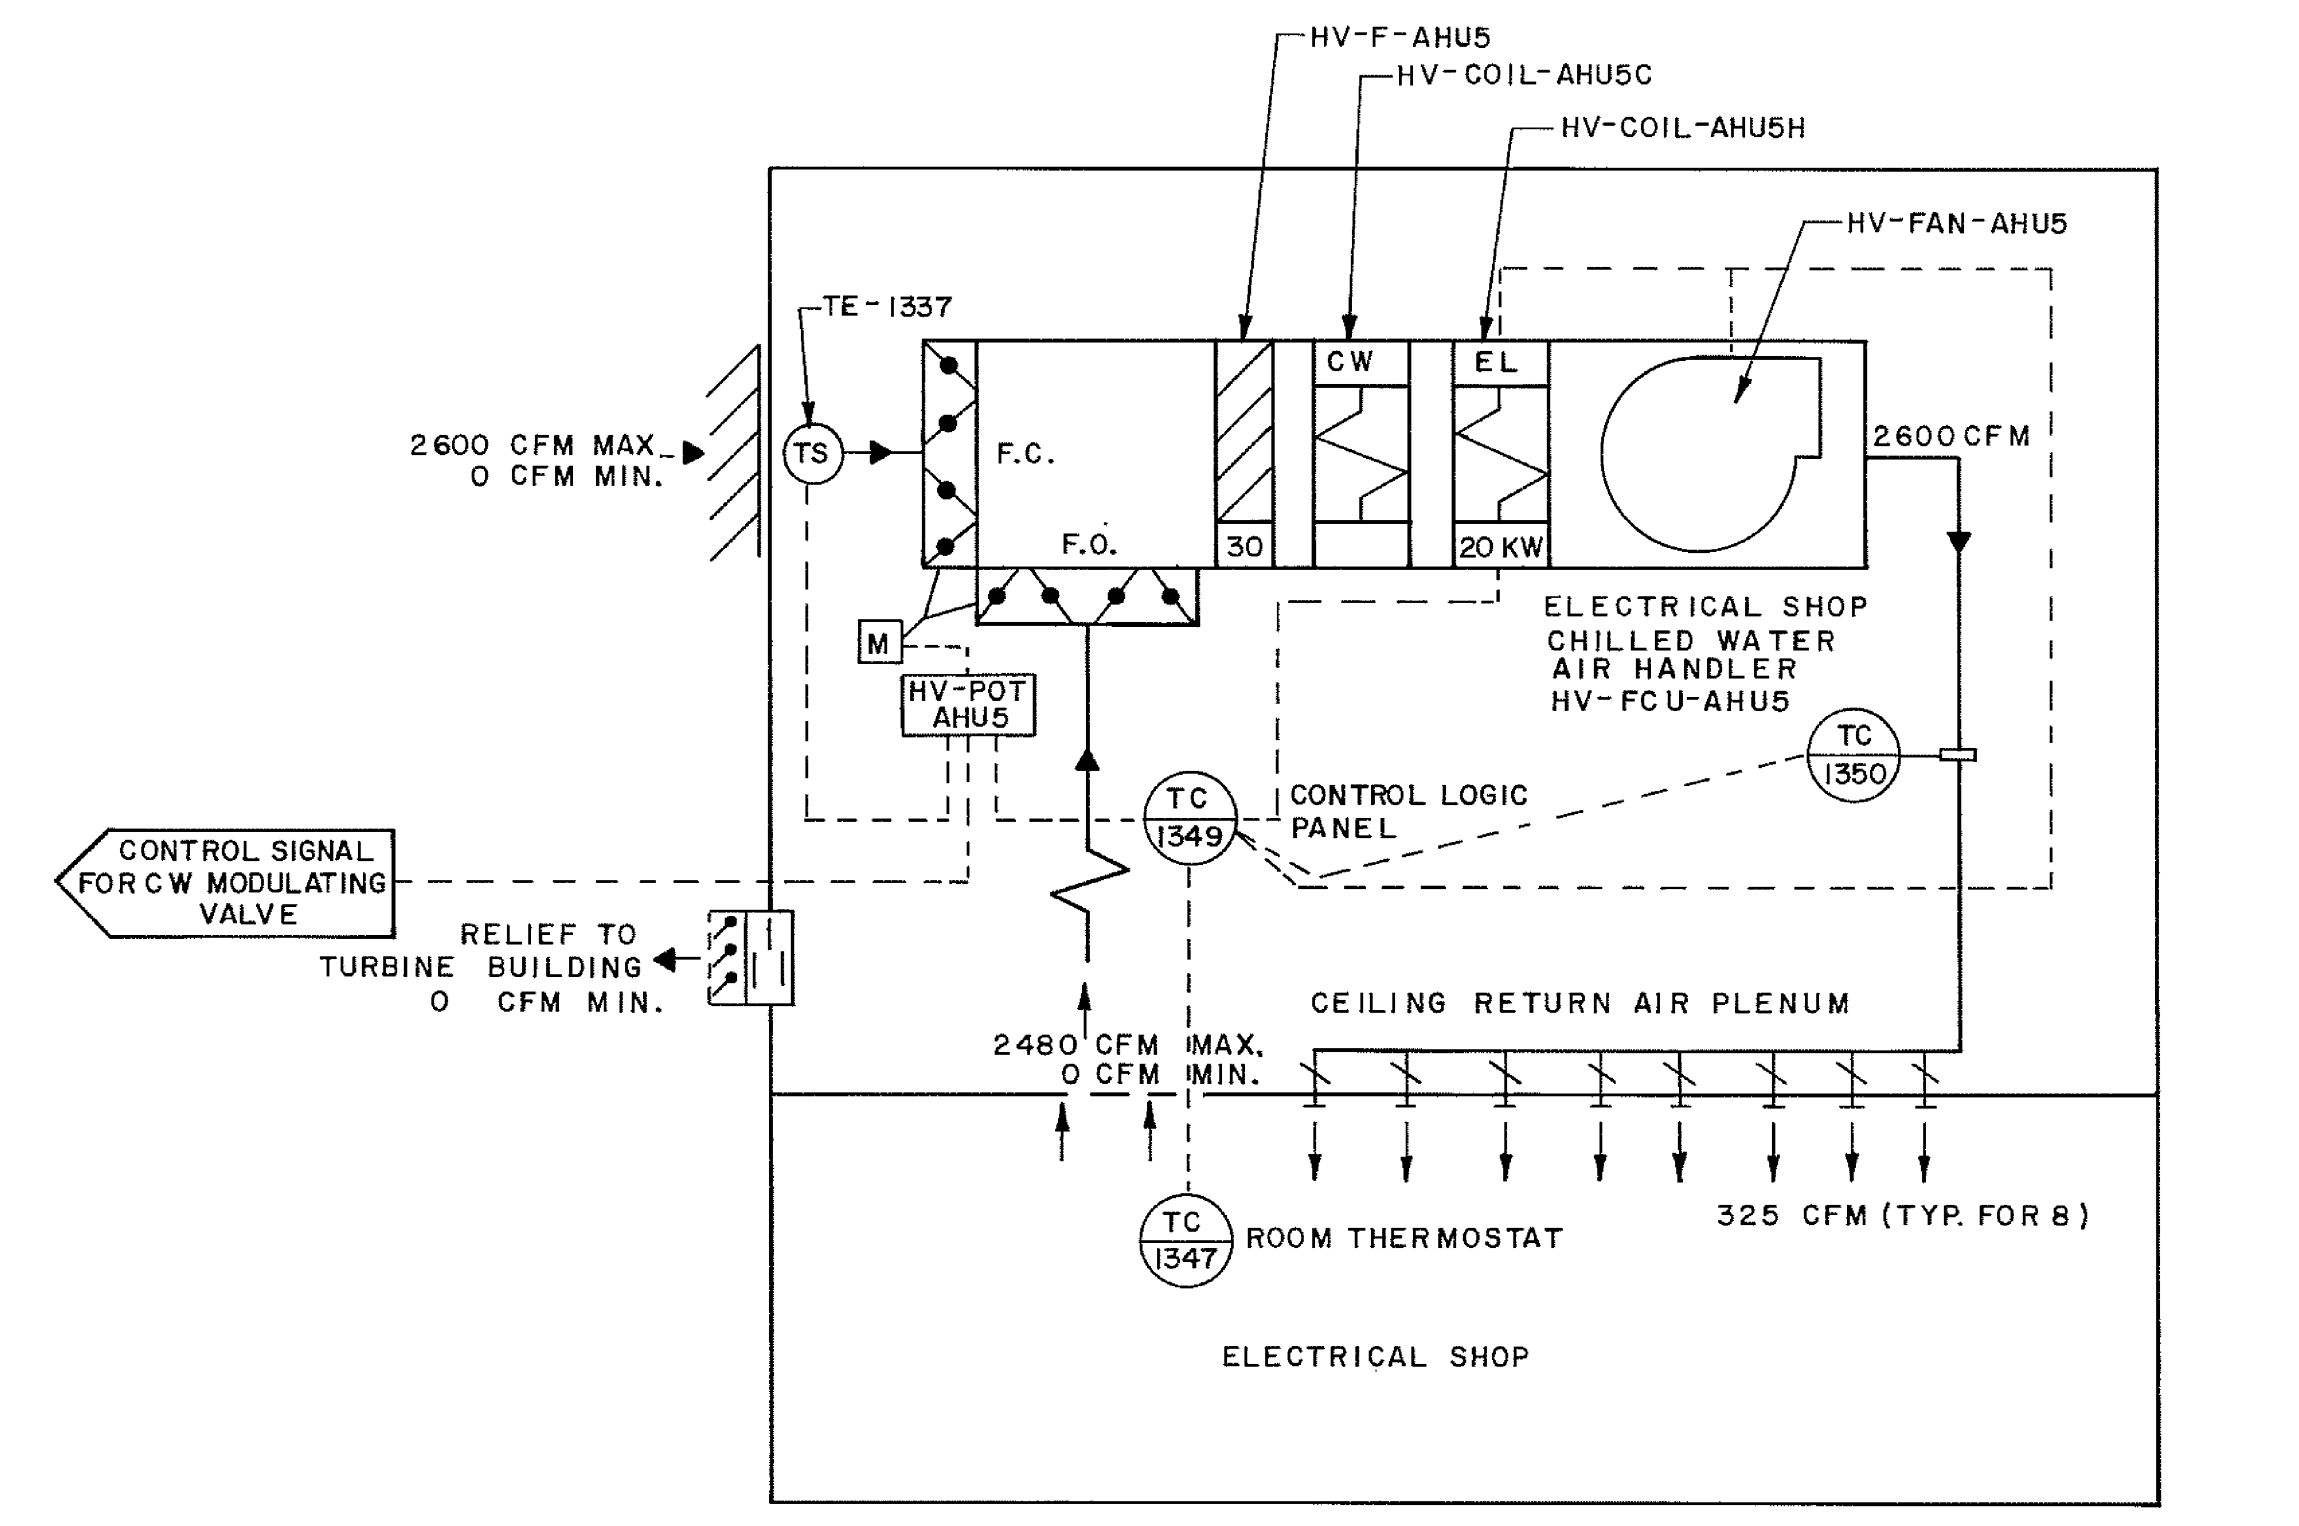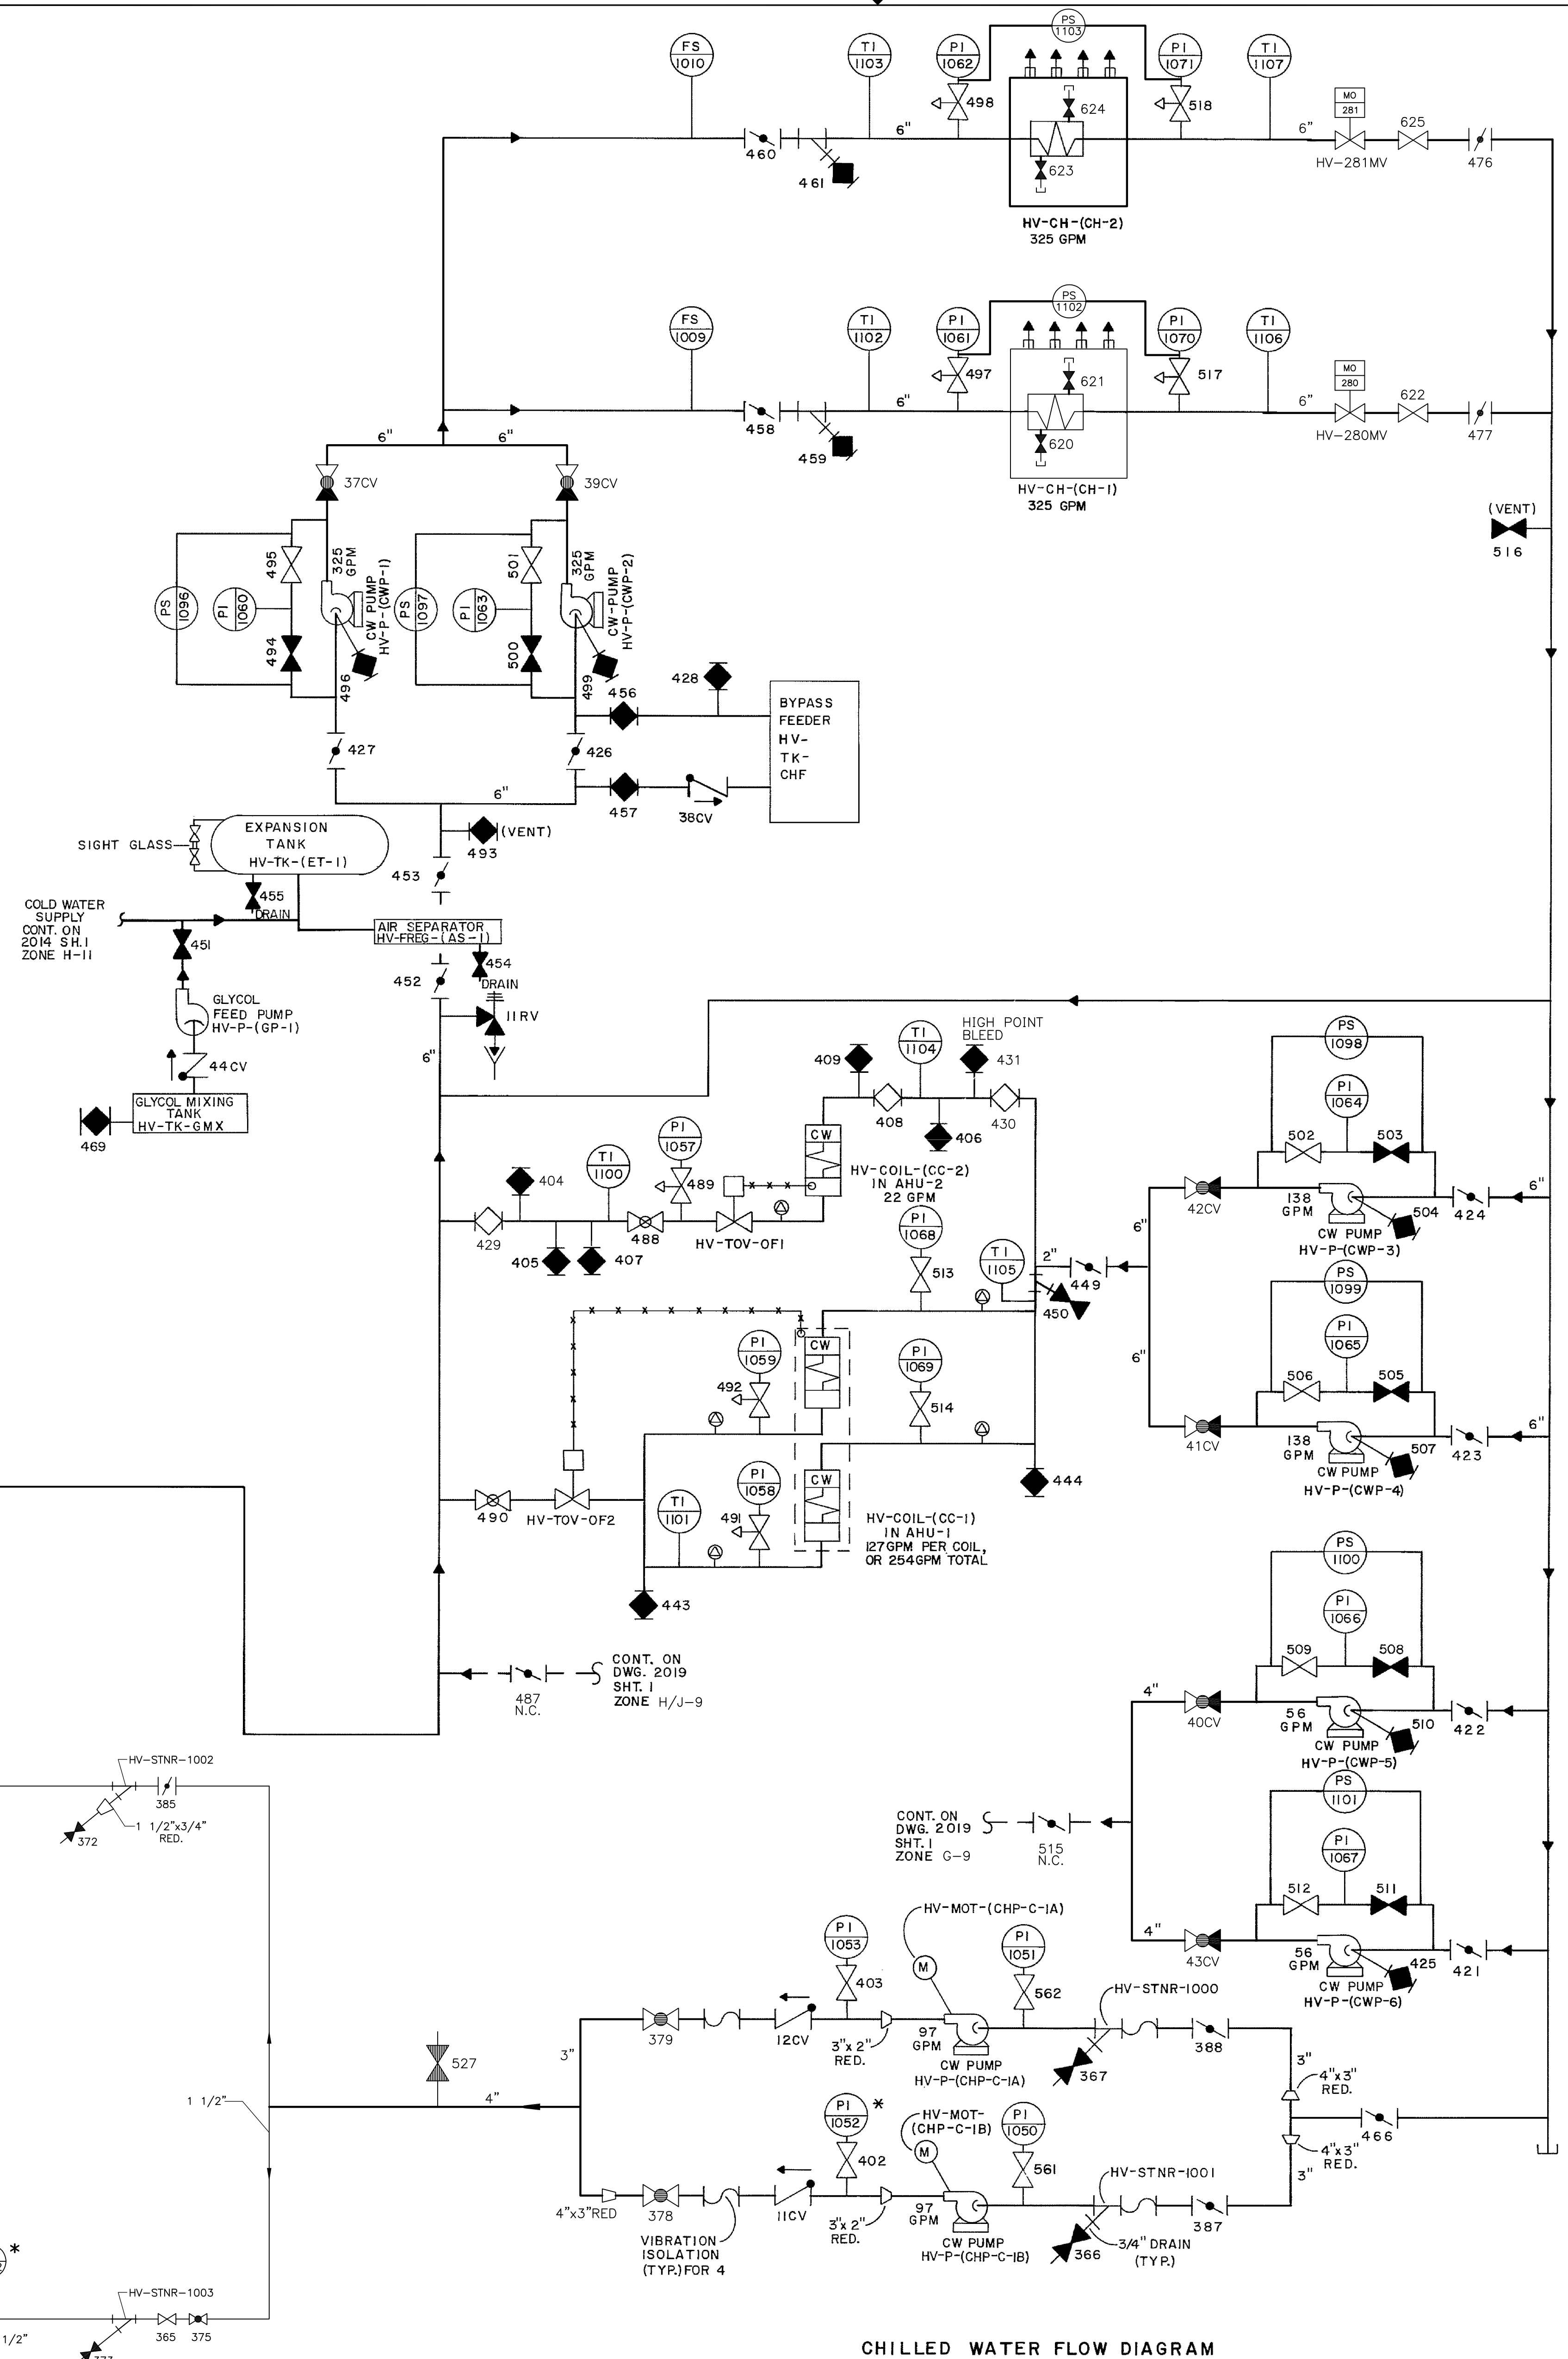

CHILLED WATER FLOW DIAGRAM

- REFERENCES:**
- 1) FOR CONTROLS FOR CONTROL BLDG. H&V UNIT I-HV-C-1A. SEE HONEYWELL DWG. 932-89003, SHT. 1.
  - 2) FOR CONTROLS FOR ELECT. SHOP AHU HV-FCU-AHU5. SEE HONEYWELL DWG. 932-89003, SHT. 2.
  - 3) BURNS & ROE DWG. 2018.
- NOTES:**
- 1) \* FURNISHED WITH PUMPS OR CW COIL UNITS.
  - 2) @ - AIR BLEED

\* THIS DRAWING GENERATED BY NPPD

NO. REVISIONS

--	--

FOR PREVIOUS REVISIONS, SEE SUPERSEDED CARDS.

NO.	REVISIONS	BY	DATE

COOPER NUCLEAR STATION  
 FLOW DIAGRAM CHILLED WATER SYSTEM  
 ELECTRICAL SHOP, NON-CRITICAL SWITCHGEAR, CONTROL & OFFICE BLDG.

NO.	1	2	3	4	5	6
DATE	10/15/90					
DATE	10/15/90					
DATE	10/16/90					

2019 SH 2 N11


AS BUILT  
 454236406

SCAN/CADD DWG

DO NOT REVISE MANUALLY

BURNS & ROE

REVISION NO. 00053029

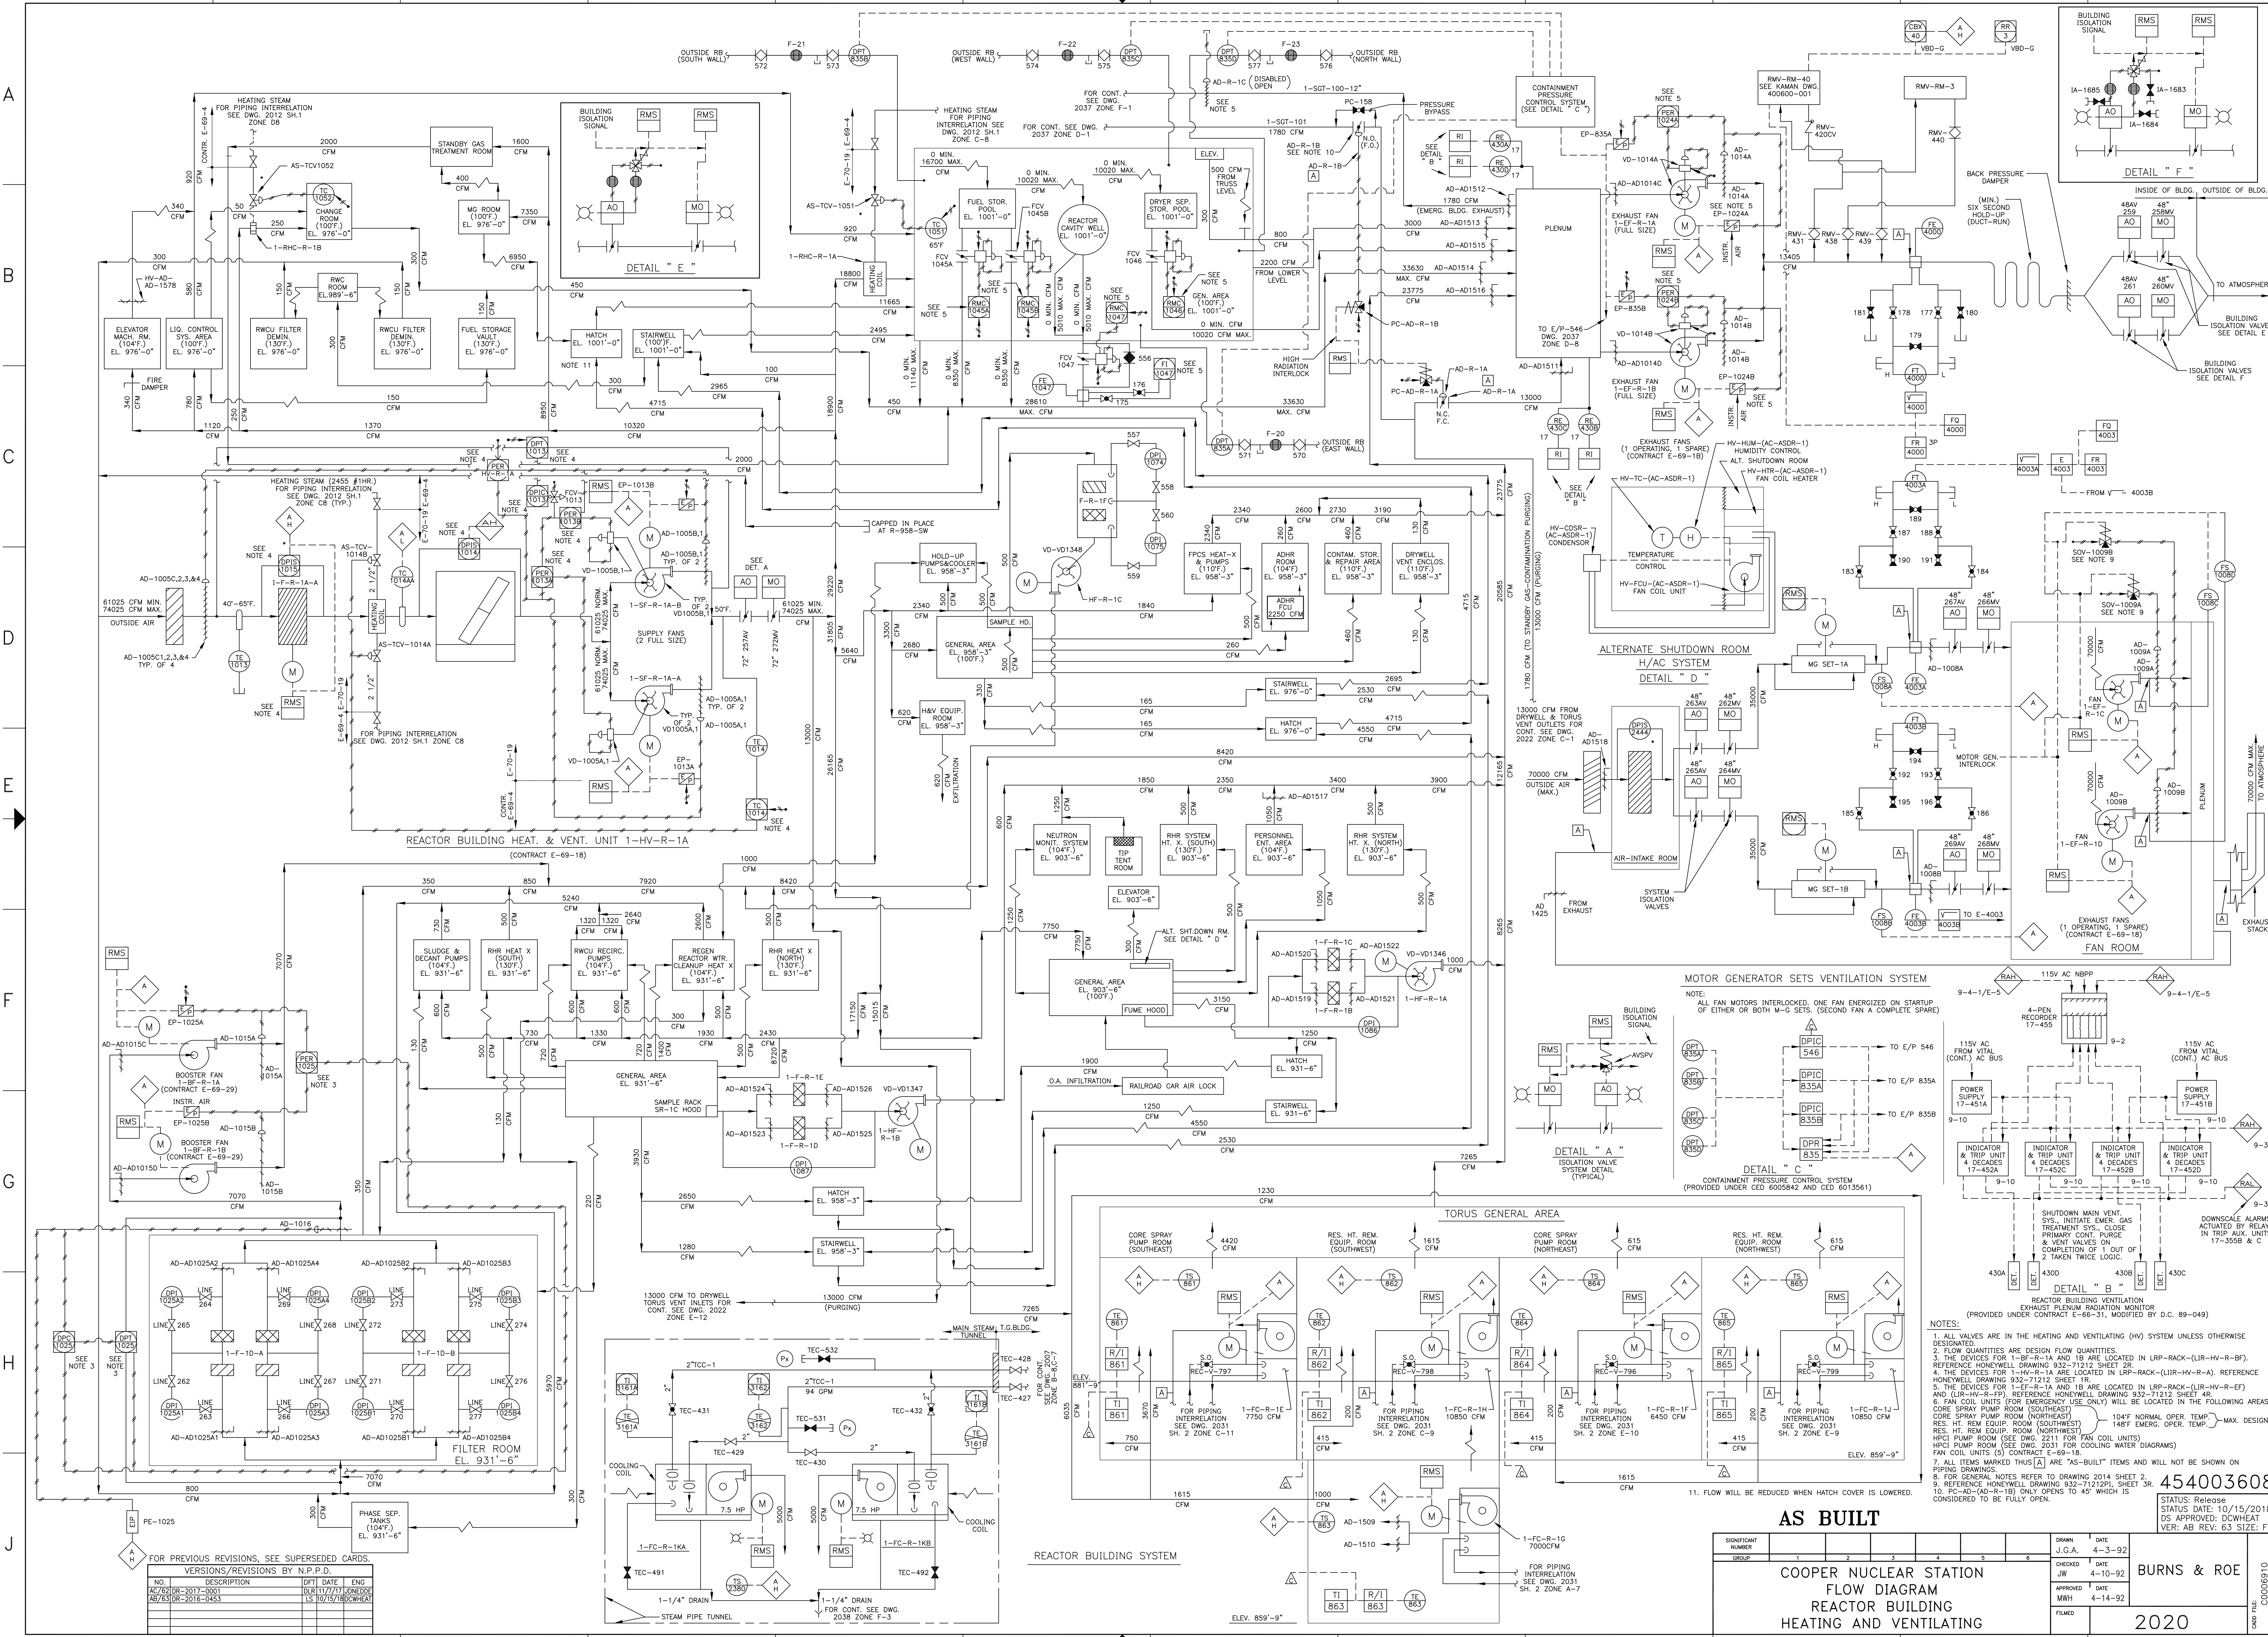

FOR PREVIOUS REVISIONS, SEE SUPERSEDED CARDS.

NO.	DESCRIPTION	DPT	DATE	ENG
AC/62	DR-2017-0001	DLR	11/7/17	JKH/DFD
AB/53	DR-2018-0453	LS	10/15/18	DCW/HEA

VERSIONS/REVISIONS BY N.P.P.D.

**AS BUILT**


COOPER NUCLEAR STATION  
 FLOW DIAGRAM  
 REACTOR BUILDING  
 HEATING AND VENTILATING

454003608

STATUS: Release  
 STATUS DATE: 10/15/2018  
 DS APPROVED: DCW/HEA  
 VER: AB REV: 63 SIZE: F

SIGNIFICANT NUMBER	GROUP	1	2	3	4	5	6	7	8	9	10	11	12
DATE	J.G.A.	4-3-92											
CHECKED	J.W.	4-10-92											
APPROVED	M.W.H.	4-14-92											
FILED													

11. FLOW WILL BE REDUCED WHEN HATCH COVER IS LOWERED.

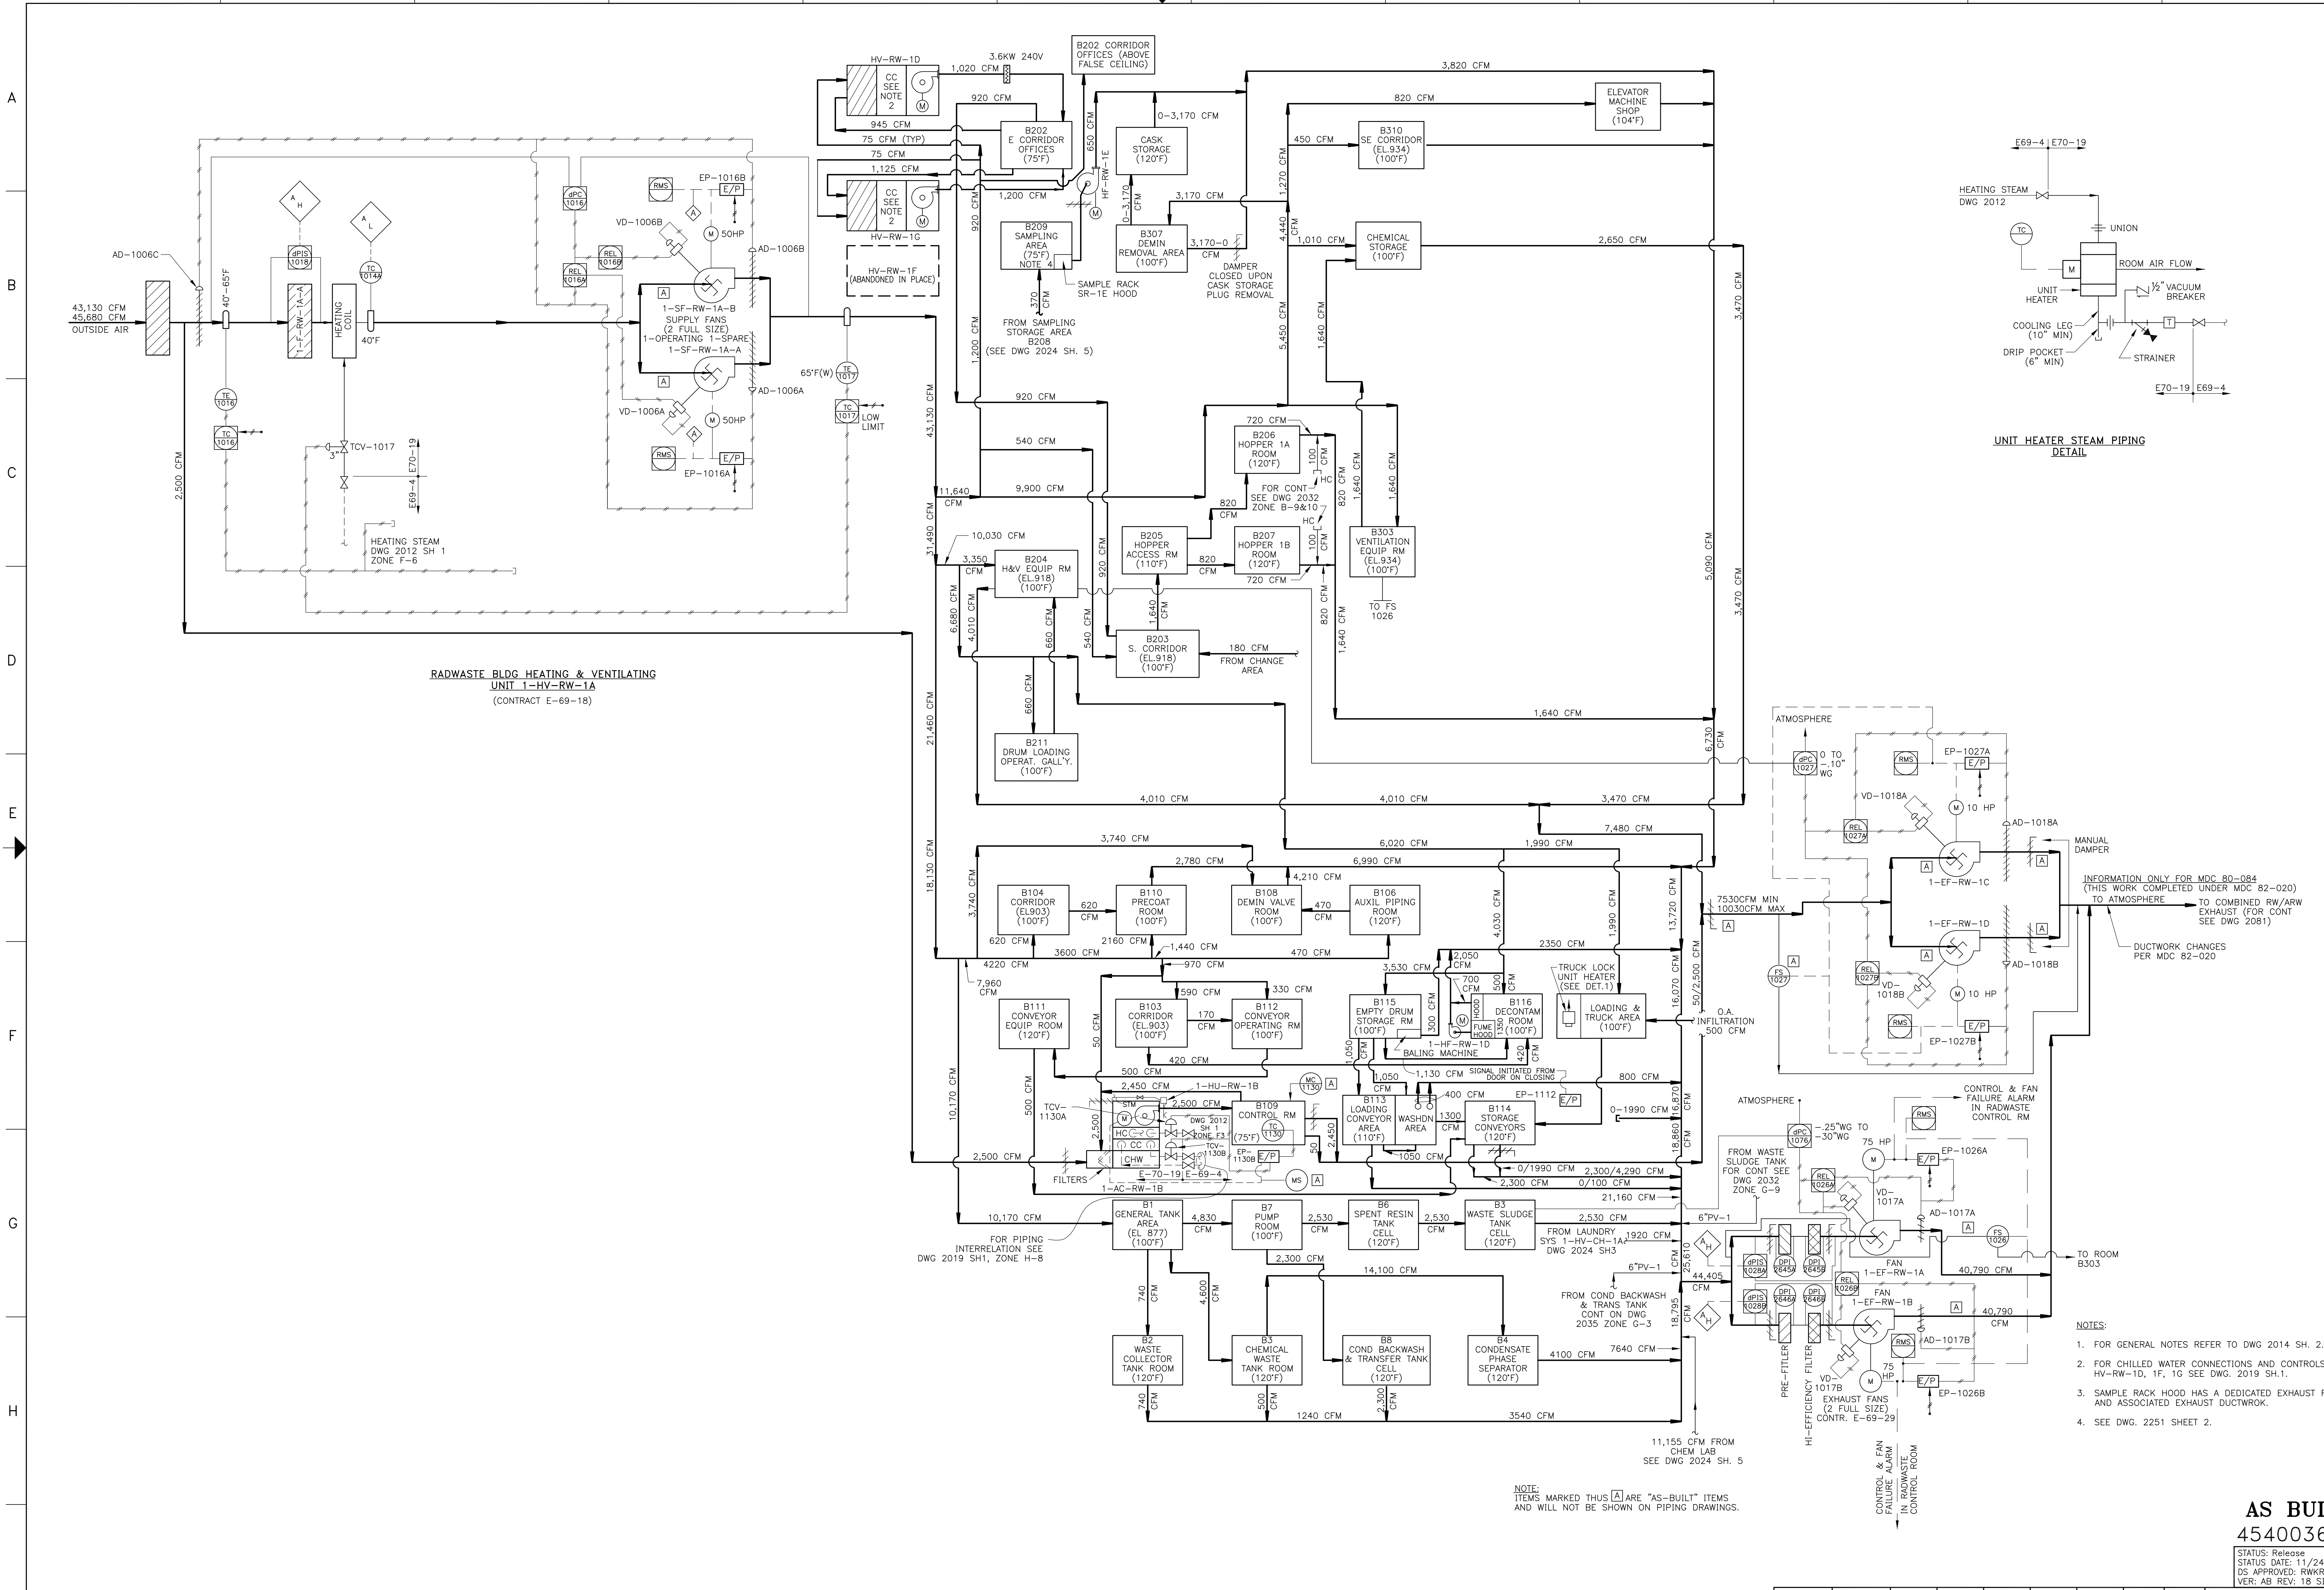

**RADWASTE BLDG HEATING & VENTILATING UNIT 1-HV-RW-1A**  
(CONTRACT E-69-18)

**UNIT HEATER STEAM PIPING DETAIL**

INFORMATION ONLY FOR MDC 80-084  
(THIS WORK COMPLETED UNDER MDC 82-020)  
TO COMBINED RW/ARW EXHAUST (FOR CONT SEE DWG 2081)

- NOTES:**
- FOR GENERAL NOTES REFER TO DWG 2014 SH. 2.
  - FOR CHILLED WATER CONNECTIONS AND CONTROLS OF HV-RW-1D, 1F, 1G SEE DWG. 2019 SH.1.
  - SAMPLE RACK HOOD HAS A DEDICATED EXHAUST FAN AND ASSOCIATED EXHAUST DUCTWORK.
  - SEE DWG. 2251 SHEET 2.

NOTE:  
ITEMS MARKED THUS [A] ARE "AS-BUILT" ITEMS AND WILL NOT BE SHOWN ON PIPING DRAWINGS.

FOR PREVIOUS REVISIONS, SEE SUPERSEDED CARDS

VERSIONS/REVISIONS BY N.P.P.D.			
NO.	DESCRIPTION	DFT DATE	ENG
AB/78	OR-2014-0008	DUR/17/24/14	BDSEIDL

SIGNATURE NUMBER	GROUP	DATE
1	2	3
4	5	6


**AS BUILT**  
454003609  
STATUS: Release  
STATUS DATE: 11/24/2014  
DS APPROVED: RWKRAUS  
VER: AB REV: 18 SIZE: F

**BURNS & ROE**

2021

COO36684

**FLOW DIAGRAM  
RADWASTE BUILDING  
HEATING & VENTILATING  
COOPER NUCLEAR STATION**

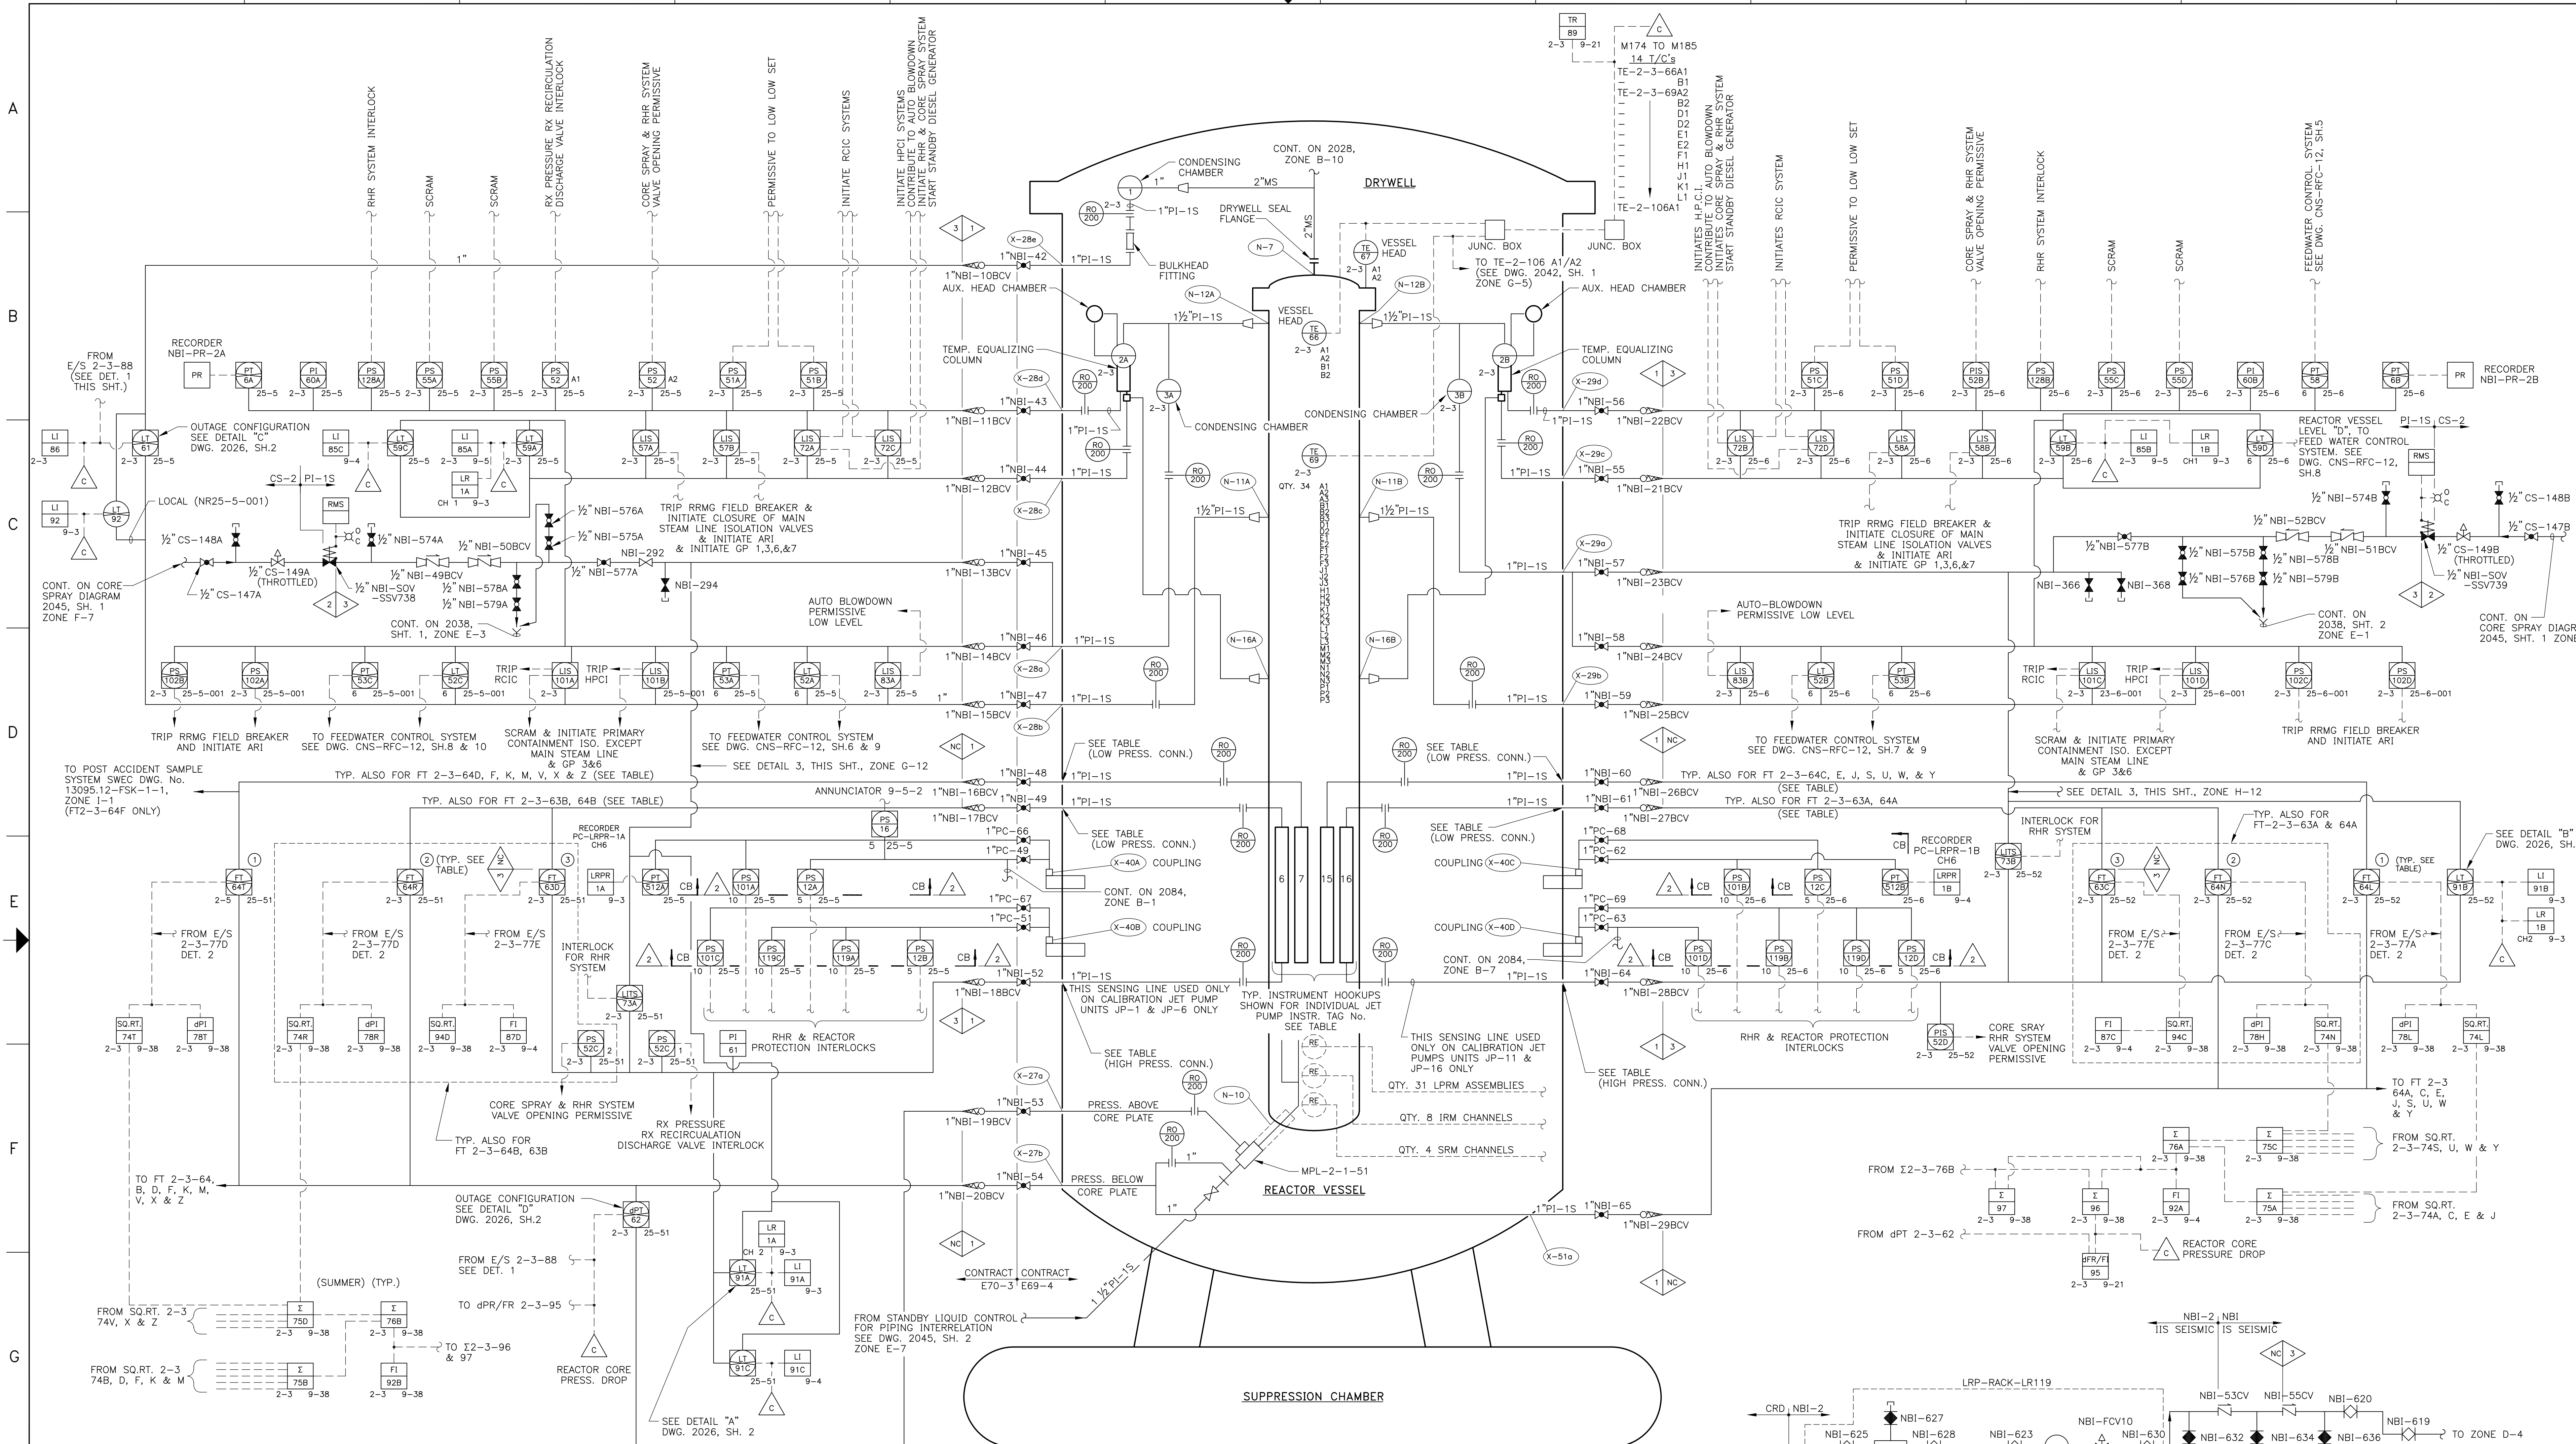

EXCESS FLOW BALL CHECK NUMBERS	INSTRUMENT LINE ROOT VALVE NUMBERS	JET PUMP	JET PUMP INSTR. PENET. NO.	INSTRUMENT TRANSMITTER	MATCHING TABLE
NBI-30BCV	NBI-30	JP-1	UPPER X-400-c	NBI-FT ①	NBI-FT ②
NBI-31BCV	NBI-31	JP-1	LOWER X-400-b	FT64B	FT63B
NBI-32BCV	NBI-32	JP-2	X-400-e	FT64D	FT63B
NBI-33BCV	NBI-33	JP-3	X-400-d	FT64F	-
NBI-34BCV	NBI-34	JP-4	X-400-f	FT64K	-
NBI-35BCV	NBI-35	JP-5	X-400-a	FT64M	-
NBI-36BCV	NBI-36	JP-6	UPPER X-400-c	FT64R	FT63D
NBI-37BCV	NBI-37	JP-6	LOWER X-400-b	FT64R	FT63D
NBI-38BCV	NBI-38	JP-7	X-400-a	FT64T	-
NBI-39BCV	NBI-39	JP-8	X-400-a	FT64V	-
NBI-40BCV	NBI-40	JP-9	X-400-f	FT64X	-
NBI-41BCV	NBI-41	JP-10	X-400-a	FT64Z	-
NBI-42BCV	NBI-42	JP-11	UPPER X-400-c	FT64A	FT63A
NBI-43BCV	NBI-43	JP-11	LOWER X-400-b	FT64A	FT63A
NBI-44BCV	NBI-44	JP-12	X-400-e	FT64C	-
NBI-45BCV	NBI-45	JP-13	X-400-d	FT64E	-
NBI-46BCV	NBI-46	JP-14	X-400-f	FT64J	-
NBI-47BCV	NBI-47	JP-15	X-400-a	FT64L	-
NBI-48BCV	NBI-48	JP-16	UPPER X-400-c	FT64N	FT63C
NBI-49BCV	NBI-49	JP-16	LOWER X-400-b	FT64N	FT63C
NBI-50BCV	NBI-50	JP-17	X-400-e	FT64S	-
NBI-51BCV	NBI-51	JP-18	X-400-d	FT64U	-
NBI-52BCV	NBI-52	JP-19	X-400-f	FT64W	-
NBI-53BCV	NBI-53	JP-20	X-400-a	FT64Y	-

- NOTES:**
- PROCESS INSTRUMENTATION (PI-1S) LINES UP TO AND INCLUDING ROOT VALVES V-276X SHALL BE FURNISHED AND INSTALLED UNDER CONTRACT E-69-4.
  - DELETED.
  - INSTRUMENT, SAMPLE, TEST, DRAIN AND VENT LINES ARE NOT ALWAYS THE SAME CLASS AS THE MAIN LINE AND THESE BOUNDARIES ARE TOO NUMEROUS TO IDENTIFY IN THIS MANNER (SEE ISI PROGRAM BOUNDARY DESCRIPTIONS FOR DETAILS).
  - CB IS CONTAINMENT BOUNDARY.
  - WHERE LINES ARE INTERCONNECTED AND CONTINUED ON OTHER DRAWINGS, INSTRUMENT NUMBERS ARE APPROXIMATE ONLY.

REVISIONS TO THIS DRAWING REQUIRES A REVISION TO THE CORRESPONDING ISOKEY.

FOR PREVIOUS REVISIONS, SEE SUPERSEDED CARDS.

NO.	DESCRIPTION	DFT DATE	ENG
AB/87/DR-2015-0641		DJB/10/27/18	TCMULL
BC/88/DR-2015-0641		DJB/10/27/18	JONEDDE

**AS BUILT**  
454003616



STATUS: Release  
STATUS DATE: 10/22/2016  
DS APPROVED: JONEDDE  
VER: AC REV: 68 SIZE: F


SIGNIFICANT NUMBER	GROUP	1	2	3	4	5	6	DRAWN	DATE

COOPER NUCLEAR STATION  
FLOW DIAGRAM  
REACTOR VESSEL  
INSTRUMENTATION

CHECKED	DATE	APPROVED	DATE	FILED


BURNS & ROE  
2026 SH 1

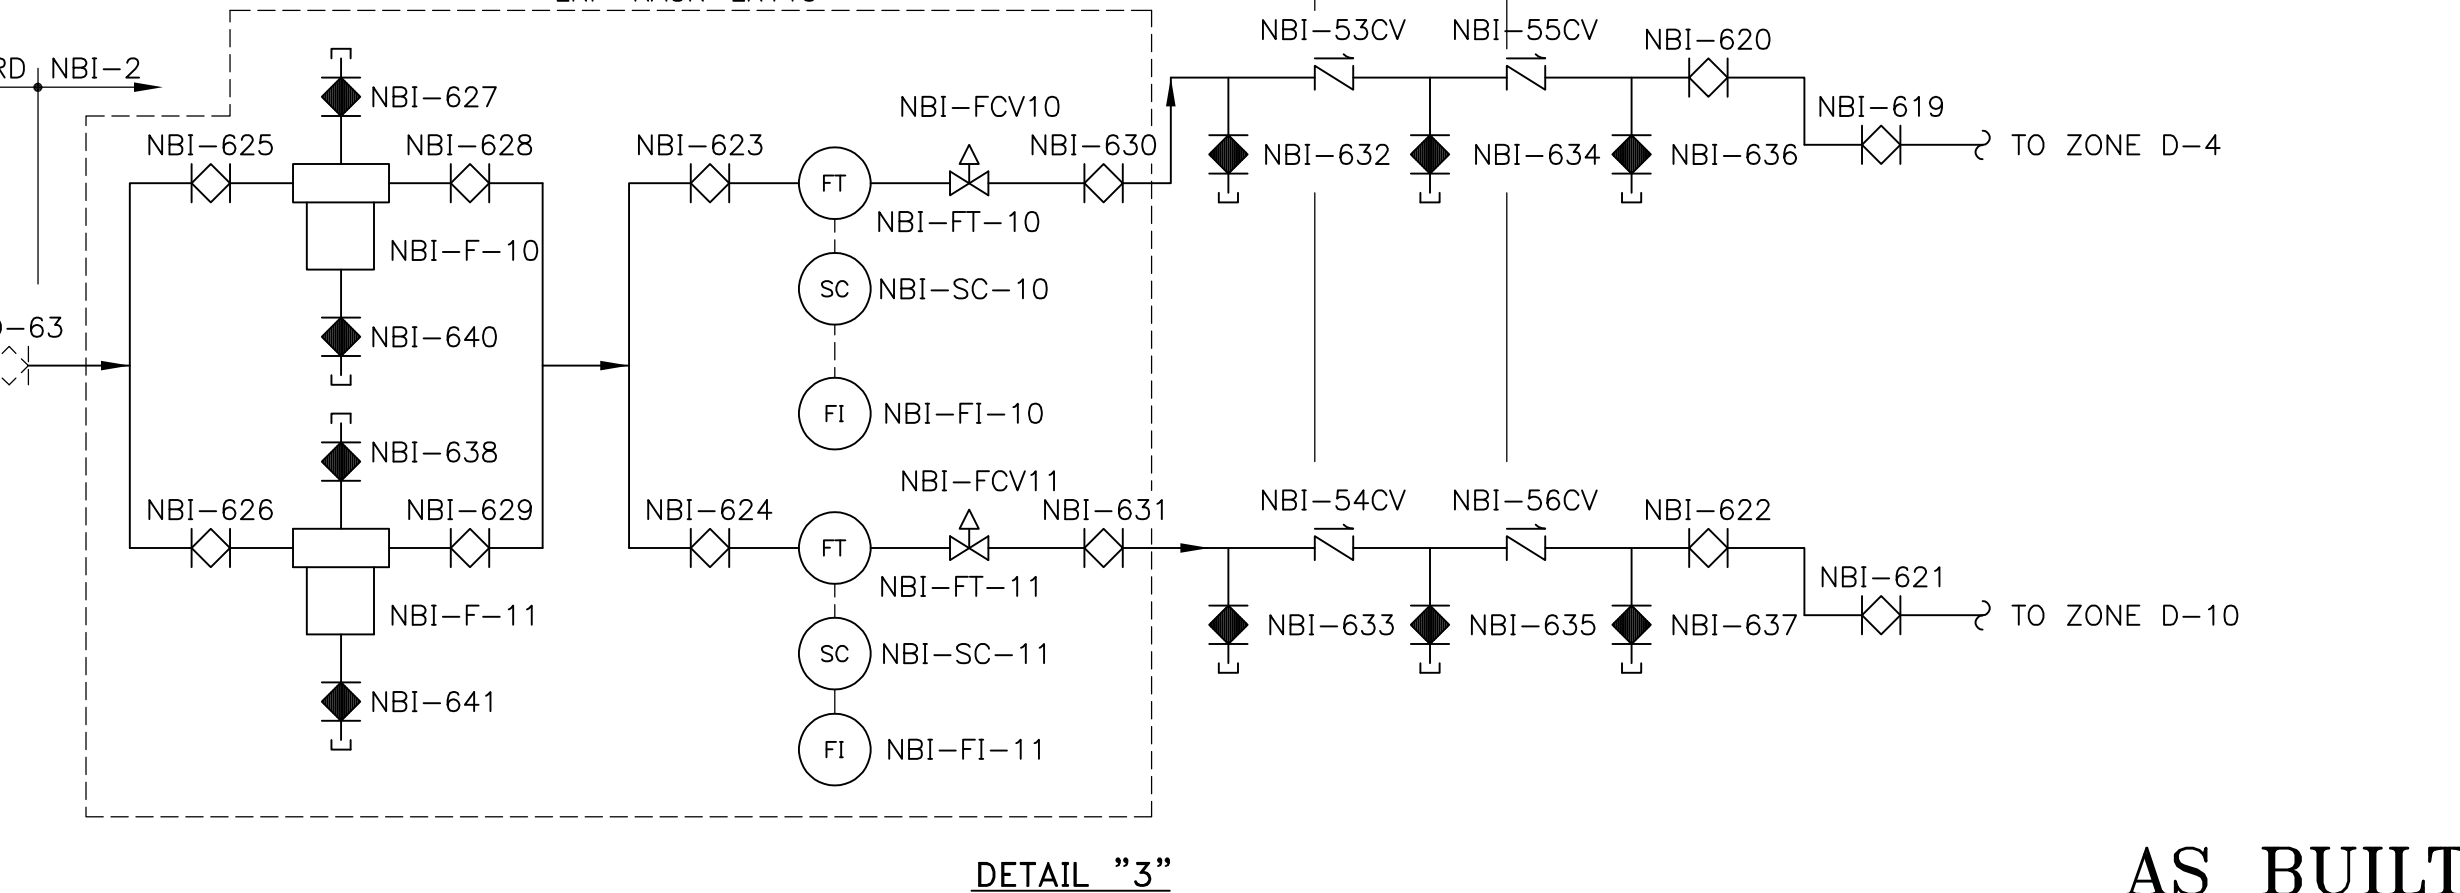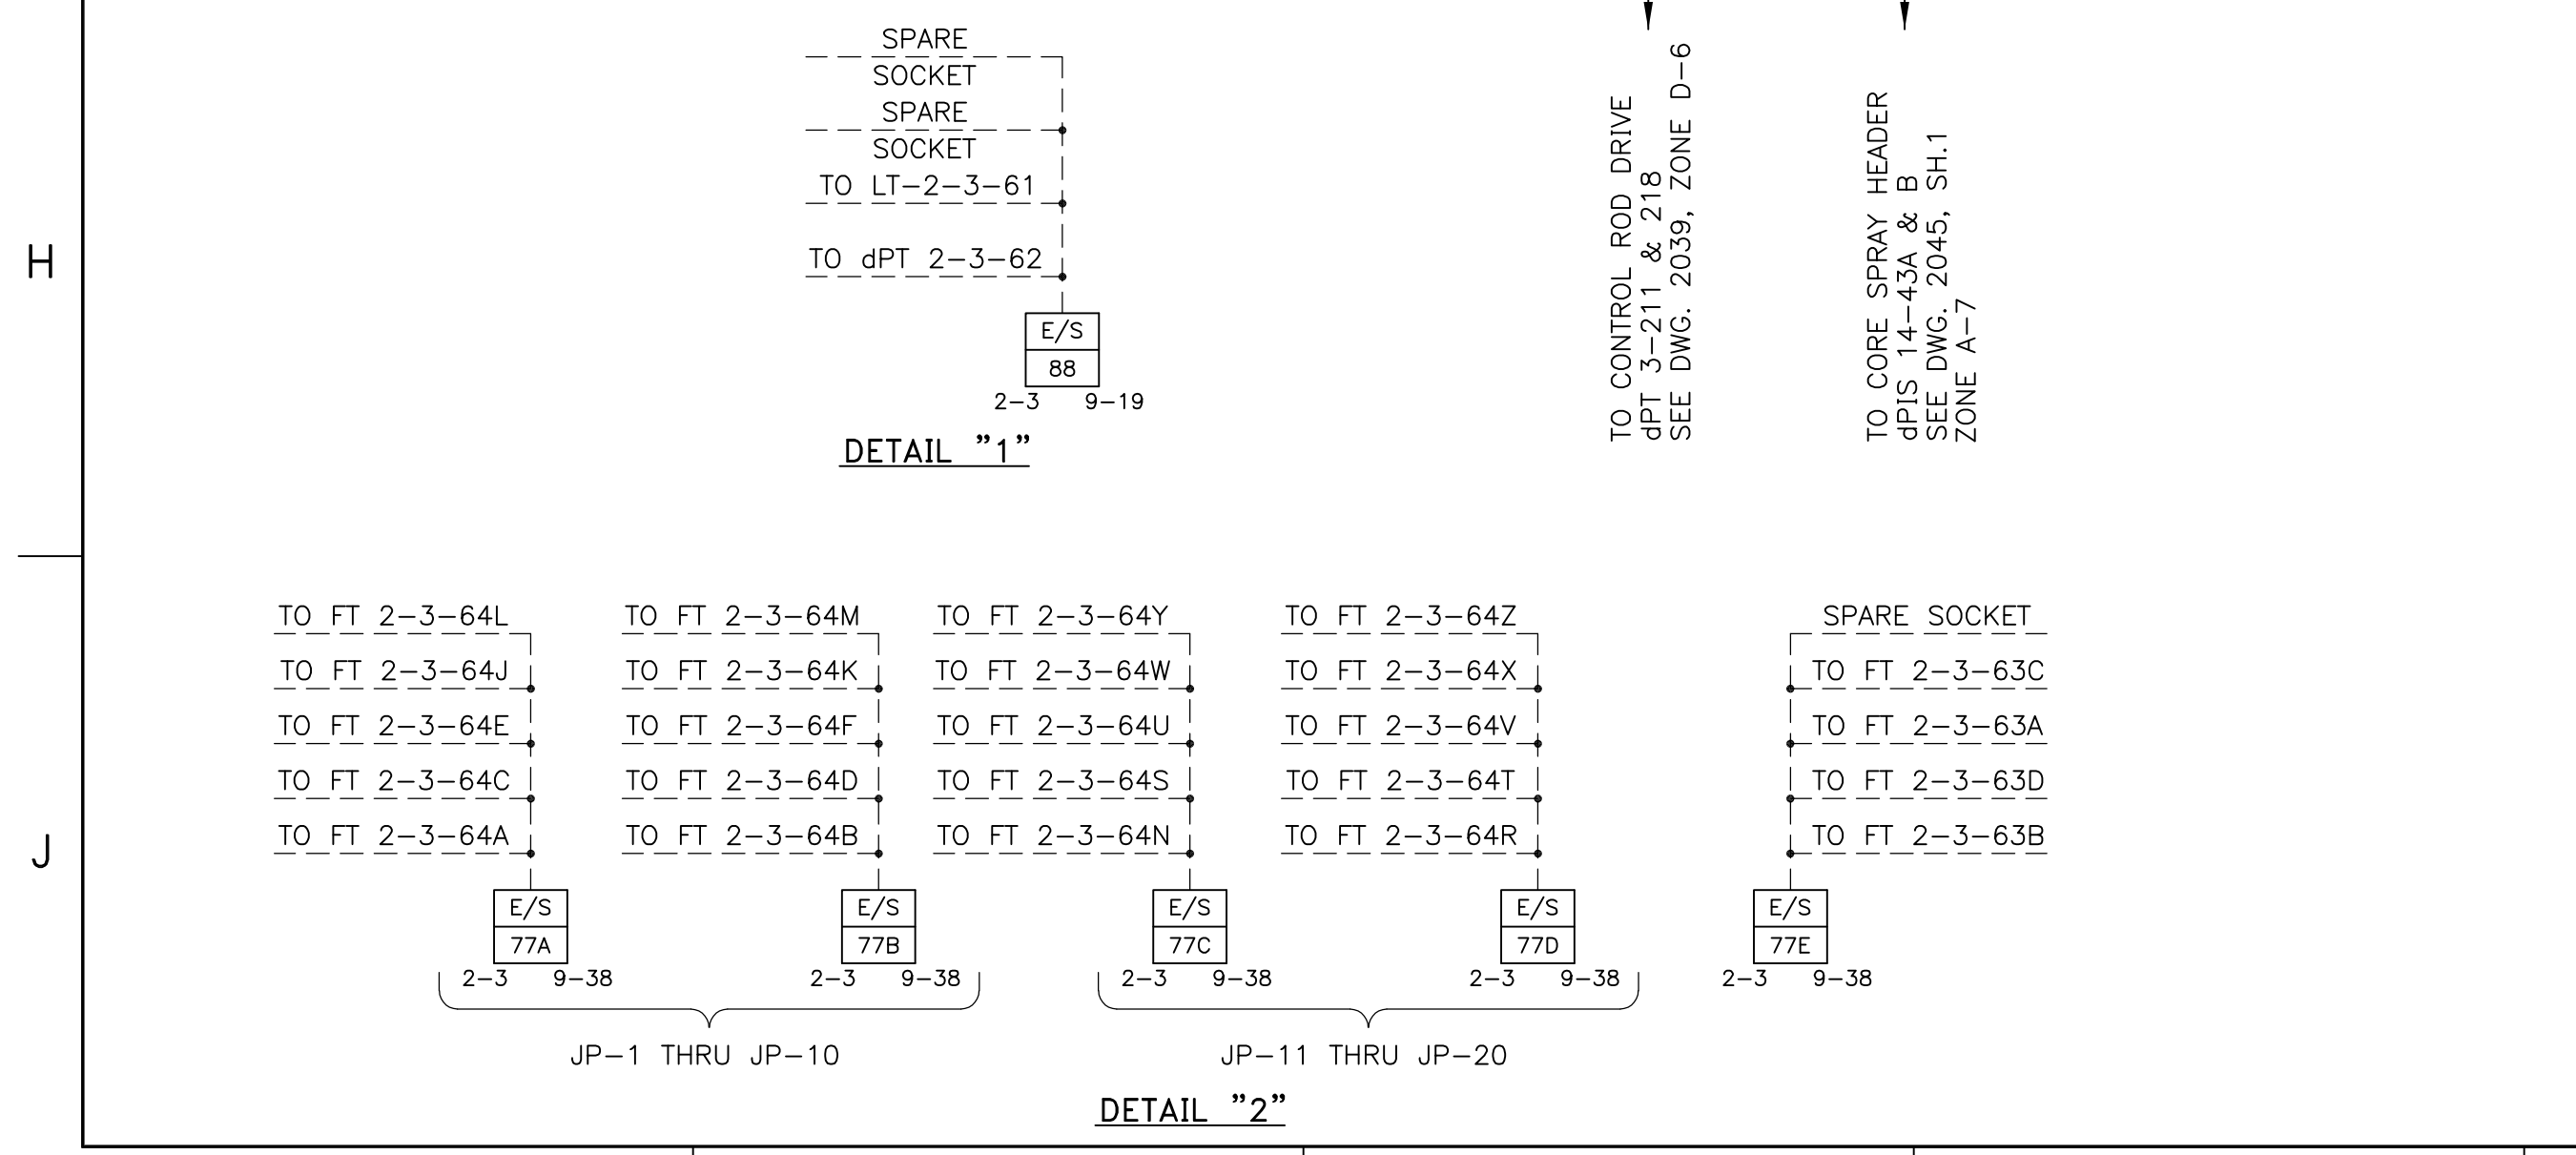

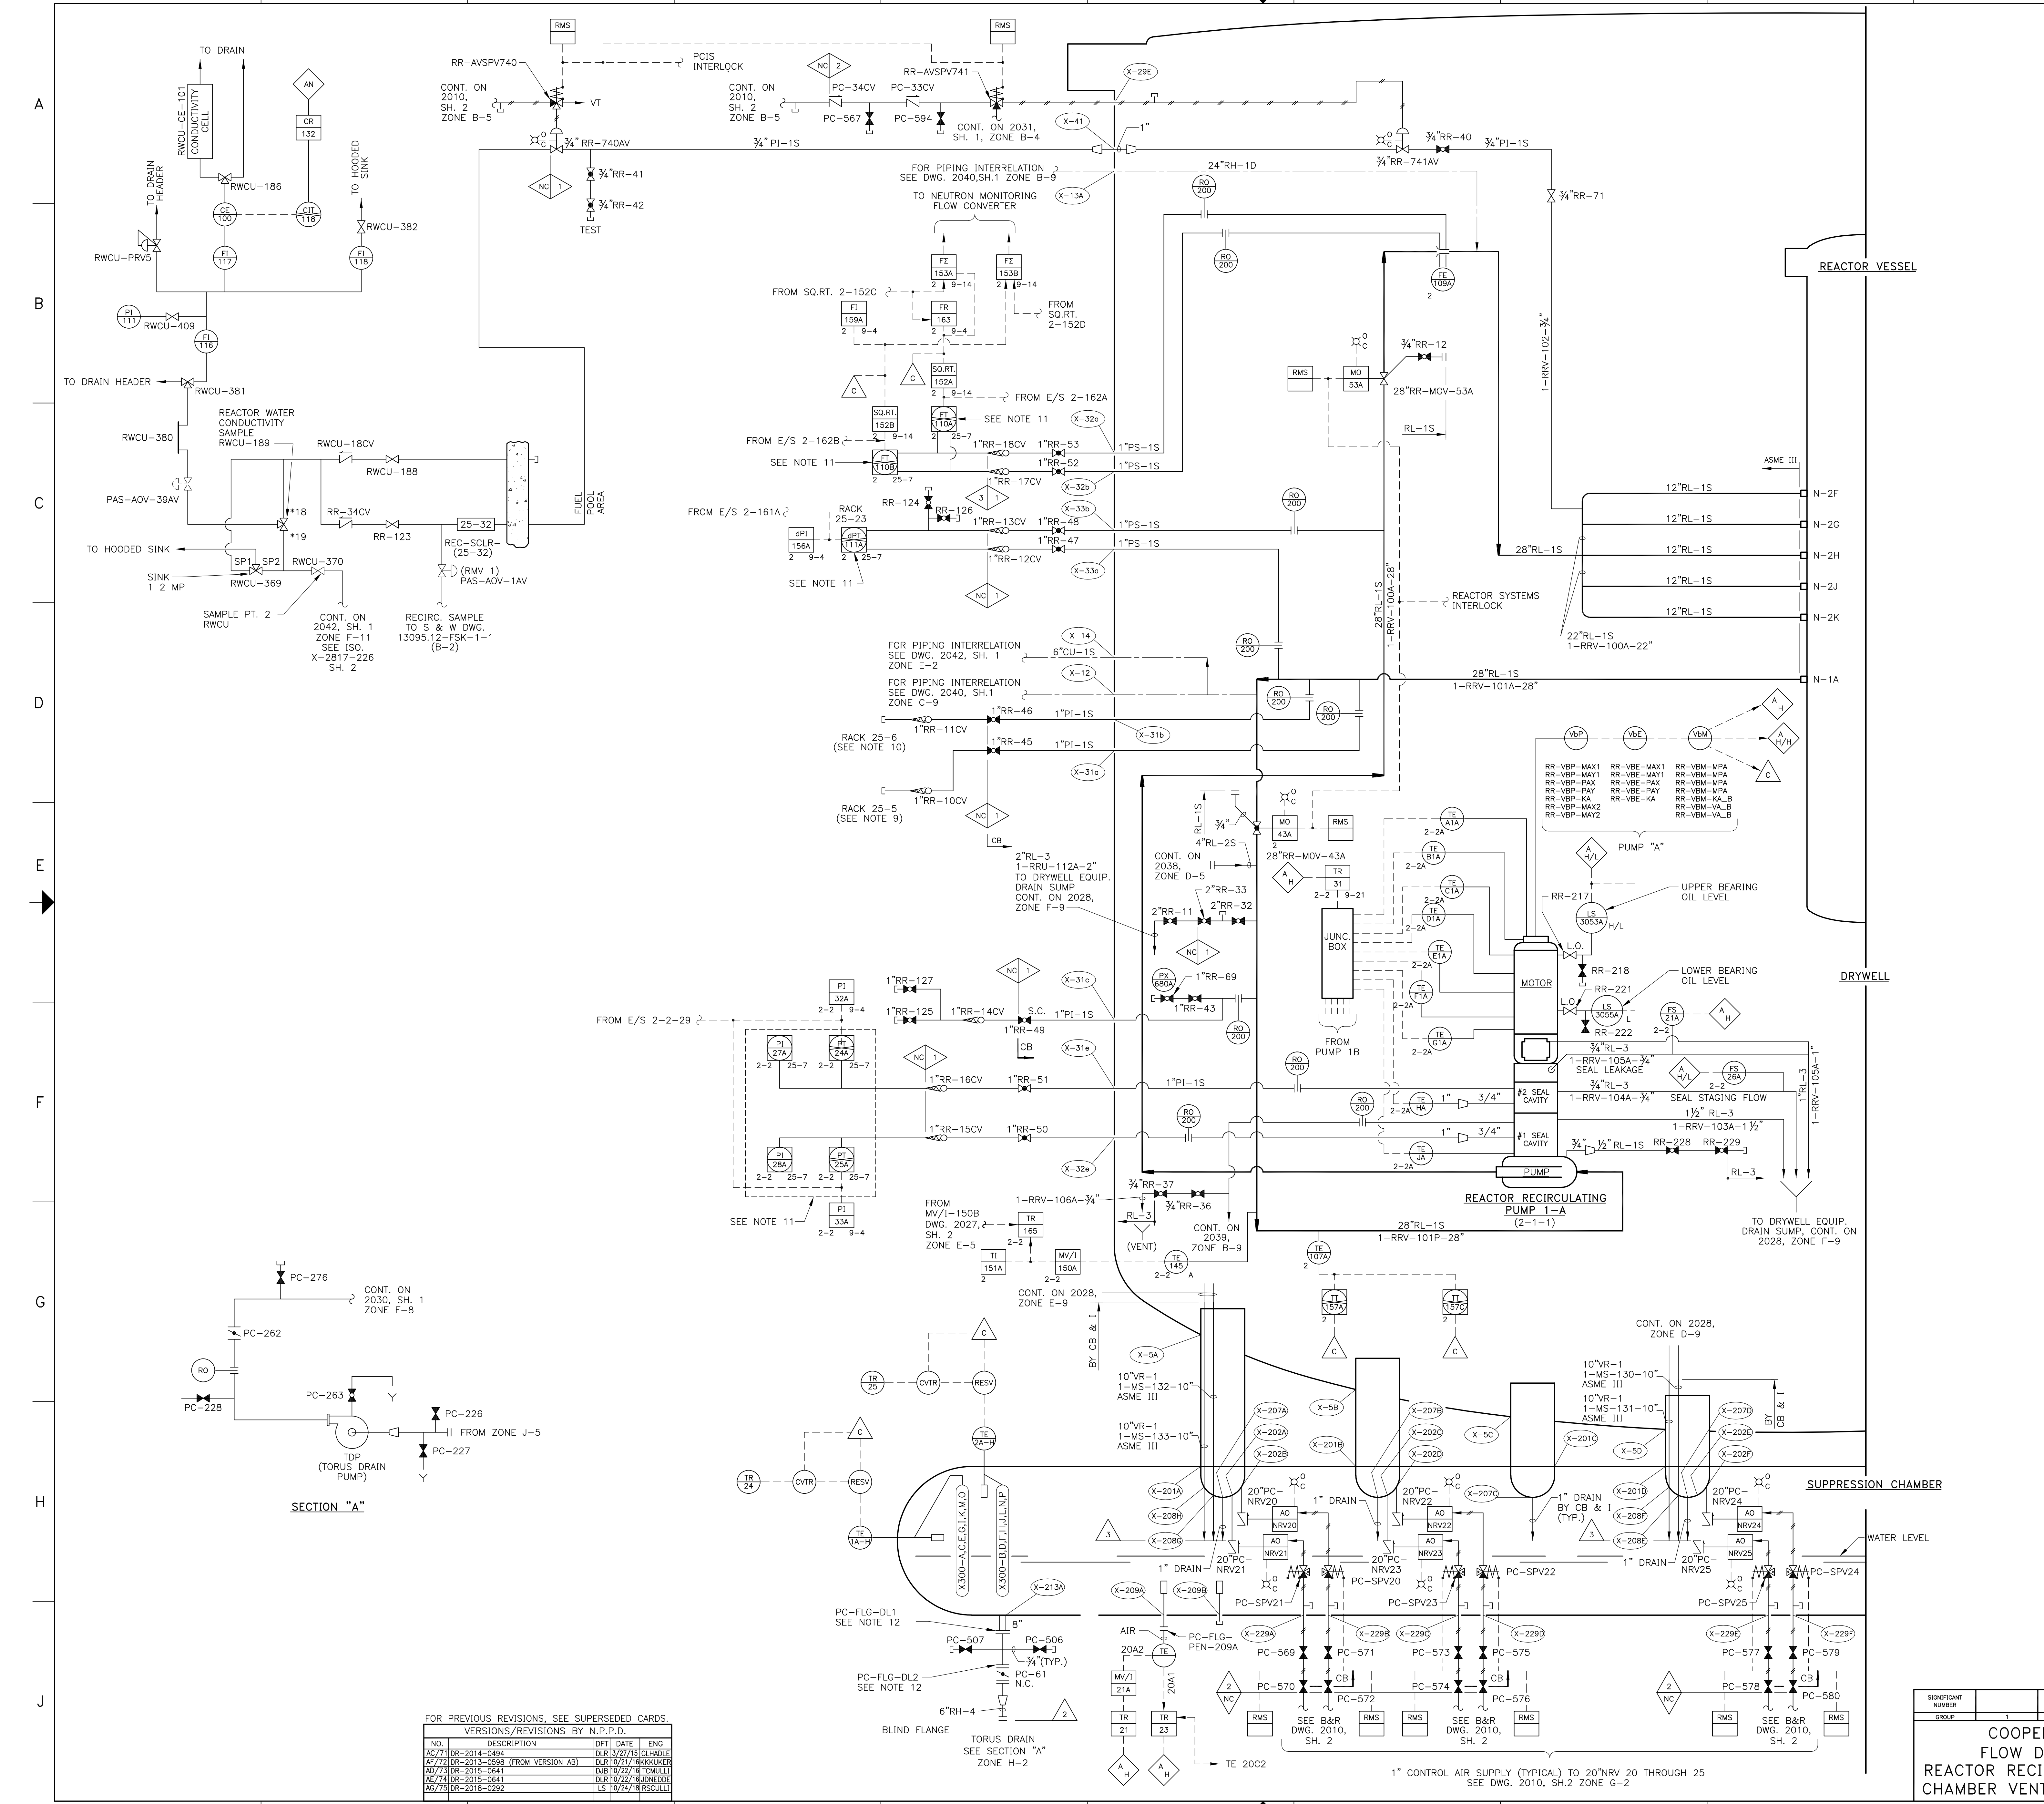

NOTES:

- FOR PRESSURE SENSING LINES, LINE UP TO AND INCLUDING ROOT VALVE SHALL BE FURNISHED & INSTALLED UNDER CONTRACT E-69-4.
- SAMPLING POINT SP-1 LINE UP TO AND INCLUDING 3/4" 740AV976P SHALL BE FURNISHED AND INSTALLED UNDER CONTRACT E-69-4. CONTINUATION OF SAMPLING PIPING BY E-70-3.
- REPLACEMENT PIPING FOR THE REACTOR RECIRCULATION LINES WAS FURNISHED BY NIAC UNDER CONTRACT 83-41 AND INSTALLED BY CBI UNDER CONTRACT 84-2. SEE MDC 84-150 FOR DETAILS.
- HIGH POINT VENTS AND LOW POINT DRAINS NOT SHOWN.
- DELETED.
- 2" VALVE 276X (PC-V-65) IS DISCONNECTED FROM TORUS DRAIN PEN-T-213B. PIPING WAS NO LONGER REQUIRED AS A RESULT OF DC 76-2. PIPING WAS REMOVED AND PIPE CAPS INSTALLED PER CONTRACT 84-2. SEE MDC 84-150A AND MDC 84-150A-AMENDMENT 1 FOR DETAILS.
- DELETED.
- REF. GE DWG. 115D6009, SH. 2 FOR INSTRUMENT PIPING AND VALVE INSTALLATION AT INSTRUMENT RACK 25-5. INSTRUMENT TUBING IS CAPPED AT RACK 25-5 DOWN STREAM OF RACK ISOLATION VALVE RR-V-210.
- REF. GE DWG. 115D6010, SH. 2 FOR INSTRUMENT PIPING AND VALVE INSTALLATION AT INSTRUMENT RACK 25-6. INSTRUMENT TUBING IS CAPPED AT RACK 25-6 DOWN STREAM OF RACK ISOLATION VALVE RR-V-212.
- REF. GE DWG. 921D172, SH. 2 FOR INSTRUMENT PIPING AND VALVE INSTALLATION AT INSTRUMENT RACK 25-7.
- TESTABLE FLANGE.
- INSTRUMENT, SAMPLE, TEST, DRAIN AND VENT LINES ARE NOT ALWAYS THE SAME CLASS AS THE MAIN LINE AND THESE BOUNDARIES ARE TOO NUMEROUS TO IDENTIFY IN THIS MANNER (SEE ISI PROGRAM BOUNDARY DESCRIPTIONS FOR DETAILS).
- PENETRATIONS X-202A, X-202B, X-202C, X-202D, X-202E, X-202F, X-202G, X-202H, X-202I, X-202J, X-202K, X-202L, X-202M, X-202N, X-202O, X-202P, X-202Q, X-202R, X-202S, X-202T, X-202U, X-202V, X-202W, X-202X, X-202Y, X-202Z, X-203A, X-203B, X-203C, X-203D, X-203E, X-203F, X-203G AND X-203H ARE NOT CONSIDERED PRIMARY CONTAINMENT PENETRATIONS.
- ALL PIPING OPEN TO PENETRATIONS X-206C, X-206D AND X-215 ON THIS DRAWING IS A PART OF THE PRIMARY CONTAINMENT BOUNDARY.
- CB IS PRIMARY CONTAINMENT BOUNDARY.
- SAMPLE PT 1 RX RECIRC. HEADER.
- SAMPLE PT 2 RWCU F/D INLET.
- WHERE LINES ARE INTERCONNECTED AND CONTINUED ON OTHER DRAWINGS, ZONE NUMBERS ARE APPROXIMATE ONLY.
- PENETRATIONS X-209A & C ARE TESTABLE. PENETRATIONS X-209B & D ARE SPARES AND CAPPED. THERMOCOUPLES TE-20B-1 & TE-20D ARE REMOVED. DC94-212A.

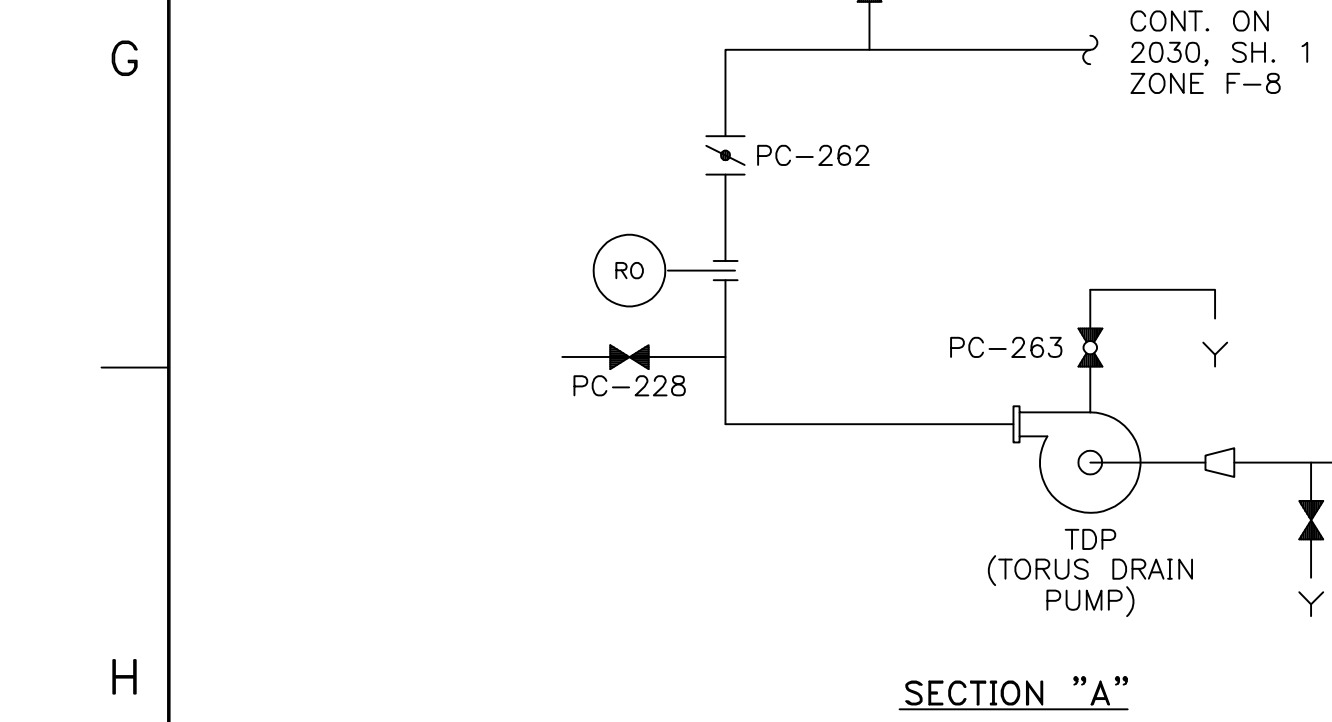


FOR PREVIOUS REVISIONS, SEE SUPERSEDED CARDS.  
 REVISIONS/REVISIONS BY N.P.P.D.

NO.	DESCRIPTION	DFT	DATE	ENG
AC/7110R-2014-0484			08/13/27/73	SHANLEY
AD/7210R-2015-0598	(FROM VERSION AD)		08/10/27/18	WAKOWICZ
AD/7310R-2015-0841			08/10/27/18	COMELLI
AE/7410R-2015-0841			08/10/27/18	JNEBOLD
AD/7510R-2015-0292			11/10/24	RBCULLI

REVISIONS TO THIS DRAWING  
 REQUIRES A REVISION TO THE  
 CORRESPONDING ISOKEY.

AS BUILT 454003617 STATUS: Release STATUS DATE: 10/24/2018 DS APPROVED: RSCULLI VER: AG REV: 75 SIZE: F	SIGNIFICANT NUMBER GROUP 1 2 3 4 5 6 CHECKED DATE APPROVED DATE FILED	DRAWN DATE 2027 SH 1 BURNS & ROE COOPER NUCLEAR STATION FLOW DIAGRAM - LOOP "A" REACTOR RECIRCULATION & SUPPRESSION CHAMBER VENT SYSTEMS & CONNECTIONS
--	---	--

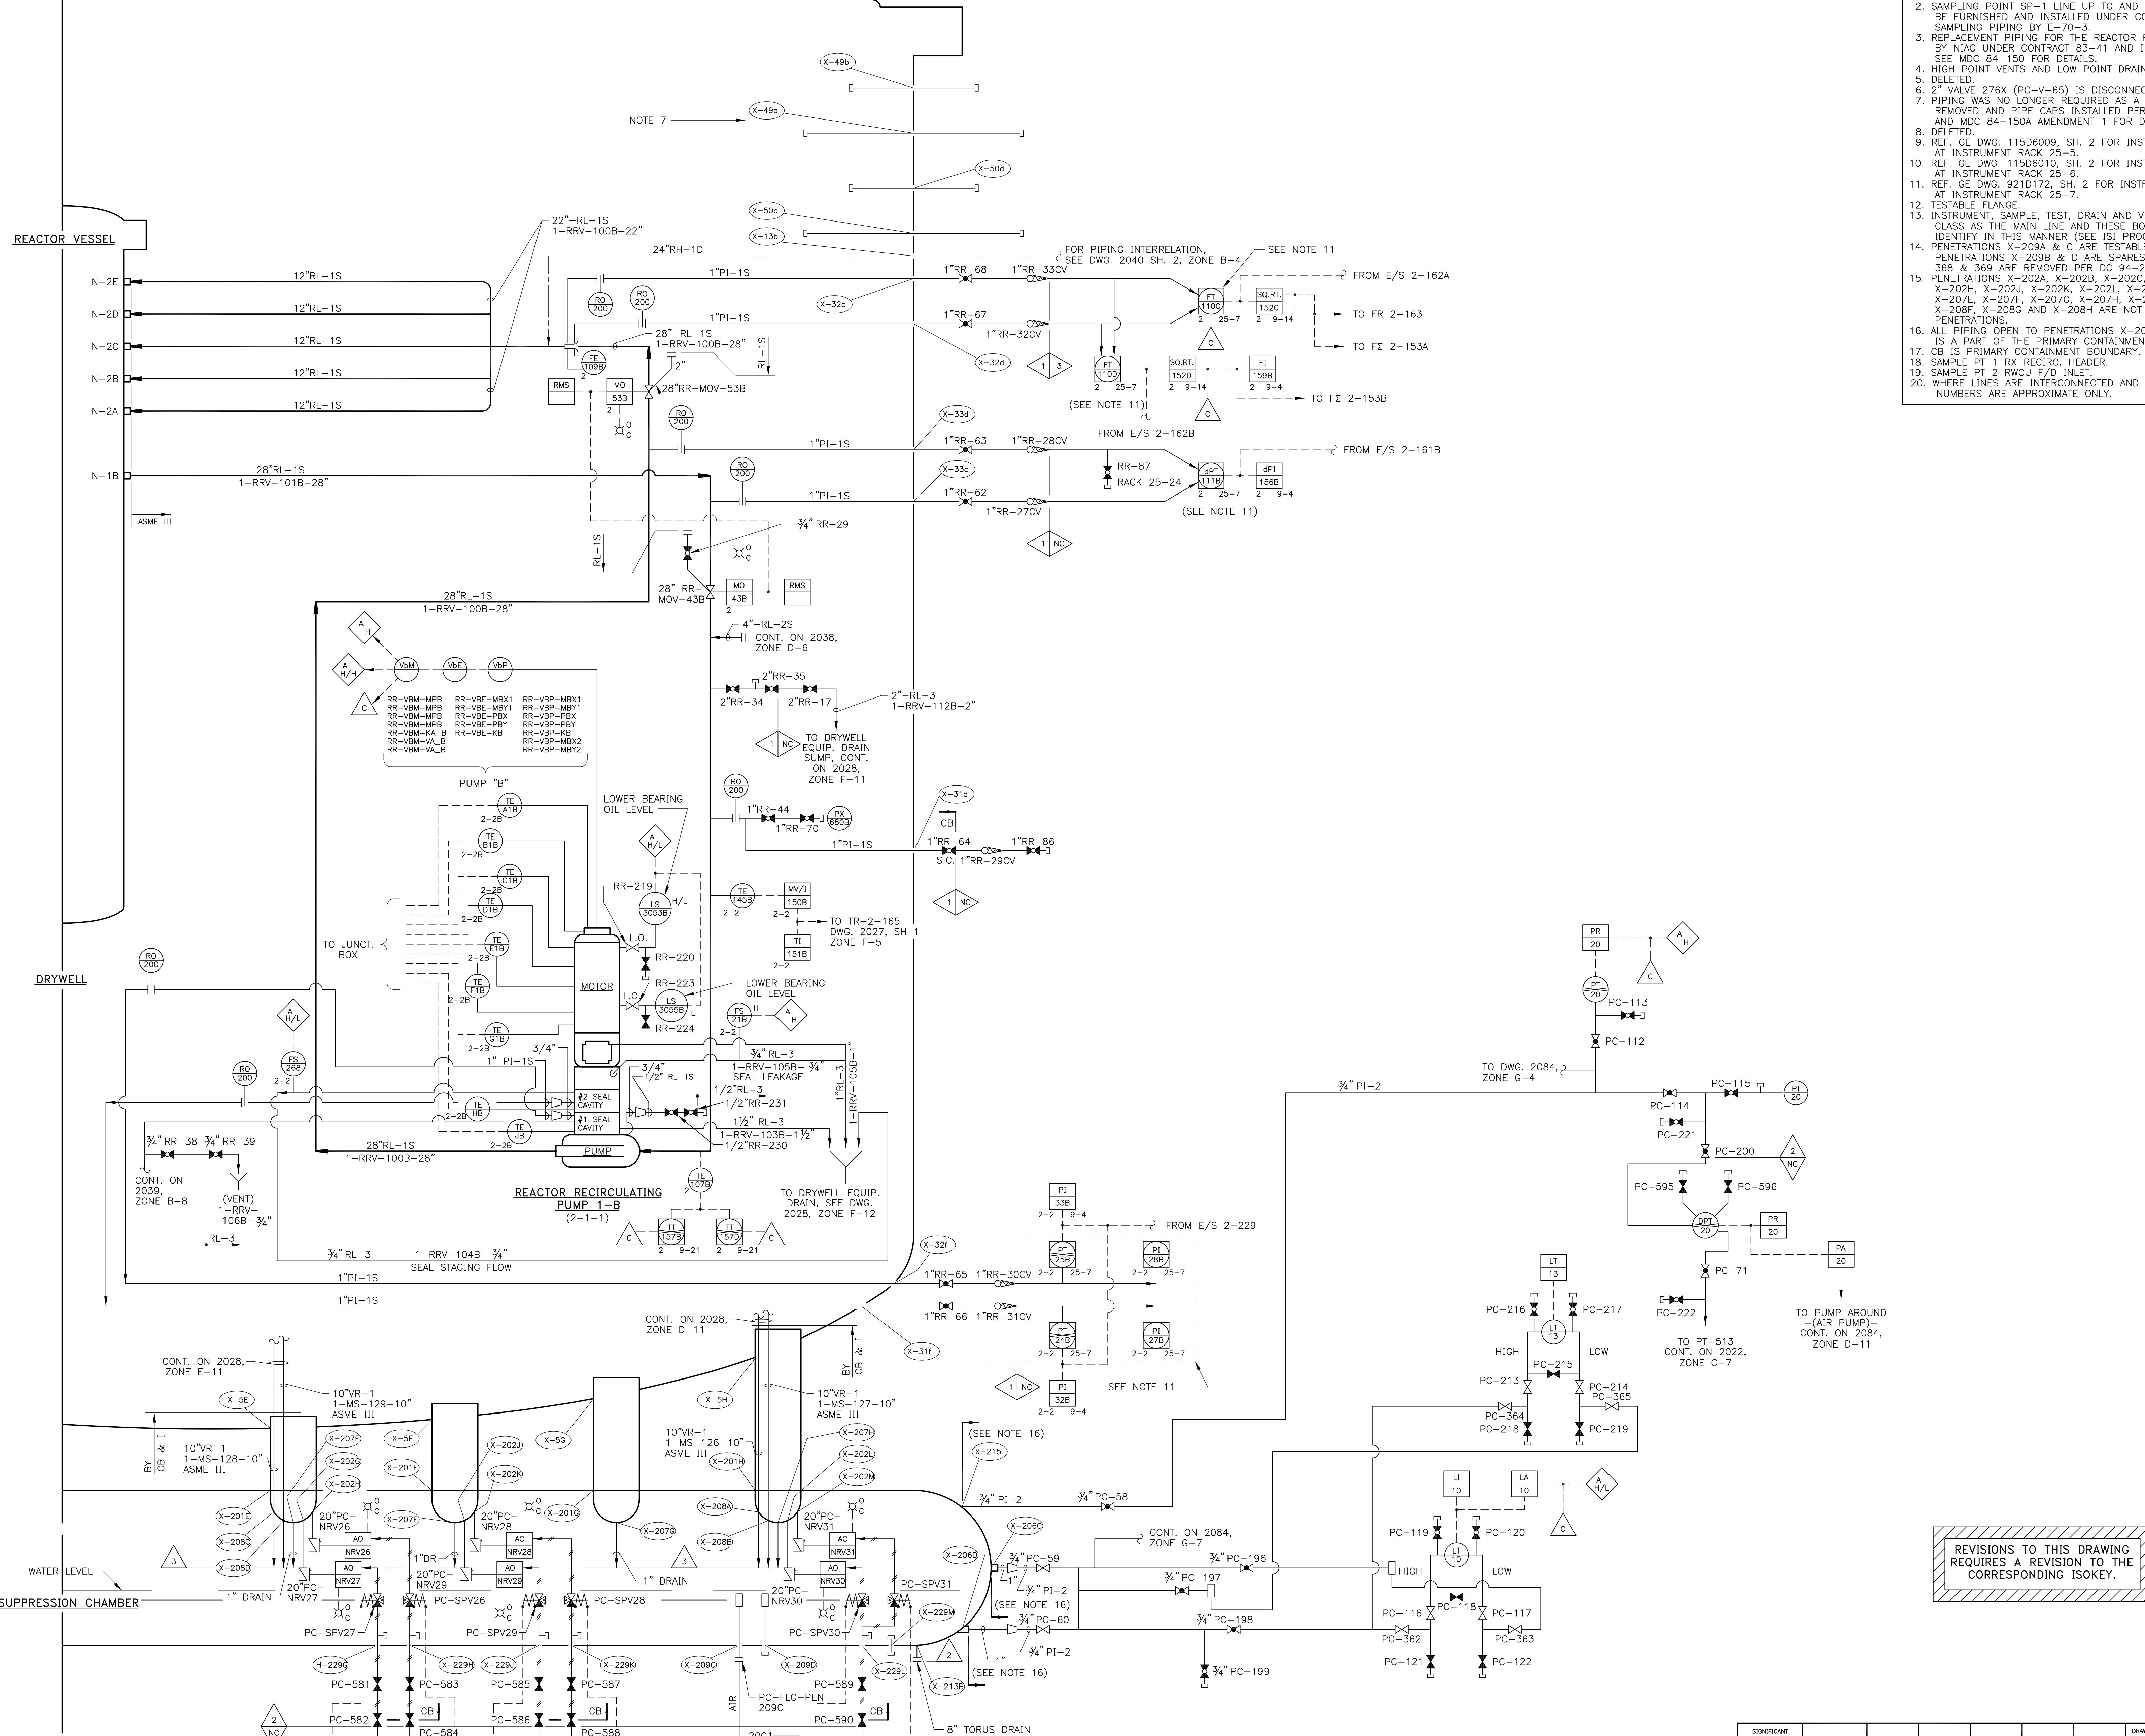

- NOTES:**
- FOR PRESSURE SENSING LINES, LINE UP TO AND INCLUDING ROOT VALVE SHALL BE FURNISHED & INSTALLED UNDER CONTRACT E-69-4.
  - SAMPLING POINT SP-1 LINE UP TO AND INCLUDING 3/4" 740AV976P SHALL BE FURNISHED AND INSTALLED UNDER CONTRACT E-69-4. CONTINUATION OF SAMPLING PIPING BY E-70-3.
  - REPLACEMENT PIPING FOR THE REACTOR RECIRCULATION LINES WAS FURNISHED BY NIAC UNDER CONTRACT 83-41 AND INSTALLED BY CBI UNDER CONTRACT 84-2. SEE MDC 84-150 FOR DETAILS.
  - HIGH POINT VENTS AND LOW POINT DRAINS NOT SHOWN.
  - DELETED.
  - 2" VALVE 276X (PC-V-65) IS DISCONNECTED FROM TORUS DRAIN PENT X-213B.
  - PIPING WAS NO LONGER REQUIRED AS A RESULT OF DC 76-2. PIPING WAS REMOVED AND PIPE CAPS INSTALLED PER CONTRACT 84-2. SEE MDC 84-150A AND MDC 84-150A-AMENDMENT 1 FOR DETAILS.
  - DELETED.
  - REF. GE DWG. 115D6009, SH. 2 FOR INSTRUMENT PIPING AND VALVE INSTALLATION AT INSTRUMENT RACK 25-5.
  - REF. GE DWG. 115D6010, SH. 2 FOR INSTRUMENT PIPING AND VALVE INSTALLATION AT INSTRUMENT RACK 25-6.
  - REF. GE DWG. 921D172, SH. 2 FOR INSTRUMENT PIPING AND VALVE INSTALLATION AT INSTRUMENT RACK 25-7.
  - DELETED.
  - INSTRUMENT, SAMPLE, TEST, DRAIN AND VENT LINES ARE NOT ALWAYS THE SAME CLASS AS THE MAIN LINE AND THESE BOUNDARIES ARE TOO NUMEROUS TO IDENTIFY IN THIS MANNER (SEE ISI PROGRAM BOUNDARY DESCRIPTIONS FOR DETAILS).
  - PENETRATIONS X-209B & C ARE TESTABLE ELEC/MECH FLANGE ASSEMBLIES. PENETRATIONS X-209A, X-202B, X-202C, X-202D, X-202E, X-202F, X-202G, X-202H, X-202J, X-202K, X-202L, X-202M, X-202N, X-202O, X-202P, X-202Q, X-202R, X-202S, X-202T, X-202U, X-202V, X-202W, X-202X, X-202Y, X-202Z, X-207H, X-207I, X-207J, X-207K, X-207L, X-207M, X-207N, X-207O, X-207P, X-207Q, X-207R, X-207S, X-207T, X-207U, X-207V, X-207W, X-207X, X-207Y, X-207Z, X-208A, X-208B, X-208C, X-208D, X-208E, X-208F, X-208G, X-208H, X-208I, X-208J, X-208K, X-208L, X-208M, X-208N, X-208O, X-208P, X-208Q, X-208R, X-208S, X-208T, X-208U, X-208V, X-208W, X-208X, X-208Y, X-208Z ARE NOT CONSIDERED PRIMARY CONTAINMENT PENETRATIONS.
  - ALL PIPING OPEN TO PENETRATIONS X-206C, X-206D AND X-215 ON THIS DRAWING IS A PART OF THE PRIMARY CONTAINMENT BOUNDARY.
  - CB IS PRIMARY CONTAINMENT BOUNDARY.
  - SAMPLE PT 1 RX RECIRC. HEADER.
  - SAMPLE PT 2 RWCU F/O INLET.
  - WHERE LINES ARE INTERCONNECTED AND CONTINUED ON OTHER DRAWINGS, ZONE NUMBERS ARE APPROXIMATE ONLY.

REVISIONS TO THIS DRAWING  
REQUIRES A REVISION TO THE  
CORRESPONDING ISOKEY.

**AS BUILT**  
**454242941**  
STATUS: Release  
STATUS DATE: 10/15/2014  
DS APPROVED: NEWERNE  
VER: AC REV: 15 SIZE: F


NO.	REVISIONS

FOR PREVIOUS REVISIONS, SEE SUPERSEDED CARDS.

NO.	DESCRIPTION	DFT	DATE	ENG
AC/15	DR-2013-0588 (FROM VERSION AB)	DJB	05/14/2013	KUKUR

SIGNIFICANT NUMBER	GROUP	1	2	3	4	5	6	DATE
FLOW DIAGRAM - LOOP "B"								
REACTOR RECIRCULATION & SUPPRESSION CHAMBER VENT SYSTEMS & CONNECTIONS								
COOPER NUCLEAR STATION								

DRAWN	DATE	7-12-95	BURNS & ROE
CHECKED	DATE	9-14-95	
APPROVED	DATE	9-14-95	2027 SH 2
FILED	DATE	9-14-95	

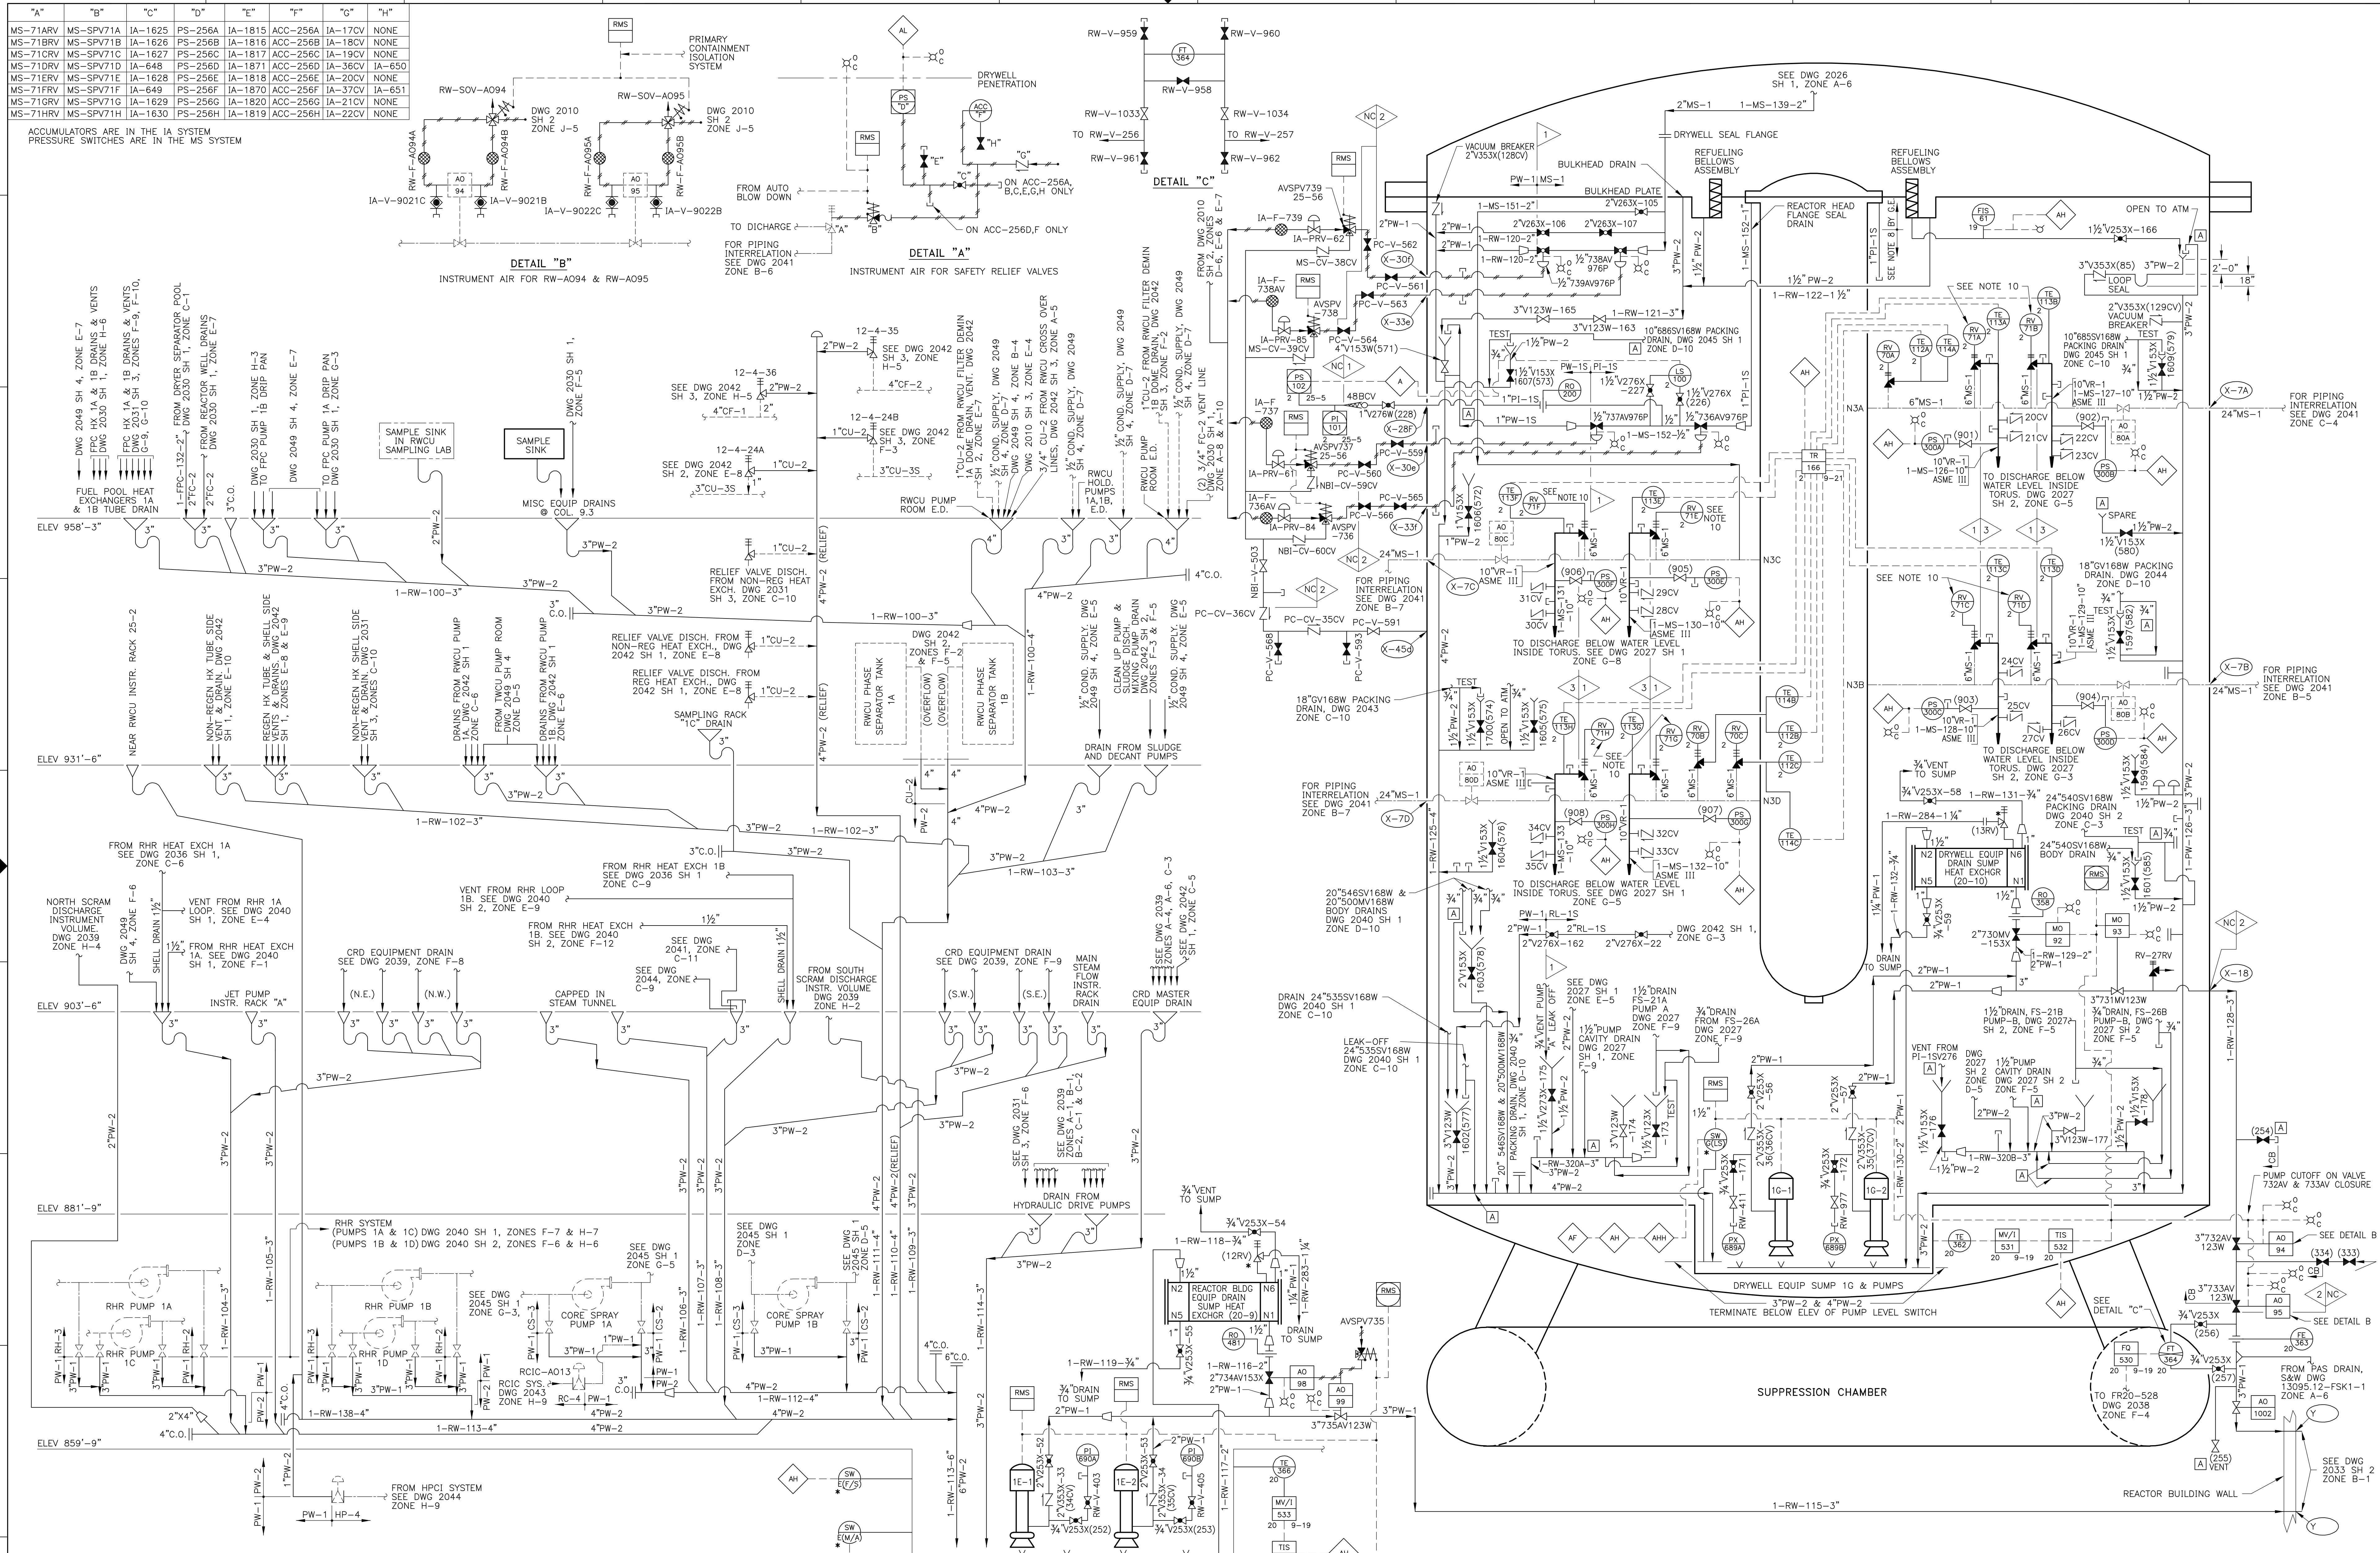

	"A"	"B"	"C"	"D"	"E"	"F"	"G"	"H"
MS-71ARV	MS-SPV71A	IA-1625	PS-256A	IA-1815	ACC-256A	IA-17CV	NONE	
MS-71BRV	MS-SPV71B	IA-1626	PS-256B	IA-1816	ACC-256B	IA-18CV	NONE	
MS-71CRV	MS-SPV71C	IA-1627	PS-256C	IA-1817	ACC-256C	IA-19CV	NONE	
MS-71DRV	MS-SPV71D	IA-1628	PS-256D	IA-1818	ACC-256D	IA-36CV	IA-650	
MS-71ERV	MS-SPV71E	IA-1629	PS-256E	IA-1819	ACC-256E	IA-20CV	NONE	
MS-71FRV	MS-SPV71F	IA-1630	PS-256F	IA-1820	ACC-256F	IA-37CV	IA-651	
MS-71GRV	MS-SPV71G	IA-1631	PS-256G	IA-1821	ACC-256G	IA-21CV	NONE	
MS-71HRV	MS-SPV71H	IA-1632	PS-256H	IA-1822	ACC-256H	IA-22CV	NONE	

ACCUMULATORS ARE IN THE IA SYSTEM  
PRESSURE SWITCHES ARE IN THE MS SYSTEM

DETAIL "B"  
INSTRUMENT AIR FOR RW-A094 & RW-A095

DETAIL "A"  
INSTRUMENT AIR FOR SAFETY RELIEF VALVES

FOR PIPING INTERRELATION SEE DWG 2041 ZONE B-6

FOR PIPING INTERRELATION SEE DWG 2041 ZONE C-4

FOR PIPING INTERRELATION SEE DWG 2041 ZONE B-5

FOR PIPING INTERRELATION SEE DWG 2041 ZONE C-4

FOR PIPING INTERRELATION SEE DWG 2041 ZONE B-5

FOR PIPING INTERRELATION SEE DWG 2041 ZONE C-4

454003618  
STATUS: Release  
STATUS DATE: 02/07/2017  
DS APPROVED: NEWNERE  
VER: AB REV: 53 DATE: F

AS BUILT

COOPER NUCLEAR STATION  
FLOW DIAGRAM  
REACTOR BUILDING & DRYWELL  
EQUIPMENT DRAIN SYSTEM

BURNS & ROE  
2028

- NOTE: ALL ITEMS MARKED THUS [A] ARE "AS BUILT" ITEMS AND ARE NOT SHOWN ON PIPING DRAWINGS.
- NOTES:
- INSTRUMENT SENSING LINES UP TO AND INCLUDING THE ROOT VALVES SHALL BE FURNISHED AND INSTALLED UNDER CONTRACT E69-4.
  - FLOOR AND EQUIPMENT DRAIN FITTINGS AND PORTIONS OF EMBEDDED PIPING FURNISHED AND INSTALLED BY OTHERS AS SHOWN ON DRAWINGS 2183, 2184, 2185, 2186 AND 2187.
  - DIFFUSER PIPE IN SUMPS TO BE 2" DIA. ENCIRCLING SUMP. DIFFUSER HOLES TO BE 3/4" DIA. APPROXIMATELY 1" O.C.
  - ALL "MS-1" PIPING SYSTEMS SHOWN HEREON SHALL BE CLASS "IN" NUCLEAR CLASSIFICATION.
  - ALL EQUIPMENT DRAINS EXTERIOR TO DRYWELL TO BE FURNISHED WITH LOOP SEALS.
  - ALL VR-1 SYSTEM PIPING INSIDE OF THE DRYWELL IS SUPPORTED TO CLIPPING IS RESTRAINED CRITERIA.
  - ALL VALVE NUMBERS IN PARENTHESIS ( ) ARE NUMBERS USED IN OPERATING PROCEDURES. THESE NUMBERS ARE ASSIGNED BY NPPD AND WILL NOT BE SHOWN ON PIPING DRAWINGS.
  - 1" PI-15 REACTOR VESSEL FLANGE LOW PRESSURE LEAK-OFF PIPING CONFORMS TO CLASS "IN" REQUIREMENTS FOR MATERIALS, EXPLANATION AND FABRICATION (EXCEPT THAT THREADED JOINTS ARE PERMISSIBLE WITHOUT SEAL WELDING). THIS LINE IS ATMOSPHERIC DRAIN LINE, AND NO HYDROSTATIC TESTING IS REQUIRED.
  - TYPICAL VALVE NUMBERING CODE FOR 10" VACUUM BREAKERS (LOCATED DOWNSTREAM FROM RV 71A THROUGH H) IS 10V359F.
  - FOR 1A CONNECTION, SEE DETAIL A. TYPICAL FOR MS-71, ARV, 71BRV, 71CRV, 71DRV, 71ERV, 71FRV, 71GRV, 71HRV.
  - INSTRUMENT, SAMPLE, TEST, DRAIN AND VENT LINES ARE NOT ALWAYS THE SAME CLASS AS THE MAIN LINE AND THESE BOUNDARIES ARE TOO NUMEROUS TO IDENTIFY IN THIS MANNER (SEE ISI PROGRAM BOUNDARY DESCRIPTIONS FOR DETAILS).
  - CB IS PRIMARY CONTAINMENT BOUNDARY.
  - WHERE LINES INTERCONNECT AND ARE CONTINUED ON OTHER DRAWINGS, ZONE NUMBERS ARE APPROXIMATE ONLY.


REVISIONS TO THIS DRAWING  
REQUIRES A REVISION TO THE  
CORRESPONDING ISOKEY.

NO.	DESCRIPTION	DATE	ENG
AB/23	01-2017-0001	DJR	2/7/17
		NEWNERE	

SIGNIFICANT NUMBER	GROUP	DATE	DATE	DATE
		1	2	3
		4	5	6
		7	8	9
		10	11	12

FOR PREVIOUS REVISIONS, SEE SUPERSEDED CARDS.



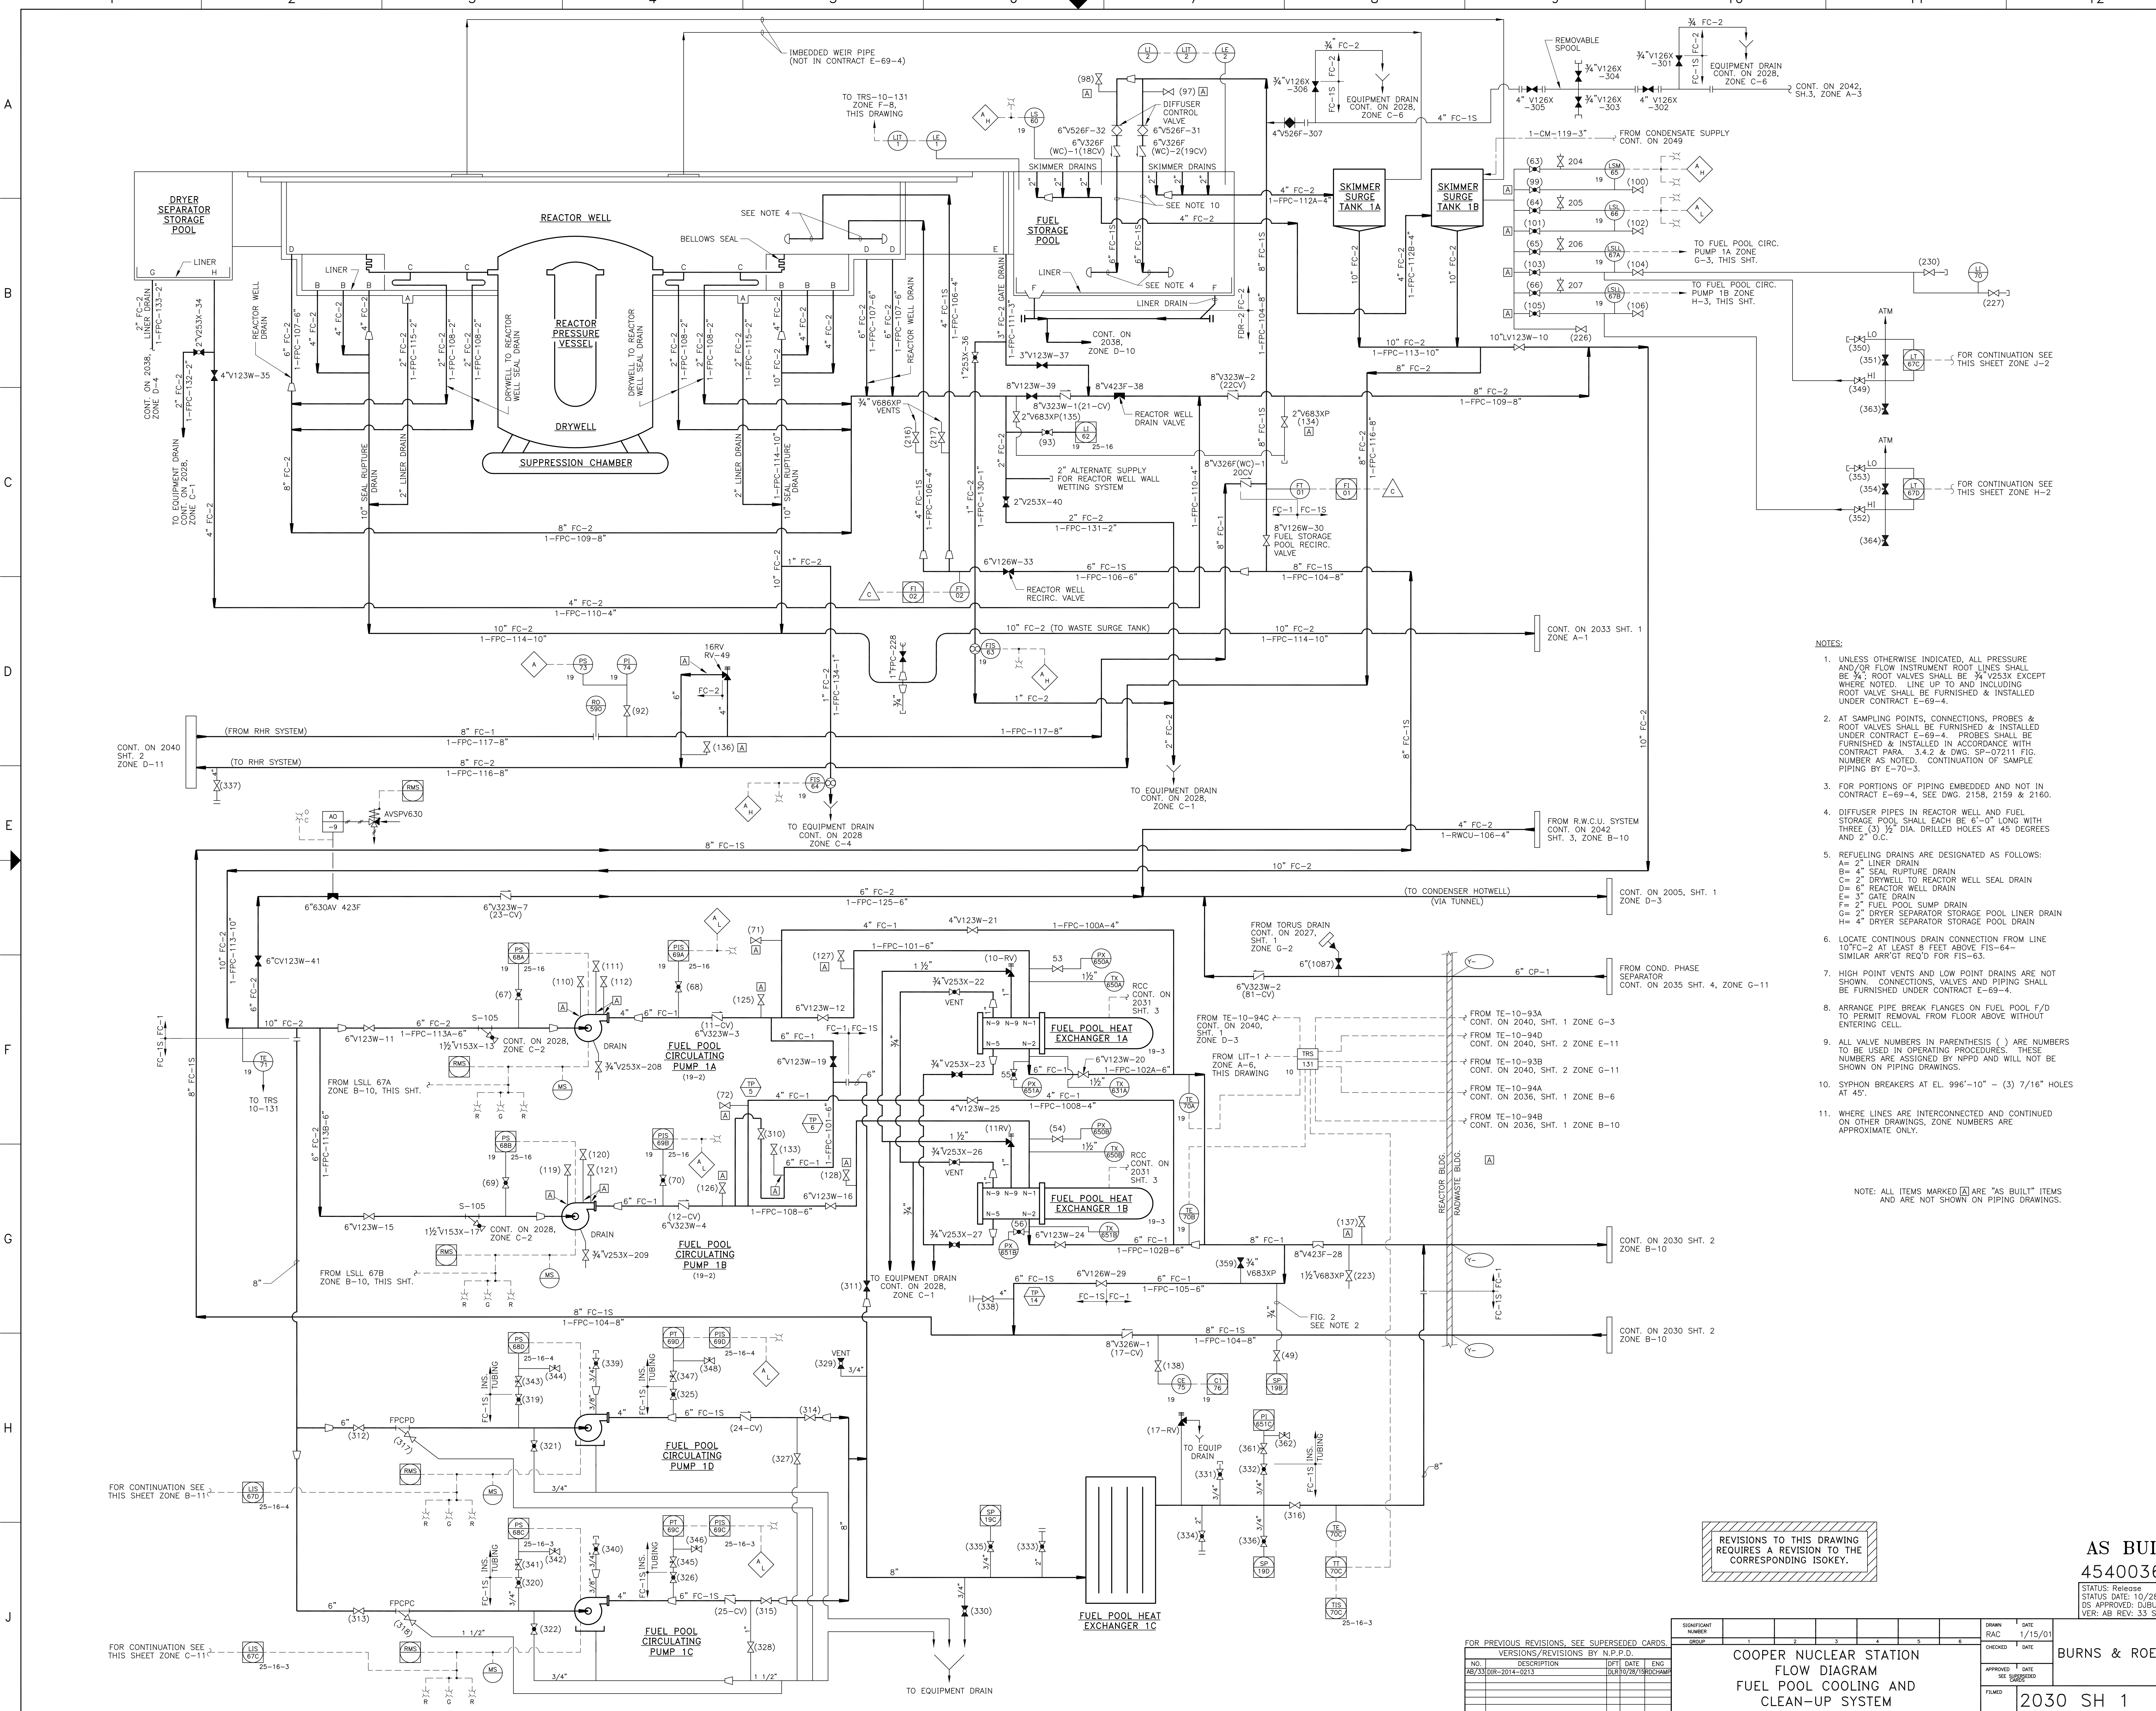

- NOTES:**
- UNLESS OTHERWISE INDICATED, ALL PRESSURE AND/OR FLOW INSTRUMENT ROOT LINES SHALL BE 3/4\"/>
  - AT SAMPLING POINTS, CONNECTIONS, PROBES & ROOT VALVES SHALL BE FURNISHED & INSTALLED UNDER CONTRACT E-69-4. PROBES SHALL BE FURNISHED & INSTALLED IN ACCORDANCE WITH CONTRACT PARA. 3.4.2 & DWG. SP-07211 FIG. NUMBER AS NOTED. CONTINUATION OF SAMPLE PIPING BY E-70-3.
  - FOR PORTIONS OF PIPING EMBEDDED AND NOT IN CONTRACT E-69-4, SEE DWGS. 2158, 2159 & 2160.
  - DIFFUSER PIPES IN REACTOR WELL AND FUEL STORAGE POOL SHALL EACH BE 6\"/>
  - REFUELING DRAINS ARE DESIGNATED AS FOLLOWS:  
 A= 2\"/>
  - LOCATE CONTINUOUS DRAIN CONNECTION FROM LINE 10\"/>
  - HIGH POINT VENTS AND LOW POINT DRAINS ARE NOT SHOWN. CONNECTIONS, VALVES AND PIPING SHALL BE FURNISHED UNDER CONTRACT E-69-4.
  - ARRANGE PIPE BREAK FLANGES ON FUEL POOL F/D TO PERMIT REMOVAL FROM FLOOR ABOVE WITHOUT ENTERING CELL.
  - ALL VALVE NUMBERS IN PARENTHESIS ( ) ARE NUMBERS TO BE USED IN OPERATING PROCEDURES. THESE NUMBERS ARE ASSIGNED BY NPPD AND WILL NOT BE SHOWN ON PIPING DRAWINGS.
  - SYPHON BREAKERS AT EL. 996'-10\"/>
  - WHERE LINES ARE INTERCONNECTED AND CONTINUED ON OTHER DRAWINGS, ZONE NUMBERS ARE APPROXIMATE ONLY.

NOTE: ALL ITEMS MARKED [A] ARE "AS BUILT" ITEMS AND ARE NOT SHOWN ON PIPING DRAWINGS.

REVISIONS TO THIS DRAWING REQUIRES A REVISION TO THE CORRESPONDING ISOKEY.

**AS BUILT**  
 454003620  
 STATUS: Release  
 STATUS DATE: 10/28/2015  
 IS APPROVED: DUBUTLE  
 VER: AB REV: 33 SIZE: E

FOR PREVIOUS REVISIONS, SEE SUPERSEDED CARDS.		NO.	DESCRIPTION	DATE	ENG.
1	AS BUILT	1	AS BUILT	10/28/2015	DUBUTLE

NO.	DESCRIPTION	DATE	ENG.
1	AS BUILT	10/28/2015	DUBUTLE

NO.	DATE	BY	CHKD.
1	10/28/2015	DUBUTLE	DUBUTLE


NO.	DATE	BY	CHKD.
1	10/28/2015	DUBUTLE	DUBUTLE

NO.	DATE	BY	CHKD.
1	10/28/2015	DUBUTLE	DUBUTLE

**COOPER NUCLEAR STATION**  
**FLOW DIAGRAM**  
**FUEL POOL COOLING AND**  
**CLEAN-UP SYSTEM**

2030 SH 1

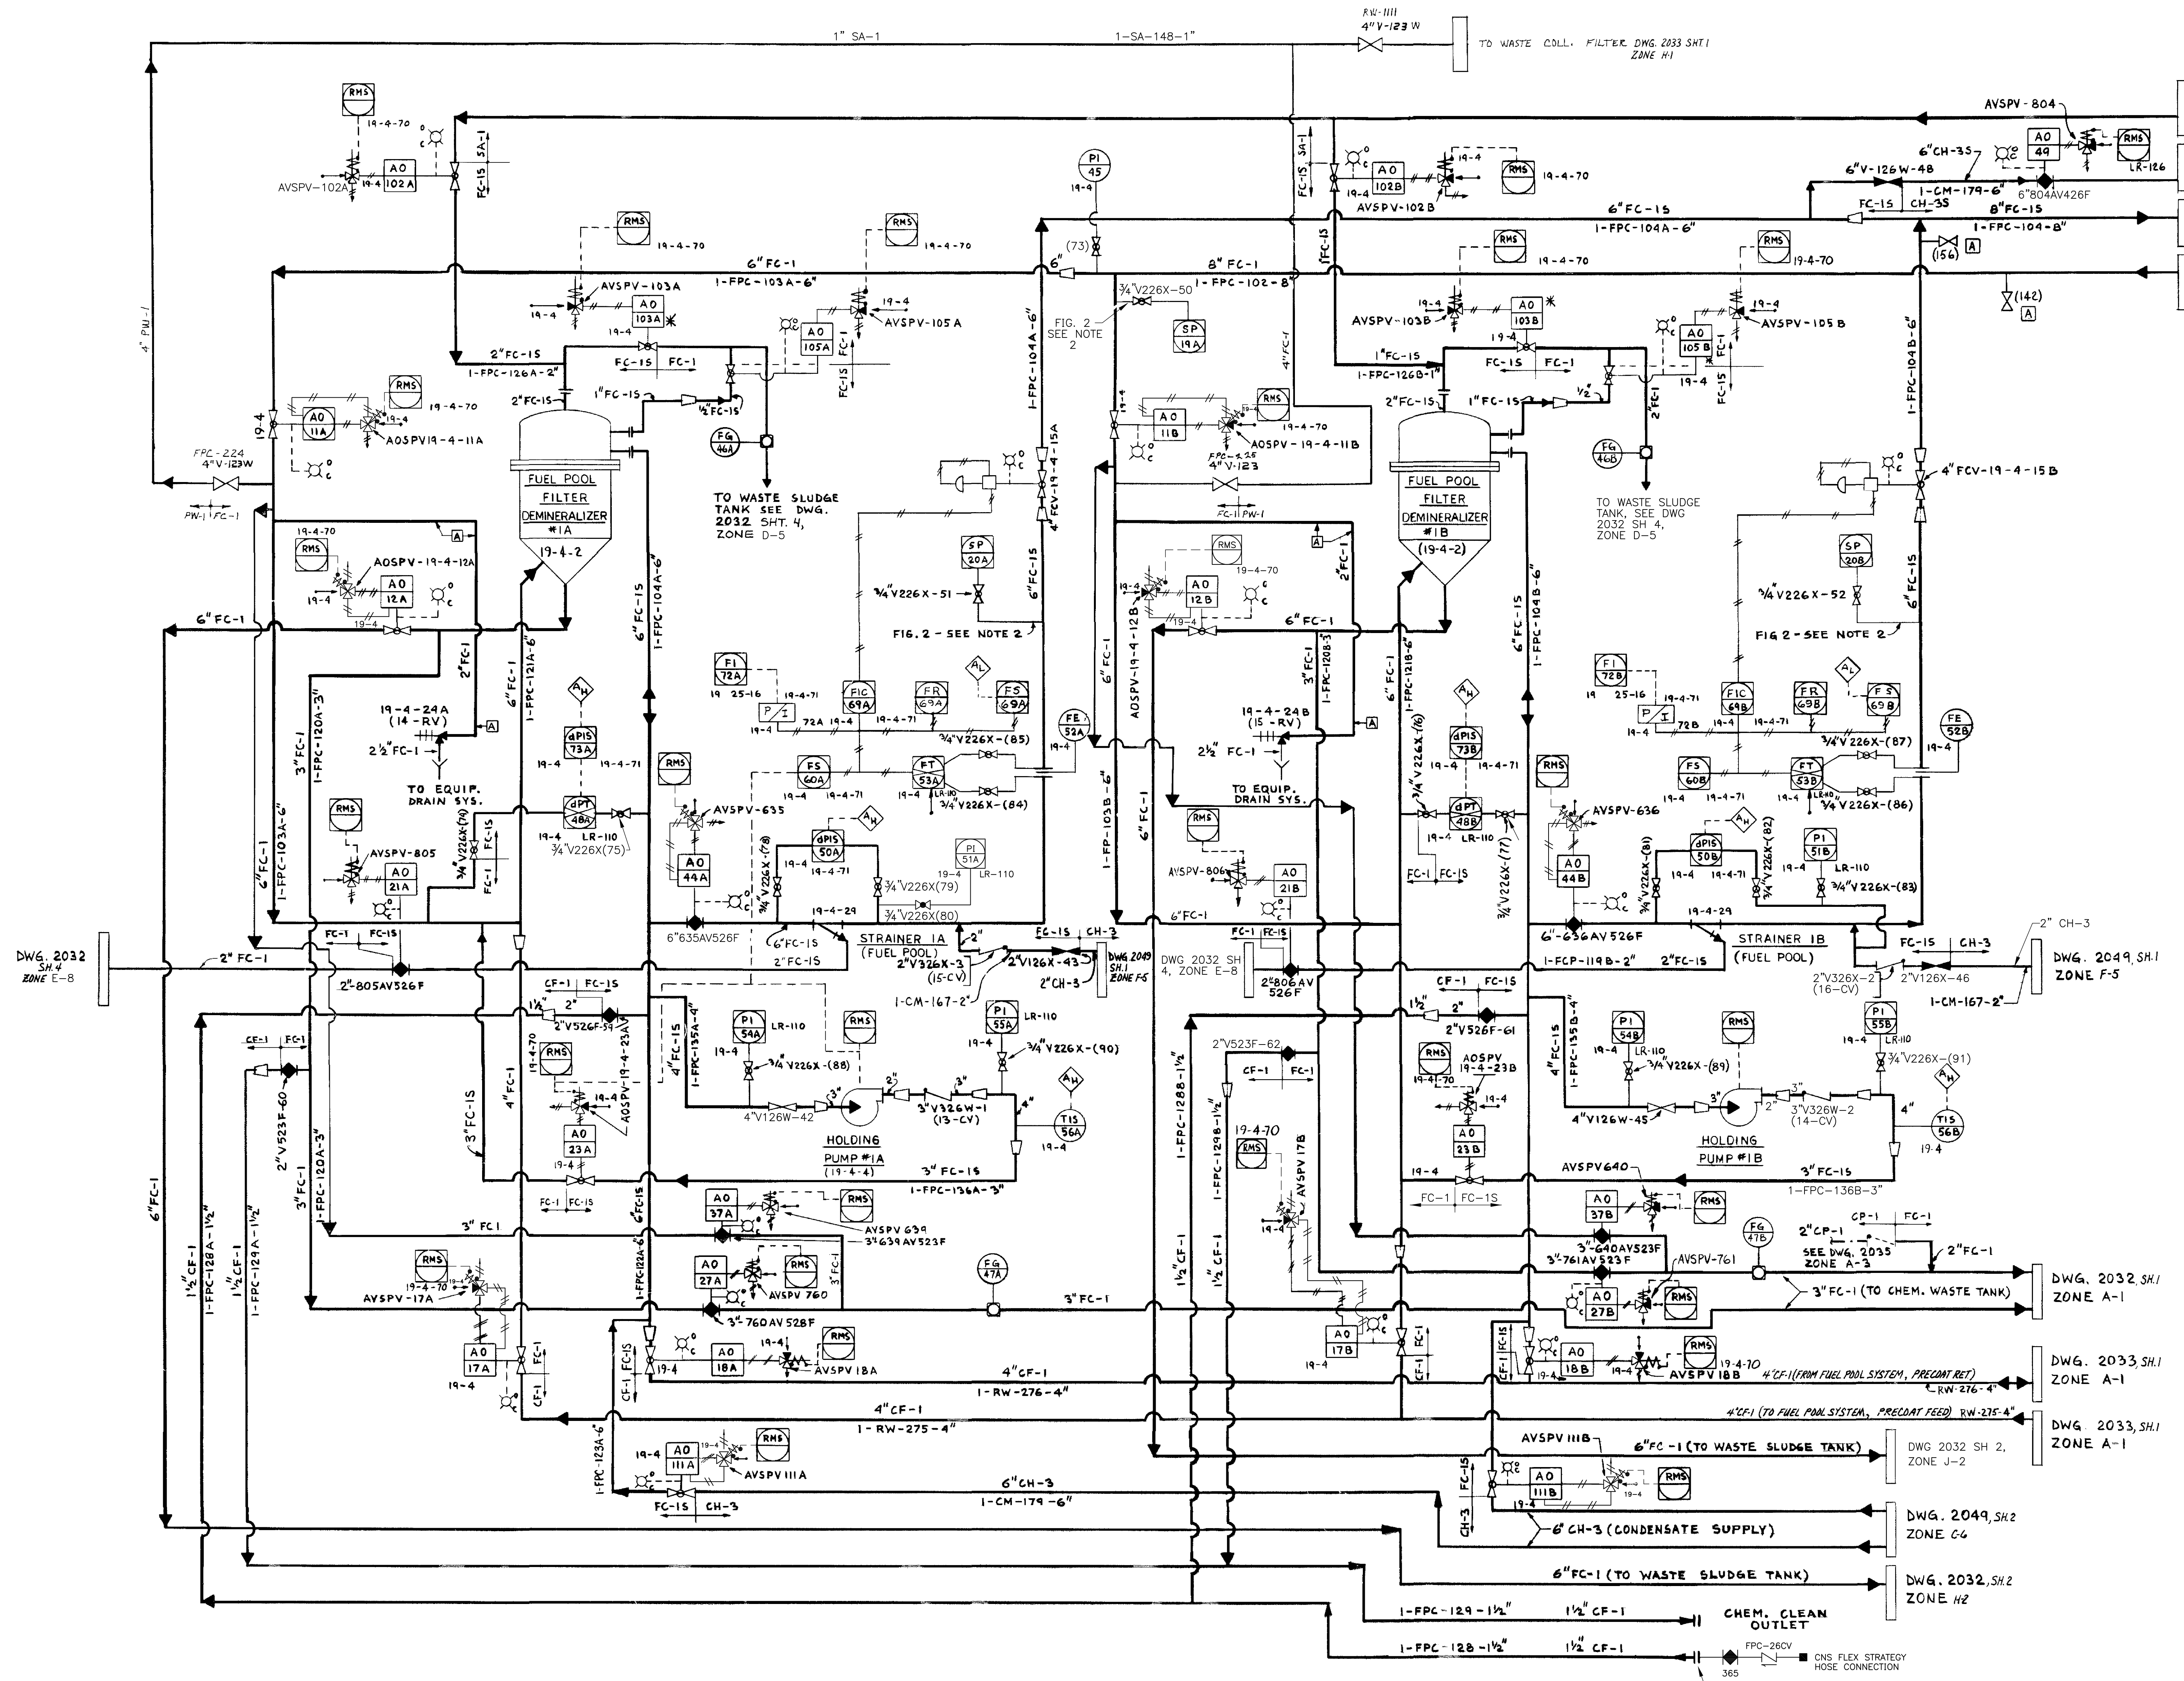

70-100 AIR SUPPLY  
DWG. 2010 SH 3 ZONE B-2

TO COND. STOR& TK.  
DWG. 2049 SH-2 ZONE F-1

THIS DWG SHT 1  
ZONE J-10

THIS DWG SHT 1  
ZONE H-10

DWG. 2032 SH 4  
ZONE E-8

DWG. 2049 SH 1  
ZONE F-5

DWG. 2032 SH 1  
ZONE A-1

DWG. 2033 SH 1  
ZONE A-1

DWG. 2033 SH 2  
ZONE A-1

DWG. 2049 SH 2  
ZONE G-4

DWG. 2032 SH 2  
ZONE H-2

NOTE:  
FOR NOTES SEE THIS DWG. SHT. 1.

REVISIONS TO THIS DRAWING  
REQUIRES A REVISION TO THE  
CORRESPONDING ISOKEY.

FOR PREVIOUS REVISIONS, SEE SUPERSEDED CARDS.

VERSIONS/REVISIONS BY N.P.P.D.			
NO.	DESCRIPTION	DFTI DATE	ENG
AB/78	DR-2015-0141	DJB/01/17/18	KKUKUR

SIGNIFICANT NUMBER	GROUP						DRAWN	DATE	CHECKED	DATE	APPROVED	DATE	FILMED
	1	2	3	4	5	6							
							DJF	5/30/02					


COOPER NUCLEAR STATION  
FUEL POOL COOLING AND  
CLEAN-UP SYSTEM

BURNS & ROE

2030 SH 2

STATUS: Release  
STATUS DATE: 01/11/2016  
DS APPROVED: KKKUKUR  
VER: AB REV: 16 SIZE: F

AS BUILT  
454003621

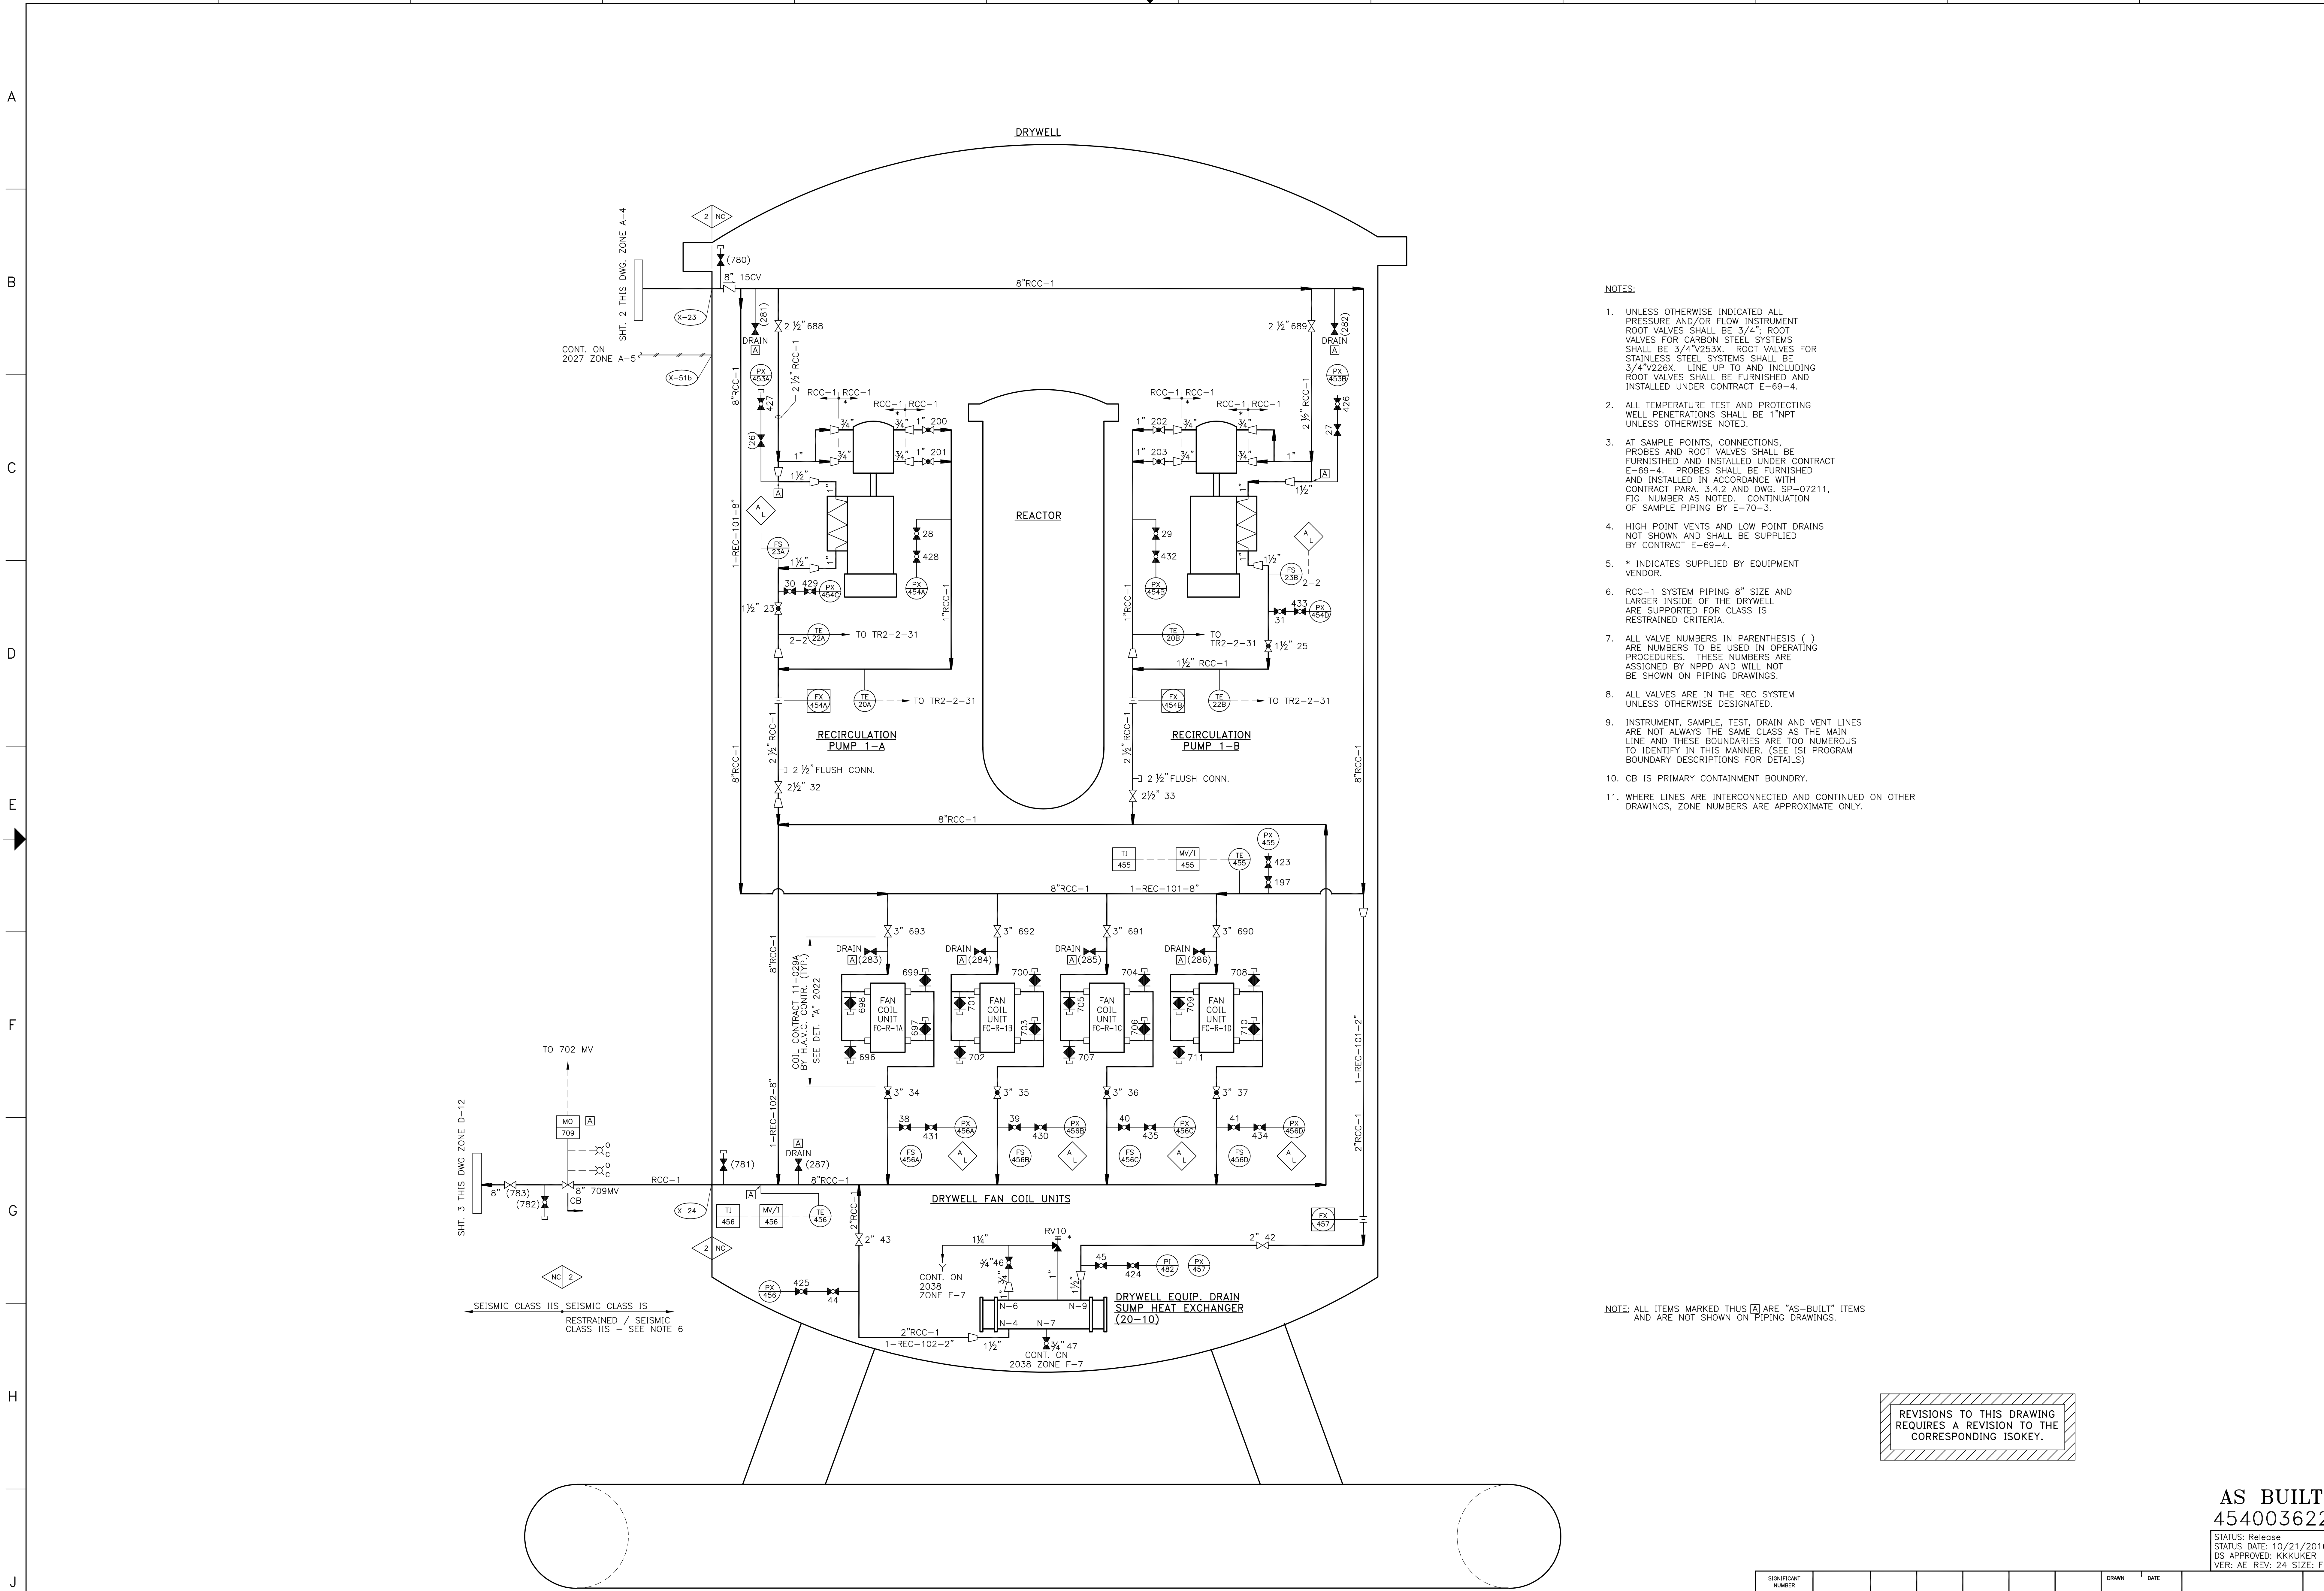

- NOTES:
- UNLESS OTHERWISE INDICATED ALL PRESSURE AND/OR FLOW INSTRUMENT ROOT VALVES SHALL BE 3/4"; ROOT VALVES FOR CARBON STEEL SYSTEMS SHALL BE 3/4"V253X. ROOT VALVES FOR STAINLESS STEEL SYSTEMS SHALL BE 3/4"V226X. LINE UP TO AND INCLUDING ROOT VALVES SHALL BE FURNISHED AND INSTALLED UNDER CONTRACT E-69-4.
  - ALL TEMPERATURE TEST AND PROTECTING WELL PENETRATIONS SHALL BE 1"NPT UNLESS OTHERWISE NOTED.
  - AT SAMPLE POINTS, CONNECTIONS, PROBES AND ROOT VALVES SHALL BE FURNISHED AND INSTALLED UNDER CONTRACT E-69-4. PROBES SHALL BE FURNISHED AND INSTALLED IN ACCORDANCE WITH CONTRACT PARA. 3.4.2 AND DWG. SP-07211, FIG. NUMBER AS NOTED. CONTINUATION OF SAMPLE PIPING BY E-70-3.
  - HIGH POINT VENTS AND LOW POINT DRAINS NOT SHOWN AND SHALL BE SUPPLIED BY CONTRACT E-69-4.
  - \* INDICATES SUPPLIED BY EQUIPMENT VENDOR.
  - RCC-1 SYSTEM PIPING 8" SIZE AND LARGER INSIDE OF THE DRYWELL ARE SUPPORTED FOR CLASS IS RESTRAINED CRITERIA.
  - ALL VALVE NUMBERS IN PARENTHESIS ( ) ARE NUMBERS TO BE USED IN OPERATING PROCEDURES. THESE NUMBERS ARE ASSIGNED BY NPPD AND WILL NOT BE SHOWN ON PIPING DRAWINGS.
  - ALL VALVES ARE IN THE REC SYSTEM UNLESS OTHERWISE DESIGNATED.
  - INSTRUMENT, SAMPLE, TEST, DRAIN AND VENT LINES ARE NOT ALWAYS THE SAME CLASS AS THE MAIN LINE AND THESE BOUNDARIES ARE TOO NUMEROUS TO IDENTIFY IN THIS MANNER. (SEE ISI PROGRAM BOUNDARY DESCRIPTIONS FOR DETAILS).
  - CB IS PRIMARY CONTAINMENT BOUNDARY.
  - WHERE LINES ARE INTERCONNECTED AND CONTINUED ON OTHER DRAWINGS, ZONE NUMBERS ARE APPROXIMATE ONLY.

NOTE: ALL ITEMS MARKED THIS [A] ARE "AS-BUILT" ITEMS AND ARE NOT SHOWN ON PIPING DRAWINGS.


REVISIONS TO THIS DRAWING REQUIRES A REVISION TO THE CORRESPONDING ISOKEY.

**AS BUILT**  
454003622  
STATUS: Release  
STATUS DATE: 10/21/2016  
DS APPROVED: KKKUKER  
VER: AE REV: 24 SIZE: F

FOR PREVIOUS REVISIONS, SEE SUPERSEDED CARDS.						SIGNIFICANT NUMBER		DRAWN		DATE	
VERSIONS/REVISIONS BY N.P.P.D.						GROUP		CHECKED		DATE	
NO.	DESCRIPTION	DFT	DATE	ENG							
AD/23	DR-2013-0588 (FROM VERSION AB)	DJB	10/18/14	KKUKER							
AE/24	DR-2013-0588 (FROM VERSION AC)	PAM	10/21/16	KKUKER							

COOPER NUCLEAR STATION						DRAWN		DATE		<b>BURNS &amp; ROE</b>	
FLOW DIAGRAM						CHECKED		DATE			
REACTOR BUILDING						APPROVED		DATE			
CLOSED COOLING WATER SYSTEM						FILMED		DATE		<b>2031 SH 1</b>	

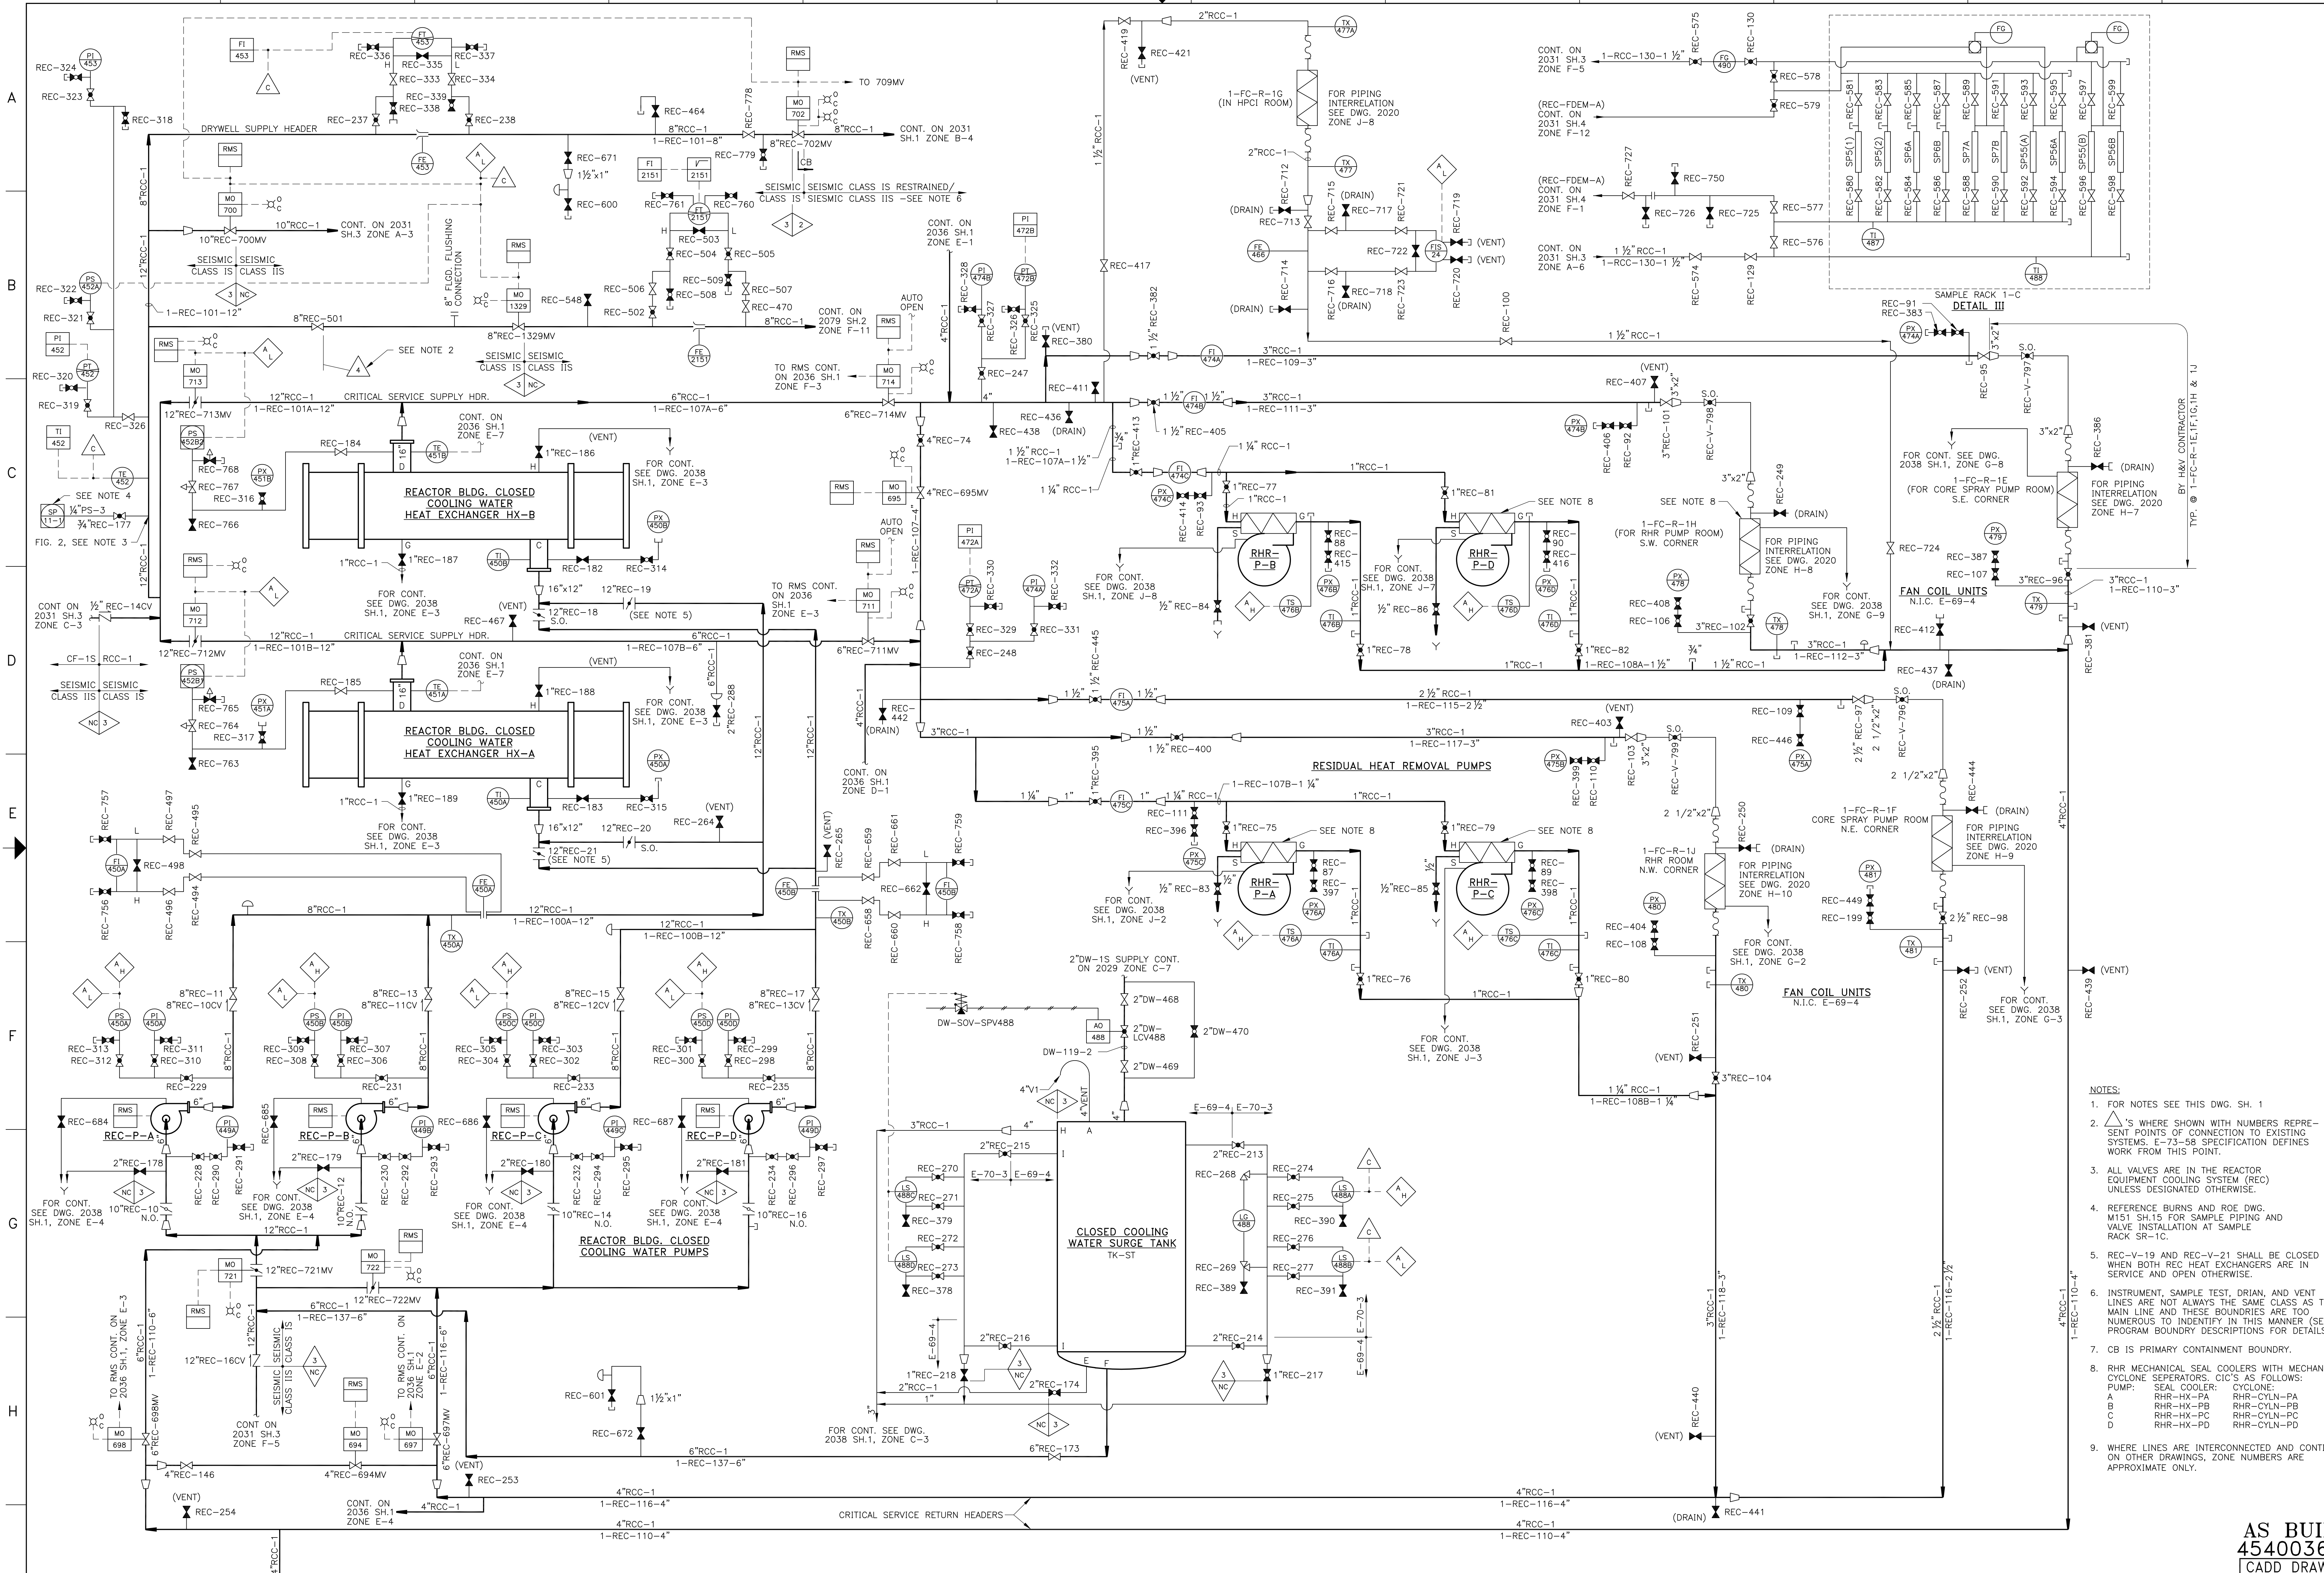

- NOTES:
- FOR NOTES SEE THIS DWG. SH. 1
  - △'S WHERE SHOWN WITH NUMBERS REPRESENT POINTS OF CONNECTION TO EXISTING SYSTEMS. E-73-58 SPECIFICATION DEFINES WORK FROM THIS POINT.
  - ALL VALVES ARE IN THE REACTOR EQUIPMENT COOLING SYSTEM (REC) UNLESS DESIGNATED OTHERWISE.
  - REFERENCE BURNS AND ROE DWG. N151 SH.15 FOR SAMPLE PIPING AND VALVE INSTALLATION AT SAMPLE RACK SR-1C.
  - REC-V-19 AND REC-V-21 SHALL BE CLOSED WHEN BOTH REC HEAT EXCHANGERS ARE IN SERVICE AND OPEN OTHERWISE.
  - INSTRUMENT, SAMPLE TEST, DRAIN, AND VENT LINES ARE NOT ALWAYS THE SAME CLASS AS THE MAIN LINE AND THESE BOUNDARIES ARE TOO NUMEROUS TO IDENTIFY IN THIS MANNER (SEE ISI PROGRAM BOUNDARY DESCRIPTIONS FOR DETAILS).
  - CB IS PRIMARY CONTAINMENT BOUNDARY.
  - RHR MECHANICAL SEAL COOLERS WITH MECHANICAL CYCLONE SEPARATORS, CICS AS FOLLOWS:  
 PUMP: SEAL COOLER: CYCLONE:  
 A RHR-HX-PA RHR-CYLN-PA  
 B RHR-HX-PB RHR-CYLN-PB  
 C RHR-HX-PC RHR-CYLN-PC  
 D RHR-HX-PD RHR-CYLN-PD
  - WHERE LINES ARE INTERCONNECTED AND CONTINUED ON OTHER DRAWINGS, ZONE NUMBERS ARE APPROXIMATE ONLY.

REVISIONS TO THIS DRAWING REQUIRES A REVISION TO THE CORRESPONDING ISOKEY.


FOR PREVIOUS REVISIONS, SEE SUPERSEDED CARDS.

REVISIONS BY N.P.D.			
NO.	REVISIONS	DFT	CHK
N63CED 6008243	(DCN 02-0298)	DLR	DLR
N64CED 6016821	(DCN 05-0666)	ROA	DLR
N65CED 6028200	(DCN 08-1437)	KG	DLR

SIGNIFICANT NUMBER	GROUP	1	2	3	4	5	6	DATE	DATE
<p>AS BUILT 454003623 CADD DRAWING</p>									
<p>DO NOT REVISE MANUALLY</p>									
<p>REACTOR BUILDING - CLOSED COOLING WATER SYSTEM COOPER NUCLEAR STATION</p>									
<p>2031 SH 2 N65</p>								<p>BURNS &amp; ROE</p>	

AS BUILT  
454003623  
CADD DRAWING

BURNS & ROE  
2031 SH 2 N65

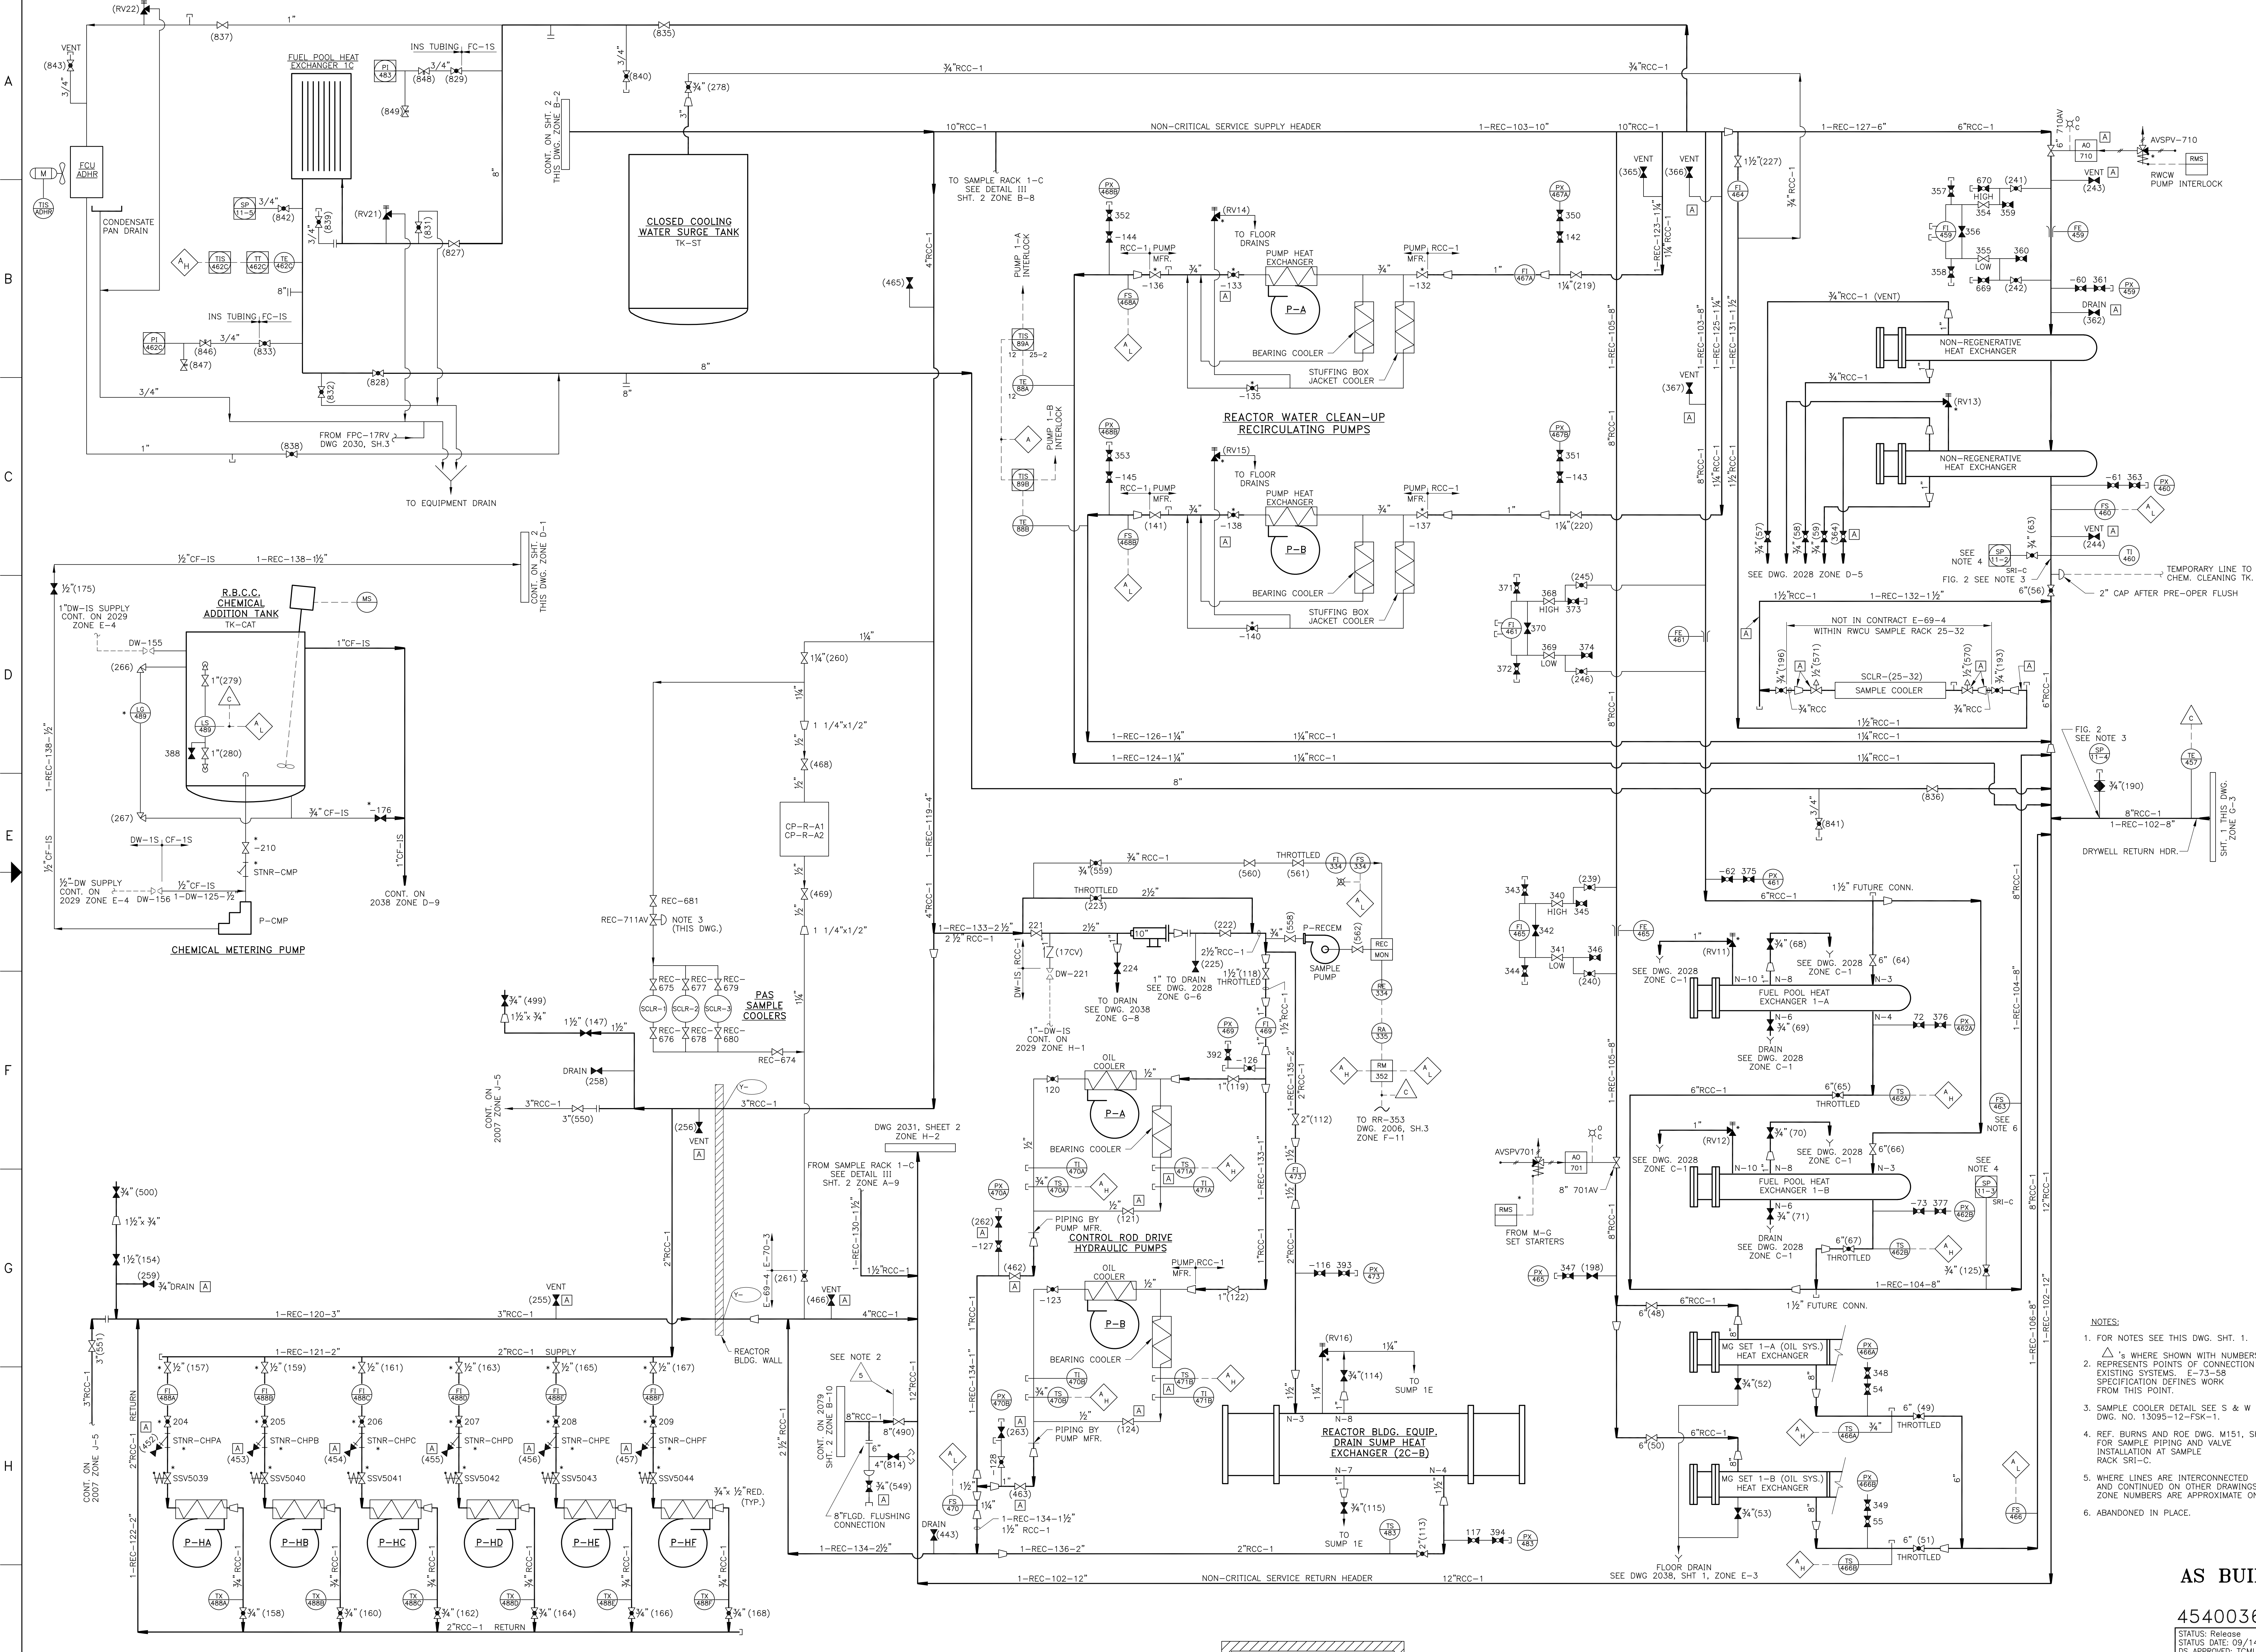

- NOTES:
- FOR NOTES SEE THIS DWG. SHT. 1.
  - △'S WHERE SHOWN WITH NUMBERS REPRESENTS POINTS OF CONNECTION TO EXISTING SYSTEMS. E-73-58 SPECIFICATION DEFINES WORK FROM THIS POINT.
  - SAMPLE COOLER DETAIL SEE S & W DWG. NO. 13095-12-FSK-1.
  - REF. BURNS AND ROE DWG. M151, SHT. 15 FOR SAMPLE PIPING AND VALVE INSTALLATION AT SAMPLE RACK SRI-C.
  - WHERE LINES ARE INTERCONNECTED AND CONTINUED ON OTHER DRAWINGS, ZONE NUMBERS ARE APPROXIMATE ONLY.
  - ABANDONED IN PLACE.

REVISIONS TO THIS DRAWING  
REQUIRES A REVISION TO THE  
CORRESPONDING ISOKEY.

FOR PREVIOUS REVISIONS, SEE SUPERSEDED CARDS

NO.	DESCRIPTION	DATE	ENG.
102/2108-2013-0813	DRYWELL RETURN HDR	08/13/13	MARKUS
102/2108-2013-0412	DRYWELL RETURN HDR	04/12/13	MARKUS
102/2108-2014-0602	DRYWELL RETURN HDR	06/02/14	MARKUS

SYMBOL	NUMBER	DATE	DATE
1	2	3	4
5	6	7	8
9	10	11	12


COOPER NUCLEAR STATION  
FLOW DIAGRAM  
REACTOR BUILDING - CLOSED  
COOLING WATER SYSTEM

2031 SH 3

BURNS & ROE

100% FILE: C001398

AS BUILT  
454003624

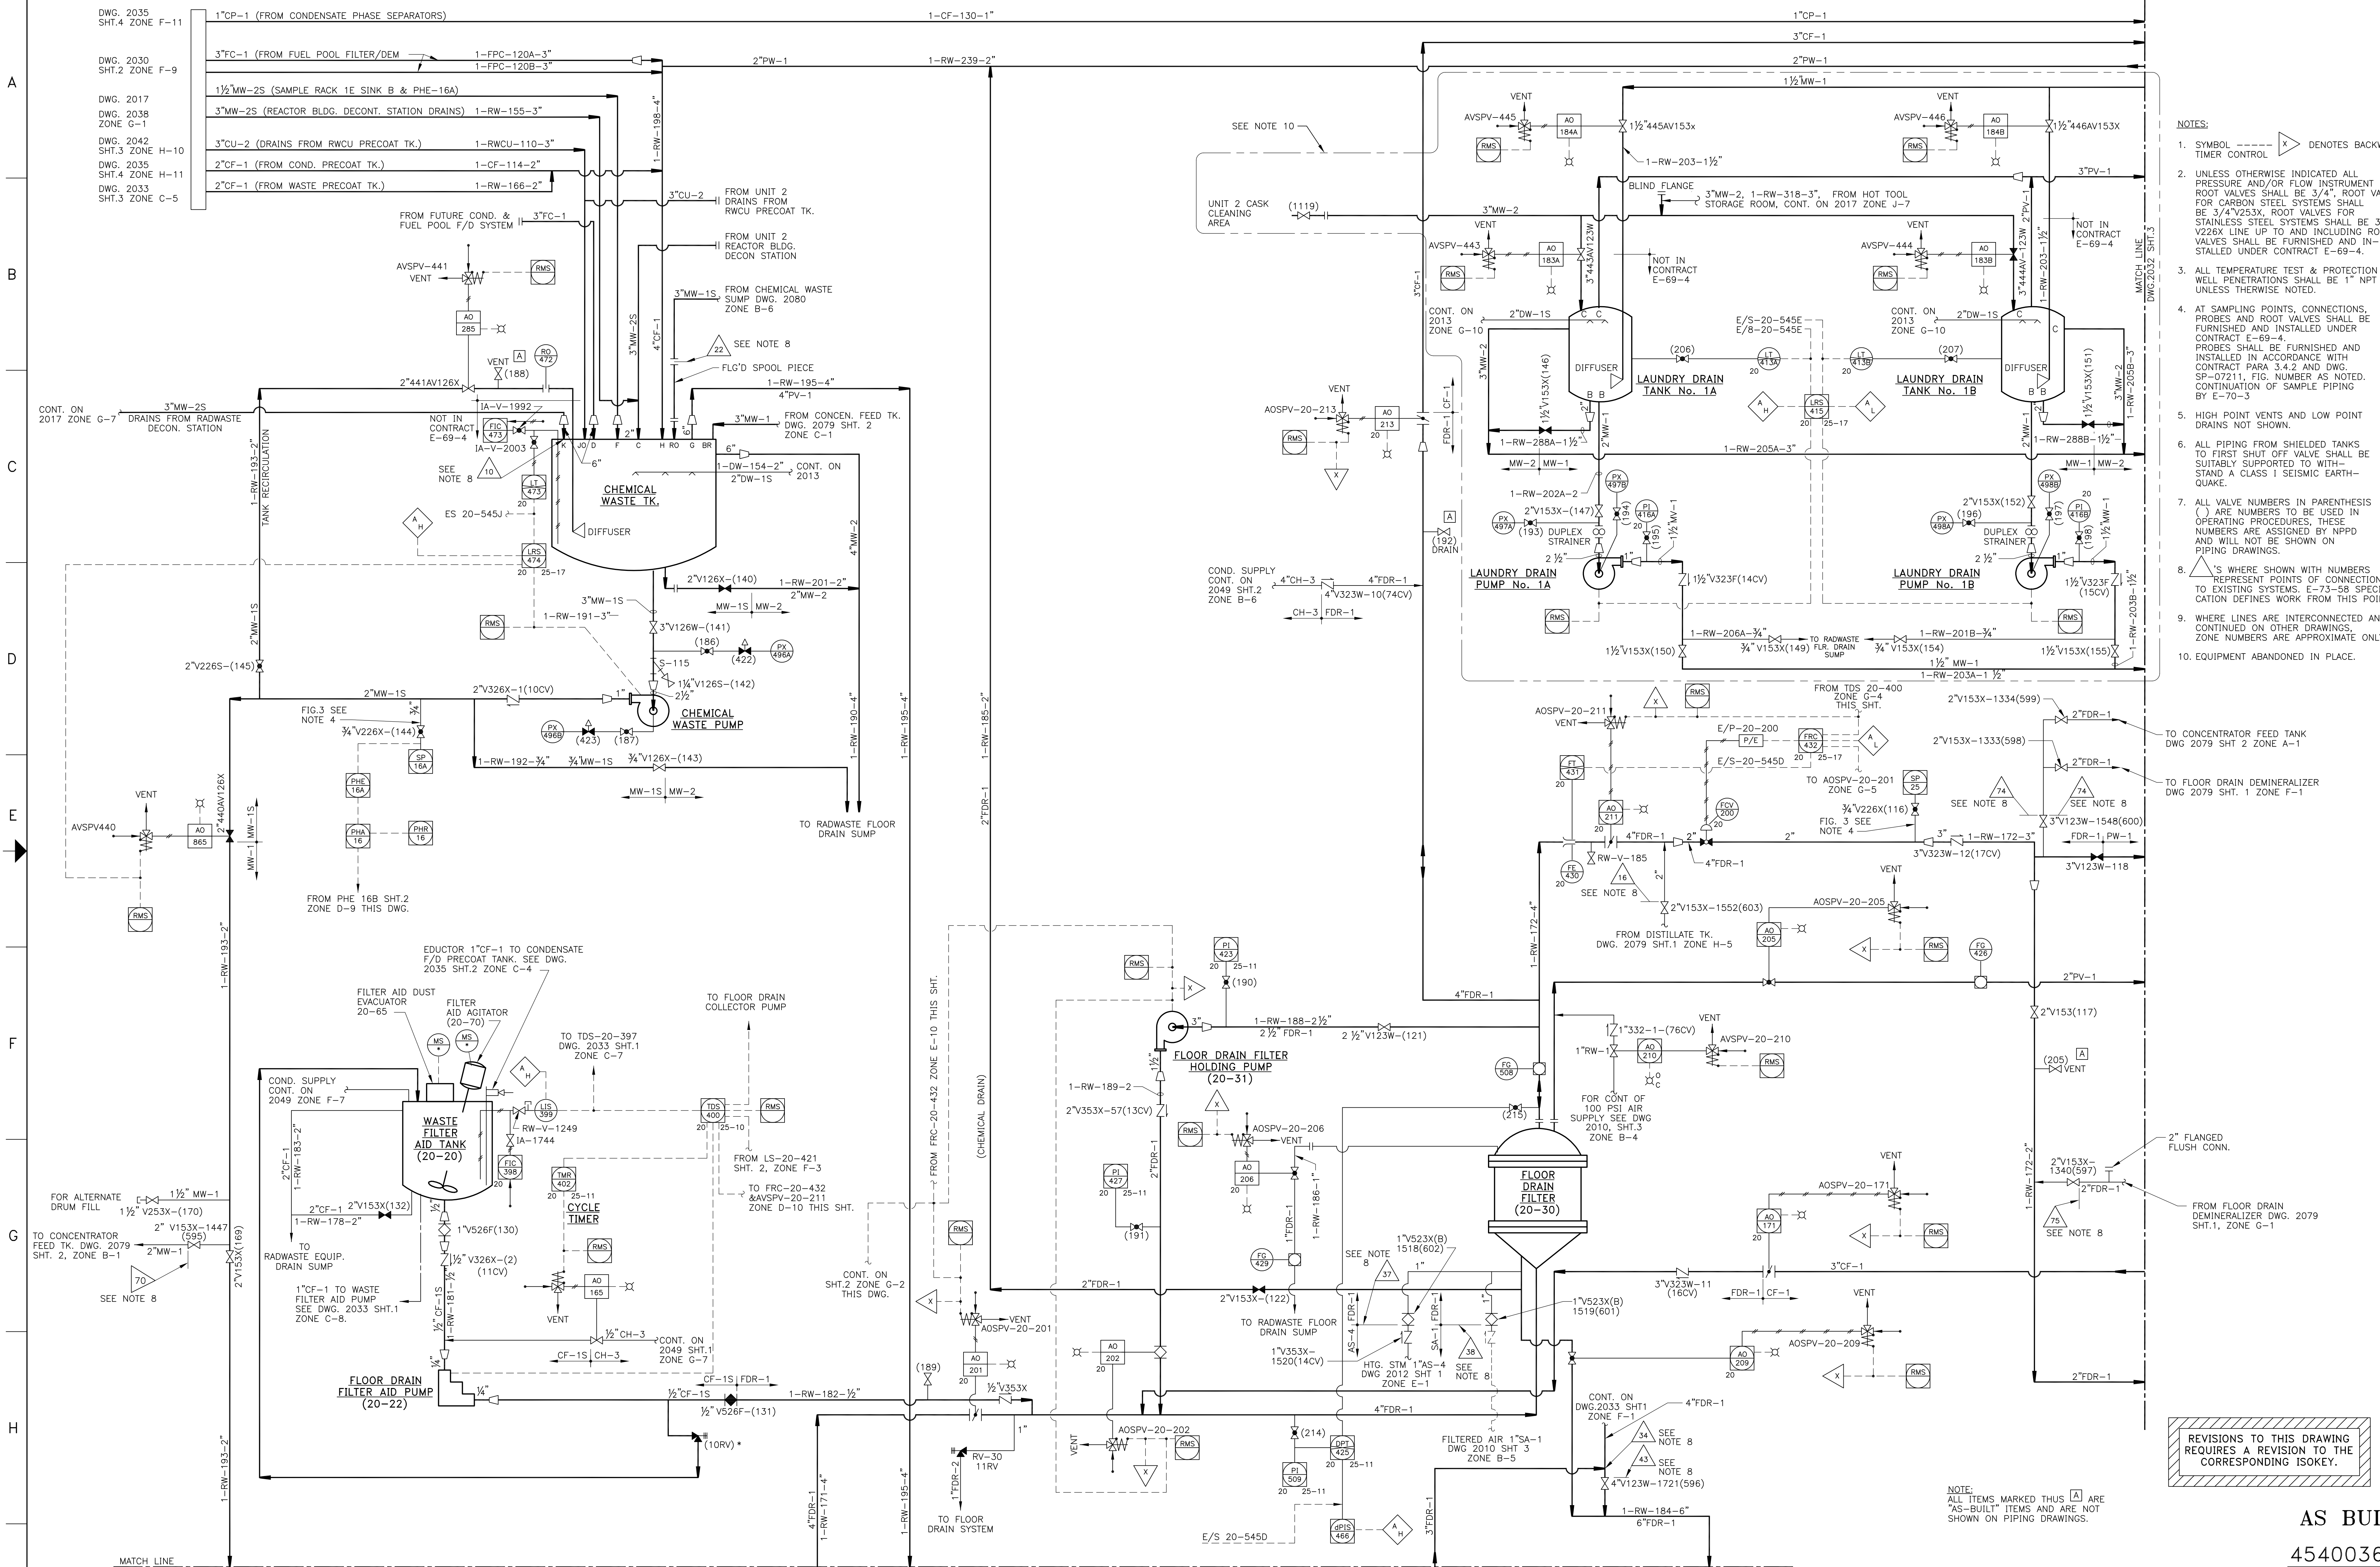

- NOTES:**
1. SYMBOL DENOTES BACKWASH TIMER CONTROL.
  2. UNLESS OTHERWISE INDICATED ALL PRESSURE AND/OR FLOW INSTRUMENT ROOT VALVES SHALL BE 3/4" ROOT VALVES FOR CARBON STEEL SYSTEMS SHALL BE 5/4" V226X, ROOT VALVES FOR STAINLESS STEEL SYSTEMS SHALL BE 3/4" V226X LINE UP TO AND INCLUDING ROOT VALVES SHALL BE FURNISHED AND INSTALLED UNDER CONTRACT E-69-4.
  3. ALL TEMPERATURE TEST & PROTECTION WELL PENETRATIONS SHALL BE 1" NPT UNLESS OTHERWISE NOTED.
  4. AT SAMPLING POINTS, CONNECTIONS, PROBES AND ROOT VALVES SHALL BE FURNISHED AND INSTALLED UNDER CONTRACT E-69-4. PROBES SHALL BE FURNISHED AND INSTALLED IN ACCORDANCE WITH CONTRACT PARA 3.4.2 AND DWG. SP-07211. FIG. NUMBER AS NOTED. CONTINUATION OF SAMPLE PIPING BY E-70-3.
  5. HIGH POINT VENTS AND LOW POINT DRAINS NOT SHOWN.
  6. ALL PIPING FROM SHIELDED TANKS TO FIRST SHUT OFF VALVE SHALL BE SUITABLY SUPPORTED TO WITHSTAND A CLASS I SEISMIC EARTH-QUAKE.
  7. ALL VALVE NUMBERS IN PARENTHESIS ( ) ARE NUMBERS TO BE USED IN OPERATING PROCEDURES. THESE NUMBERS ARE ASSIGNED BY NPPD AND WILL NOT BE SHOWN ON PIPING DRAWINGS.
  8. WHERE SHOWN WITH NUMBERS REPRESENT POINTS OF CONNECTION TO EXISTING SYSTEMS. E-73-58 SPECIFICATION DEFINES WORK FROM THIS POINT.
  9. WHERE LINES ARE INTERCONNECTED AND CONTINUED ON OTHER DRAWINGS, CUE NUMBERS ARE APPROXIMATE ONLY.
  10. EQUIPMENT ABANDONED IN PLACE.

REVISIONS TO THIS DRAWING REQUIRES A REVISION TO THE CORRESPONDING ISOKYK.


NOTE: ALL ITEMS MARKED THIS ARE "AS-BUILT" ITEMS AND ARE NOT SHOWN ON PIPING DRAWINGS.

**AS BUILT**  
454003625  
STATUS: Release  
DATE: 08/04/2015  
DS APPROVED: GEHORN  
VER: AB REV: 32 SIZE: F

FOR PREVIOUS REVISIONS, SEE SUPERSEDED CARDS.						SIGNIFICANT NUMBER		DRAWN DATE		CHECKED DATE		APPROVED DATE		FILMED	
NO.	DESCRIPTION	DFT	DATE	ENG	GROUP	1	2	3	4	5	6	7	8	9	10
AB/22	DR-2013-0599 (DCN 13-2083)		8/4/15	GEHORN											

COOPER NUCLEAR STATION  
FLOW DIAGRAM  
HIGH CONDUCTIVITY (FLOOR DRAINS  
CHEMICAL AND LAUNDRY WASTE) PROCESS

**BURNS & ROE**  
2032 SH 1

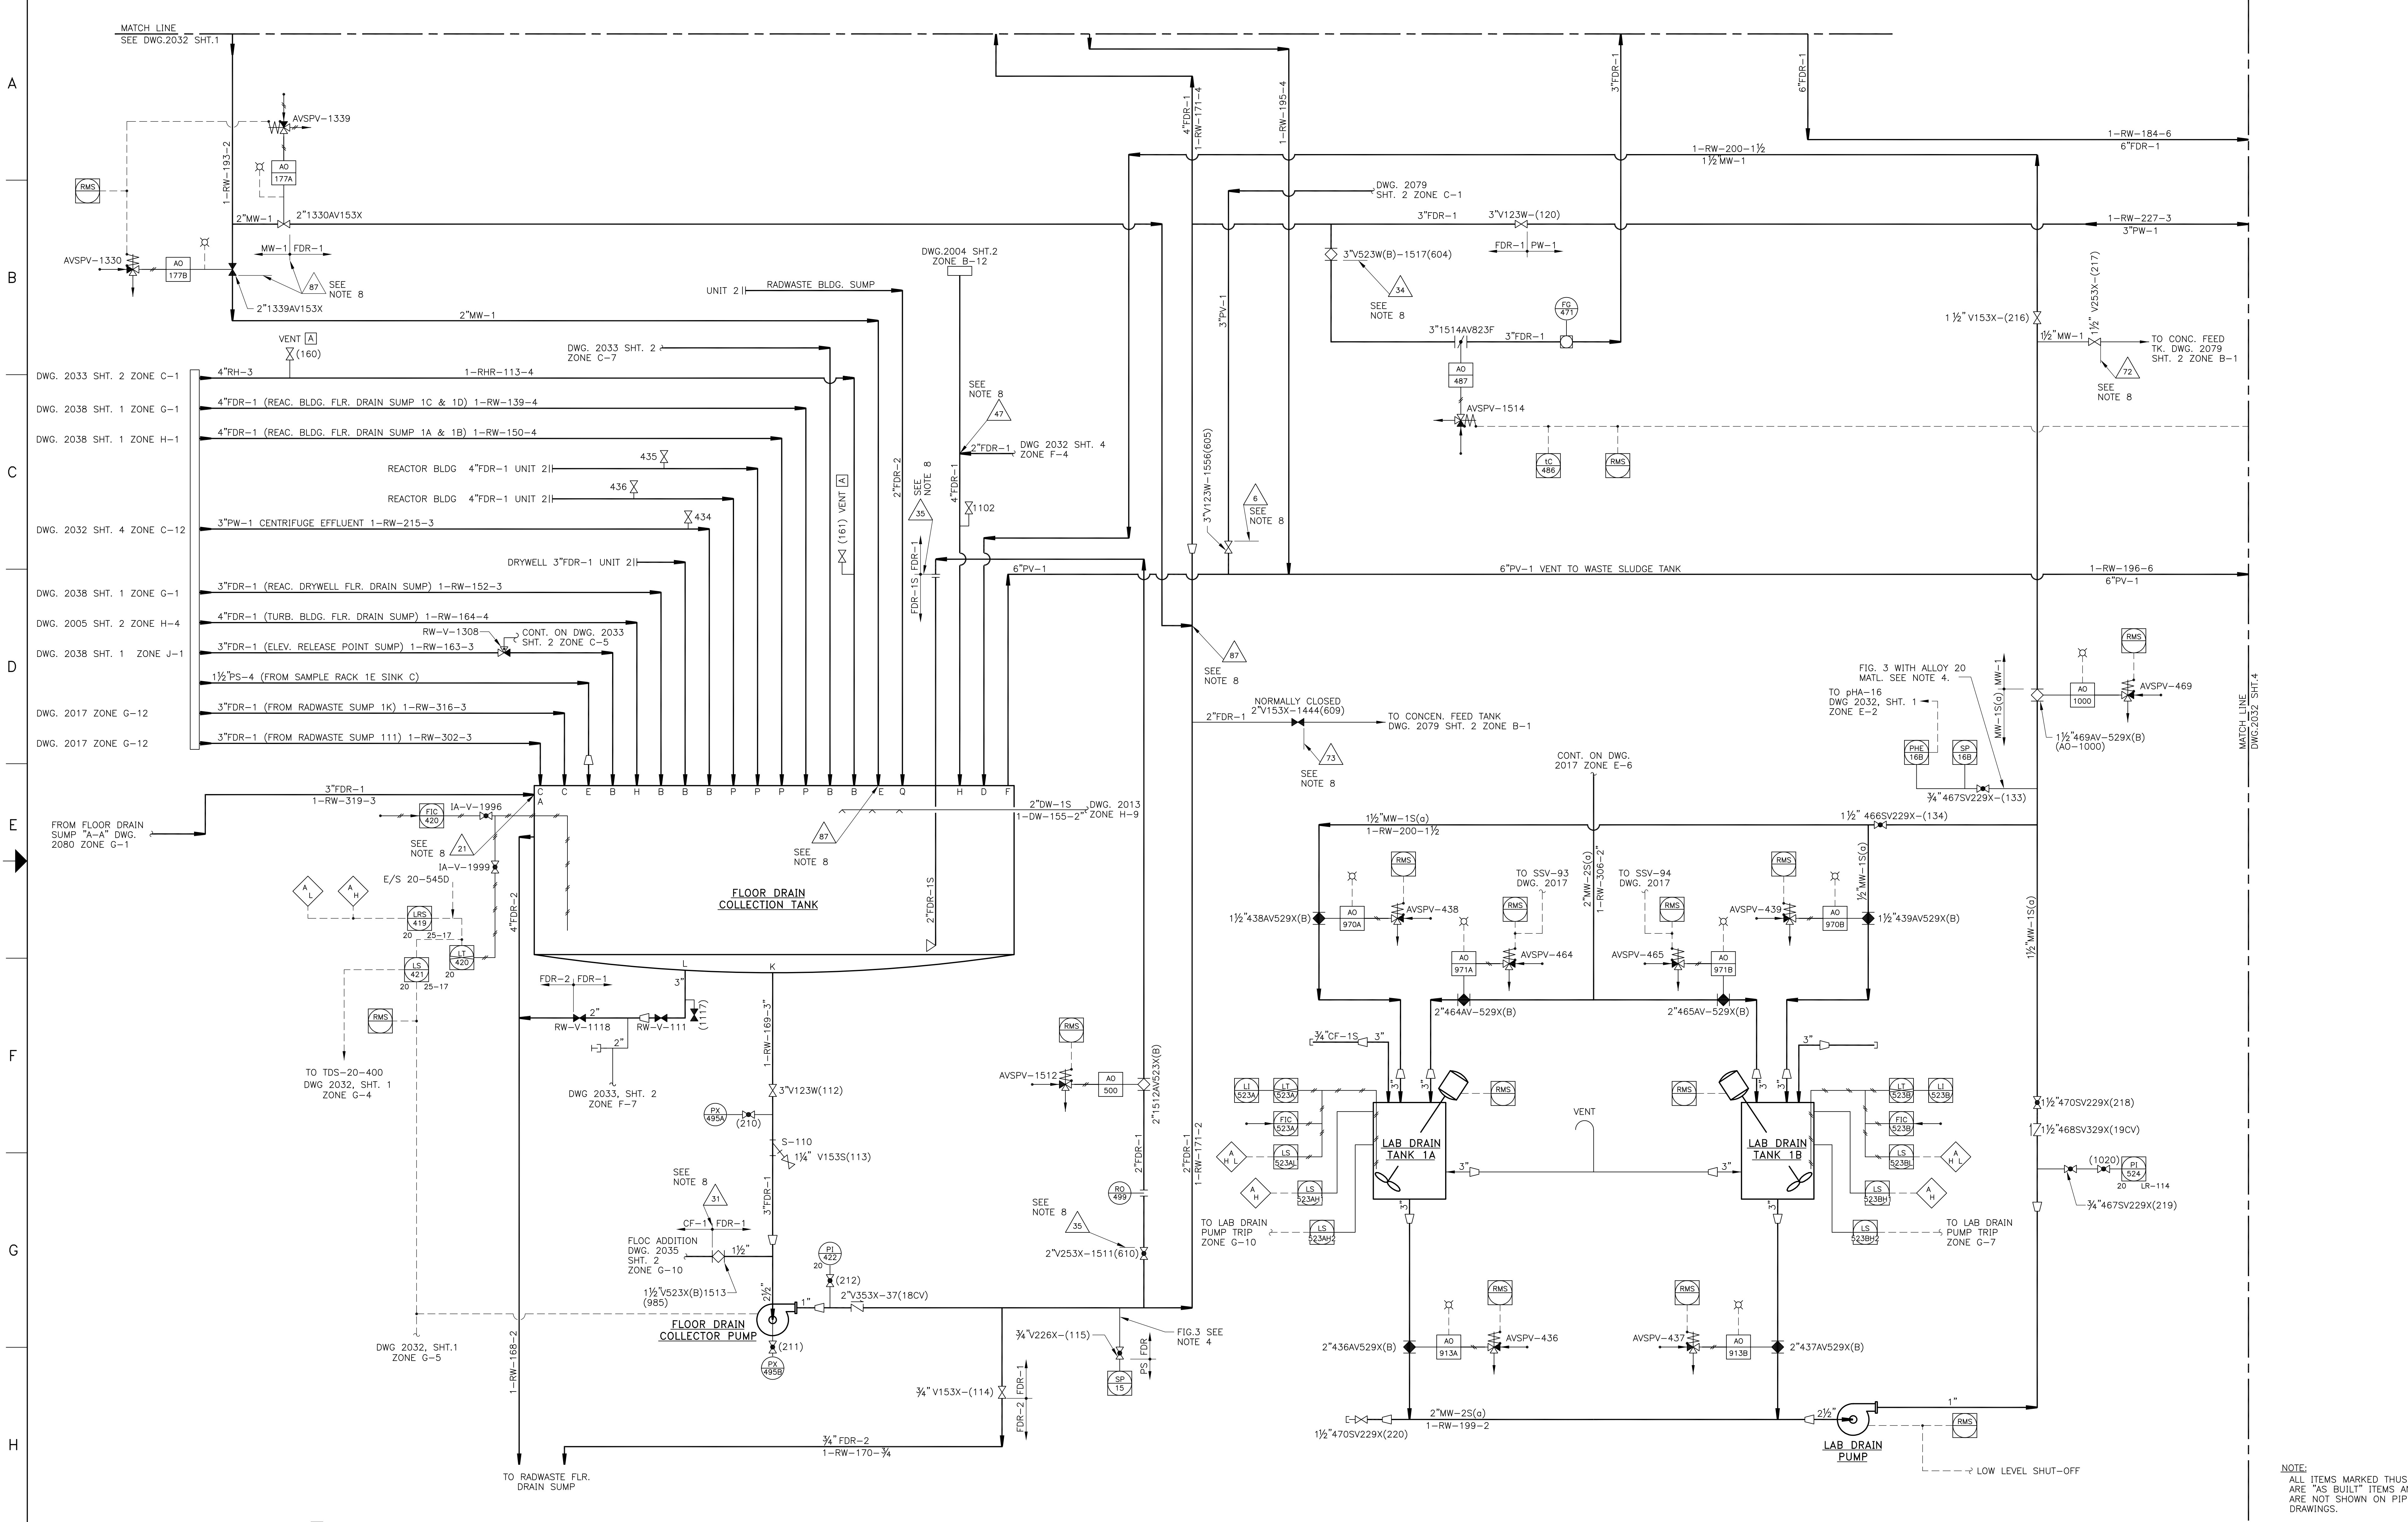

- DWG.2030 SHT.2 ZONE G-9 (6\"/>
- DWG.2030 SHT.2 ZONE H-9 (6\"/>
- DWG.2042 SHT.3 ZONE J-10 (1\"/>
- DWG.2035 SHT.4 ZONE C-11 (6\"/>

NOTE:  
ALL ITEMS MARKED THUS [A] ARE "AS BUILT" ITEMS AND ARE NOT SHOWN ON PIPING DRAWINGS.

FOR NOTES SEE SHT. 1  
**AS BUILT**  
**454003672**  
CADD DRAWING

REVISIONS TO THIS DRAWING  
REQUIRES A REVISION TO THE  
CORRESPONDING ISOKEY.

FOR PREVIOUS REVISIONS, SEE SUPERSEDED CARDS.

REVISIONS BY N.P.P.D.					
NO.	REVISIONS	DFT	CHK	APP	DATE
N21	REBRAWN, DCR 3-40217	PAM	HFY	RGA	4/24/01
N22	DCR 01-0877	RGH	TGT	DLR	7/18/03


SIGNIFICANT NUMBER	GROUP						DRAWN	DATE	CHECKED	DATE	APPROVED	DATE	FILMED	REVISION
	1	2	3	4	5	6								

**FLOW DIAGRAM**  
**HIGH CONDUCTIVITY (FLOOR DRAINS,**  
**CHEMICAL AND LAUNDRY WASTE) PROCESS**  
**COOPER NUCLEAR STATION**

**BURNS & ROE**

2032 SH 2 N22

NO.	REVISIONS

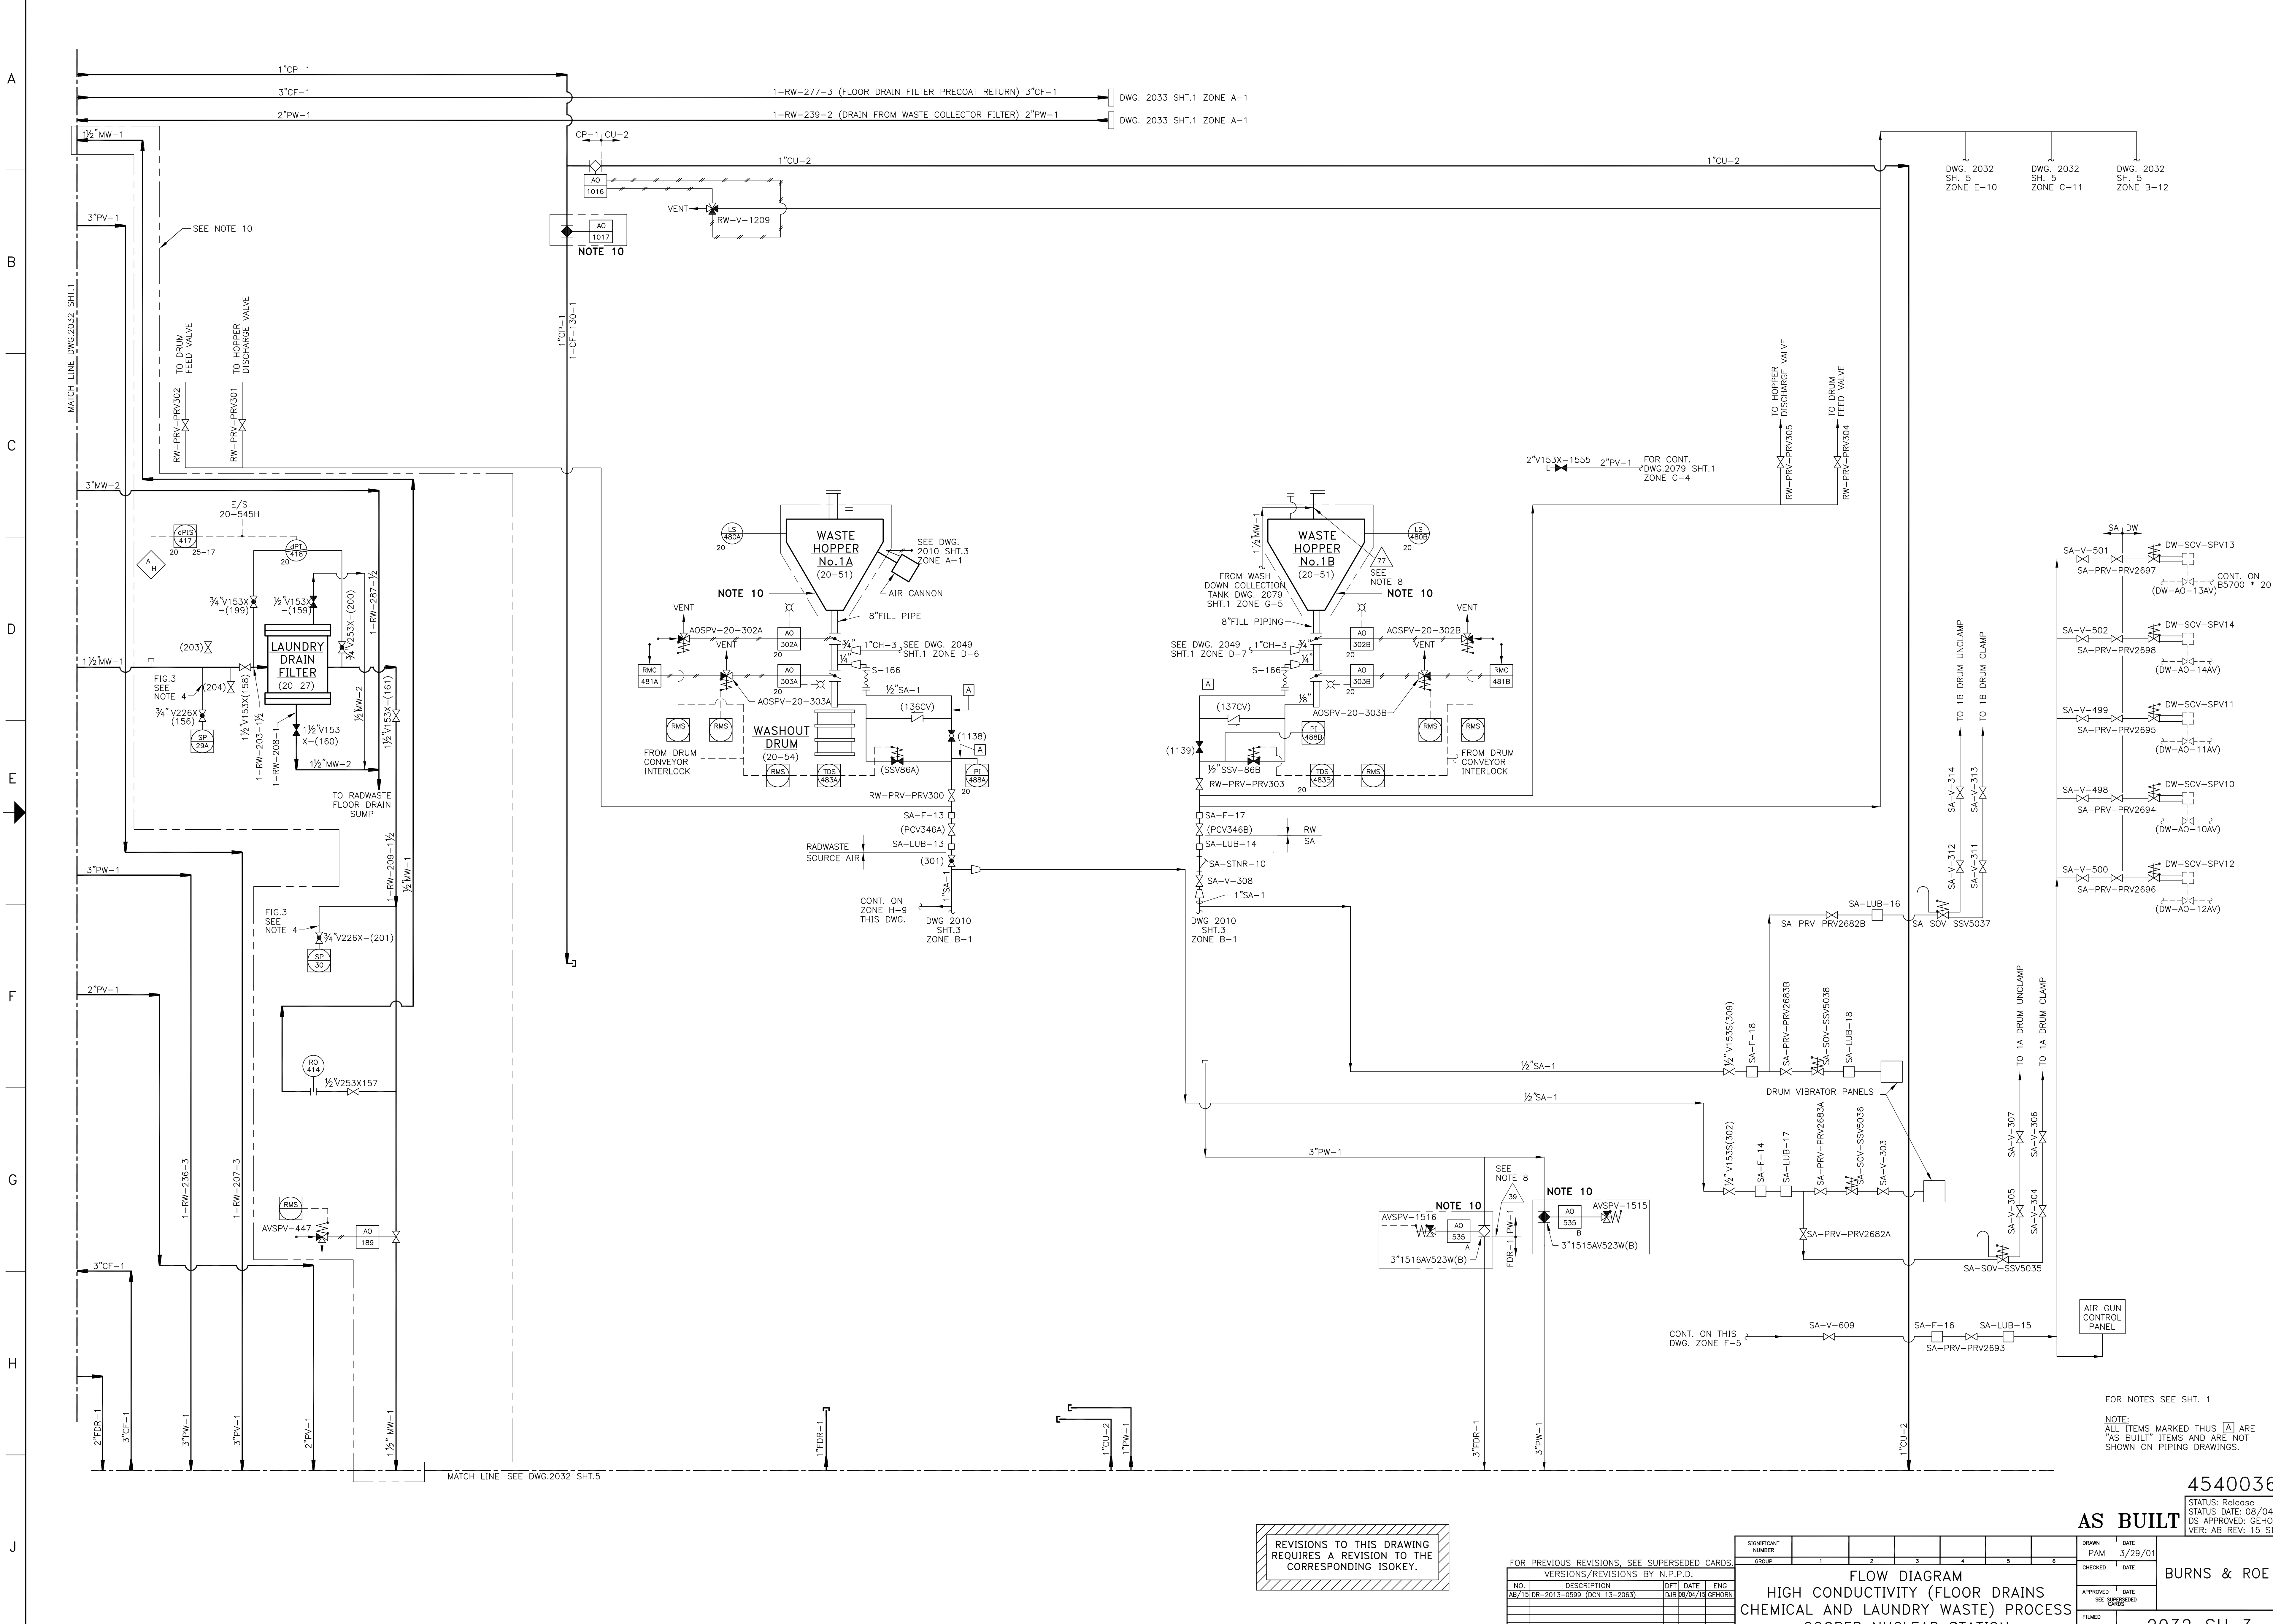

A  
B  
C  
D  
E  
F  
G  
H  
J

A  
B  
C  
D  
E  
F  
G  
H  
J

MATCH LINE DWG. 2032 SH. 1

MATCH LINE SEE DWG. 2032 SH. 5

REVISIONS TO THIS DRAWING  
REQUIRES A REVISION TO THE  
CORRESPONDING ISOKEY.

FOR PREVIOUS REVISIONS, SEE SUPERSEDED CARDS.

VERSIONS/REVISIONS BY N.P.P.D.				
NO.	DESCRIPTION	DFT	DATE	ENG
AB/15	DR-2013-0599 (DCN 13-2063)	DJB	08/04/18	GEHORN

SIGNIFICANT NUMBER	GROUP	1	2	3	4	5	6	DRAWN	DATE
									3/29/01
<p style="text-align: center;"><b>AS BUILT</b></p> <p style="text-align: center;">FLOW DIAGRAM HIGH CONDUCTIVITY (FLOOR DRAINS) CHEMICAL AND LAUNDRY WASTE PROCESS COOPER NUCLEAR STATION</p>									<p>DATE</p> <p>3/29/01</p>
<p>APPROVED</p> <p>DATE</p> <p>3/29/01</p>									<p>DATE</p> <p>3/29/01</p>
<p>FILED</p>									<p>DATE</p> <p>3/29/01</p>


454003673  
 STATUS: Release  
 STATUS DATE: 08/04/2015  
 DS APPROVED: GEHORN  
 VER: AB REV: 15 SIZE: F

FOR NOTES SEE SH. 1  
 NOTE: ALL ITEMS MARKED THUS [A] ARE "AS BUILT" ITEMS AND ARE NOT SHOWN ON PIPING DRAWINGS.

2032 SH 3

DWG NO. C0017993



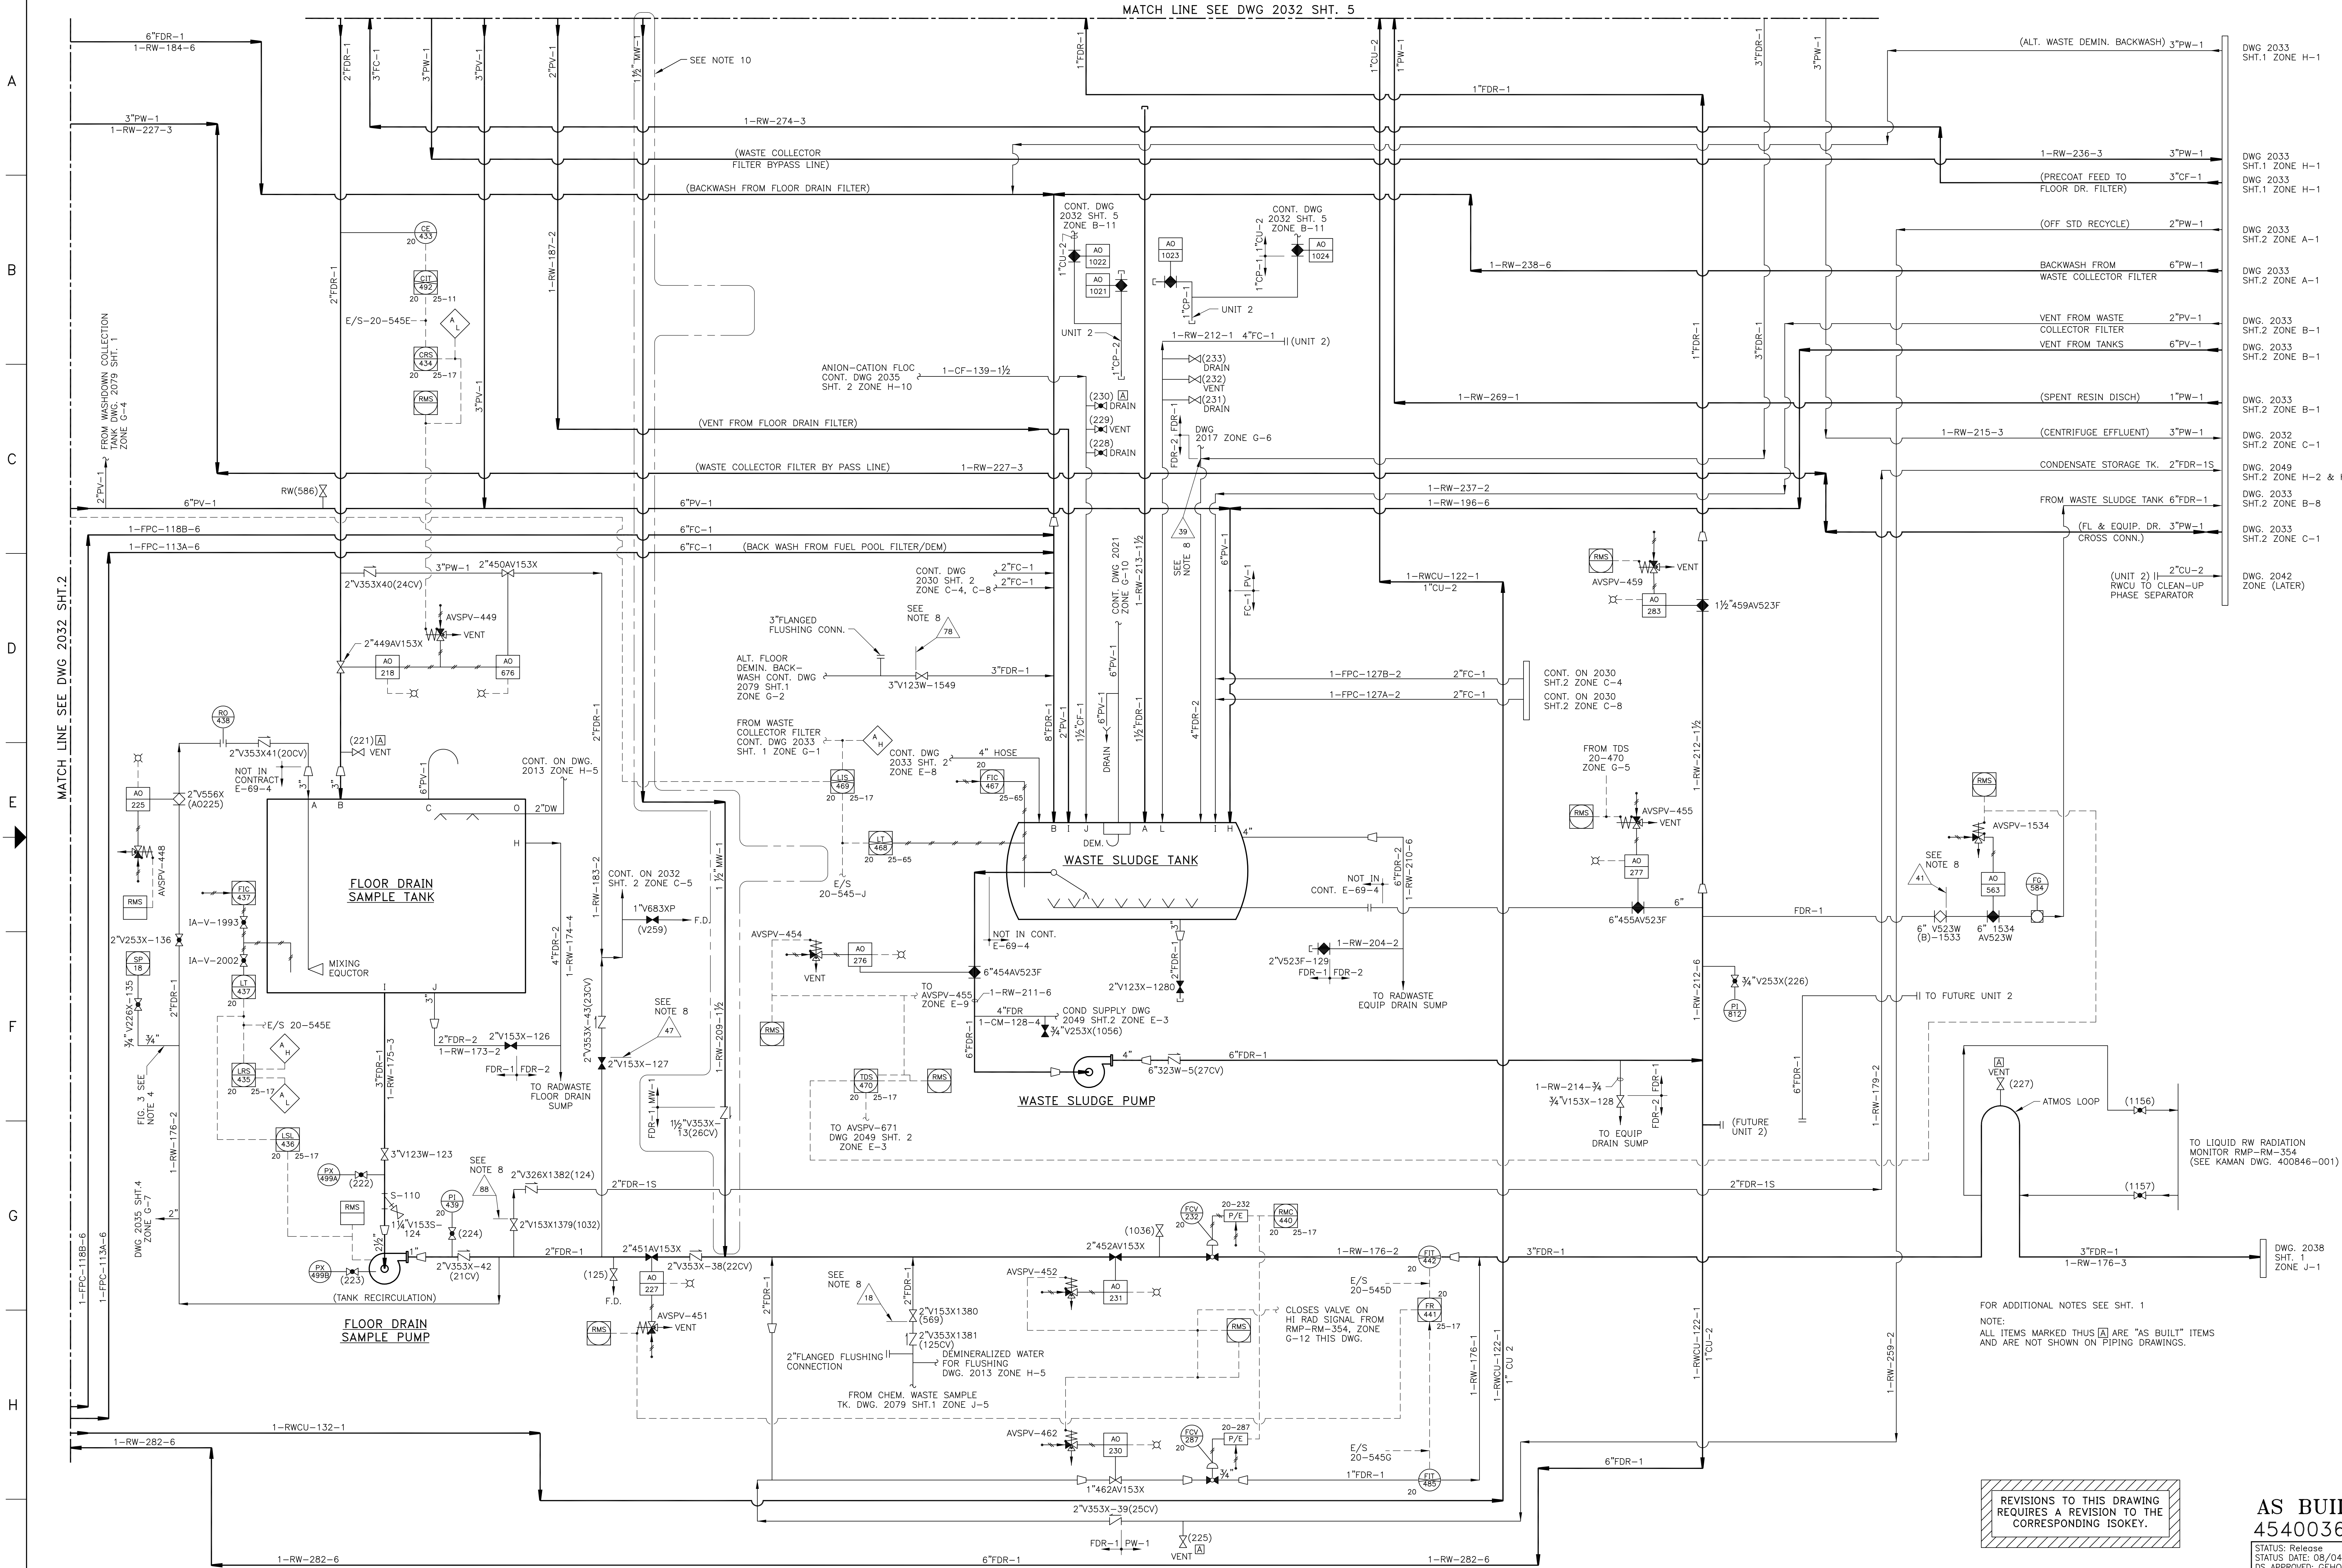

REVISIONS TO THIS DRAWING  
REQUIRES A REVISION TO THE  
CORRESPONDING ISOKEY.

**AS BUILT**  
454003674

STATUS: Release  
DATE: 08/04/2015  
DS APPROVED: GEHORN  
VER: AB REV: 26 SIZE: F

FOR PREVIOUS REVISIONS, SEE SUPERSEDED CARDS.

VERSIONS/REVISIONS BY N.P.P.D.				
NO.	DESCRIPTION	DFTI	DATE	ENG
AB/28	DR-2013-0599 (DCN 13-2068)	DJR	8/4/13	GEHORN

SIGNIFICANT NUMBER	GROUP	1	2	3	4	5	6	DATE
								3/28/01


DRAWN: RRT  
CHECKED: DATE  
APPROVED: DATE  
FILMED: DATE

**BURNS & ROE**

2032 SH 4

DATE PLOTTED: 08/04/2015 10:00:00  
DRAWN BY: C0017298

FLOW DIAGRAM  
HIGH CONDUCTIVITY (FLOOR DRAINS,  
CHEMICAL AND LAUNDRY WASTES) PROCESS  
COOPER NUCLEAR STATION

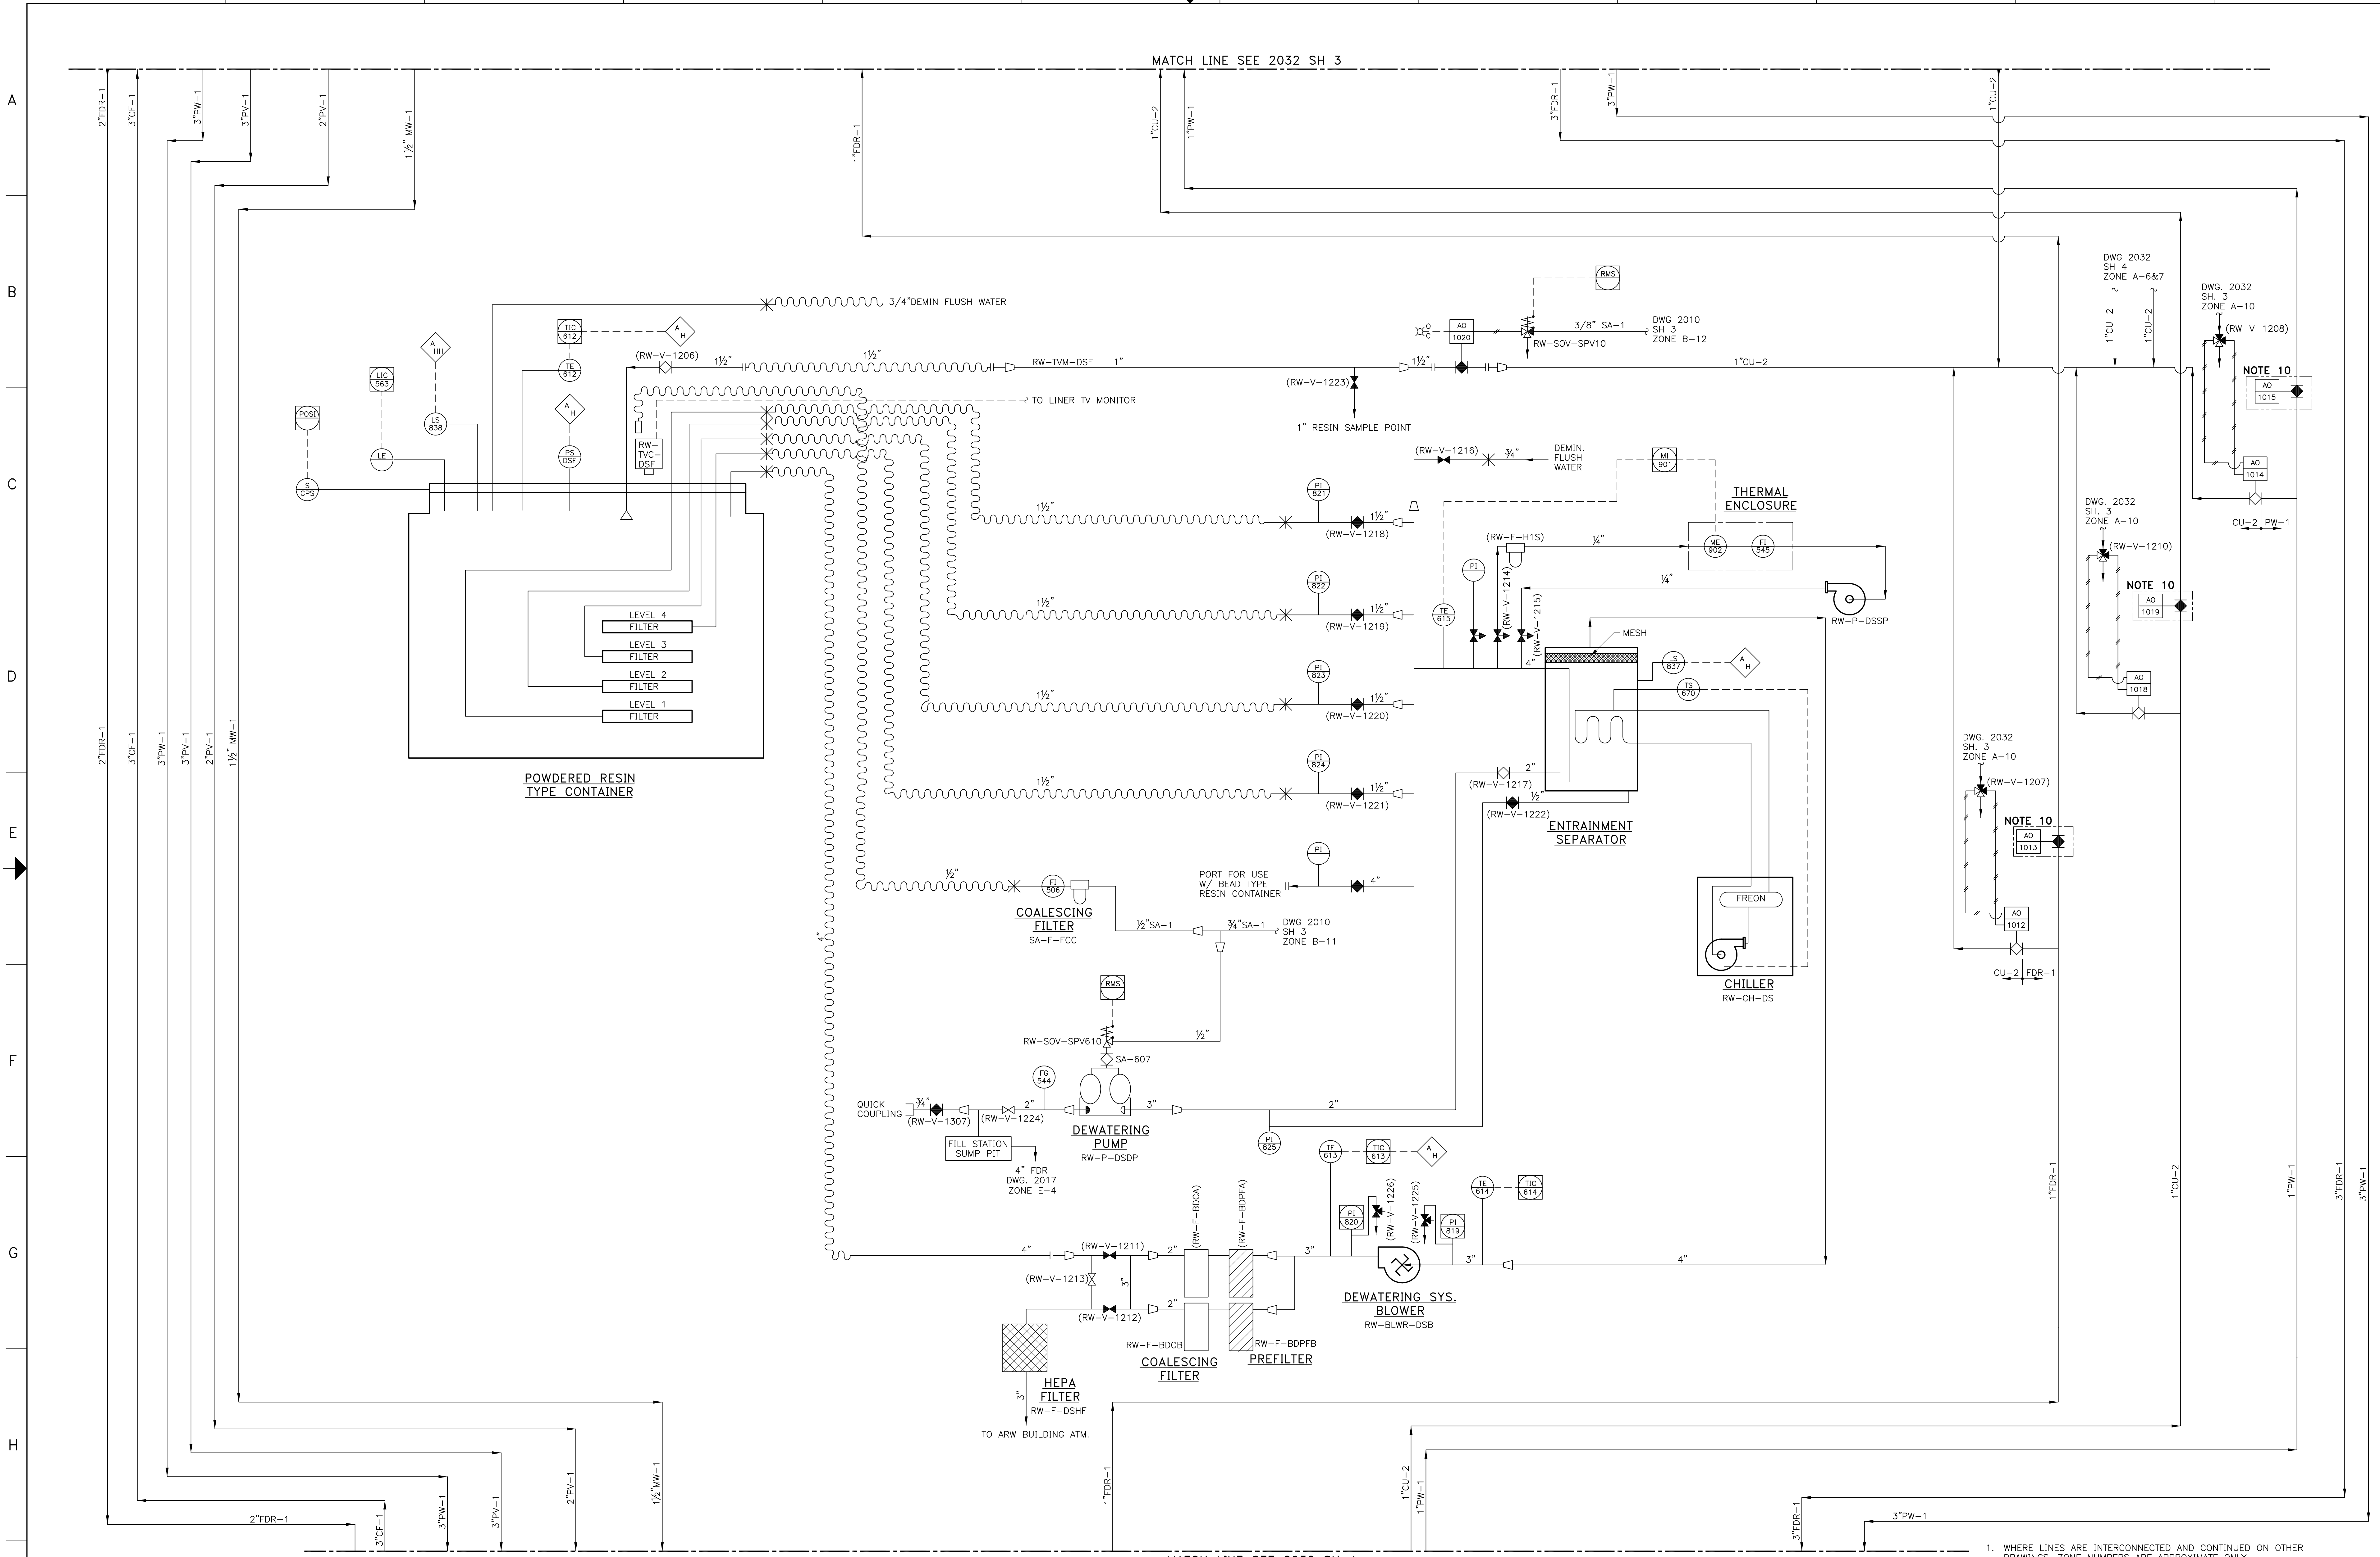

REVISIONS TO THIS DRAWING  
REQUIRES A REVISION TO THE  
CORRESPONDING ISOKEY.

FOR PREVIOUS REVISIONS, SEE SUPERSEDED CARDS.

VERSIONS/REVISIONS BY N.P.P.D.			
NO.	DESCRIPTION	DFTI	DATE
AB/09	DR-2013-0599 (DCN 13-2061)	DJB	08/04/13

SIGNIFICANT NUMBER	GROUP	1	2	3	4	5	6	DATE	DRAWN
								DATE	
								10/11/01	HFY
									CHECKED
									DATE
									APPROVED
									DATE
									FILED

AS BUILT


BURNS & ROE

2032 SH 5

454223017

STATUS: Release  
STATUS DATE: 08/04/2015  
DS APPROVED: GEHORN  
VER: AB REV: 09 SIZE: F

00017997

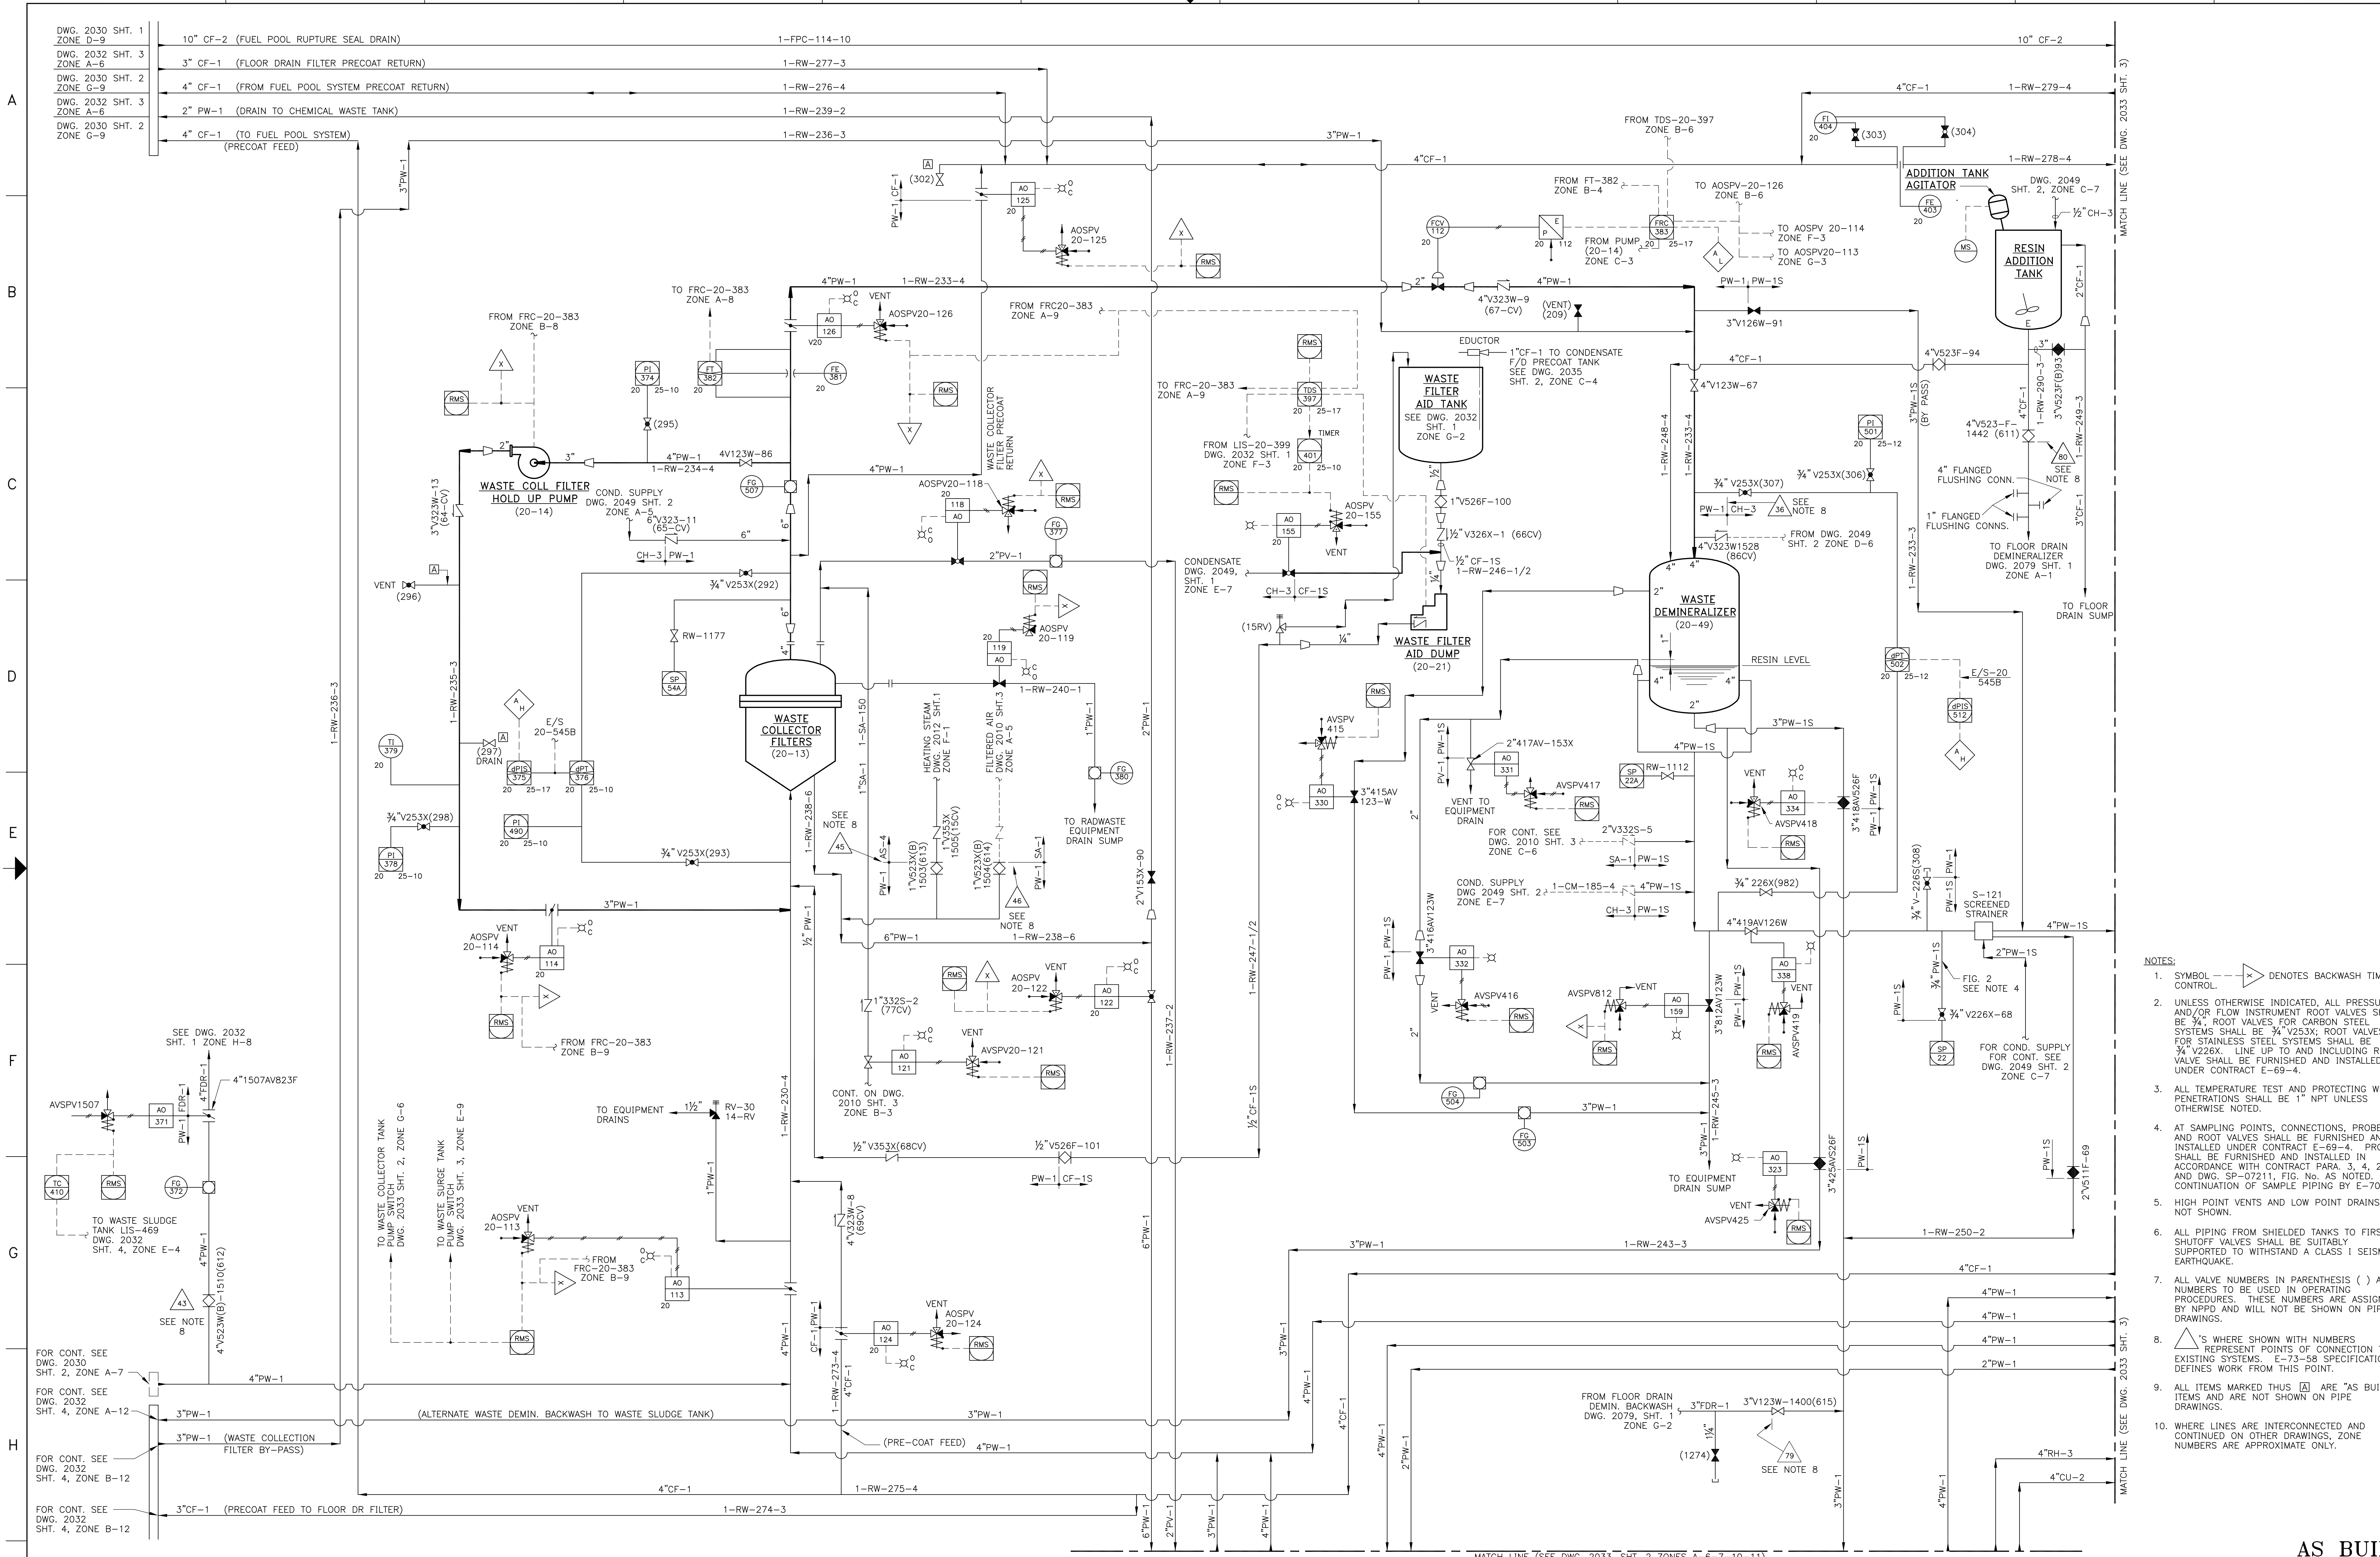

- NOTES:**
- SYMBOL DENOTES BACKWASH TIMER CONTROL.
  - UNLESS OTHERWISE INDICATED, ALL PRESSURE AND/OR FLOW INSTRUMENT ROOT VALVES SHALL BE 3/4\"/>
  - ALL TEMPERATURE TEST AND PROTECTING WELL PENETRATIONS SHALL BE 1\"/>
  - AT SAMPLING POINTS, CONNECTIONS, PROBES AND ROOT VALVES SHALL BE FURNISHED AND INSTALLED UNDER CONTRACT E-69-4. PROBES SHALL BE FURNISHED AND INSTALLED IN ACCORDANCE WITH CONTRACT PARA. 3, 4, 2 AND DWG. SP-07211, FIG. NO. AS NOTED. CONTINUATION OF SAMPLE PIPING BY E-70-3.
  - HIGH POINT VENTS AND LOW POINT DRAINS NOT SHOWN.
  - ALL PIPING FROM SHIELDED TANKS TO FIRST SHUTOFF VALVES SHALL BE SUITABLY SUPPORTED TO WITHSTAND A CLASS 1 SEISMIC EARTHQUAKE.
  - ALL VALVE NUMBERS IN PARENTHESIS ( ) ARE NUMBERS TO BE USED IN OPERATING PROCEDURES. THESE NUMBERS ARE ASSIGNED BY NPPD AND WILL NOT BE SHOWN ON PIPING DRAWINGS.
  - 'S WHERE SHOWN WITH NUMBERS REPRESENT POINTS OF CONNECTION TO EXISTING SYSTEMS. E-73-58 SPECIFICATION DEFINES WORK FROM THIS POINT.
  - ALL ITEMS MARKED THUS ARE "AS BUILT" ITEMS AND ARE NOT SHOWN ON PIPING DRAWINGS.
  - WHERE LINES ARE INTERCONNECTED AND CONTINUED ON OTHER DRAWINGS, ZONE NUMBERS ARE APPROXIMATE ONLY.


REVISIONS TO THIS DRAWING  
REQUIRES A REVISION TO THE  
CORRESPONDING ISOKEY.

FOR PREVIOUS REVISIONS, SEE SUPERSEDED CARDS.


VERSIONS/REVISIONS BY N.P.P.D.			
NO.	DESCRIPTION	DFT DATE	ENG
AB/210R-2018-0001		DJB/17/18	RS/CULLI

SIGNIFICANT NUMBER		DRAWN		DATE	
1	2	3	4	5	6
COOPER NUCLEAR STATION FLOW DIAGRAM LOW CONDUCTIVITY (EQUIPMENT DRAINS) PROCESSING					
CHECKED			DATE		
APPROVED			DATE		
FILMED			DATE		
2033 SH 1				BURNS & ROE	
STATUS: Release				STATUS DATE: 01/18/2018	
DS APPROVED: RS/CULLI				VER: AB REV: 21 SIZE: F	

**AS BUILT**  
454003626

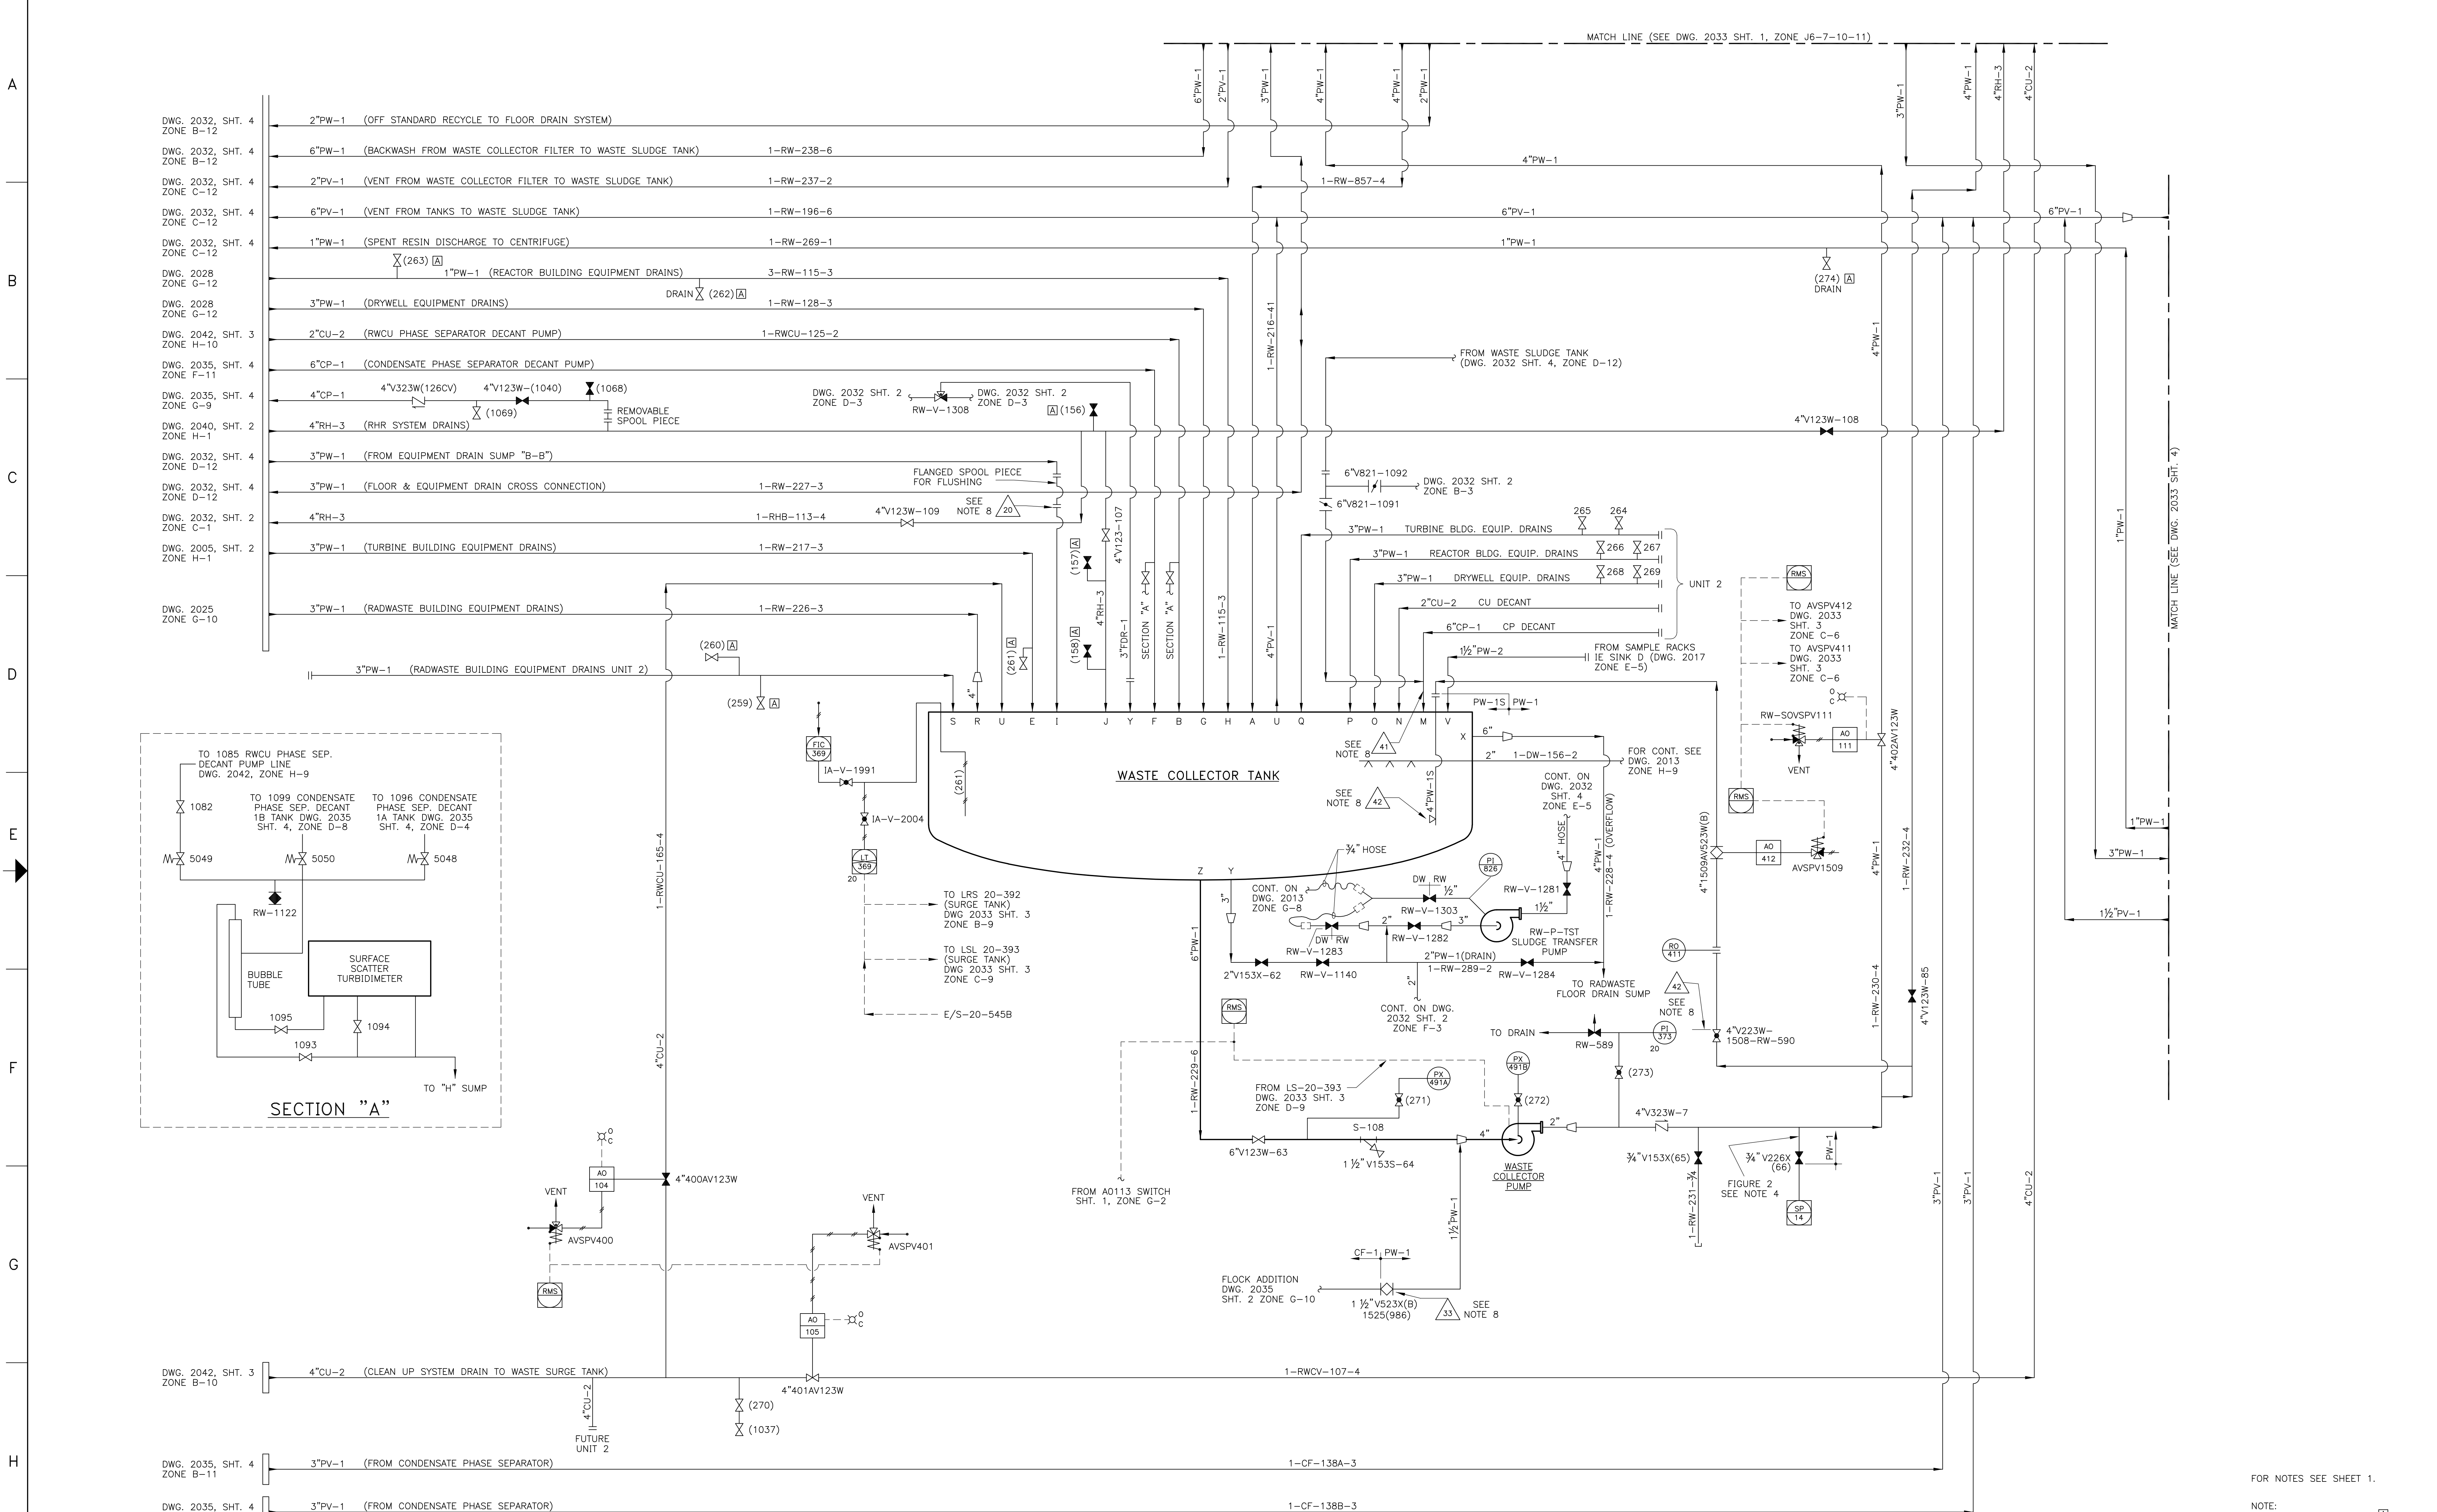

- DWG. 2032, SHT. 4 ZONE B-12 → 2"PW-1 (OFF STANDARD RECYCLE TO FLOOR DRAIN SYSTEM)
- DWG. 2032, SHT. 4 ZONE B-12 → 6"PW-1 (BACKWASH FROM WASTE COLLECTOR FILTER TO WASTE SLUDGE TANK) 1-RW-238-6
- DWG. 2032, SHT. 4 ZONE C-12 → 2"PV-1 (VENT FROM WASTE COLLECTOR FILTER TO WASTE SLUDGE TANK) 1-RW-237-2
- DWG. 2032, SHT. 4 ZONE C-12 → 6"PV-1 (VENT FROM TANKS TO WASTE SLUDGE TANK) 1-RW-196-6
- DWG. 2032, SHT. 4 ZONE C-12 → 1"PW-1 (SPENT RESIN DISCHARGE TO CENTRIFUGE) 1-RW-269-1
- DWG. 2028 ZONE G-12 → 1"PW-1 (REACTOR BUILDING EQUIPMENT DRAINS) 3-RW-115-3
- DWG. 2028 ZONE G-12 → 3"PW-1 (DRYWELL EQUIPMENT DRAINS) 1-RW-128-3
- DWG. 2042, SHT. 3 ZONE H-10 → 2"CU-2 (RWCU PHASE SEPARATOR DECANT PUMP) 1-RWCU-125-2
- DWG. 2035, SHT. 4 ZONE F-11 → 6"CP-1 (CONDENSATE PHASE SEPARATOR DECANT PUMP)
- DWG. 2035, SHT. 4 ZONE G-9 → 4"CP-1 (4"V323W(126CV) 4"V123W-(1040) (1068) REMOVABLE SPOOL PIECE)
- DWG. 2040, SHT. 2 ZONE H-1 → 4"RH-3 (RHR SYSTEM DRAINS) (1069)
- DWG. 2032, SHT. 4 ZONE D-12 → 3"PW-1 (FROM EQUIPMENT DRAIN SUMP "B-B")
- DWG. 2032, SHT. 4 ZONE D-12 → 3"PW-1 (FLOOR & EQUIPMENT DRAIN CROSS CONNECTION) 1-RW-227-3
- DWG. 2032, SHT. 2 ZONE C-1 → 4"RH-3 (1-RHB-113-4 4"V123W-109 SEE NOTE 8 20)
- DWG. 2005, SHT. 2 ZONE H-1 → 3"PW-1 (TURBINE BUILDING EQUIPMENT DRAINS) 1-RW-217-3
- DWG. 2025 ZONE G-10 → 3"PW-1 (RADWASTE BUILDING EQUIPMENT DRAINS) 1-RW-226-3
- DWG. 2025 ZONE G-10 → 3"PW-1 (RADWASTE BUILDING EQUIPMENT DRAINS UNIT 2)
- DWG. 2042, SHT. 3 ZONE B-10 → 4"CU-2 (CLEAN UP SYSTEM DRAIN TO WASTE SURGE TANK)
- DWG. 2035, SHT. 4 ZONE B-11 → 3"PV-1 (FROM CONDENSATE PHASE SEPARATOR)
- DWG. 2035, SHT. 4 ZONE C-11 → 3"PV-1 (FROM CONDENSATE PHASE SEPARATOR)

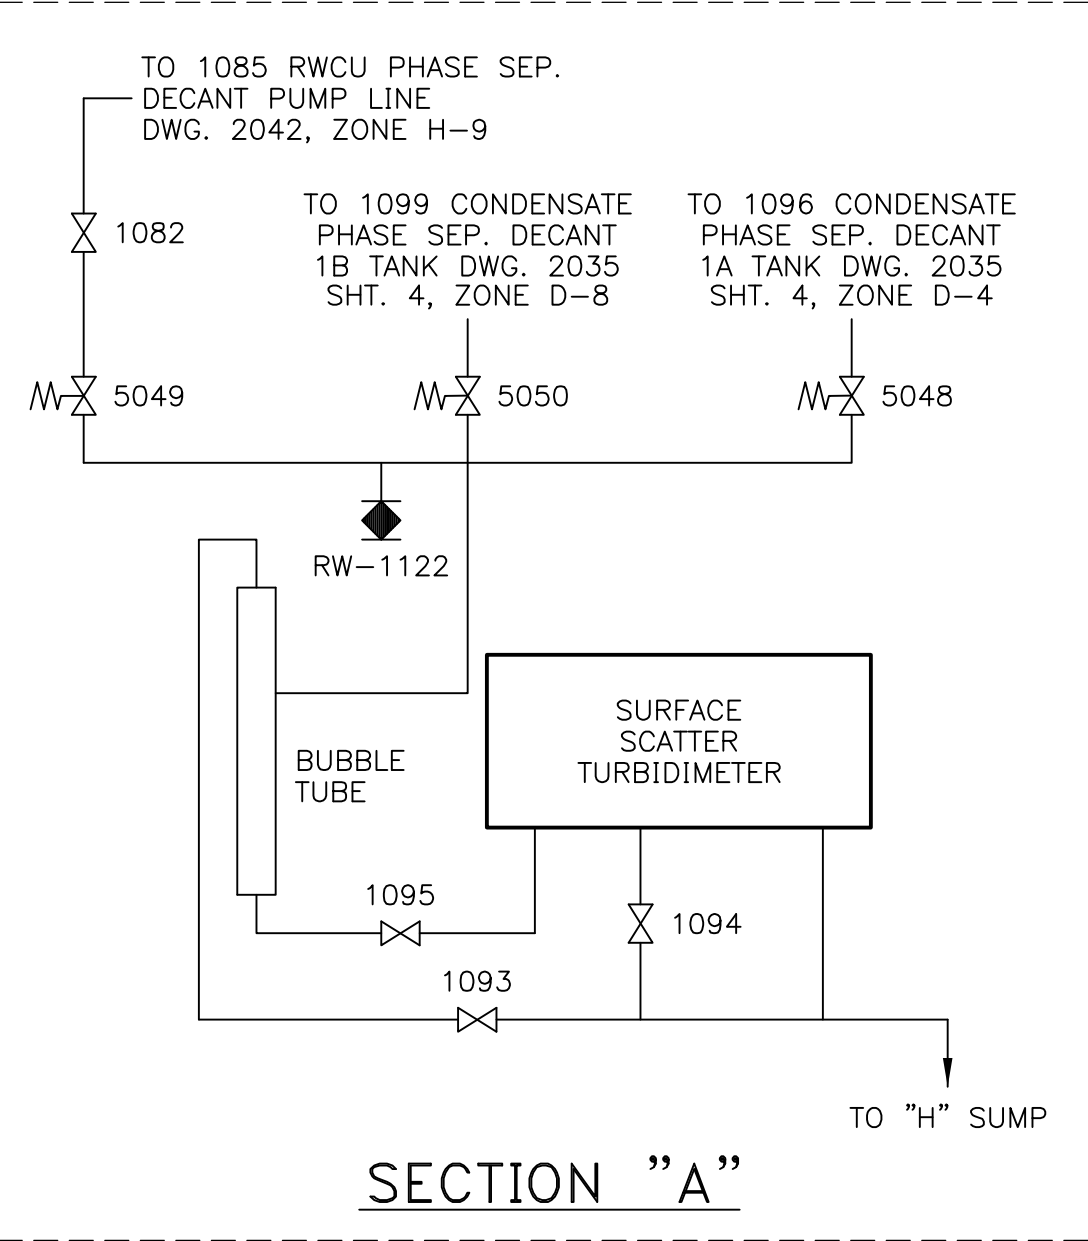

REVISIONS TO THIS DRAWING  
REQUIRES A REVISION TO THE  
CORRESPONDING ISOKEY.

FOR PREVIOUS REVISIONS, SEE SUPERSEDED CARDS.

REVISIONS BY N.P.P.D.					
NO.	REVISIONS	DFT	CHK	APP	DATE
N22	REDRAWN, DCR 3-40217	DLR	RGK	KG	4/24/07
(DCN 01-0400)					
N23	NOI 10244847 (DCN 03-0831)	KG	KG	DLR	7/17/03
N24	RCH 2002-1478 (DCN 04-0591)	KG	KG	RGK	3/26/04
N25	(DCN 10-1716)	DLR	DLR	DLR	09/09/00

SIGNIFICANT NUMBER	1	2	3	4	5	6	7	8	9	10	11	12
	DRAWN RAC	DATE 10/22/96										
CHECKED	DATE											
APPROVED	DATE											
FILMED												

FLOW DIAGRAM  
LOW CONDUCTIVITY  
(EQUIPMENT DRAINS) PROCESSING  
COOPER NUCLEAR STATION


AS BUILT  
454003679

BURNS & ROE

2033 SH 2 N25

FOR NOTES SEE SHEET 1.

NOTE:  
ALL ITEMS MARKED WITH [ ]  
ARE "AS BUILT" ITEMS AND ARE  
NOT SHOWN ON PIPING DRAWINGS.

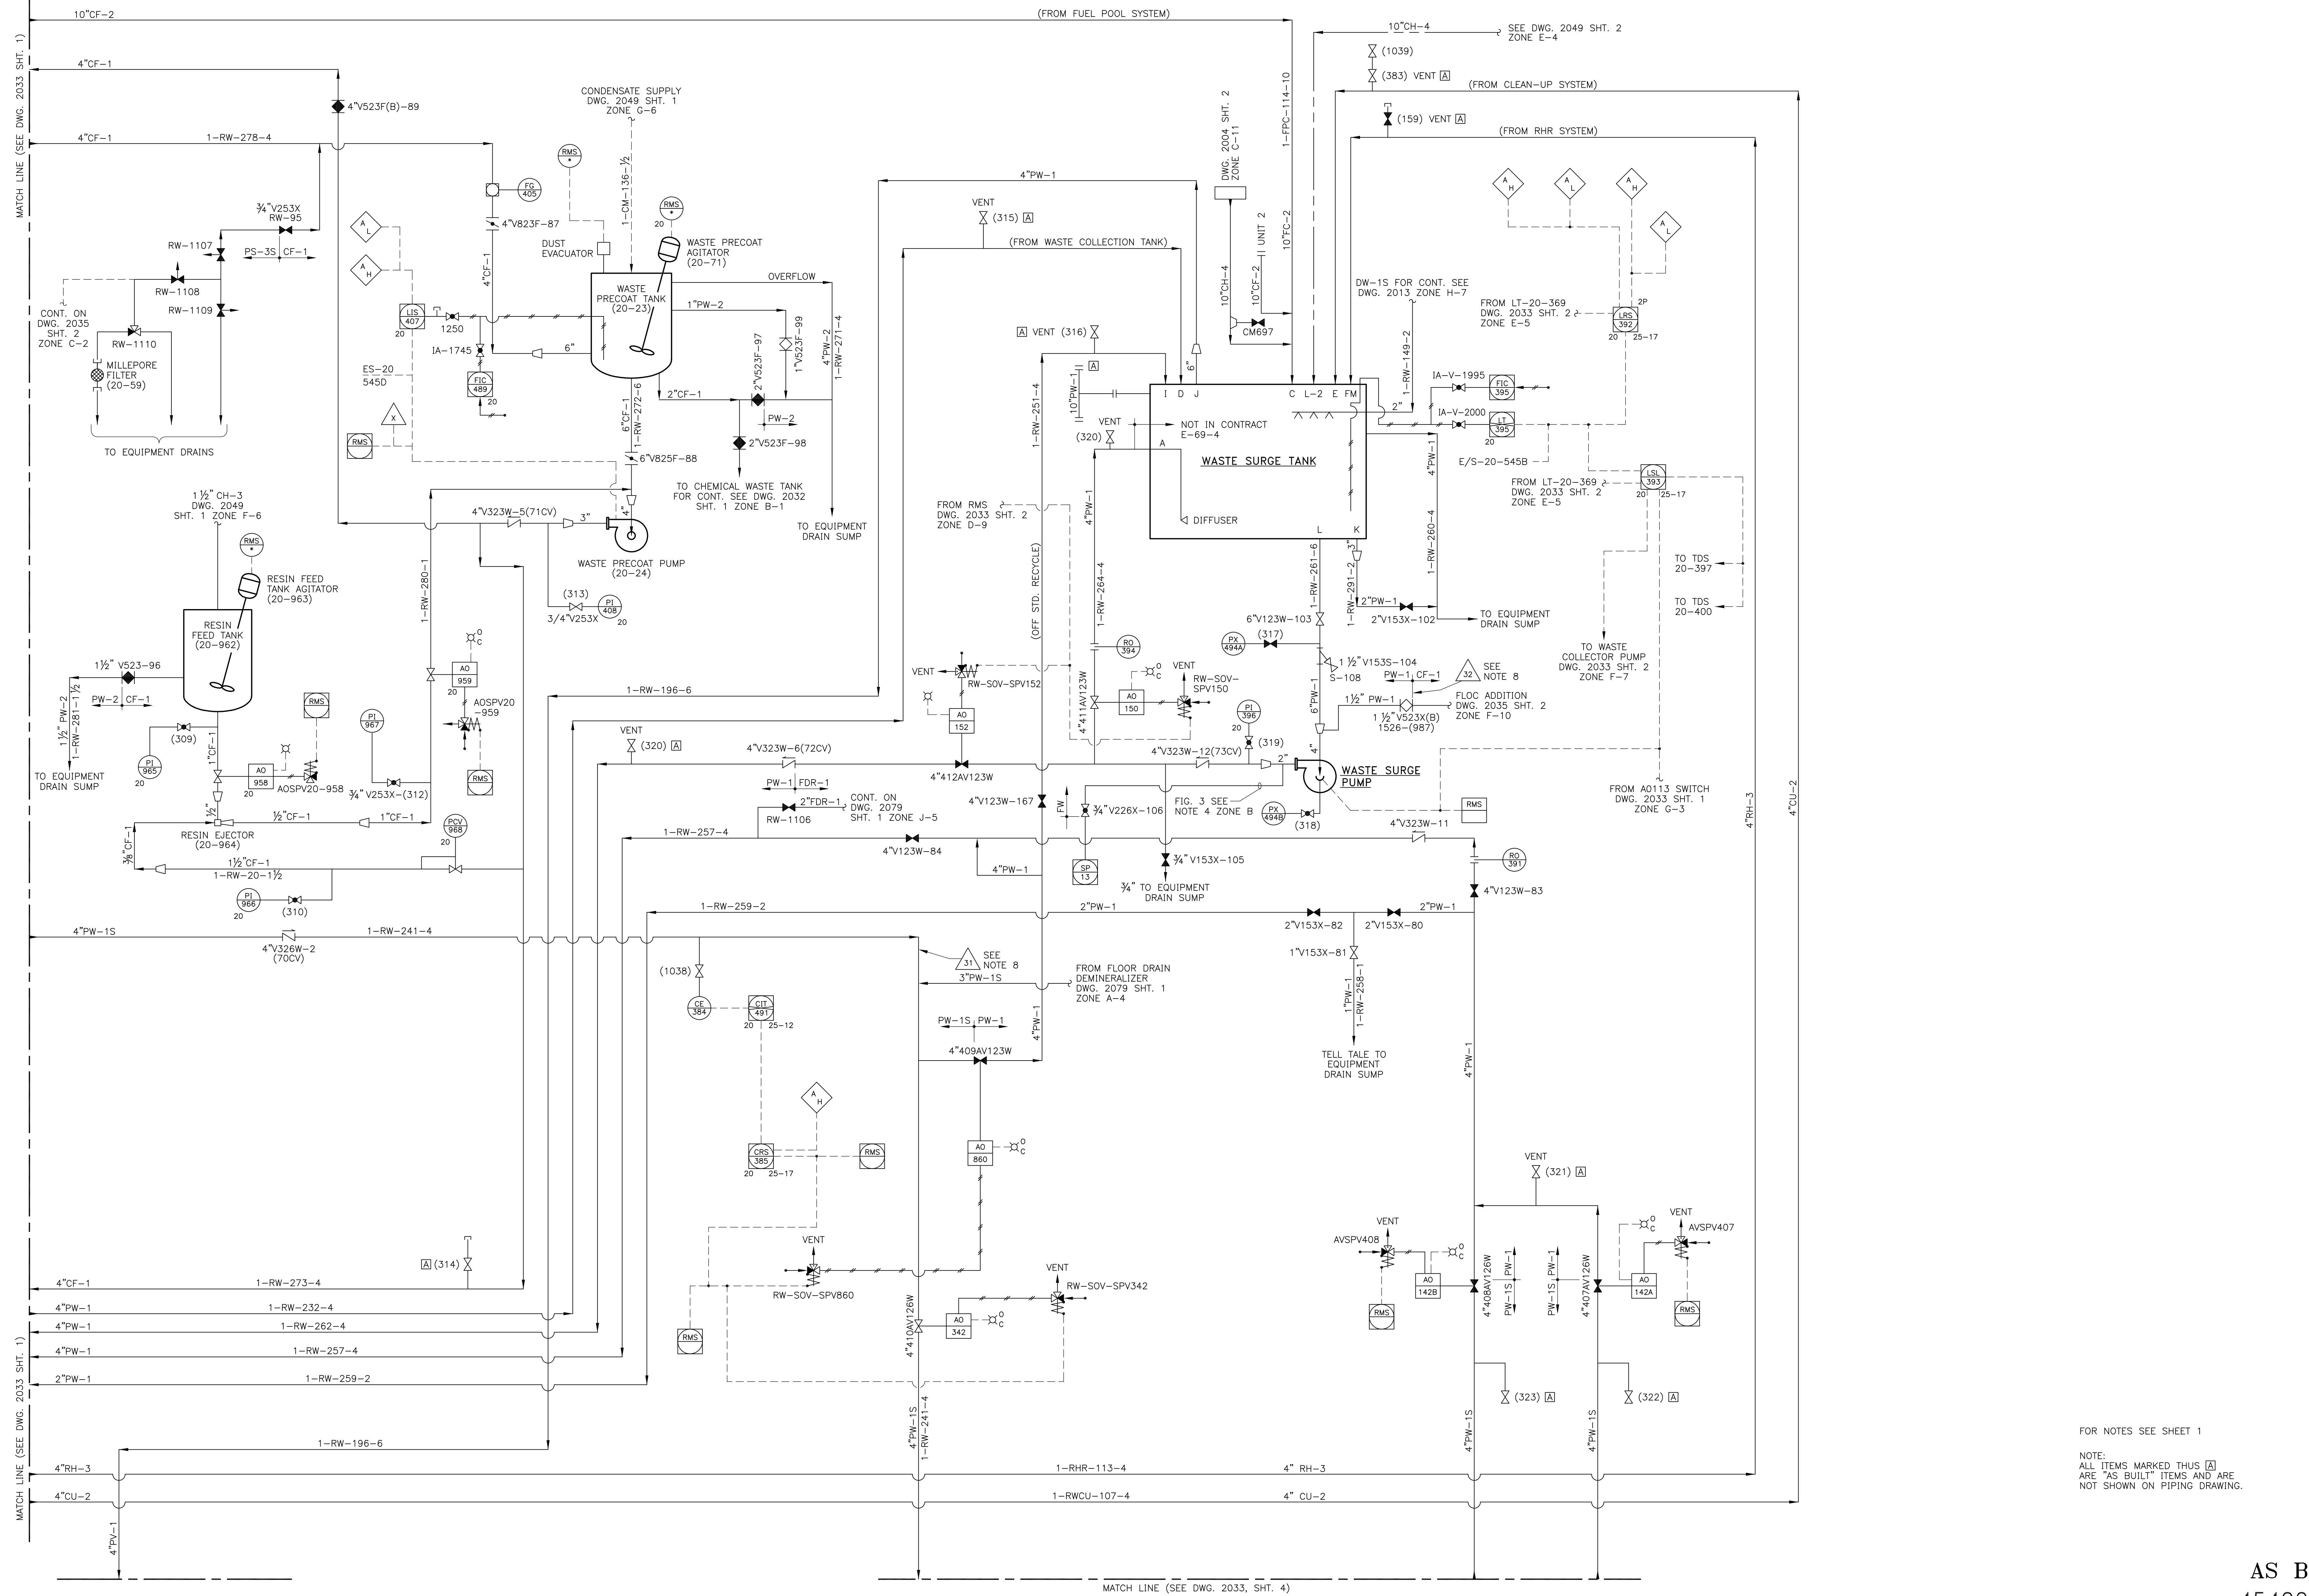

FOR NOTES SEE SHEET 1

NOTE:  
ALL ITEMS MARKED THUS [A] ARE "AS BUILT" ITEMS AND ARE NOT SHOWN ON PIPING DRAWING.

**AS BUILT**  
454003680

STATUS: Release  
STATUS DATE: 07/25/2017  
DS APPROVED: JLCHAMP  
VER: AB REV: 16 SIZE: E


REVISIONS TO THIS DRAWING  
REQUIRES A REVISION TO THE  
CORRESPONDING ISOKEY.

FOR PREVIOUS REVISIONS, SEE SUPERSEDED CARDS

NO.	DESCRIPTION	DATE	ENG.
001	ISSUED	08/17/95	JLCHAMP

SIGNIFICANT NUMBER	GROUP	1	2	3	4	5	6	DATE	DATE
								10/15/96	
DRAWN BY: RAC								DATE	
CHECKED BY:								DATE	
APPROVED BY:								DATE	
FILMED BY:								DATE	
PROJECT: 2033 SH 3								BURNS & ROE	
DRAWING: 2033 SH 3								DATE FILED: 001/1995	

**FLOW DIAGRAM**  
**LOW CONDUCTIVITY**  
**EQUIPMENT DRAINS PROCESSING**  
**COOPER NUCLEAR STATION**

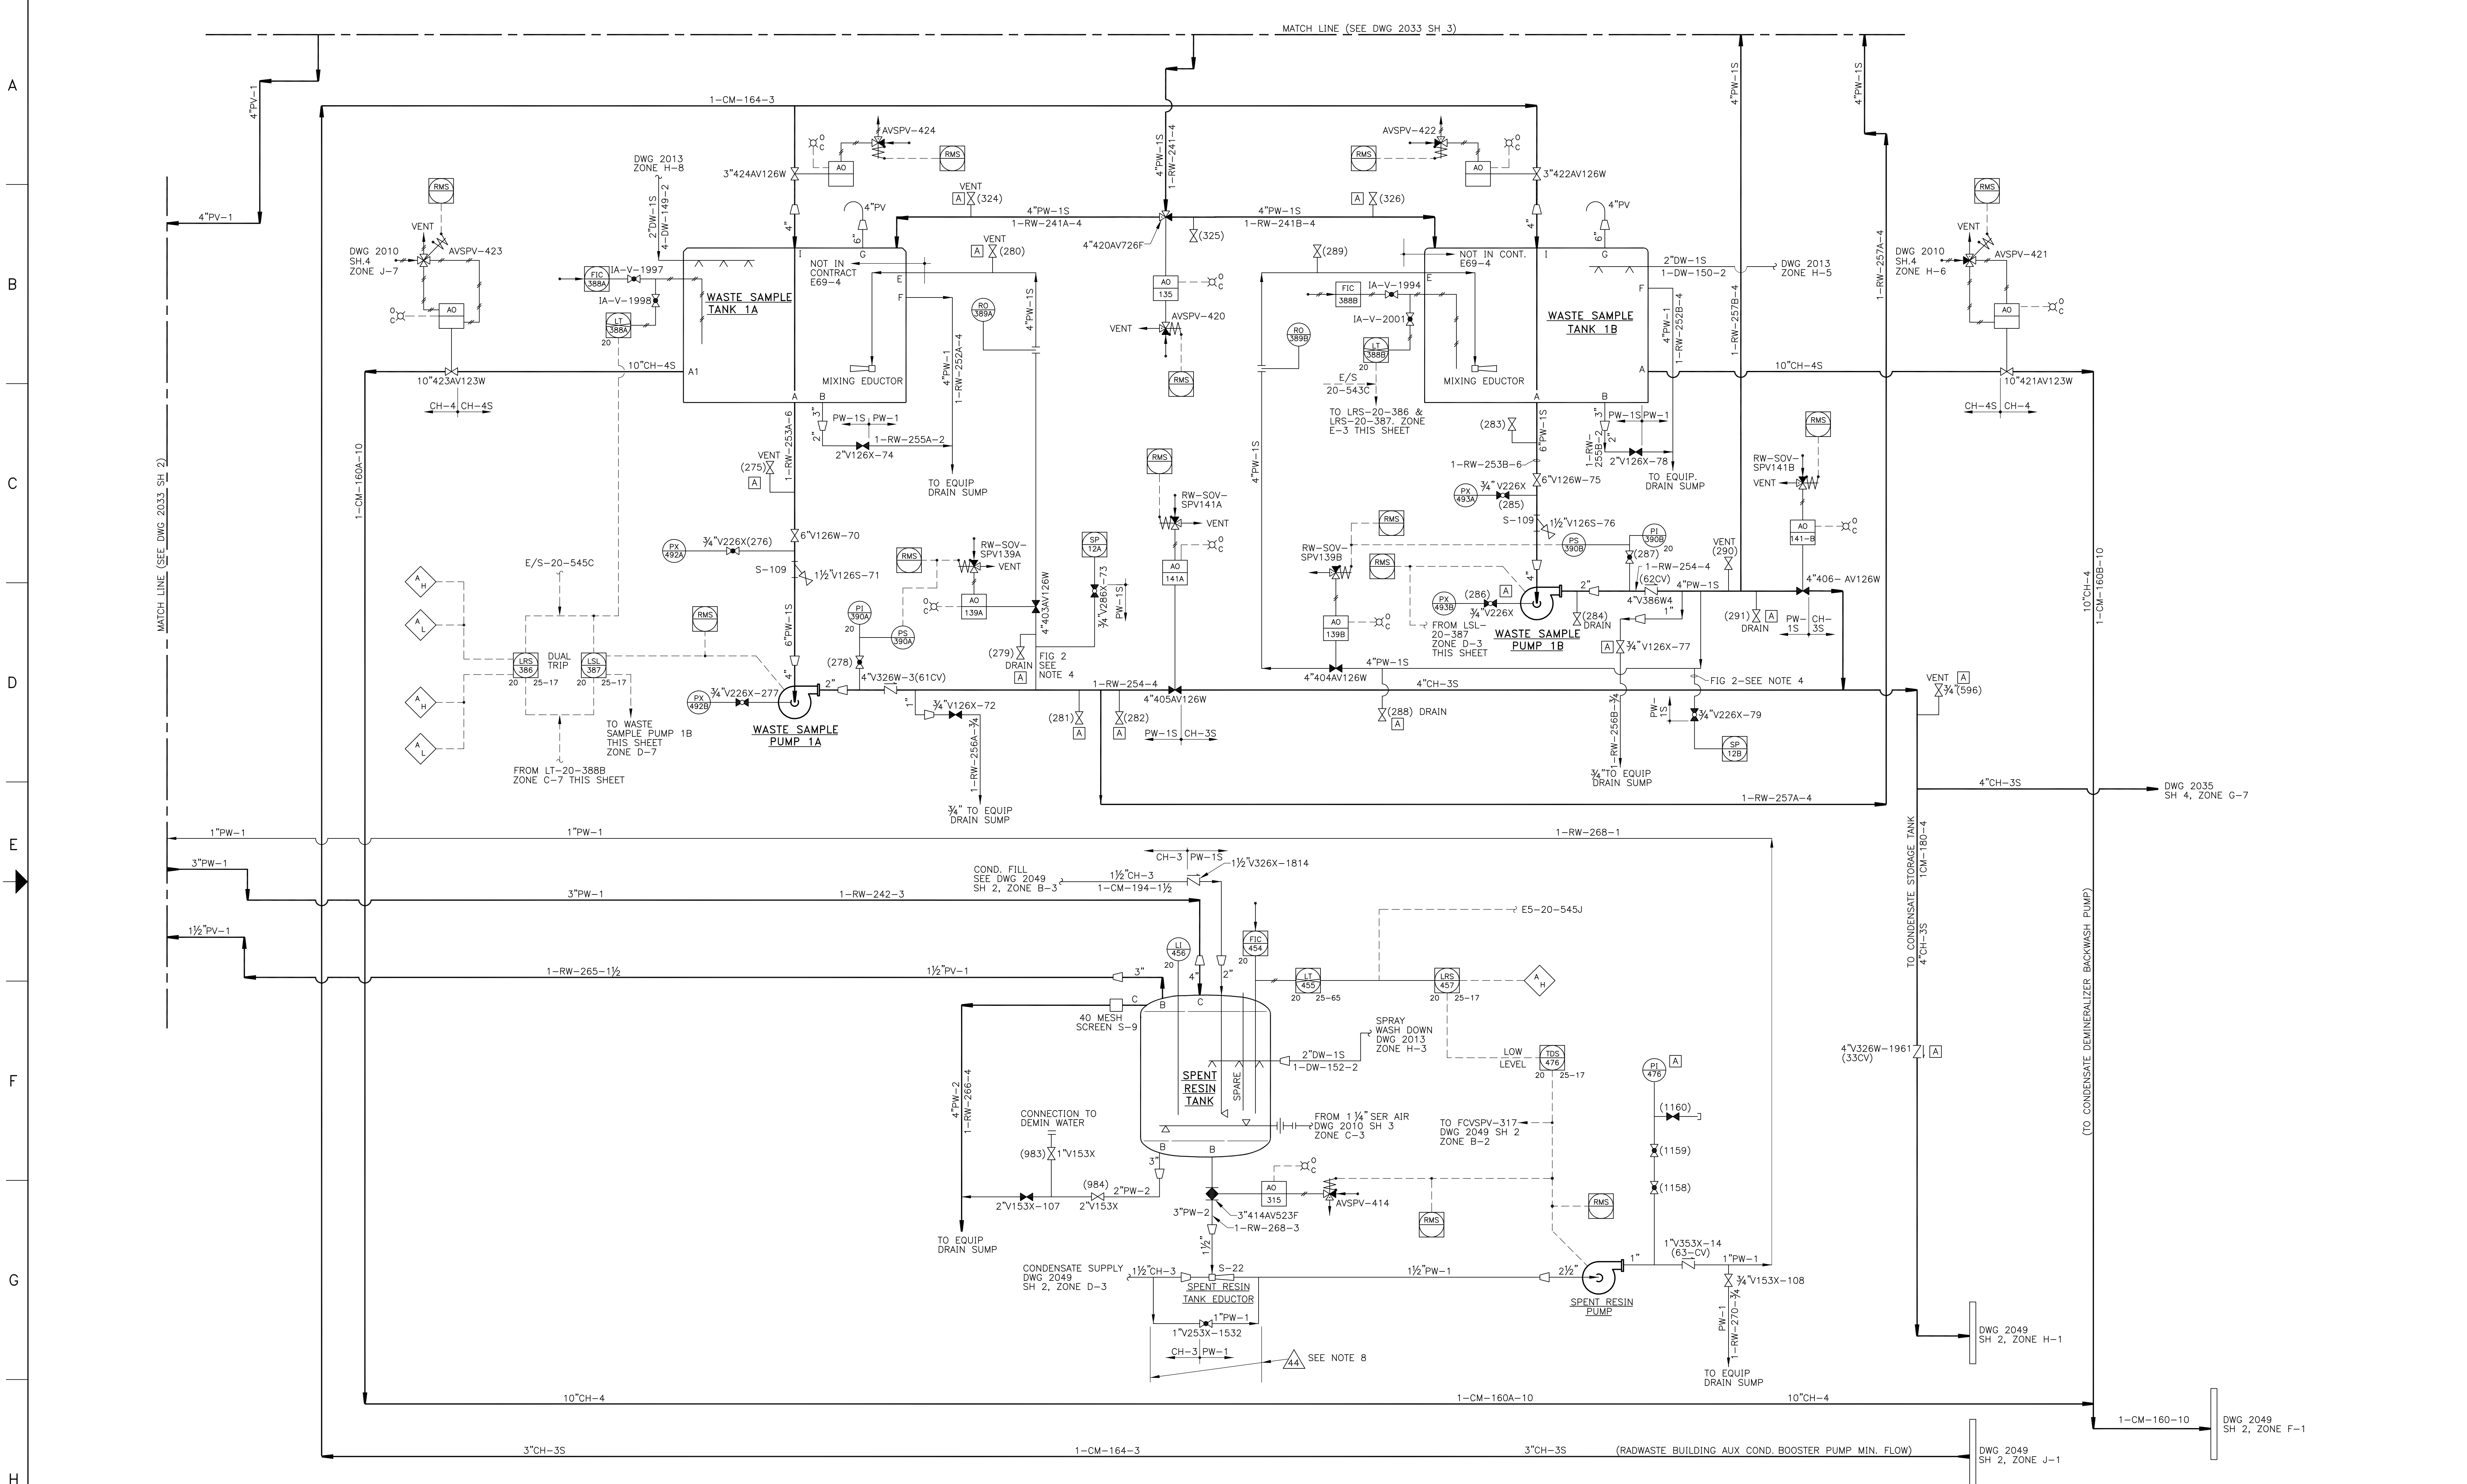

NOTE:  
ALL ITEMS MARKED THIS [A] ARE "AS BUILT" ITEMS  
AND ARE NOT SHOWN ON PIPING DRAWINGS.  
FOR NOTES SEE SHEET 1

REVISIONS TO THIS DRAWING  
REQUIRES A REVISION TO THE  
CORRESPONDING ISOKEY.

AS BUILT  
454003681  
CADD DRAWING  
DO NOT REVISE MANUALLY

FOR PREVIOUS REVISIONS, SEE SUPERSEDED CARDS.				SIGNIFICANT NUMBER		DRAWN		DATE	
NO.	REVISIONS	BY	DATE	GROUP	1	2	3	4	5
N13	REDRAWN, DCR 3-40217	RAC	HYF	KG	3/27/02				
N14	NO. 10244841 (DCN 03-0830)	KG	KG	DLR	7/1/03				
N15	CEB 6013680 (DCN 03-1765)	DLR	DLR	JDN	2/10/04				
N16	CEB 6013680 (DCN 03-1766)	DLR	DLR	JDN	2/10/04				
N17	CEB 6014781 (DCN 05-1459)	DJB	DJB	BLE	11/14/07				

REVISIONS BY N.P.P.D.		DATE	
NO.	REVISIONS	DFT	CHK
N13	REDRAWN, DCR 3-40217	RAC	HYF
N14	NO. 10244841 (DCN 03-0830)	KG	KG
N15	CEB 6013680 (DCN 03-1765)	DLR	DLR
N16	CEB 6013680 (DCN 03-1766)	DLR	DLR
N17	CEB 6014781 (DCN 05-1459)	DJB	DJB




  

APPROVED		DATE	
FILMED		DATE	
NO.		DATE	
NO.		DATE	

FLOW DIAGRAM LOW CONDUCTIVITY (EQUIPMENT DRAINS) PROCESSING COOPER NUCLEAR STATION		BURNS & ROE	
2033 SH 4 N17		REVISION	

NO.	REVISIONS

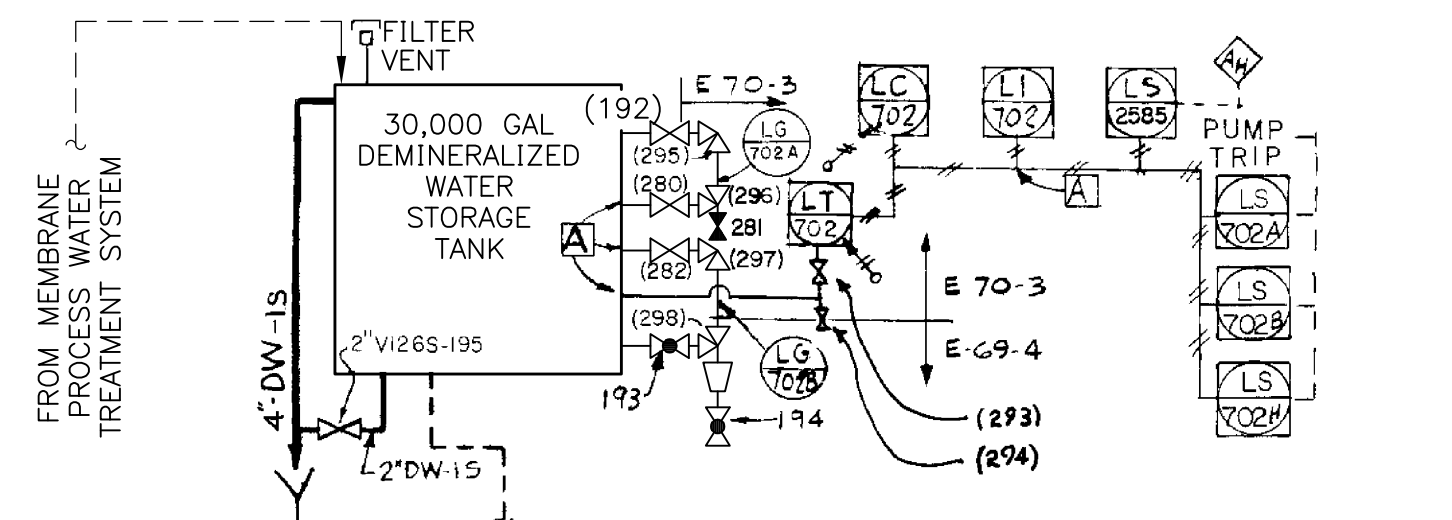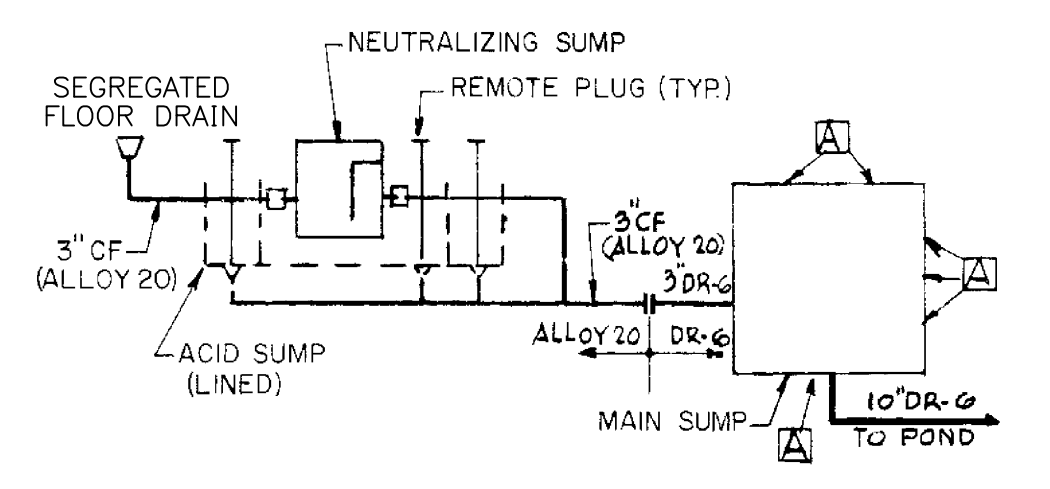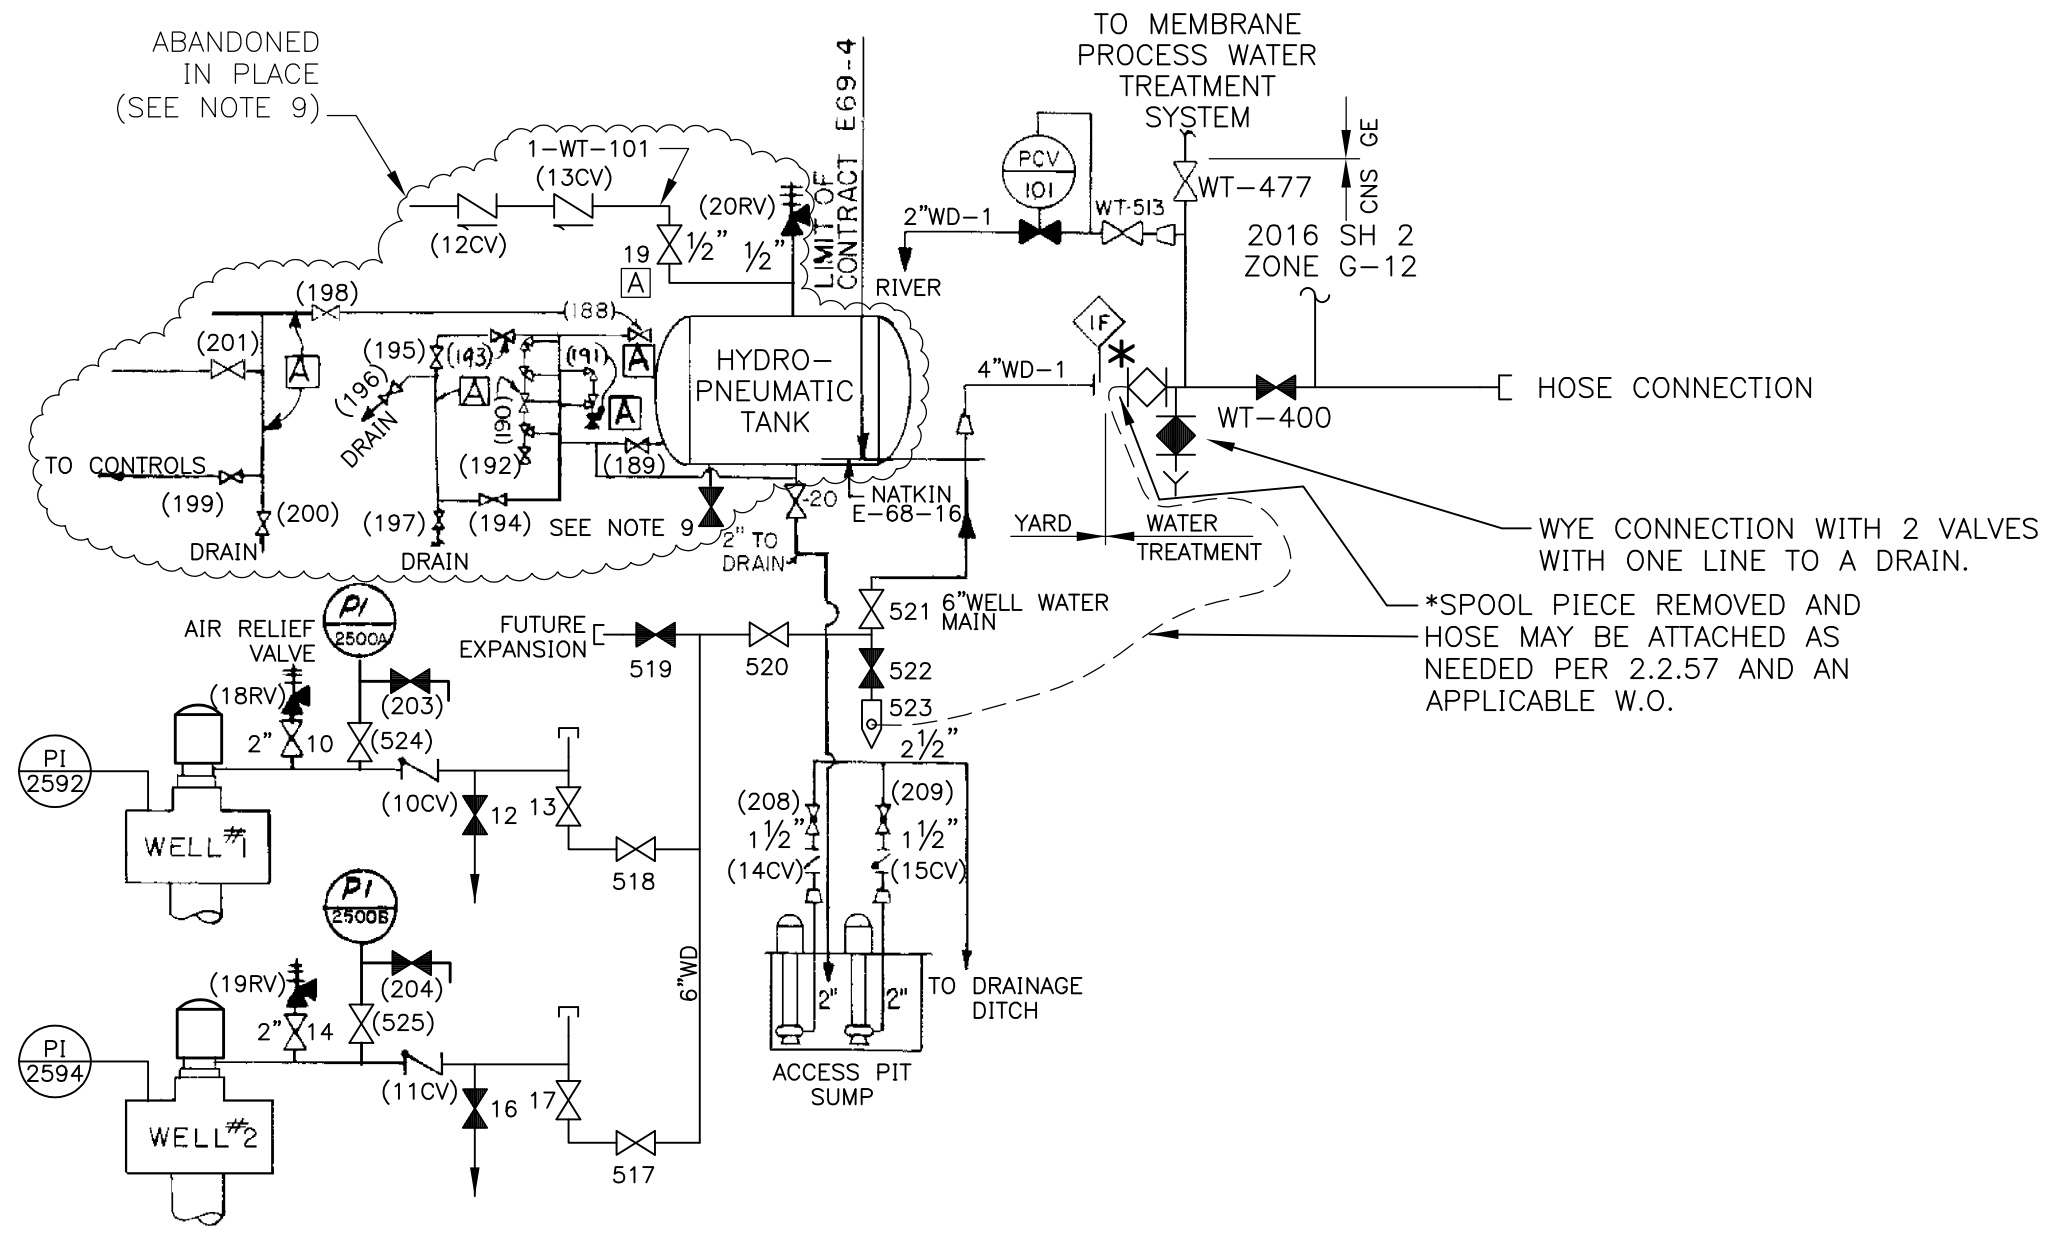

- NOTES:
- DELETED
  - HEAVY LINES INDICATE EQUIPMENT & PIPING FURNISHED AND INSTALLED UNDER CONTRACT E69-4.
  - LIGHT LINES INDICATE EQUIPMENT & PIPING FURNISHED BY OTHERS AND INSTALLED UNDER CONTRACT E69-4.
  - UNLESS OTHERWISE INDICATED ALL PRESSURE AND FLOW INSTRUMENT ROOT VALVES SHALL BE 3/4" LINES UP TO AND INCLUDING ROOT VALVES SHALL BE FURNISHED AND INSTALLED UNDER CONTRACT E69-4.
  - DELETED
  - DELETED
  - AT SAMPLING POINTS SP-32 & SP-52, CONNECTIONS, PROBES AND ROOT VALVES SHALL BE FURNISHED AND INSTALLED UNDER CONTRACT E69-4. PROBES SHALL BE FURNISHED AND INSTALLED IN ACCORDANCE WITH CONTRACT PARAGRAPH 3.4.2 AND DWG. SP-07211. FIGURE NUMBER AS NOTED. ALL OTHER SAMPLING POINTS ARE SUPPLIED BY DEGREMONT-COTTRELL AS INDICATED ON D.C. DWGS. CONTINUATION OF SAMPLE PIPING BY E70-3.
  - WHERE LINES INTERCONNECT AND ARE CONTINUED ON OTHER DRAWINGS, ZONE NUMBERS ARE APPROXIMATE ONLY.
  - HYDRA-PNEUMATIC PRESSURE MAINTENANCE SYSTEM NO LONGER USED AND ABANDONED IN PLACE.

NOTE: ALL ITEMS MARKED THUS [A] ARE "AS BUILT" ITEMS AND ARE NOT SHOWN ON PIPING DRAWINGS.

**AS BUILT**  
**454003627**  
 STATUS: Release  
 STATUS DATE: 01/03/2014  
 DS APPROVED: JECASS  
 VER: AC REV: 70 SIZE: F

REVISIONS TO THIS DRAWING  
 REQUIRES A REVISION TO THE  
 CORRESPONDING ISOKEY.


FOR PREVIOUS REVISIONS, SEE SUPERSEDED CARDS.  
 VERSIONS/REVISIONS BY N.P.P.D.

NO.	DESCRIPTION	DFT	DATE	ENG
AB/69/DR-2013-0591		RPE	10/9/13	ALABE
AC/70/DR-2013-0975		DUR	12/20/13	JECASS

SIGNIFICANT NUMBER	GROUP	DATE						DRAWN	DATE	CHECKED	DATE	APPROVED	DATE	FILMED
		1	2	3	4	5	6							
								HFY	06/28/02					
COOPER NUCLEAR STATION FLOW DIAGRAM PLANT MAKE UP WATER TREATMENT SYSTEM										BURNS & ROE				
										2034				

NO.	VERSIONS/REVISIONS
1	
2	
3	
4	
5	
6	
7	
8	
9	
10	
11	
12	


C0017934

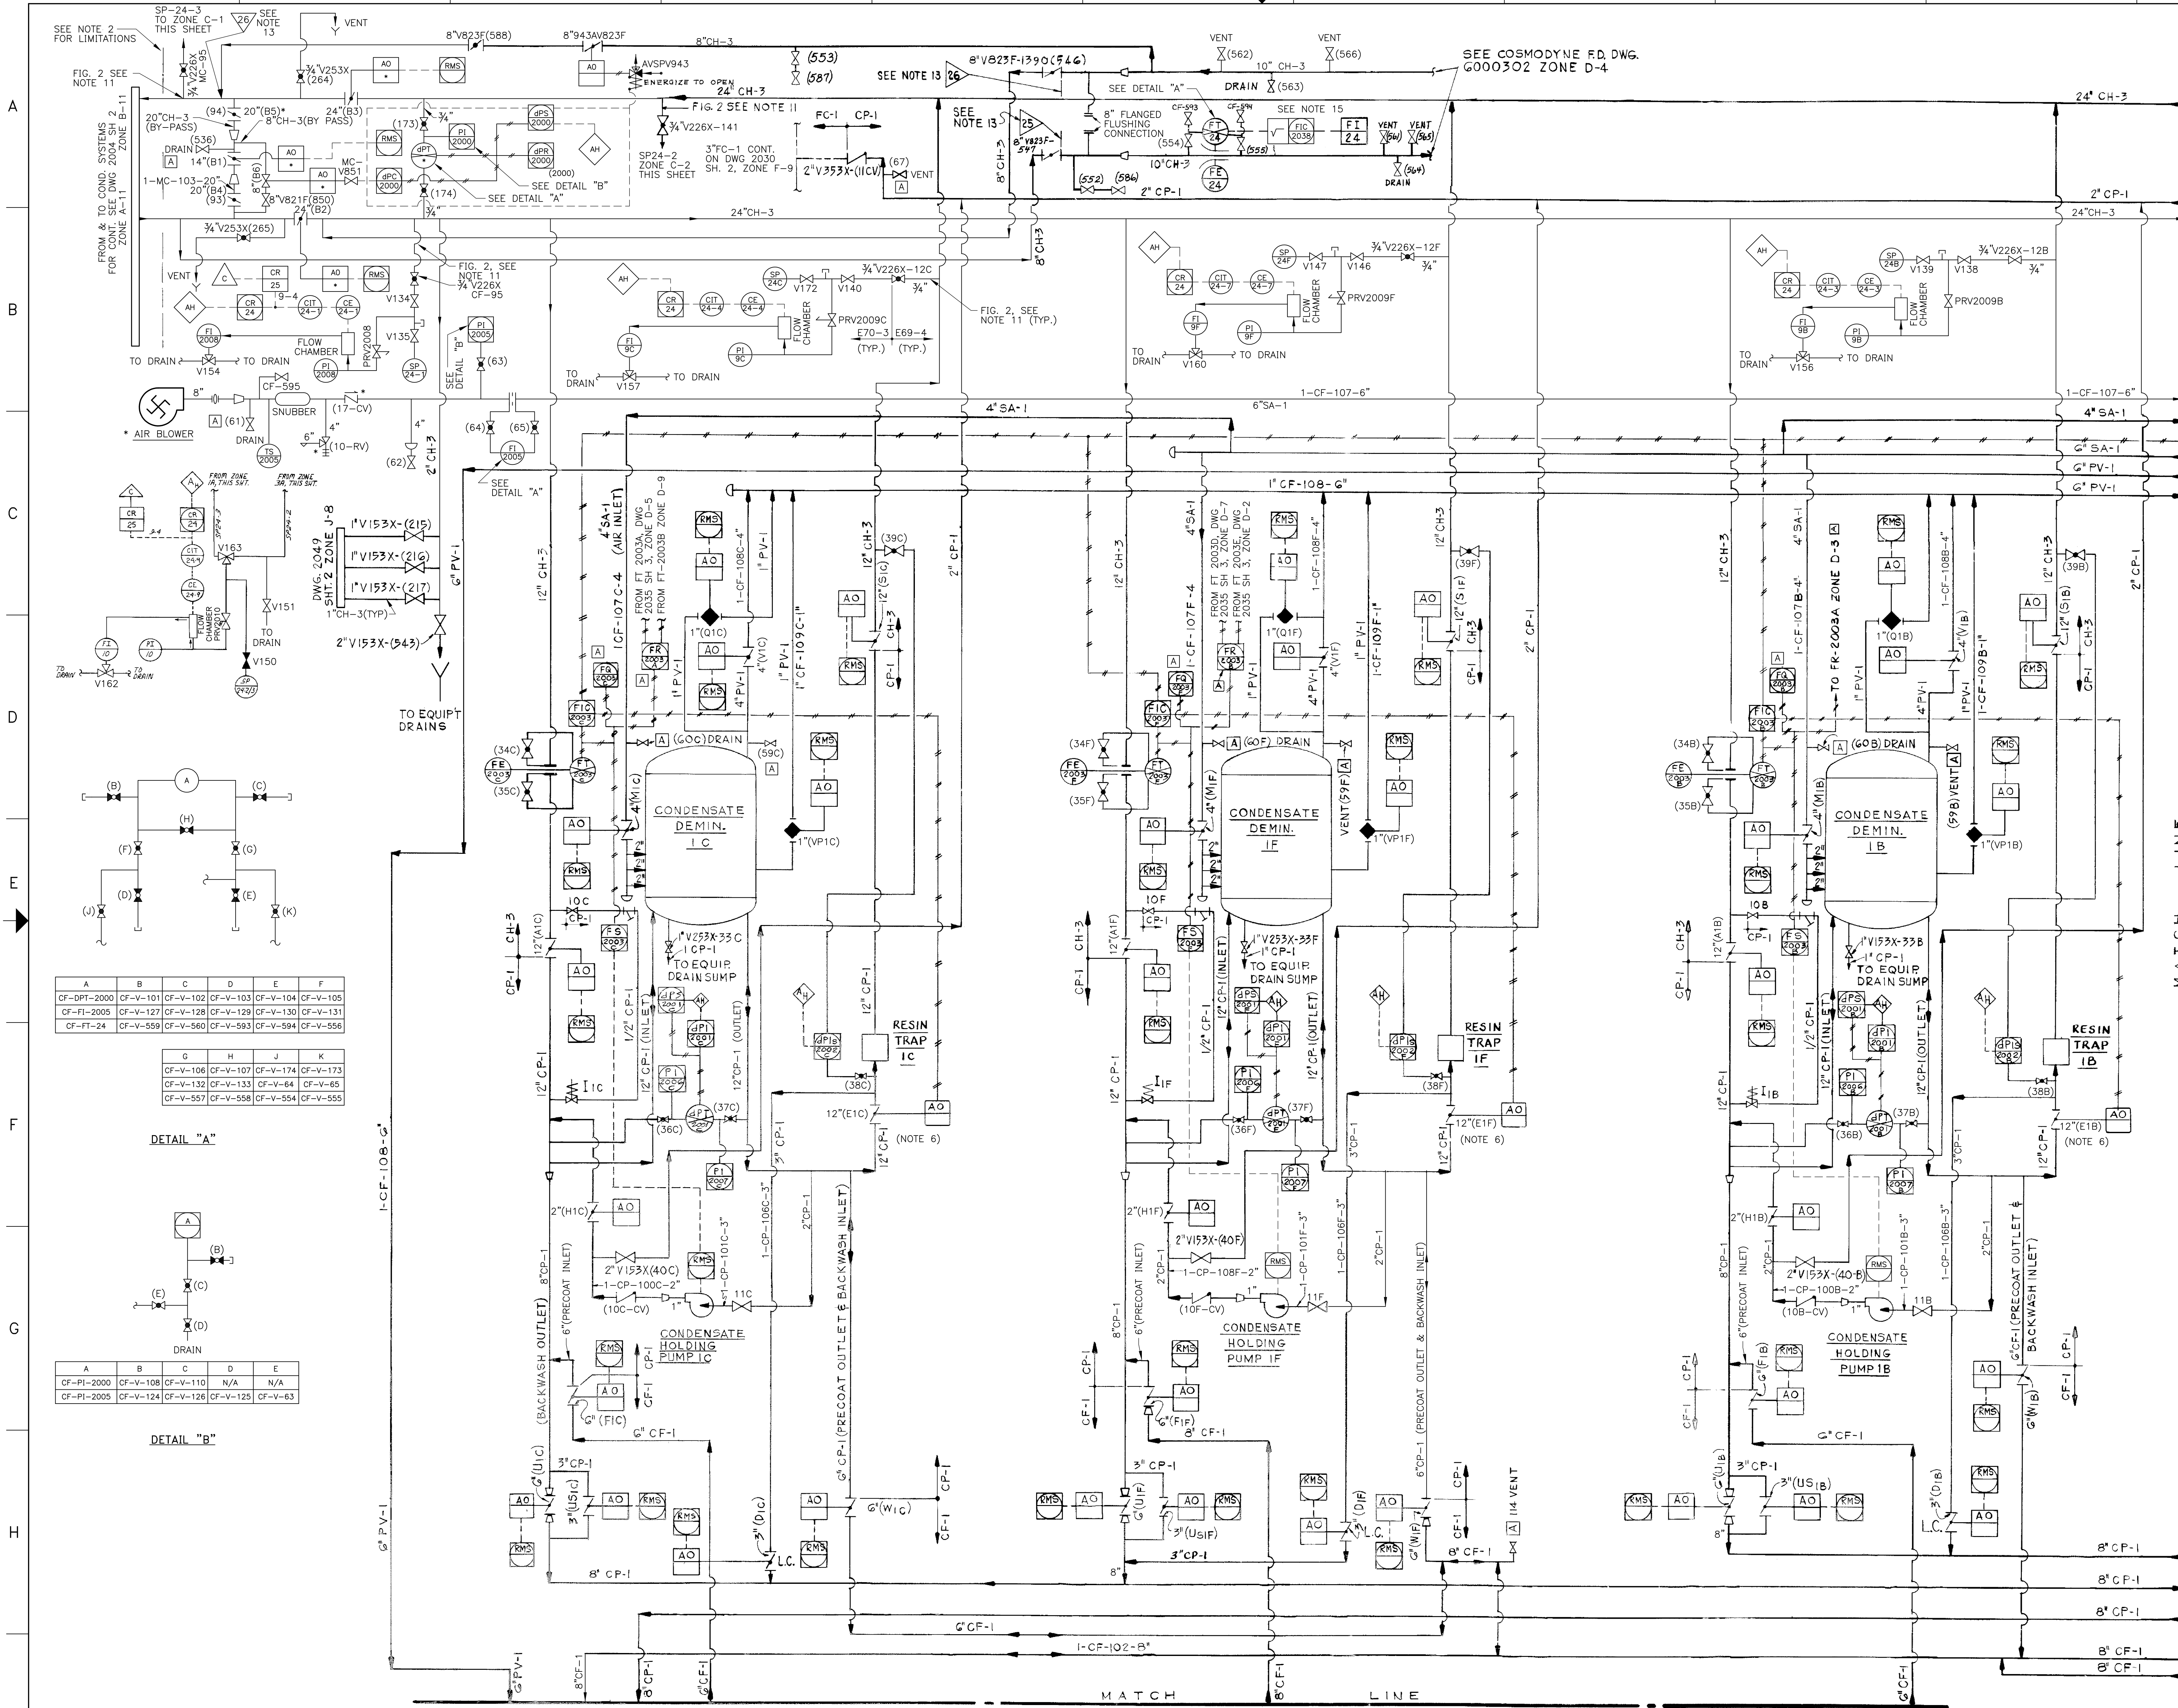


- NOTES:**
- ALL PIPING SHALL BE FURNISHED AND INSTALLED UNDER CONTRACT E-G9-4.
  - ALL VALVES AND SPECIALTIES UPSTREAM OF CONDENSATE BACKWASH TRANSFER TANK WILL BE FURNISHED UNDER CONTRACT E-G9-52, EXCEPT WHERE NOTED, AND INSTALLED UNDER CONTRACT E-G9-4.
  - ALL VALVES AND SPECIALTIES DOWNSTREAM OF CONDENSATE BACKWASH TRANSFER TANK SHALL BE FURNISHED AND INSTALLED UNDER CONTRACT E-G9-4.
  - VALVES AND EQUIPMENT MARKED WITH AN ASTERISK (\*) SHALL BE INSTALLED OUTSIDE THE DEMINERALIZER VALVE ROOM (UPSTREAM OF BACKWASH RECEIVING TANK)
  - UNLESS OTHERWISE INDICATED ALL PRESSURE AND/OR FLOW INSTRUMENT ROOT VALVES SHALL BE 3/4"; ROOT VALVES SHALL BE 3/4" V225X. LINE UP TO AND INCLUDING ROOT VALVE SHALL BE FURNISHED AND INSTALLED UNDER CONTRACT E-G9-4.
  - OPERATING AND CONTROL AIR ISOLATION VALVES SHOWN ON DWG. 2010, SH. 4.
  - SEE GRAVER DRAWING Y-4547B FOR INSTRUMENTATION HOOK UP
  - HIGH POINT VENTS AND LOW POINT DRAINS ARE NOT SHOWN AND SHALL BE FURNISHED AND INSTALLED UNDER CONTRACT E-G9-4.
  - SEE GRAVER BILL OF MATERIALS FOR ITEMS FURNISHED BY GRAVER. ALL VESSEL INTERNALS TO BE INSTALLED BY E-G9-4
  - ALL PIPING FROM SHIELDED TANK TO FIRST SHUT-OFF VALVE SHALL BE SUITABLY SUPPORTED TO WITHSTAND A CLASS I SEISMIC EARTHQUAKE.
  - AT SAMPLING POINTS, CONNECTIONS, PROBES AND ROOT VALVES SHALL BE FURNISHED AND INSTALLED UNDER CONTRACT E-G9-4. PROBES SHALL BE FURNISHED AND INSTALLED IN ACCORDANCE WITH CONTRACT PARA. 3.4.2 AND DWG. SP-07211 FIG. NUMBER AS NOTED. CONTINUATION OF SAMPLE PIPING BY E-70-3
  - ALL VALVE NUMBERS IN PARENTHESIS ( ) ARE NUMBERS TO BE USED IN OPERATING PROCEDURES. THESE NUMBERS ARE ASSIGNED BY NPPD AND WILL NOT BE SHOWN ON PIPING DRAWINGS
  - ANION FLOC EQUIPMENT WILL BE INSTALLED BUT NOT NORMALLY USED.
  - WHERE SHOWN WITH NUMBERS REPRESENT POINTS OF CONNECTION TO EXISTING SYSTEMS E-73-58 SPECIFICATION DEFINES WORK FROM THIS POINT.
  - WHERE LINES INTERCONNECT AND ARE CONTINUED ON OTHER DRAWINGS, ZONE NUMBERS ARE APPROXIMATE ONLY.
  - FIC-2038 CONTROL FUNCTION SHOWN ON DWG. 6000302 SH.1.

A	B	C	D	E	F
CF-DPT-2000	CF-V-101	CF-V-102	CF-V-103	CF-V-104	CF-V-105
CF-FI-2005	CF-V-127	CF-V-128	CF-V-129	CF-V-130	CF-V-131
CF-FT-24	CF-V-559	CF-V-560	CF-V-593	CF-V-594	CF-V-556

G	H	J	K
CF-V-106	CF-V-107	CF-V-174	CF-V-173
CF-V-132	CF-V-133	CF-V-64	CF-V-65
CF-V-557	CF-V-558	CF-V-554	CF-V-555

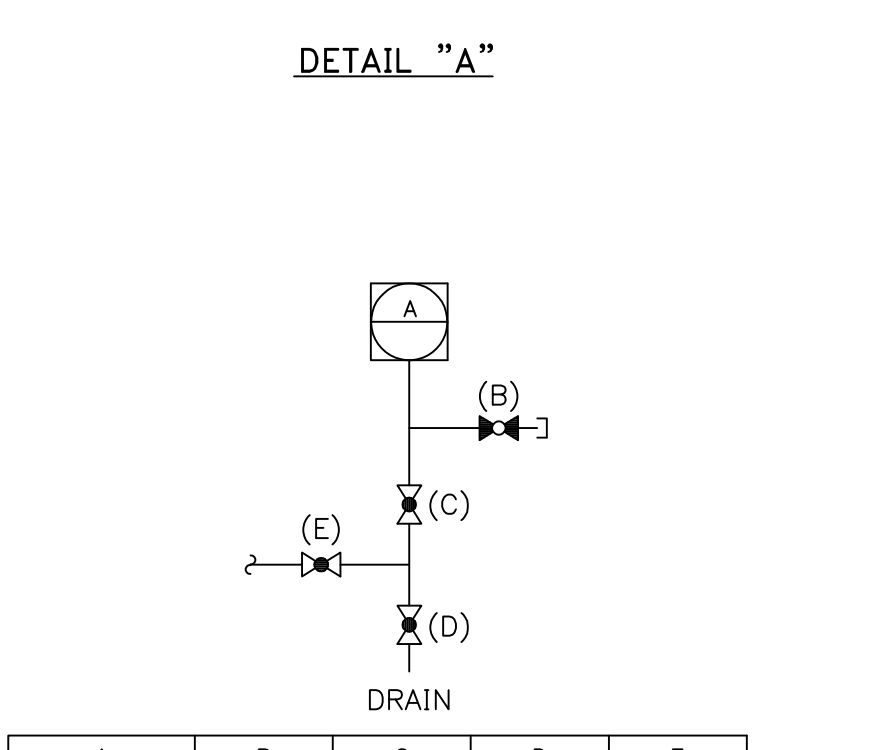

A	B	C	D	E
CF-PI-2000	CF-V-108	CF-V-110	N/A	N/A
CF-PI-2005	CF-V-124	CF-V-126	CF-V-125	CF-V-63

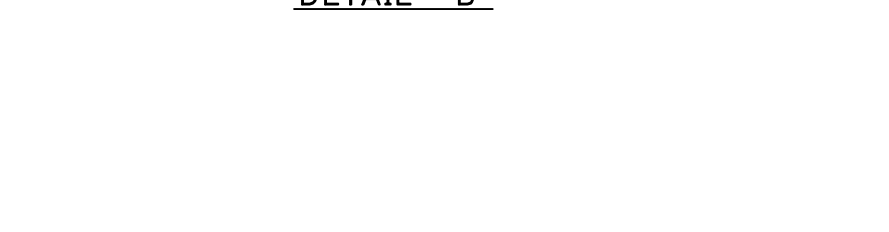

MATCH LINE SHT. 3  
SEE DWG. 2035 SH. 3

**AS BUILT**  
454003628  
SCAN/CADD DWG

SIGNIFICANT NUMBER		DATE	
1	2	3	4
GROUP		DATE	
1		6/14/02	
CHECKED		DATE	
1		6/14/02	
APPROVED		DATE	
1		6/14/02	
FILMED		DATE	
1		6/14/02	

FOR PREVIOUS REVISIONS, SEE SUPERSEDED CARDS.

REVISIONS BY N.P.P.D.

NO.	REVISIONS	DFT	CHK	APP	DATE
N16	CR 2010-09154 (DCN 10-2275)	KZ	KZ	DLR	12/27/09
R17	(DCN 13-1849)	DLB	DLB	DLR	08/07/13


**FLOW DIAGRAM**  
**CONDENSATE FILTER**  
**DEMINERALIZER SYSTEM**  
**COOPER NUCLEAR STATION**

2035 SH 1  
N17

REVISIONS TO THIS DRAWING  
REQUIRES A REVISION TO THE  
CORRESPONDING ISOKEY.

MATCH LINE  
SEE DWG. 2035 SH. 2



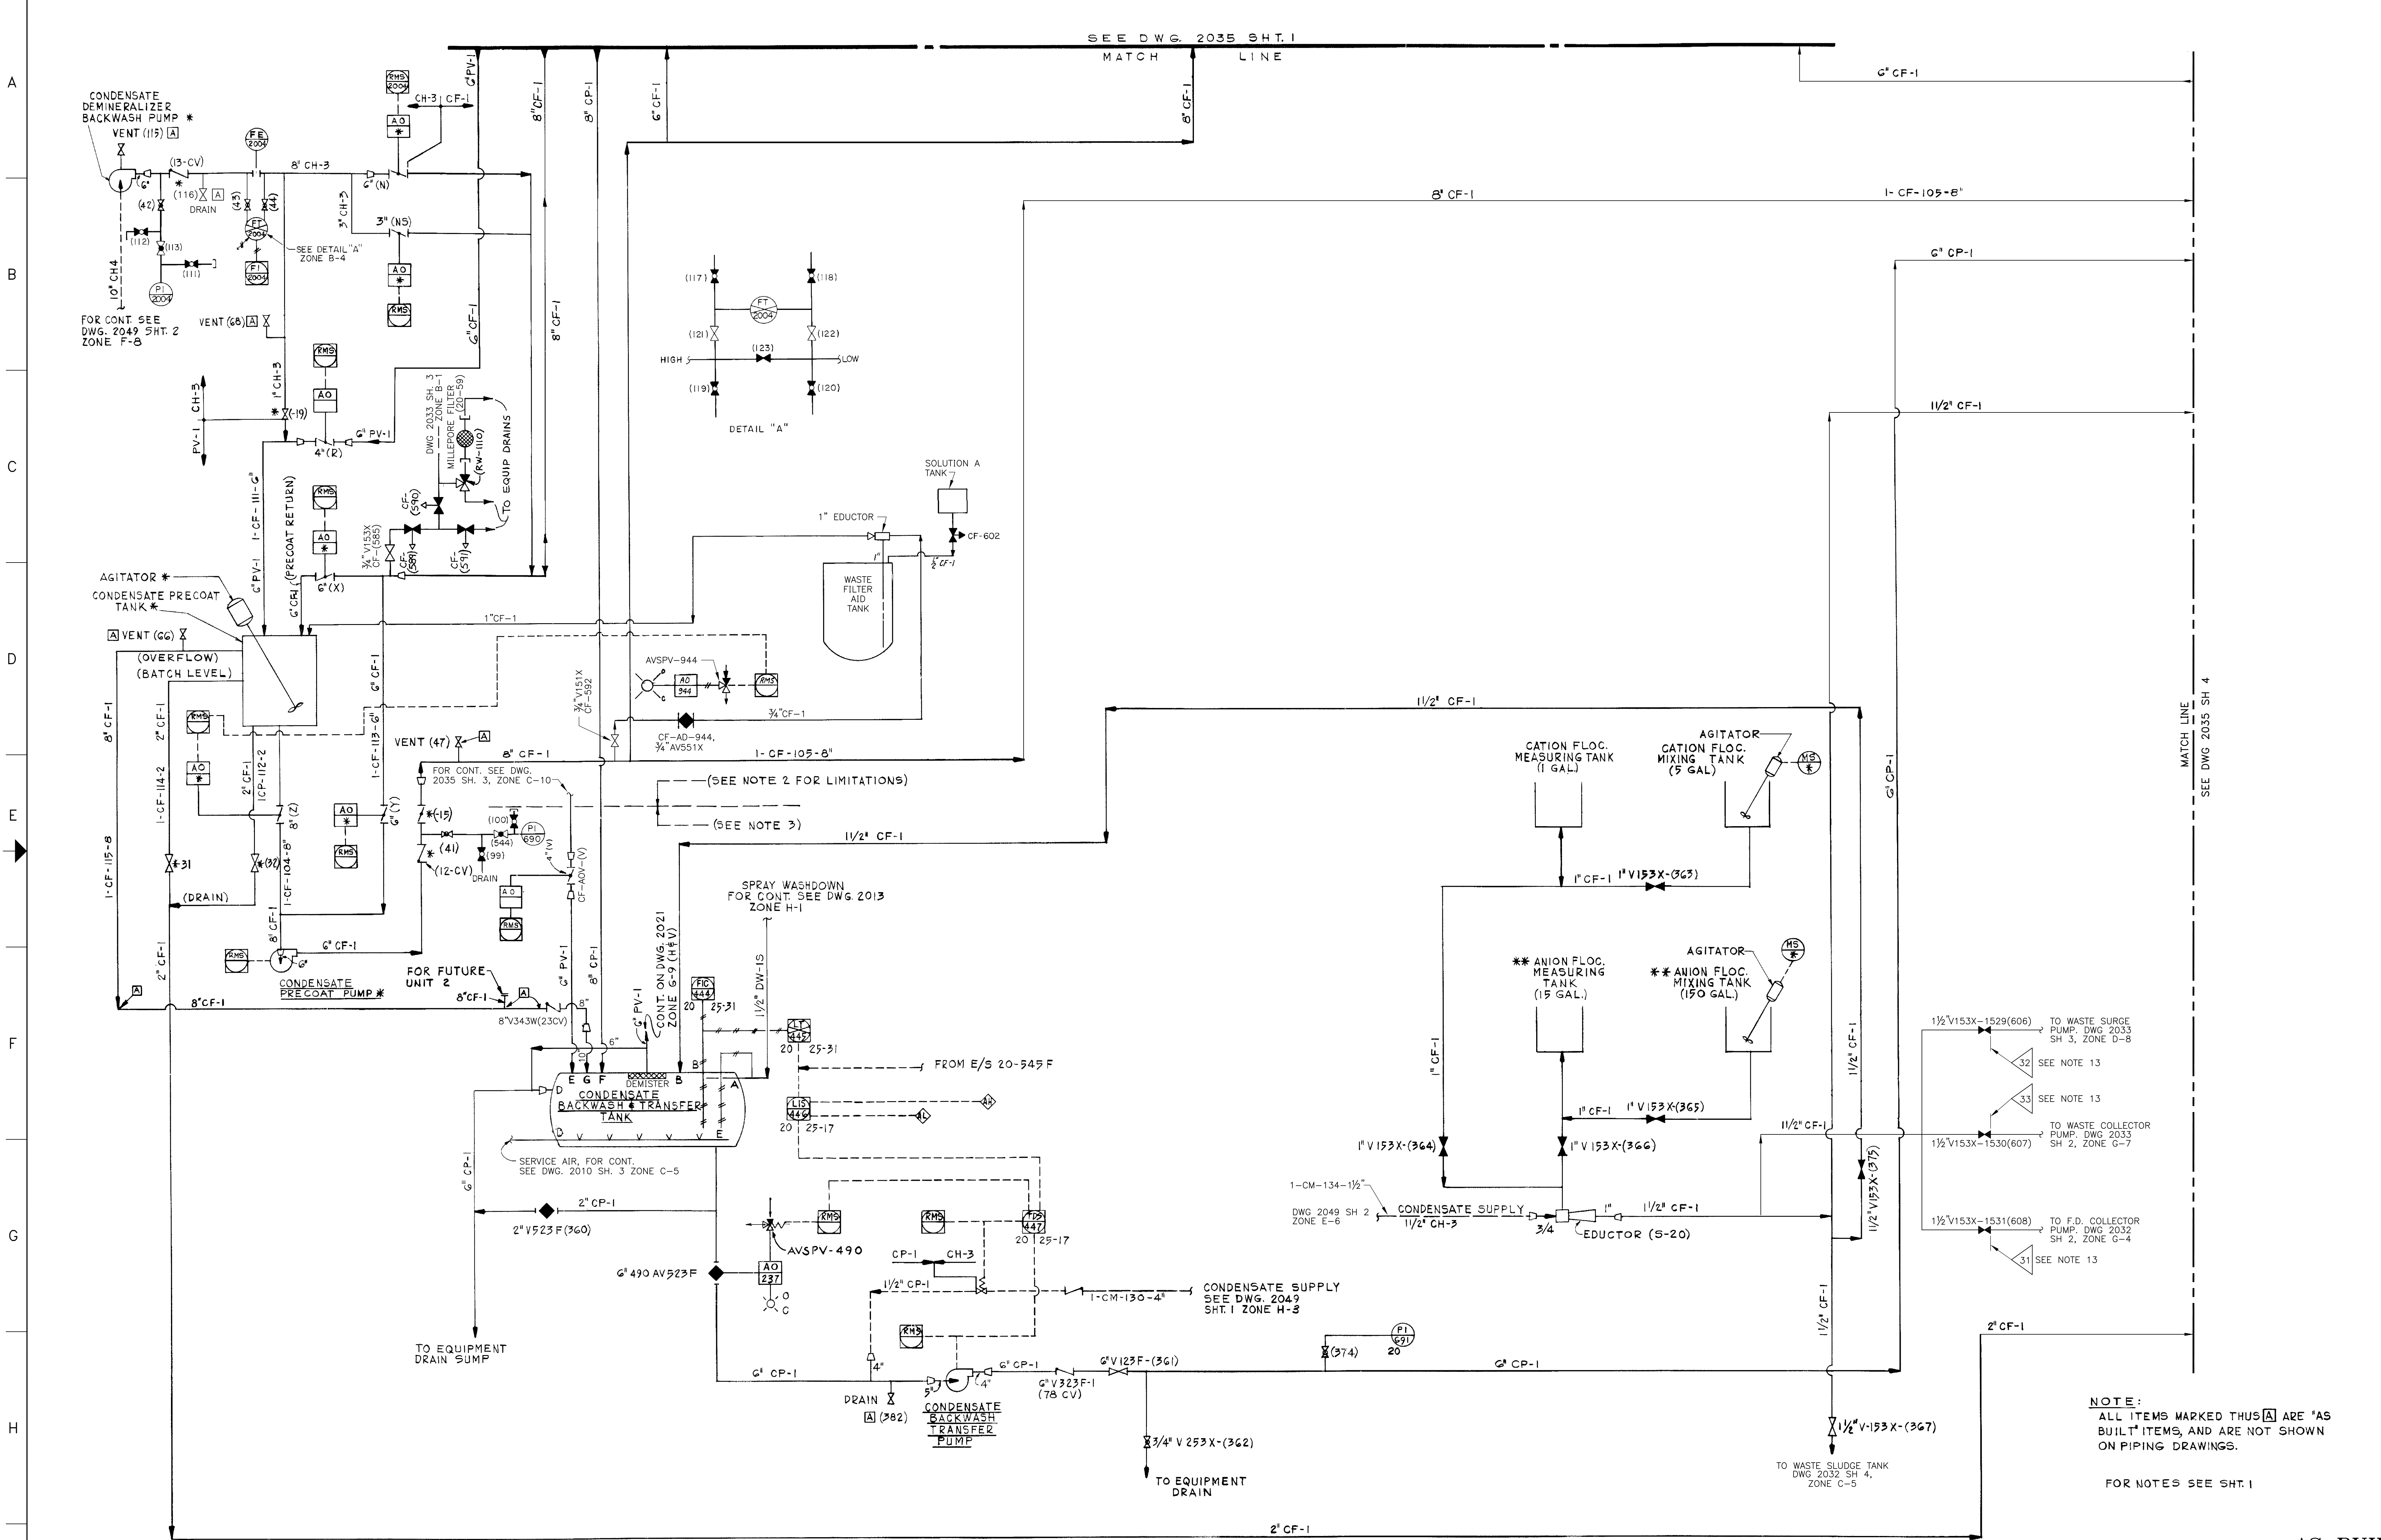

SEE DWG. 2035 SH. 1  
MATCH LINE

MATCH LINE  
SEE DWG 2035 SH 4

NOTE:  
ALL ITEMS MARKED THIS [ ] ARE 'AS BUILT' ITEMS, AND ARE NOT SHOWN ON PIPING DRAWINGS.  
FOR NOTES SEE SH. 1

AS BUILT  
454003669  
SCAN/CADD DWG

REVISIONS TO THIS DRAWING  
REQUIRES A REVISION TO THE  
CORRESPONDING ISOKEY.

FOR PREVIOUS REVISIONS, SEE SUPERSEDED CARDS.

NO.	REVISIONS	BY	DATE
N13	DCR 3-40217 (DCN 02-0857)	HFY	6/14/02


SIGNIFICANT NUMBER	GROUP						DRAWN	DATE
	1	2	3	4	5	6		
							HFY	06/14/02
							CHECKED	DATE
							APPROVED	DATE
							FILED	DATE

COOPER NUCLEAR STATION  
FLOW DIAGRAM  
CONDENSATE FILTER  
DEMINERALIZER SYSTEM

BURNS & ROE

2035 SH 2  
N13

NO.	REVISIONS

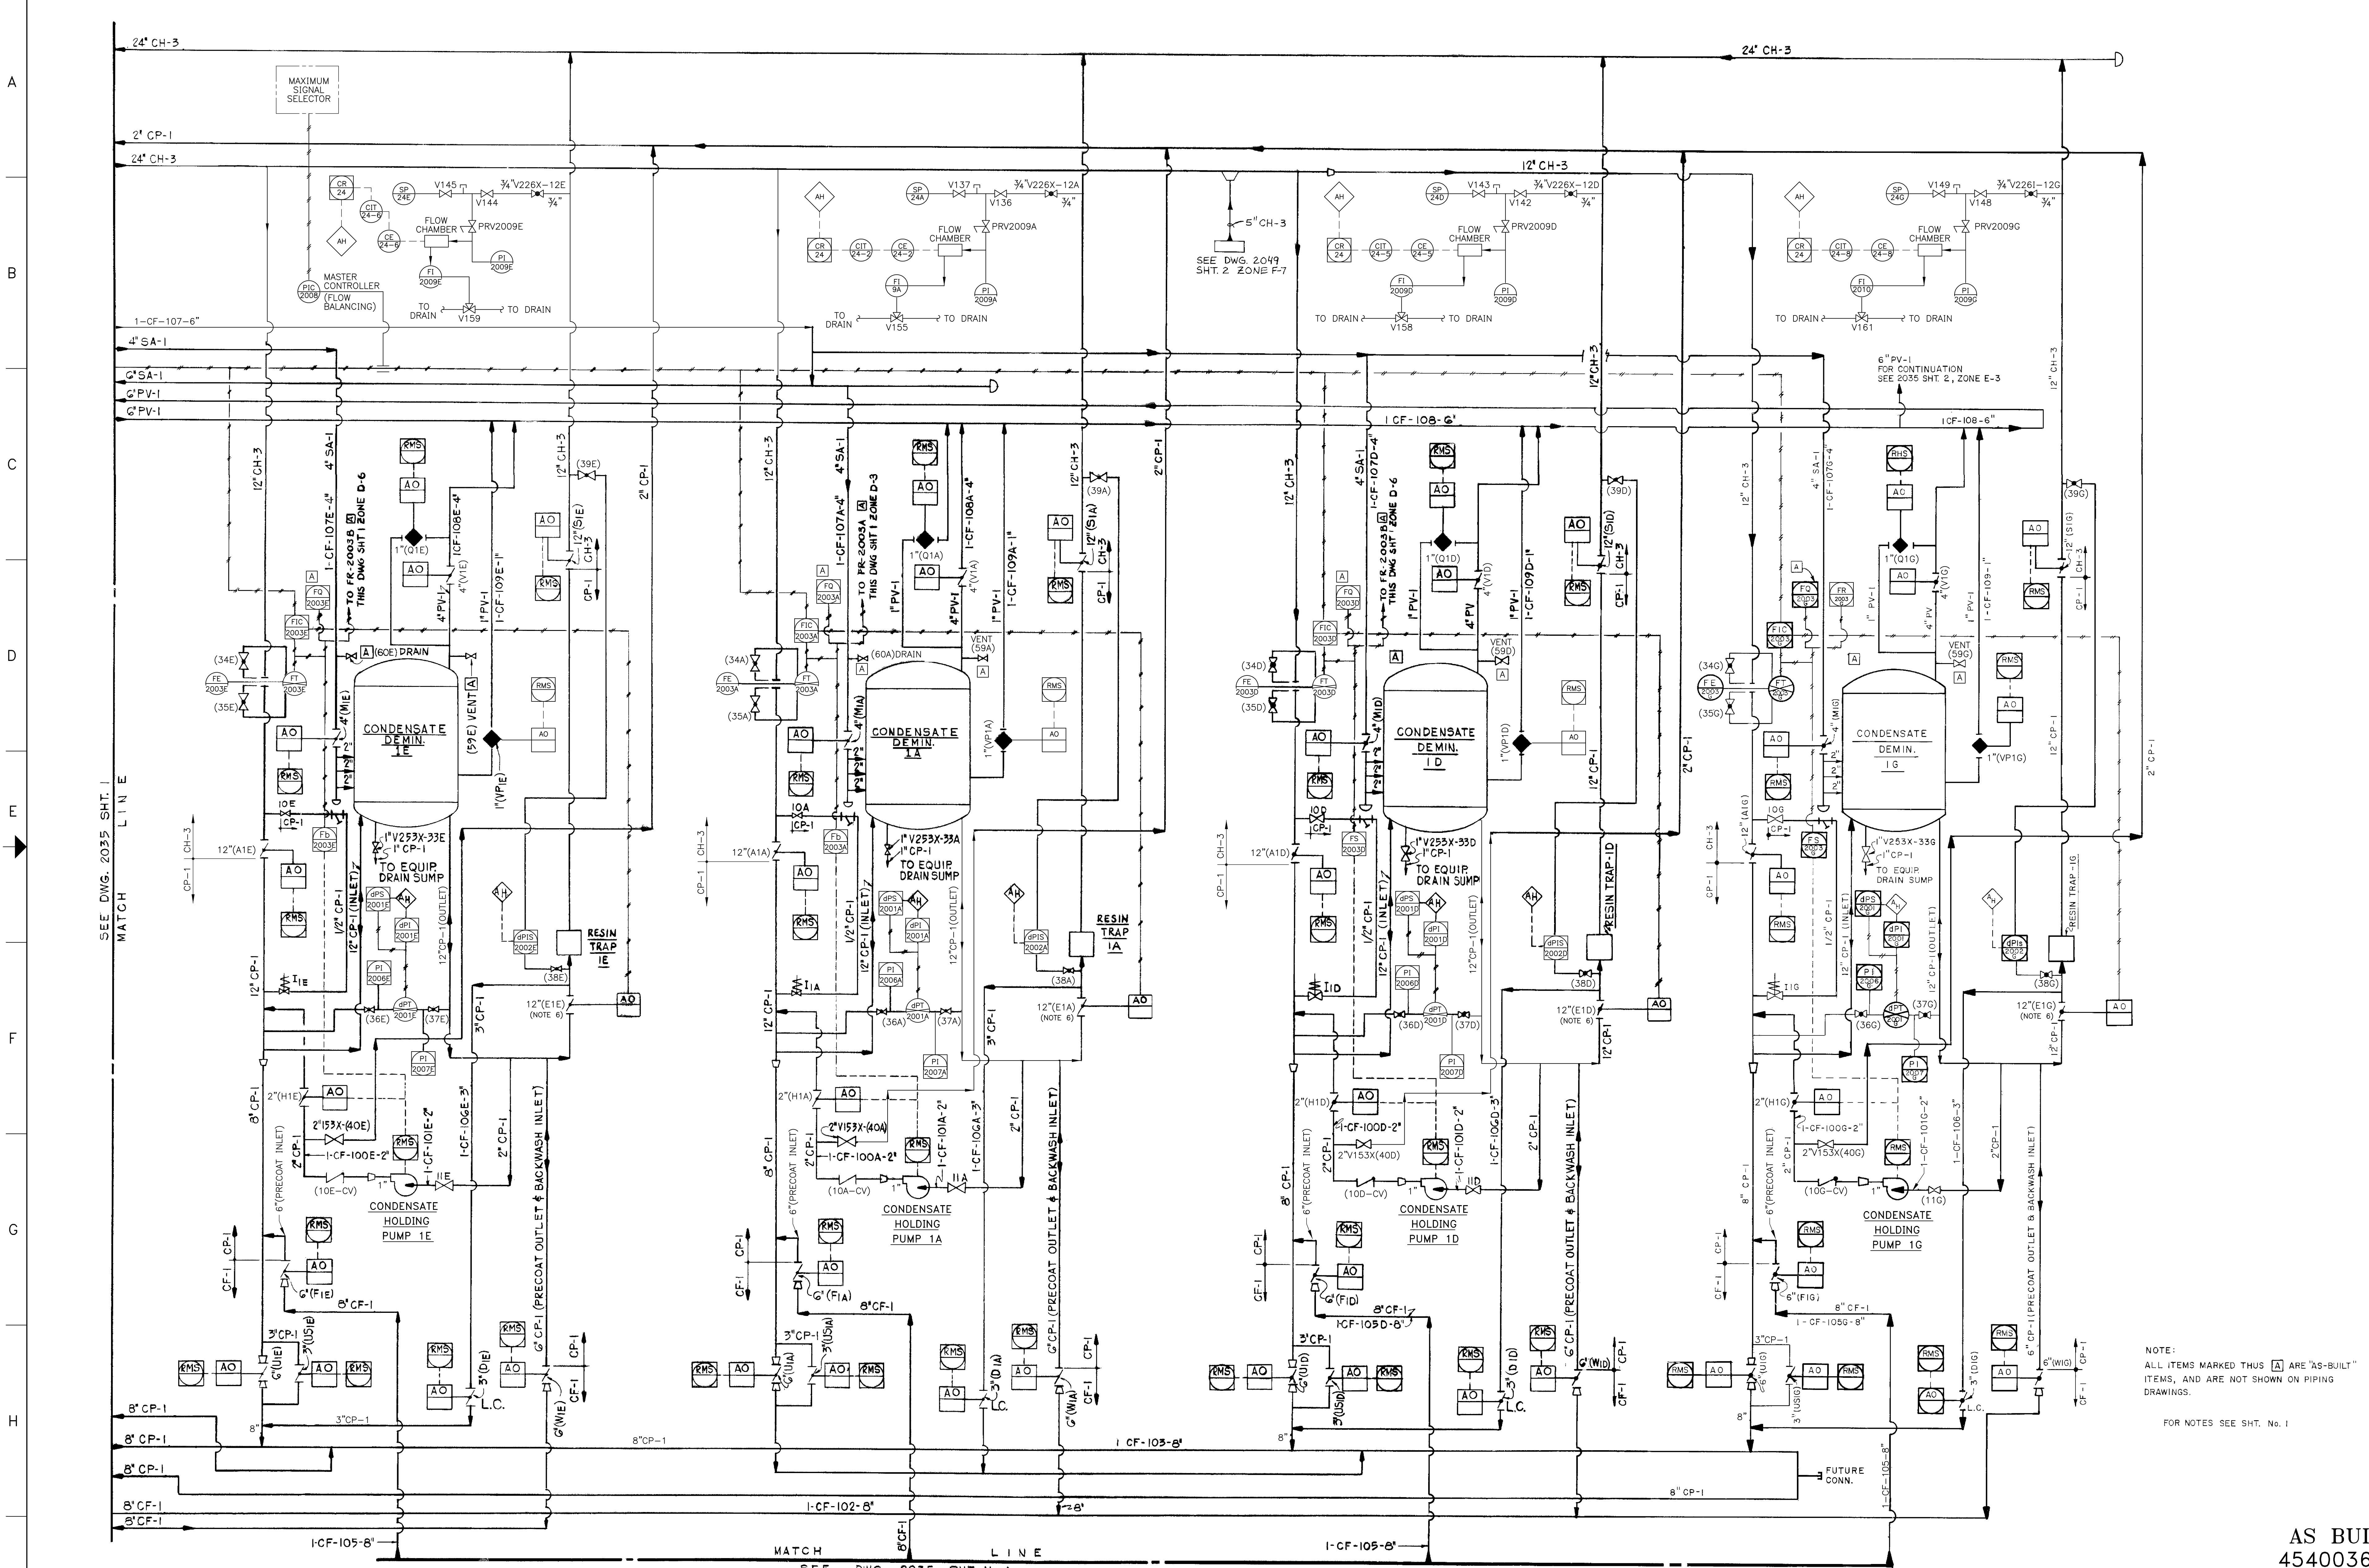

SEE DWG. 2035 SHT. 1  
MATCH LINE

MATCH LINE  
SEE DWG. 2035 SHT. No. 4

NOTE:  
ALL ITEMS MARKED THUS [A] ARE "AS-BUILT"  
ITEMS, AND ARE NOT SHOWN ON PIPING  
DRAWINGS.  
FOR NOTES SEE SHT. No. 1

REVISIONS TO THIS DRAWING  
REQUIRES A REVISION TO THE  
CORRESPONDING ISOKEY.

FOR PREVIOUS REVISIONS, SEE SUPERSEDED CARDS.

REVISIONS BY N.P.P.D.			
NO.	REVISIONS	DFT	CHK APP
N10	DCR 3-40217 (DCN 02-8859)	HFY	REGA
N11	CR-2001-10453 (DCN 08-1700)	DJB	DLE
N12	DCR-008A CR2010-02893	DJB	DLE
N13	CR 2010-09154 (DCN 10-2276)	DJB	DLE

SIGNIFICANT NUMBER		DRAWN		DATE	
1	2	HYF	6/14/02	DATE	
3	4	CHECKED		DATE	
5	6	APPROVED		DATE	
7	8	FILED		DATE	

COOPER NUCLEAR STATION  
FLOW DIAGRAM  
CONDENSATE FILTER  
DEMINERALIZER SYSTEM


BURNS & ROE

2035 SH 3  
N13

DO NOT REVISE MANUALLY

AS BUILT  
454003670  
SCAN/CADD DWG

SEE DWG. 2035 SHT. No. 3  
MATCH LINE

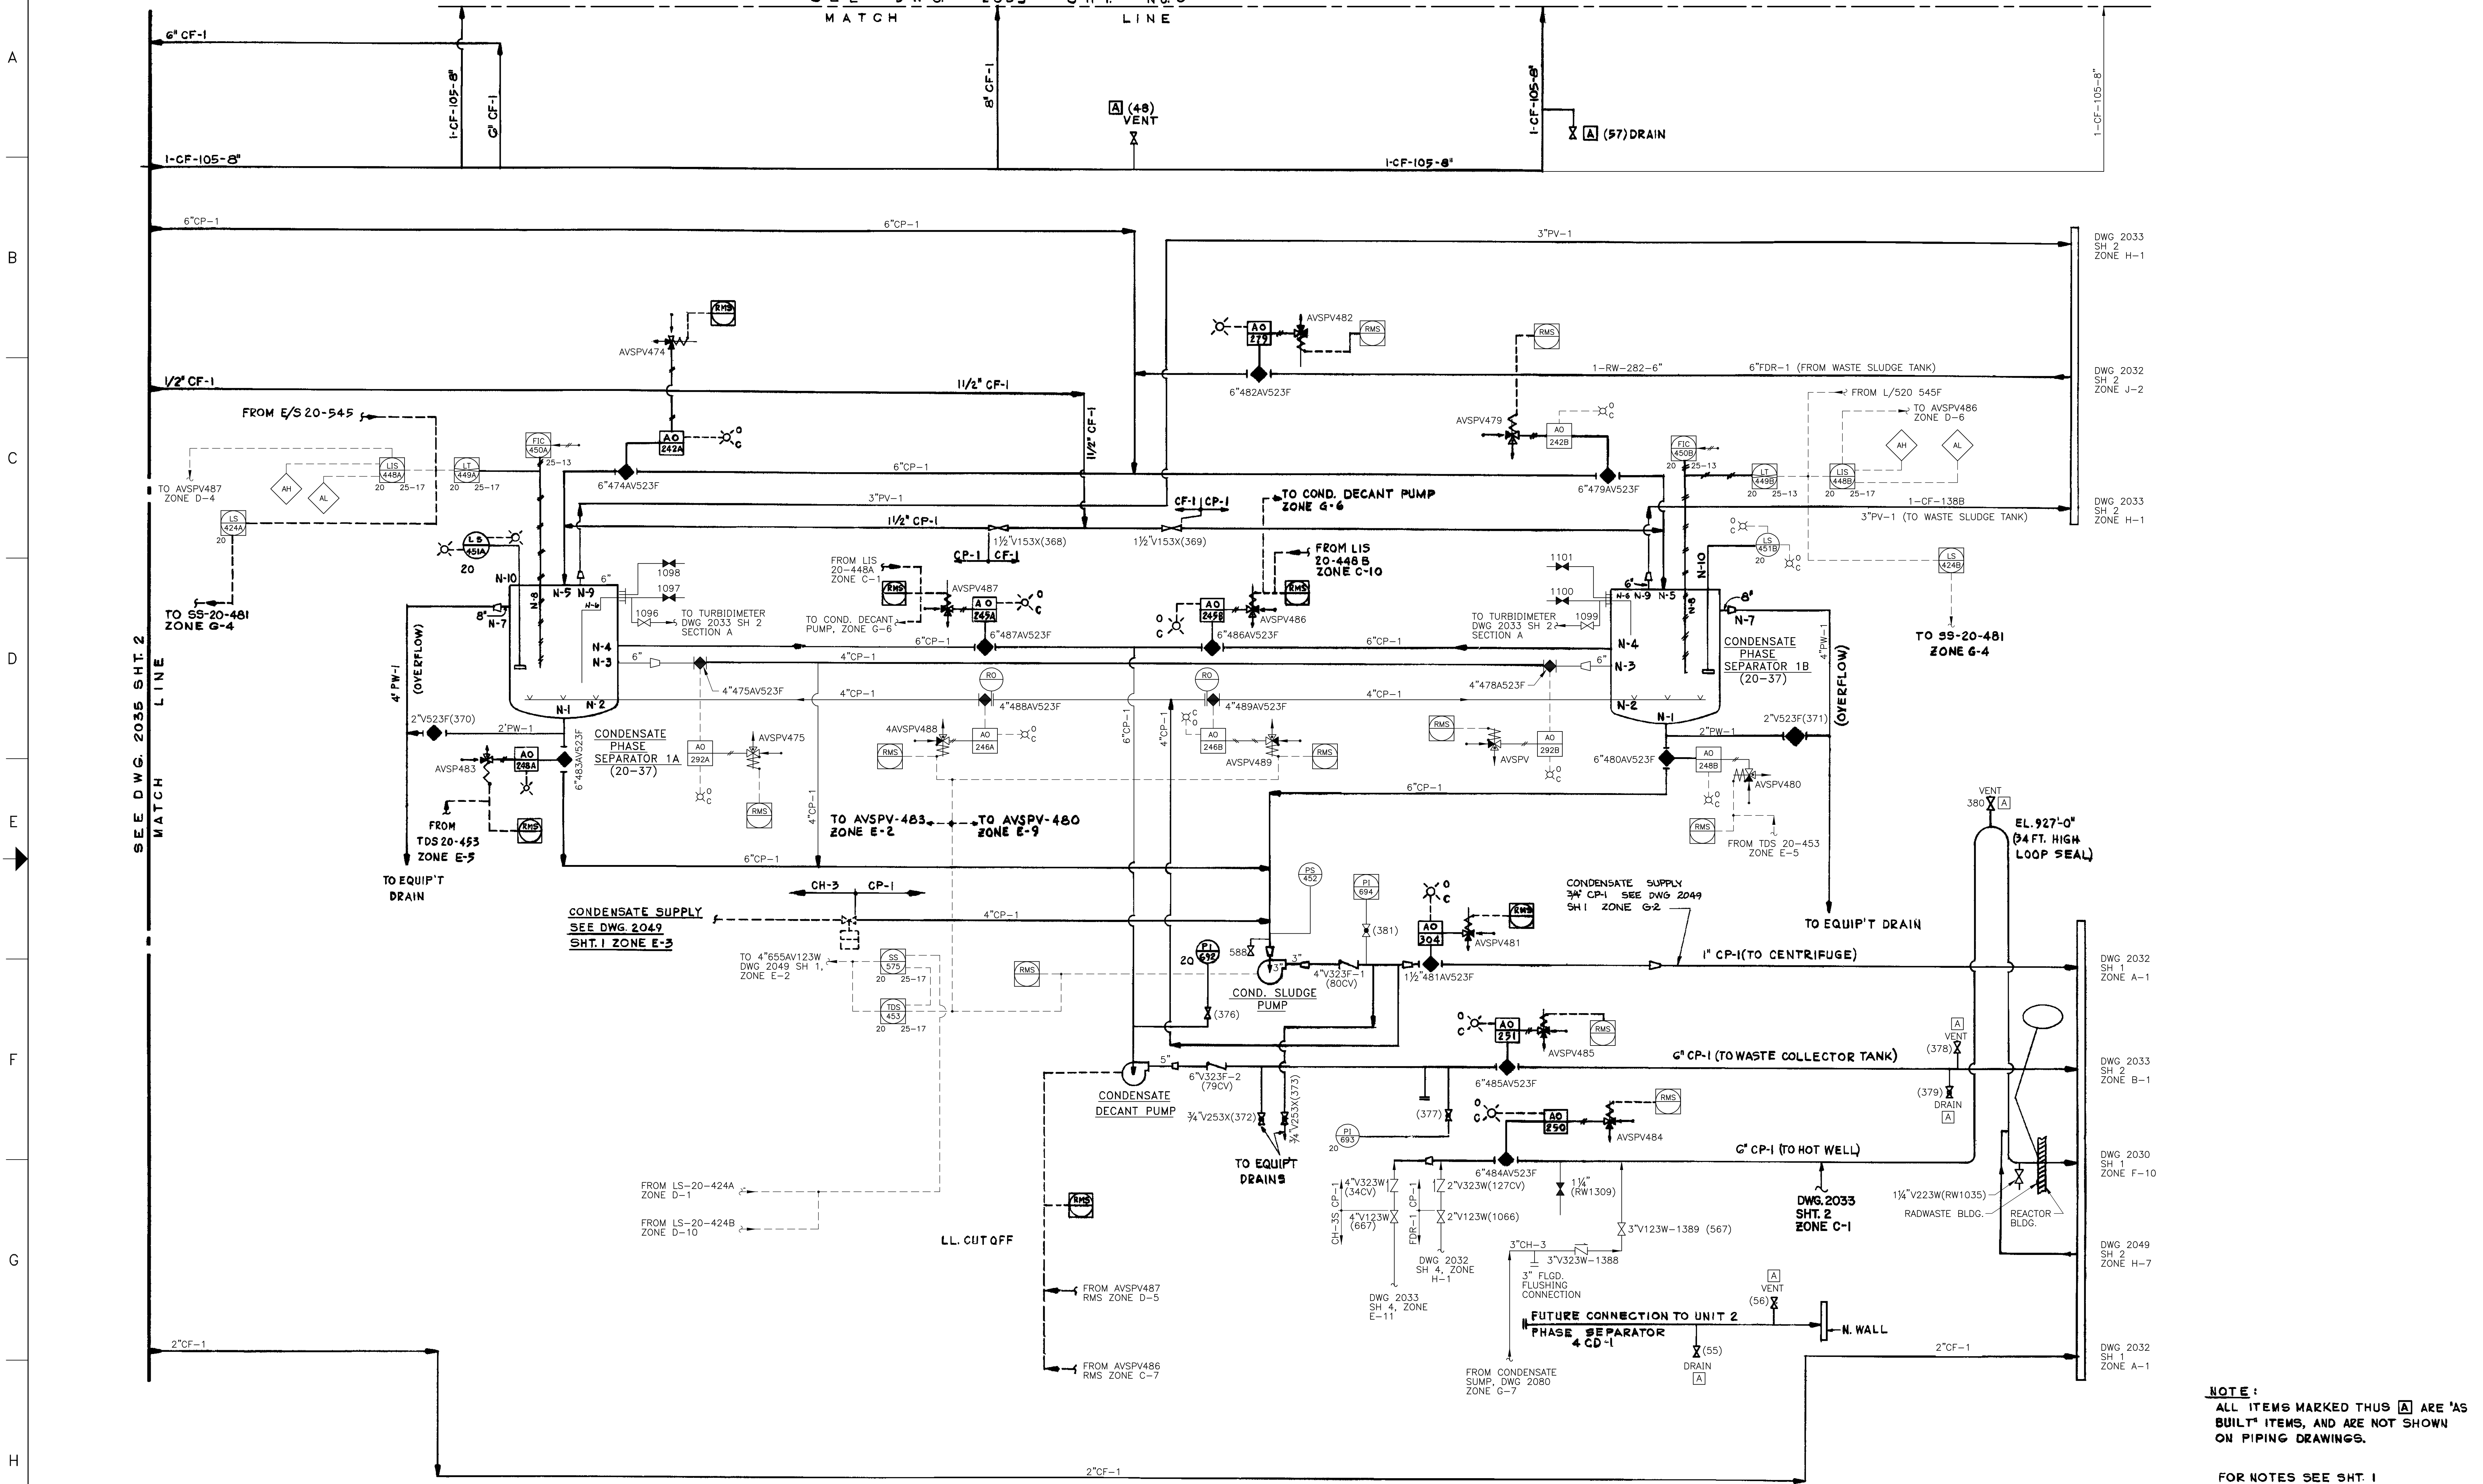

**NOTE:**  
ALL ITEMS MARKED THUS [A] ARE 'AS BUILT' ITEMS, AND ARE NOT SHOWN ON PIPING DRAWINGS.  
FOR NOTES SEE SHT. 1

REVISIONS TO THIS DRAWING REQUIRES A REVISION TO THE CORRESPONDING ISOKEY.

**AS BUILT**  
454003671

STATUS: Release  
STATUS DATE: 02/07/2017  
DS APPROVED: NEWERNE  
VER: AB REV: 16 SIZE: F

FOR PREVIOUS REVISIONS, SEE SUPERSEDED CARDS.

VERSIONS/REVISIONS BY N.P.P.D.				
NO.	DESCRIPTION	DFT	DATE	ENG
AB/18/DR-2017-0001		DJR	02/07/17	NEWERNE


SIGNIFICANT NUMBER	GROUP	DATE	DRAWN	DATE	CHECKED	DATE	APPROVED	DATE	FILMED	DATE	GROUP	DATE	
												DATE	DATE
			HFY	06/17/02									

**BURNS & ROE**

2035 SH 4

FLOW DIAGRAM  
CONDENSATE FILTER  
DEMINERALIZER SYSTEM  
COOPER NUCLEAR STATION

C0017955

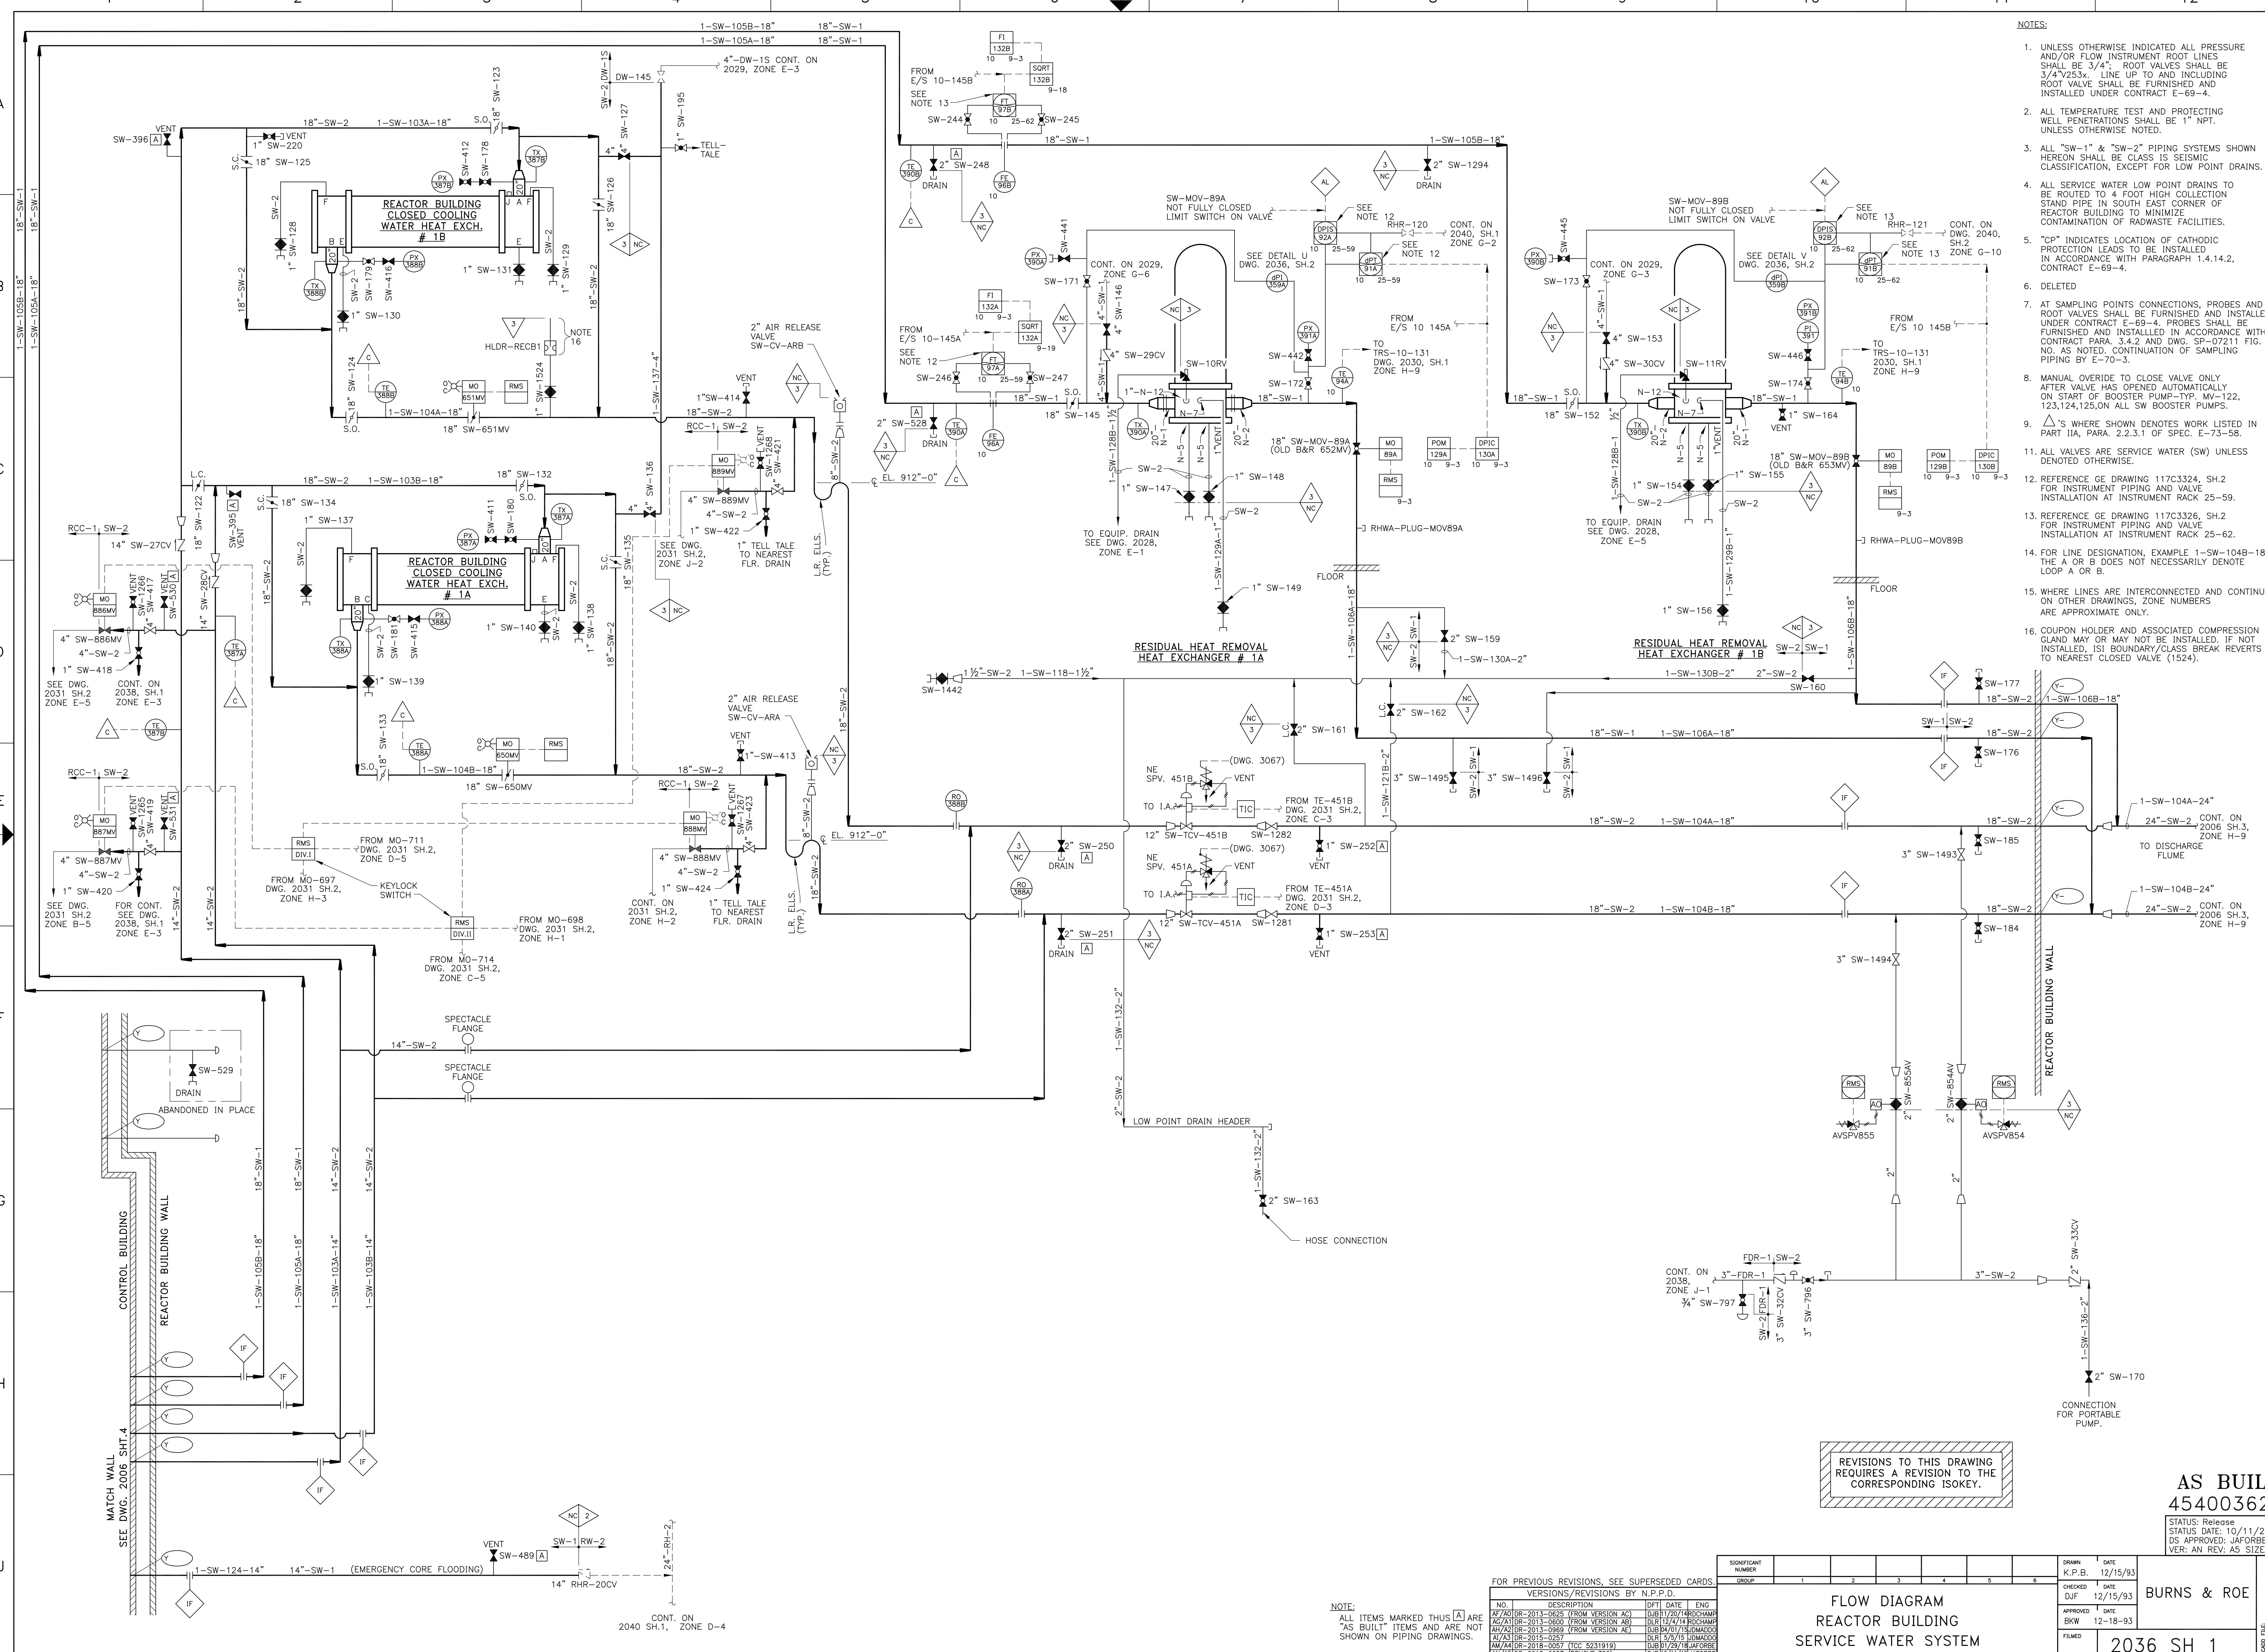

- NOTES:
- UNLESS OTHERWISE INDICATED ALL PRESSURE AND/OR FLOW INSTRUMENT ROOT LINES SHALL BE 3/4"; ROOT VALVES SHALL BE 3/4"x253.5" LINE UP TO AND INCLUDING ROOT VALVE SHALL BE FURNISHED AND INSTALLED UNDER CONTRACT E-69-4.
  - ALL TEMPERATURE TEST AND PROTECTING WELL PENETRATIONS SHALL BE 1" NPT. UNLESS OTHERWISE NOTED.
  - ALL "SW-1" & "SW-2" PIPING SYSTEMS SHOWN HEREON SHALL BE CLASS IS SEISMIC CLASSIFICATION, EXCEPT FOR LOW POINT DRAINS.
  - ALL SERVICE WATER LOW POINT DRAINS TO BE ROUTED TO 4 FOOT HIGH COLLECTION STAND PIPE IN SOUTH EAST CORNER OF REACTOR BUILDING TO MINIMIZE CONTAMINATION OF RADWASTE FACILITIES.
  - "CP" INDICATES LOCATION OF CATHODIC PROTECTION LEADS TO BE INSTALLED IN ACCORDANCE WITH PARAGRAPH 1.4.14.2, CONTRACT E-69-4.
  - DELETED
  - AT SAMPLING POINTS CONNECTIONS, PROBES AND ROOT VALVES SHALL BE FURNISHED AND INSTALLED UNDER CONTRACT E-69-4. PROBES SHALL BE FURNISHED AND INSTALLED IN ACCORDANCE WITH CONTRACT PARA. 3.4.2 AND DWG. SP-07211 FIG. NO. AS NOTED. CONTINUATION OF SAMPLING PIPING BY E-70-3.
  - MANUAL OVERRIDE TO CLOSE VALVE ONLY AFTER VALVE HAS OPENED AUTOMATICALLY ON START OF BOOSTER PUMP-TYP. MV-122, 123,124,125,ON ALL SW BOOSTER PUMPS.
  - △'S WHERE SHOWN DENOTES WORK LISTED IN PART IIA, PARA. 2.2.3.1 OF SPEC. E-73-58.
  - ALL VALVES ARE SERVICE WATER (SW) UNLESS DENOTED OTHERWISE.
  - REFERENCE GE DRAWING 117C3324, SH.2 FOR INSTRUMENT PIPING AND VALVE INSTALLATION AT INSTRUMENT RACK 25-59.
  - REFERENCE GE DRAWING 117C3326, SH.2 FOR INSTRUMENT PIPING AND VALVE INSTALLATION AT INSTRUMENT RACK 25-62.
  - FOR LINE DESIGNATION, EXAMPLE 1-SW-104B-18", THE A OR B DOES NOT NECESSARILY DENOTE LOOP A OR B.
  - WHERE LINES ARE INTERCONNECTED AND CONTINUED ON OTHER DRAWINGS, ZONE NUMBERS ARE APPROXIMATE ONLY.
  - COUPLON HOLDER AND ASSOCIATED COMPRESSION GLAND MAY OR MAY NOT BE INSTALLED. IF NOT INSTALLED, ISI BOUNDARY/CLASS BREAK REVERTS TO NEAREST CLOSED VALVE (1524).

REVISIONS TO THIS DRAWING REQUIRES A REVISION TO THE CORRESPONDING ISOKEY.

**AS BUILT**  
 454003629  
 STATUS: Release  
 STATUS DATE: 10/11/2018  
 DS APPROVED: JAFORBE  
 VER: AN REV: AS SIZE: F

FOR PREVIOUS REVISIONS, SEE SUPERSEDED CARDS.

VERSIONS/REVISIONS BY N.P.P.D.				
NO.	DESCRIPTION	DFT	DATE	ENG
01	AS/2018-2013-0625 (FROM VERSION AC)	DJB	11/29/14	ROSHAMP
02	02/21/18-2013-0650 (FROM VERSION AB)	DJB	12/27/14	ROSHAMP
03	04/24/18-2013-0969 (FROM VERSION AC)	DJB	04/21/15	UDMADDO
04	04/24/18-2015-0257	DJB	5/2/15	UDMADDO
05	04/24/18-2018-0057 (ICC 5231919)	DJB	07/27/18	JAFORBE
06	04/24/18-2018-0057 (REMOVE ICC)	DJB	07/11/18	JAFORBE

SIGNIFICANT NUMBER		GROUP		DATE		DATE		DATE	
1	2	3	4	5	6	7	8	9	10


NO.	DATE	BY	CHKD	DATE	BY	DATE
1	12/15/93	K.P.B.	DJF	12/15/93	DJF	12-16-93
2						
3						
4						
5						
6						
7						
8						
9						
10						
11						
12						

FLOW DIAGRAM  
 REACTOR BUILDING  
 SERVICE WATER SYSTEM

2036 SH 1

BURNS & ROE

NOTE:  
 ALL ITEMS MARKED THUS [A] ARE "AS BUILT" ITEMS AND ARE NOT SHOWN ON PIPING DRAWINGS.

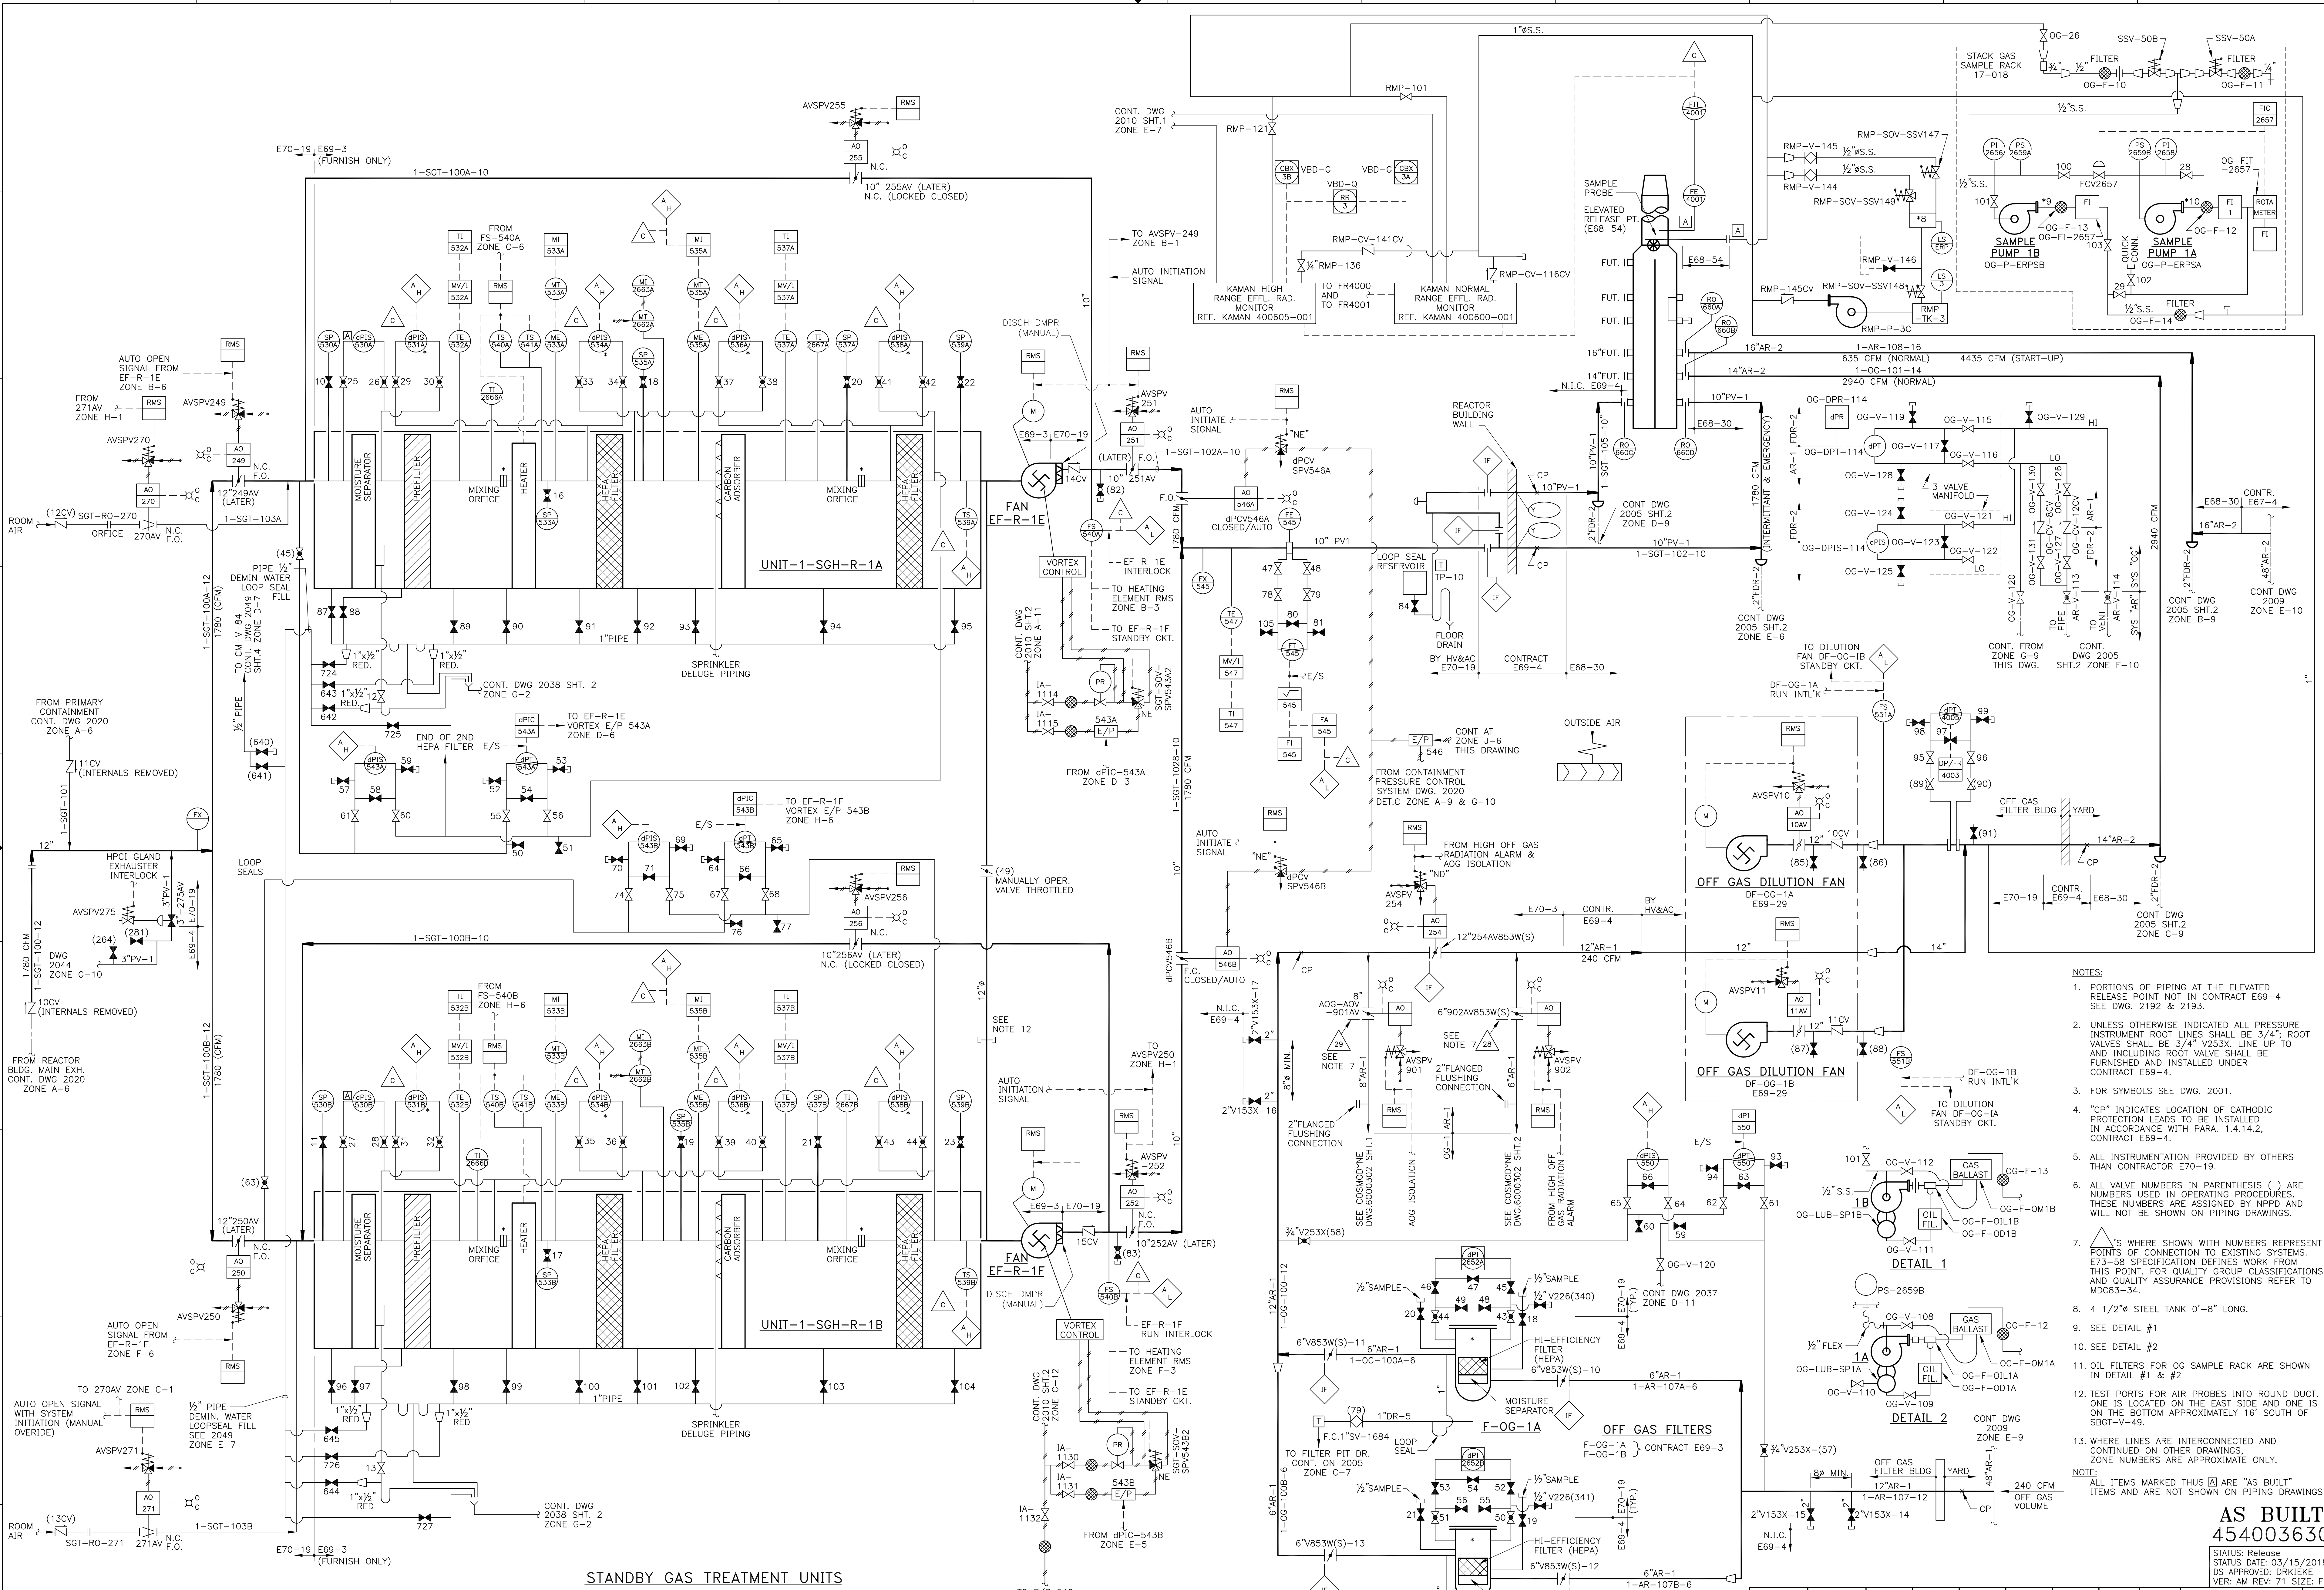

STANDBY GAS TREATMENT UNITS  
(ONE OPERATING - ONE STANDBY)(E-69-3)

- NOTES:
1. PORTIONS OF PIPING AT THE ELEVATED RELEASE POINT NOT IN CONTRACT E69-4 SEE DWG. 2192 & 2193.
  2. UNLESS OTHERWISE INDICATED ALL PRESSURE INSTRUMENT ROOT LINES SHALL BE 3/4" I.D. VALVES SHALL BE 3/4" V253X LINE UP TO AND INCLUDING ROOT VALVE SHALL BE FURNISHED AND INSTALLED UNDER CONTRACT E69-4.
  3. FOR SYMBOLS SEE DWG. 2001.
  4. "CP" INDICATES LOCATION OF CATHODIC PROTECTION LEADS TO BE INSTALLED IN ACCORDANCE WITH PARA. 1.4.14.2, CONTRACT E69-4.
  5. ALL INSTRUMENTATION PROVIDED BY OTHERS THAN CONTRACTOR E70-19.
  6. ALL VALVE NUMBERS IN PARENTHESIS ( ) ARE NUMBERS USED IN OPERATING PROCEDURES. THESE NUMBERS ARE ASSIGNED BY NPPD AND WILL NOT BE SHOWN ON PIPING DRAWINGS.
  7. Δ'S WHERE SHOWN WITH NUMBERS REPRESENT POINTS OF CONNECTION TO EXISTING SYSTEMS. E73-58 SPECIFICATION DEFINES WORK FROM THIS POINT. FOR QUALITY GROUP CLASSIFICATIONS AND QUALITY ASSURANCE PROVISIONS REFER TO MDC83-34.
  8. 4 1/2" STEEL TANK 0'-8" LONG.
  9. SEE DETAIL #1
  10. SEE DETAIL #2
  11. OIL FILTERS FOR OG SAMPLE RACK ARE SHOWN IN DETAIL #1 & #2
  12. TEST PORTS FOR AIR PROBES INTO ROUND DUCT. ONE IS LOCATED ON THE EAST SIDE AND ONE IS ON THE BOTTOM APPROXIMATELY 16" SOUTH OF SBTG-V-49.
  13. WHERE LINES ARE INTERCONNECTED AND CONTINUED ON OTHER DRAWINGS, ZONE NUMBERS ARE APPROXIMATE ONLY.
- NOTE:  
ALL ITEMS MARKED WITH (A) ARE "AS BUILT" ITEMS AND ARE NOT SHOWN ON PIPING DRAWINGS.

AS BUILT  
454003630  
STATUS: Release  
STATUS DATE: 03/15/2018  
DS APPROVED: DRKIEKE  
VER: AM REV: 71 STATE: F

FOR PREVIOUS REVISIONS, SEE SUPERSEDED CARDS.  
VERSIONS/REVISIONS BY N.P.P.D.

NO.	DESCRIPTION	DPT	DATE	ENG
AJ/69/DR-2015-0086			08/10/14	DRKIEKE
AJ/70/DR-2017-0443			03/15/18	DRKIEKE
AM/72/DR-2017-0443			03/15/18	DRKIEKE


REVISIONS TO THIS DRAWING  
REQUIRES A REVISION TO THE  
CORRESPONDING ISOKEY.

SIGNIFICANT NUMBER	DATE		DATE	DATE
	GROUP	HYF		
1			7/10/01	
2				
3				
4				
5				
6				
7				
8				
9				
10				
11				
12				

COOPER NUCLEAR STATION  
FLOW DIAGRAM  
H&V STANDBY GAS TREATMENT  
& OFF GAS FILTERS

APPROVED: DATE: 03/15/2018  
VER: AM REV: 71 STATE: F

2037

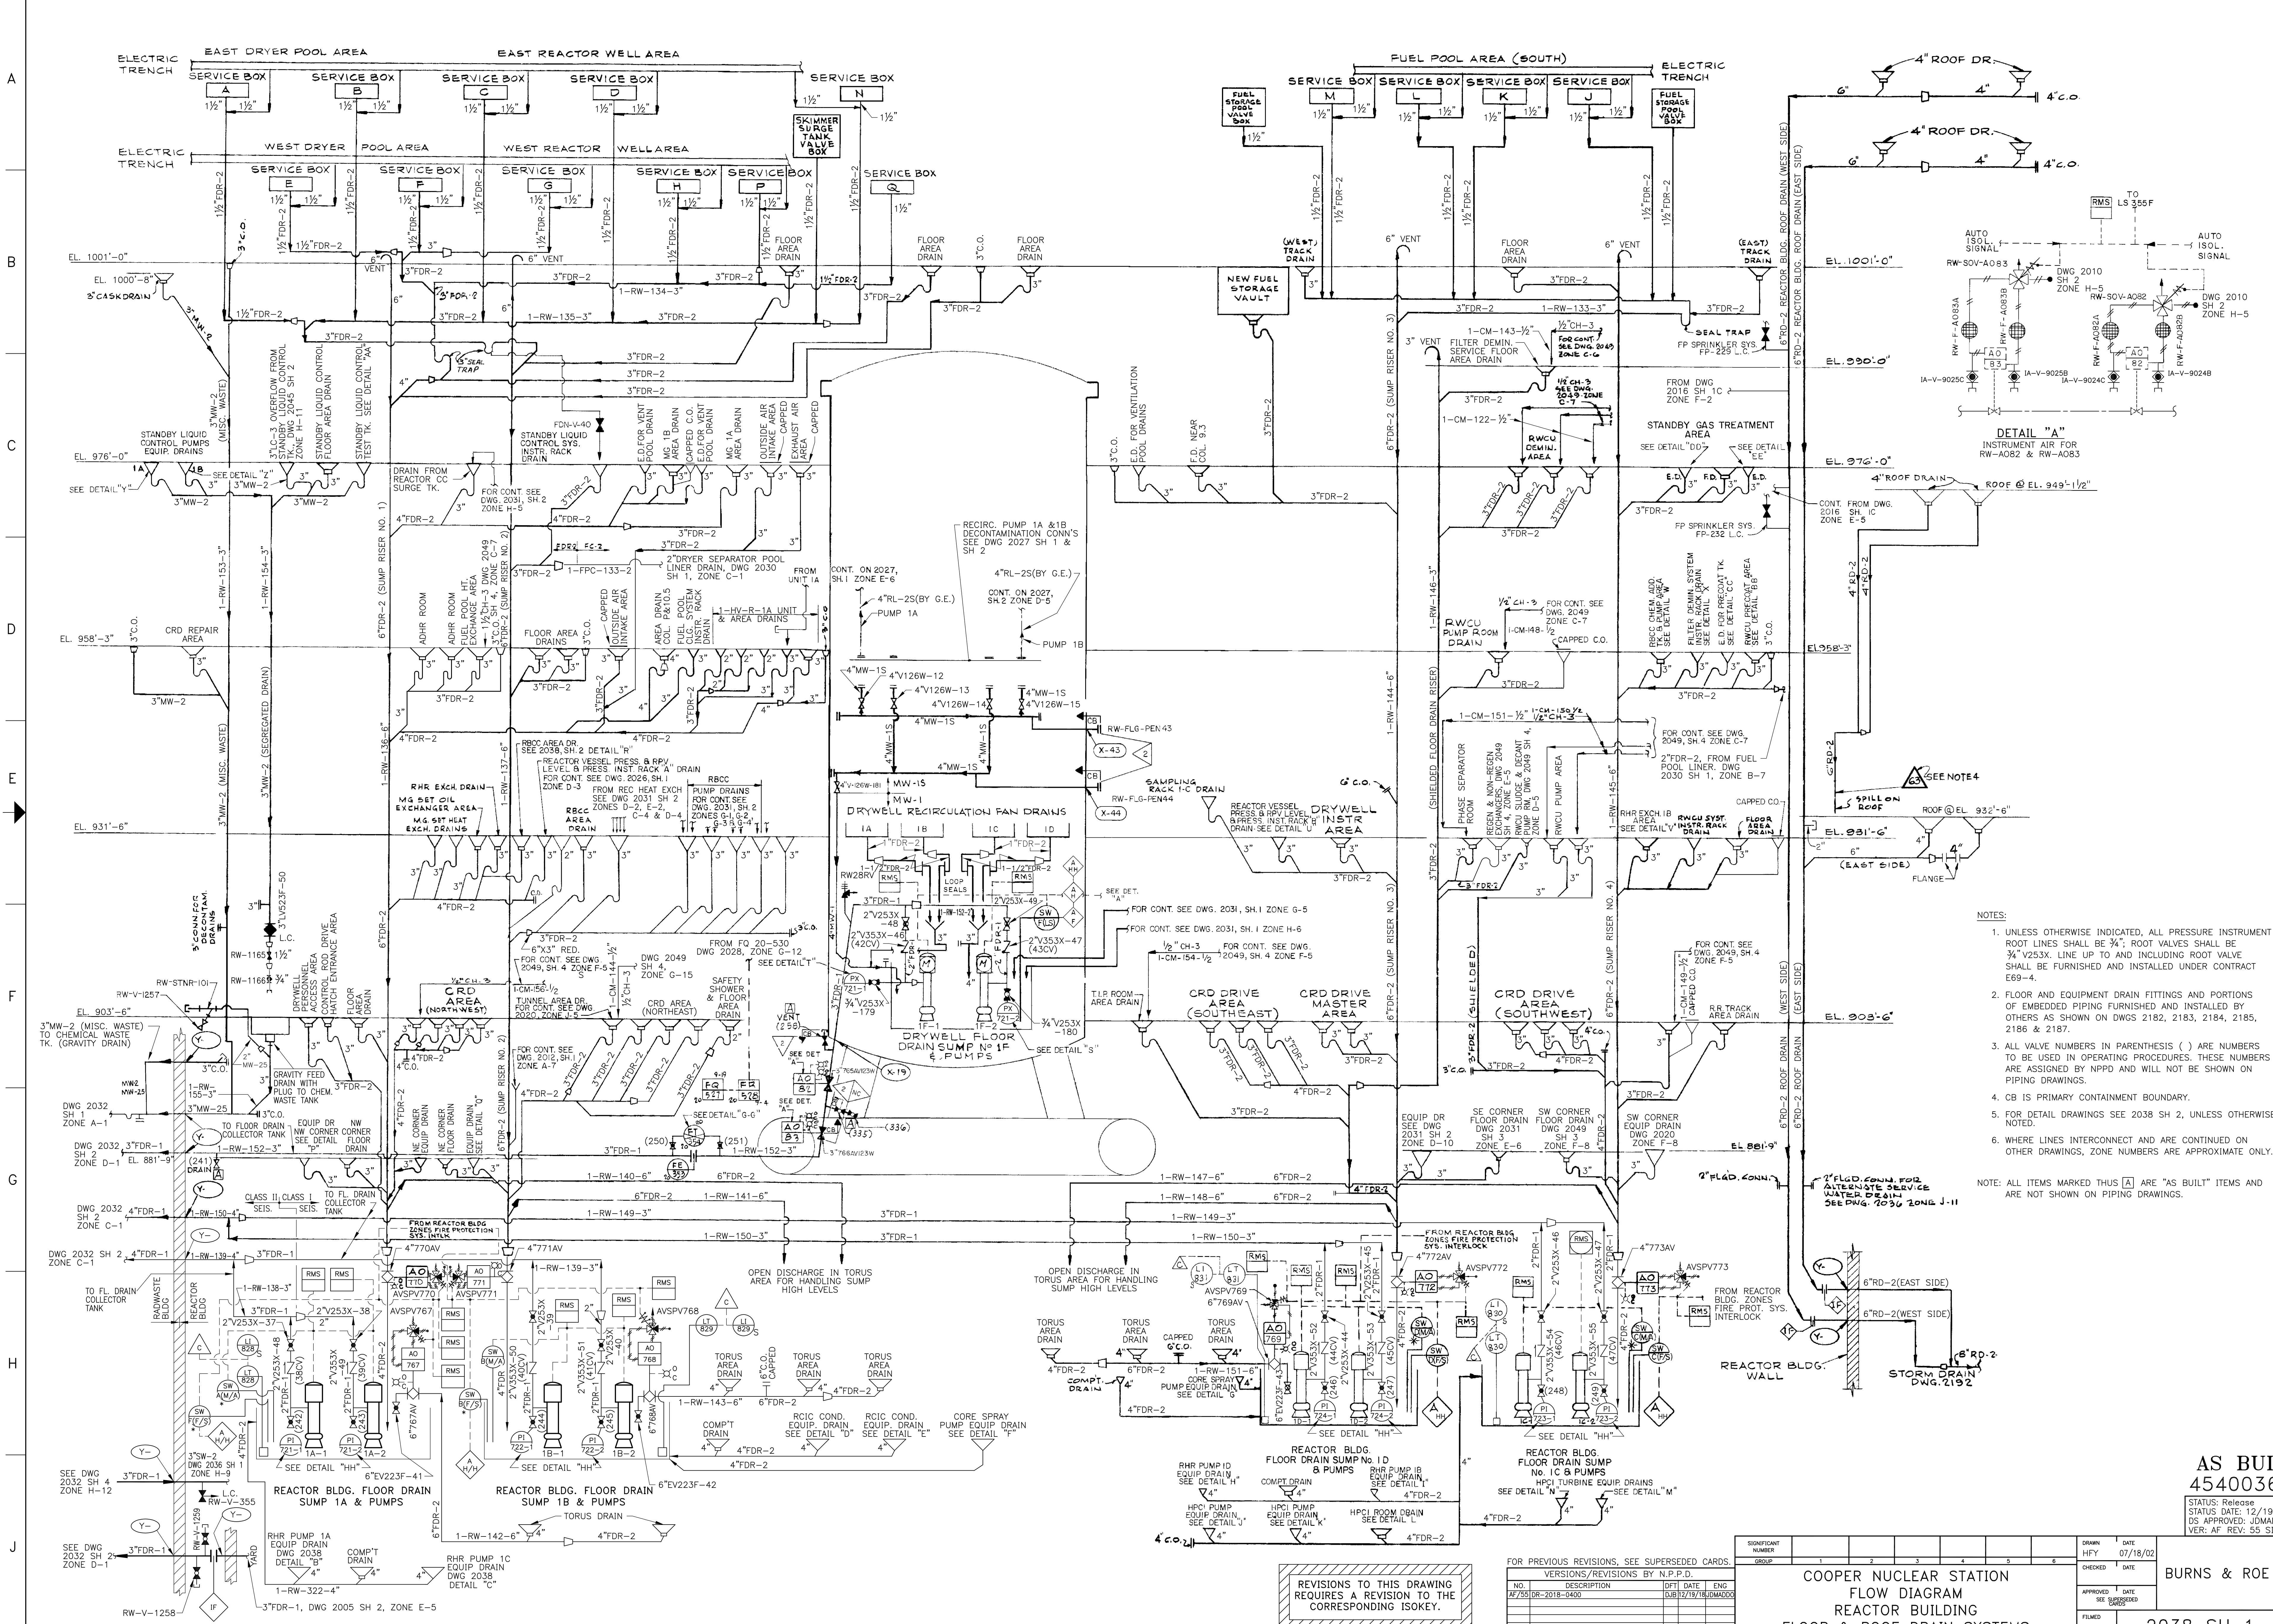

- NOTES:
- UNLESS OTHERWISE INDICATED, ALL PRESSURE INSTRUMENT ROOT LINES SHALL BE 3/4"; ROOT VALVES SHALL BE 3/4" V253X. LINE UP TO AND INCLUDING ROOT VALVE SHALL BE FURNISHED AND INSTALLED UNDER CONTRACT E69-4.
  - FLOOR AND EQUIPMENT DRAIN FITTINGS AND PORTIONS OF EMBEDDED PIPING FURNISHED AND INSTALLED BY OTHERS AS SHOWN ON DWGS 2182, 2183, 2184, 2185, 2186 & 2187.
  - ALL VALVE NUMBERS IN PARENTHESIS ( ) ARE NUMBERS TO BE USED IN OPERATING PROCEDURES. THESE NUMBERS ARE ASSIGNED BY NPPD AND WILL NOT BE SHOWN ON PIPING DRAWINGS.
  - CB IS PRIMARY CONTAINMENT BOUNDARY.
  - FOR DETAIL DRAWINGS SEE 2038 SH 2, UNLESS OTHERWISE NOTED.
  - WHERE LINES INTERCONNECT AND ARE CONTINUED ON OTHER DRAWINGS, ZONE NUMBERS ARE APPROXIMATE ONLY.

NOTE: ALL ITEMS MARKED THUS [A] ARE "AS BUILT" ITEMS AND ARE NOT SHOWN ON PIPING DRAWINGS.

AS BUILT  
454003631

STATUS: Release  
STATUS DATE: 12/19/2018  
DS APPROVED: JDMADDO  
VER: AF REV: 55 SIZE: F

FOR PREVIOUS REVISIONS, SEE SUPERSSEDED CARDS.

VERSIONS/REVISIONS BY N.P.D.			
NO.	DESCRIPTION	DFT DATE	ENG
AF/2510R-2018-0400		DJR/12/19/18	JDMADDO


SIGNATURE	DATE	GROUP					
		1	2	3	4	5	6
HYF	07/18/02						
CHECKED	DATE						
APPROVED	DATE						
FILED							

COOPER NUCLEAR STATION  
FLOW DIAGRAM  
REACTOR BUILDING  
FLOOR & ROOF DRAIN SYSTEMS

BURNS & ROE

2038 SH 1

REVISIONS TO THIS DRAWING REQUIRES A REVISION TO THE CORRESPONDING ISOKEY.

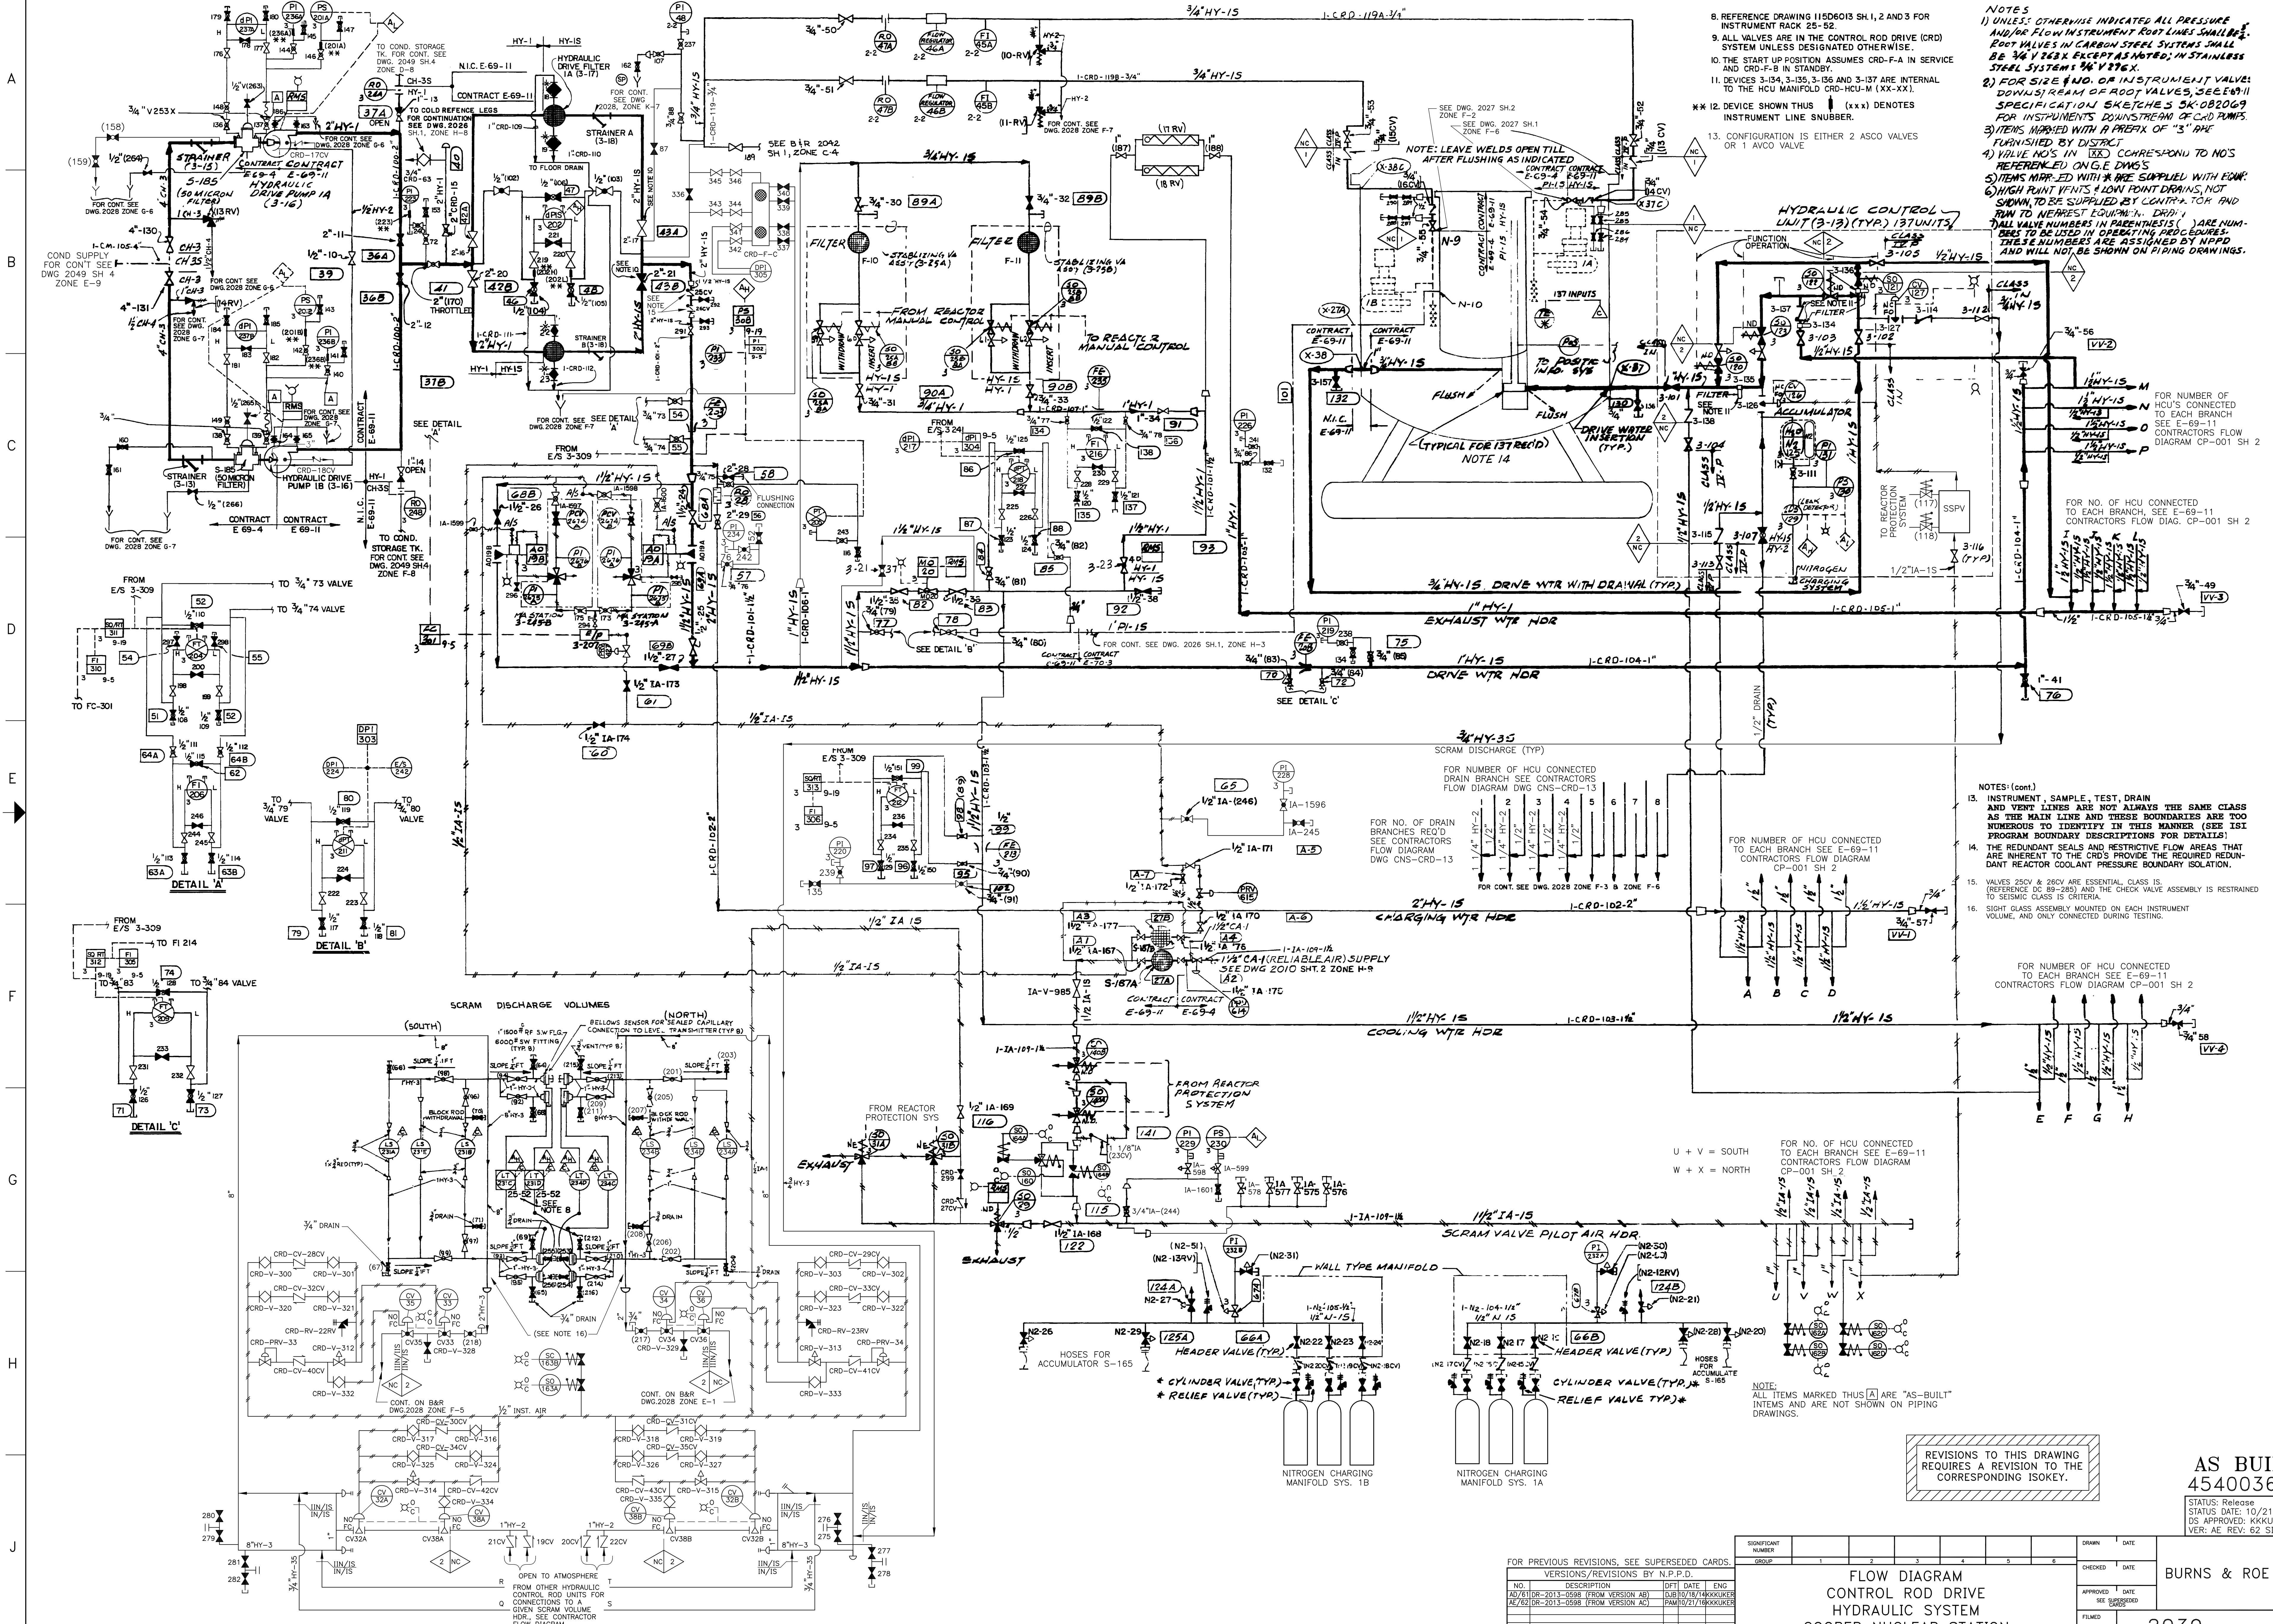

8. REFERENCE DRAWING 115D6013 SH. 1, 2 AND 3 FOR INSTRUMENT RACK 25-52.
9. ALL VALVES ARE IN THE CONTROL ROD DRIVE (CRD) SYSTEM UNLESS DESIGNATED OTHERWISE.
10. THE START UP POSITION ASSUMES CRD-F-A IN SERVICE AND CRD-F-B IN STANDBY.
11. DEVICES 3-134, 3-135, 3-136 AND 3-137 ARE INTERNAL TO THE HCU MANIFOLD CRD-HCU-M (XX-XX).
12. DEVICE SHOWN THUS  $\uparrow$  (XXX) DENOTES INSTRUMENT LINE SNUBBER.
13. CONFIGURATION IS EITHER 2 ASCO VALVES OR 1 AVCO VALVE.

- NOTES
- 1) UNLESS OTHERWISE INDICATED ALL PRESSURE AND/OR FLOW INSTRUMENT ROOT LINES SHALL BE 3/4\"/>

2) FOR SIZE #NO. OF INSTRUMENT VALVE: DOWNSTREAM OF ROOT VALVES, SEE E-69-11 SPECIFICATION SKETCHES SK-082069 FOR INSTRUMENTS DOWNSTREAM OF CRD PUMPS.

3) ITEMS MARKED WITH A PREFIX OF "S" ARE FINISHED BY DISTRICT.

4) VALVE NOS IN ( ) CORRESPOND TO NOS REFERENCED ON THE DWS'S.

5) ITEMS MARKED WITH \* ARE SUPPLIED WITH EQUIP.

6) HIGH POINT VENTS & LOW POINT DRAINS, NOT SHOWN, TO BE SUPPLIED BY CONTRACTOR AND RUN TO NEAREST EQUIPMENT. DRIP-1.

7) ALL VALVE NUMBERS IN PARENTHESES ( ) ARE NUMBERS TO BE USED IN OPERATING PROCEDURES. THESE NUMBERS ARE ASSIGNED BY NPD AND WILL NOT BE SHOWN ON PIPING DRAWINGS.

- NOTES (cont.)
13. INSTRUMENT, SAMPLE, TEST, DRAIN AND VENT LINES ARE NOT ALWAYS THE SAME CLASS AS THE MAIN LINE AND THESE BOUNDARIES ARE TOO NUMEROUS TO IDENTIFY IN THIS MANNER (SEE 1ST PROGRAM BOUNDARY DESCRIPTIONS FOR DETAILS).
14. THE REDUNDANT SEALS AND RESTRICTIVE FLOW AREAS THAT ARE INHERENT TO THE CRD'S PROVIDE THE REQUIRED REDUNDANT REACTOR COOLANT PRESSURE BOUNDARY ISOLATION.
15. VALVES 25CV & 26CV ARE ESSENTIAL, CLASS IS (REFERENCE DC 89-285) AND THE CHECK VALVE ASSEMBLY IS RESTRAINED TO SEISMIC CLASS IS CRITERIA.
16. SIGHT GLASS ASSEMBLY MOUNTED ON EACH INSTRUMENT VOLUME, AND ONLY CONNECTED DURING TESTING.

REVISIONS TO THIS DRAWING REQUIRES A REVISION TO THE CORRESPONDING ISOKEY.

AS BUILT  
454003632  
STATUS: Release  
STATUS DATE: 10/21/2016  
DS APPROVED: KKKUKUR  
VER: AE REV: 62 SIZE: F


FOR PREVIOUS REVISIONS, SEE SUPERSEDED CARDS.			SIGNIFICANT NUMBER		DRAWN DATE	
NO.	DESCRIPTION	DFTI DATE	GROUP	1	2	3
AD/810R-2013-0588 (FROM VERSION AB)	DATE: 10/17/14	ENG: KKKUKUR				
AE/820R-2013-0588 (FROM VERSION AC)	DATE: 02/27/14	ENG: KKKUKUR				

CHECKED DATE		APPROVED DATE		FILMED	2039
GROUP	DATE	GROUP	DATE		

FLOW DIAGRAM CONTROL ROD DRIVE HYDRAULIC SYSTEM COOPER NUCLEAR STATION		BURNS & ROE	
---	--	-------------	--



11. TESTABLE FLANGES.
12. INFORMATION CONTAINED IN THE LONG RECTANGULAR BOXES (E.G. SEC XI-CLS II) INDICATES AN ASME SECTION XI CODE CLASSIFICATION (I.E. CLASS I, II OR III). INSTRUMENT, SAMPLE, TEST, DRAIN AND VENT LINES ARE NOT ALWAYS THE SAME CLASS AS THE MAIN LINE AND THESE BOUNDARIES ARE TOO NUMEROUS TO IDENTIFY IN THIS MANNER (SEE ISI PROGRAM BOUNDARY DESCRIPTIONS).
13. CB IS PRIMARY CONTAINMENT BOUNDARY WHICH IS CLASS III OR IN CONSTRUCTION.
14. TO RHR MECHANICAL SEAL COOLERS AND MECHANICAL CYCLONE SEPARATORS FOR RHR PUMPS A, B, C & D SHOWN ON BURNS & ROE DRAWING 2031 SH. 2 AND 82600\*F280005/8.
15. WHERE LINES ARE INTERCONNECTED AND CONTINUED ON OTHER DRAWINGS, ZONE NUMBERS ARE APPROXIMATE ONLY.
16. RHR STEAM CONDENSING IS NO LONGER AN OPERATIONAL MODE.

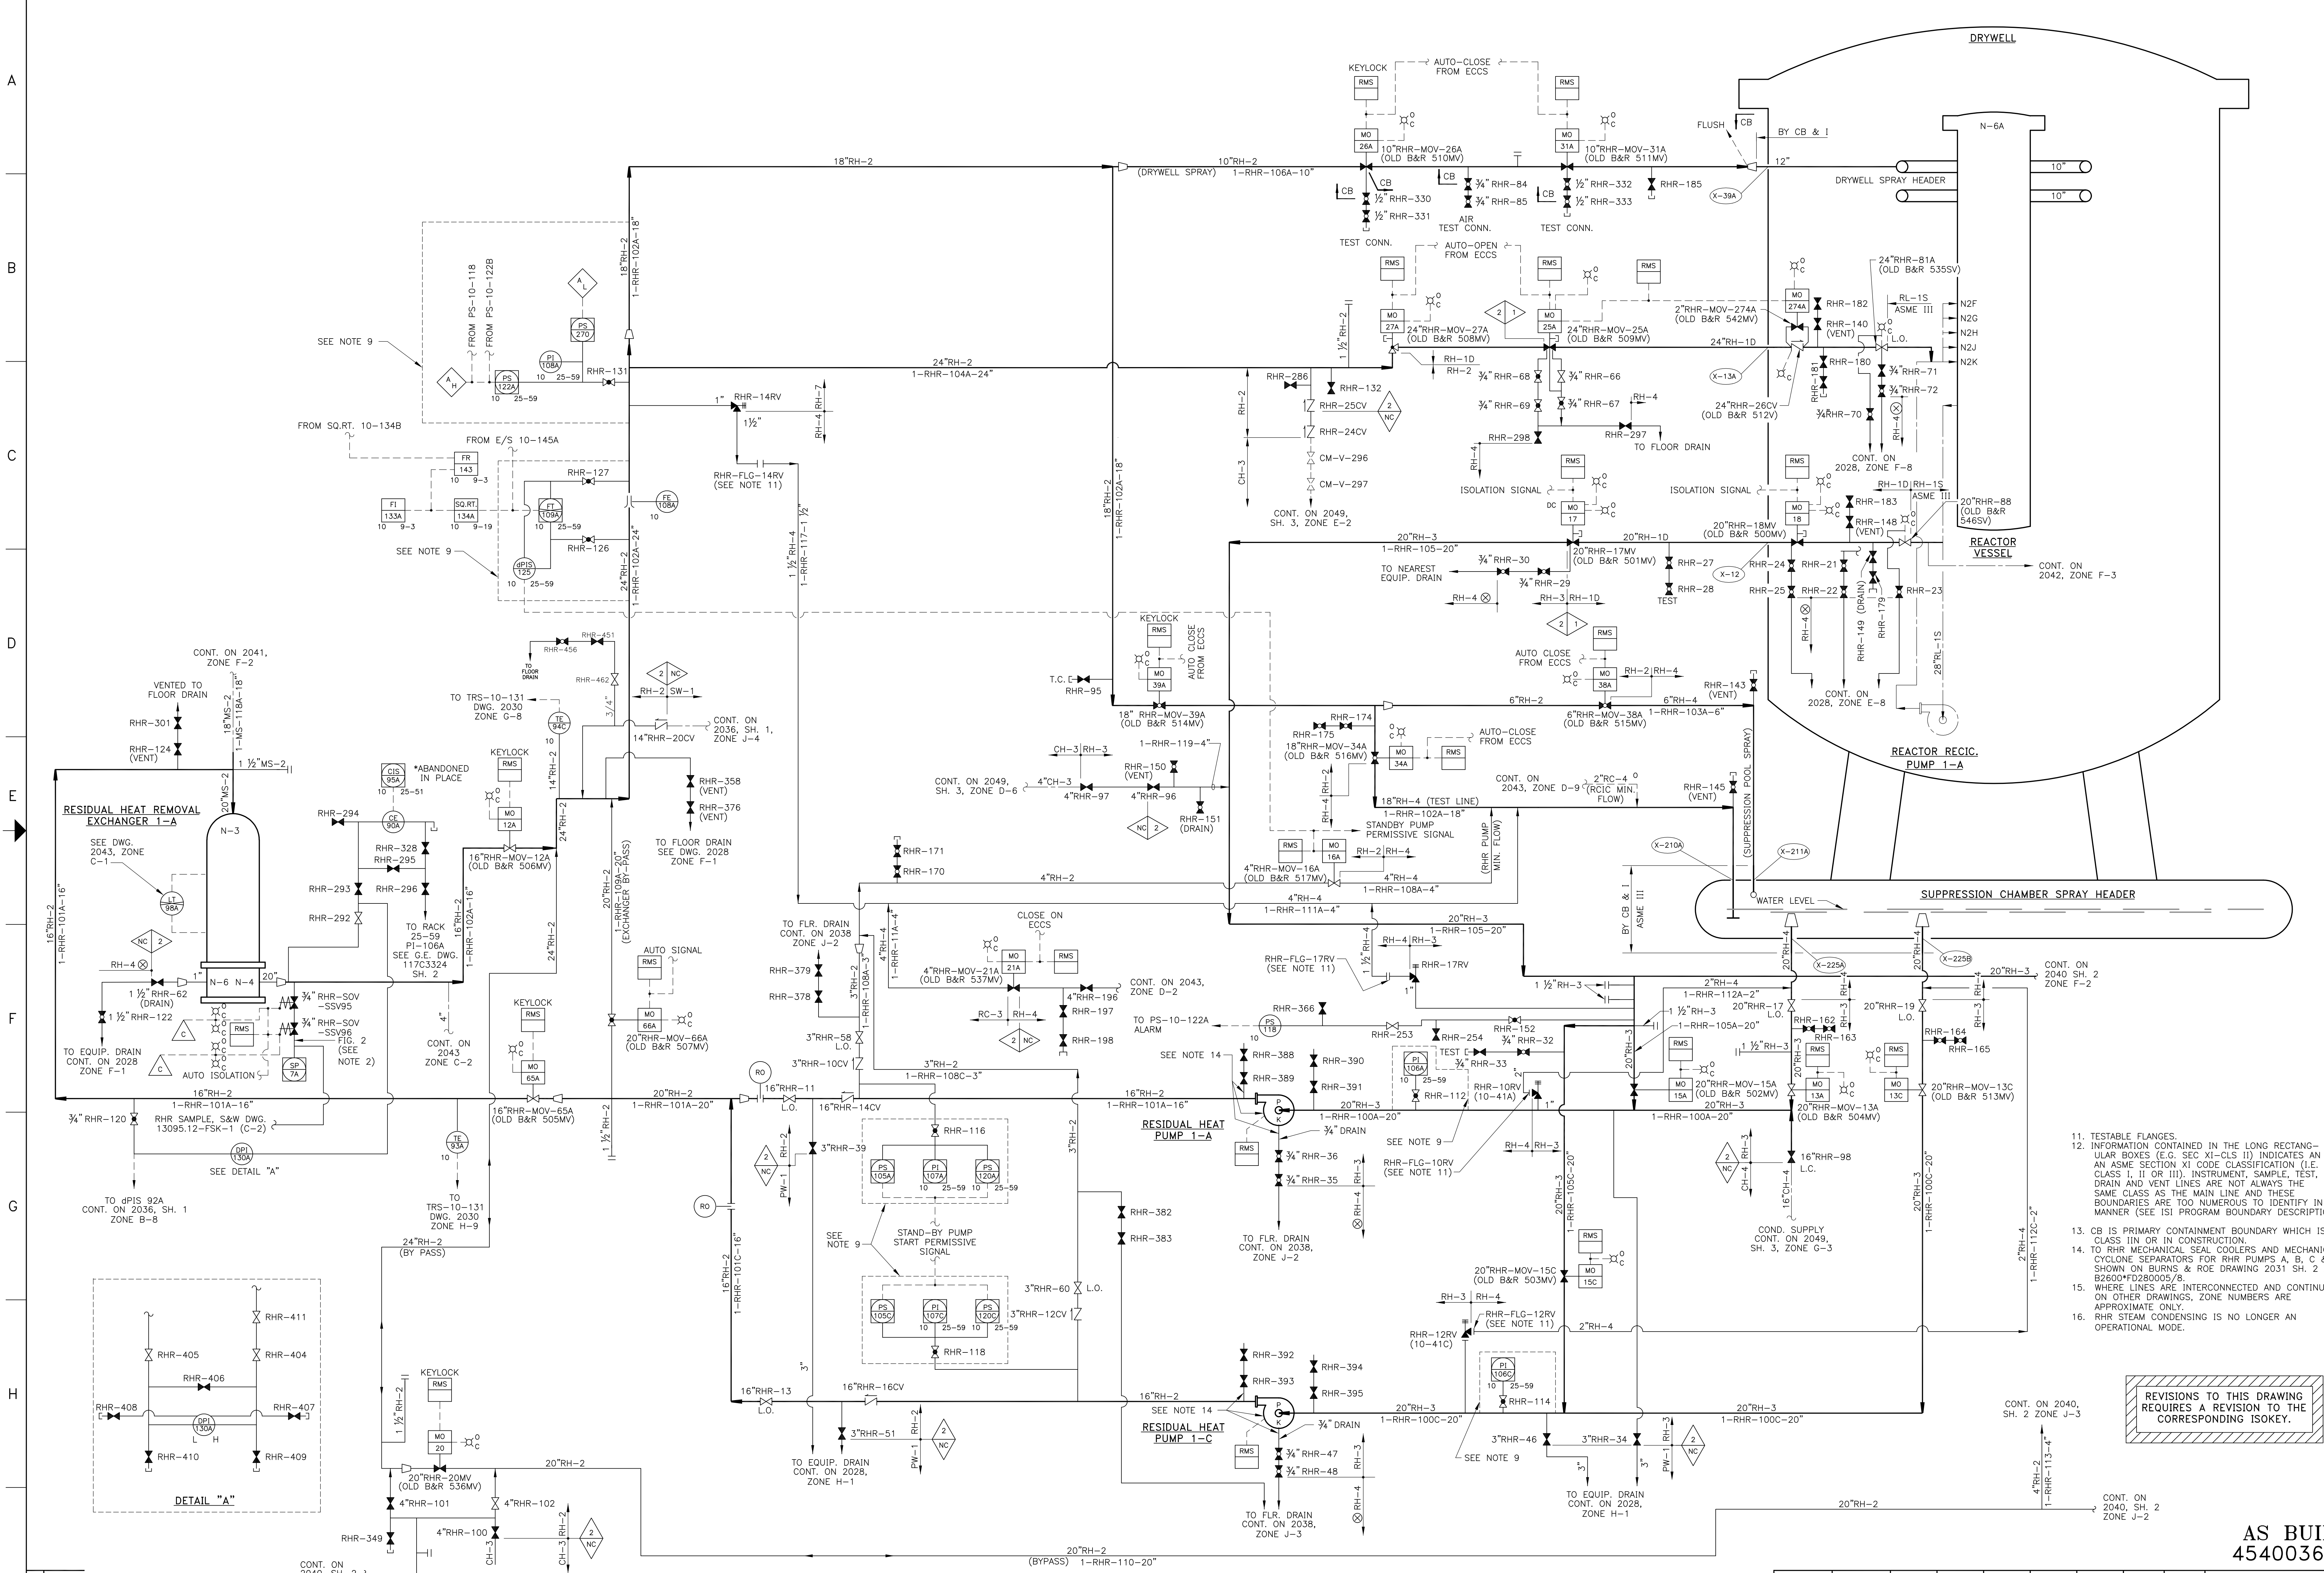REVISIONS TO THIS DRAWING  
REQUIRES A REVISION TO THE  
CORRESPONDING ISOKEY.

**NOTES:**

1. UNLESS OTHERWISE INDICATED, ALL PRESSURE AND/OR FLOW INSTRUMENT ROOT LINES SHALL BE 3/4" ROOT VALVES SHALL BE 3/4" LINES UP TO AND INCLUDING ROOT VALVES SHALL BE FURNISHED AND INSTALLED UNDER CONTRACT E-69-4.
2. AT SAMPLING POINTS, CONNECTIONS, PROBES AND ROOT VALVES SHALL BE FURNISHED AND INSTALLED UNDER CONTRACT E-69-4. PROBES SHALL BE FURNISHED AND

3. ALL RHR-4 PIPING SHALL BE PER CLASS III CLASSIFICATION EXCEPT THAT RHR-4 PIPING 2" NOMINAL SIZE AND SMALLER WHICH CONNECTS TO/OR DRAINS INTO FLOOR DRAIN Sumps OR EQUIPMENT DRAIN Sumps SHALL BE CLASS IVP CLASSIFICATION WITH MATERIALS AND JOINTS AS SPECIFIED FOR "RHR-4" SYSTEM.

4. HIGH POINT VENTS & LOW POINT DRAINS ARE NOT SHOWN.
5. VALVES IDENTIFIED AS V268X SHALL CONFORM TO THE REQUIREMENTS OF CONTRACT E-69-4 SPECIFICATION PARA. 3.2.8.8, GROUP A-7 VALVES, WHERE STAINLESS STEEL VALVES ARE FURNISHED BY THE CONTRACTOR UNDER PARA. 3.2.8.8, THE STAINLESS STEEL INTERCONNECTING PIPING SHALL CONFORM TO CONTRACT E-69-4 SPECIFICATION REQUIREMENTS FOR CLASS III, RF-1S SYSTEM PIPING.
6. DELETED

7. Δs WHERE SHOWN WITH NUMBERS, REPRESENT POINTS OF CONNECTION TO EXISTING SYSTEMS, E-73-58 SPECIFICATION DEFINES WORK FROM THIS POINT.
8. REF. G.E. DRAWING 117C3326 SH. 2 FOR INSTRUMENT PIPING AND VALVE INSTALLATION AT INSTRUMENT RACK 25-62.
9. REF. G.E. DRAWING 117C3324 SH. 2 FOR INSTRUMENT PIPING AND VALVE INSTALLATION AT INSTRUMENT RACK 25-59.
10. DELETED



FOR PREVIOUS REVISIONS, SEE SUPERSEDED CARDS.

NO.	REVISIONS	DATE	BY	CHKD	APPD
1	REVISED	08-09-69	KG	DJB	DLR
2	REVISED	09-04-69	DLR	DLR	DLR
3	REVISED	09-04-69	DLR	DLR	DLR
4	REVISED	09-04-69	DLR	DLR	DLR
5	REVISED	09-04-69	DLR	DLR	DLR
6	REVISED	09-04-69	DLR	DLR	DLR
7	REVISED	09-04-69	DLR	DLR	DLR
8	REVISED	09-04-69	DLR	DLR	DLR
9	REVISED	09-04-69	DLR	DLR	DLR
10	REVISED	09-04-69	DLR	DLR	DLR

SIGNIFICANT NUMBER		DRAWN		DATE	
1	2	3	4	5	6
COOPER NUCLEAR STATION FLOW DIAGRAM RESIDUAL HEAT REMOVAL SYSTEM					
CHECKED			DATE		
APPROVED			DATE		
FILED			REVISION		
2040 SH 1 N82			BURNS & ROE		

AS BUILT  
454003633



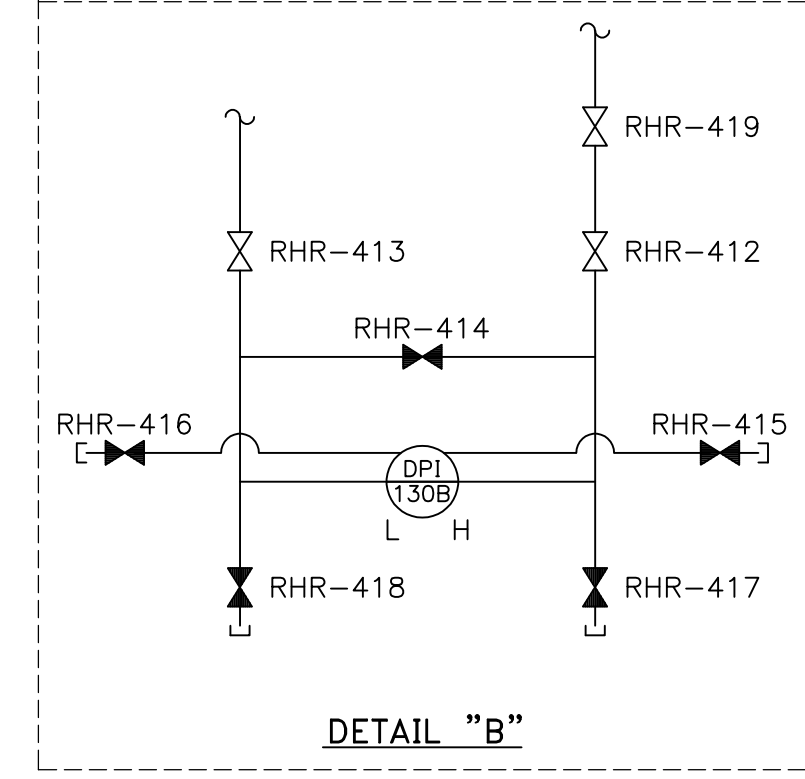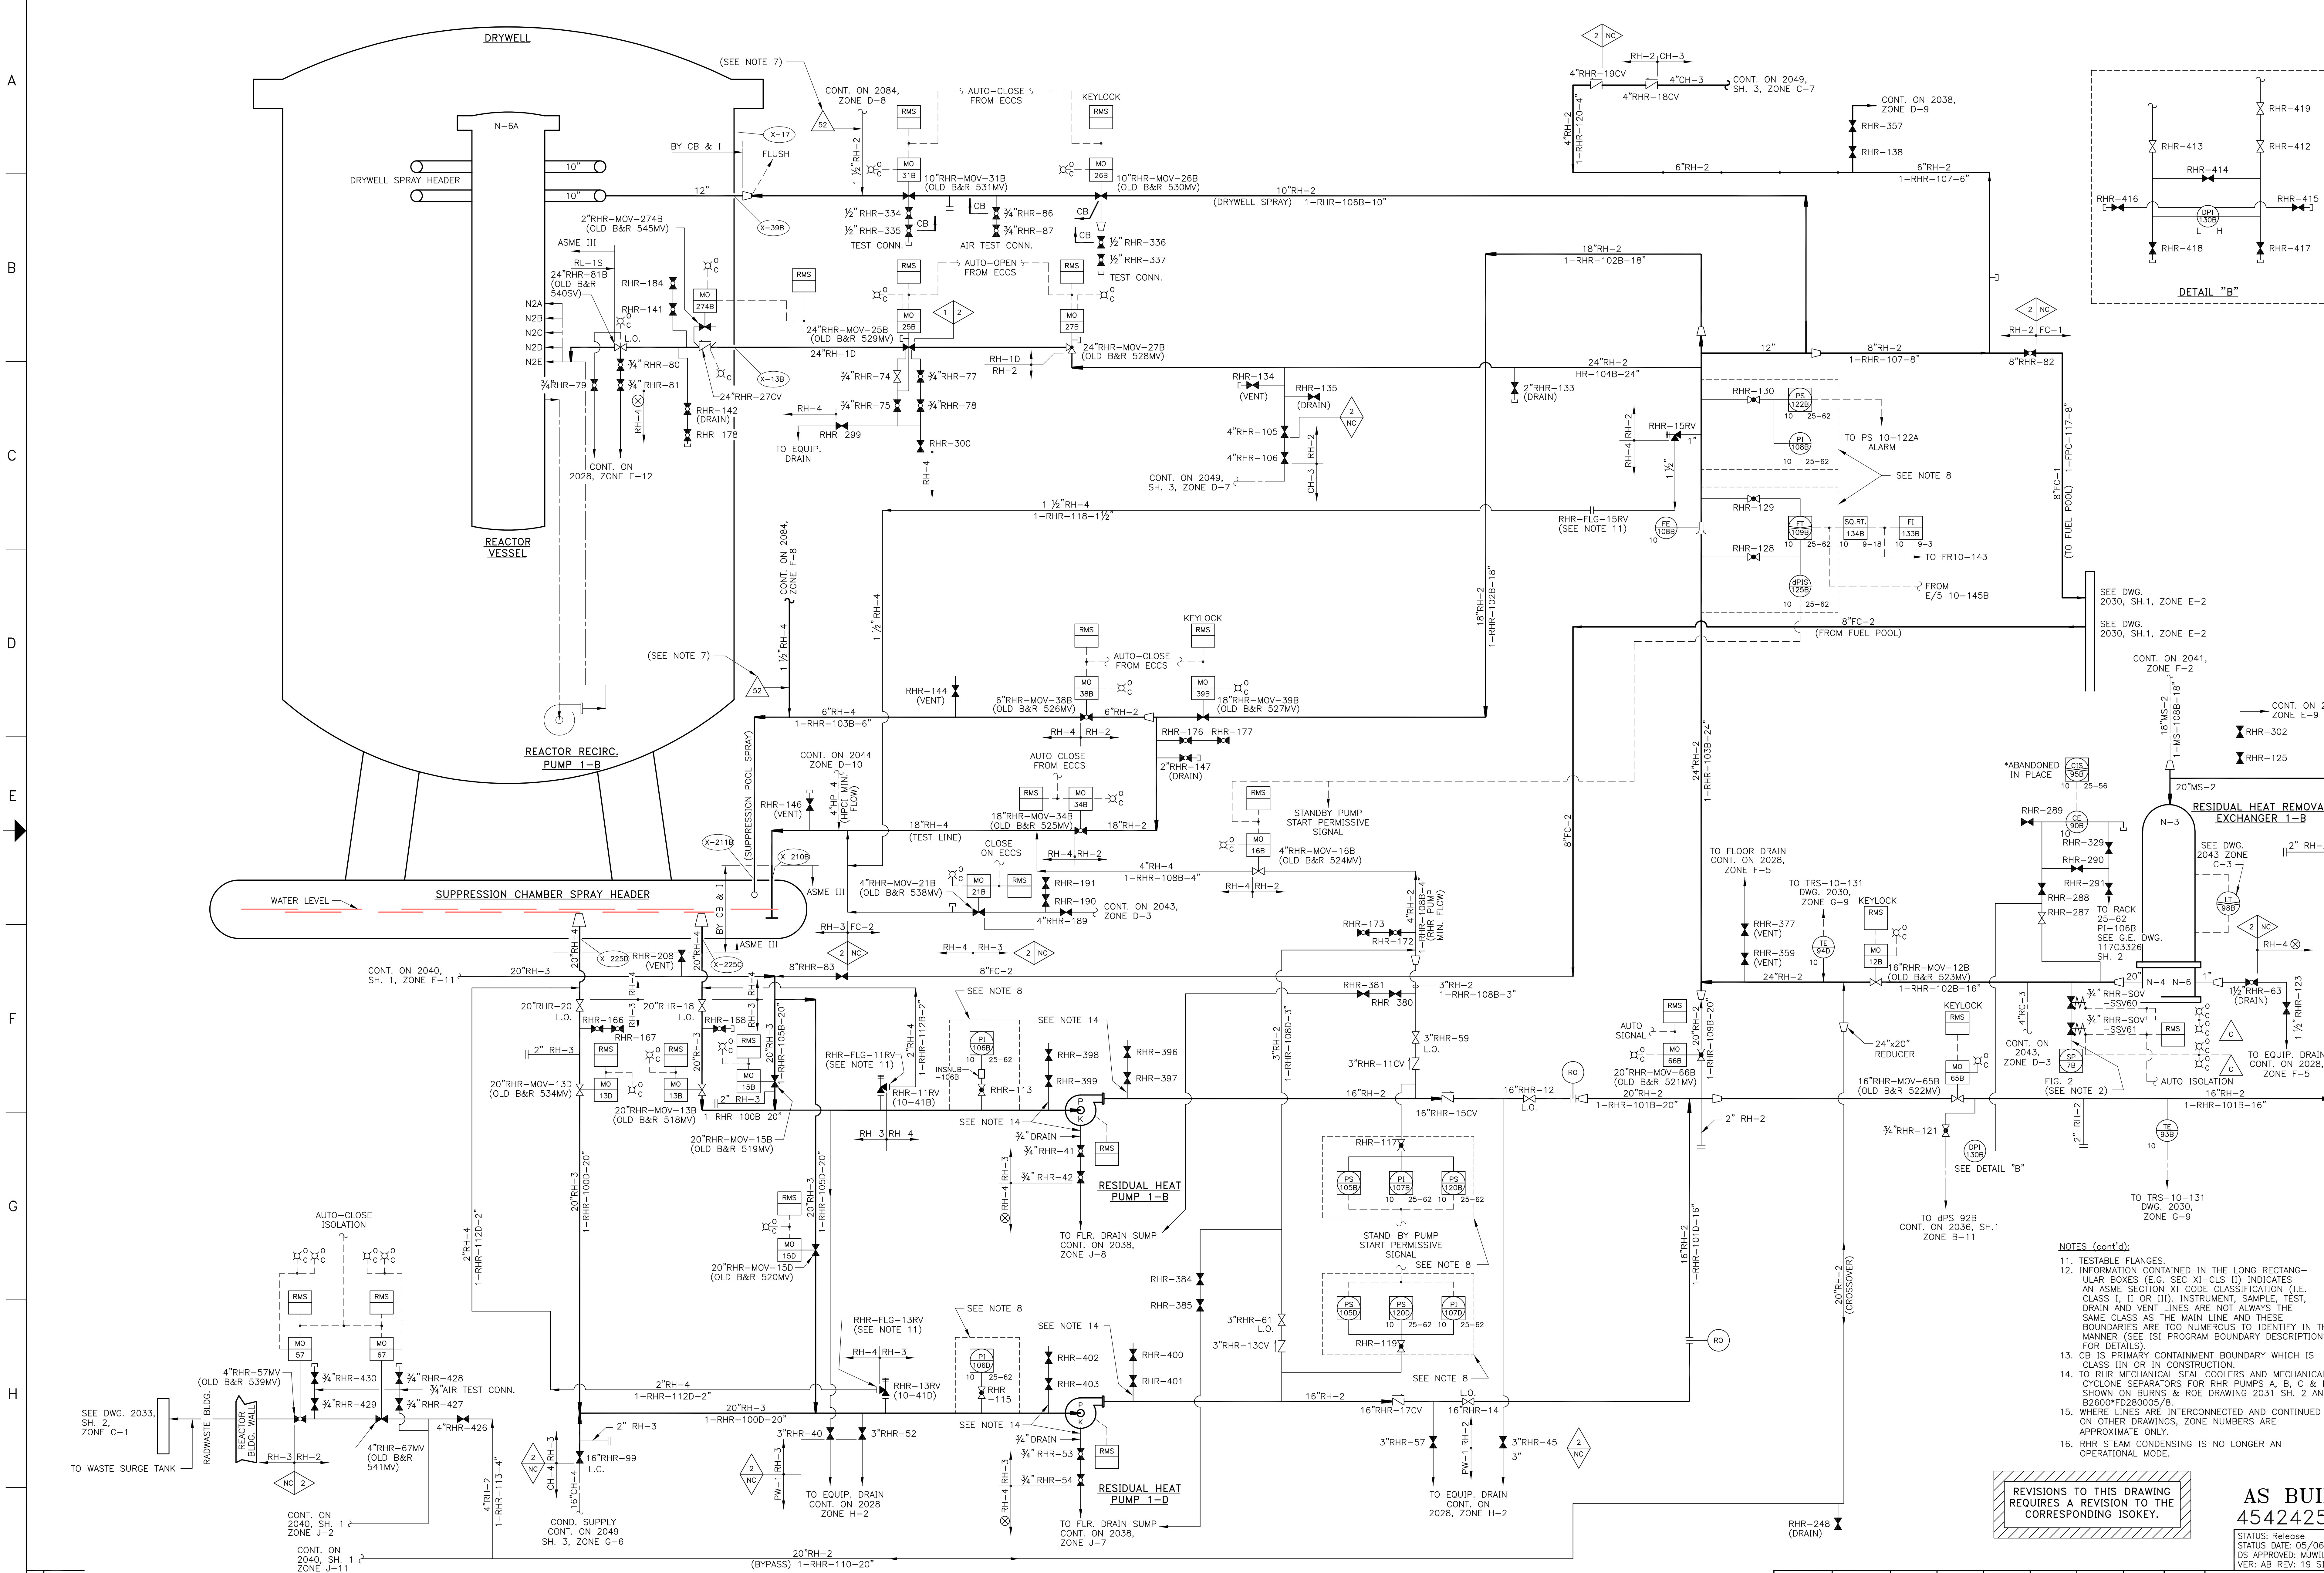

- NOTES (cont'd):
- TESTABLE FLANGES.
  - INFORMATION CONTAINED IN THE LONG RECTANGULAR BOXES (E.G. SEC XI-015 (I)) INDICATES AN ASME SECTION XI CODE CLASSIFICATION (I.E. CLASS I, II OR III). INSTRUMENT, SAMPLE, TEST, DRAIN AND VENT LINES ARE NOT ALWAYS THE SAME CLASS AS THE MAIN LINE AND THESE BOUNDARIES ARE TOO NUMEROUS TO IDENTIFY IN THIS MANNER (SEE ISI PROGRAM BOUNDARY DESCRIPTIONS FOR DETAILS).
  - CB IS PRIMARY CONTAINMENT BOUNDARY WHICH IS CLASS IIN OR IN CONSTRUCTION.
  - TO RHR MECHANICAL SEAL COOLERS AND MECHANICAL CYCLONE SEPARATORS FOR RHR PUMPS A, B, C & D SHOWN ON BURNS & ROE DRAWING 2031 SH. 2 AND 82600\*FD280005/8.
  - WHERE LINES ARE INTERCONNECTED AND CONTINUED ON OTHER DRAWINGS, ZONE NUMBERS ARE APPROXIMATE ONLY.
  - RHR STEAM CONDENSING IS NO LONGER AN OPERATIONAL MODE.

REVISIONS TO THIS DRAWING  
REQUIRES A REVISION TO THE  
CORRESPONDING ISOKEY.

**AS BUILT**  
454242533  
STATUS: Release  
STATUS DATE: 05/06/2014  
DS APPROVED: MWJ/MLM  
VER: AB REV: 19 SIZE: F

- NOTES:
- UNLESS OTHERWISE INDICATED, ALL PRESSURE AND/OR FLOW INSTRUMENT ROOT LINES SHALL BE 3/4" ROOT VALVES SHALL BE 3/4" V253X. LINES UP TO AND INCLUDING ROOT VALVES SHALL BE FURNISHED AND INSTALLED UNDER CONTRACT E-69-4.
  - AT SAMPLING POINTS, CONNECTIONS, PROBES AND ROOT VALVES SHALL BE FURNISHED AND INSTALLED UNDER CONTRACT E-69-4. PROBES SHALL BE FURNISHED AND

- INSTALLED IN ACCORDANCE WITH CONTRACT PARA. 3.4.2 AND DWG. SP-07211, FIG. NO. AS NOTED. CONTINUATION OF SAMPLE PIPING BY E-70-3.
- ALL RH-4 PIPING SHALL BE PER CLASS IIN CLASSIFICATION EXCEPT THAT RH-4 PIPING 2" NOMINAL SIZE AND SMALLER WHICH CONNECTS TO/OR DRAINS INTO FLOOR DRAIN SUMPS OR EQUIPMENT DRAIN SUMPS SHALL BE CLASS IVP CLASSIFICATION WITH MATERIALS AND JOINTS AS SPECIFIED FOR "RH-4" SYSTEM.

- HIGH POINT VENTS & LOW POINT DRAINS ARE NOT SHOWN.
- VALVES IDENTIFIED AS V268X SHALL CONFORM TO THE REQUIREMENTS OF CONTRACT E-69-4 SPECIFICATION PARA. 3.2.8.8, GROUP A-7 VALVES. WHERE STAINLESS STEEL VALVES ARE FURNISHED BY THE CONTRACTOR UNDER PARA. 3.2.8.8, THE STAINLESS STEEL INTERCONNECTING PIPING SHALL CONFORM TO CONTRACT E-69-4 SPECIFICATION REQUIREMENTS FOR CLASS IIN, RF-15 SYSTEM PIPING.
- DELETED

- WHERE SHOWN WITH NUMBERS, REPRESENT POINTS OF CONNECTION TO EXISTING SYSTEMS, E-73-58 SPECIFICATION DEFINES WORK FROM THIS POINT.
- REF. G.E. DRAWING 11703324 SH. 2 FOR INSTRUMENT PIPING AND VALVE INSTALLATION AT INSTRUMENT RACK 25-62.
- REF. G.E. DRAWING 11703324 SH. 2 FOR INSTRUMENT PIPING AND VALVE INSTALLATION AT INSTRUMENT RACK 25-59.
- DELETED

FOR PREVIOUS REVISIONS, SEE SUPERSEDED CARDS


NO.	DESCRIPTION	DATE	ENG.
AB/19	OR-2014-0008	DUR/05/08	MWJ/MLM

REVISION NUMBER	DATE	BY	CHKD	DATE
1				
2				
3				
4				
5				
6				

COOPER NUCLEAR STATION  
FLOW DIAGRAM  
RESIDUAL HEAT REMOVAL SYS LOOP "B"

2040 SH 2

BURNS & ROE

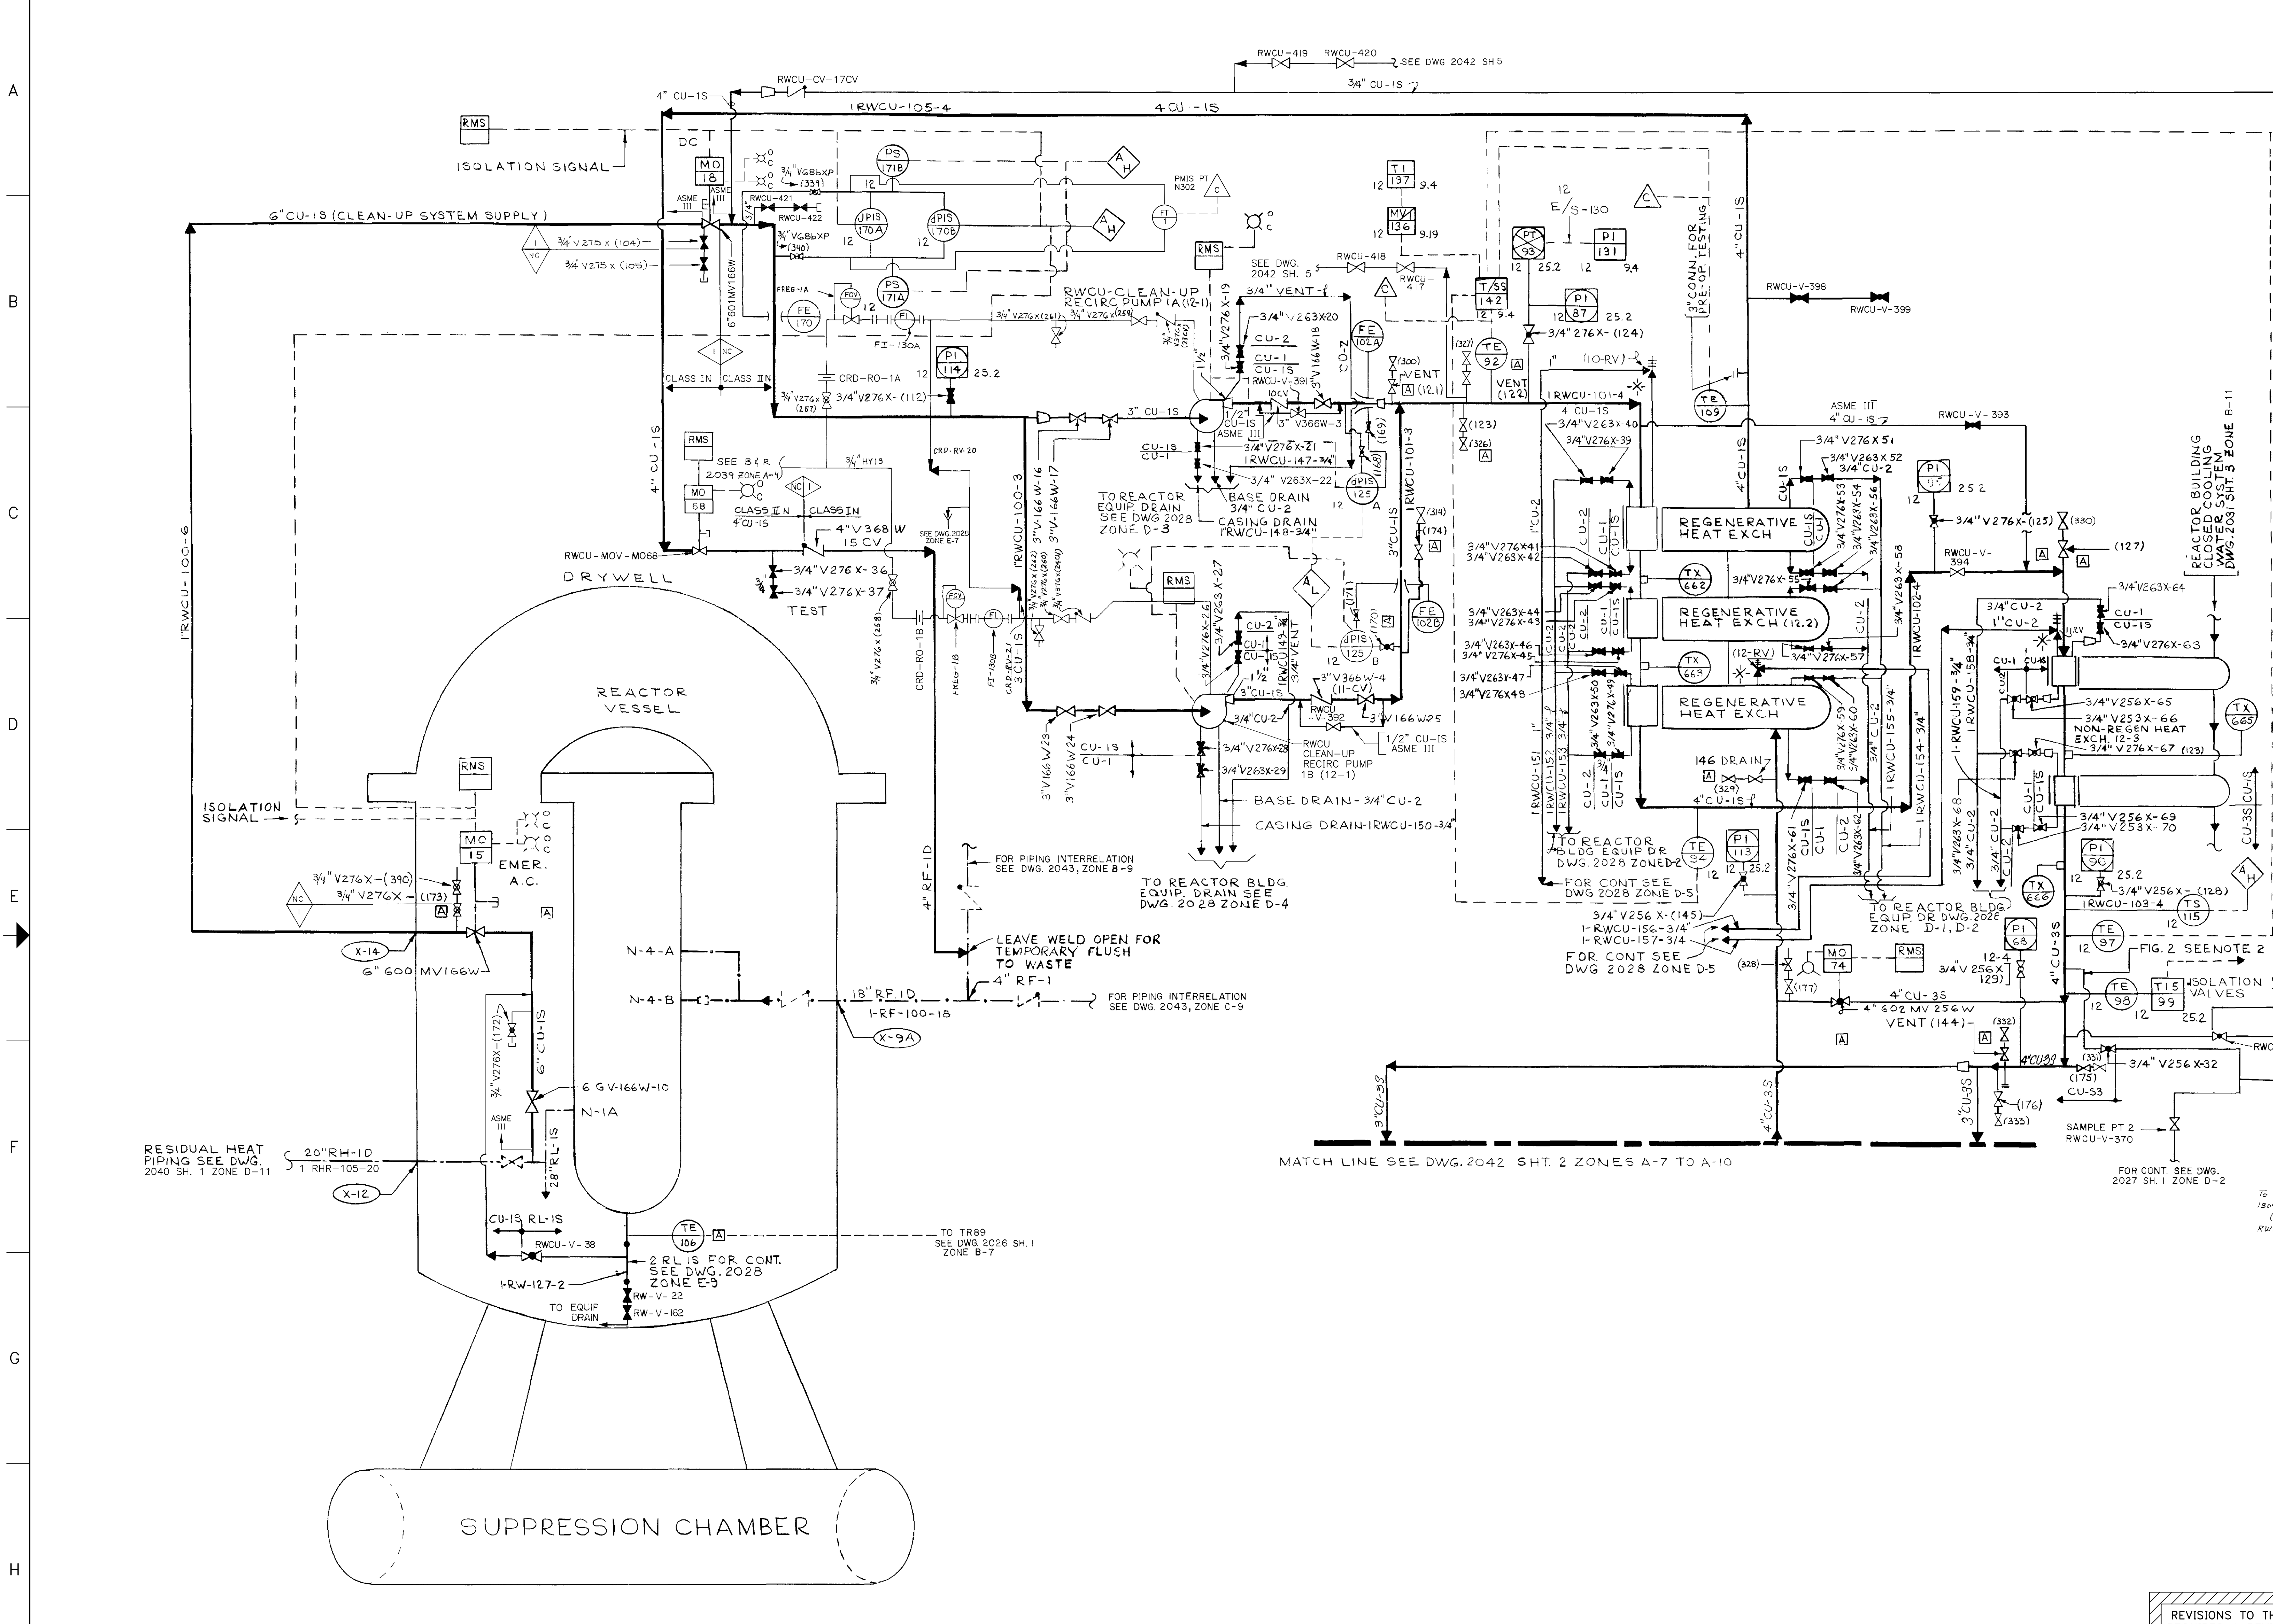

- NOTES:**
- UNLESS OTHERWISE INDICATED ALL PRESSURE AND/OR INSTRUMENT ROOT LINES SHALL BE 3/4" LINE UP TO AND INCLUDING ROOT VALVE SHALL BE FURNISHED AND INSTALLED UNDER CONTRACT E-69-4.
  - AT SAMPLING POINTS CONNECTIONS, PROBES AND ROOT VALVES SHALL BE FURNISHED AND INSTALLED UNDER CONTRACT E-69-4. PROBES SHALL BE FURNISHED AND INSTALLED IN ACCORDANCE WITH CONTRACT PARA. 3.4.2 AND DWG. SP-07211 FIG. NUMBER AS NOTED. CONTINUATION OF SAMPLE PIPING BY E-70-3.
  - ALL "CU-IS" PIPING SHALL BE PER CLASSIFICATION I-N NUCLEAR OR II-N NUCLEAR WITHIN THE LIMITS SHOWN HEREON.
  - TYPICAL DESIGNATION CHANGE FOR "CU" SYSTEM VENT DRAINS WITH DOUBLE VALVING SHALL BE AS SHOWN BELOW:  

CU-3S	CU-1	TO DRAIN OR SUMP
CU-1S	CU-2	
  - ALL "CU-2" DRAIN PIPING TO DRAIN SUMPS SHALL BE FABRICATED PER CLASS II-P CLASSIFICATION WITH MATERIALS AND JOINTS PER CLASS II-N REQUIREMENTS FOR "CU-2" SYSTEM.
  - FLANGES FOR REMOTE REMOVAL TO BE FURNISHED ON F/D PIPING.
  - HIGH POINT VENTS & LOW POINT DRAINS NOT SHOWN.
  - ALL VALVE NUMBERS IN PARENTHESES ( ) ARE NUMBERS USED IN OPERATING PROCEDURES. THESE NUMBERS ARE ASSIGNED BY N.P.P.D. AND WILL NOT BE SHOWN ON PIPING DRAWINGS.
  - INSTRUMENT, SAMPLE, TEST, DRAIN, AND VENT LINES ARE NOT ALWAYS THE SAME CLASS AS THE MAIN LINE AND THESE BOUNDARIES ARE TOO NUMEROUS TO IDENTIFY IN THIS MANNER (SEE 1ST PROGRAM BOUNDARY DESCRIPTIONS FOR DETAILS).
  - WHERE LINES ARE INTERCONNECTED AND CONTINUED ON OTHER DRAWINGS, ZONE NUMBERS ARE APPROXIMATE ONLY.

**NOTE:**  
ALL ITEMS MARKED THUS [A] ARE "AS BUILT" ITEMS ARE NOT SHOWN ON PIPING DWGS.


REVISIONS TO THIS DRAWING REQUIRES A REVISION TO THE CORRESPONDING ISOKEY.

**AS BUILT**  
454003635

FOR PREVIOUS REVISIONS, SEE SUPERSEDED CARDS.		SIGNIFICANT NUMBER		DRAWN		DATE	
VERSIONS/REVISIONS BY N.P.P.D.		GROUP		BMR		11-20-00	
NO.	DESCRIPTION	DFT	DATE	ENG	CHECKED	DATE	
AB/38	DR-2017-0342						
BC/31	DR-2018-0043						
COOPER NUCLEAR STATION FLOW DIAGRAM REACTOR WATER CLEAN-UP SYSTEM				BURNS & ROE			
2042 SH 1				FILMED			

NOTE 1 - SEE DETAIL "A" SHEET 4  
 NOTE 2 - SEE DETAIL "B" SHEET 4

MATCHLINE SEE DWG 2042 SH 1 ZONES F-7 TO F-10

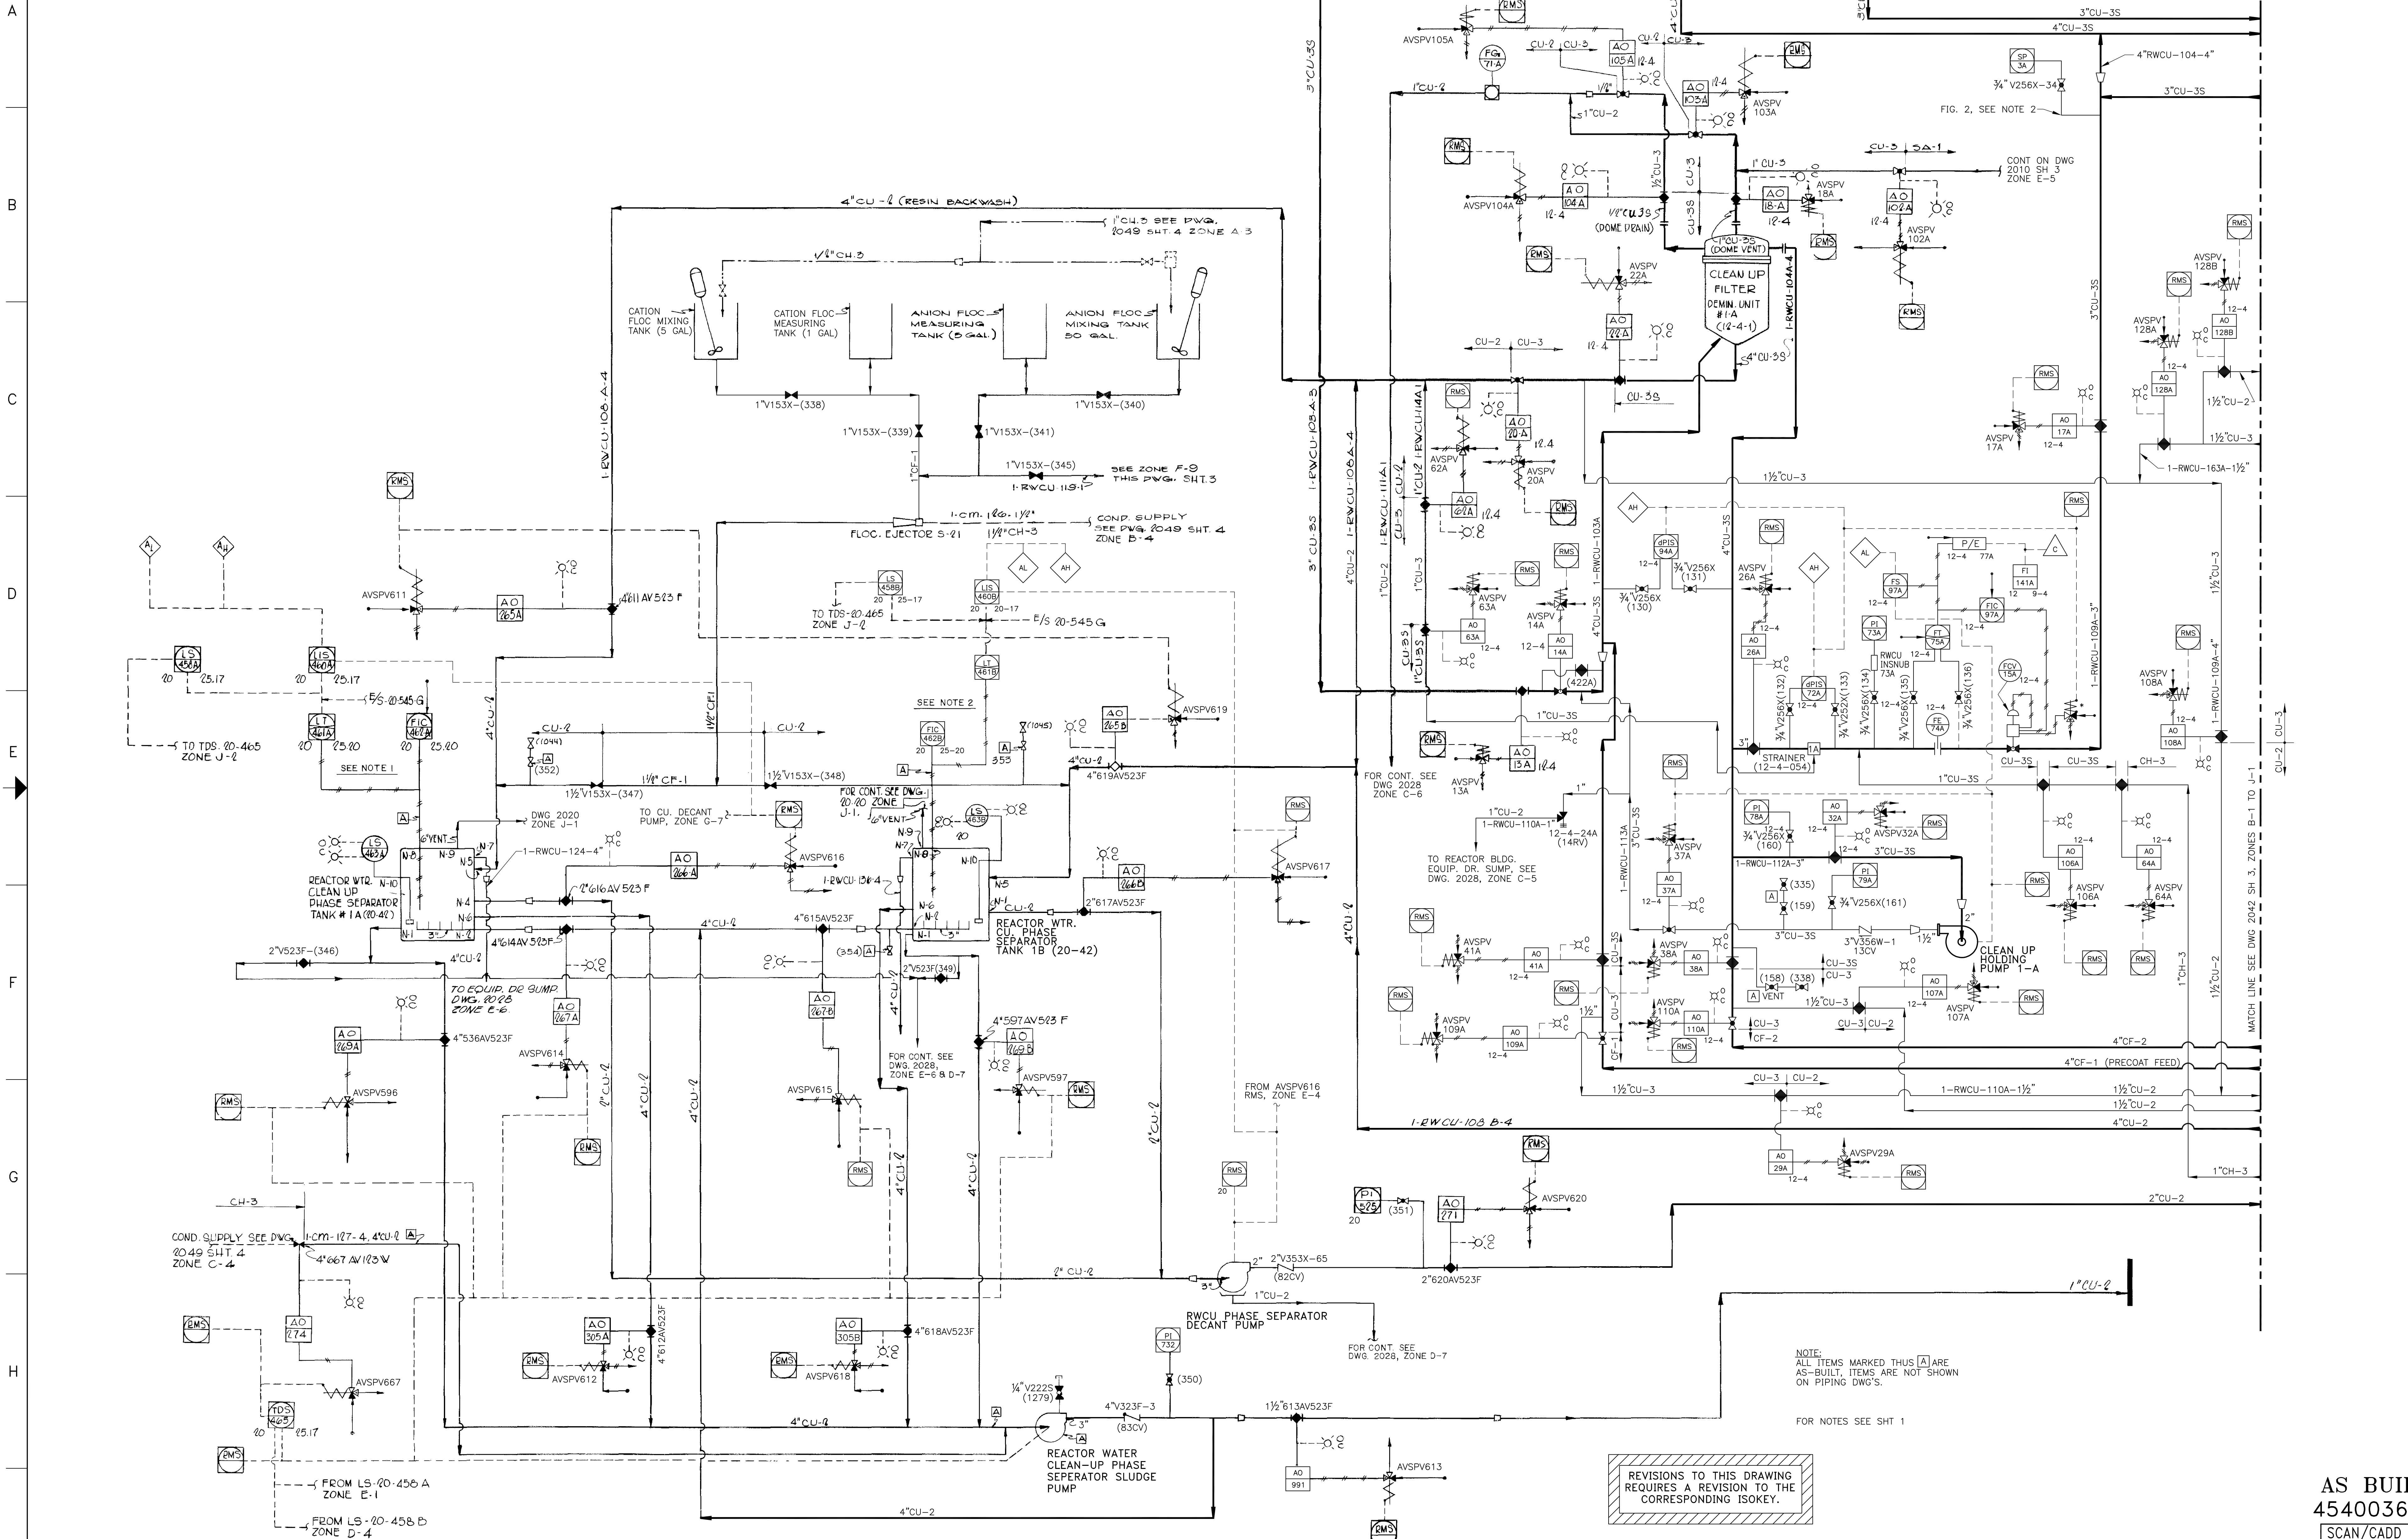

REVISIONS TO THIS DRAWING  
 REQUIRES A REVISION TO THE  
 CORRESPONDING ISOKEY.

NOTE:  
 ALL ITEMS MARKED THUS [A] ARE  
 AS-BUILT. ITEMS ARE NOT SHOWN  
 ON PIPING DWG'S.  
 FOR NOTES SEE SH 1

AS BUILT  
 454003683  
 SCAN/CADD DWG  
 DO NOT REVISE MANUALLY


FOR PREVIOUS REVISIONS, SEE SUPERSEDED CARDS.

NO.	REVISIONS	BY	DATE
N10	DCR 3-40217 (DCN 02-0757)	HPT RGA	KG 9/20/02
N11	DCR 03-1389	RGA TRGA	KG 10/27/03
N12	DCR 6017860 (DCN 05-0782)	RGA KG	DLR 12/24/08
N13	DCR 2141515 (DCN 07-1247)	DJB KG	DLR 06/26/09
N14	DCR 2009-06841 (DCN 09-1233)	DJB KG	RPL 11/4/09
N15	DCR 6014761 (DCN 09-1468)	DJB RPL	11/14/09

SIGNIFICANT NUMBER	GROUP	1	2	3	4	5	6
COOPER NUCLEAR STATION FLOW DIAGRAM REACTOR WATER CLEAN UP SYSTEM							
DATE	07/25/02						
CHECKED							
APPROVED							
FILED							
DATE							
REVISION							
NO.	2042 SH 2	N15					

BURNS & ROE

NO.	REVISIONS

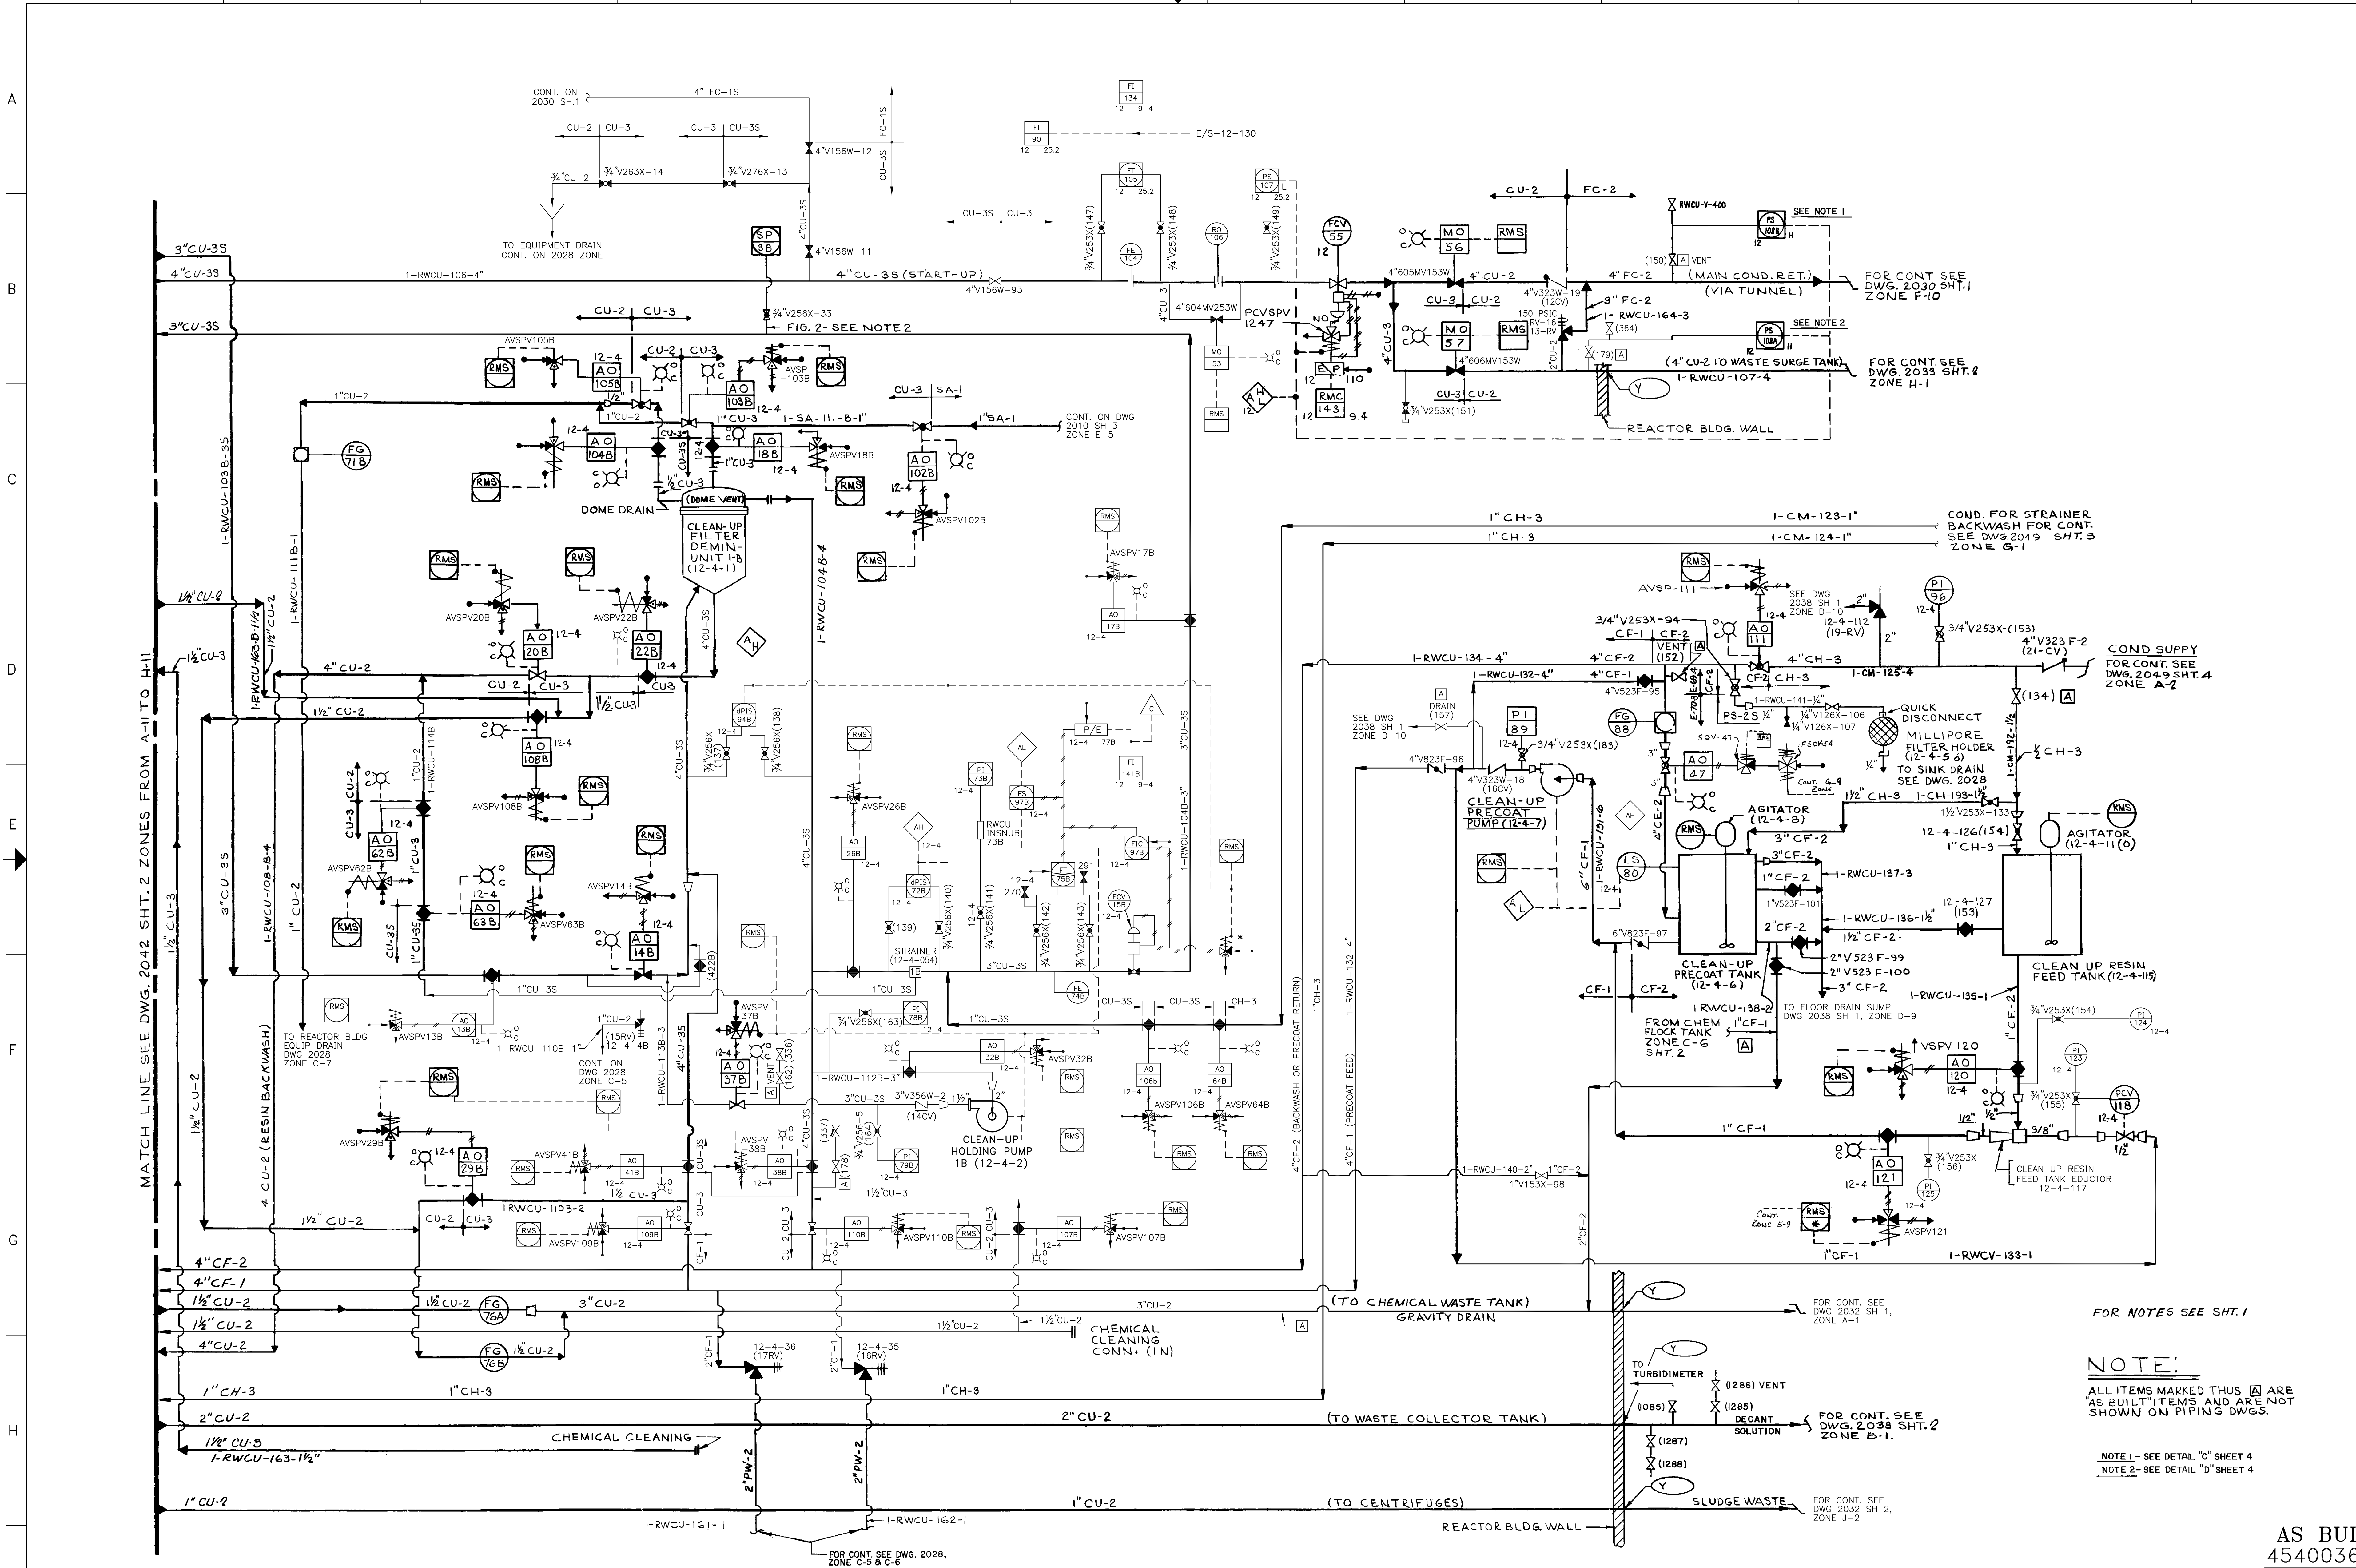

**NOTE:**  
 ALL ITEMS MARKED WITH  $\square$  ARE  
 "AS BUILT" ITEMS AND ARE NOT  
 SHOWN ON PIPING DWGS.

NOTE 1 - SEE DETAIL "C" SHEET 4  
 NOTE 2 - SEE DETAIL "D" SHEET 4

REVISIONS TO THIS DRAWING  
 REQUIRES A REVISION TO THE  
 CORRESPONDING ISOKEY.

FOR PREVIOUS REVISIONS, SEE SUPERSEDED CARDS.

VERSIONS/REVISIONS BY N.P.P.D.			
NO.	DESCRIPTION	DFT DATE	ENG
AB/22	DR-2017-0001	DJR 04/03/18	KASCHIZ

SIGNIFICANT NUMBER		DATE	
GROUP	NO.	DATE	BY
1	1	08/21/02	PAM
2	2		
3	3		
4	4		
5	5		
6	6		


COOPER NUCLEAR STATION  
 FLOW DIAGRAM  
 REACTOR WATER  
 CLEAN UP SYSTEM

APPROVED: **BURNS & ROE**  
 DATE: 08/21/02

2042 SH 3

**AS BUILT**  
 454003684

STATUS: Release  
 STATUS DATE: 04/03/2018  
 DS APPROVED: KASCHIZ  
 VER: AB REV: 22 SIZE: F

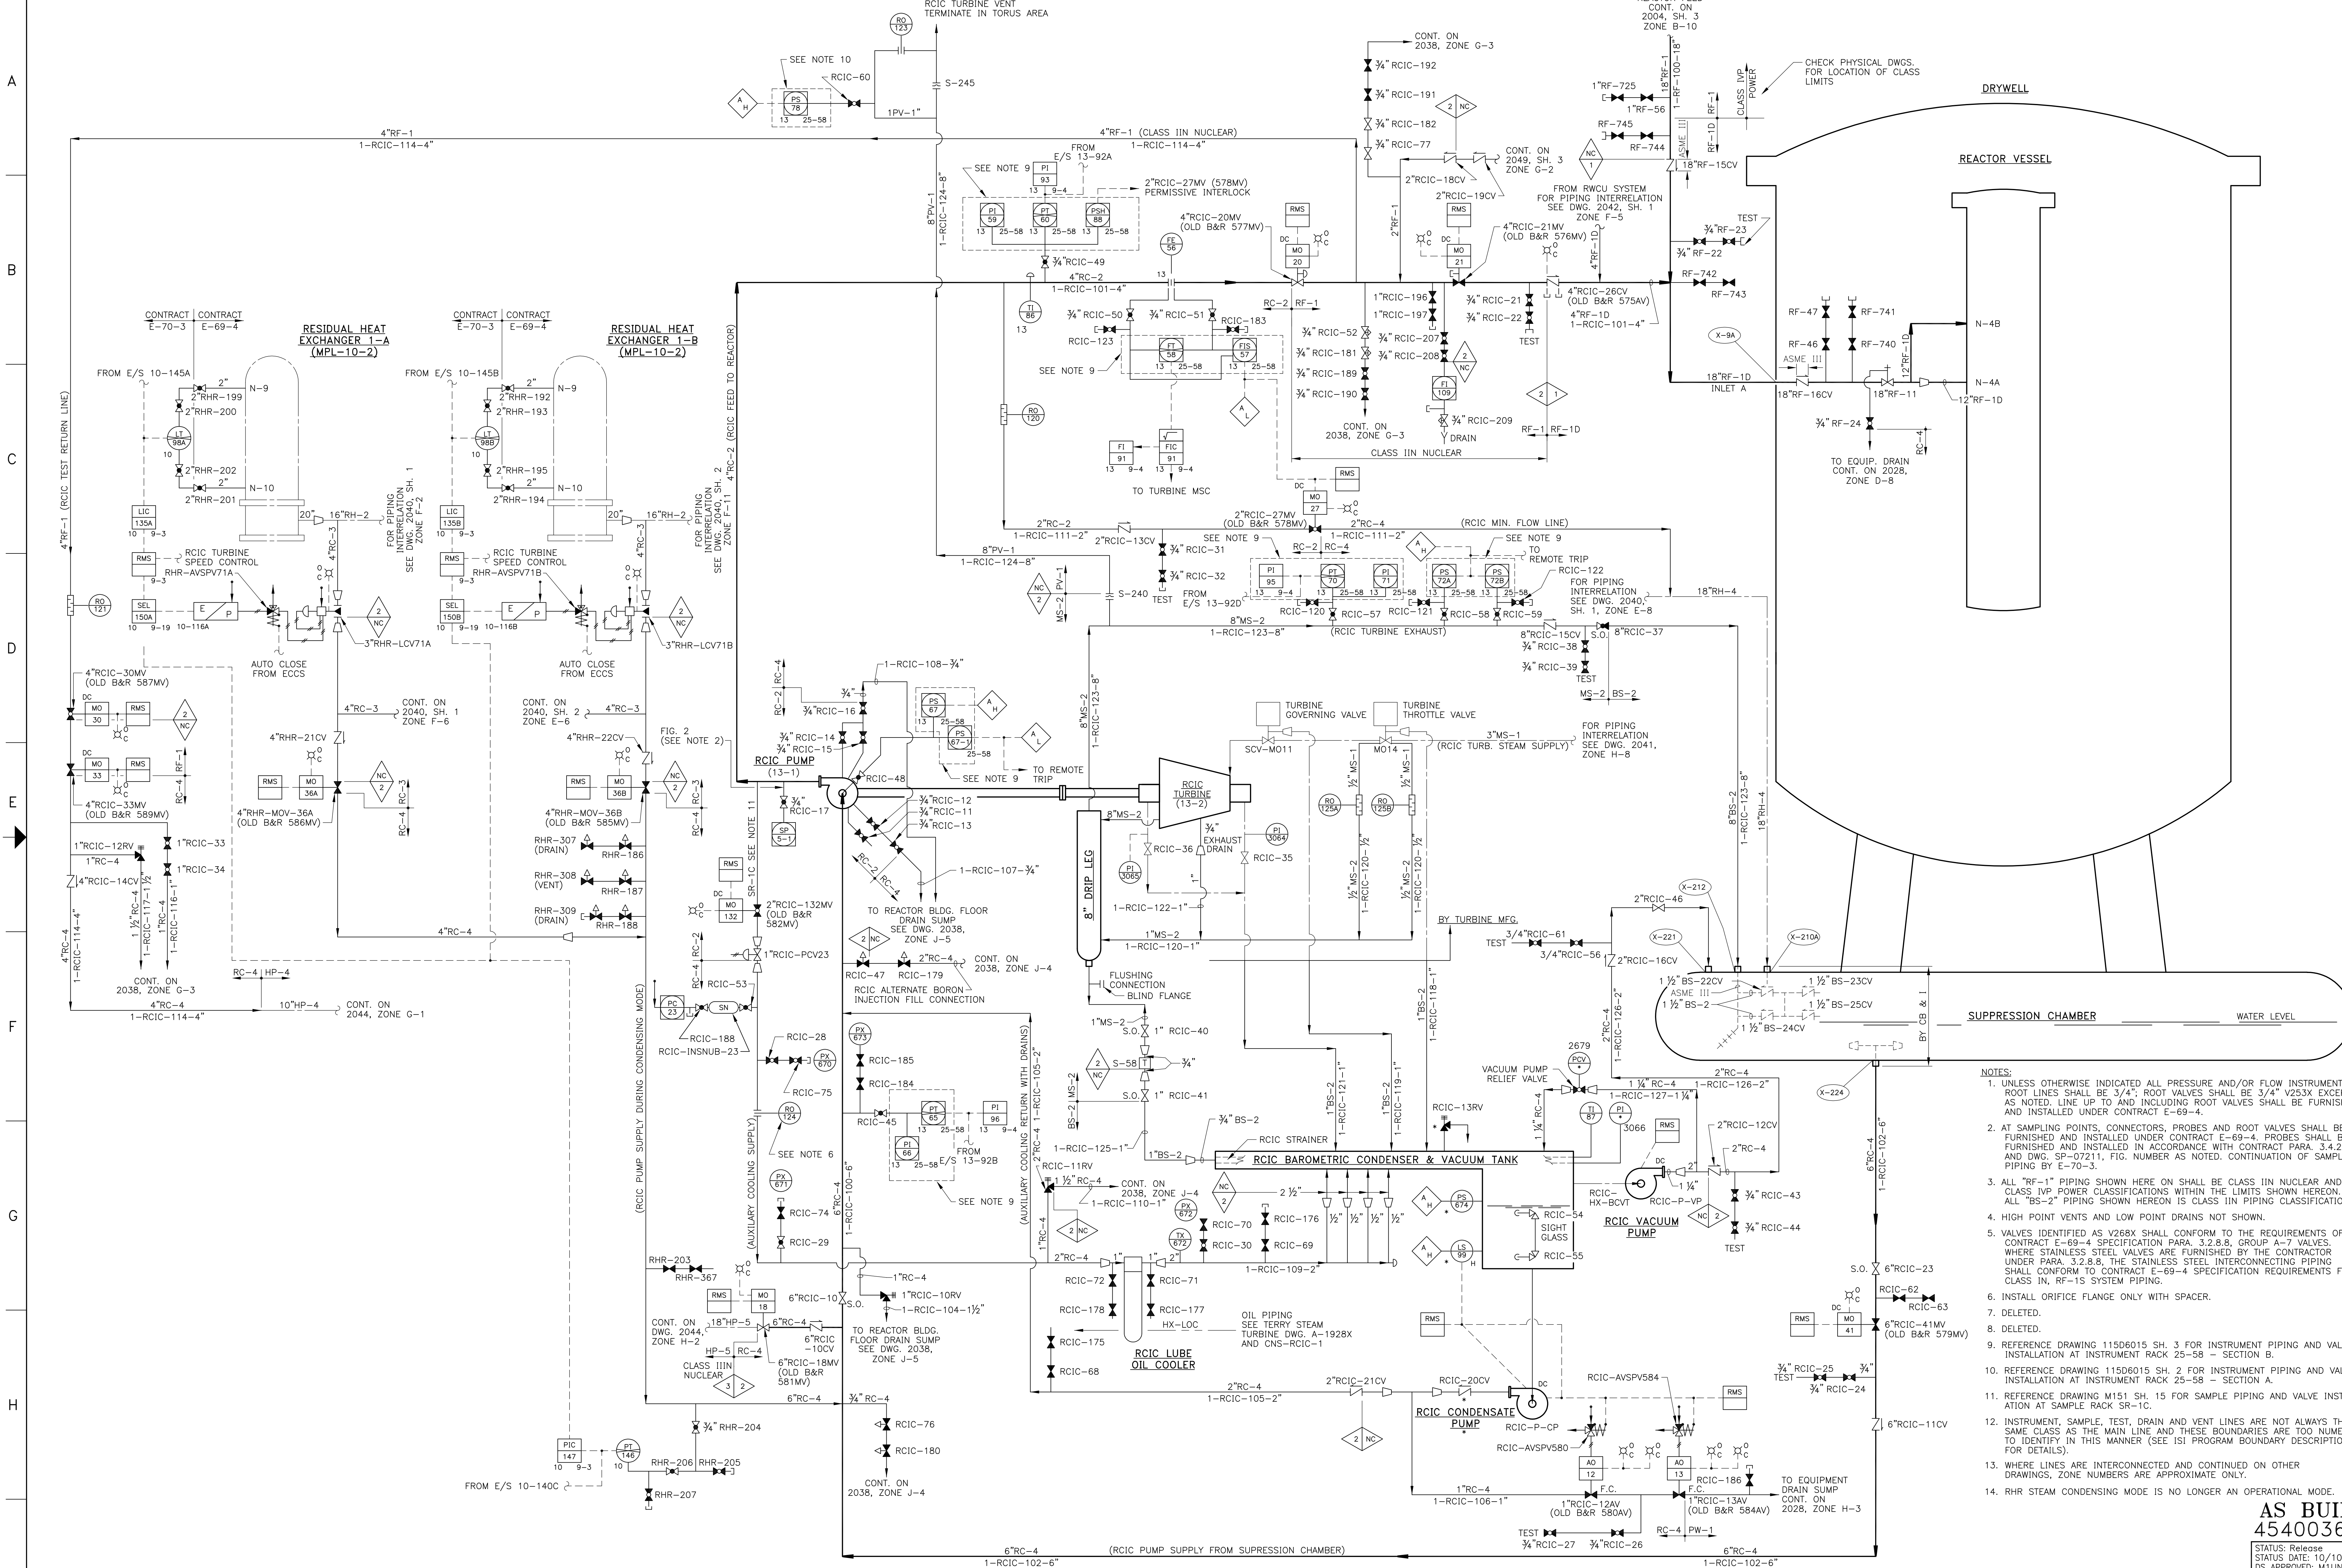

- NOTES:
- UNLESS OTHERWISE INDICATED ALL PRESSURE AND/OR FLOW INSTRUMENT ROOT LINES SHALL BE 3/4"; ROOT VALVES SHALL BE 3/4" V253X EXCEPT AS NOTED. LINE UP TO AND INCLUDING ROOT VALVES SHALL BE FURNISHED AND INSTALLED UNDER CONTRACT E-69-4.
  - AT SAMPLING POINTS, CONNECTORS, PROBES AND ROOT VALVES SHALL BE FURNISHED AND INSTALLED IN ACCORDANCE WITH CONTRACT PARA. 3.4.2 AND DWG. SP-07211. FIG. NUMBER AS NOTED. CONTINUATION OF SAMPLE PIPING BY E-70-3.
  - ALL "RF-1" PIPING SHOWN HERE ON SHALL BE CLASS IIN NUCLEAR AND CLASS IVP POWER CLASSIFICATIONS WITHIN THE LIMITS SHOWN HEREON. ALL "BS-2" PIPING SHOWN HEREON IS CLASS IIN PIPING CLASSIFICATION.
  - HIGH POINT VENTS AND LOW POINT DRAINS NOT SHOWN.
  - VALVES IDENTIFIED AS V268X SHALL CONFORM TO THE REQUIREMENTS OF CONTRACT E-69-4 SPECIFICATION PARA. 3.2.8.8, GROUP A-7 VALVES. WHERE STAINLESS STEEL VALVES ARE FURNISHED BY THE CONTRACTOR UNDER PARA. 3.2.8.8, THE STAINLESS STEEL INTERCONNECTING PIPING SHALL CONFORM TO CONTRACT E-69-4 SPECIFICATION REQUIREMENTS FOR CLASS IIN, RF-1S SYSTEM PIPING.
  - INSTALL ORIFICE FLANGE ONLY WITH SPACER.
  - DELETED.
  - DELETED.
  - REFERENCE DRAWING 115D6015 SH. 3 FOR INSTRUMENT PIPING AND VALVE INSTALLATION AT INSTRUMENT RACK 25-58 - SECTION B.
  - REFERENCE DRAWING 115D6015 SH. 2 FOR INSTRUMENT PIPING AND VALVE INSTALLATION AT INSTRUMENT RACK 25-58 - SECTION A.
  - REFERENCE DRAWING M151 SH. 15 FOR SAMPLE PIPING AND VALVE INSTALLATION AT SAMPLE RACK SR-1C.
  - INSTRUMENT, SAMPLE, TEST, DRAIN AND VENT LINES ARE NOT ALWAYS THE SAME CLASS AS THE MAIN LINE AND THESE BOUNDARIES ARE TOO NUMEROUS TO IDENTIFY IN THIS MANNER (SEE ISI PROGRAM BOUNDARY DESCRIPTIONS FOR DETAILS).
  - WHERE LINES ARE INTERCONNECTED AND CONTINUED ON OTHER DRAWINGS, ZONE NUMBERS ARE APPROXIMATE ONLY.
  - RHR STEAM CONDENSING MODE IS NO LONGER AN OPERATIONAL MODE.


REVISIONS TO THIS DRAWING  
REQUIRES A REVISION TO THE  
CORRESPONDING ISOKEY.

FOR PREVIOUS REVISIONS, SEE SUPERSEDED CARDS.  
VERSIONS/REVISIONS BY N.P.P.D.

NO.	DESCRIPTION	DFT	DATE	ENG
1	AS BUILT	DLB	07/28/1980	CHADLER
2	REVISED	DLB	07/28/1980	CHADLER
3	REVISED	DLB	07/28/1980	CHADLER

SIGNIFICANT NUMBER		DRAWN		DATE	
1	2	3	4	5	6
COOPER NUCLEAR STATION FLOW DIAGRAM REACTOR CORE ISOLATION COOLANT AND REACTOR FEED SYSTEMS					
CHECKED		DATE		BURNS & ROE	
APPROVED		DATE		2043	
FILMED		DATE		2043	

STATUS: Release  
STATUS DATE: 10/10/2018  
DS APPROVED: M1UNRUH  
VER: AB REV: 57 SIZE: F

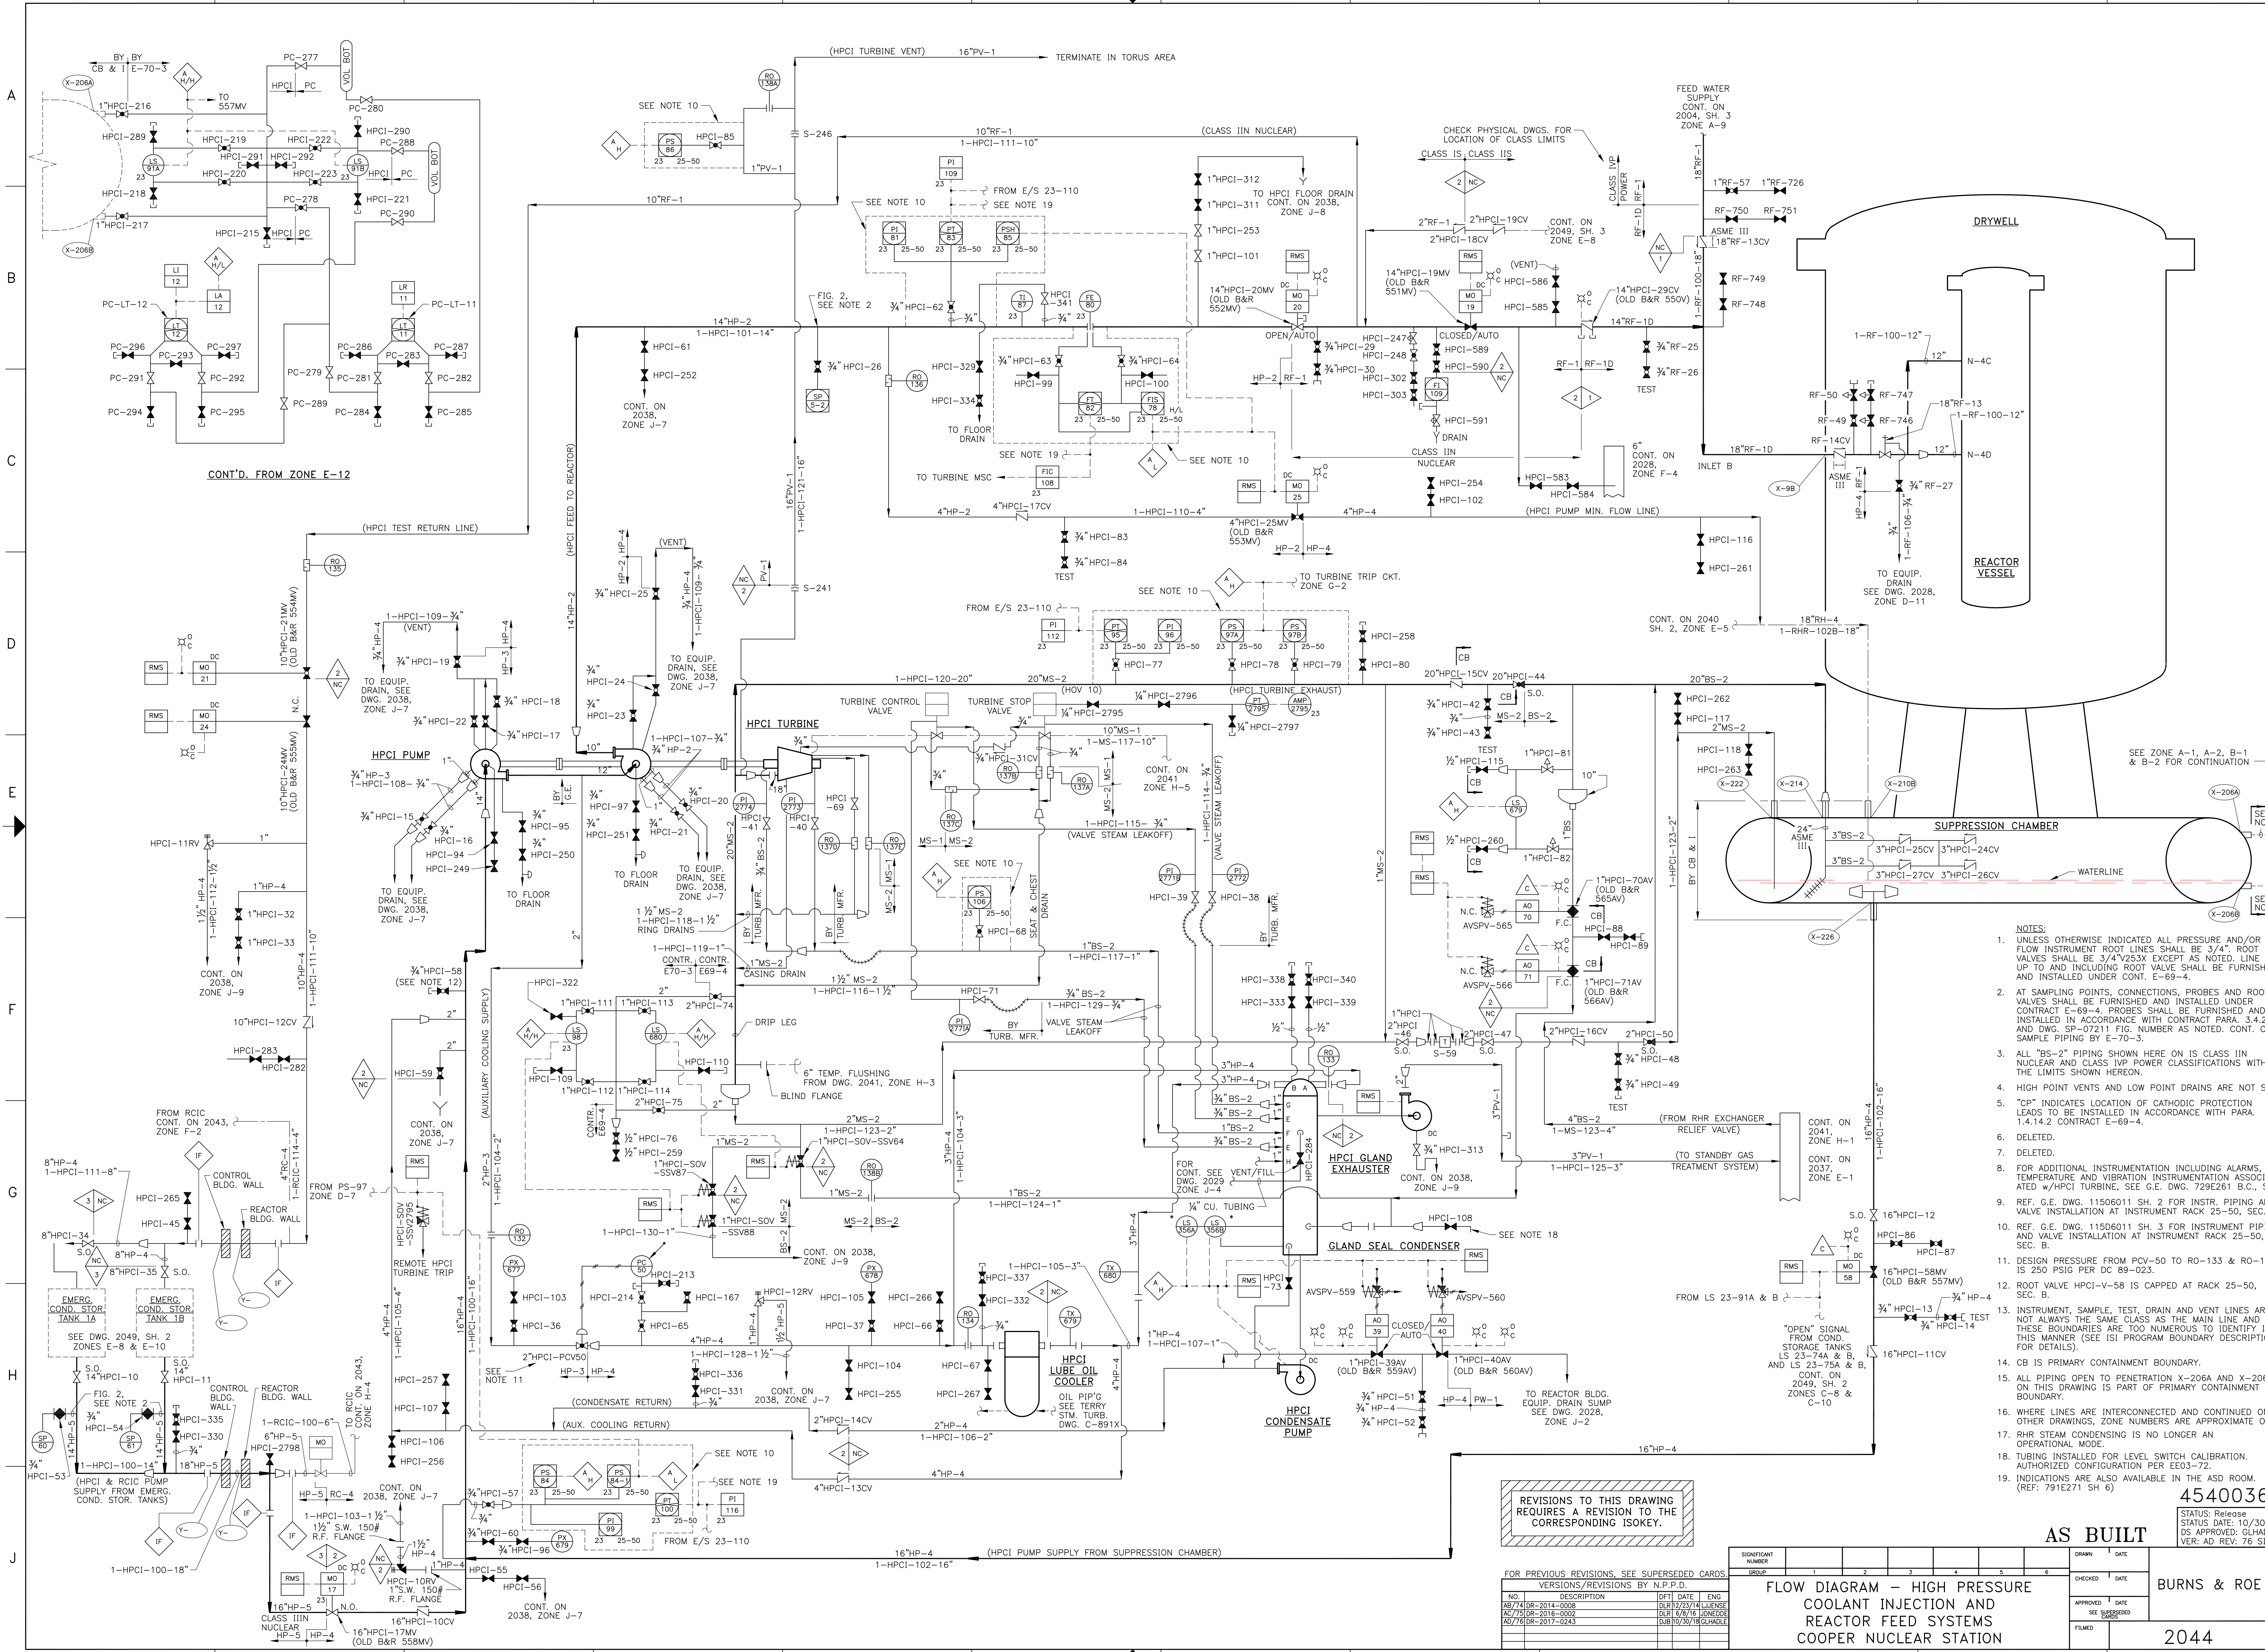

- NOTES:
- UNLESS OTHERWISE INDICATED ALL PRESSURE AND/OR FLOW INSTRUMENT ROOT LINES SHALL BE 3/4". ROOT VALVES SHALL BE 3/4" V253X EXCEPT AS NOTED. LINE UP TO AND INCLUDING ROOT VALVE SHALL BE FURNISHED AND INSTALLED UNDER CONTRACT E-69-4.
  - AT SAMPLING POINTS, CONNECTIONS, PROBES AND ROOT VALVES SHALL BE FURNISHED AND INSTALLED IN ACCORDANCE WITH CONTRACT PARA. 3.4.2 AND DWG. SP-07211 FIG. NUMBER AS NOTED. CONT. OF SAMPLE PIPING IS E-70-3.
  - ALL "BS-2" PIPING SHOWN HERE ON IS CLASS IIN NUCLEAR AND CLASS IVP POWER CLASSIFICATIONS WITHIN THE LIMITS SHOWN HEREON.
  - HIGH POINT VENTS AND LOW POINT DRAINS ARE NOT SHOWN.
  - "CP" INDICATES LOCATION OF CATHODIC PROTECTION LEADS TO BE INSTALLED IN ACCORDANCE WITH PARA. 1.4.14.2 CONTRACT E-69-4.
  - DELETED.
  - DELETED.
  - FOR ADDITIONAL INSTRUMENTATION INCLUDING ALARMS, TEMPERATURE AND VIBRATION INSTRUMENTATION ASSOCIATED W/HPCI TURBINE, SEE G.E. DWG. 7292561 B.C., SH. 2.
  - REF. G.E. DWG. 1150611 SH. 2 FOR INSTR. PIPING AND VALVE INSTALLATION AT INSTRUMENT RACK 25-50, SEC. A.
  - REF. G.E. DWG. 1150611 SH. 3 FOR INSTRUMENT PIPING AND VALVE INSTALLATION AT INSTRUMENT RACK 25-50, SEC. B.
  - DESIGN PRESSURE FROM PCV-50 TO RO-133 & RO-134 IS 250 PSIG PER DC 89-023.
  - ROOT VALVE HPCI-V-58 IS CAPPED AT RACK 25-50, SEC. B.
  - INSTRUMENT, SAMPLE, TEST, DRAIN AND VENT LINES ARE NOT ALWAYS THE SAME CLASS AS THE MAIN LINE AND THESE BOUNDARIES ARE TOO NUMEROUS TO IDENTIFY IN THIS MANNER (SEE ISI PROGRAM BOUNDARY DESCRIPTIONS FOR DETAILS).
  - CB IS PRIMARY CONTAINMENT BOUNDARY.
  - ALL PIPING OPEN TO PENETRATION X-206A AND X-206B ON THIS DRAWING IS PART OF PRIMARY CONTAINMENT BOUNDARY.
  - WHERE LINES ARE INTERCONNECTED AND CONTINUED ON OTHER DRAWINGS, ZONE NUMBERS ARE APPROXIMATE ONLY.
  - RHR STEAM CONDENSING IS NO LONGER AN OPERATIONAL MODE.
  - TUBING INSTALLED FOR LEVEL SWITCH CALIBRATION. AUTHORIZED CONFIGURATION PER E03-72.
  - INDICATIONS ARE ALSO AVAILABLE IN THE ASD ROOM. (REF: 791E271 SH 6)

REVISIONS TO THIS DRAWING  
REQUIRES A REVISION TO THE  
CORRESPONDING ISOKEY.

FOR PREVIOUS REVISIONS, SEE SUPERSEDED CARDS.

VERSIONS/REVISIONS BY N.P.P.D.			
NO.	DESCRIPTION	DFT DATE	ENG
18/74	DR-2014-0008	08/27/23	JA
18/75	DR-2014-0009	08/27/23	JA
18/76	DR-2017-0243	08/27/23	JA

454003637

STATUS: Release  
STATUS DATE: 10/30/2018  
DS APPROVED: GLHADDE  
VER: AD REV: 76 SIZE: F


**AS BUILT**

SIGNATURE	DATE	DATE	DATE
DESIGNED	1	2	3
CHECKED	4	5	6
APPROVED	7	8	9
FILED	10	11	12

**BURNS & ROE**

2044

FLOW DIAGRAM - HIGH PRESSURE  
COOLANT INJECTION AND  
REACTOR FEED SYSTEMS  
COOPER NUCLEAR STATION

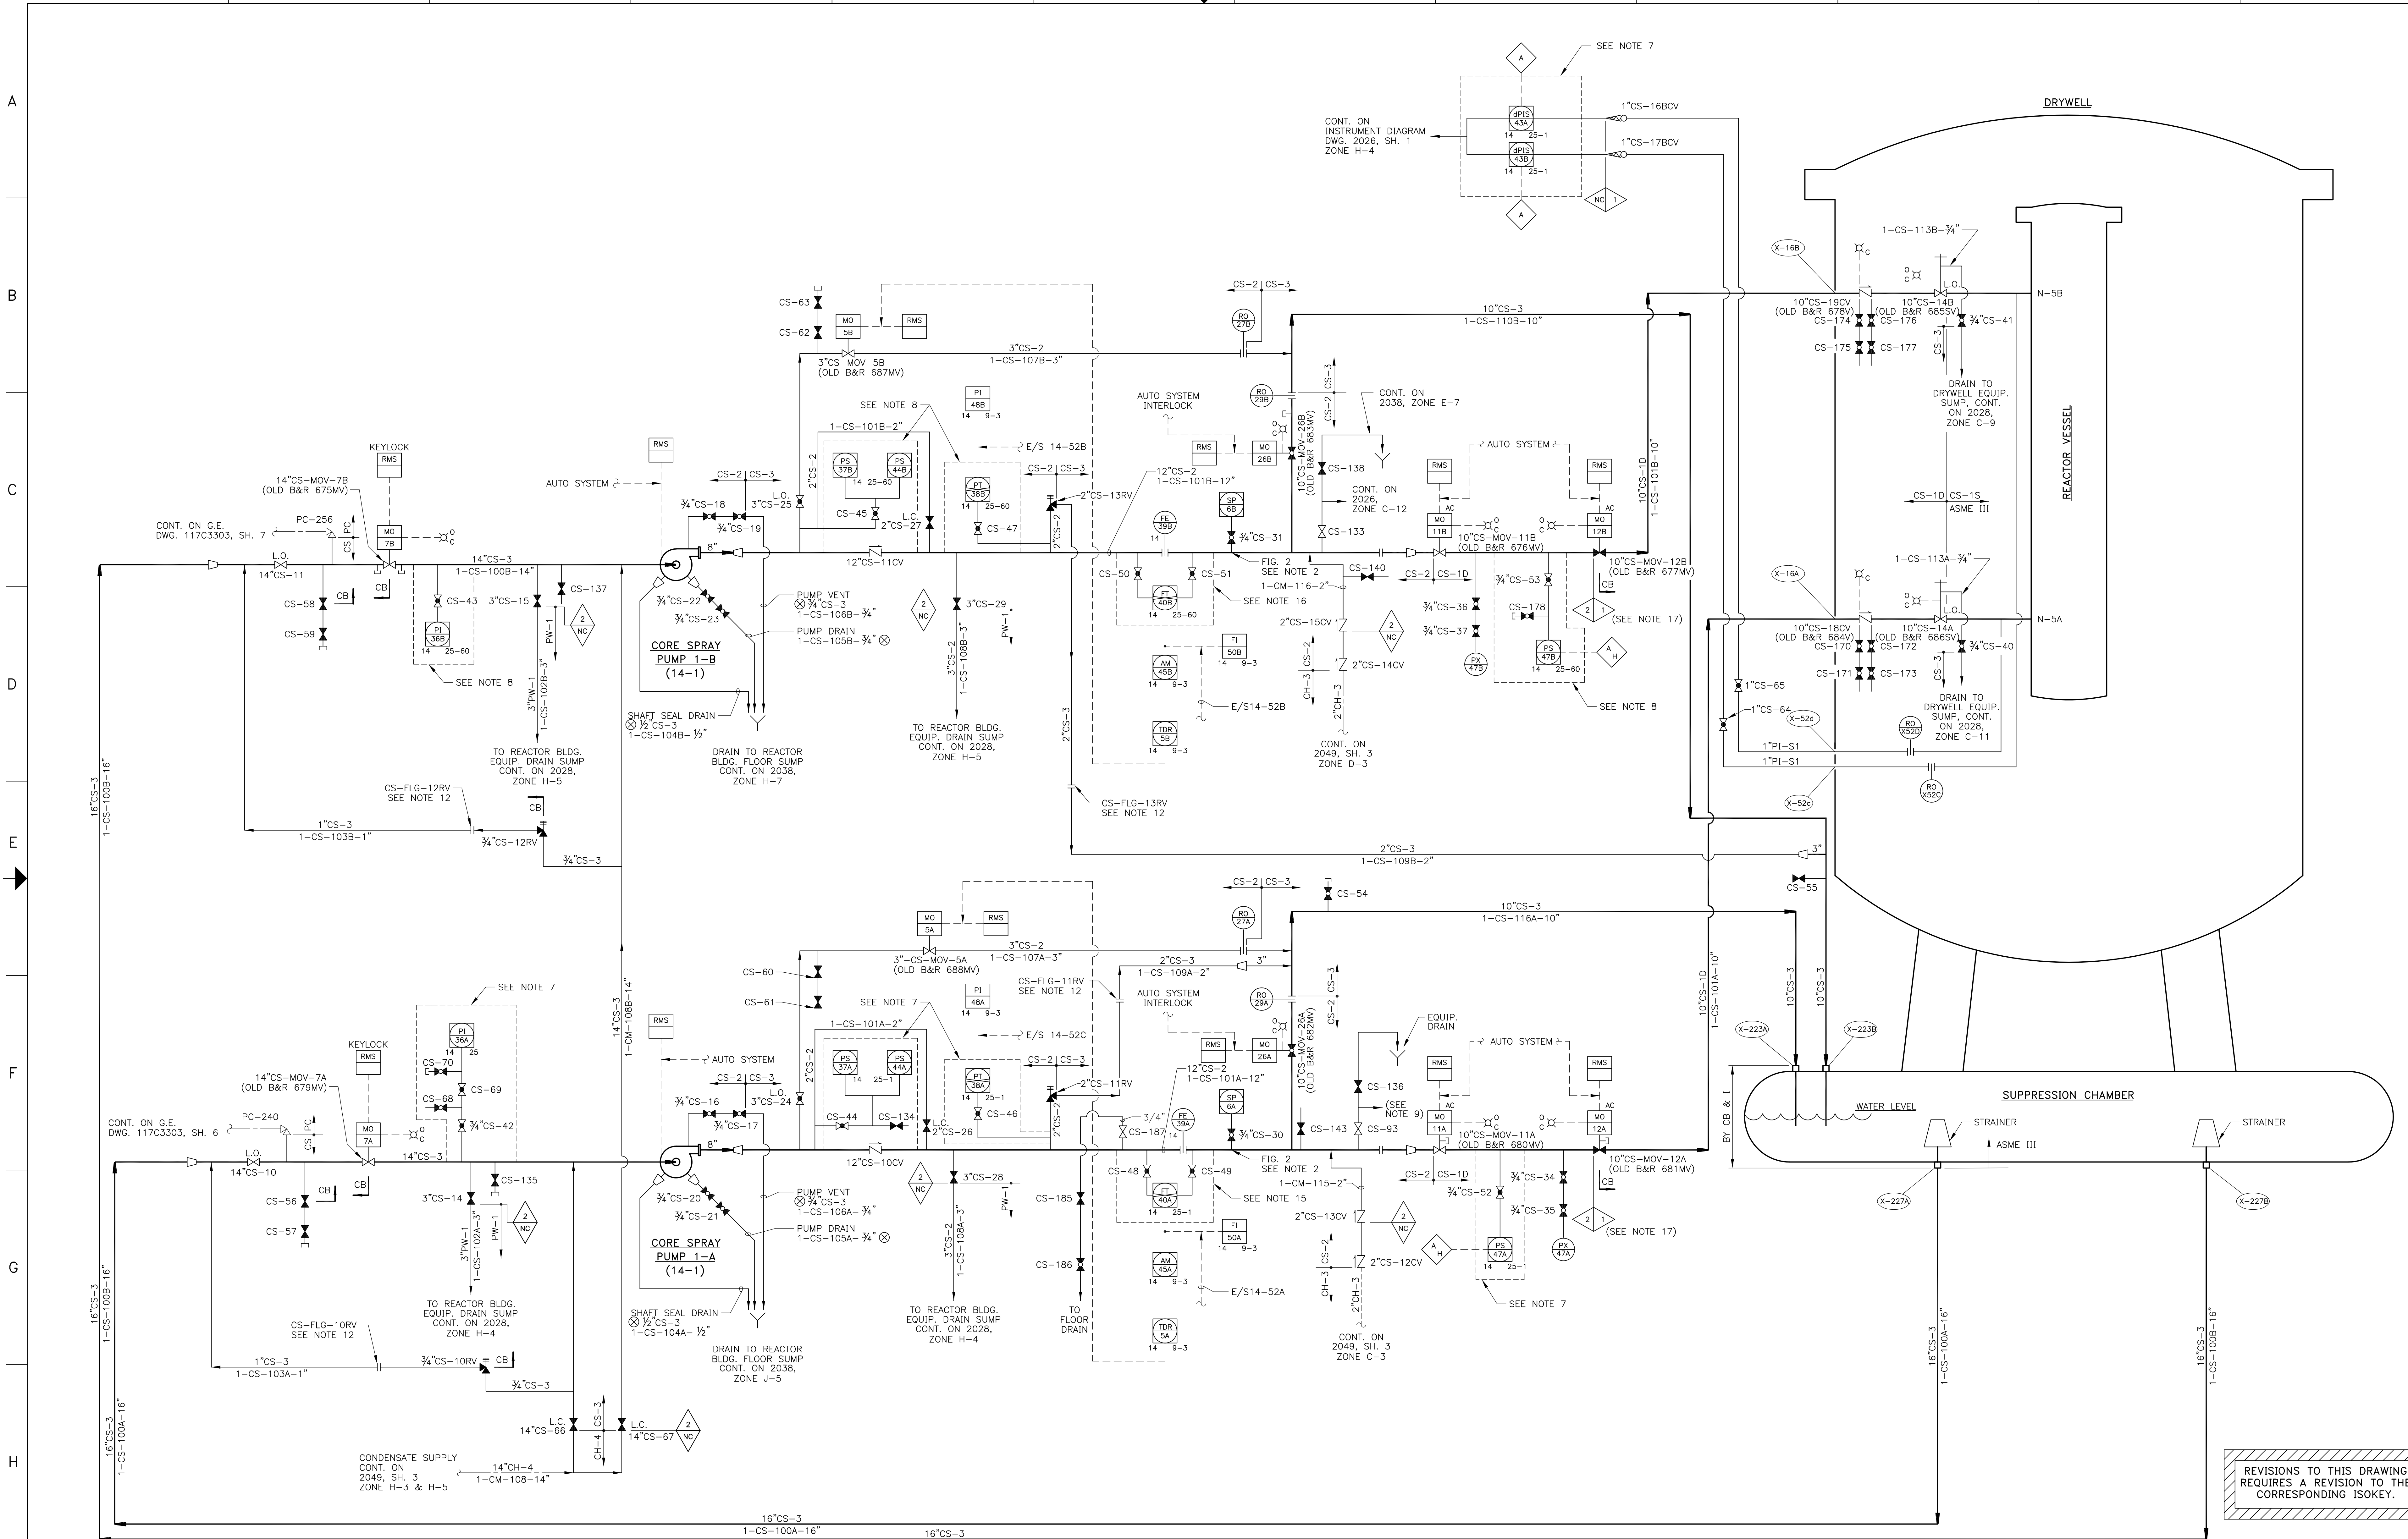

**NOTES:**

- UNLESS OTHERWISE INDICATED ALL PRESSURE AND/OR FLOW INSTRUMENT ROOT VALVES SHALL BE 3/4" ROOT VALVES SHALL BE 3/4" V25X3 LINE UP TO AND INCLUDING ROOT VALVE SHALL BE FURNISHED AND INSTALLED UNDER CONTRACT E-69-4.
- AT SAMPLING POINTS, CONNECTIONS, PROBES AND ROOT VALVES SHALL BE FURNISHED AND INSTALLED UNDER CONTRACT E-69-4. PROBES SHALL BE FURNISHED AND INSTALLED IN ACCORDANCE WITH CONTRACT PARA. 3.42 AND DRAWING SP-07211, FIG. NUMBER AS NOTED.
- CONTINUATION OF SAMPLE PIPING BY E-70-3.
- ALL CS-3 PIPING SYSTEMS SHALL BE CLASS III IN CLASSIFICATION, EXCEPT THAT "O" CS-3 PIPING 2" NOMINAL SIZE AND SMALLER WHICH CONNECTS TO/OR DRAINS INTO FLOOR DRAIN OR EQUIPMENT DRAIN SUMPS SHALL BE CLASS IVP CLASSIFICATION WITH MATERIALS AND JOINTS AS SPECIFIED FOR "CS-3" CLASS IN CLASSIFICATION.
- HIGH POINT VENTS & LOW POINT DRAINS ARE NOT SHOWN.
- VALVES IDENTIFIED AS V26X8 SHALL CONFORM TO THE REQUIREMENTS OF CONTRACT E-69-4 SPECIFICATION PARA. 3.2.8.8, GROUP A-7 VALVES WHERE STAINLESS STEEL VALVES ARE FURNISHED BY THE CONTRACTOR UNDER PARA. 3.2.8.8, THE STAINLESS STEEL INTERCONNECTING PIPING SHALL CONFORM TO CONTRACT E-69-4 SPECIFICATION REQUIREMENTS FOR CLASS IN, RF-IS SYSTEM PIPING.
- DELETED.
- REFERENCE G.E. DRAWING 117C3303, SH. 2 FOR INSTRUMENT PIPING AND VALVE INSTALLATION AT INSTRUMENT RACK 25-1.
- REFERENCE G.E. DRAWING 117C3325, SH. 2 FOR INSTRUMENT PIPING AND VALVE INSTALLATION AT INSTRUMENT RACK 25-60.
- FOR CONTINUATION SEE INSTRUMENT DIAGRAM DRAWING 2026, SH. 1, C-1.
- DELETED.
- FOR STANDBY LIQUID CONTROL SYSTEM FLOW DIAGRAM SEE FLOW DRAWINGS 2045, SH. 2.
- TESTABLE FLANGES.
- INSTRUMENT, SAMPLE, TEST, DRAIN AND VENT LINES ARE NOT ALWAYS THE SAME CLASS AS THE MAIN LINE AND THESE BOUNDARIES ARE TOO NUMEROUS TO IDENTIFY IN THIS MANNER (SEE ISI PROGRAM BOUNDARY DESCRIPTIONS FOR DETAILS).
- CB IS PRIMARY CONTAINMENT BOUNDARY.
- REFERENCE DRAWING 2045, SH. 3, DETAIL "A" FOR INSTRUMENT PIPING AND VALVE INSTALLATION AT INSTRUMENT RACK 25-1.
- REFERENCE DRAWING 2045, SH. 3, DETAIL "B" FOR INSTRUMENT PIPING AND VALVE INSTALLATION AT INSTRUMENT RACK 25-60.
- PER DC 94-330, PIPING BETWEEN MO-11A(B) AND MO-12A(B) IS RECLASSIFIED AS IIN. HOWEVER, EXISTING CS-10 PIPING IN THIS ZONE IS FABRICATED AND DESIGNED TO CLASS IN REQUIREMENTS.
- WHERE LINES ARE INTERCONNECTED AND CONTINUED ON OTHER DRAWINGS, ZONE NUMBERS ARE APPROXIMATE.

REVISIONS TO THIS DRAWING  
REQUIRES A REVISION TO THE  
CORRESPONDING ISOKEY.


**AS BUILT**  
454003638

FOR PREVIOUS REVISIONS, SEE SUPERSEDED CARDS.						SIGNIFICANT REVISIONS BY N.P.P.D.						DRAWN		DATE		
NO.	REVISIONS	DFT	CHK	APP	DATE	GROUP	1	2	3	4	5	6	CHECKED	DATE	APPROVED	DATE
N53DCR3-401217	(DCN 99-1064)	RGA	DLR	ALM	12-14-99											
N54DCKR BNDW 224	(DCN 99-0646)	DLR	TRCA	KG	10-27-99											
N55CR 2057-07475	(DCN 07-1985)	KG	DJB	DJR	11/29/07											
N56(DCN 09-0436)		KG	DJB	DJR	12/26/09											
N57CR 2058-07338	(DCN 09-0936)	KG	I	KG	08/15/08											
N58(CED 6029200	(DCN 09-0423)	DJB	DJB	KG	10/17/09											

**COOPER NUCLEAR STATION**  
**FLOW DIAGRAM**  
**CORE SPRAY SYSTEM**

2045 SH 1 N58

BURNS & ROE

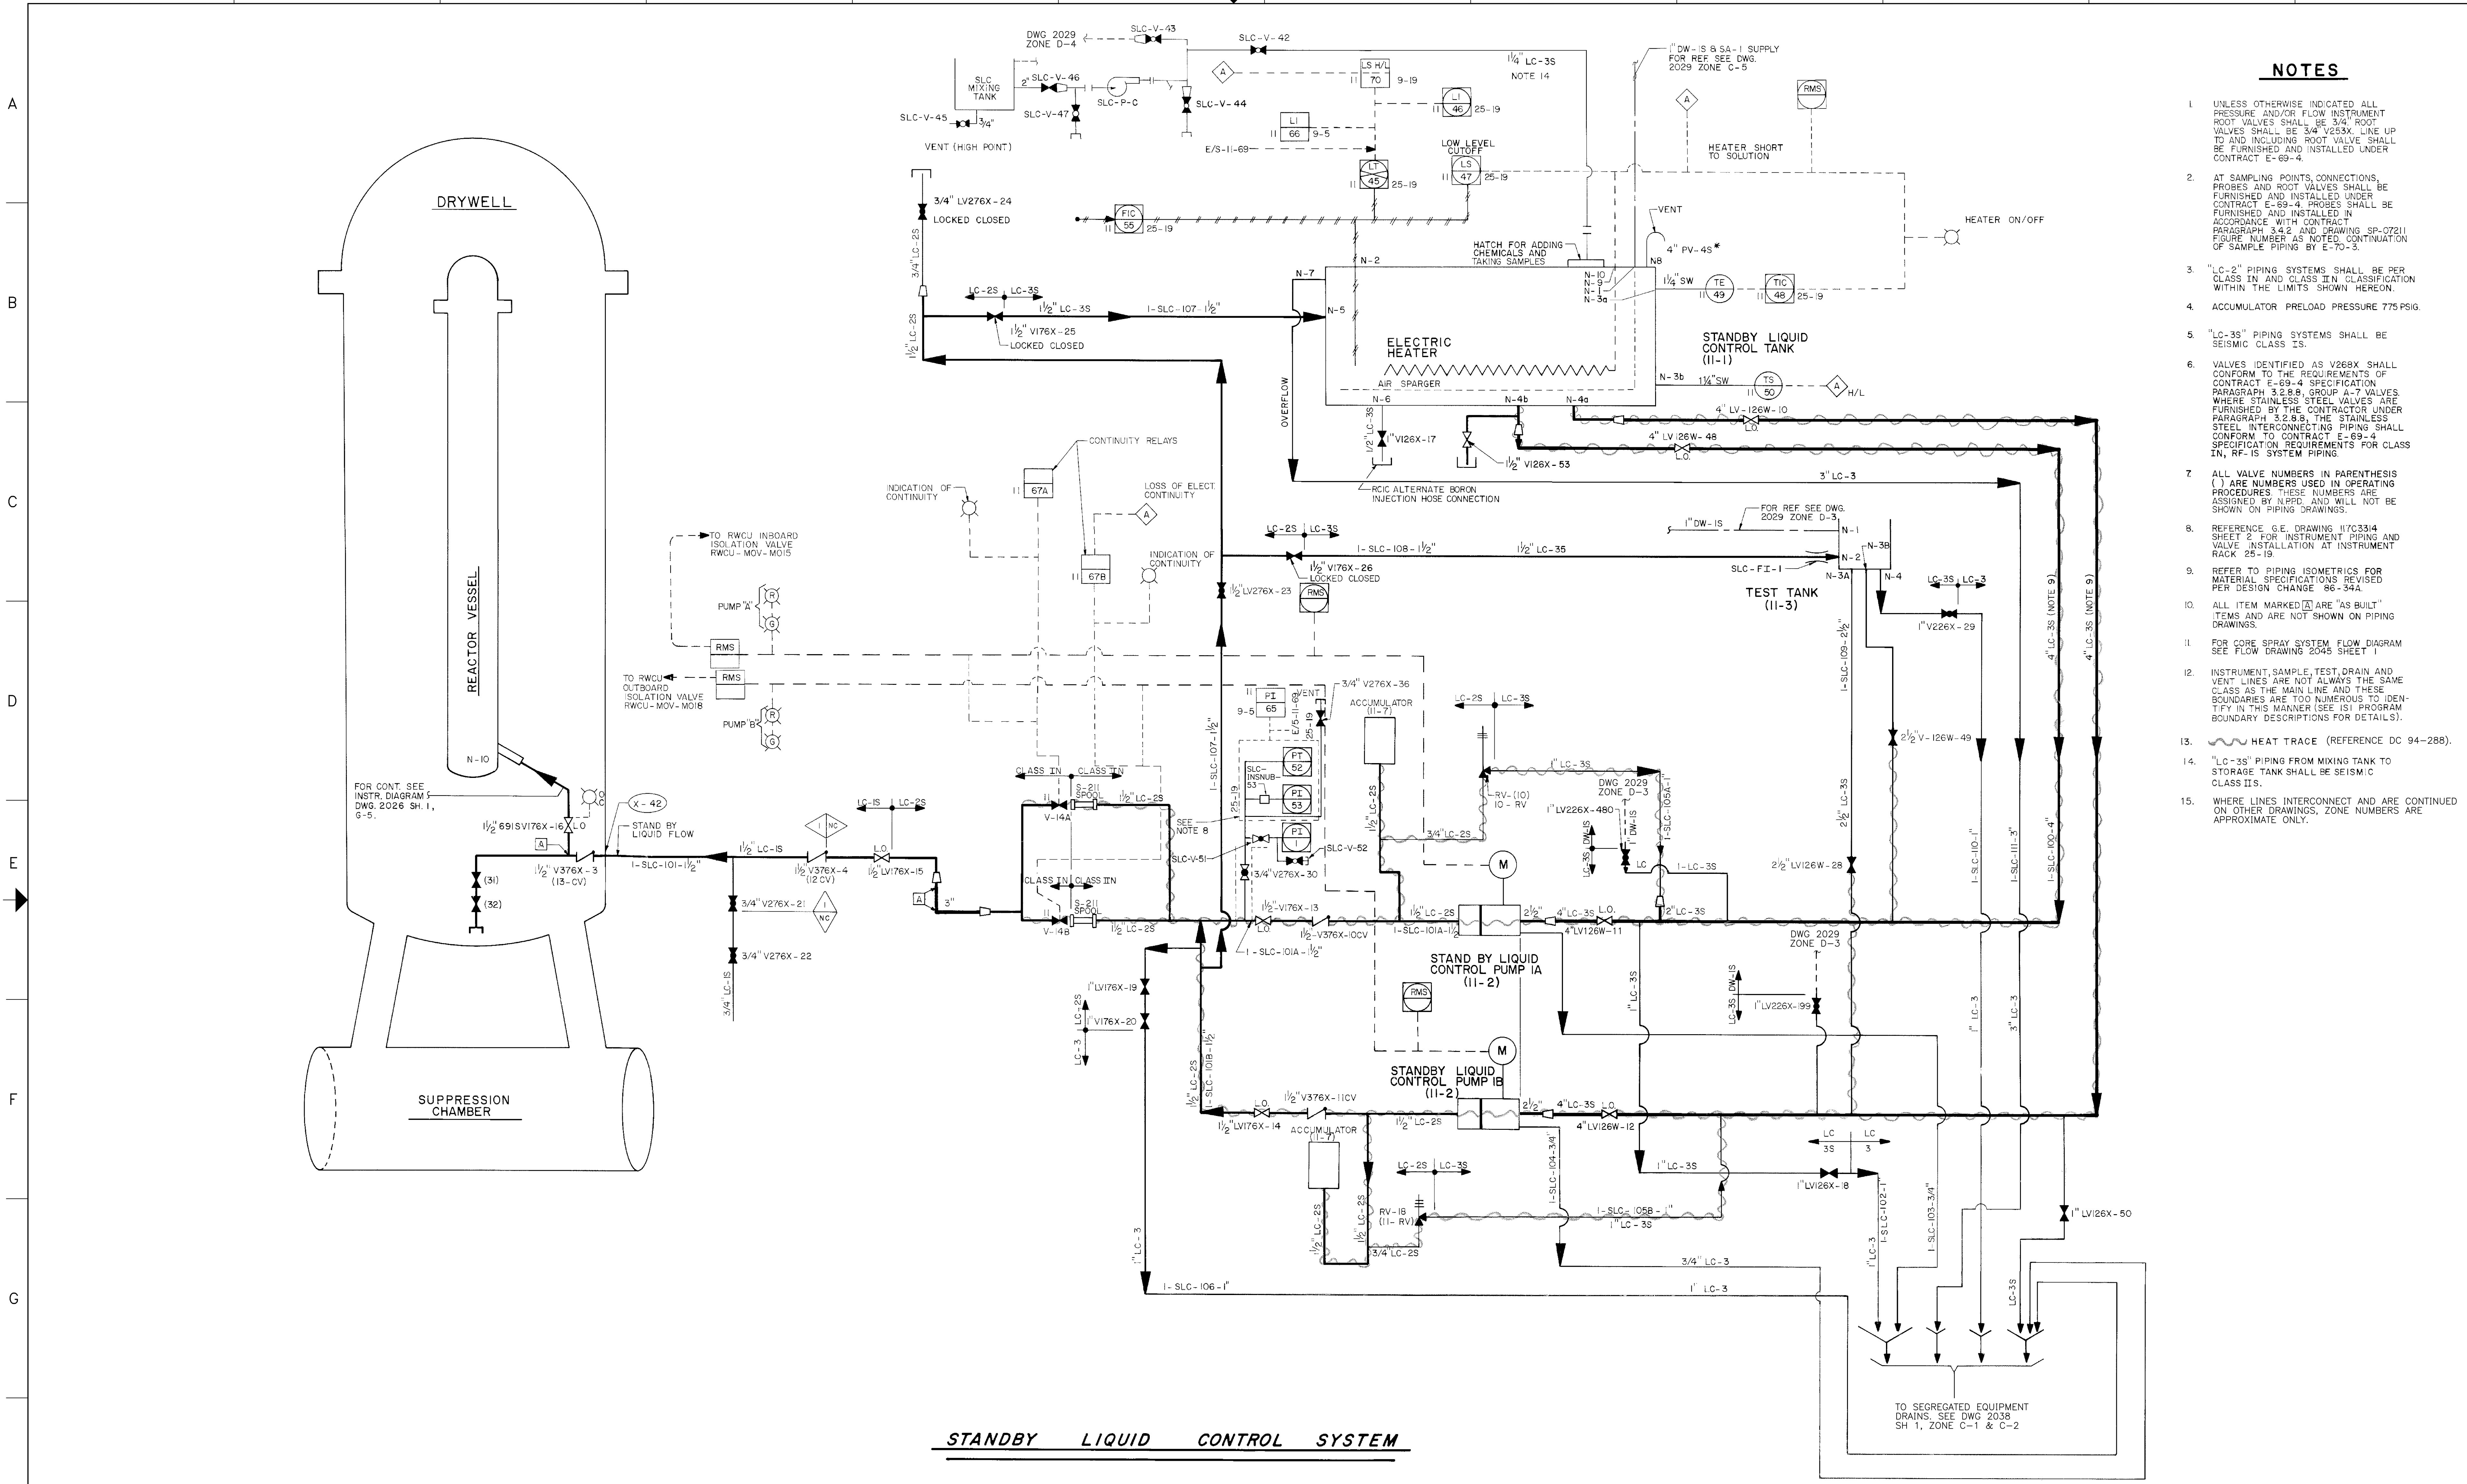

**NOTES**

1. UNLESS OTHERWISE INDICATED ALL PRESSURE AND/OR FLOW INSTRUMENT ROOT VALVES SHALL BE 3/4" ROOT VALVES SHALL BE 3/4" V25X3. LINE UP TO AND INCLUDING ROOT VALVE SHALL BE FURNISHED AND INSTALLED UNDER CONTRACT E-69-4.
2. AT SAMPLING POINTS, CONNECTIONS, PROBES AND ROOT VALVES SHALL BE FURNISHED AND INSTALLED UNDER CONTRACT E-69-4. PROBES SHALL BE FURNISHED AND INSTALLED IN ACCORDANCE WITH CONTRACT PARAGRAPH 3.4.2 AND DRAWING SP-07211. FIGURE NUMBER AS NOTED. CONTINUATION OF SAMPLE PIPING BY E-70-3.
3. "LC-2" PIPING SYSTEMS SHALL BE PER CLASS IN AND CLASS II IN CLASSIFICATION WITHIN THE LIMITS SHOWN HEREON.
4. ACCUMULATOR PRELOAD PRESSURE 775 PSIG.
5. "LC-35" PIPING SYSTEMS SHALL BE SEISMIC CLASS IS.
6. VALVES IDENTIFIED AS V26X SHALL CONFORM TO THE REQUIREMENTS OF CONTRACT E-69-4 SPECIFICATION PARAGRAPH 3.2.8.9, GROUP A-7 VALVES WHERE STAINLESS STEEL VALVES ARE FURNISHED BY THE CONTRACTOR UNDER PARAGRAPH 3.2.8.8, THE STAINLESS STEEL INTERCONNECTING PIPING SHALL CONFORM TO CONTRACT E-69-4 SPECIFICATION REQUIREMENTS FOR CLASS IN, RF-IS SYSTEM PIPING.
7. ALL VALVE NUMBERS IN PARENTHESIS ( ) ARE NUMBERS USED IN OPERATING PROCEDURES THESE NUMBERS ARE ASSIGNED BY NPPC AND WILL NOT BE SHOWN ON PIPING DRAWINGS.
8. REFERENCE G.E. DRAWING 117C3314 SHEET 2 FOR INSTRUMENT PIPING AND VALVE INSTALLATION AT INSTRUMENT RACK 25-19.
9. REFER TO PIPING ISOMETRICS FOR MATERIAL SPECIFICATIONS REVISED PER DESIGN CHANGE 96-344.
10. ALL ITEM MARKED [X] ARE "AS BUILT" ITEMS AND ARE NOT SHOWN ON PIPING DRAWINGS.
11. FOR CORE SPRAY SYSTEM FLOW DIAGRAM SEE FLOW DRAWING 2045 SHEET 1.
12. INSTRUMENT, SAMPLE, TEST, DRAIN AND VENT LINES ARE NOT ALWAYS THE SAME CLASS AS THE MAIN LINE AND THESE BOUNDARIES ARE TOO NUMEROUS TO IDENTIFY IN THIS MANNER (SEE ISI PROGRAM BOUNDARY DESCRIPTIONS FOR DETAILS).
13. HEAT TRACE (REFERENCE DC 94-288).
14. "LC-35" PIPING FROM MIXING TANK TO STORAGE TANK SHALL BE SEISMIC CLASS IS.
15. WHERE LINES INTERCONNECT AND ARE CONTINUED ON OTHER DRAWINGS, ZONE NUMBERS ARE APPROXIMATE ONLY.

**STANDBY LIQUID CONTROL SYSTEM**

REVISIONS TO THIS DRAWING REQUIRES A REVISION TO THE CORRESPONDING ISOKEY.

**AS BUILT**  
454224291  
SCAN/CADD DWG


NO.	REVISIONS

FOR PREVIOUS REVISIONS, SEE SUPERSEDED CARDS.

NO.	REVISIONS	BY	DATE
N18	DCR 3-40217 (DCN 02-8856)	HFY REGA	KG 10/29/02
N19	DCR 03-070 (DCN 03-1565)	DCR FILE	KG 11/07/04
N20	NOTE 10139172 (DCN 05-0021)	REGA REGA	DLS 11/6/05
N21	CA 2004-07601 (DCN 04-2998)	KZ KZ	DLR 12/14/05

GROUP	1	2	3	4	5	6
SIGNATURE						
DATE						
DRAWN	HFY	DATE	08/22/02			
CHECKED		DATE				
APPROVED		DATE				
FILED						
COOPER NUCLEAR STATION FLOW DIAGRAM STANDBY LIQUID CONTROL SYSTEM			BURNS & ROE			
2045 SH 2			N21			



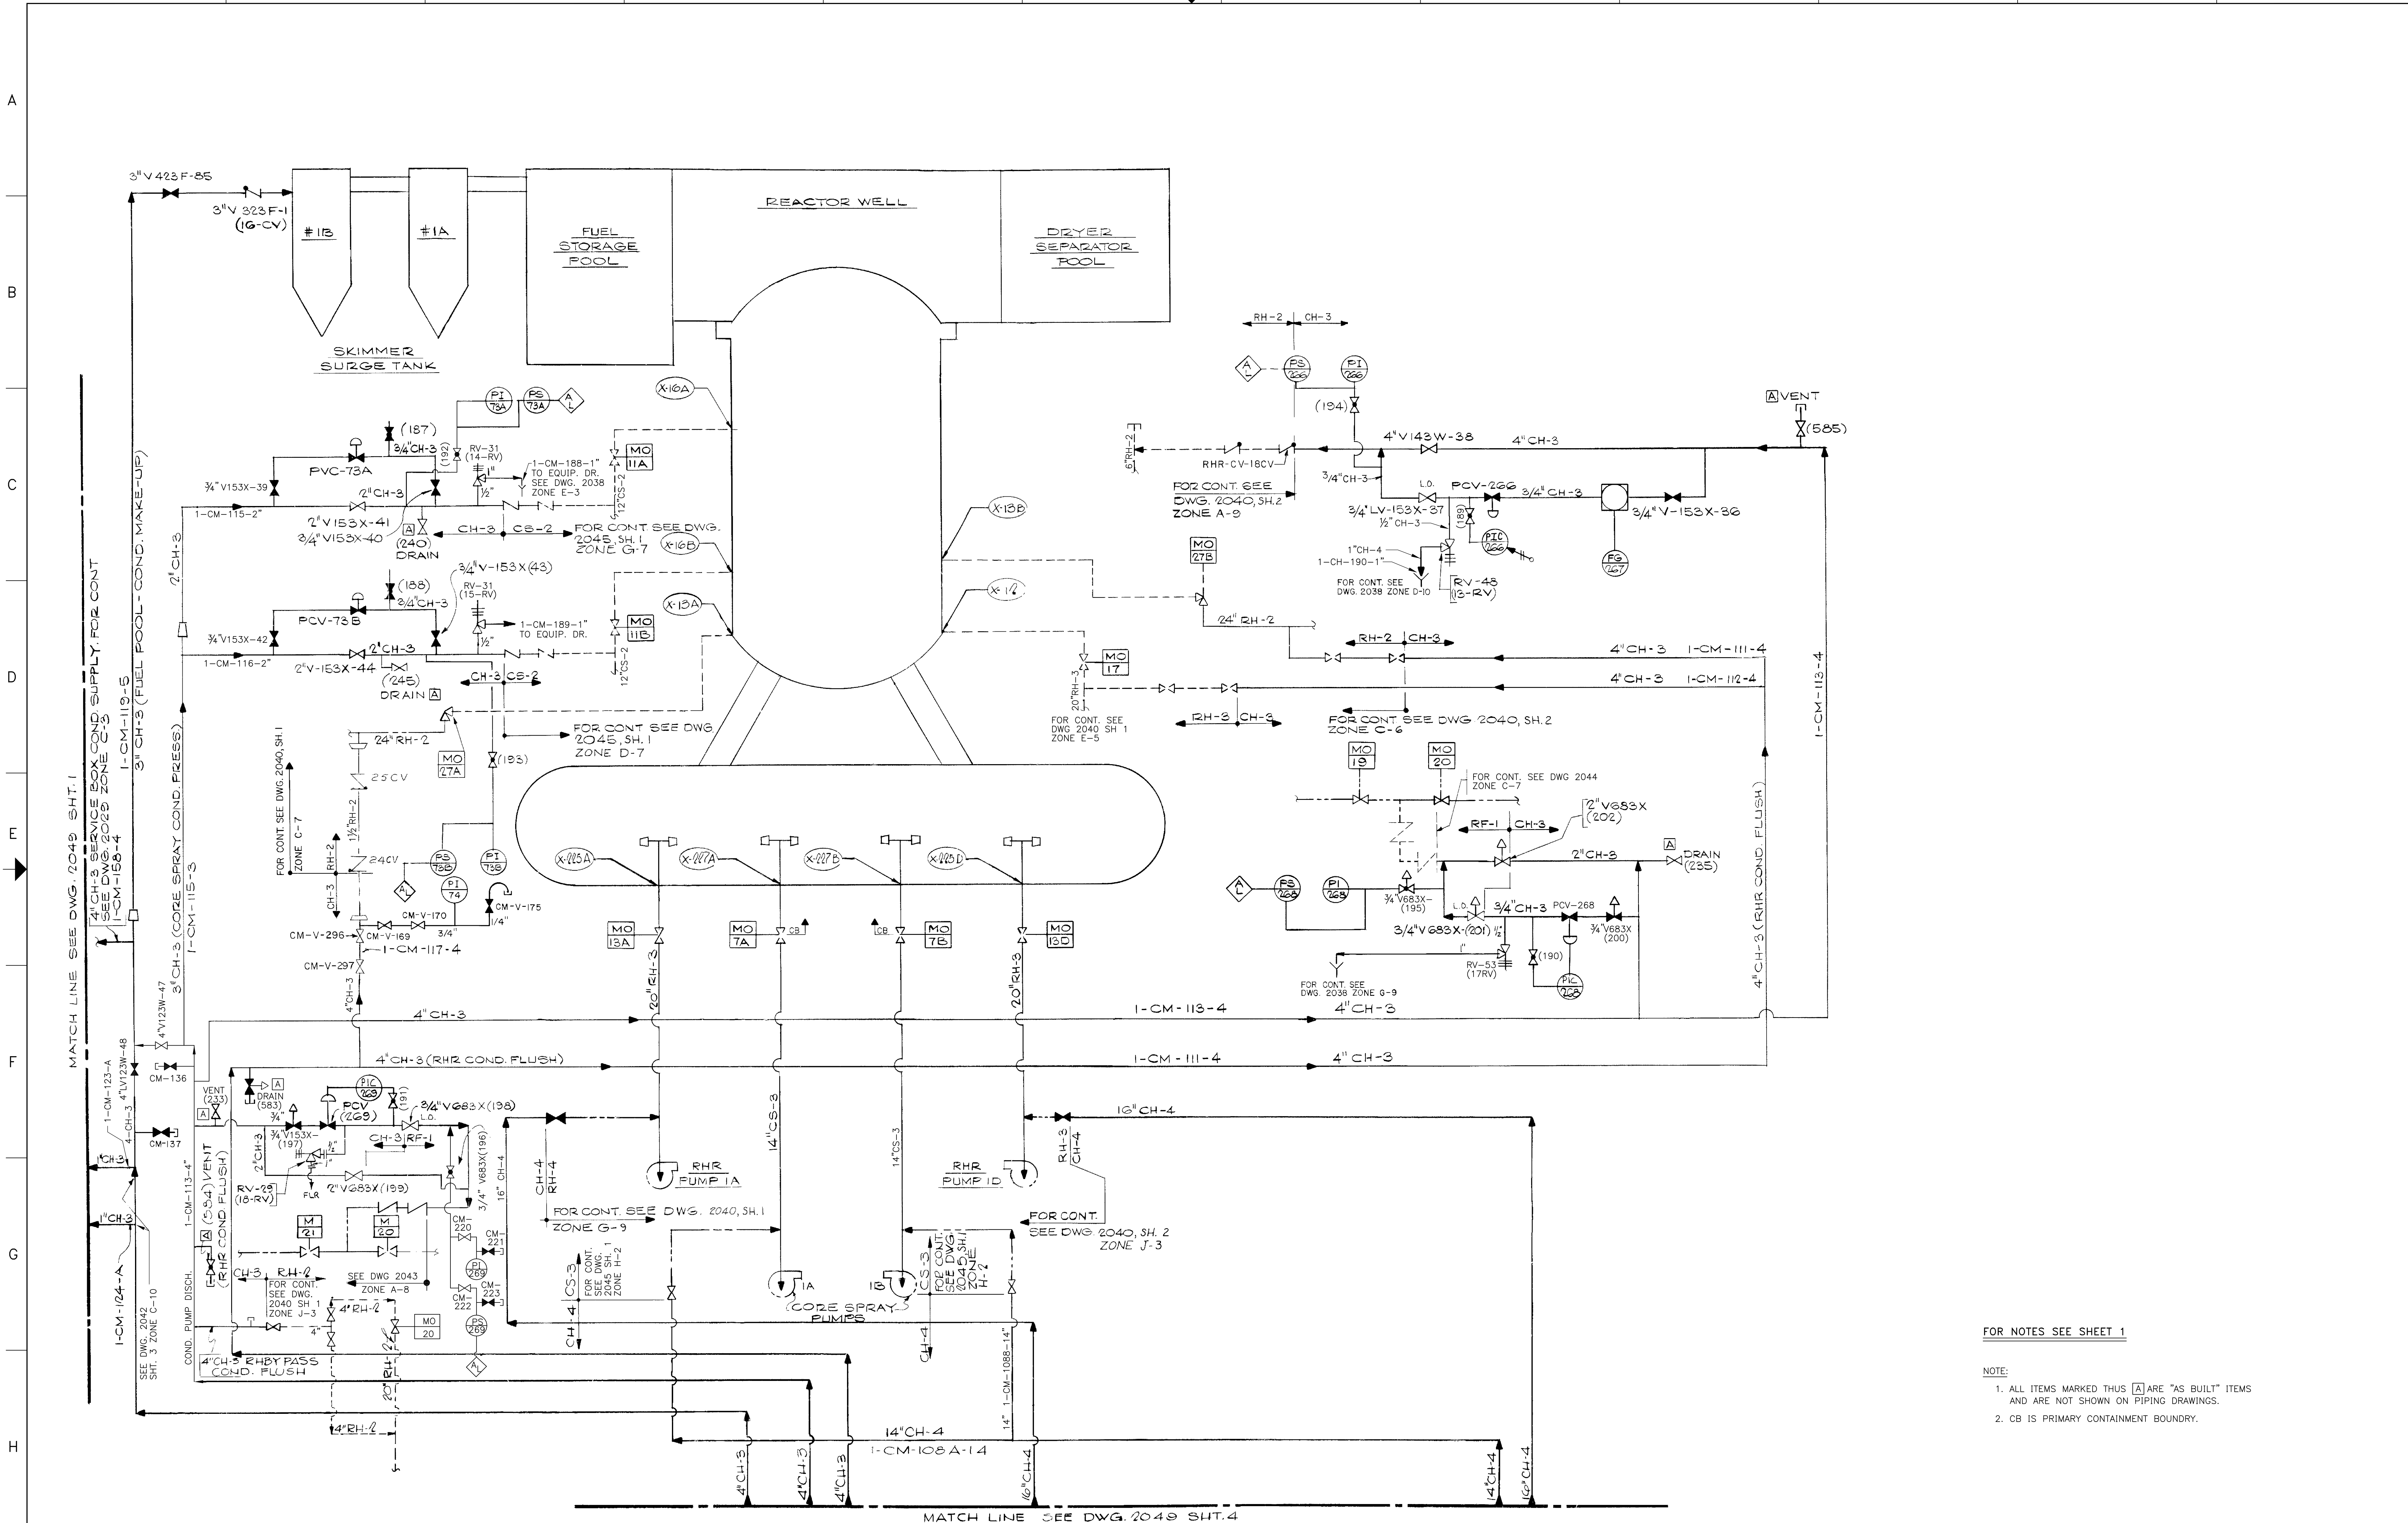

FOR NOTES SEE SHEET 1

NOTE:

- ALL ITEMS MARKED THUS [A] ARE "AS BUILT" ITEMS AND ARE NOT SHOWN ON PIPING DRAWINGS.
- CB IS PRIMARY CONTAINMENT BOUNDARY.

REVISIONS TO THIS DRAWING  
REQUIRES A REVISION TO THE  
CORRESPONDING ISOKEY.

AS BUILT  
454003677  
SCAN/CADD DWG  
DO NOT REVISE MANUALLY

NO.	REVISIONS

FOR PREVIOUS REVISIONS, SEE SUPERSEDED CARDS.

REVISIONS BY N.P.P.D.			
NO.	REVISIONS	DFT	CHK APP DATE
119	DCR 3-40217 (DCN 02-0788)	DJF	RGK KG 10/26/07
120	NOVIF 10152075 (DCN 04-0842)	KG	KG DUKI 3/17/04

SIGNATURE	DATE	DRAWN	DATE
DJF	08/09/02	DJF	08/09/02
CHECKED	DATE	APPROVED	DATE
FILED	DATE	REVISION	DATE
		2049 SH 3	N20

COOPER NUCLEAR STATION  
FLOW DIAGRAM  
CONDENSATE SUPPLY SYSTEM

BURNS & ROE

NO. 0007951

SECURITY-RELATED INFORMATION -  
WITHHOLD UNDER 10 CFR 2.390

DRAWING 2050  
GENERAL ARRANGEMENT, TURBINE BUILDING,  
BASEMENT FLOOR PLAN

SECURITY-RELATED INFORMATION -  
WITHHOLD UNDER 10 CFR 2.390

DRAWING 2051  
GENERAL ARRANGEMENT, TURBINE BUILDING,  
MEZZANINE FLOOR PLAN

SECURITY-RELATED INFORMATION -  
WITHHOLD UNDER 10 CFR 2.390

DRAWING 2052  
GENERAL ARRANGEMENT, TURBINE BUILDING,  
OPERATING FLOOR PLAN

SECURITY-RELATED INFORMATION -  
WITHHOLD UNDER 10 CFR 2.390

DRAWING 2053  
GENERAL ARRANGEMENT, TURBINE BUILDING,  
SECTION A-A

SECURITY-RELATED INFORMATION -  
WITHHOLD UNDER 10 CFR 2.390

DRAWING 2054  
GENERAL ARRANGEMENT, TURBINE BUILDING,  
SECTION B-B

SECURITY-RELATED INFORMATION -  
WITHHOLD UNDER 10 CFR 2.390

DRAWING 2056  
GENERAL ARRANGEMENT,  
INTAKE STRUCTURE PLAN AND SECTIONS

SECURITY-RELATED INFORMATION -  
WITHHOLD UNDER 10 CFR 2.390

DRAWING 2059  
GENERAL ARRANGEMENT, REACTOR BUILDING,  
PLAN BELOW GRADE



SECURITY-RELATED INFORMATION -  
WITHHOLD UNDER 10 CFR 2.390

DRAWING 2060  
GENERAL ARRANGEMENT, REACTOR BUILDING,  
PLAN AT ELEVATION 903'-6"

SECURITY-RELATED INFORMATION -  
WITHHOLD UNDER 10 CFR 2.390

DRAWING 2061  
GENERAL ARRANGEMENT, REACTOR BUILDING,  
PLAN AT ELEVATION 931'-6"

SECURITY-RELATED INFORMATION -  
WITHHOLD UNDER 10 CFR 2.390

DRAWING 2062  
GENERAL ARRANGEMENT, REACTOR BUILDING,  
PLAN AT ELEVATION 958'-3"

SECURITY-RELATED INFORMATION -  
WITHHOLD UNDER 10 CFR 2.390

DRAWING 2063  
GENERAL ARRANGEMENT, REACTOR BUILDING,  
PLAN AT ELEVATION 976'-0"

SECURITY-RELATED INFORMATION -  
WITHHOLD UNDER 10 CFR 2.390

DRAWING 2064  
GENERAL ARRANGEMENT, REACTOR BUILDING,  
PLAN AT ELEVATION 1001'-0"

SECURITY-RELATED INFORMATION -  
WITHHOLD UNDER 10 CFR 2.390

DRAWING 2065  
GENERAL ARRANGEMENT, REACTOR BUILDING,  
SECTION A-A

SECURITY-RELATED INFORMATION -  
WITHHOLD UNDER 10 CFR 2.390

DRAWING 2066  
GENERAL ARRANGEMENT, REACTOR BUILDING,  
SECTION B-B

SECURITY-RELATED INFORMATION -  
WITHHOLD UNDER 10 CFR 2.390

DRAWING 2067  
GENERAL ARRANGEMENT, RADWASTE BUILDING,  
PLANS AT ELEVATIONS 877'-6" AND 903'-6"



SECURITY-RELATED INFORMATION -  
WITHHOLD UNDER 10 CFR 2.390

DRAWING 2068  
GENERAL ARRANGEMENT, RADWASTE BUILDING,  
PLANS AT ELEVATIONS 918'-0" AND 934'-0"

SECURITY-RELATED INFORMATION -  
WITHHOLD UNDER 10 CFR 2.390


DRAWING 2069  
GENERAL ARRANGEMENT,  
RADWASTE BUILDING SECTIONS

SECURITY-RELATED INFORMATION -  
WITHHOLD UNDER 10 CFR 2.390

DRAWING 2072  
GENERAL ARRANGEMENT,  
AUGMENTED RADWASTE BUILDING PLANS

SECURITY-RELATED INFORMATION -  
WITHHOLD UNDER 10 CFR 2.390

DRAWING 2073  
GENERAL ARRANGEMENT,  
AUGMENTED RADWASTE BUILDING SECTIONS

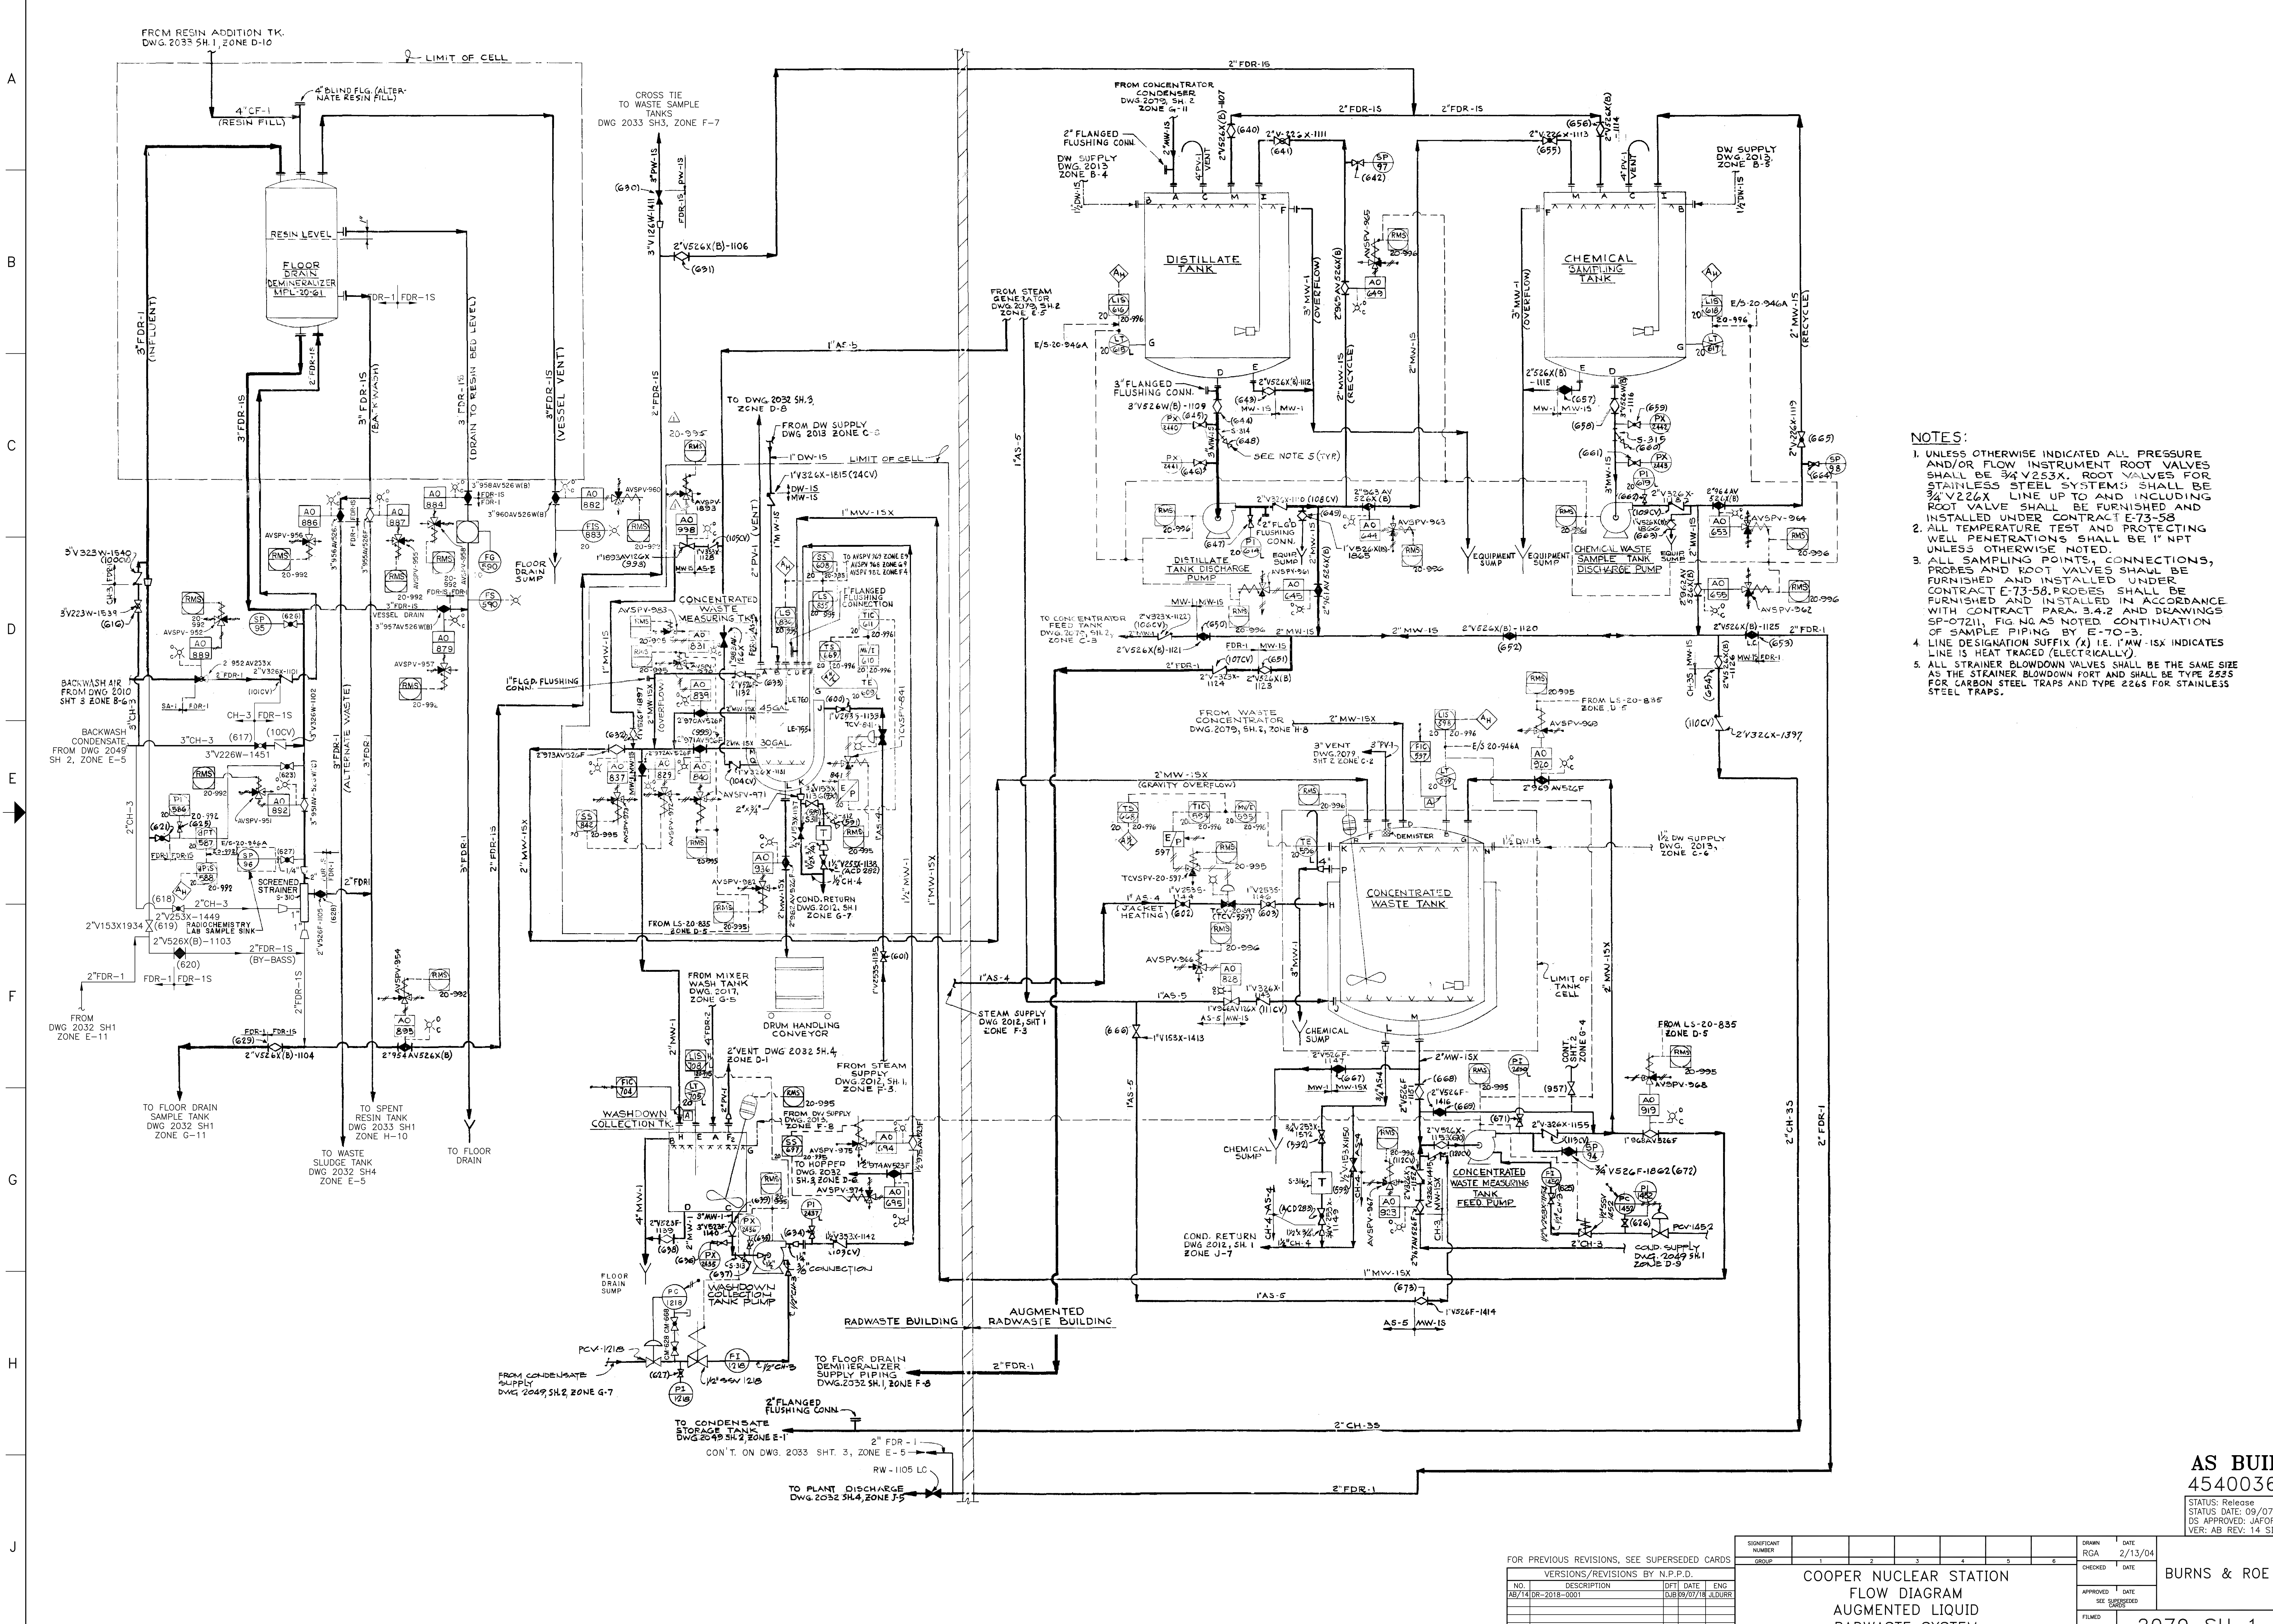

- NOTES:**
1. UNLESS OTHERWISE INDICATED ALL PRESSURE AND/OR FLOW INSTRUMENT ROOT VALVES SHALL BE 3/4" V253X. ROOT VALVES FOR STAINLESS STEEL SYSTEMS SHALL BE 3/4" V226X LINE UP TO AND INCLUDING ROOT VALVE SHALL BE FURNISHED AND INSTALLED UNDER CONTRACT E-73-58
  2. ALL TEMPERATURE TEST AND PROTECTING WELL PENETRATIONS SHALL BE 1" NPT UNLESS OTHERWISE NOTED.
  3. ALL SAMPLING POINTS, CONNECTIONS, PROBES AND ROOT VALVES SHALL BE FURNISHED AND INSTALLED UNDER CONTRACT E-73-58. PROBES SHALL BE FURNISHED AND INSTALLED IN ACCORDANCE WITH CONTRACT PARA. 3.4.2 AND DRAWINGS SP-07211, FIG. NO. AS NOTED. CONTINUATION OF SAMPLE PIPING BY E-70-3.
  4. LINE DESIGNATION SUFFIX (X) I.E. 1" MW-15X INDICATES LINE IS HEAT TRACED (ELECTRICALLY).
  5. ALL STRAINER BLOWDOWN VALVES SHALL BE THE SAME SIZE AS THE STRAINER BLOWDOWN PORT AND SHALL BE TYPE 2535 FOR CARBON STEEL TRAPS AND TYPE 2265 FOR STAINLESS STEEL TRAPS.

**AS BUILT**  
454003659

STATUS DATE: 09/07/2018  
DS APPROVED: JAFORBE  
VER: AB REV: 14 SIZE: F

FOR PREVIOUS REVISIONS, SEE SUPERSEDED CARDS				SIGNIFICANT NUMBER					
NO.	DESCRIPTION	DFTI	DATE	1	2	3	4	5	6
AB/1410R-2018-0001									


VERSIONS/REVISIONS BY N.P.P.D.				DRAWN		DATE	
NO.	DESCRIPTION	DFTI	DATE	GROUP	DATE	GROUP	DATE

COOPER NUCLEAR STATION				DRAWN		DATE	
FLOW DIAGRAM				GROUP	DATE	GROUP	DATE
AUGMENTED LIQUID							
RADWASTE SYSTEM							
				APPROVED		DATE	
				FILED		DATE	

BURNS & ROE	
2079 SH 1	



- NOTES:
1. FOR NOTES SEE DWG 2079 SH 1.
  2. \*\* OPERATES AT TEMPERATURE EQUAL TO THAT OF AS-2 SYSTEM.
  3. ALL ITEMS MARKED WITH [A] ARE "AS-BUILT" ITEMS AND ARE NOT SHOWN ON PIPING DWGS.

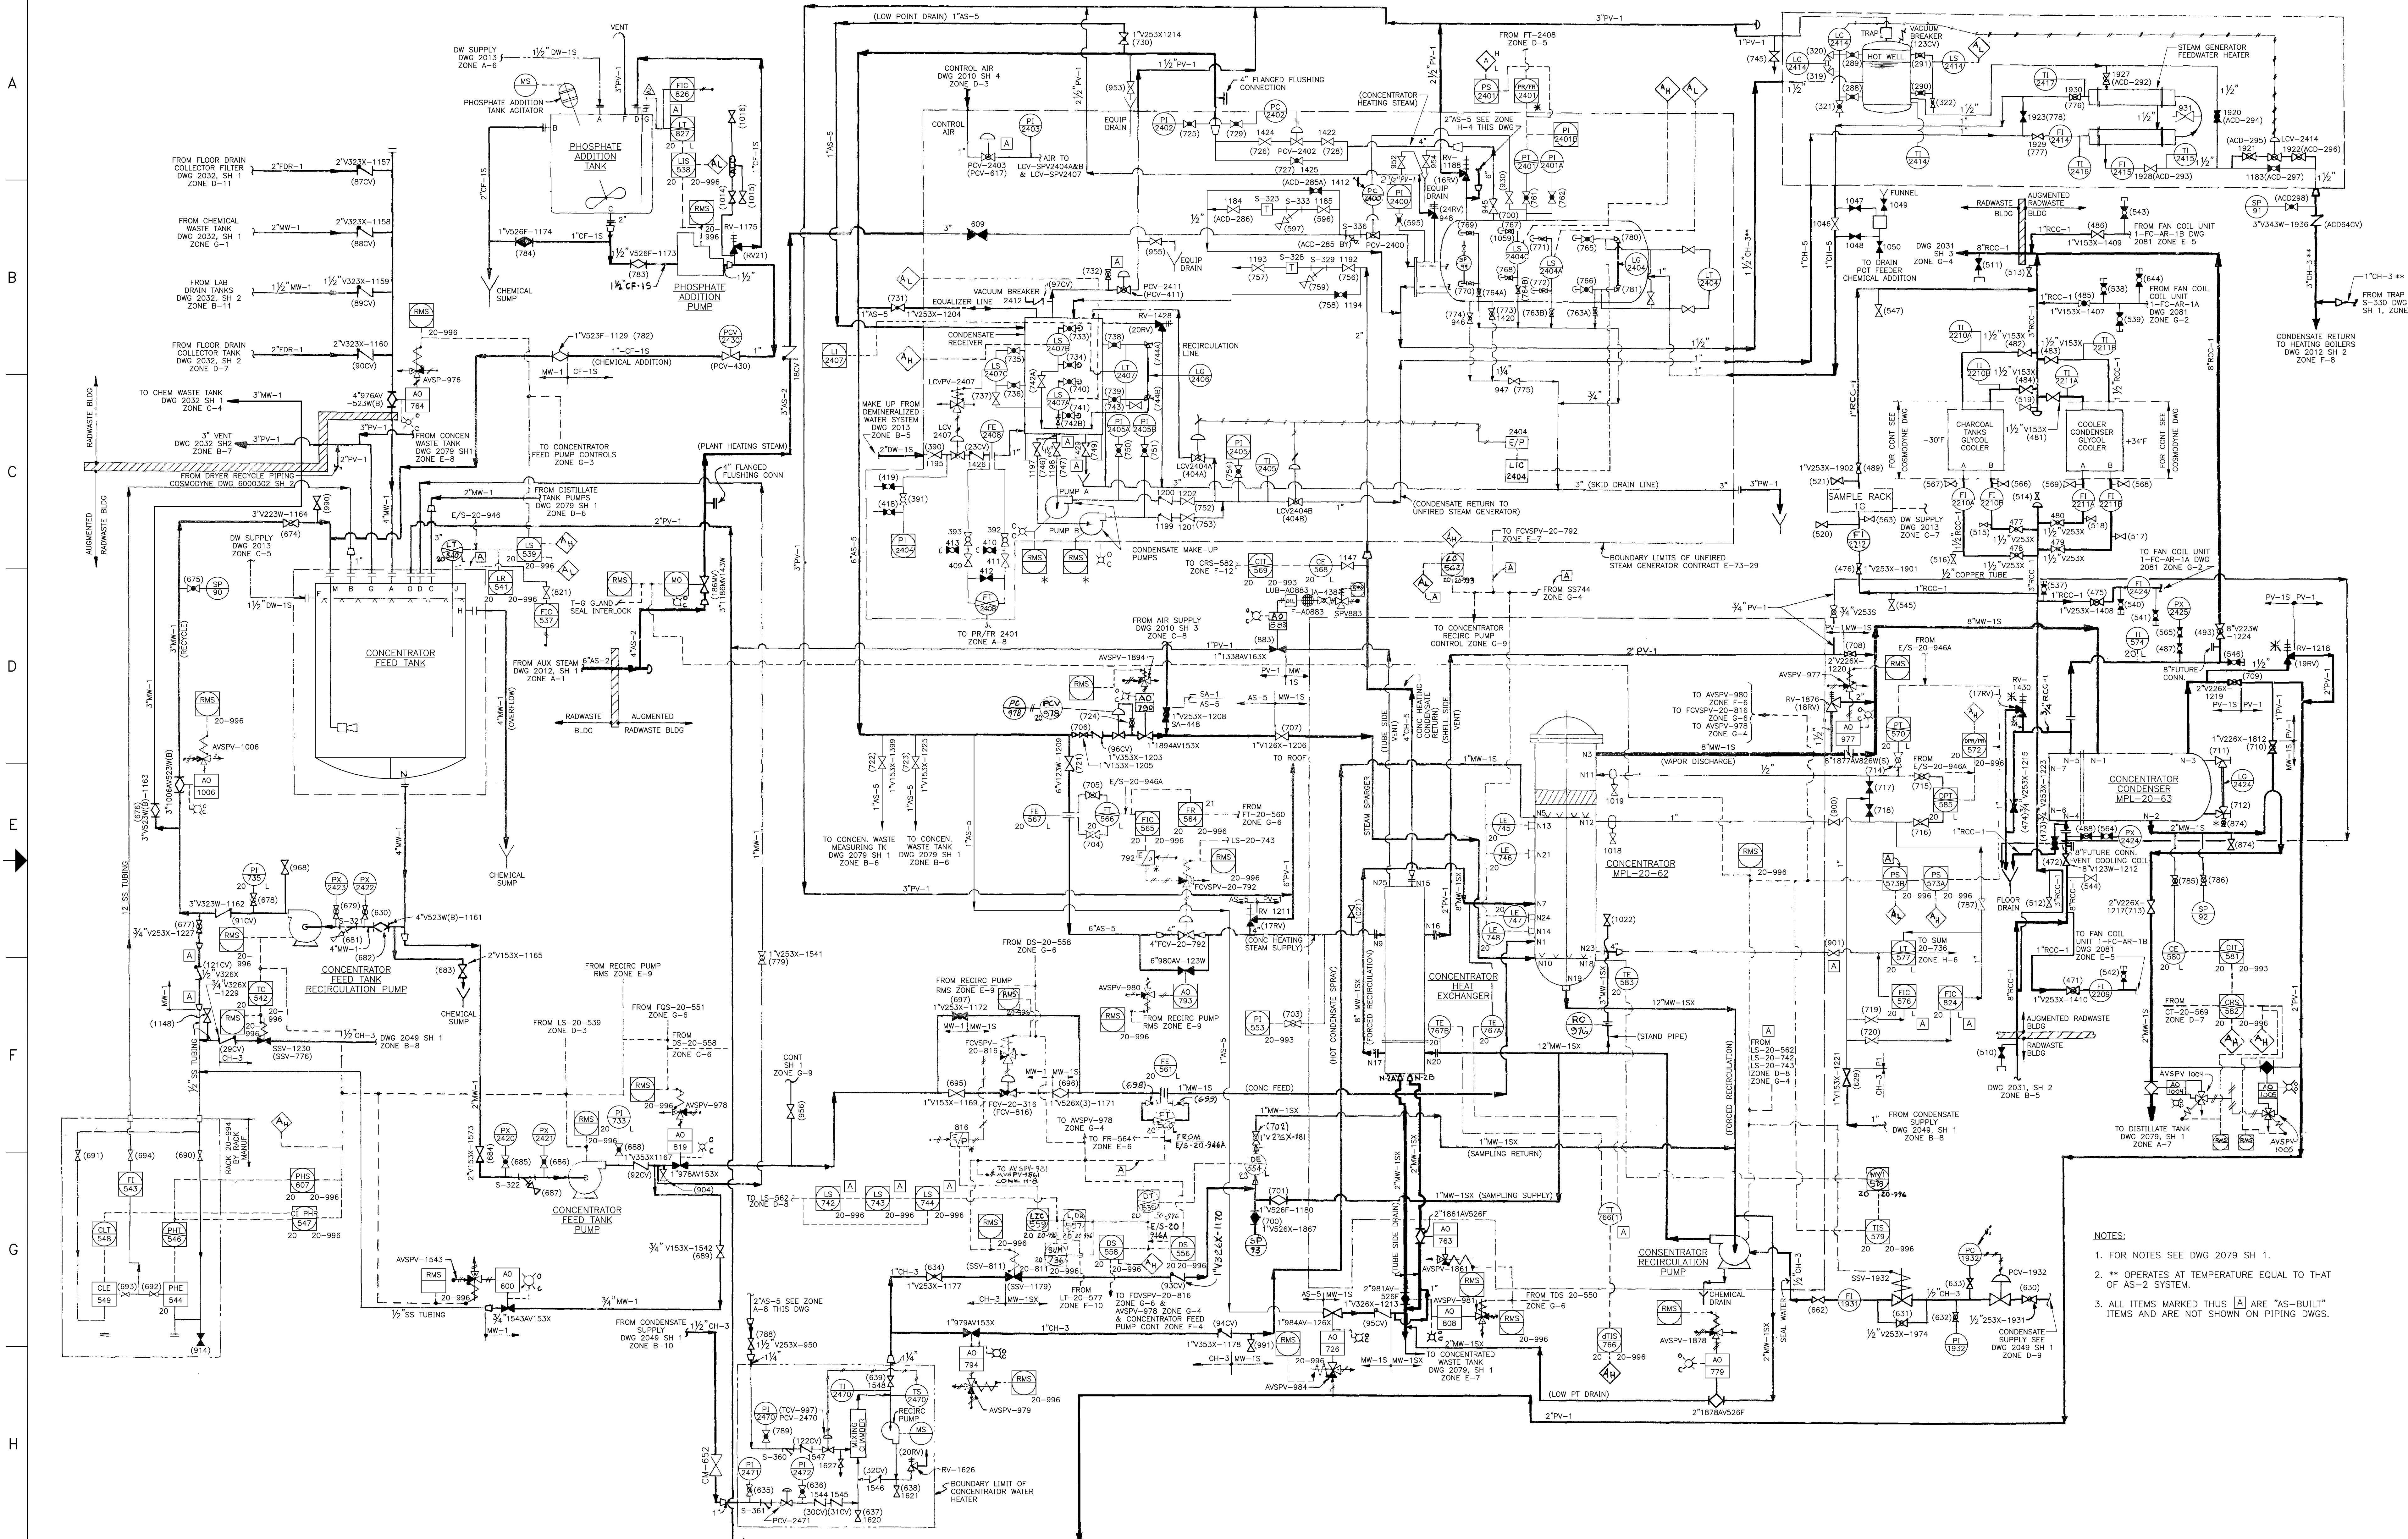AS BUILT  
454003660  
SCAN/CADD DWG  
DO NOT REVISE MANUALLY

REVISIONS BY N.P.P.D.			
NO.	REVISIONS	DFT	CHK
N29	REPRAWN TO CAD (DCN 03-0107)	RGA	KG
N30	DCN 03-082 (DCN 03-1144)	DLR	KG
N31	DCN 03-082 (DCN 03-1144)	DLR	KG
N31	DCN 03-082 (DCN 03-1144)	DLR	KG

SIGNIFICANT NUMBER		DATE	
GROUP	NO.	DATE	BY
1	1	12/19/02	RG
2	2		
3	3		
4	4		
5	5		
6	6		


COOPER NUCLEAR STATION  
FLOW DIAGRAM  
AUGMENTED LIQUID  
RADWASTE SYSTEM

BURNS & ROE

APPROVED DATE: 2079 SH 2 N31

REVISION: N31

NO.	REVISIONS

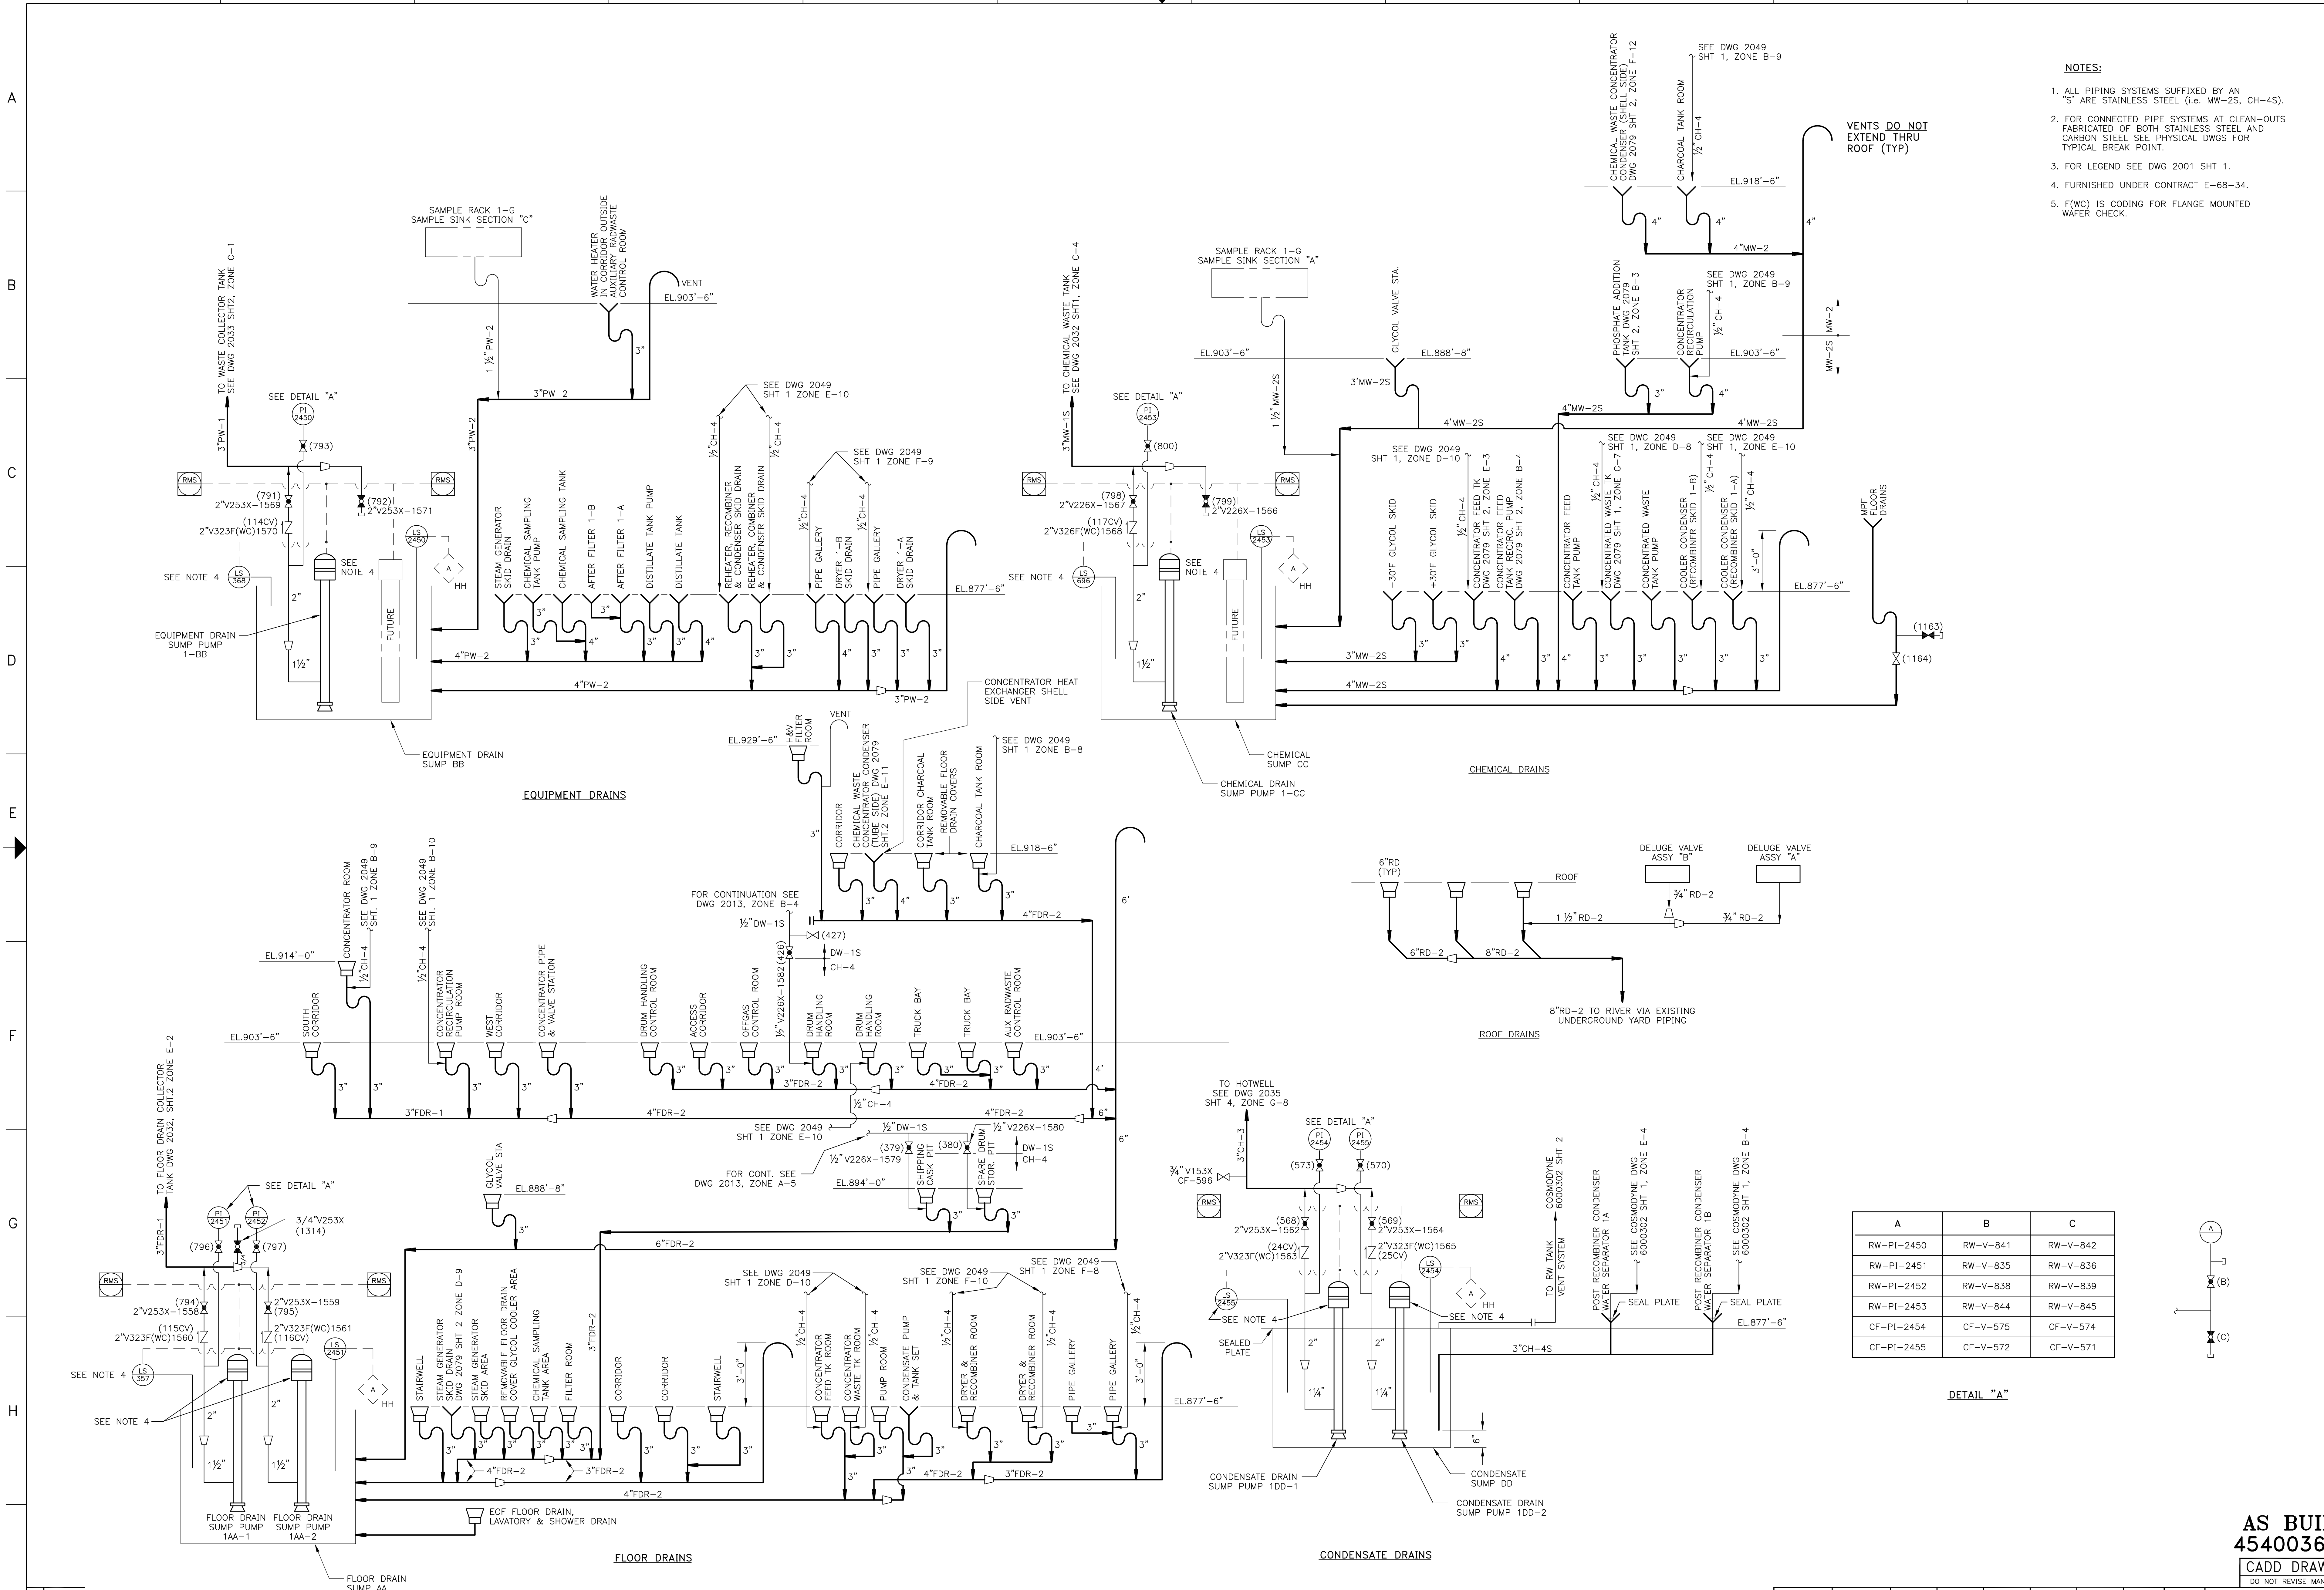

- NOTES:**
1. ALL PIPING SYSTEMS SUFFIXED BY AN "S" ARE STAINLESS STEEL (i.e. MW-2S, CH-4S).
  2. FOR CONNECTED PIPE SYSTEMS AT CLEAN-OUTS FABRICATED OF BOTH STAINLESS STEEL AND CARBON STEEL SEE PHYSICAL DWGS FOR TYPICAL BREAK POINT.
  3. FOR LEGEND SEE DWG 2001 SHT. 1.
  4. FURNISHED UNDER CONTRACT E-68-34.
  5. F(WC) IS CODING FOR FLANGE MOUNTED WAFER CHECK.

A	B	C
RW-PI-2450	RW-V-841	RW-V-842
RW-PI-2451	RW-V-835	RW-V-836
RW-PI-2452	RW-V-838	RW-V-839
RW-PI-2453	RW-V-844	RW-V-845
CF-PI-2454	CF-V-575	CF-V-574
CF-PI-2455	CF-V-572	CF-V-571


**DETAIL "A"**

**AS BUILT**  
**454003675**

CADD DRAWING

DO NOT REVISE MANUALLY

SIGNIFICANT NUMBER						GROUP	1	2	3	4	5	6	
DRAWN						DATE	3/10/05						
CHECKED						DATE							
APPROVED						DATE							
FILMED													
REVISIONS BY N.P.P.D. NO. REVISIONS DATE DFT CKD APP DATE N13 DEC 1999-0063 (DCN 99-0617) RGA TMB KC 3/31/00 N14 DEC 05-0456 RGA TMB KC 12/26/05 N15 FEB 02-021 (DCN 02-0672) DJB DJB DLR 02/07/02												BURNS & ROE APPROVED DATE	
FOR PREVIOUS REVISIONS, SEE SUPERSEDED CARDS													
FLOW DIAGRAM AUGMENTED RADWASTE BUILDING EQUIPMENT, CHEMICAL & FLOOR DRAINS COOPER NUCLEAR STATION													
2080										N15			

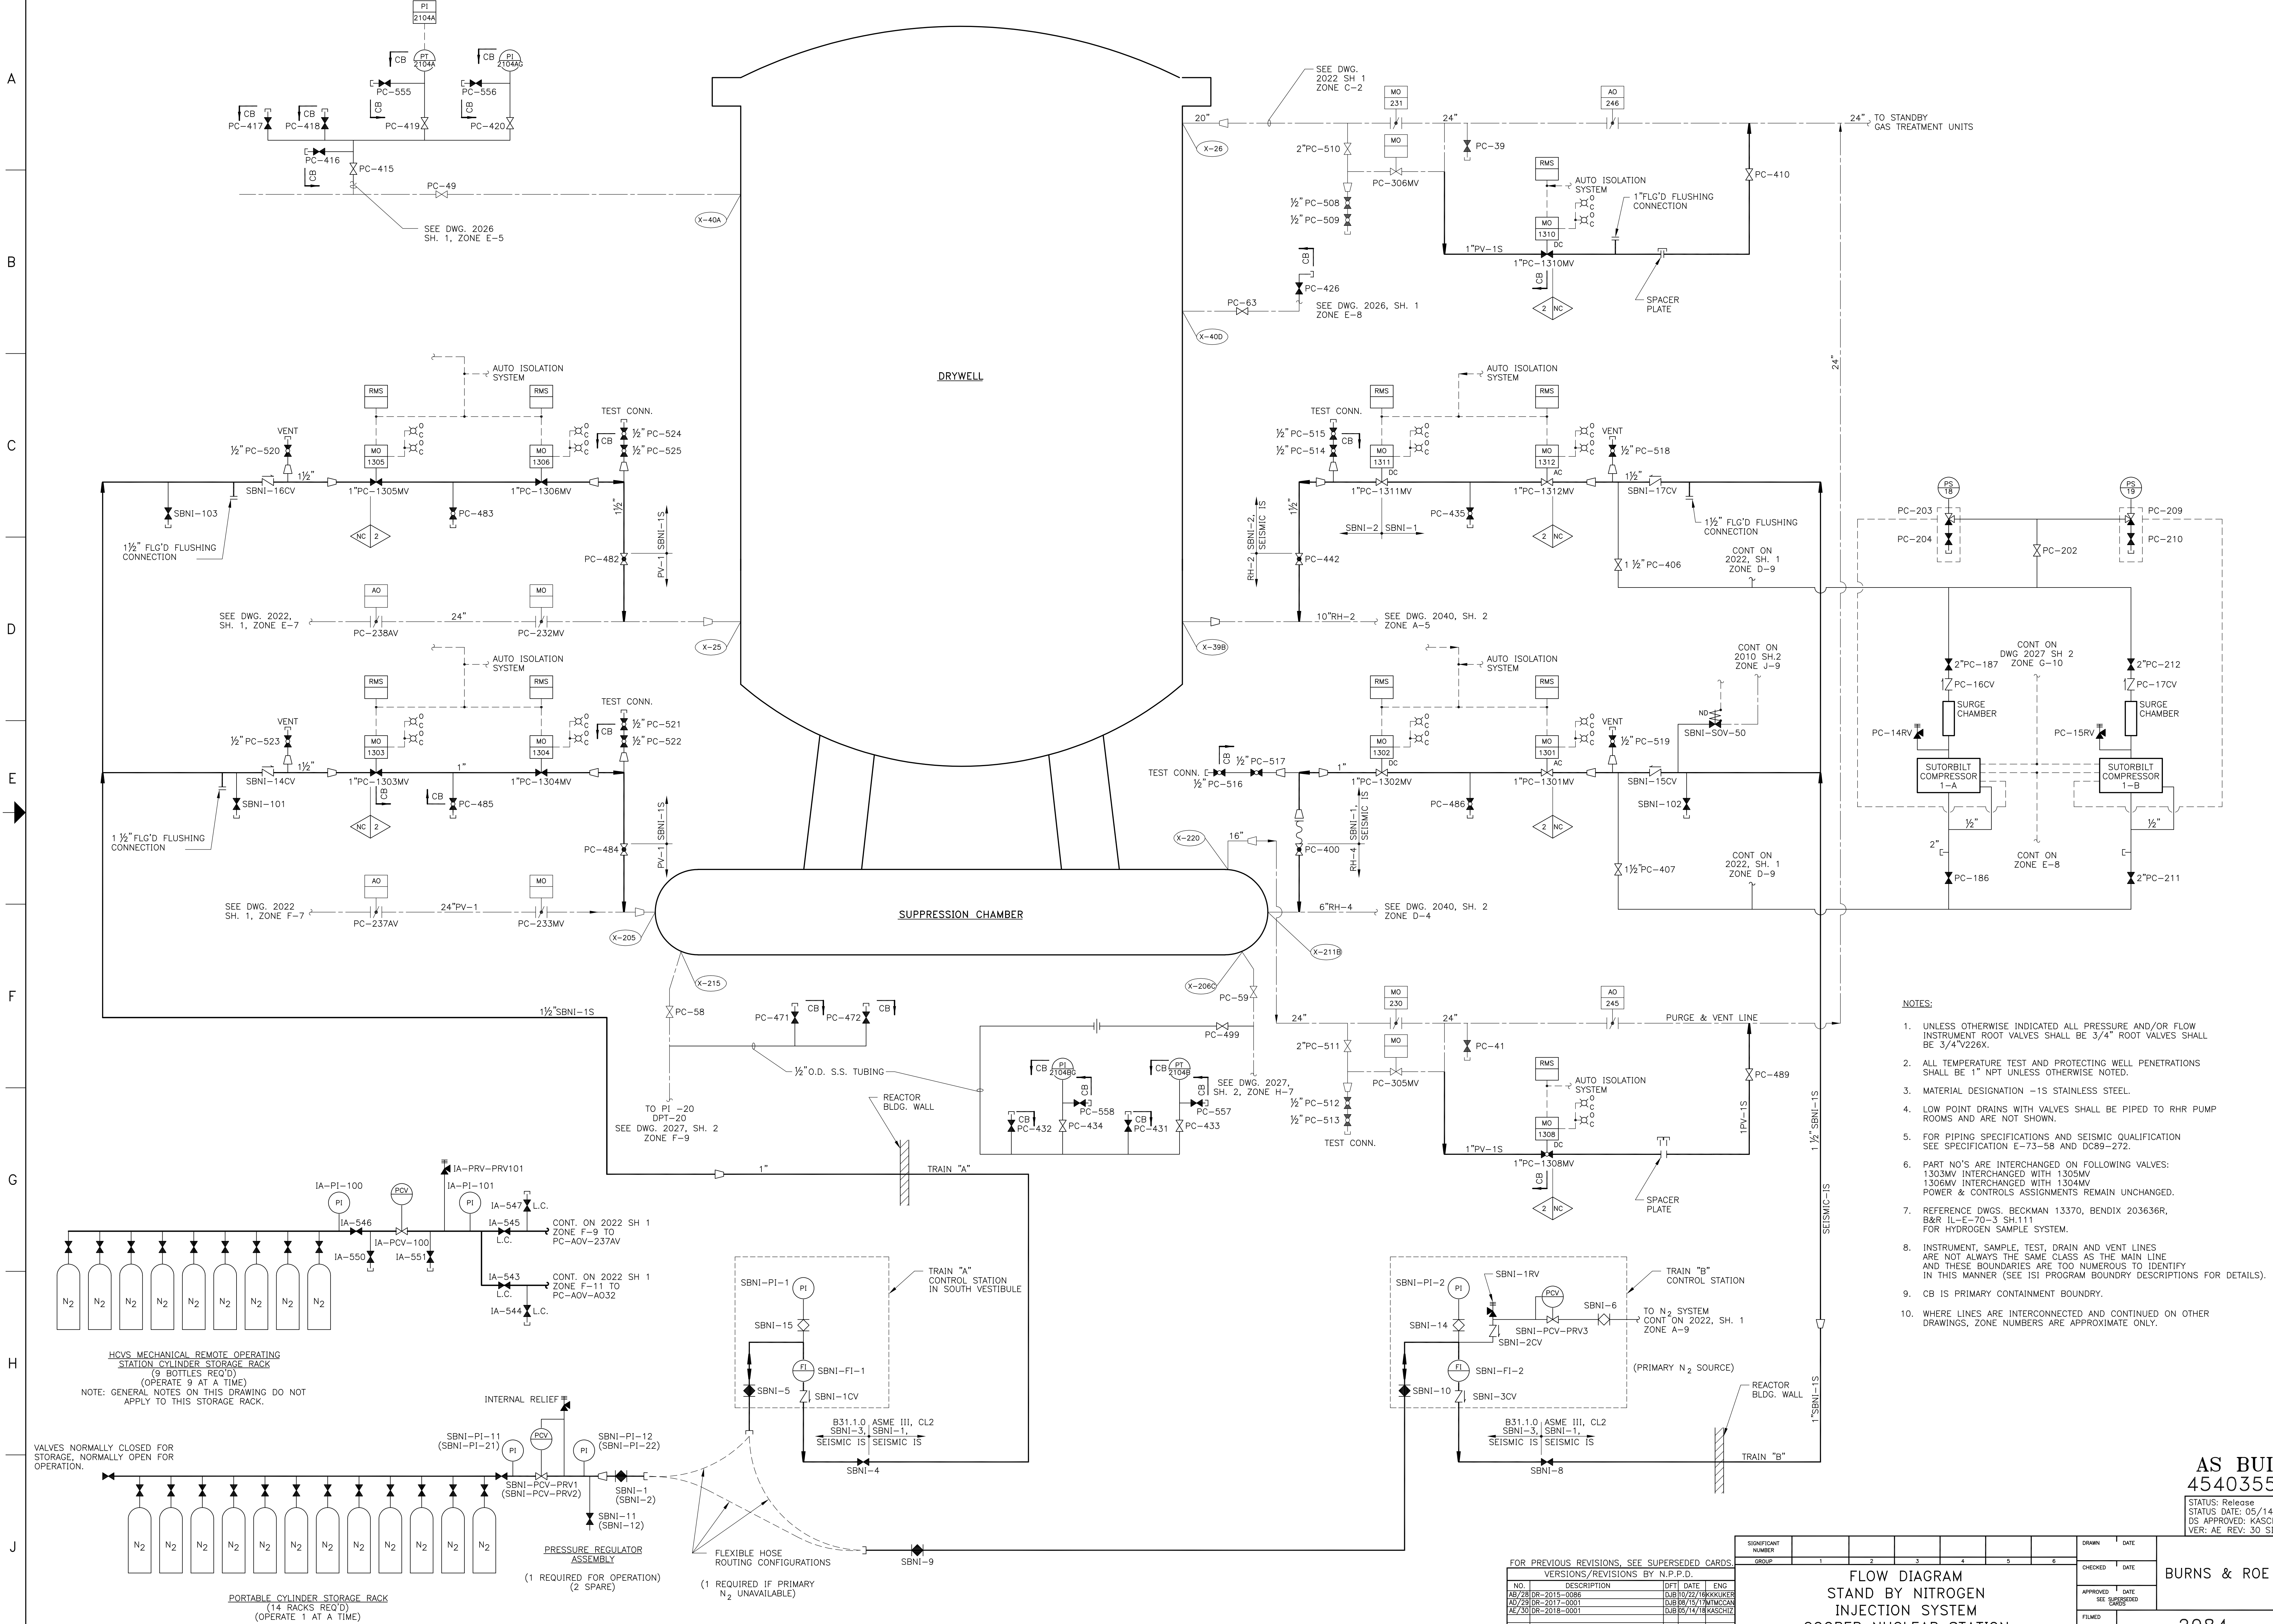

- NOTES:**
- UNLESS OTHERWISE INDICATED ALL PRESSURE AND/OR FLOW INSTRUMENT ROOT VALVES SHALL BE 3/4" ROOT VALVES SHALL BE 3/4"V226X.
  - ALL TEMPERATURE TEST AND PROTECTING WELL PENETRATIONS SHALL BE 1" NPT UNLESS OTHERWISE NOTED.
  - MATERIAL DESIGNATION -1S STAINLESS STEEL.
  - LOW POINT DRAINS WITH VALVES SHALL BE PIPED TO RHR PUMP ROOMS AND ARE NOT SHOWN.
  - FOR PIPING SPECIFICATIONS AND SEISMIC QUALIFICATION SEE SPECIFICATION E-73-5B AND DC89-272.
  - PART NO'S ARE INTERCHANGED ON FOLLOWING VALVES: 1303MV INTERCHANGED WITH 1303MV, 1306MV INTERCHANGED WITH 1304MV, POWER & CONTROLS ASSIGNMENTS REMAIN UNCHANGED.
  - REFERENCE DWGS. BECKMAN 13370, BENDIX 203636R, B&R IL-E-70-3 SH.111 FOR HYDROGEN SAMPLE SYSTEM.
  - INSTRUMENT, SAMPLE, TEST, DRAIN AND VENT LINES ARE NOT ALWAYS THE SAME CLASS AS THE MAIN LINE AND THESE BOUNDARIES ARE TOO NUMEROUS TO IDENTIFY IN THIS MANNER (SEE ISI PROGRAM BOUNDARY DESCRIPTIONS FOR DETAILS).
  - CB IS PRIMARY CONTAINMENT BOUNDARY.
  - WHERE LINES ARE INTERCONNECTED AND CONTINUED ON OTHER DRAWINGS, ZONE NUMBERS ARE APPROXIMATE ONLY.

**AS BUILT**  
454035514  
STATUS: Release  
STATUS DATE: 05/14/2018  
DS APPROVED: KASCHIZ  
VER: AE REV: 30 SIZE: F

FOR PREVIOUS REVISIONS, SEE SUPERSEDED CARDS.

NO.	DESCRIPTION	DFT	DATE	ENG
AB/28/DR-2015-0086			03/07/22/18	KURKUR
AL/29/DR-2017-0081			03/08/17	MATTICAN
AL/30/DR-2018-0001			03/05/14/18	KASCHIZ

GROUP	1	2	3	4	5	6	7	8	9	10	11	12
SIGNIFICANT NUMBER												
DRAWN												
DATE												
CHECKED												
DATE												
APPROVED												
DATE												
FILED												

**FLOW DIAGRAM  
STAND BY NITROGEN  
INJECTION SYSTEM  
COOPER NUCLEAR STATION**


**BURNS & ROE**  
2084

SHEET NO. C0017984



SECURITY-RELATED INFORMATION -  
WITHHOLD UNDER 10 CFR 2.390

DRAWING 2298  
RADWASTE BUILDING,  
CONVEYOR OPERATING AREAS  
PLANS AND SECTIONS

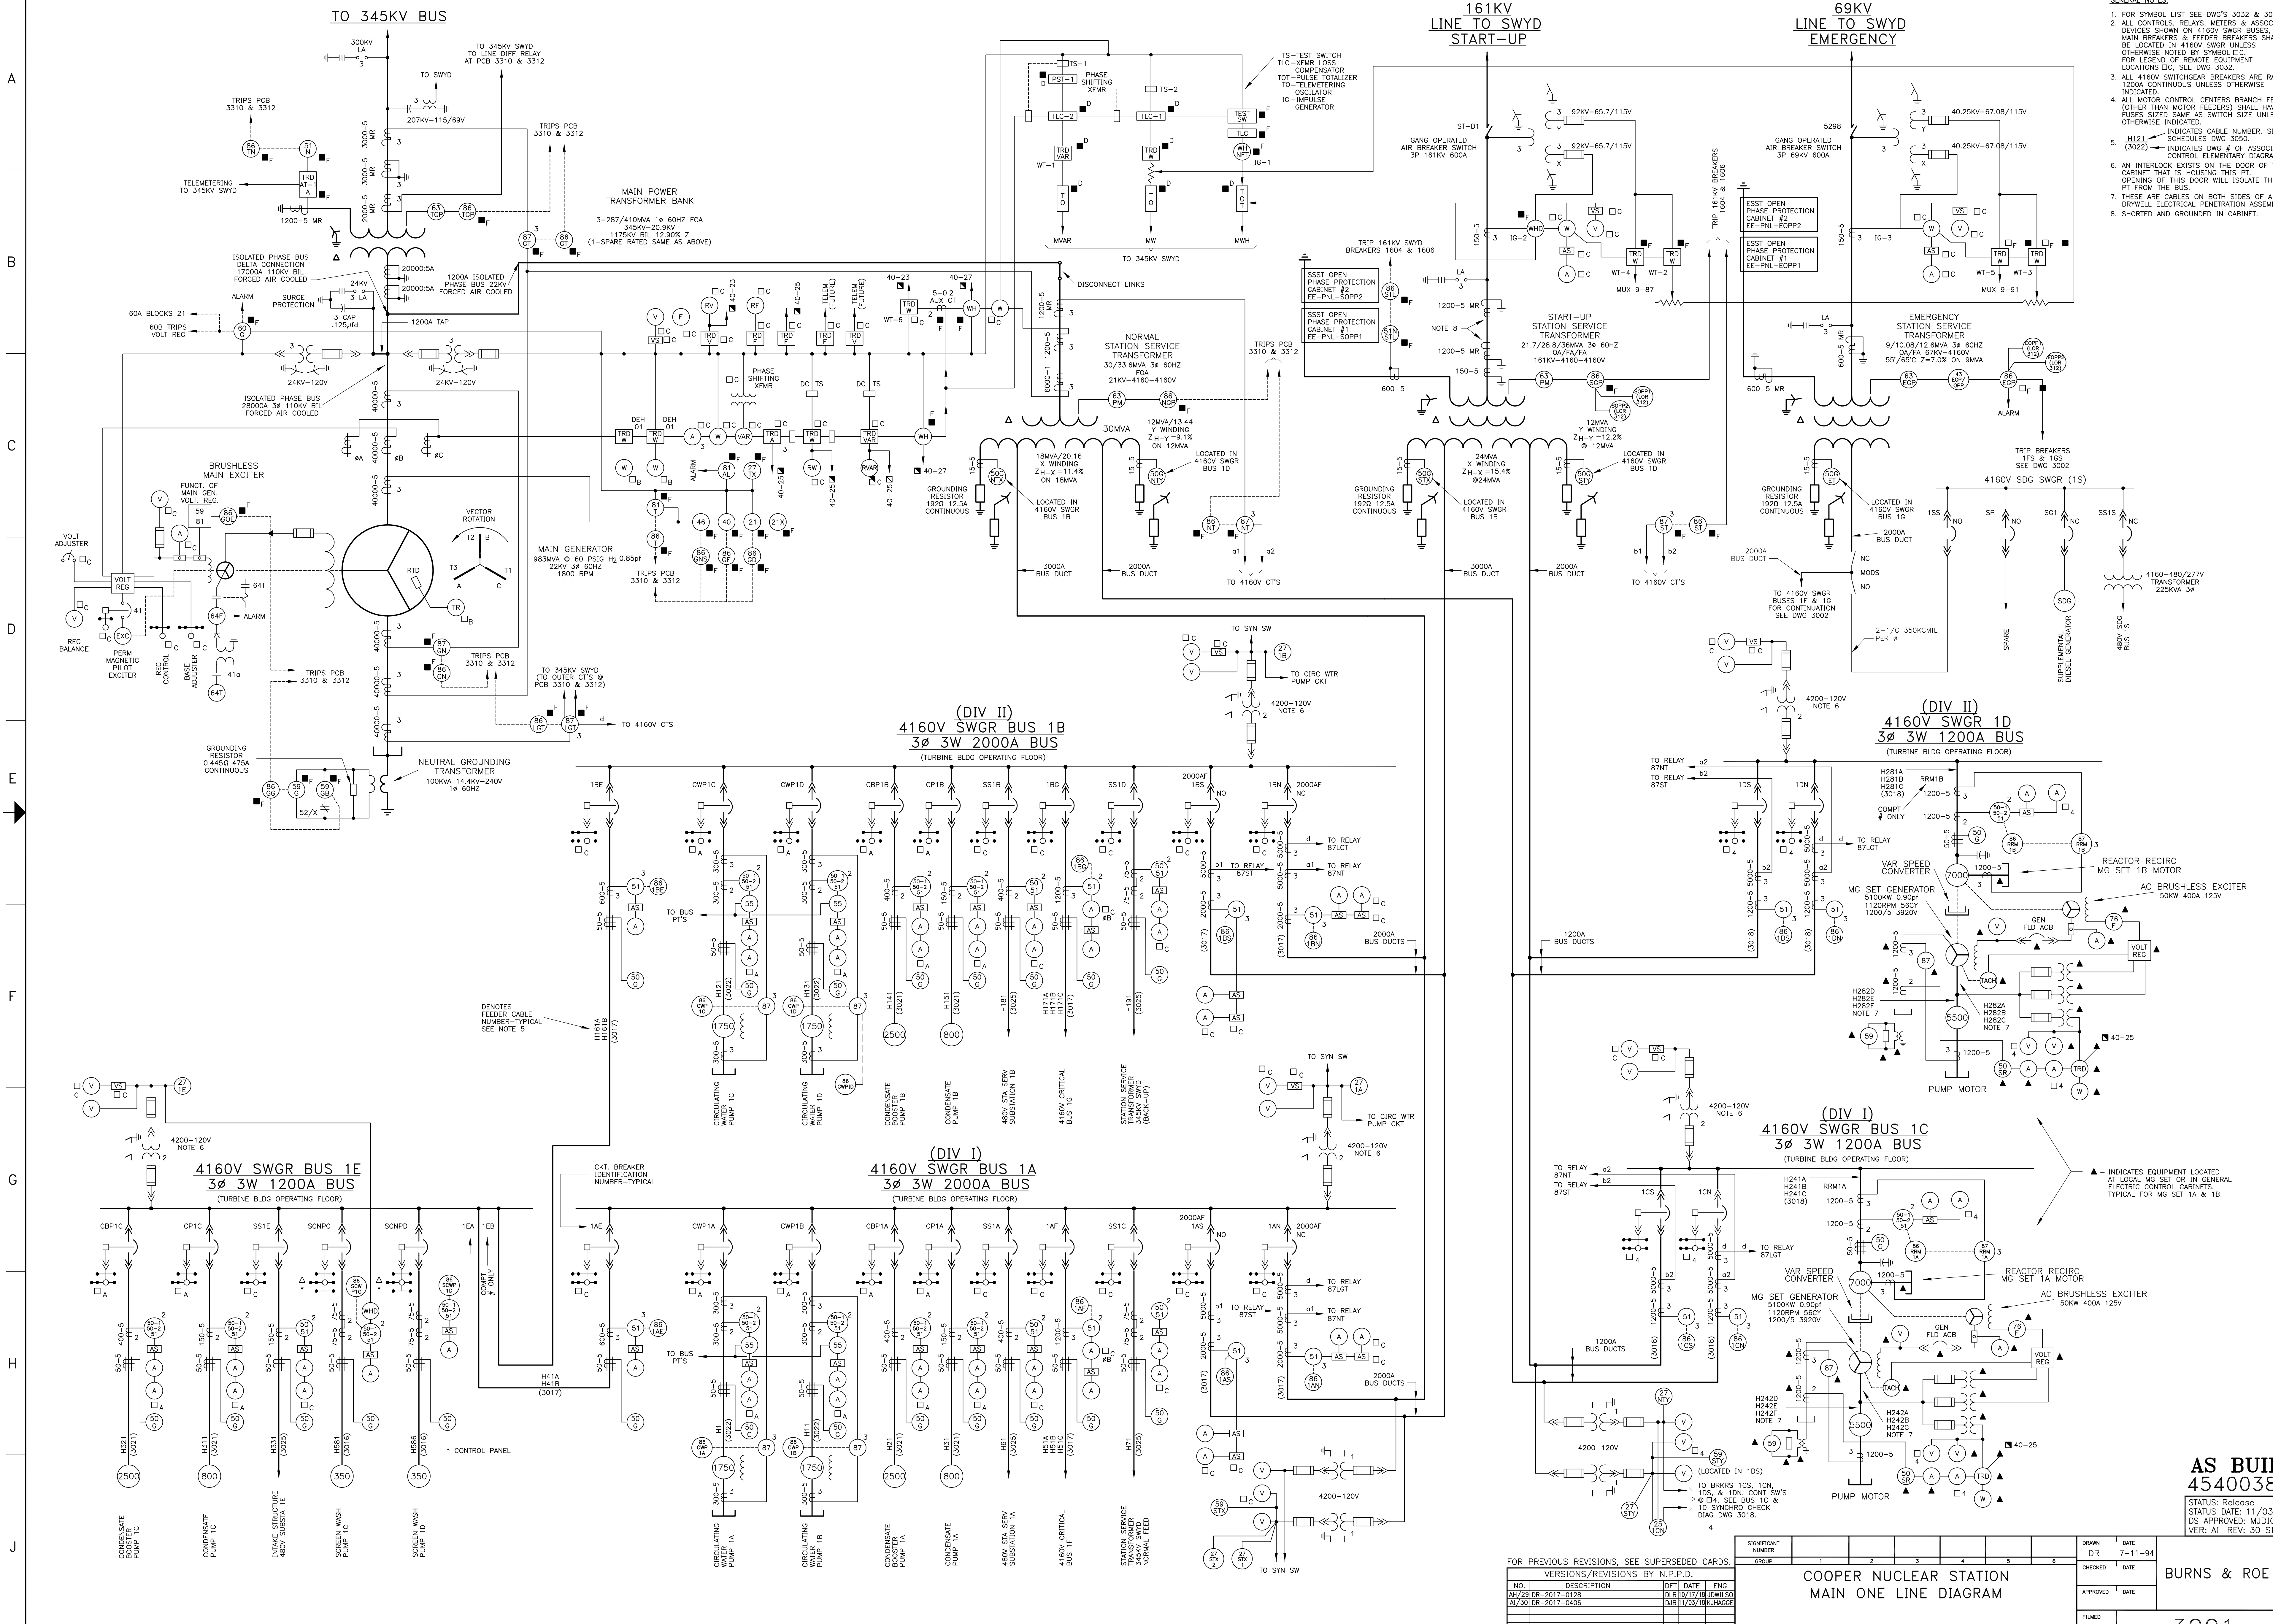

VERSIONS/REVISIONS BY N.P.P.D.			
NO.	DESCRIPTION	DFT DATE	ENG
AH/29/DR-2017-0128		06/16/17	JDM/LSO
AU/30/DR-2017-0406		08/17/17	HCN/AGC


SIGNIFICANT NUMBER		DATE	
GROUP	NO.	DR	DATE
1	1	7-11-94	
2	2		
3	3		
4	4		
5	5		
6	6		

APPROVED		DATE	FILMED
DRAWN		DATE	
CHECKED		DATE	
DESIGNED		DATE	

AS BUILT 454003876		COOPER NUCLEAR STATION MAIN ONE LINE DIAGRAM	BURNS & ROE
STATUS: Release STATUS DATE: 11/03/2018 DS APPROVED: MJD/CKE VER: AT REV: 30 SIZE: F			



**EQUIPMENT DEVICE LEGEND**

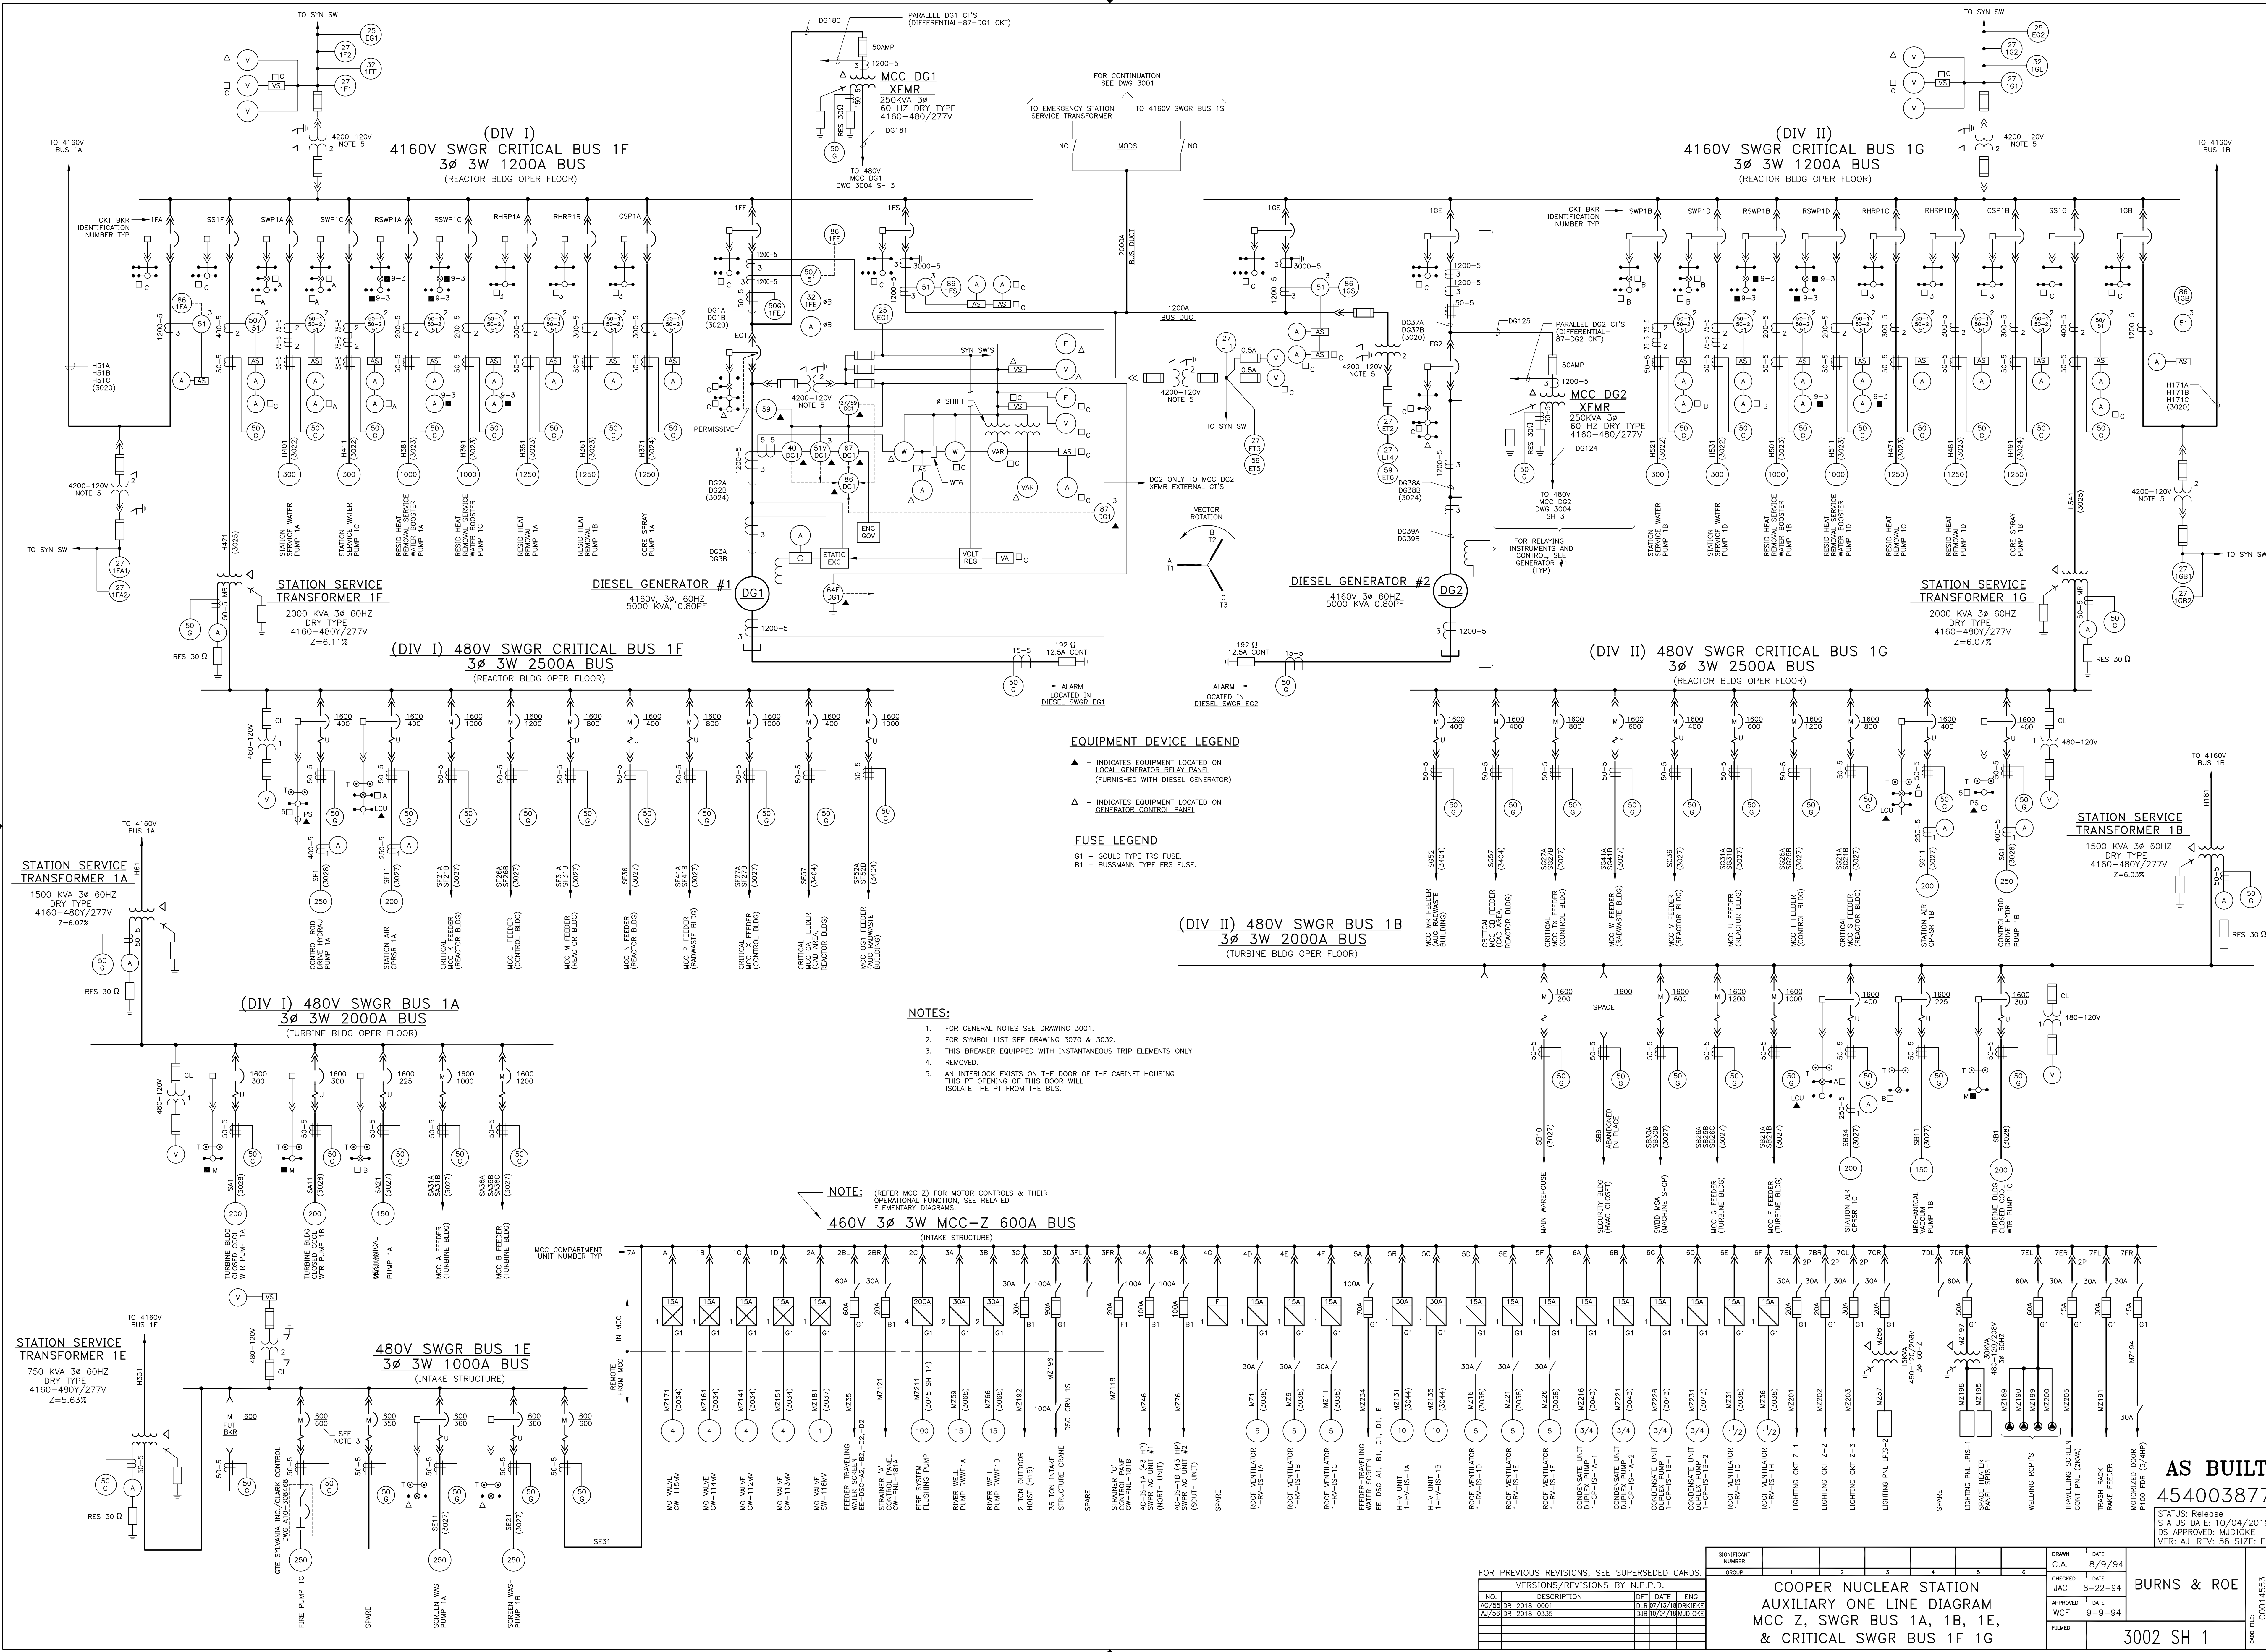- ▲ - INDICATES EQUIPMENT LOCATED ON LOCAL GENERATOR RELAY PANEL (FURNISHED WITH DIESEL GENERATOR)
- △ - INDICATES EQUIPMENT LOCATED ON GENERATOR CONTROL PANEL

**FUSE LEGEND**


- G1 - GOULD TYPE TRS FUSE.
- B1 - BUSMANN TYPE FRG FUSE.

**NOTES:**

- FOR GENERAL NOTES SEE DRAWING 3001.
- FOR SYMBOL LIST SEE DRAWING 3070 & 3032.
- THIS BREAKER EQUIPPED WITH INSTANTANEOUS TRIP ELEMENTS ONLY.
- REMOVED.
- AN INTERLOCK EXISTS ON THE DOOR OF THE CABINET HOUSING THIS ON OPENING OF THIS DOOR WILL ISOLATE THE PT FROM THE BUS.

**NOTE:** (REFER MCC 2) FOR MOTOR CONTROLS & THEIR OPERATIONAL FUNCTION, SEE RELATED ELEMENTARY DIAGRAMS.

**460V 3Ø 3W MCC-Z 600A BUS**

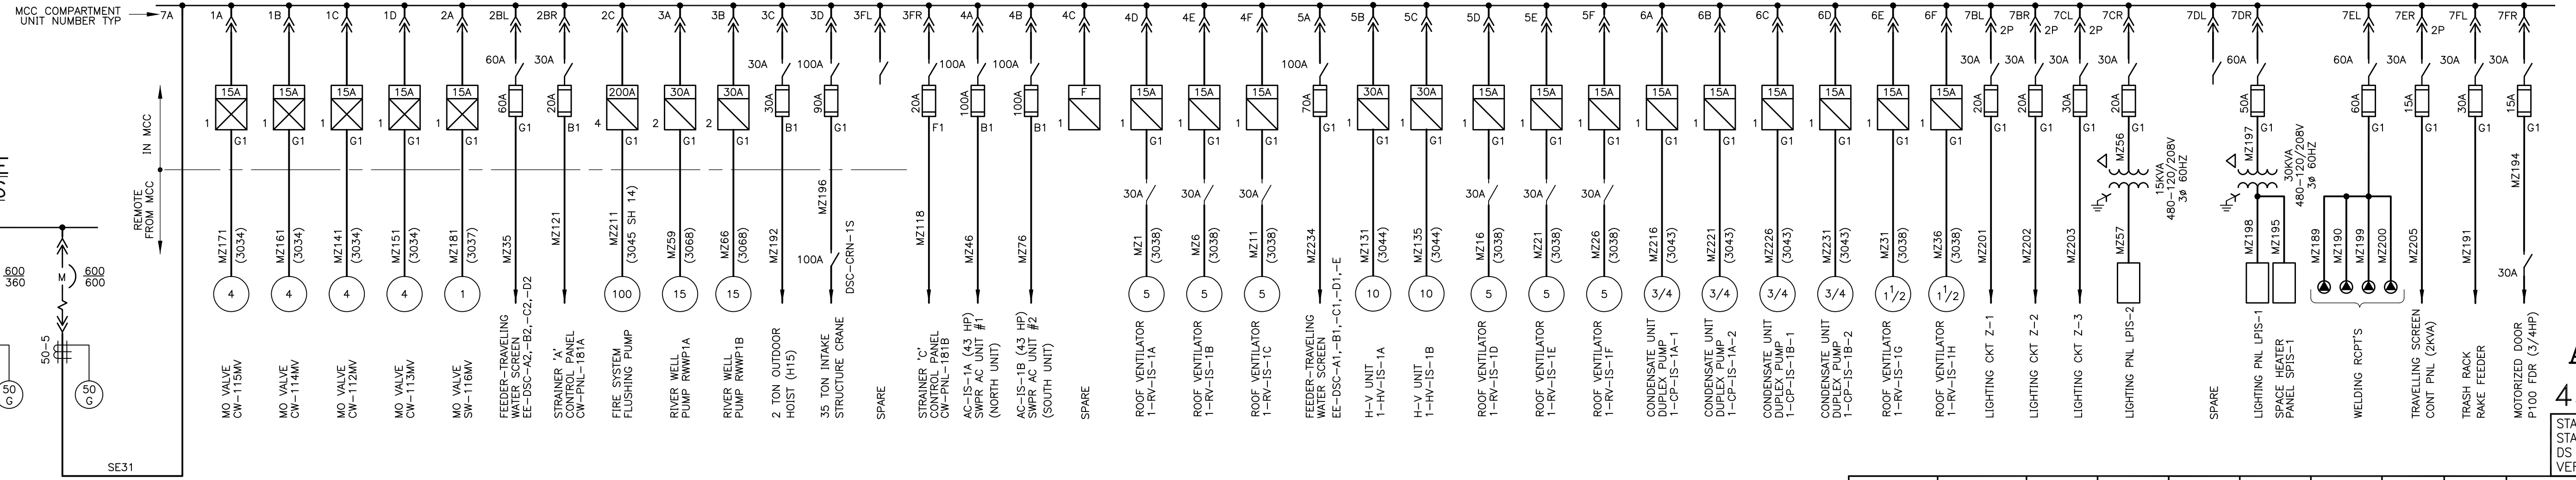

FOR PREVIOUS REVISIONS, SEE SUPERSEDED CARDS.

VERSIONS/REVISIONS BY N.P.P.D.			
NO.	DESCRIPTION	DFT	DATE
01/25/01	DR-2018-0001	DR	07/13/18
02/26/01	DR-2018-0335	DR	03/14/18

**COOPER NUCLEAR STATION**  
**AUXILIARY ONE LINE DIAGRAM**  
**MCC 1, SWGR BUS 1A, 1B, 1E,**  
**& CRITICAL SWGR BUS 1F 1G**

GROUP	1	2	3	4	5	6
SIGNIFICANT NUMBER						





STATUS: Release  
 STATUS DATE: 10/04/2018  
 DS APPROVED: MUDICKE  
 VER: AJ REV: 56 SIZE: F

**AS BUILT**  
**454003877**

DATE: 8/9/94  
 CHECKED: JAC  
 DATE: 8-22-94  
 APPROVED: WCF  
 DATE: 9-9-94

**BURNS & ROE**

3002 SH 1

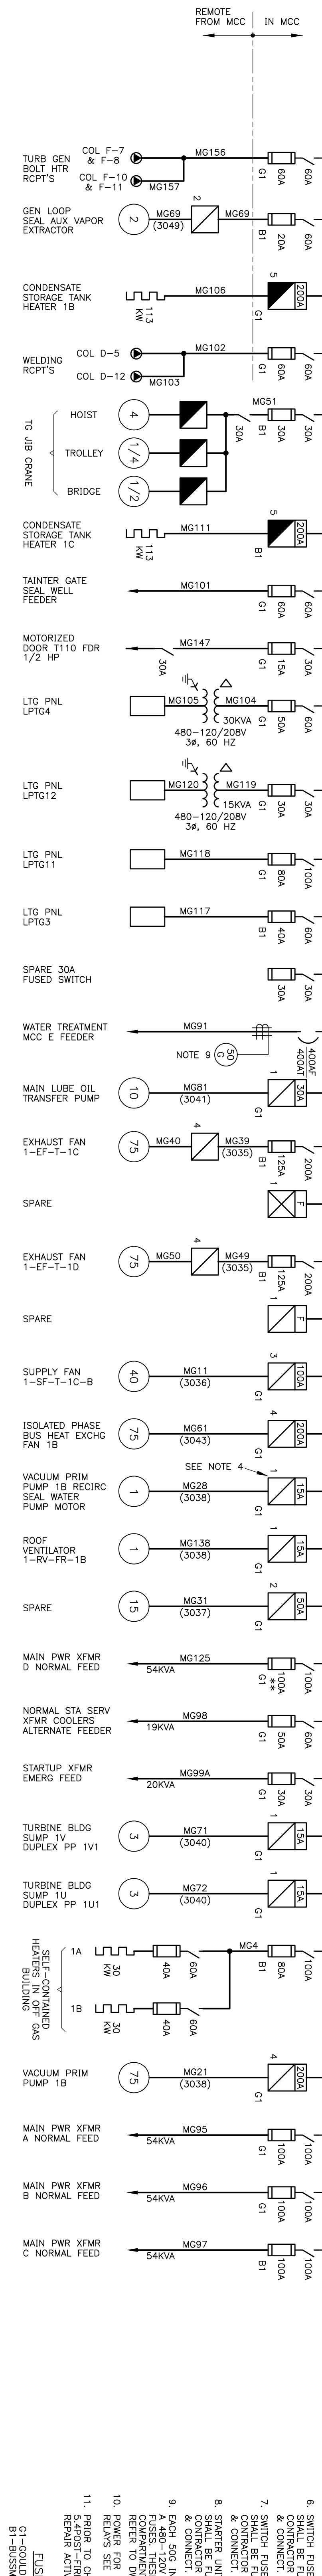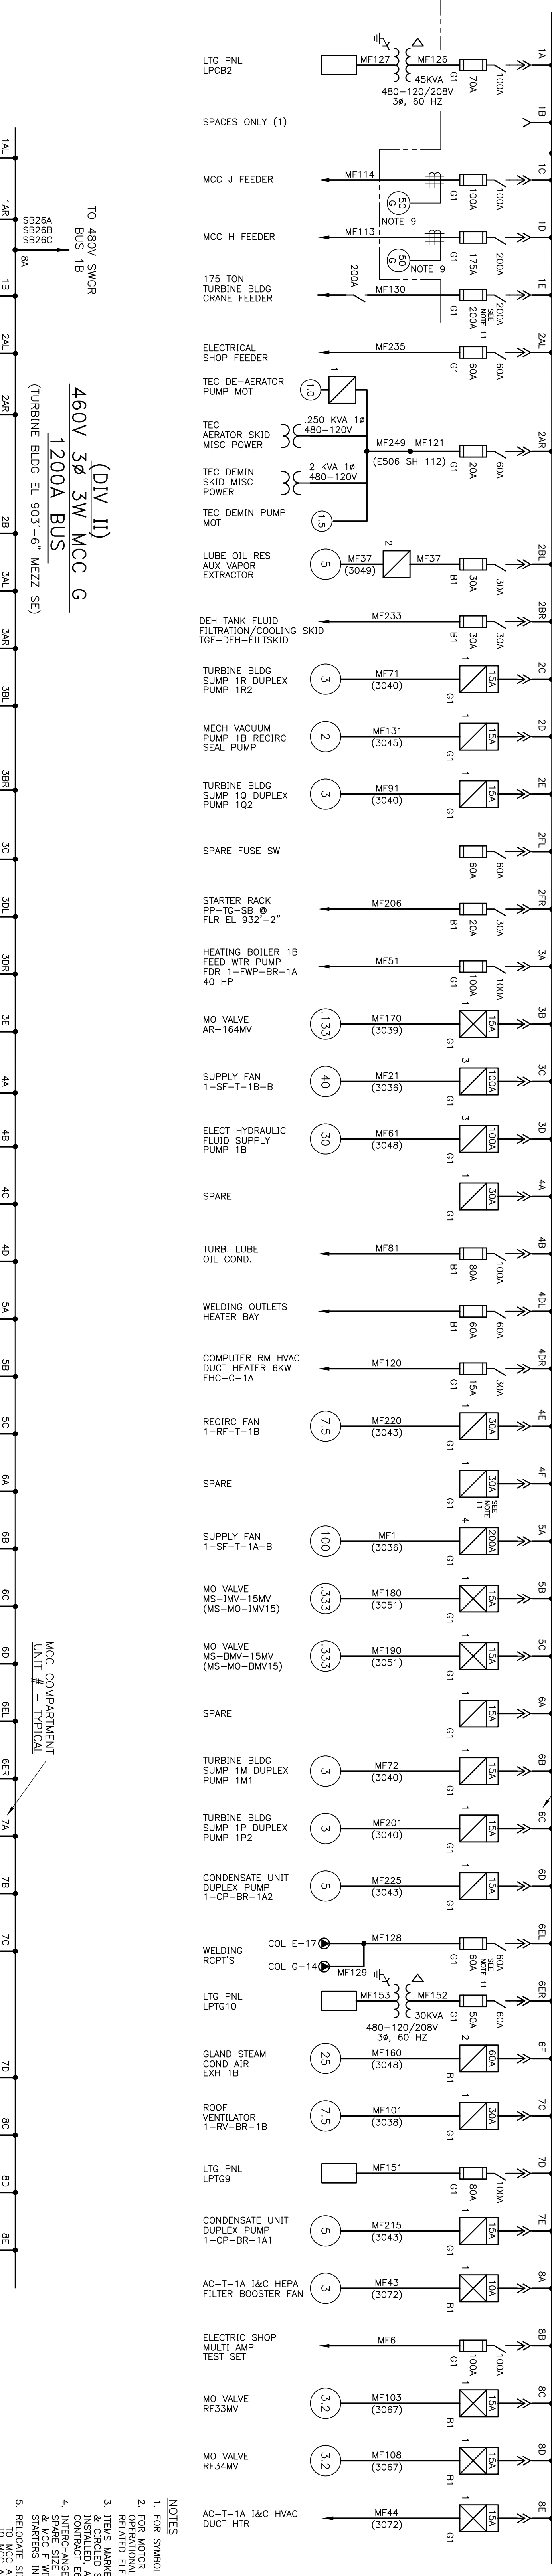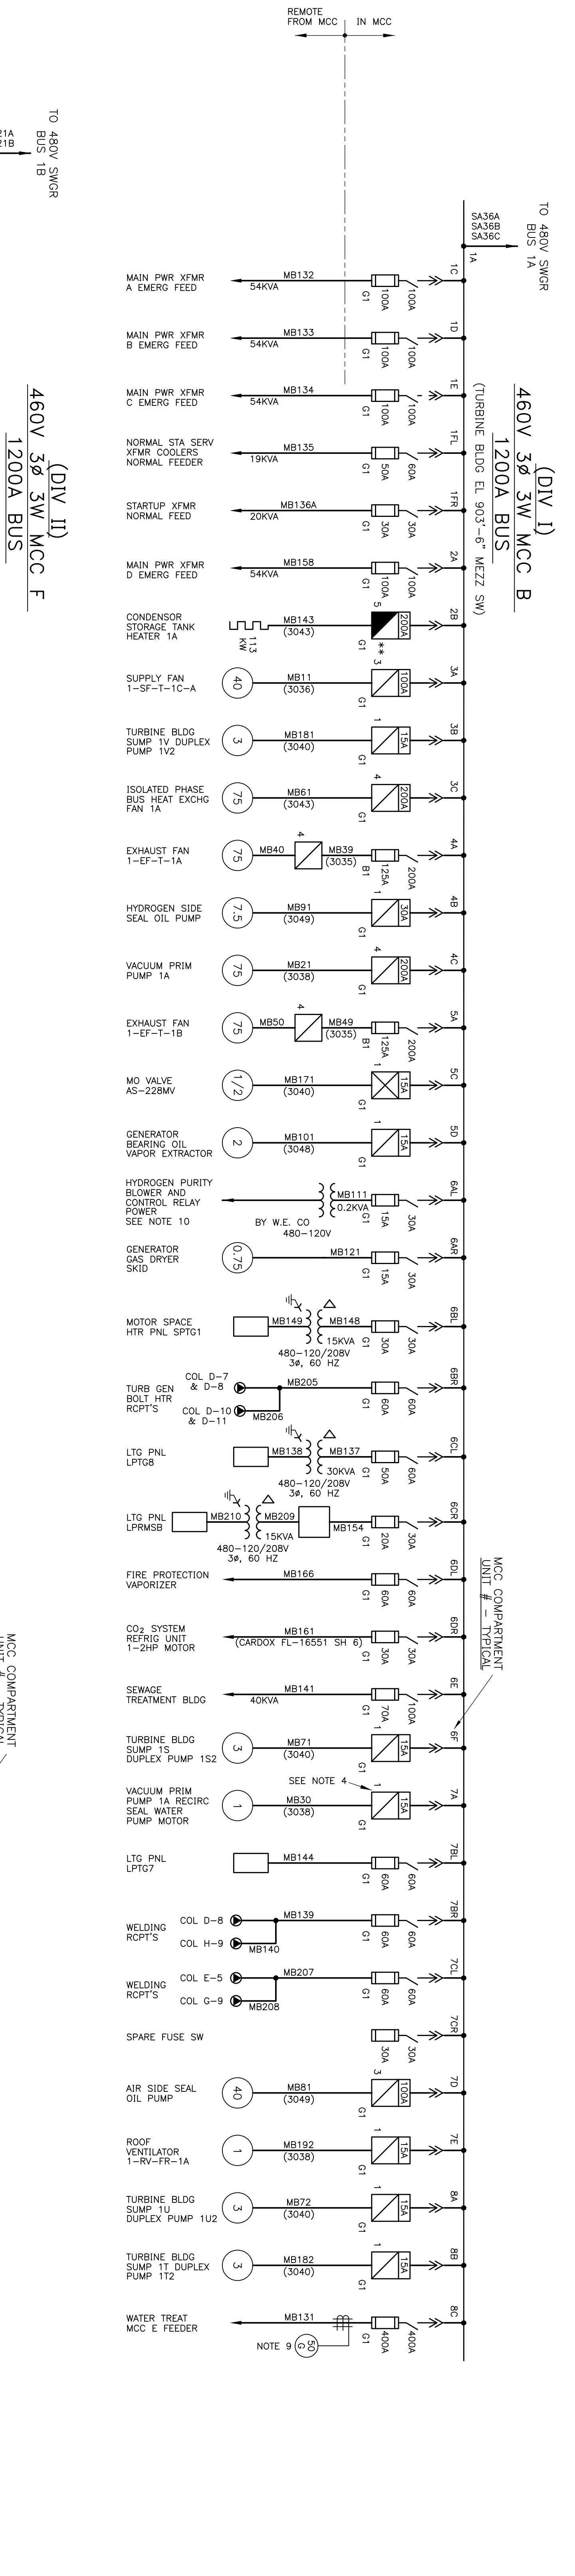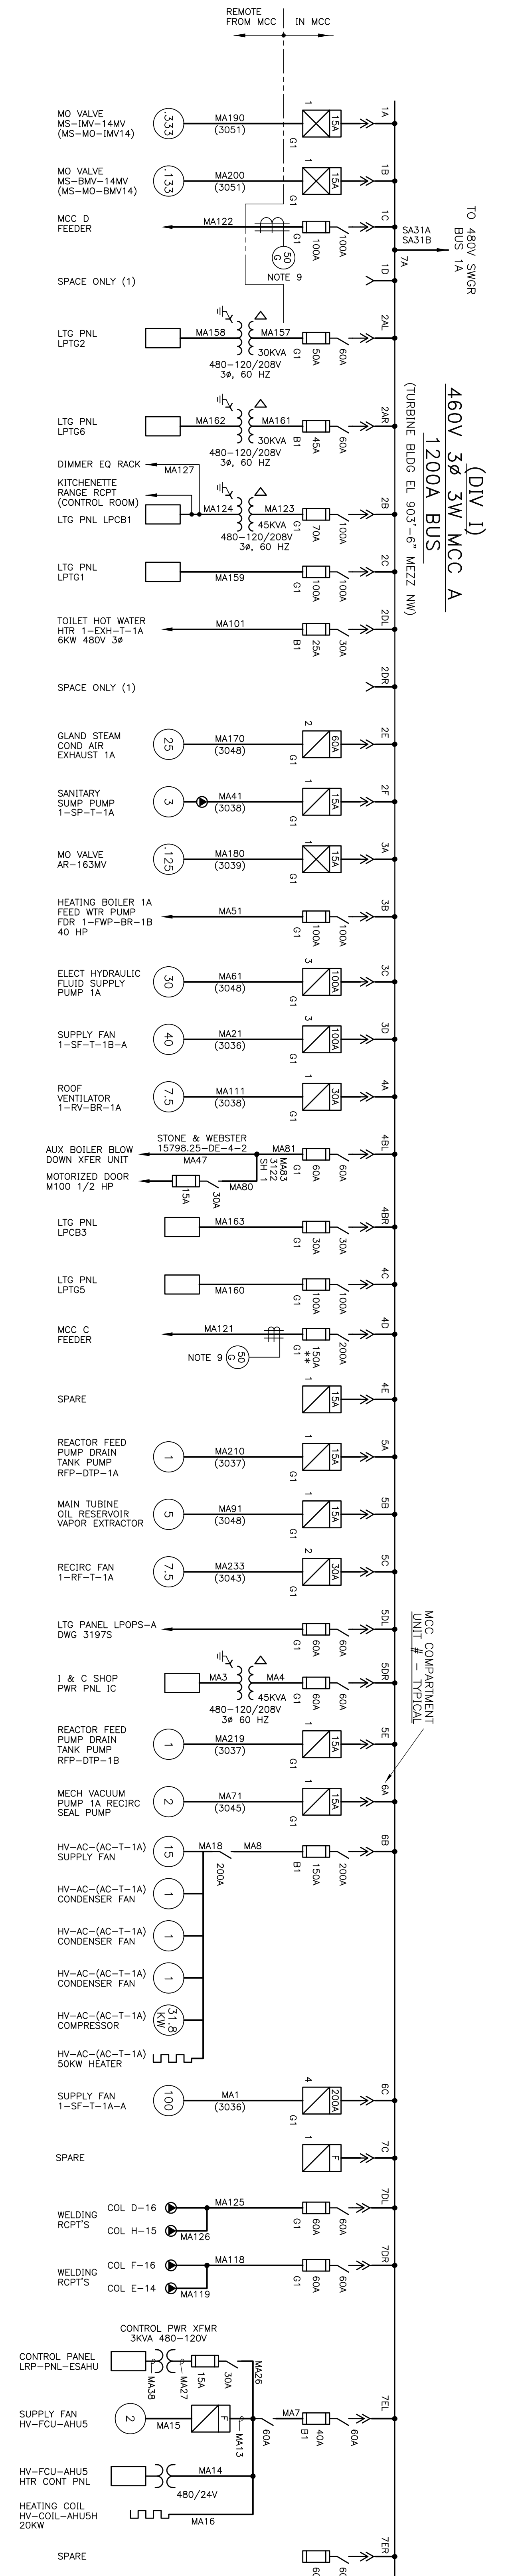

NOTES:  
 1. SEE SWING LIST FOR PUMP MOTOR.  
 2. FOR MOTOR CONTROLS & THEIR OPERATIONAL FUNCTION, SEE SWING LIST.  
 3. ITEMS MARKED WITH AN asterisk \* & CIRCLED SHALL BE FURNISHED BY CONTRACTOR (E99-17) SHALL INSTALL.  
 4. INTERFERENCES WHERE NOTED ON THIS DRAWING SHALL BE CORRECTED BY CONTRACTOR.  
 5. SWITCHES SHALL BE FURNISHED BY CONTRACTOR.  
 6. SWITCHES SHALL BE FURNISHED BY CONTRACTOR.  
 7. SWITCHES SHALL BE FURNISHED BY CONTRACTOR.  
 8. SWITCHES SHALL BE FURNISHED BY CONTRACTOR.  
 9. SWITCHES SHALL BE FURNISHED BY CONTRACTOR.  
 10. SWITCHES SHALL BE FURNISHED BY CONTRACTOR.  
 11. PRIOR TO CHANGING THIS FUSE SIZE, REVIEW EFFECTS ON MAINS AND ALL OTHER EQUIPMENT.  
 12. PRIOR TO CHANGING THIS FUSE SIZE, REVIEW EFFECTS ON MAINS AND ALL OTHER EQUIPMENT.  
 13. PRIOR TO CHANGING THIS FUSE SIZE, REVIEW EFFECTS ON MAINS AND ALL OTHER EQUIPMENT.  
 14. PRIOR TO CHANGING THIS FUSE SIZE, REVIEW EFFECTS ON MAINS AND ALL OTHER EQUIPMENT.  
 15. PRIOR TO CHANGING THIS FUSE SIZE, REVIEW EFFECTS ON MAINS AND ALL OTHER EQUIPMENT.

NO.	DATE	DESCRIPTION	BY	CHKD
1	11-11-94	ISSUED FOR CONSTRUCTION	AS	AS
2	11-11-94	REVISED FOR CONSTRUCTION	AS	AS
3	11-11-94	REVISED FOR CONSTRUCTION	AS	AS
4	11-11-94	REVISED FOR CONSTRUCTION	AS	AS
5	11-11-94	REVISED FOR CONSTRUCTION	AS	AS
6	11-11-94	REVISED FOR CONSTRUCTION	AS	AS

FOR PREVIOUS REVISIONS SEE SUPERSEDED CARDS

COOPER NUCLEAR STATION  
 AUXILIARY ONE LINE DIAGRAM  
 MOTOR CONTROL CENTERS  
 A, B, F, & C


3003 SH 2

AS BUILT  
 454003878

STATUS: Released  
 DATE: 11/21/2019  
 BY: AS  
 CHECKED: AS  
 DATE: 11-21-94  
 APPROVED: AS  
 DATE: 11-21-94  
 REVISION: 11-21-94

BURNS & ROE

0014554

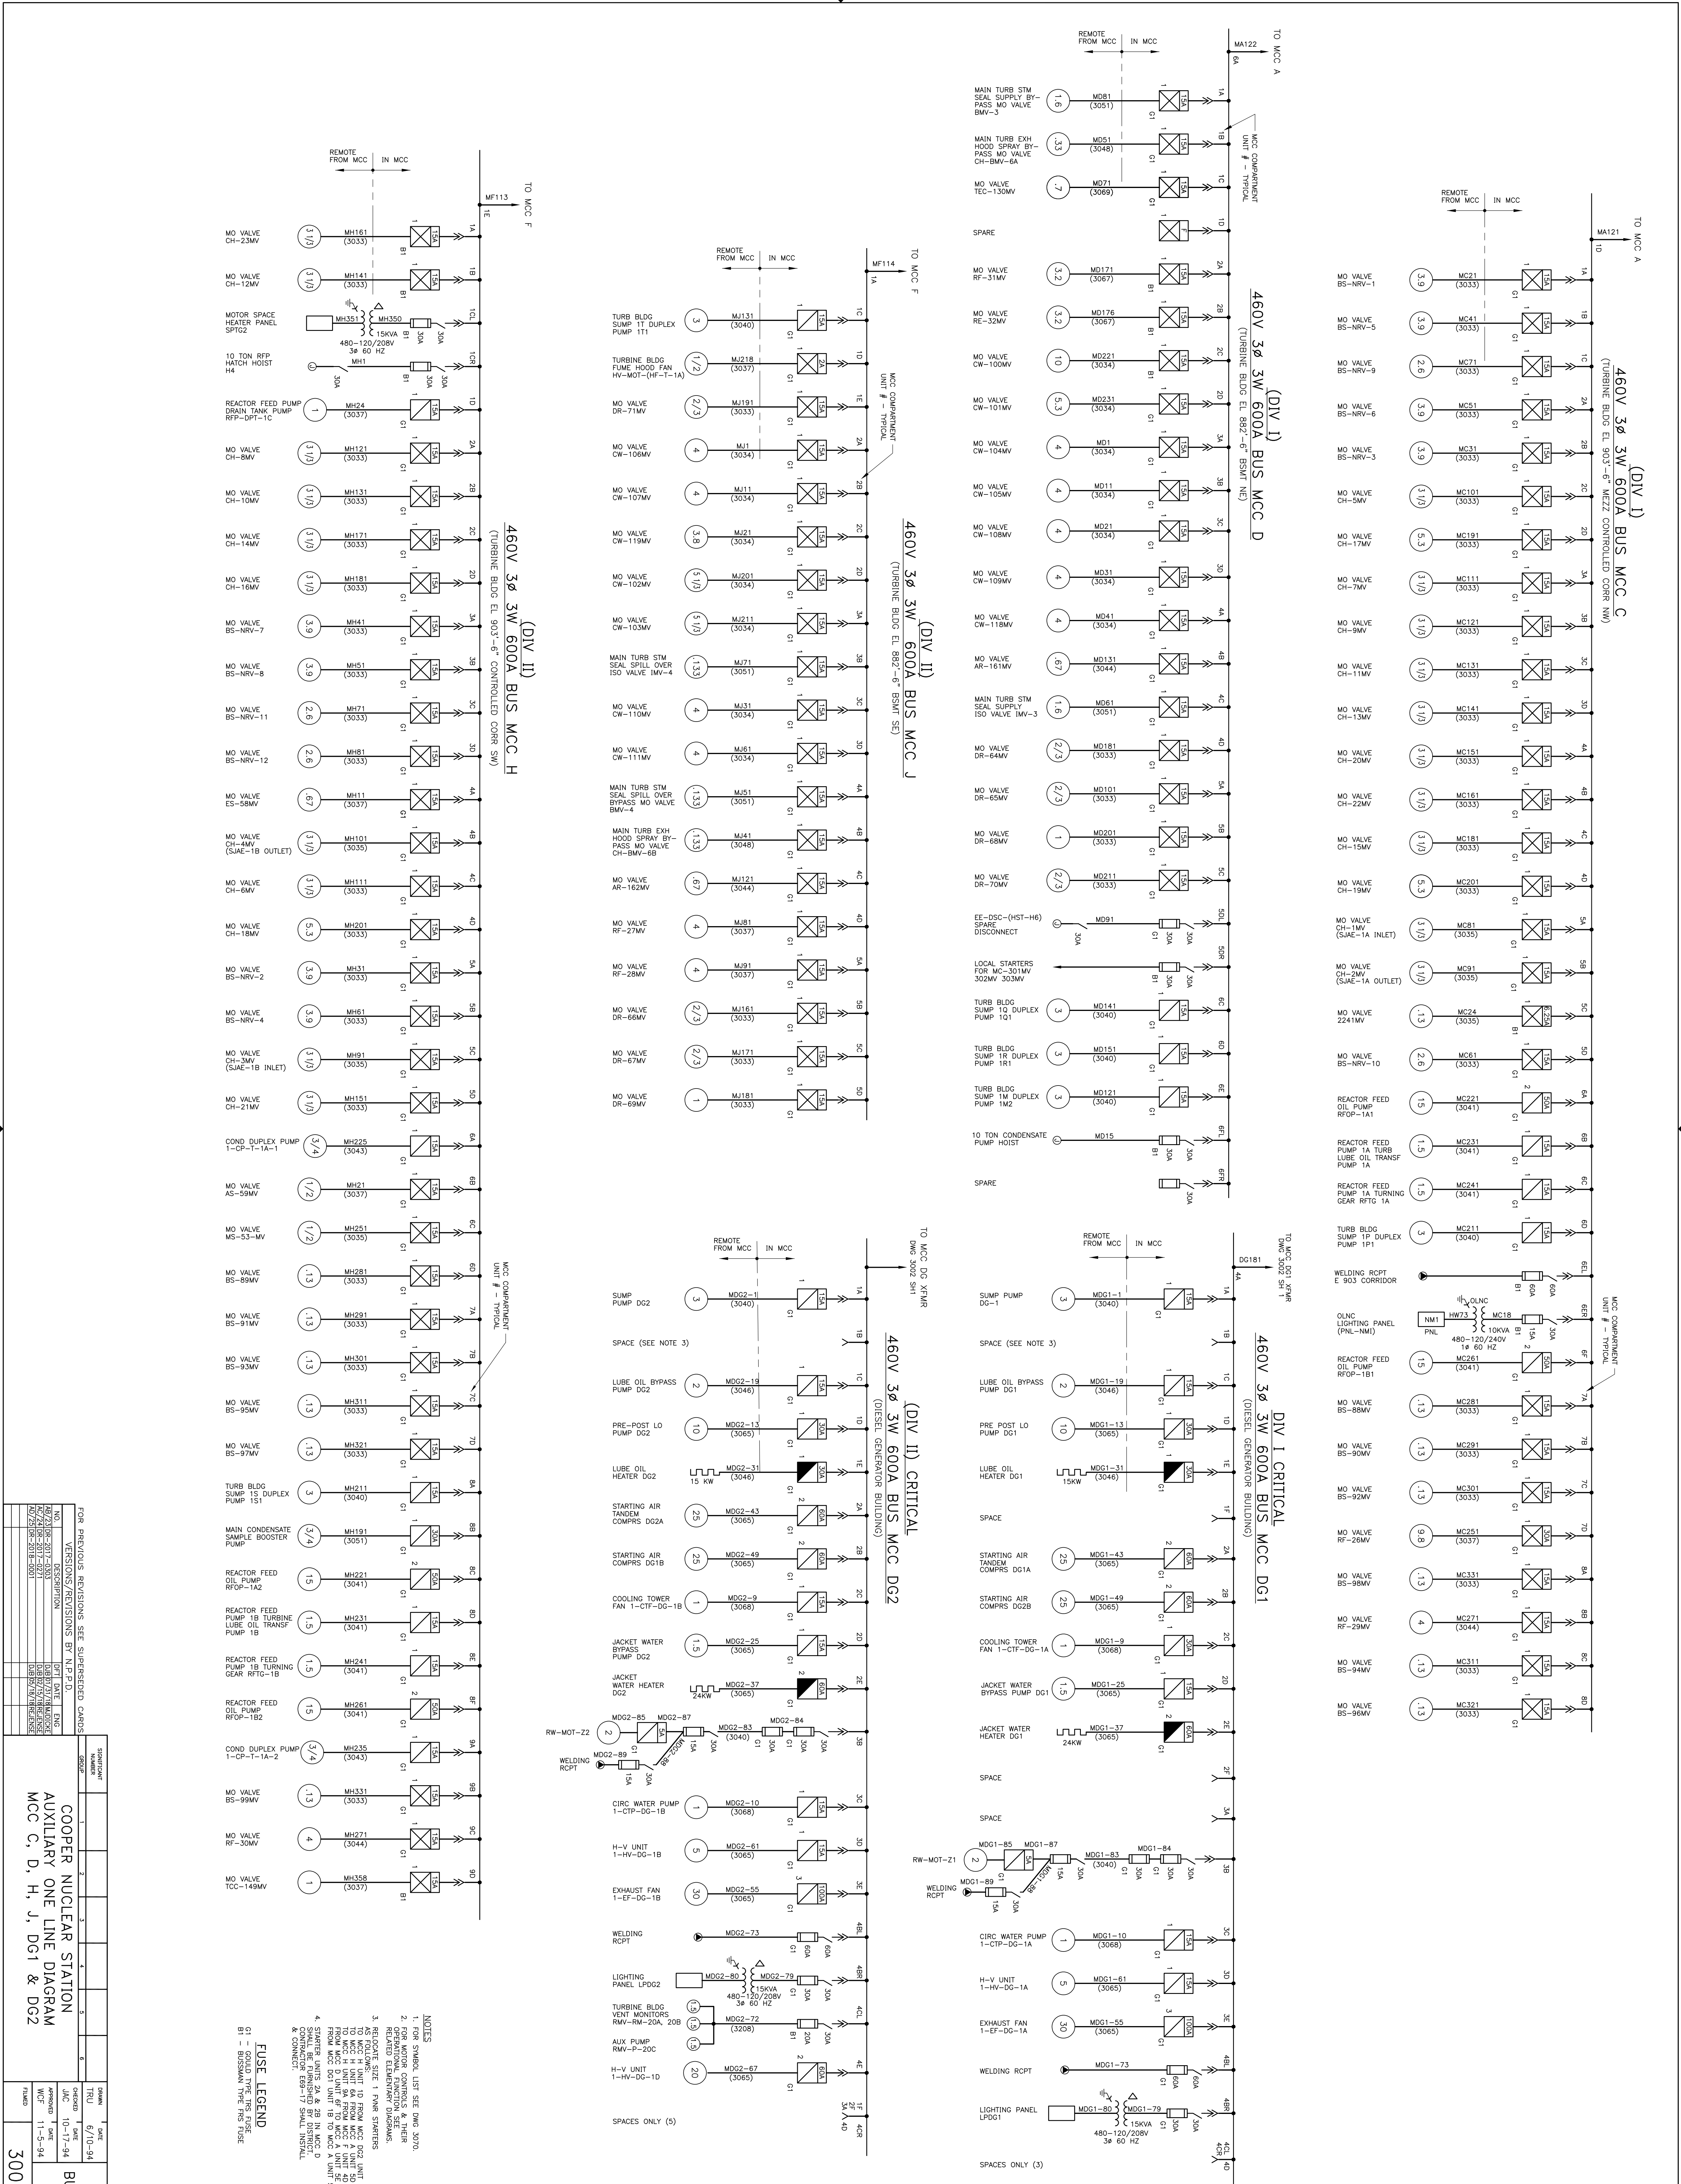

**AS BUILT**  
 454003879  
 STATUS: Released 1/19/2018  
 OS APPROVED, RELEASED  
 VERN AD REV. 23 SIZE: E

**COOPER NUCLEAR STATION**  
 AUXILIARY ONE LINE DIAGRAM  
 MCC C, D, H, J, DG1 & DG2

NO.	DATE	DESCRIPTION	BY	CHKD	APP'D
1	01-17-94	ISSUED	...	...	...
2	01-17-94	...	...	...	...
3	01-17-94	...	...	...	...
4	01-17-94	...	...	...	...
5	01-17-94	...	...	...	...
6	01-17-94	...	...	...	...

**3004 SH 3**

DATE: 6/10/94  
 DESIGNED BY: ...  
 CHECKED BY: ...  
 APPROVED BY: ...

**NOTES**

- FOR SYMBOL LIST SEE DWG 3070.
- FOR MOTOR CONTROLS & THEIR RELATED ELEMENTARY DIAGRAMS.
- RELUCTANT SIZE 1 PUMP STARTERS.
- TO MCC H UNIT 18 FROM MCC DG2 UNIT 18 FROM MCC D UNIT 6 FROM MCC A UNIT 20 FROM MCC G UNIT 17 TO MCC J UNIT 54. STARTER UNITS 2A & 2B IN MCC D SHALL BE DISPATCHED BY DISTRICT & CONNECT. E99=17 SHALL INSTAL.

**FUSE LEGEND**

B1 - DISCONNECT  
 B2 - DISCONNECT WITH FUSE