




REACTOR PROTECTION SYSTEM BLOCK DIAGRAM

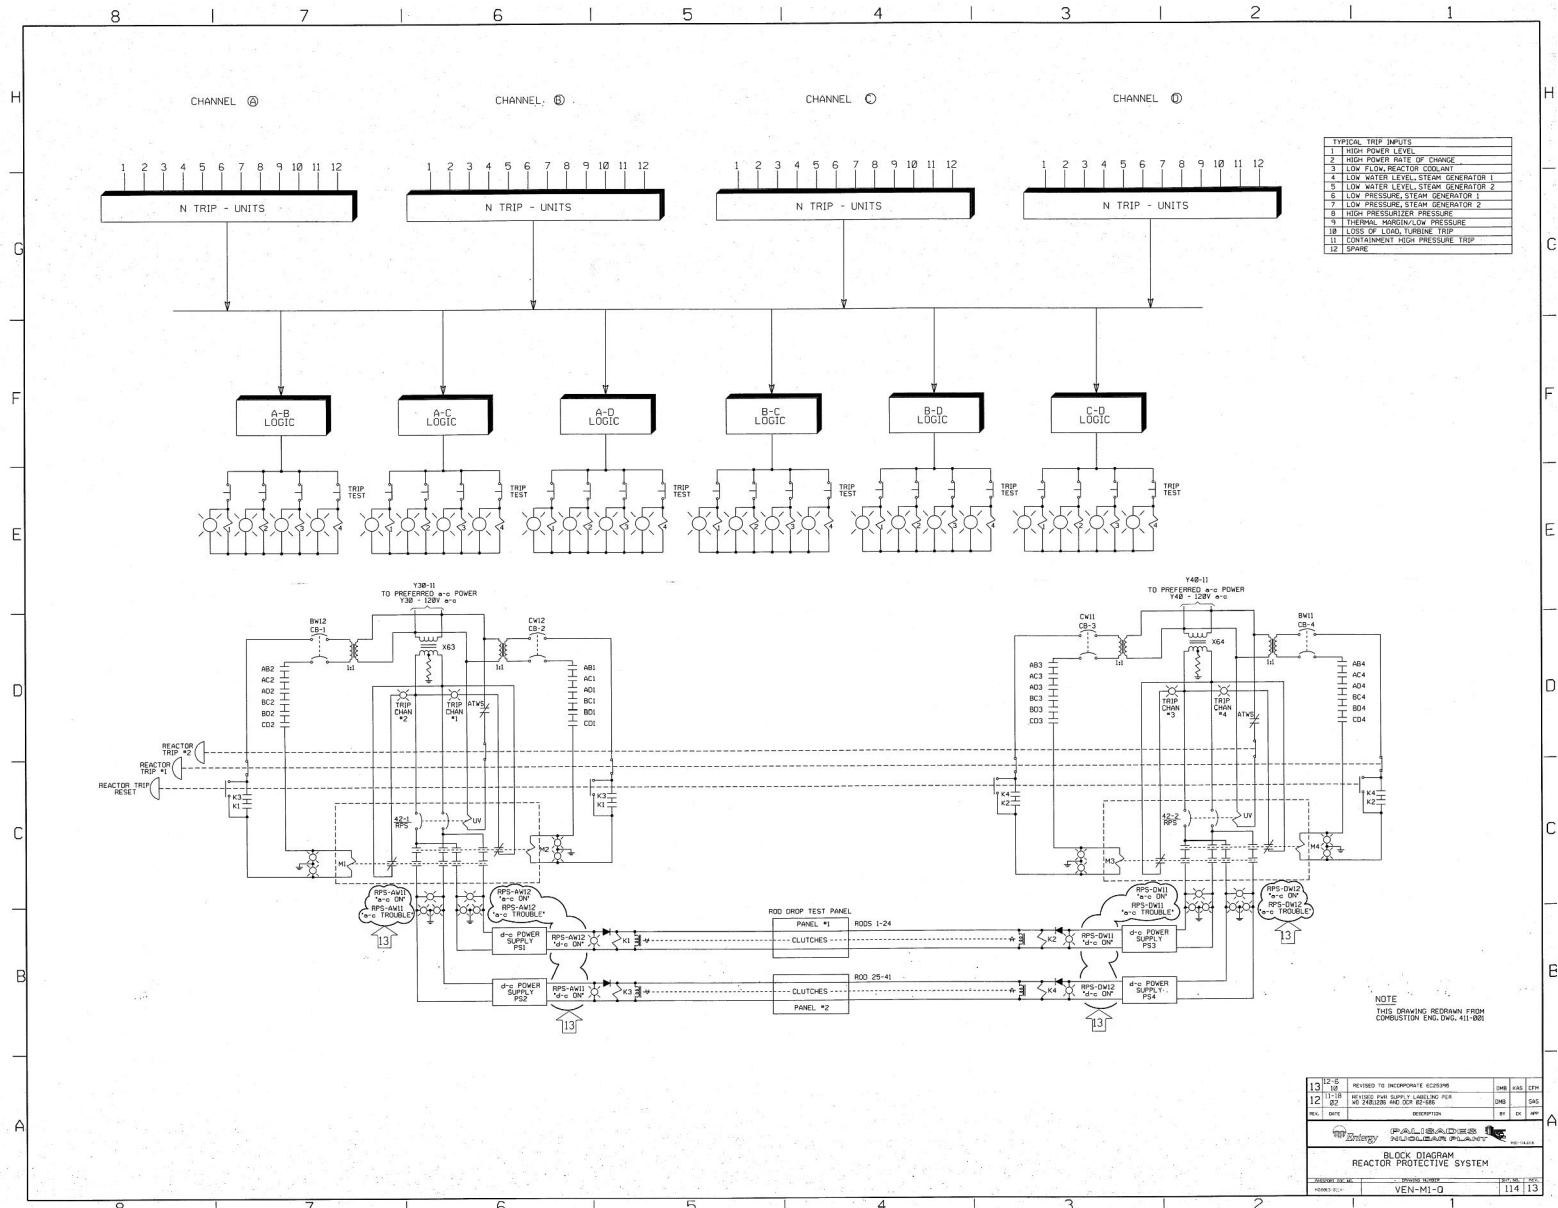


REACTOR PROTECTIVE SYSTEM FUNCTIONAL DIAGRAM

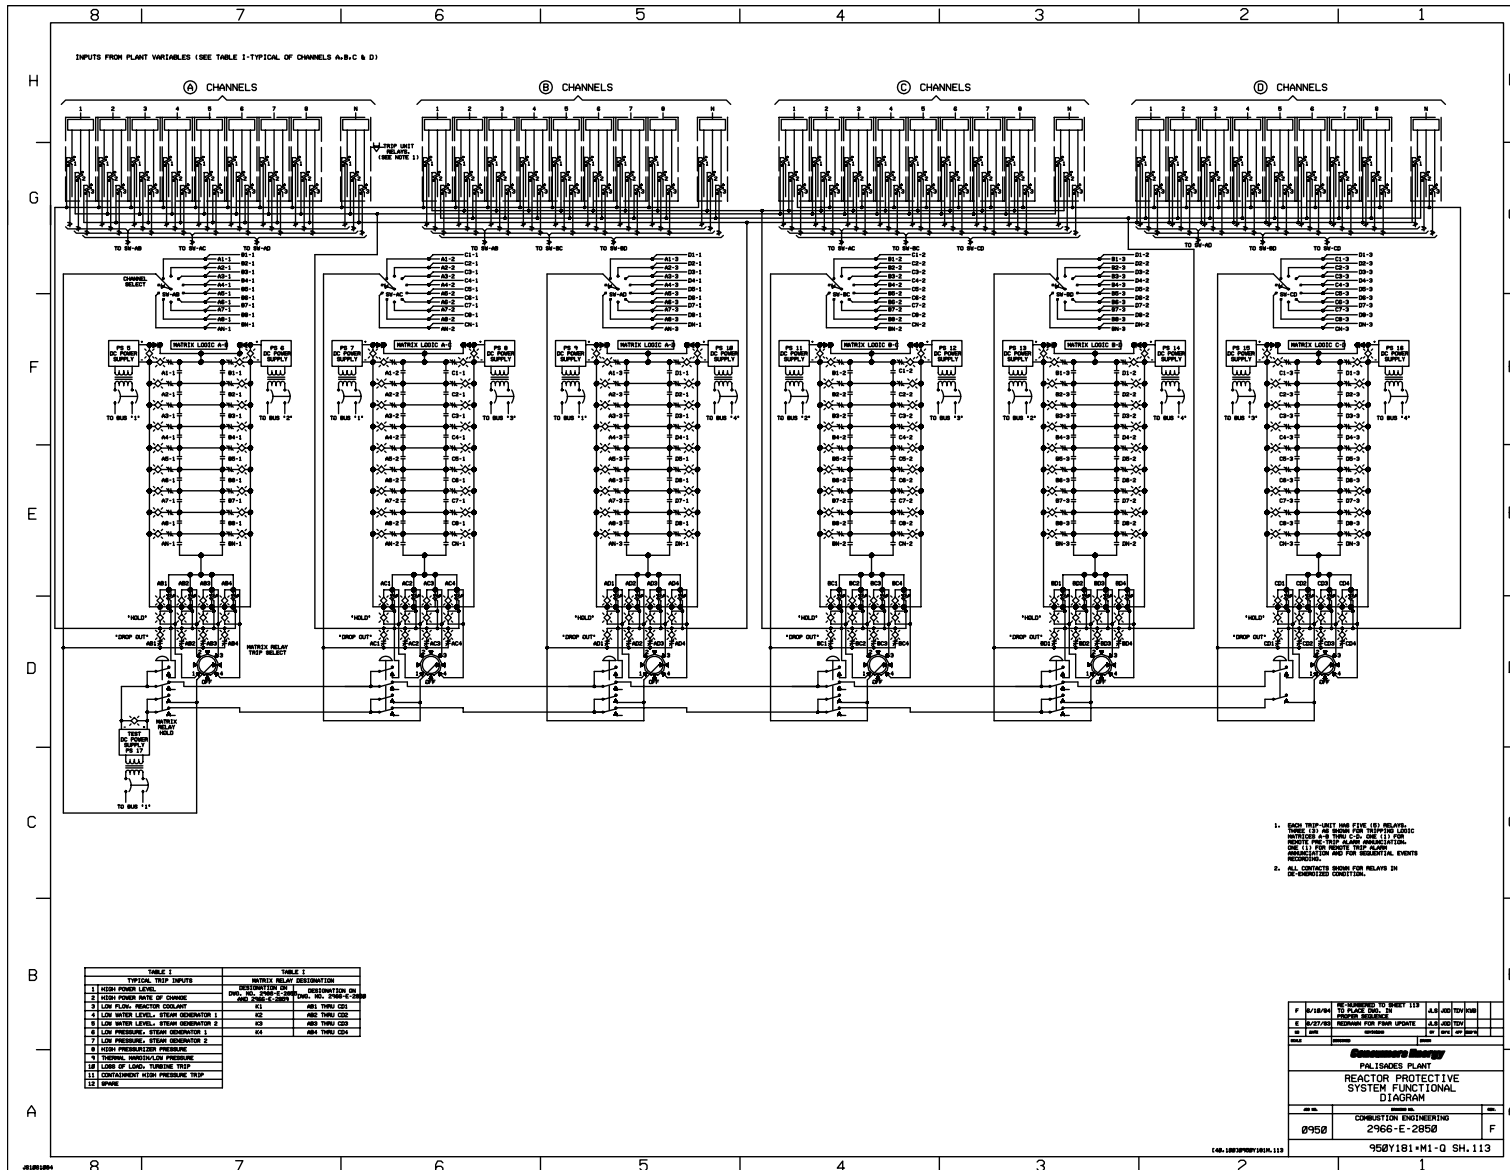


**SCHEMATIC DIAGRAM
PRESSURIZER PRESSURE ATWS**

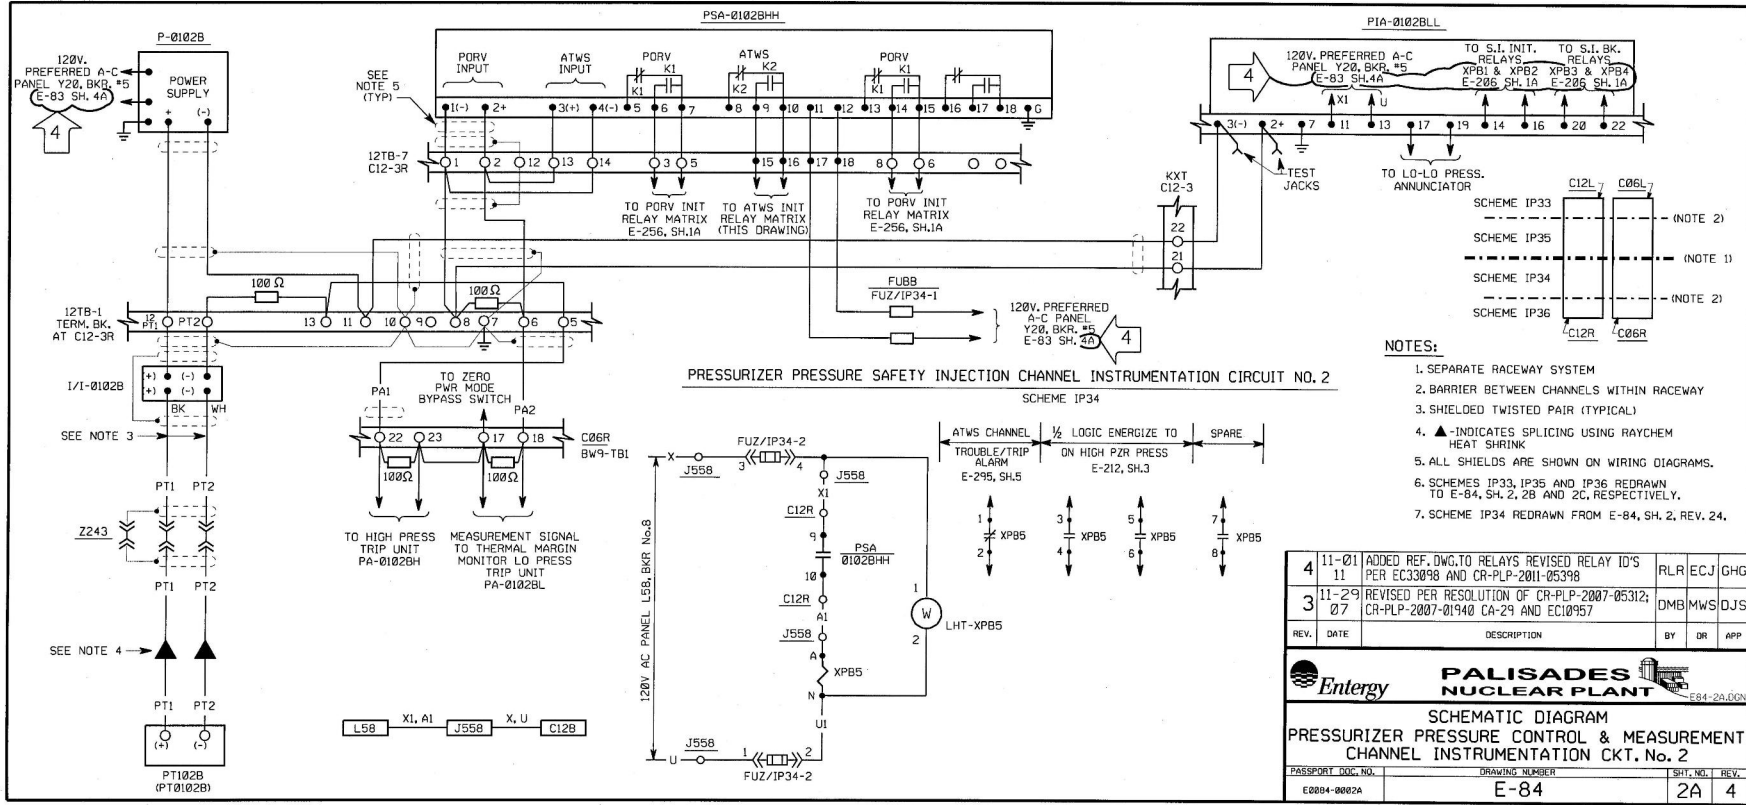


LOW FLOW PROTECTIVE SYSTEM FUNCTIONAL DIAGRAM

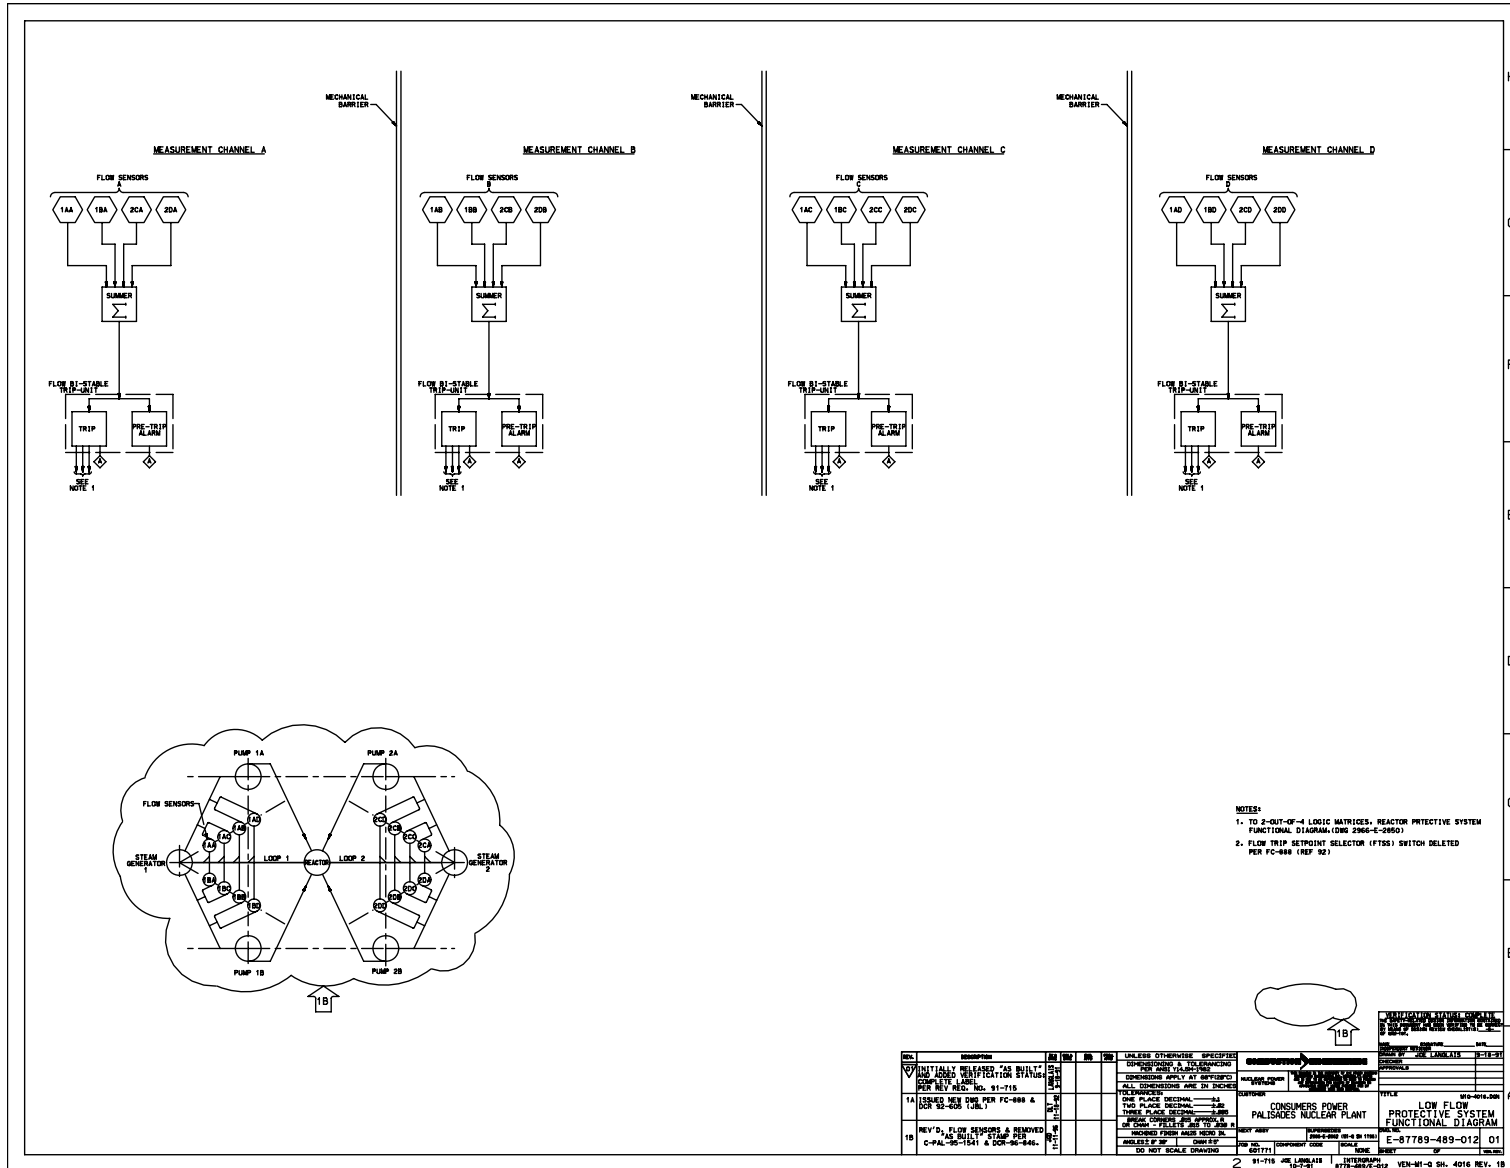


LOGIC FOR THERMAL MARGIN MONITOR

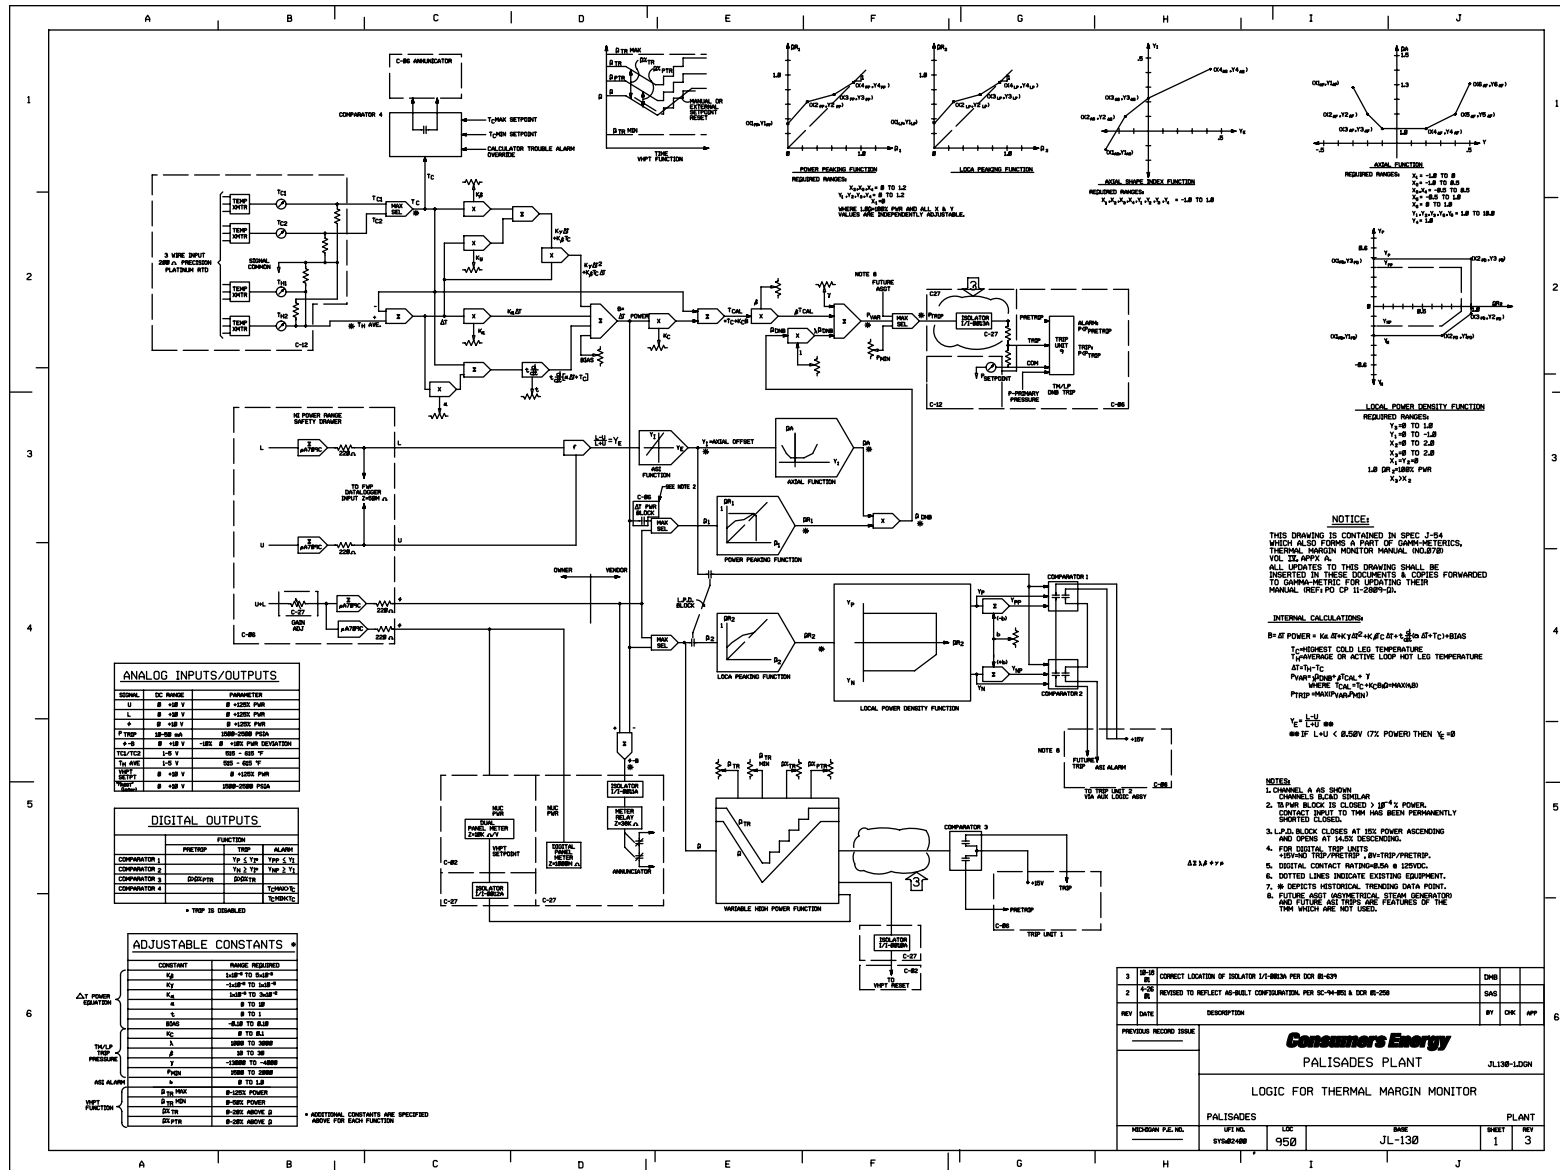

NEUTRON FLUX MONITORING SYSTEM START-UP AND LOGARITHMIC RANGE CHANNELS

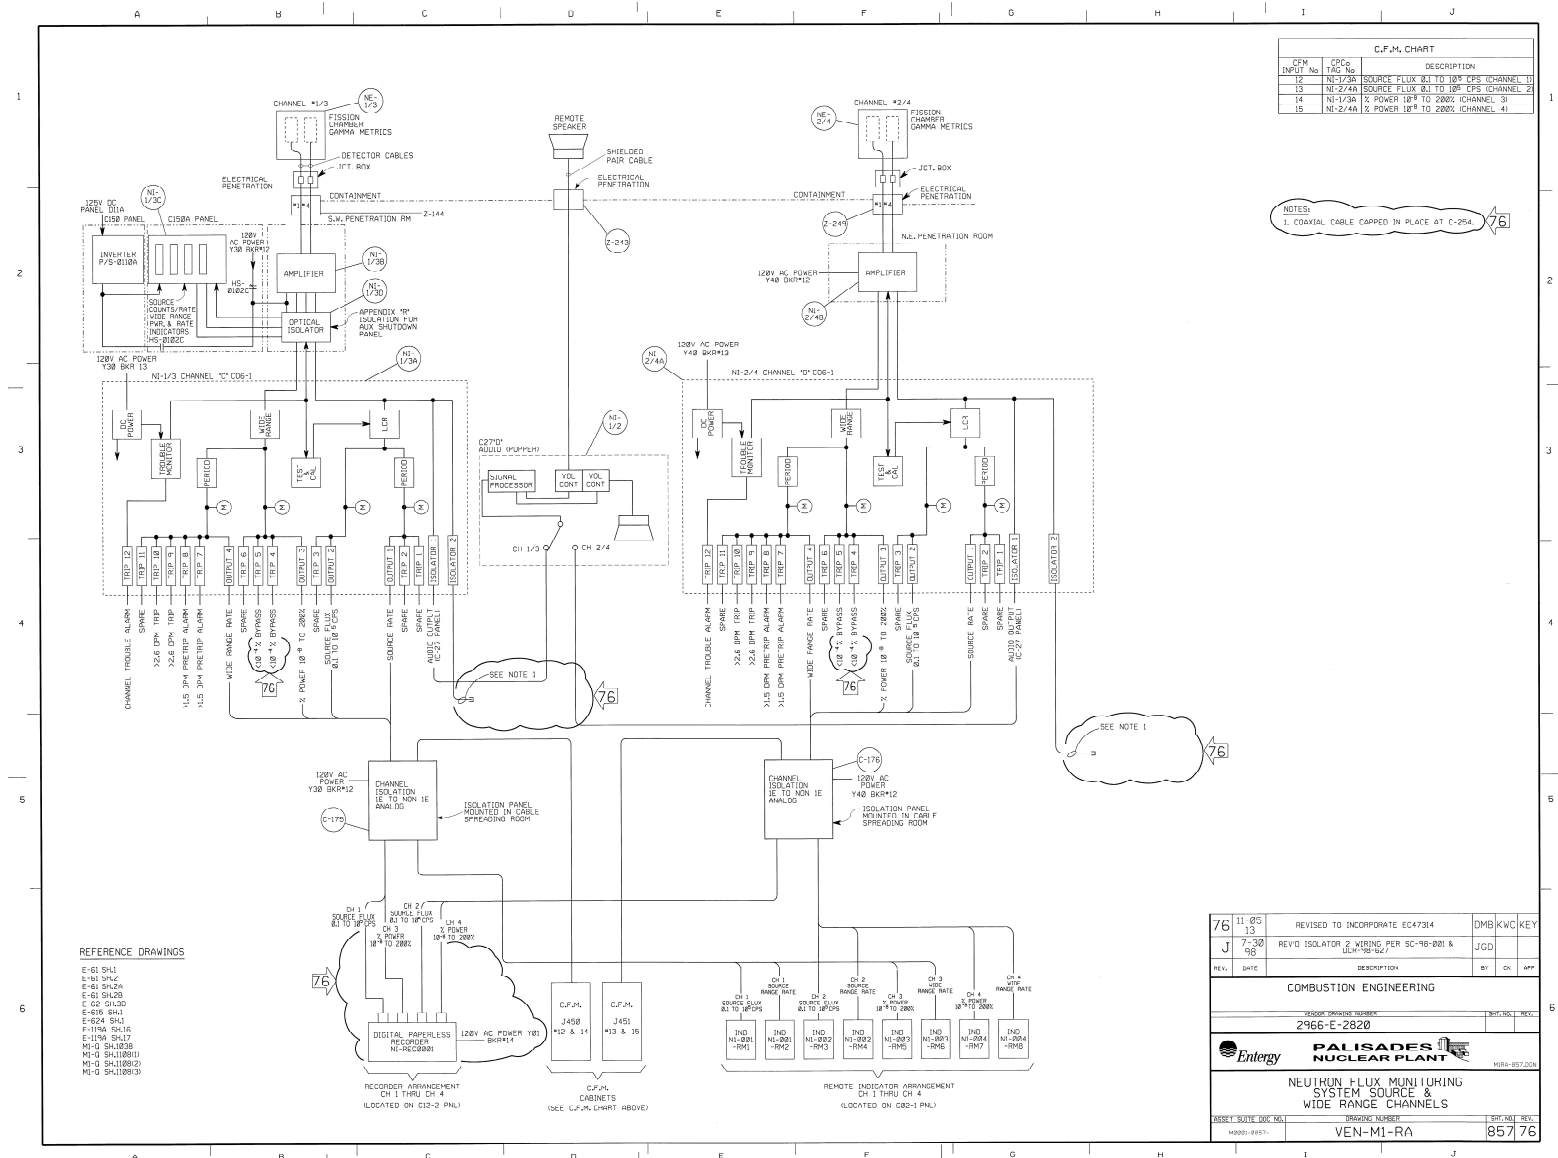


POWER RATE-OF-CHANGE TRIP AND PRETRIP INTERFACE WITH RPS

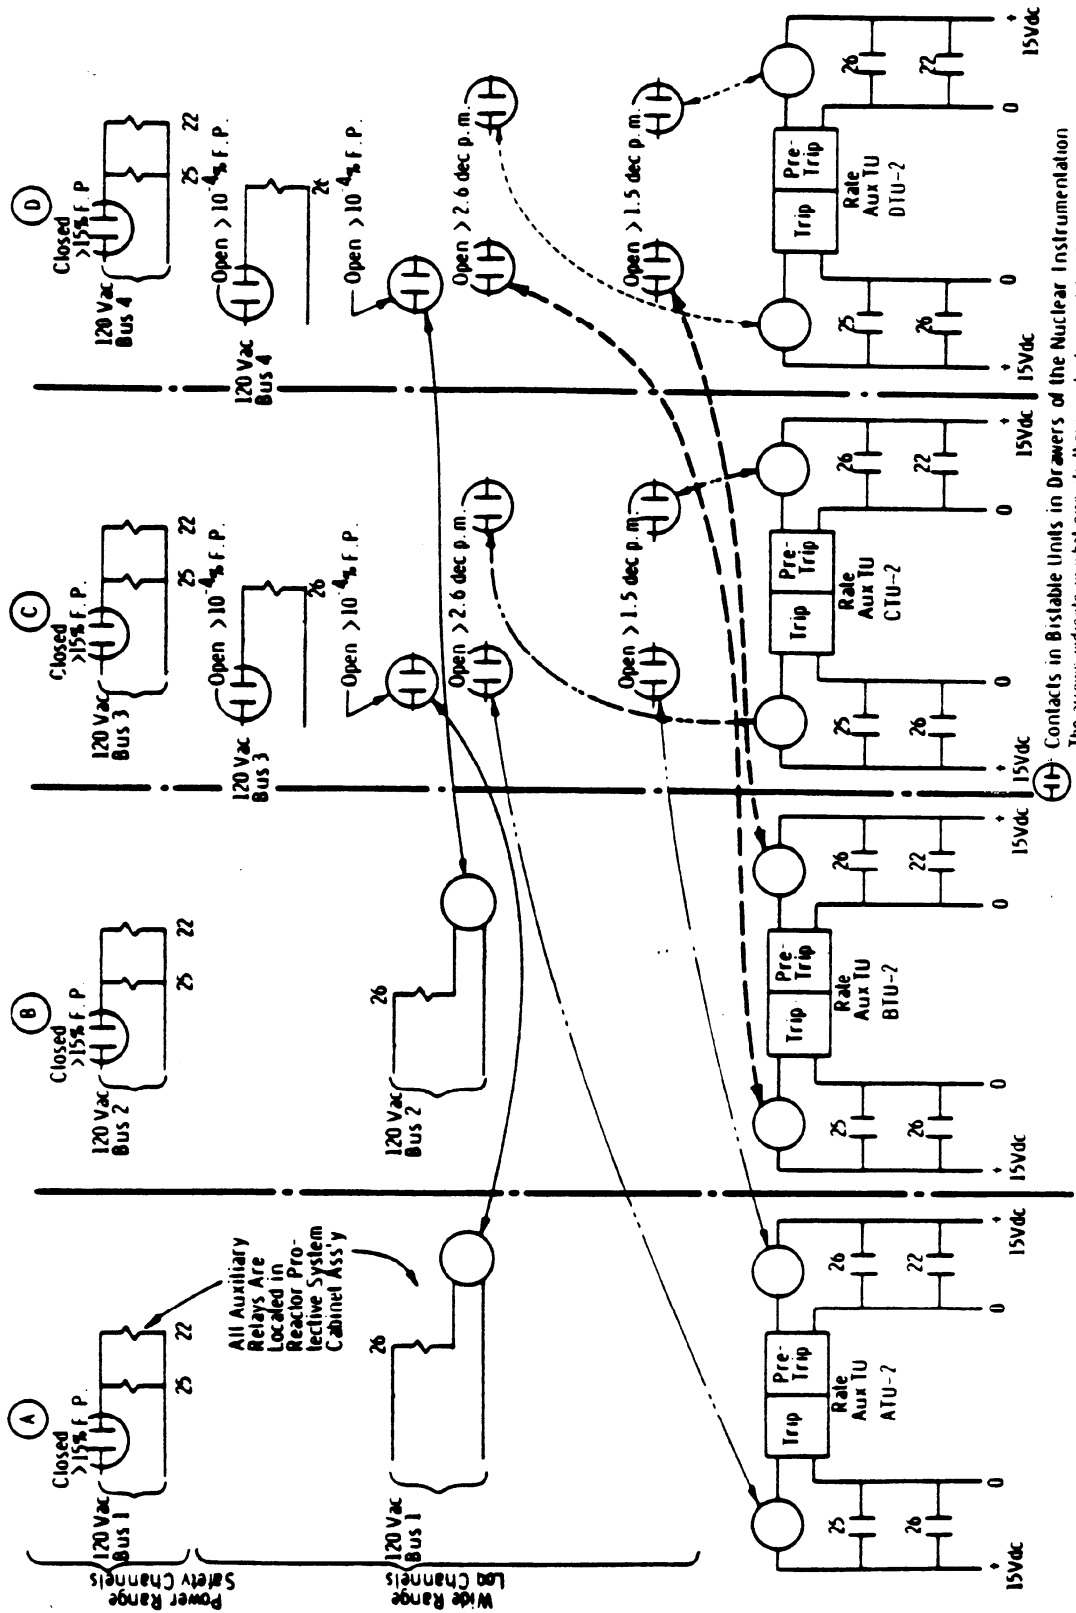

Contacts in Bistable Units in Drawers of the Nuclear Instrumentation
The arrows indicate in what circuits these contacts are utilized.

ZERO POWER MODE BYPASS

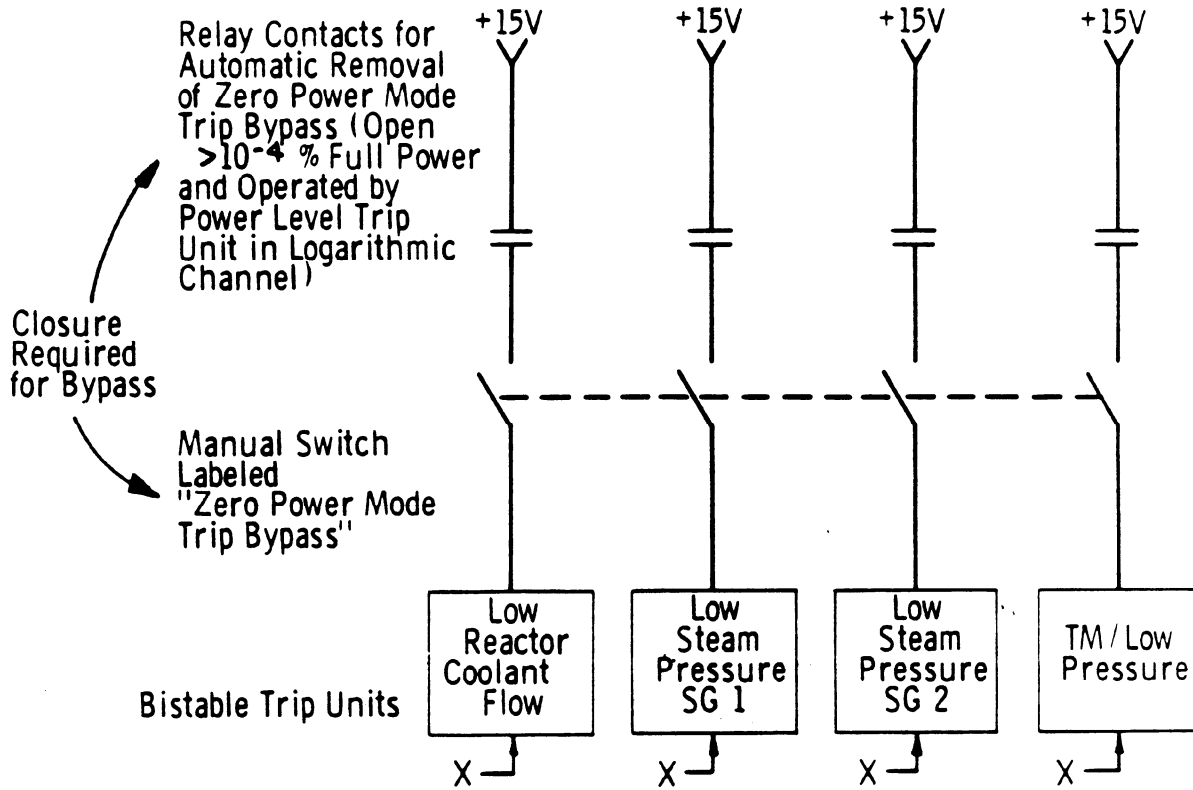


X = Analog Input Signal

With +15V Applied to Bistable Trip Unit: No Trip Regardless To Level of Input Analog Signal

Without +15V Applied to Bistable Trip Unit: Trip According to Level of Input Analog Signal

Same Arrangement for Other 3 Channels


REACTOR PROTECTIVE SYSTEM INTERFACES

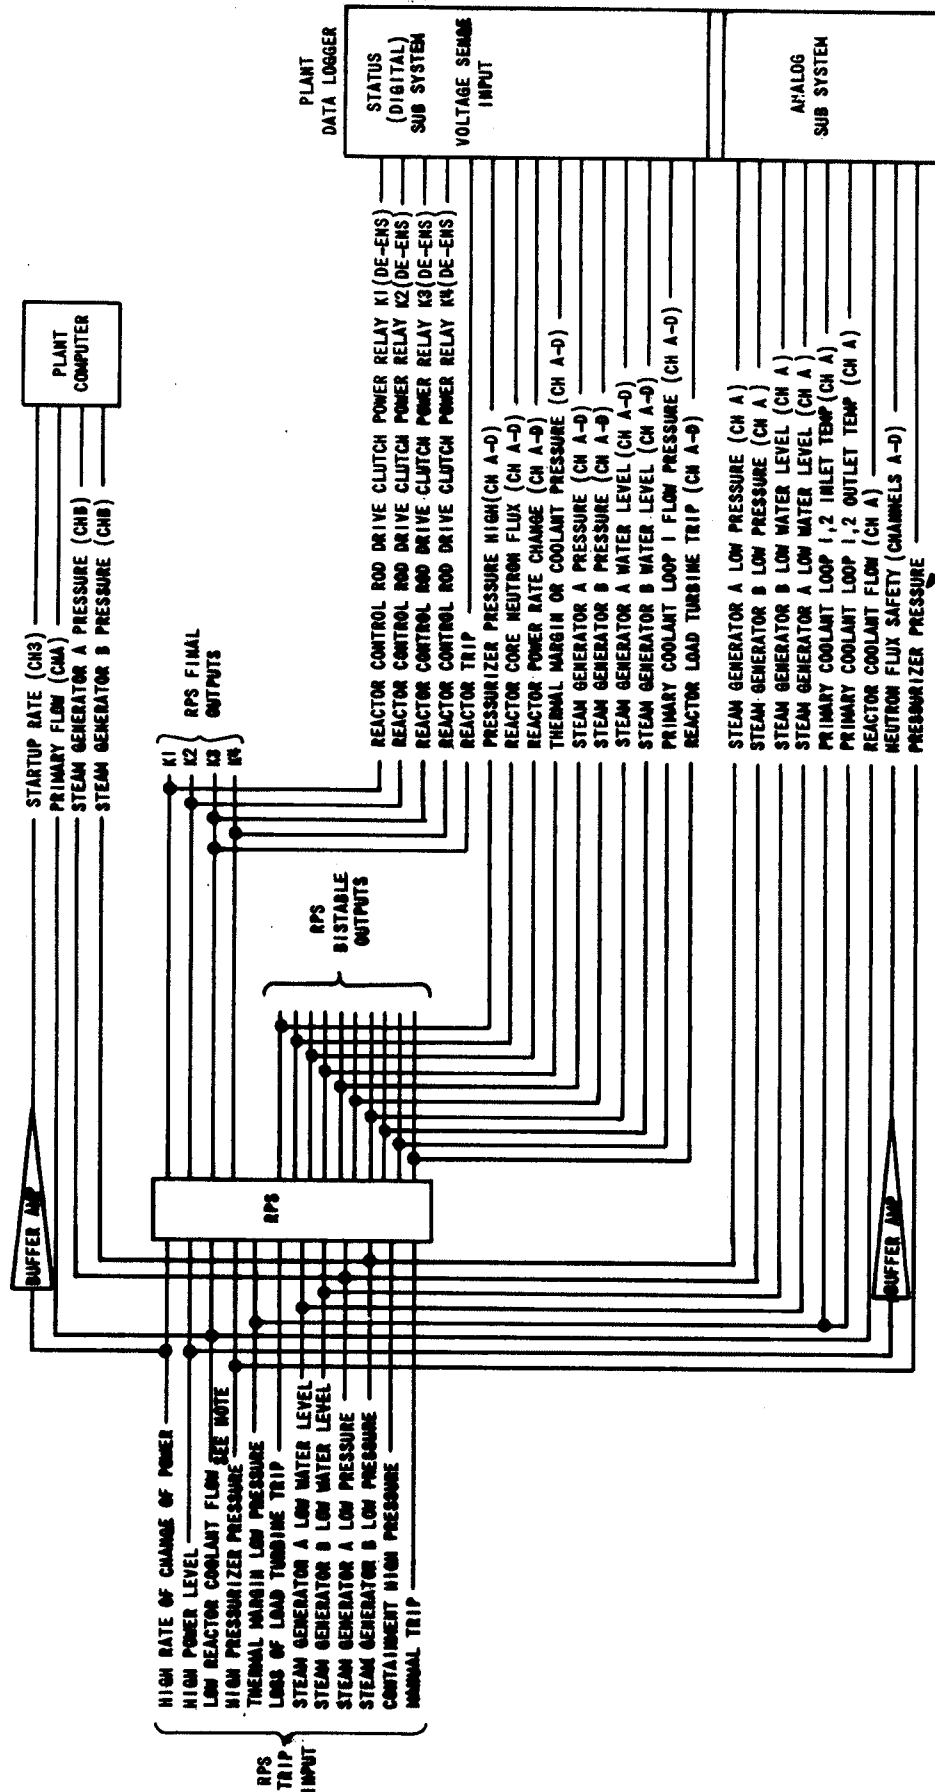

NOTE:
THE SAFETY RELATED CHANNEL OF PRESSURIZER PRESSURE INPUTS TO RPS. WIDE RANGE PRESSURIZER PRESSURE (NON-SAFETY) INPUTS TO DATA LOGGER.

SEE NOTE


LOGIC DIAGRAM
SAFETY INJECTION INITIATION

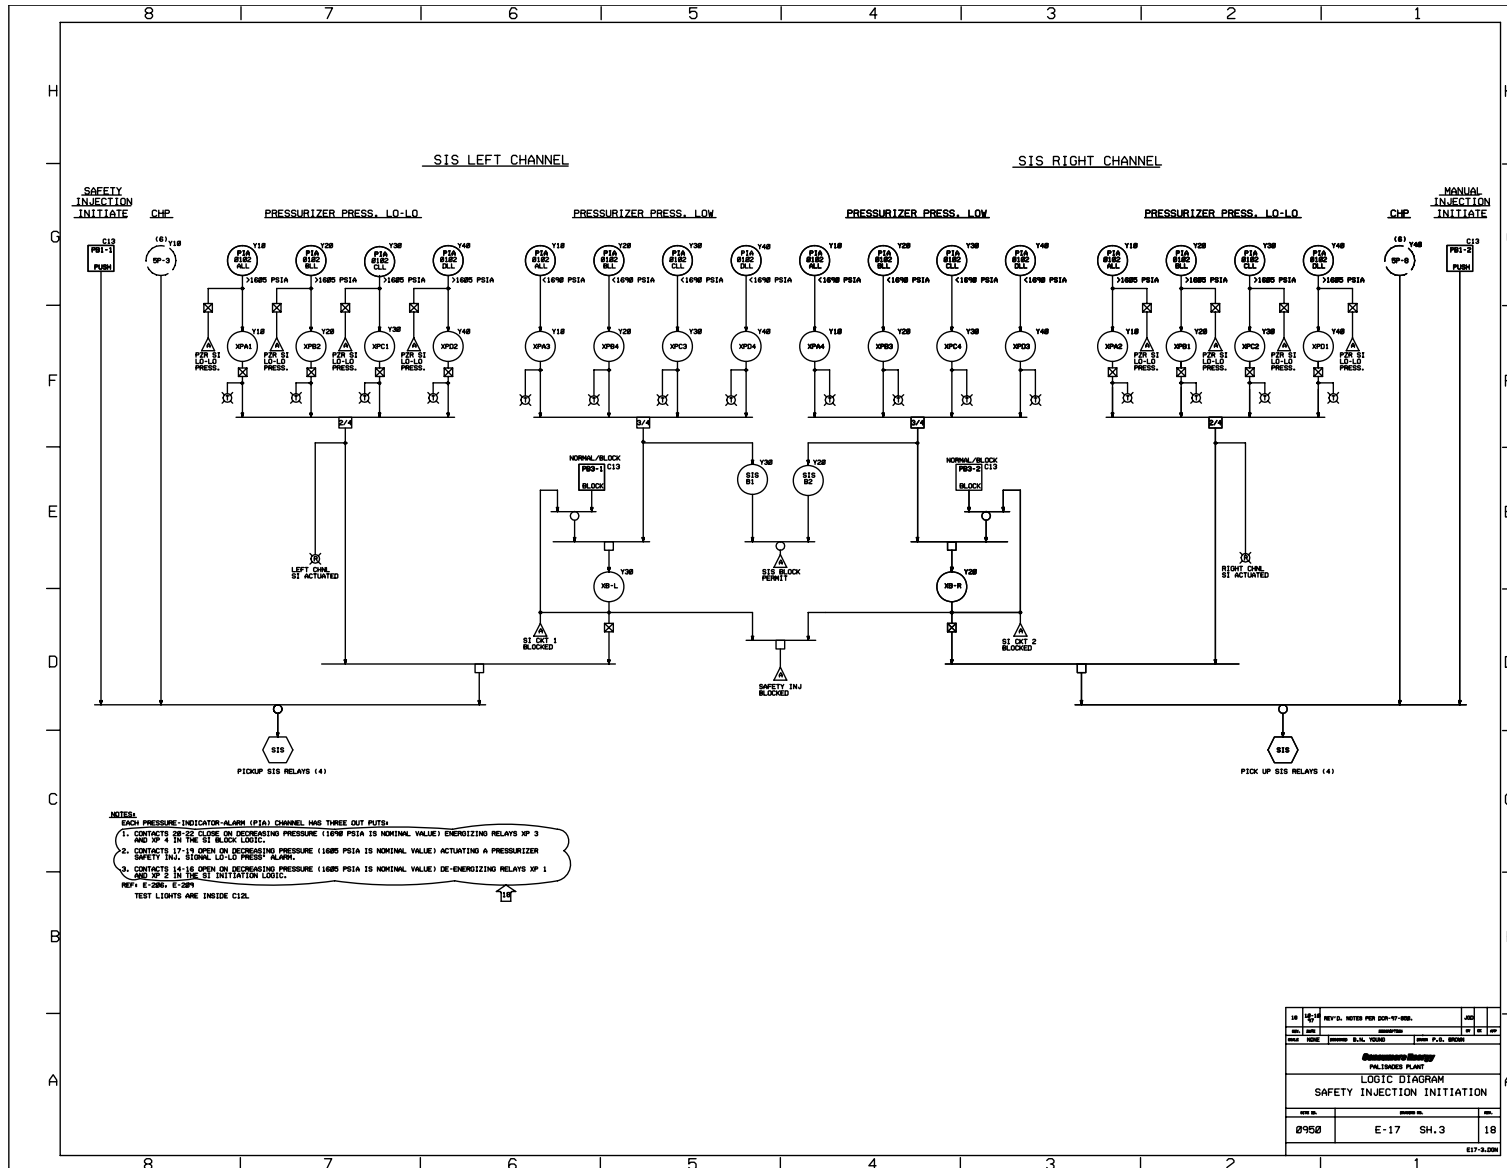


18	REV'D. NOTES PER 004-17-000.	AND	
REV	DATE	BY	CHK
0950	E-17 SH.3	18	817-3-000

LOGIC DIAGRAM
SAFETY INJECTION INITIATION


LOGIC DIAGRAM
MAIN GENERATOR PROTECTION

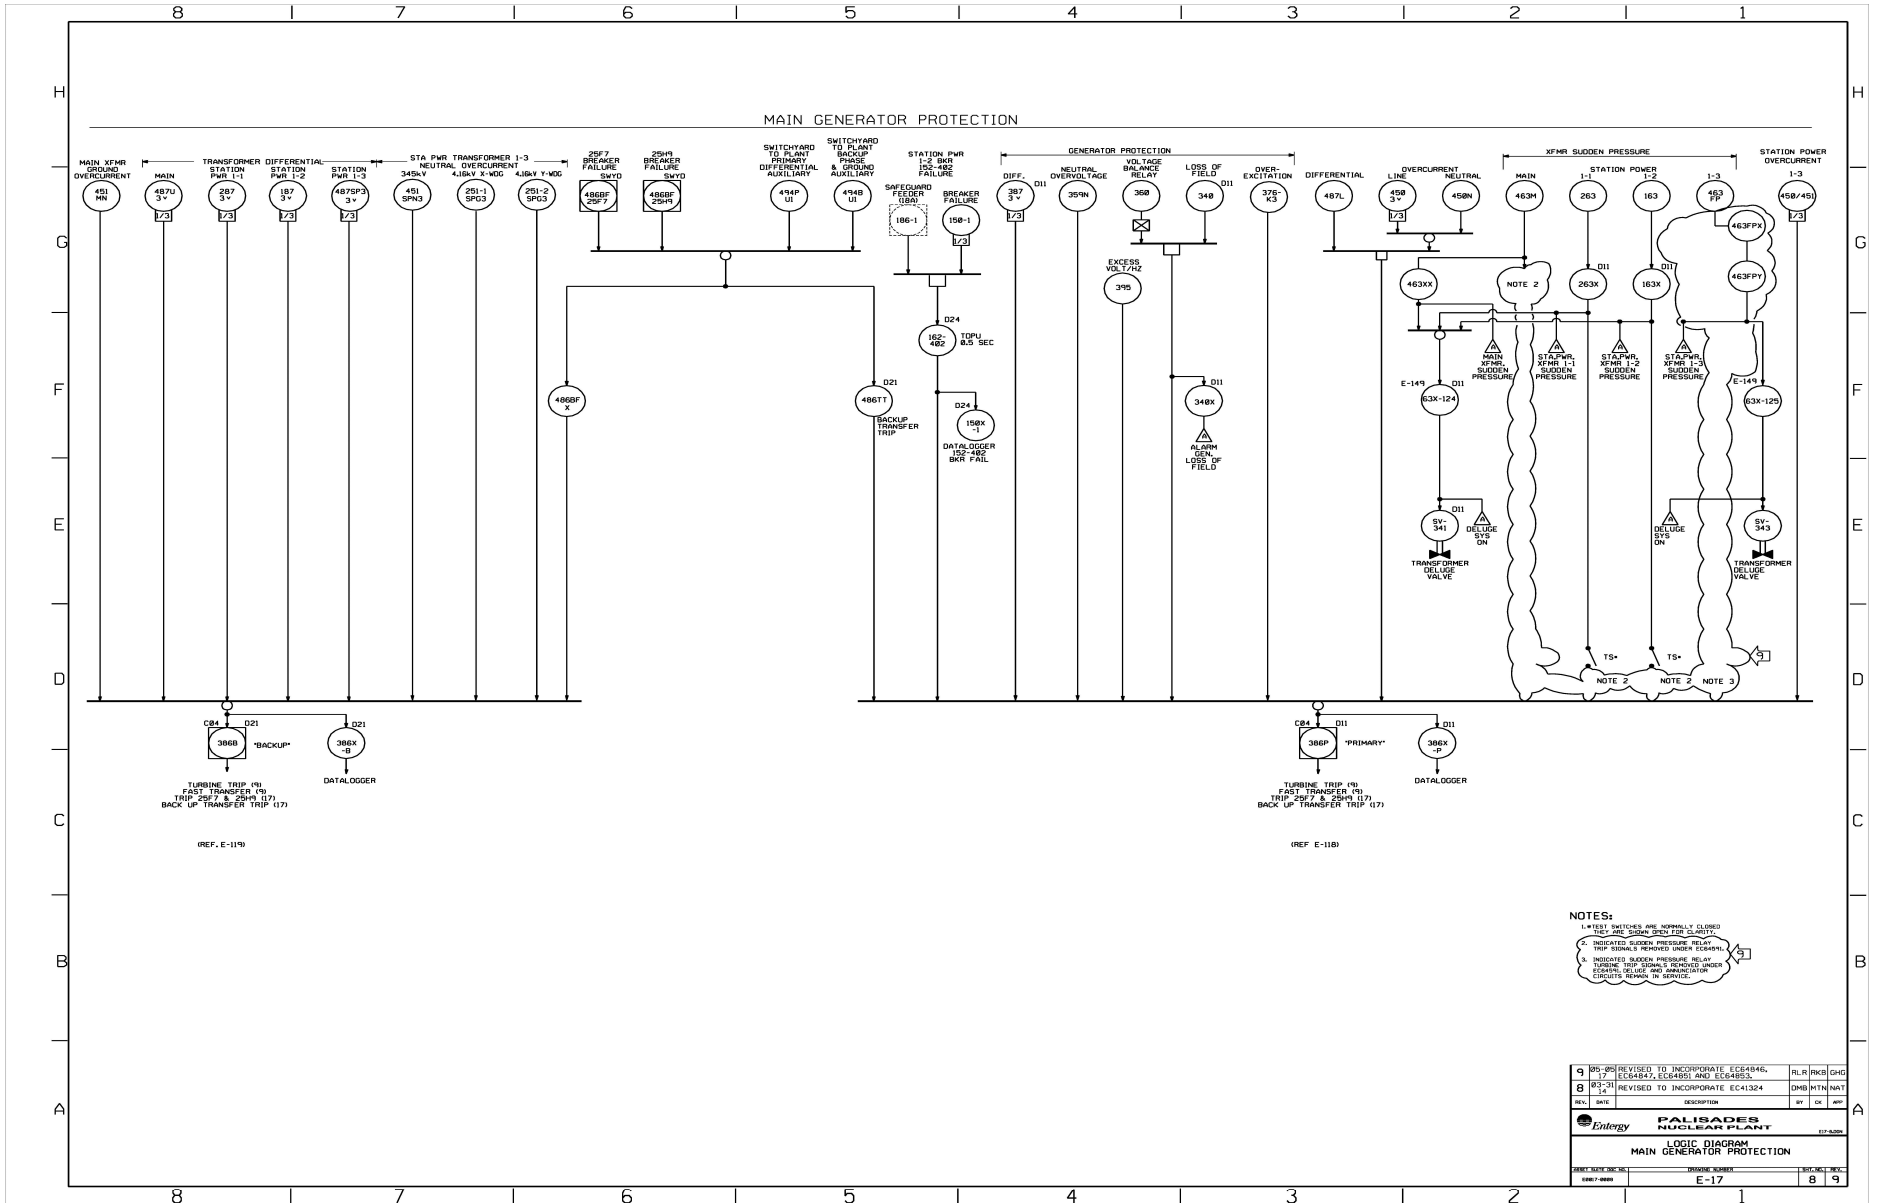


LOGIC DIAGRAM
TURBINE-GENERATOR TRIPS AND FAST TRANSFER

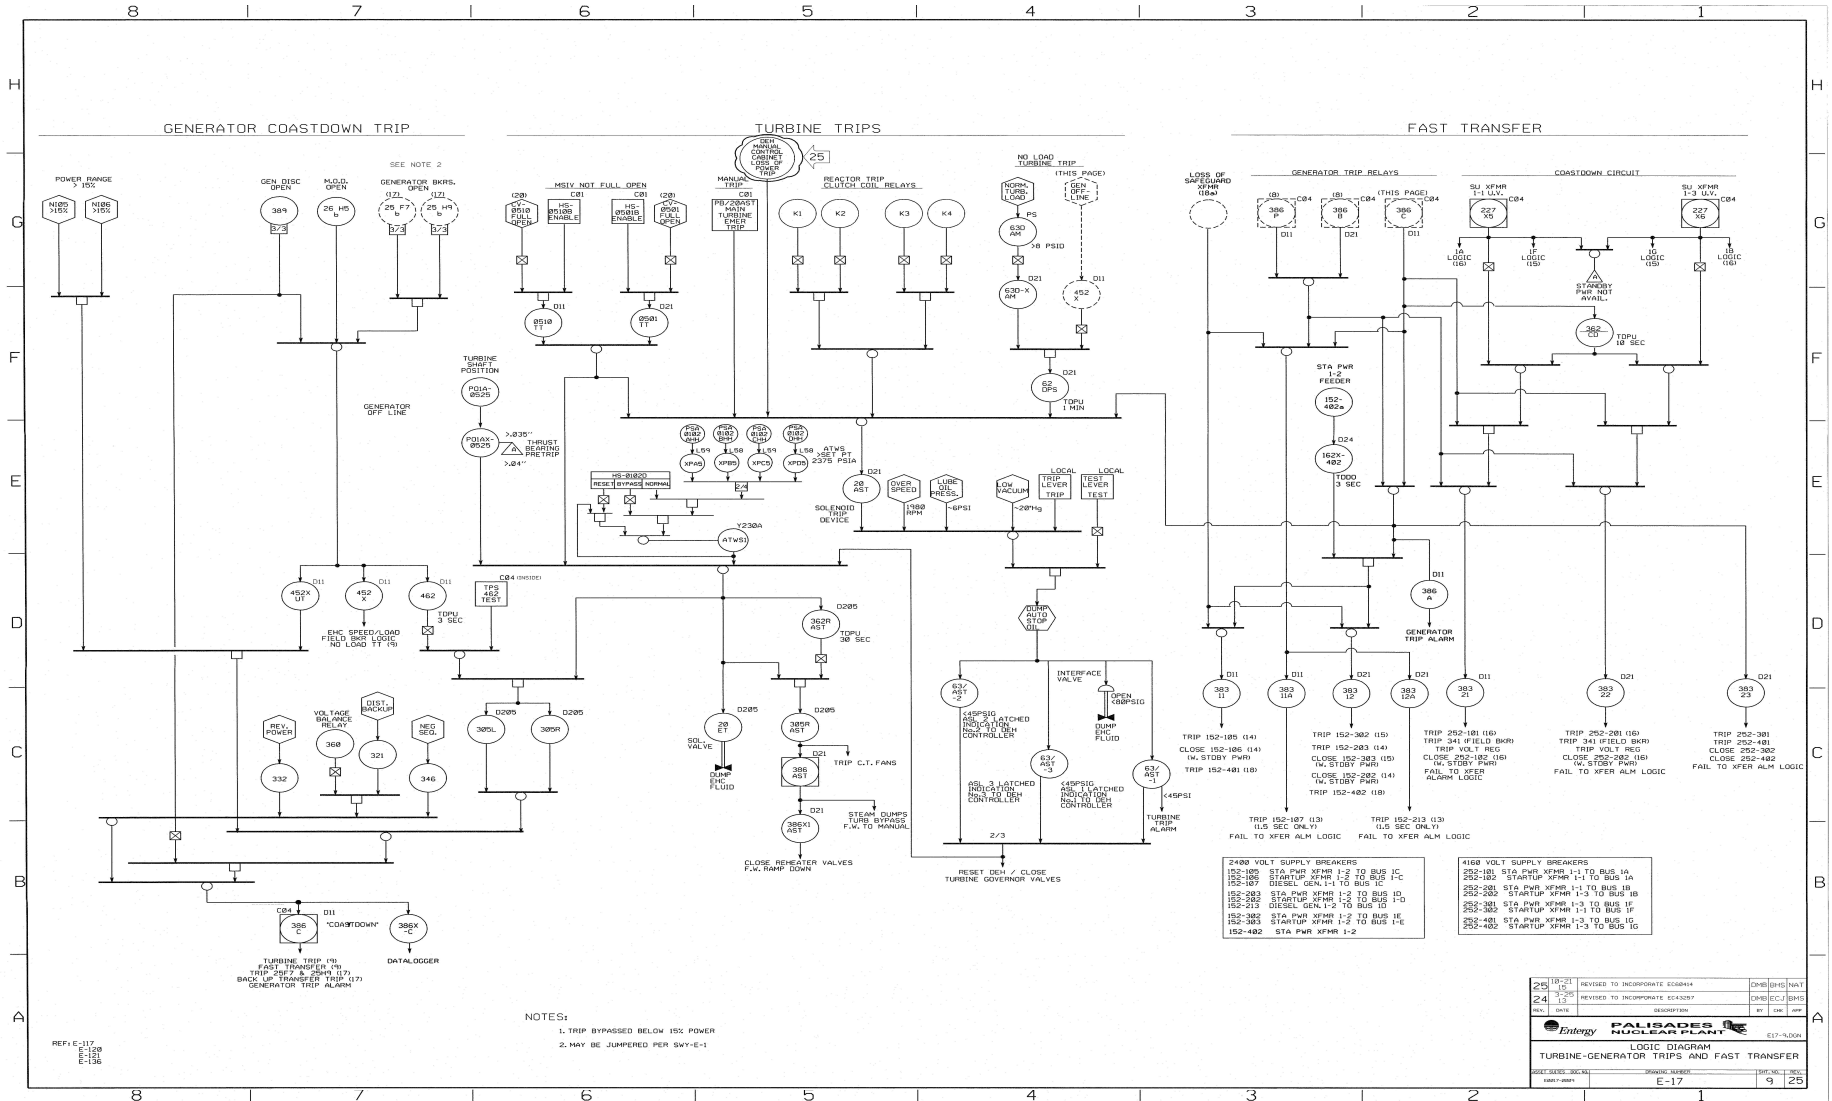


LOGIC DIAGRAM
DIESEL START

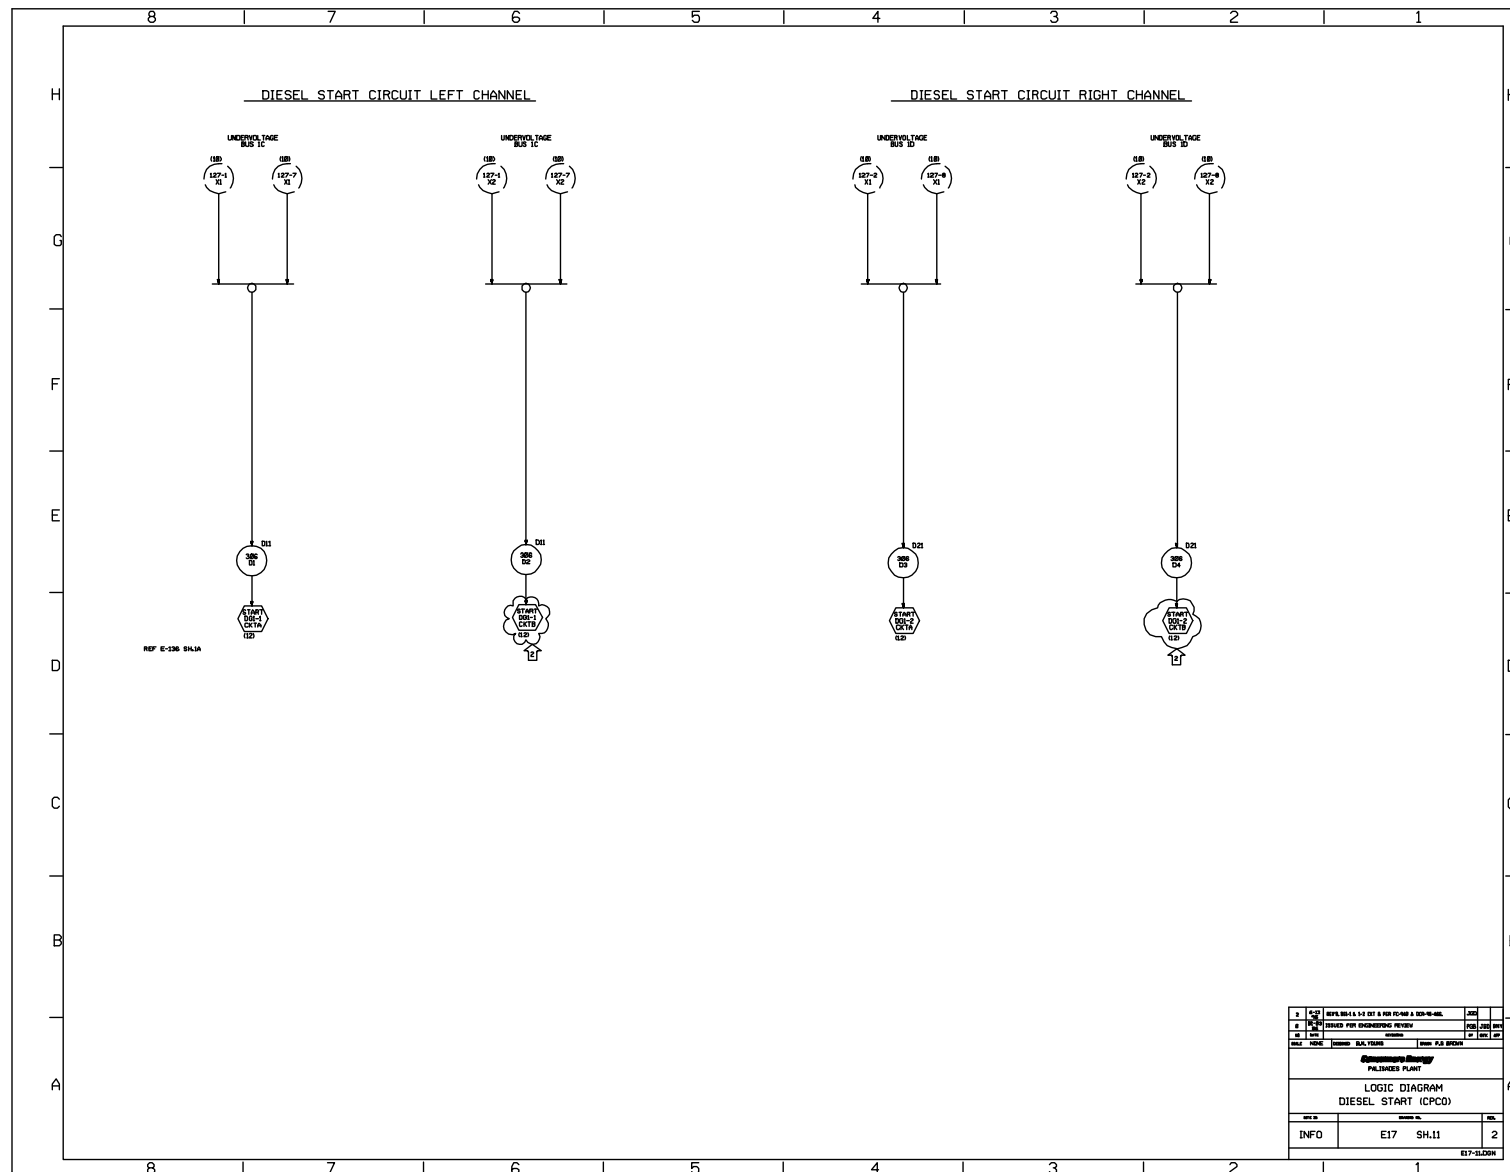


LOGIC DIAGRAM
DIESEL ENGINE CONTROL, TRIPS AND ALARMS

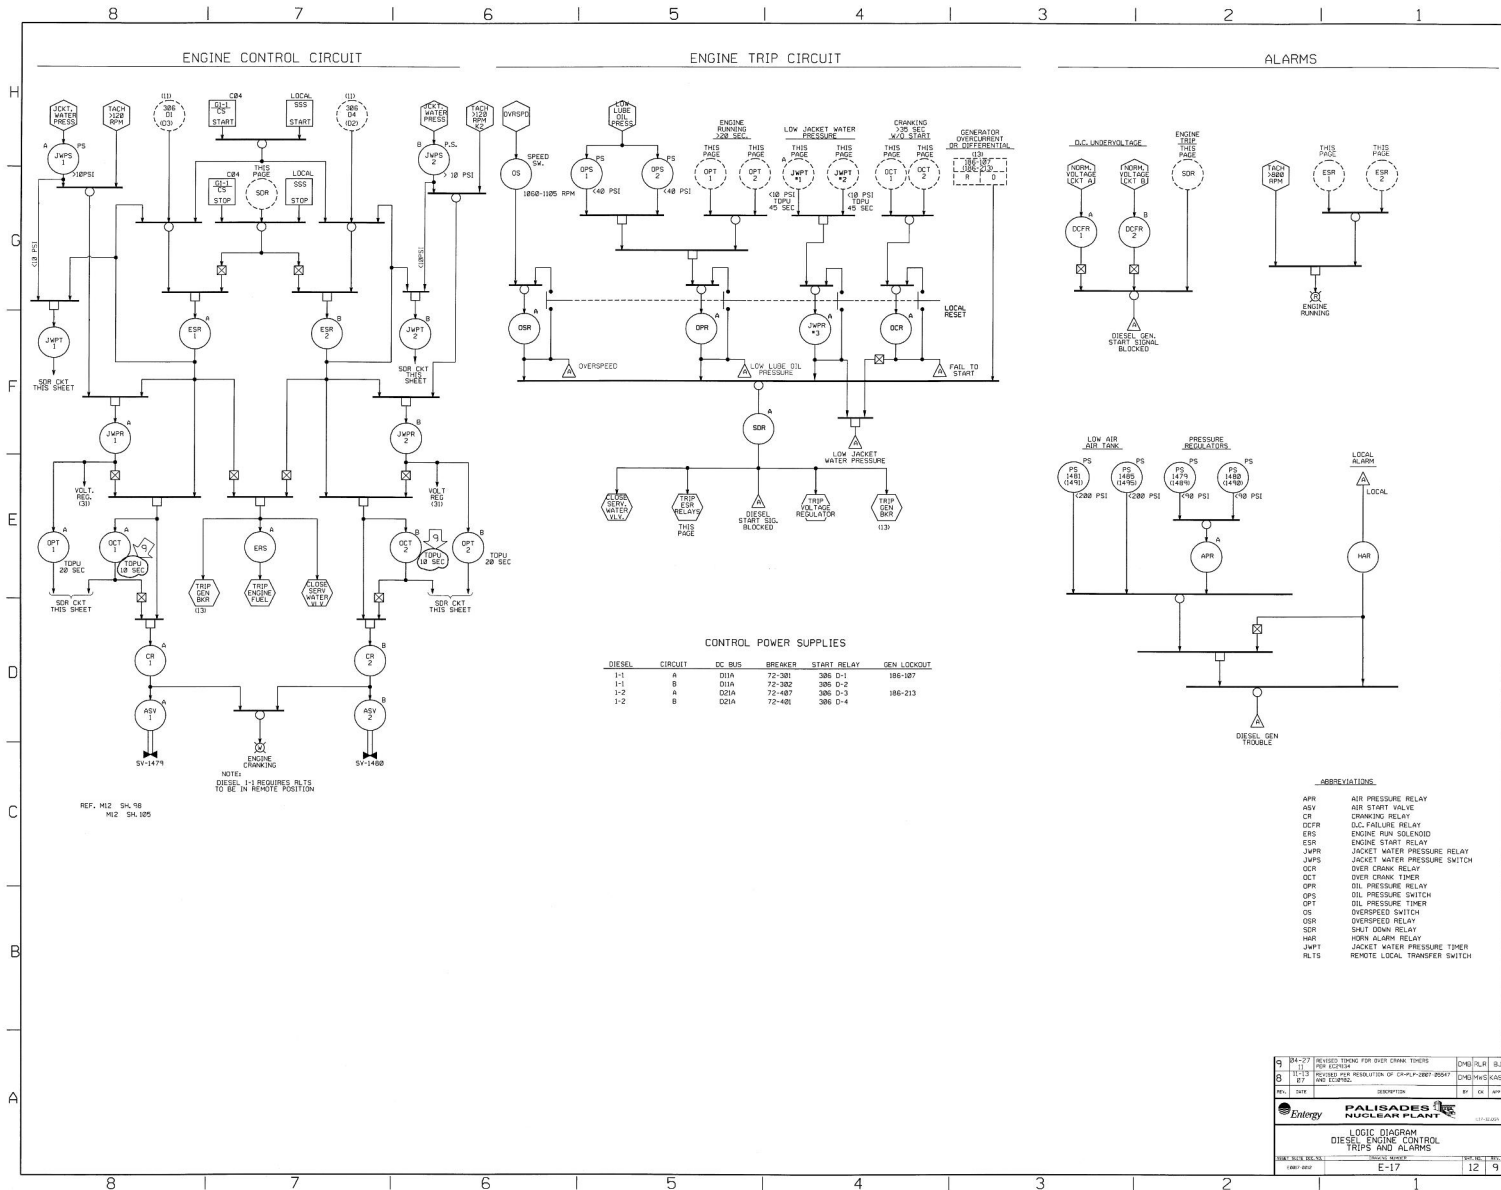


LOGIC DIAGRAM
DIESEL GENERATOR BREAKERS

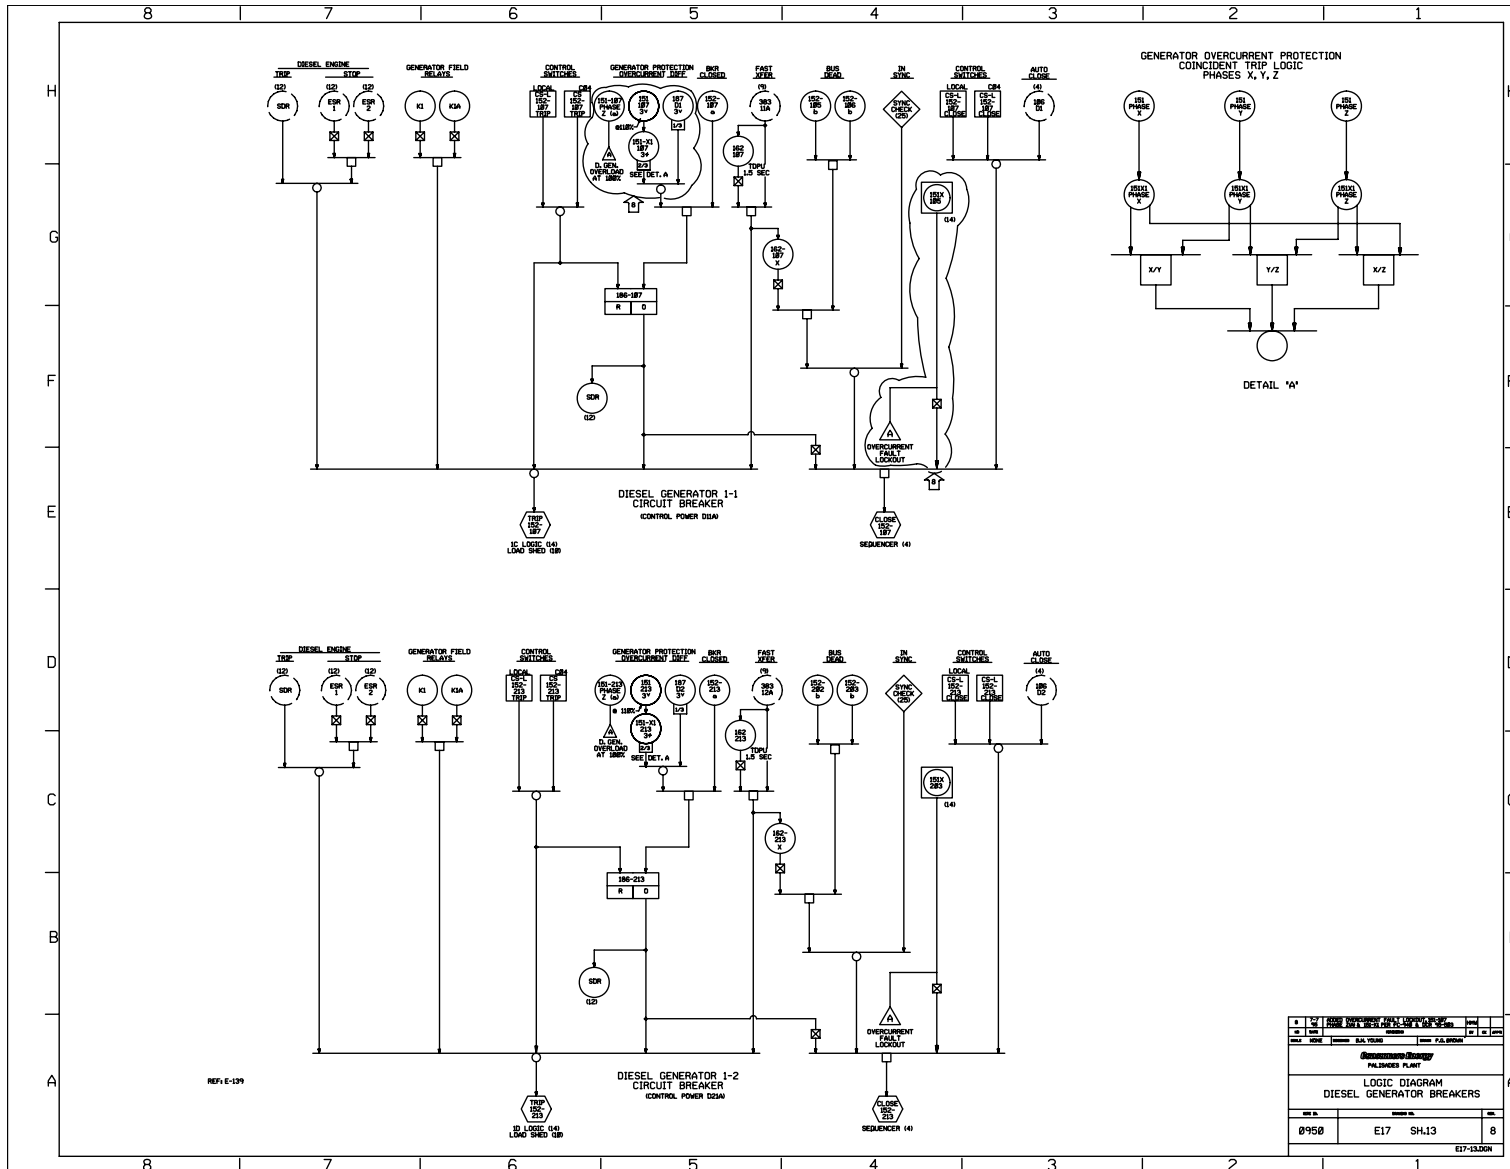


LOGIC DIAGRAM
BUS 1C AND 1D INCOMING BREAKERS

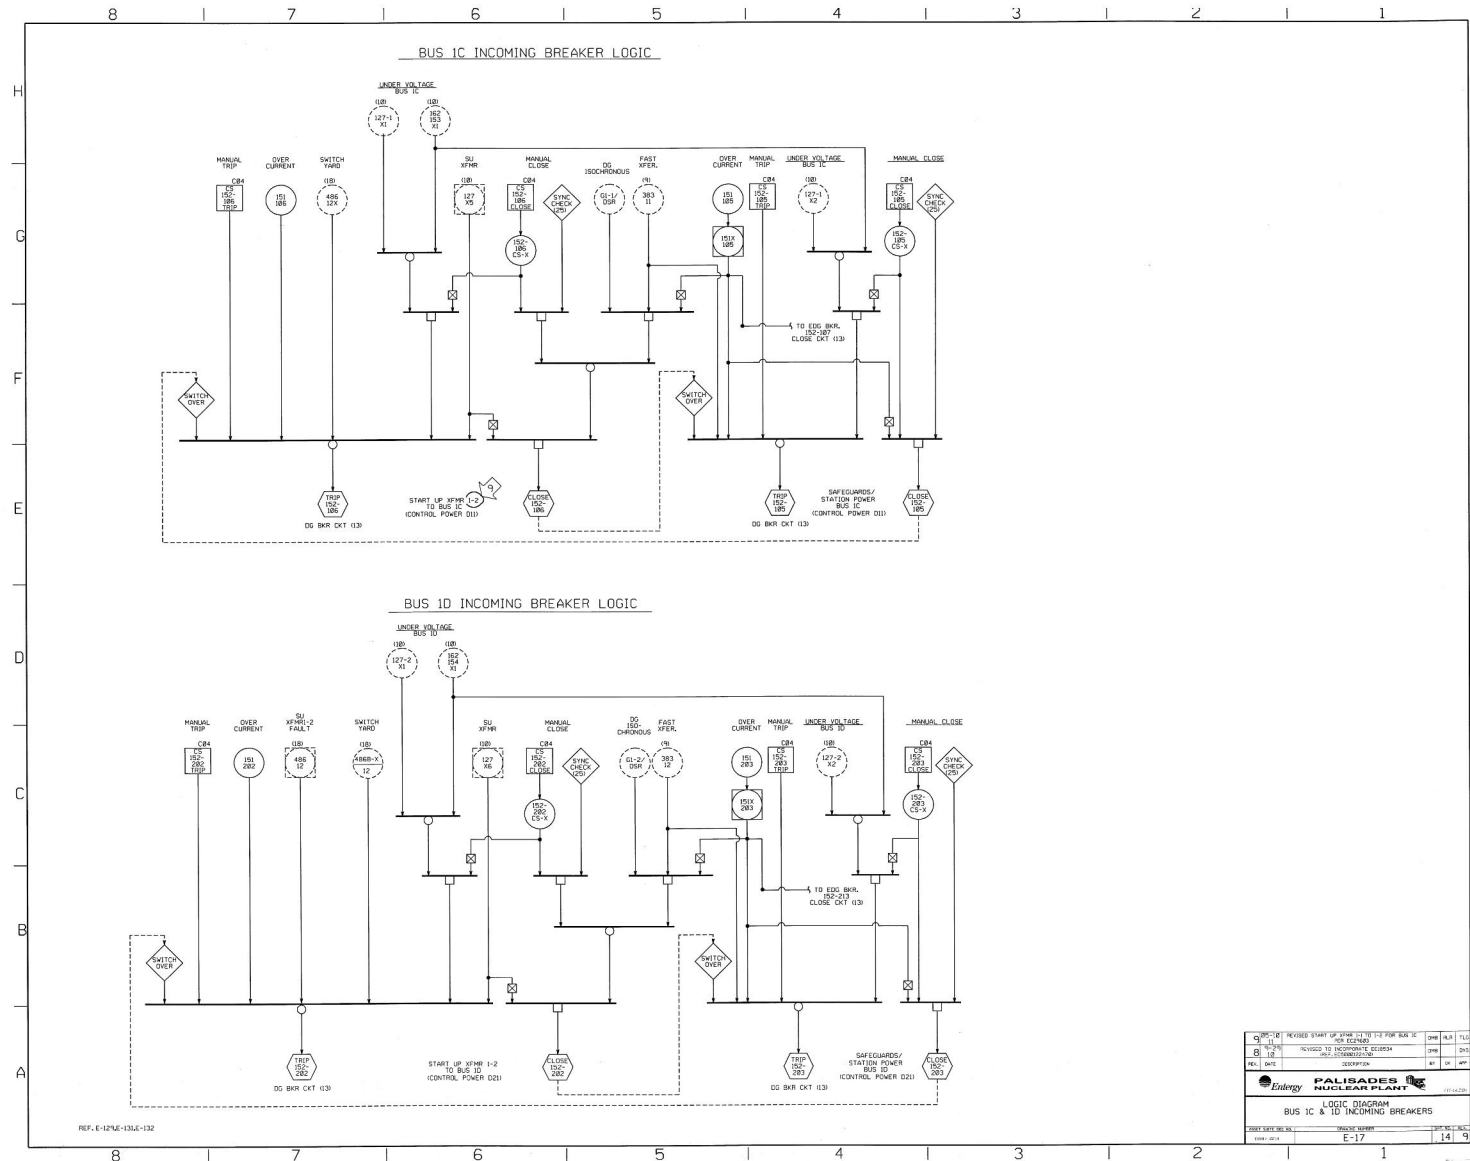


**LOGIC DIAGRAM
BUS 1A & 1 B INCOMING BREAKERS**

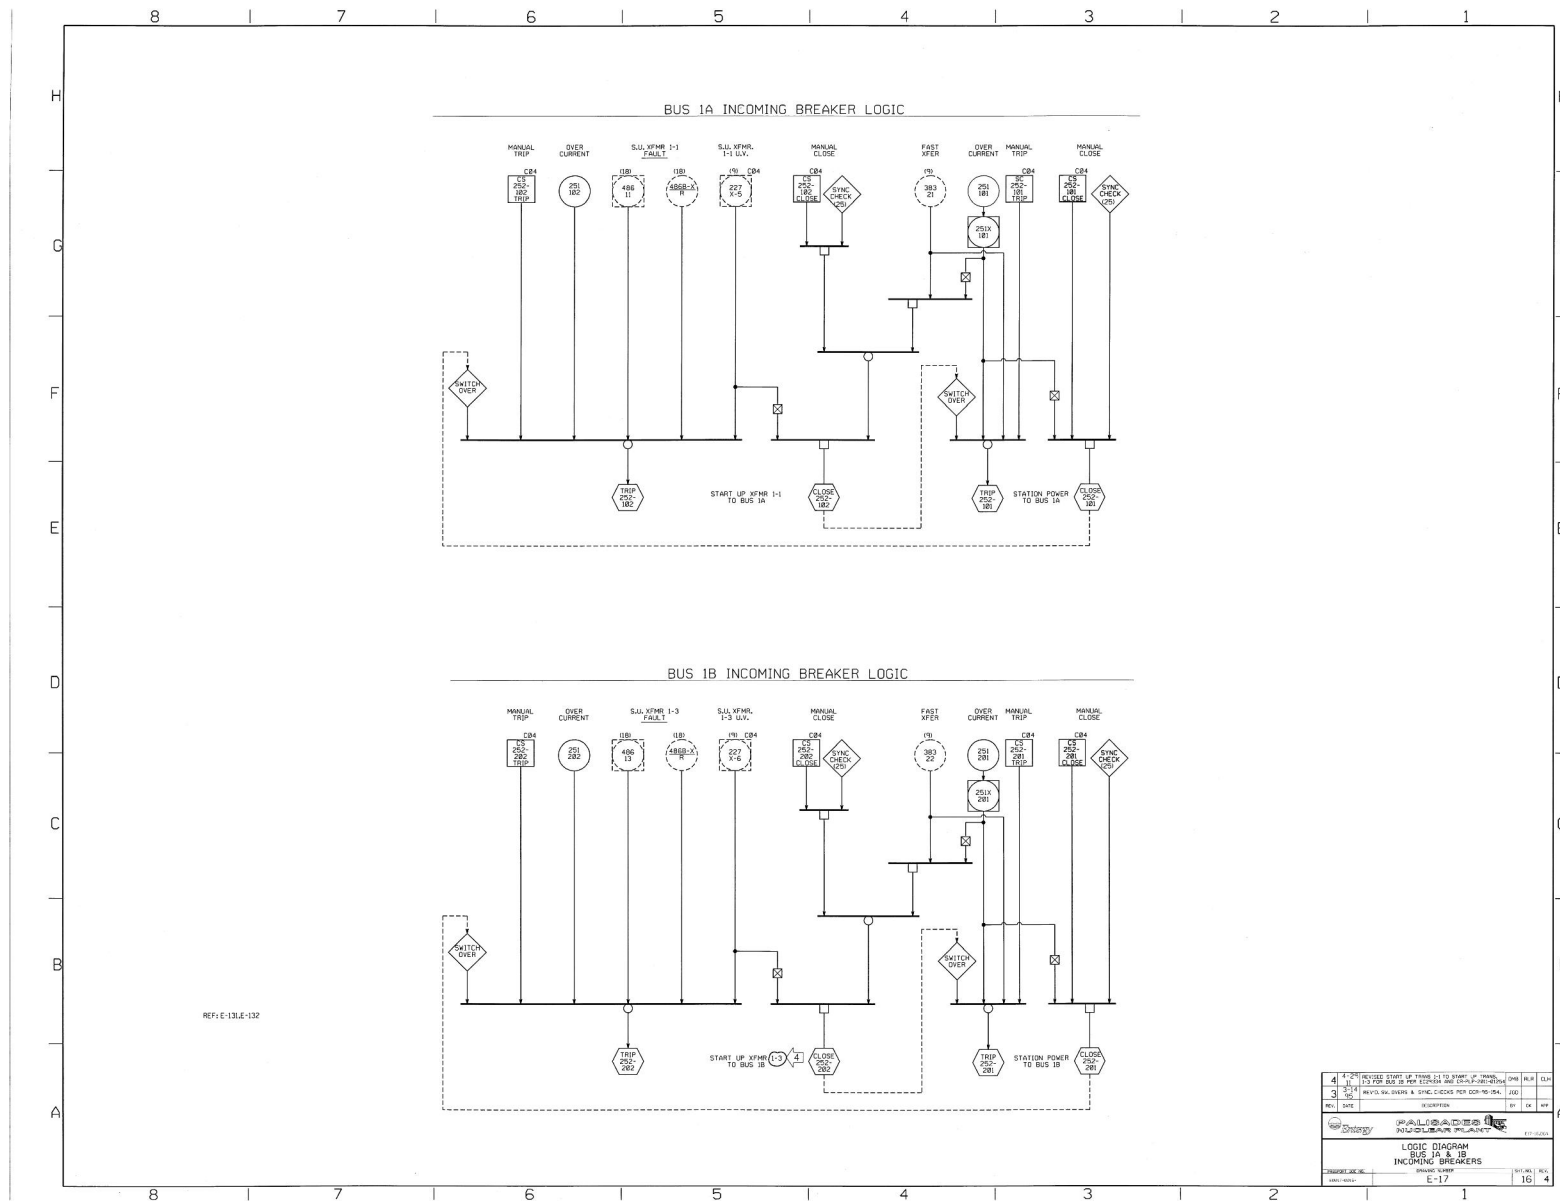


LOGIC DIAGRAM
GENERATOR BREAKER AND M.O.D. CONTROL

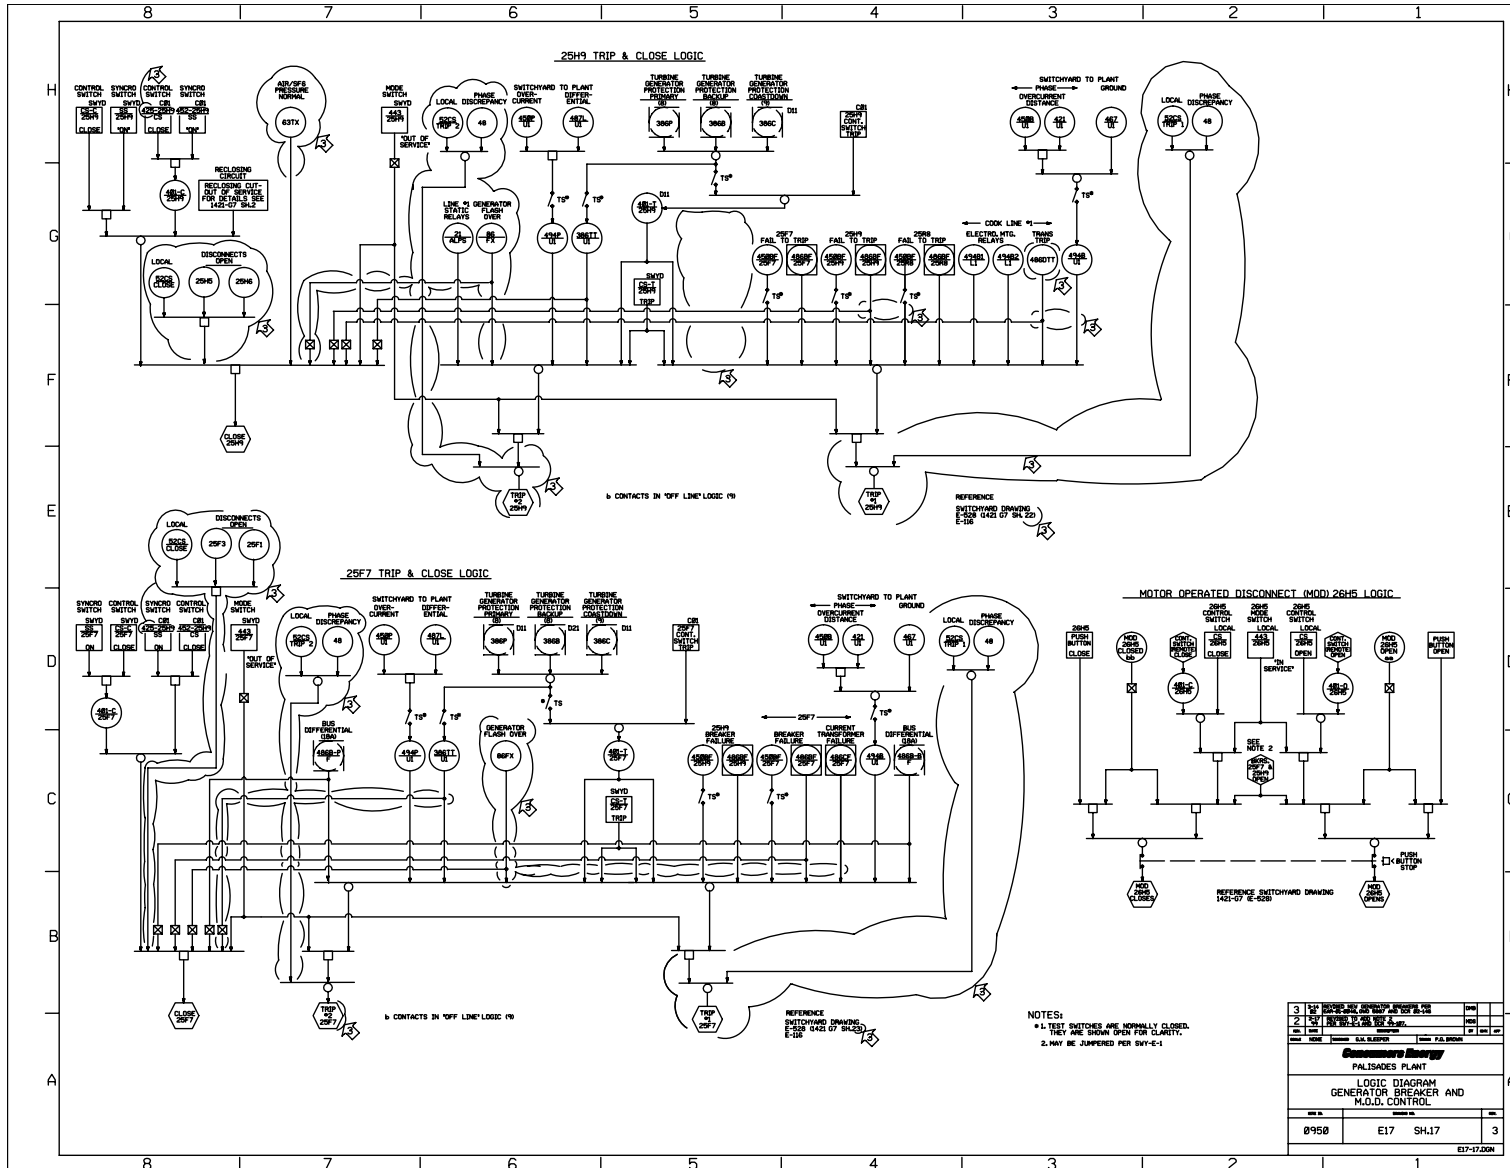


LOGIC DIAGRAM
START-UP XFMR PROTECTION

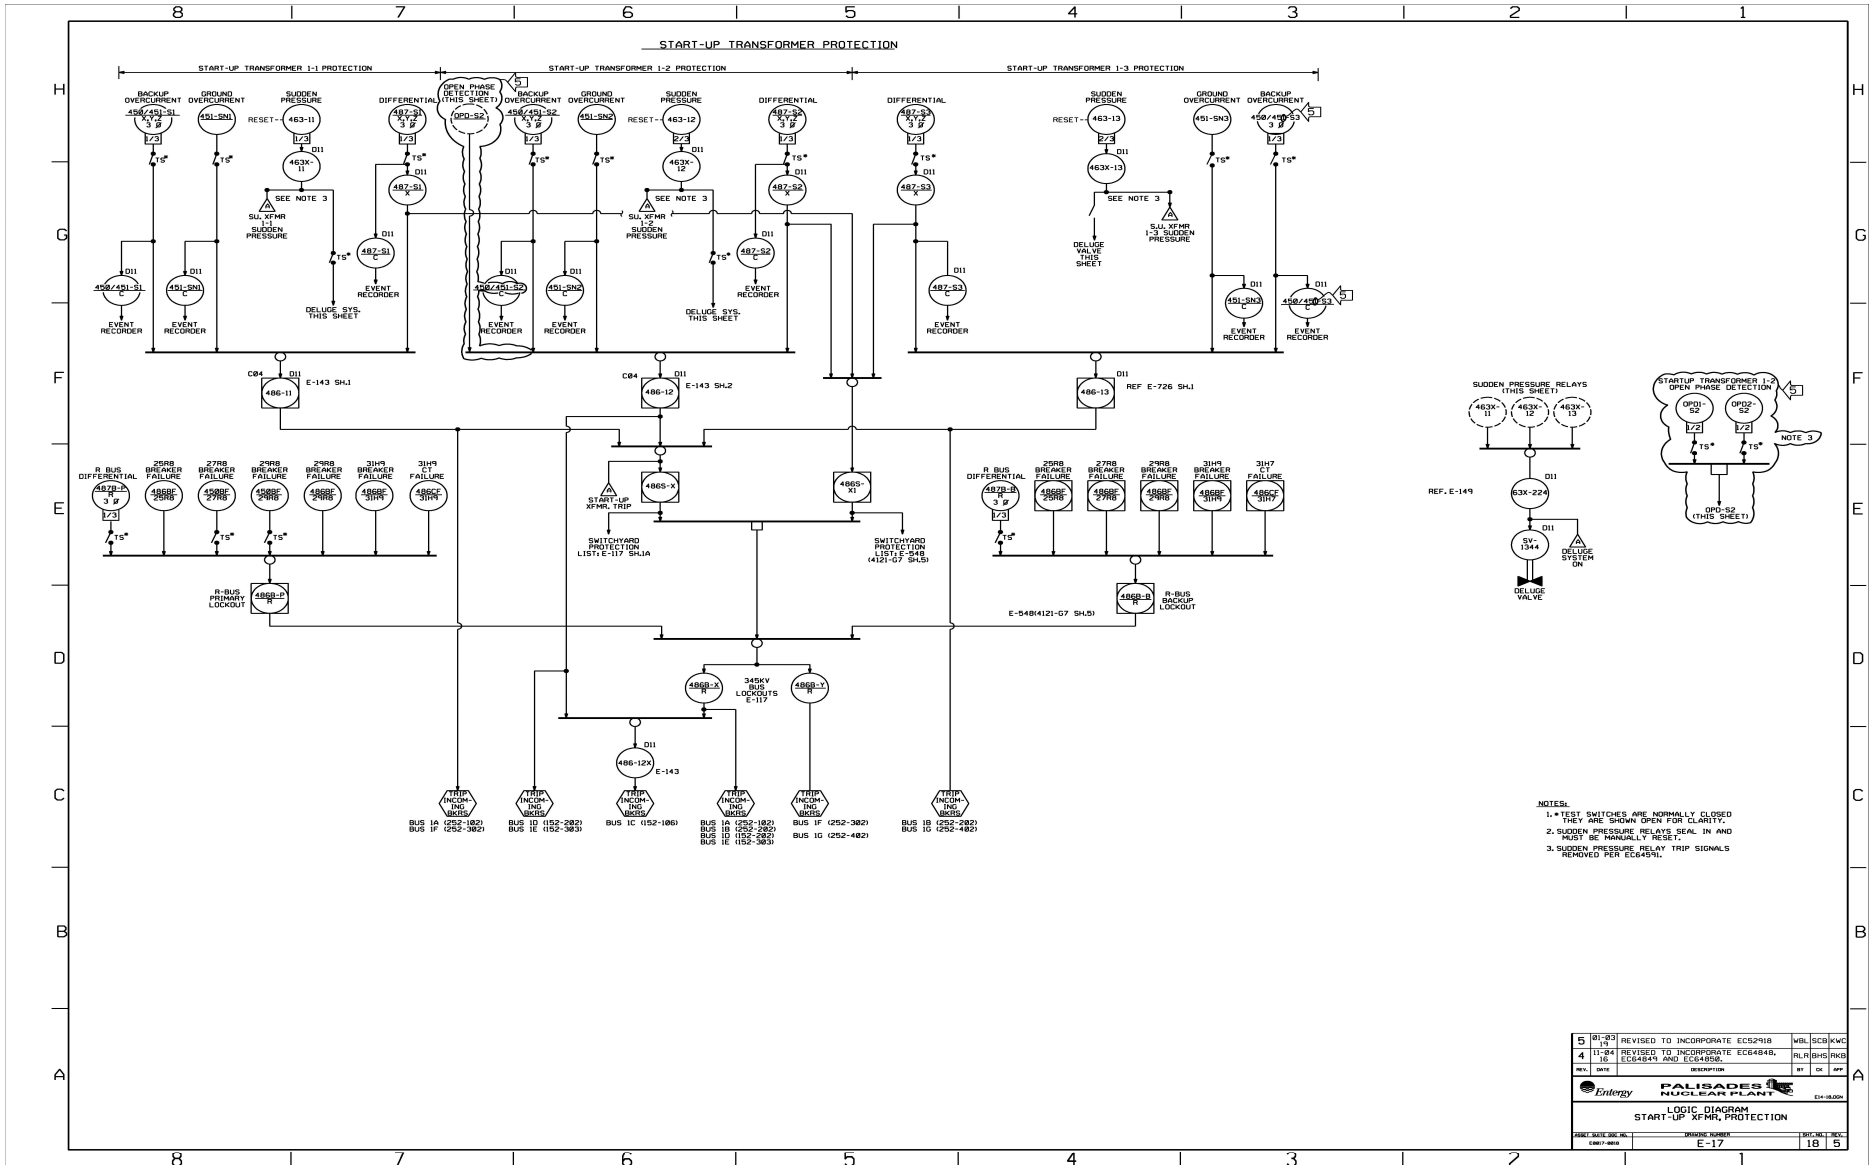


LOGIC DIAGRAM
CIRCUIT BREAKER OPERATION

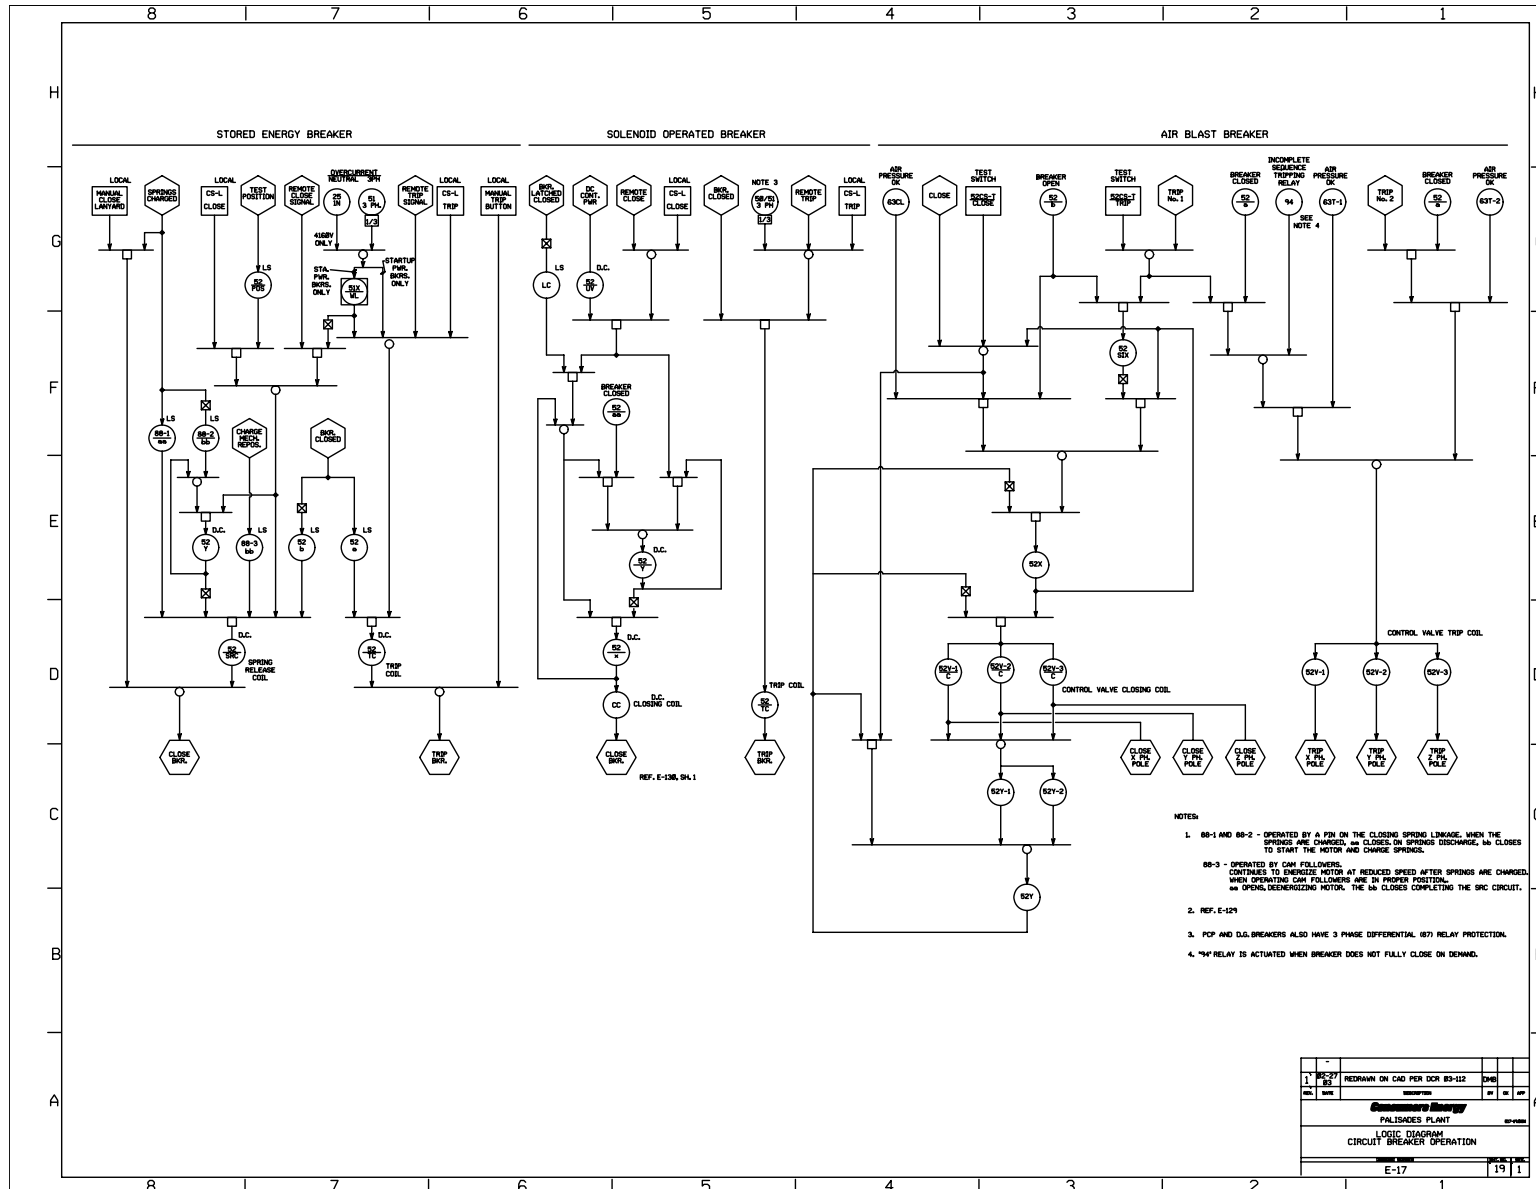

**SCHEMATIC DIAGRAM
SAFETY INJECTION SIGNAL AUXILIARY CIRCUITS**

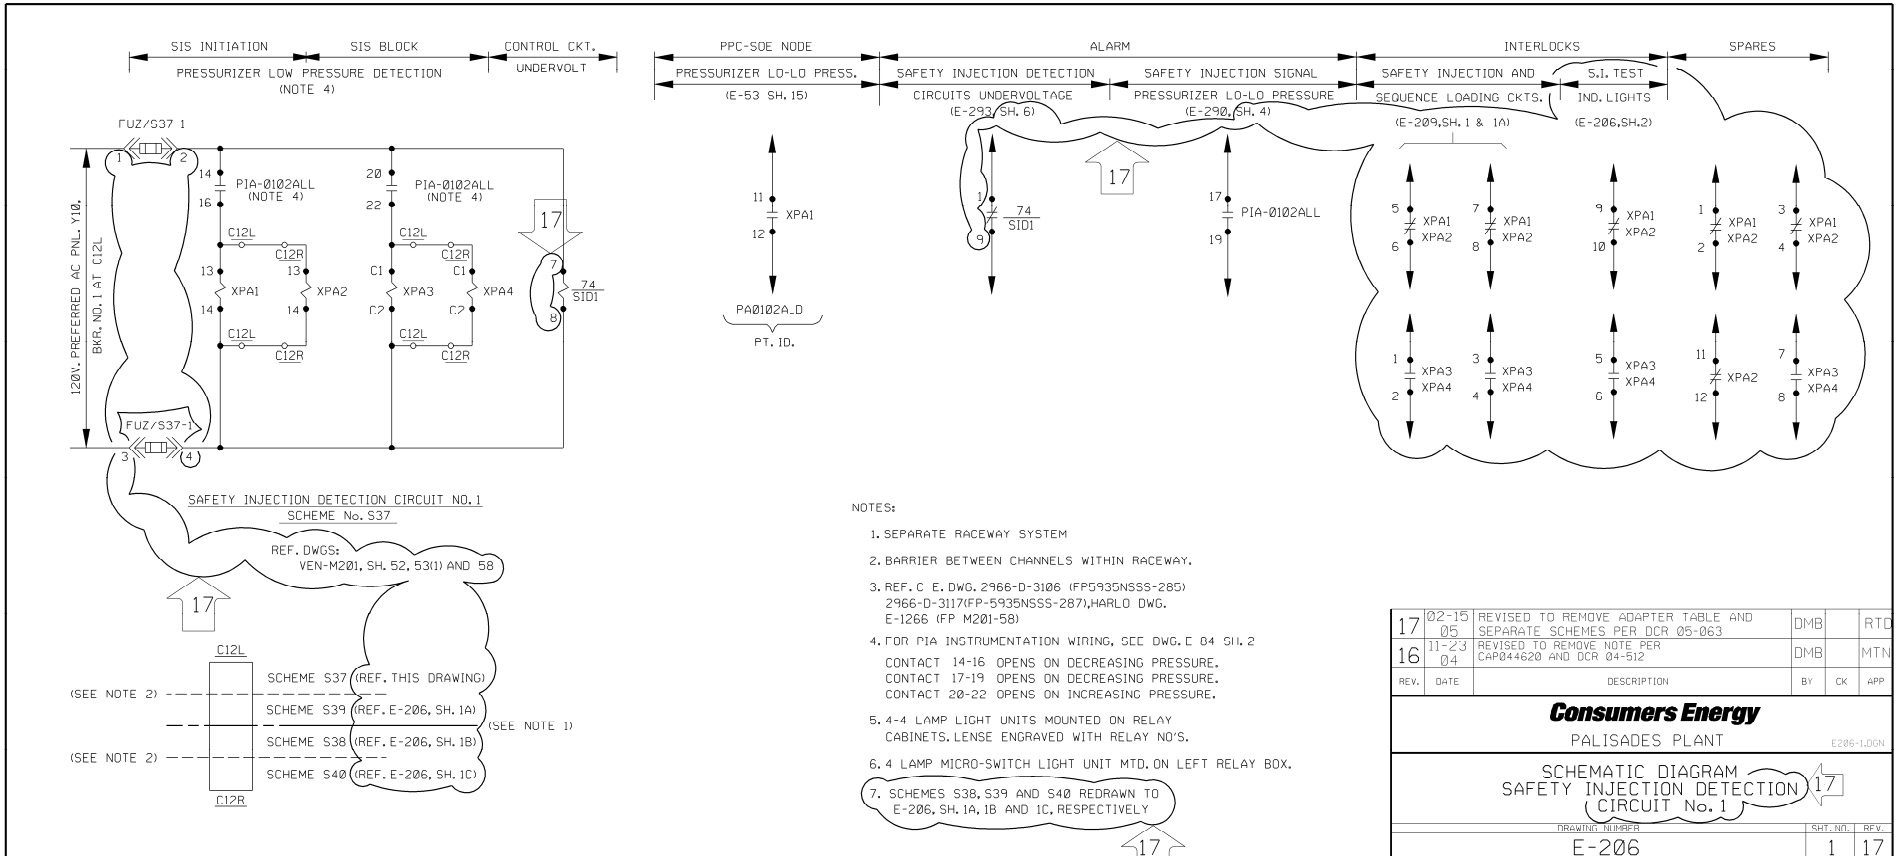


**SCHEMATIC DIAGRAM
SAFETY INJECTION SIGNAL AUXILIARY CIRCUITS**

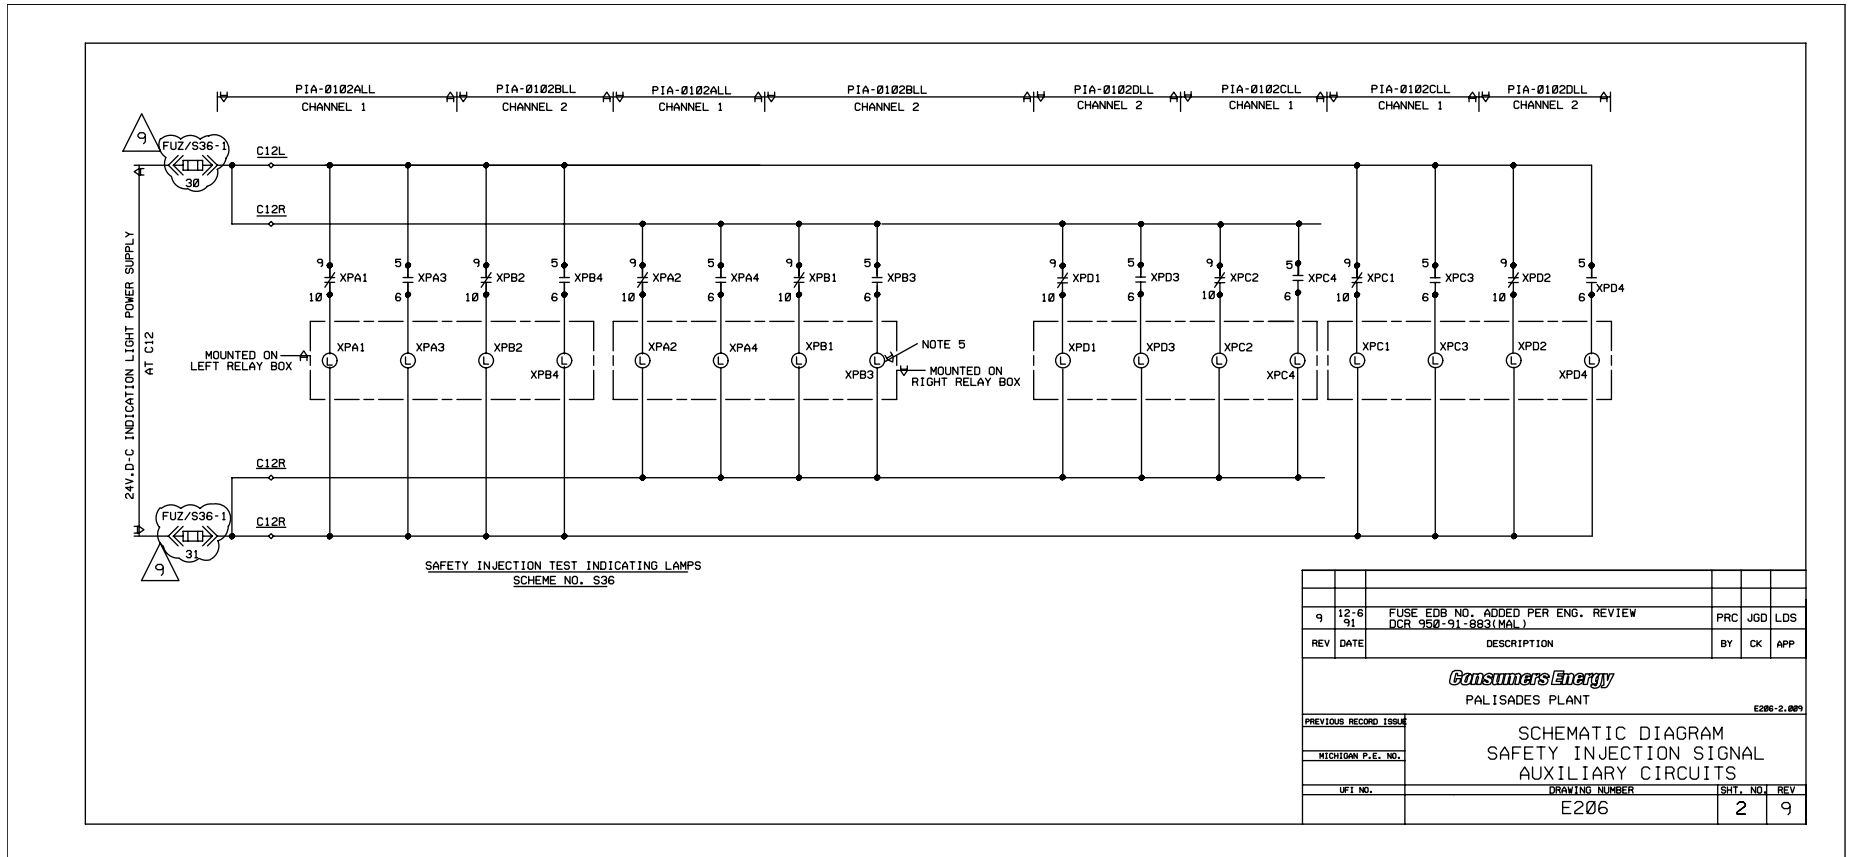


REV	DATE	DESCRIPTION	BY	CK	APP
9	12-6-91	FUSE EDB NO. ADDED PER ENG. REVIEW DCR 950-91-883(MAL)	PRC	JGD	LDS
Consumers Energy PALISADES PLANT <small>E206-2.009</small>					
PREVIOUS RECORD ISSUED		SCHEMATIC DIAGRAM SAFETY INJECTION SIGNAL AUXILIARY CIRCUITS			
MICHIGAN P.E. NO.					
LIC. NO.					
DRAWING NUMBER		SHT. NO.	REV		
E206		2	9		

**SCHEMATIC DIAGRAM
SAFETY INJECTION AND SEQUENCE LOADING CIRCUITS**

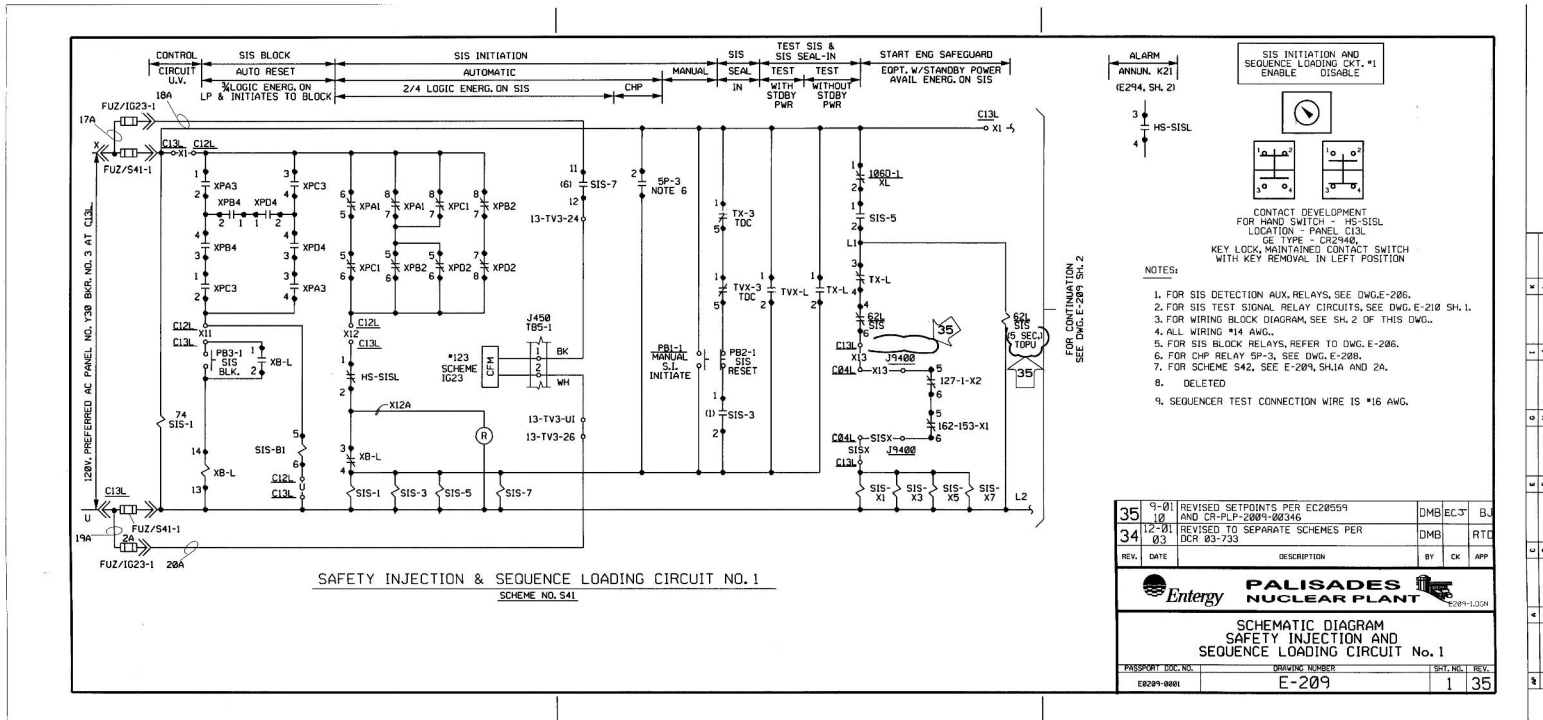


**SCHEMATIC DIAGRAM
SAFETY INJECTION AND SEQUENCE LOADING CIRCUITS**

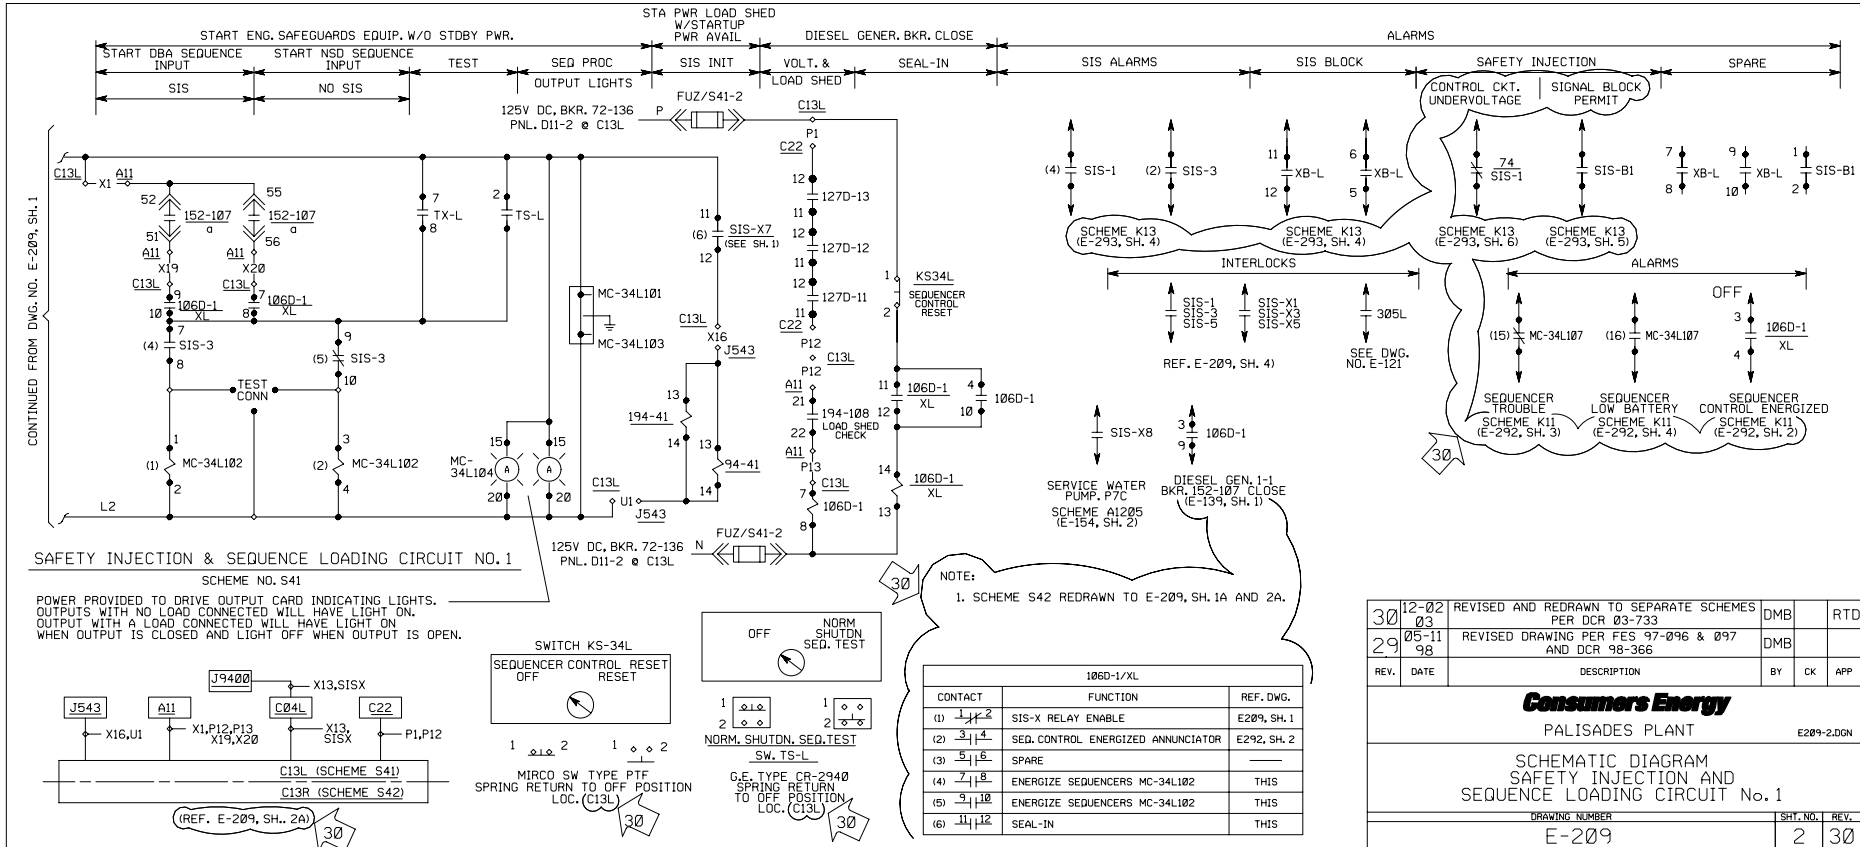

30	12-02	REVISED AND REDRAWN TO SEPARATE SCHEMES PER DCR 03-733	DMB	RTD
29	05-11	REVISED DRAWING PER FES 97-096 & 097 AND DCR 98-366	DMB	
REV.	DATE	DESCRIPTION	BY	CK APP
Consumers Energy				
PALISADES PLANT				
E209-2.DGN				
SCHEMATIC DIAGRAM SAFETY INJECTION AND SEQUENCE LOADING CIRCUIT No. 1				
DRAWING NUMBER				REV.
E-209				2 30

SCHMATIC DIAGRAM
SAFETY INJECTION AND SEQUENCE LOADING CIRCUITS

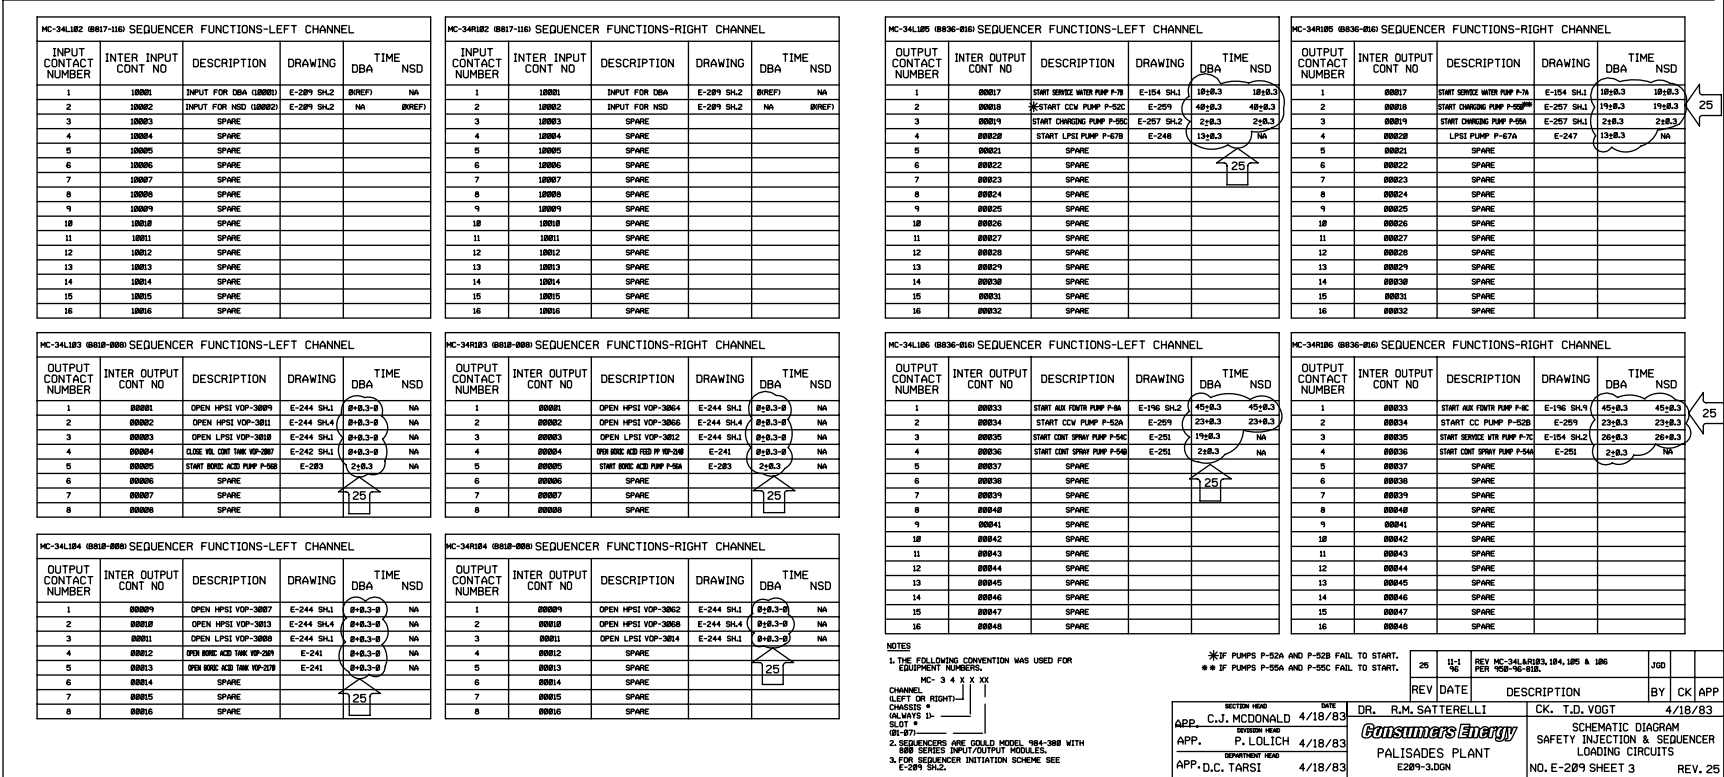

**SCHEMATIC DIAGRAM
SAFETY INJECTION AND SEQUENCE LOADING CIRCUITS**


SIS RELAYS-LEFT (ODD NUMBERS)												SIS RELAYS-RIGHT (EVEN NUMBERS)											
CONTACTS	SIS-1	REF. DWG.	SIS-3	REF. DWG.	SIS-5 (SEE NOTE 4)	REF. DWG.	CONTACTS	SIS-7	REF. DWG.	SIS-2	REF. DWG.	SIS-4	REF. DWG.	SIS-6	REF. DWG.	CONTACTS	SIS-8	REF. DWG.	SIS-10 (SEE NOTE 4)	REF. DWG.			
1	●- -●	E-228 SH1	SEAL-IN CONTACT	E-229 SH1	SIS WITH STANDBY PWR. AVAILABLE E-229 SH1	E-229 SH1	●- -●	●- -●	E-229 SH2	●- -●	E-228 SH1	SEAL-IN CONTACT	E-229 SH1	●- -●	E-229 SH1	●- -●	E-217	●- -●	E-216	●- -●	E-216		
2	●- -●	E-219 SH3	S.I. INITIATION ALARM (SIGNAL 0)	E-243 SH1	CLOSE BORIC ACID MAKE-UP STOP VALVE SV235	E-234 SH1	●- -●	●- -●	E-231 SH2	●- -●	E-231 SH2	S.I. INITIATION ALARM (SIGNAL 0)	E-243 SH1	●- -●	E-231 SH2	●- -●	E-217	●- -●	E-216	●- -●	E-216		
3	●- -●	E-227 SH2	CLOSE BORIC ACID RECIRC. VALVE POC236	E-249 SH2	CLOSE S.I. TANK RELIEF VALVE SV2347	E-245 SH3	●- -●	●- -●	E-217	●- -●	E-219 SH3	CLOSE SERVICE WTR. TO NON-CRITICAL ITEMS SV1329	E-245 SH3	●- -●	E-239 SH2	●- -●	E-217	●- -●	E-216	●- -●	E-216		
4	●- -●	E-253 SH4	START OBA SEQUENCE	E-229 SH2	CLOSE S.I. TANK RELIEF VALVE SV2339	E-249 SH3	●- -●	●- -●	E-217	●- -●	E-229 SH2	START OBA SEQUENCE	E-249 SH3	●- -●	E-239 SH2	●- -●	E-217	●- -●	E-216	●- -●	E-216		
5	●- -●	E-227 SH2	NO. SIS TO START NORMAL SHUT DN SEQUENCER	E-229 SH2	OPEN COMPONENT CLG. WTR. TO SHUT DN HEAT EXCH. SV1938	E-249 SH3	●- -●	●- -●	E-217	●- -●	E-229 SH2	NO. SIS TO START NORMAL SHUT DN SEQUENCER	E-249 SH3	●- -●	E-239 SH2	●- -●	E-217	●- -●	E-216	●- -●	E-216		
6	●- -●	E-245 SH3	CLOSE S.I. TANK RELIEF VALVE SV246	E-245 SH3	CLOSE HPSI HOT-LEG PRESSURE SETPOINT VALVE CV286	E-245 SH3	●- -●	●- -●	E-229 SH1	●- -●	E-245 SH3	CLOSE S.I. TANK RELIEF VALVE SV247	E-245 SH3	●- -●	E-216 SH1	●- -●	E-217	●- -●	E-216	●- -●	E-216		
							7	●- -●	E-239 SH2	7	●- -●	E-239 SH2	ENABLE OPENING COMP. CLG. WTR. TO FUEL POOL HEAT EXCH.	E-239 SH2	7	●- -●	E-228 SH1	7	●- -●	E-228 SH1	E-228 SH1		
							8	●- -●	E-231 SH2	8	●- -●	E-231 SH2	CLOSE COMP. CLG. WTR. TO FUEL POOL HEAT EXCH. SV1944A	E-231 SH2	8	●- -●	E-245 SH1	8	●- -●	E-245 SH1	E-245 SH1		
							9	●- -●	E-231 SH2	9	●- -●	E-231 SH2	CLOSE COMP. CLG. WTR. TO RADWST. EVAPS. SV1944, SV1977B	E-231 SH2	9	●- -●	E-228 SH1	9	●- -●	E-228 SH1	E-228 SH1		
							10	●- -●		10	●- -●		SPARE		10	●- -●		10	●- -●				
							11	●- -●		11	●- -●		SPARE		11	●- -●		11	●- -●				
							12	●- -●		12	●- -●		SPARE		12	●- -●		12	●- -●				

SIS-X RELAYS-LEFT (ODD NUMBERS)												SIS-X RELAYS-RIGHT (EVEN NUMBERS)											
CONTACTS	SIS-X1	REF. DWG.	SIS-X3	REF. DWG.	SIS-X5	REF. DWG.	SIS-X7	REF. DWG.	SIS-X2	REF. DWG.	SIS-X4	REF. DWG.	SIS-X6	REF. DWG.	SIS-X8	REF. DWG.							
1	●- -●	E-249	START L.P. INJ. PUMP P27B	E-249	OPEN H.P. INJ. LINE MOV 381	E-244 SH4	CLOSE VOLUME CONTROL TANK OUTLET MOV2887	E-242 SH1	START SERV. WTR. PUMP P7B	E-247	START L.P. INJ. PUMP P27A	E-249	START H.P. INJ. PUMP P66A	E-241	START SERV. WTR. PUMP P7C	E-154 SH2							
2	●- -●	E-249	START L.P. INJ. PUMP P27B	E-249	OPEN H.P. INJ. LINE MOV 382	E-244 SH1	CLOSE BORIC ACID PUMP P56B	E-241	START COMP. CLG. PUMP P52A	E-247	START H.P. INJ. PUMP P66A	E-249	START H.P. INJ. PUMP P66A	E-241	START SERV. WTR. PUMP P7C	E-154 SH2							
3	●- -●	E-251	CONT. SPRAY PUMP P54B ON STAND BY	E-251	OPEN H.P. INJ. LINE MOV 382	E-244 SH1	OPEN BORIC ACID GRAVITY FEED MOV216A	E-241	START COMP. CLG. PUMP P52C	E-247	START H.P. INJ. PUMP P66A	E-249	START H.P. INJ. PUMP P66A	E-241	START SERV. WTR. PUMP P7C	E-154 SH2							
4	●- -●	E-244 SH1	TRIP CONT. CLG. UNIT Y4B	E-244 SH1	TRIP CONT. CLG. UNIT Y4B	E-244 SH1	OPEN BORIC ACID GRAVITY FEED MOV217B	E-241	SPARE	E-247	START H.P. INJ. LINE MOV 382	E-249	START H.P. INJ. PUMP P66A	E-241	START SERV. WTR. PUMP P7C	E-154 SH2							
5	●- -●	E-244 SH1	SPARE	E-244 SH1	SPARE	E-244 SH1	SPARE	E-241	SPARE	E-247	START H.P. INJ. LINE MOV 382	E-249	START H.P. INJ. PUMP P66A	E-241	START SERV. WTR. PUMP P7C	E-154 SH2							
6	●- -●	E-244 SH4	CONT. SPRAY PUMP P54C ON STAND BY	E-244 SH4	CONT. SPRAY PUMP P54C ON STAND BY	E-244 SH4	START CHG. PUMP P55C	E-241	INITIATE STARTUP POWER LOAD SHED SYSTEM	E-247	START H.P. INJ. LINE MOV 384	E-249	START H.P. INJ. PUMP P66A	E-241	INITIATE STARTUP POWER LOAD SHED SYSTEM	E-241							


FUNCTIONS WITH SIS & STANDBY POWER AVAILABLE											
REV.	DATE	DESCRIPTION	BY	CK	APP						
31	10-26	REVISED TO INCORPORATE ECI19665	RLR	DMK	ECJ						
30	12-02	REVISED PER SC-95-098 AND DCR 98-340	DMB		RTD						

GWO_8428 SUBMERGED ELECT. EQUIP. MOD.		PALISADES NUCLEAR PLANT		E289-4.00A
NOTES				
1. * N.O. CONTACT				
2. ** N.C. CONTACT-OPENS ON SIS				
3. FOR RELAY CIRCUITS, SEE E-209, SH1				
4. SIS-10 & SIS-5 RELAYS HAVE 12 CONTACTS				
SCHEMATIC DIAGRAM SAFETY INJECTION & SEQUENCE LOADING CIRCUITS			DRAWING NUMBER	SIT. NO. REV.
E-209			4	31

**SCHEMATIC DIAGRAM
SAFETY INJECTION AND SEQUENCE LOADING TEST CIRCUITS**

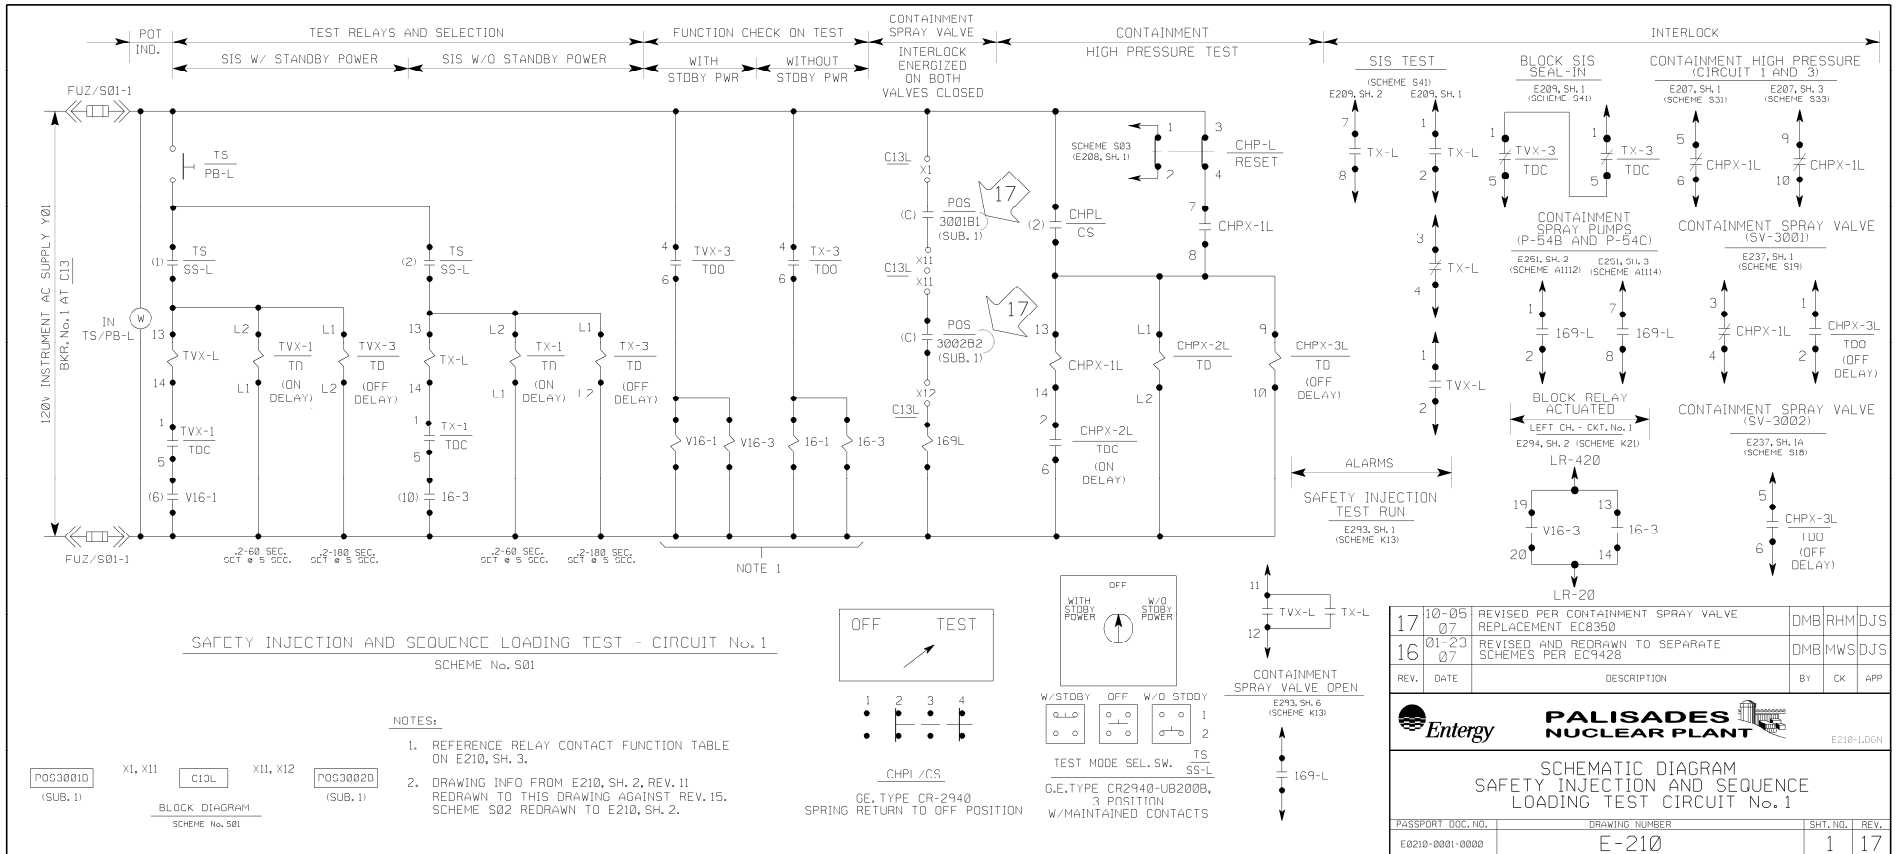

**SCHEMATIC DIAGRAM
SAFETY INJECTION AND SEQUENCE LOADING TEST CIRCUITS**

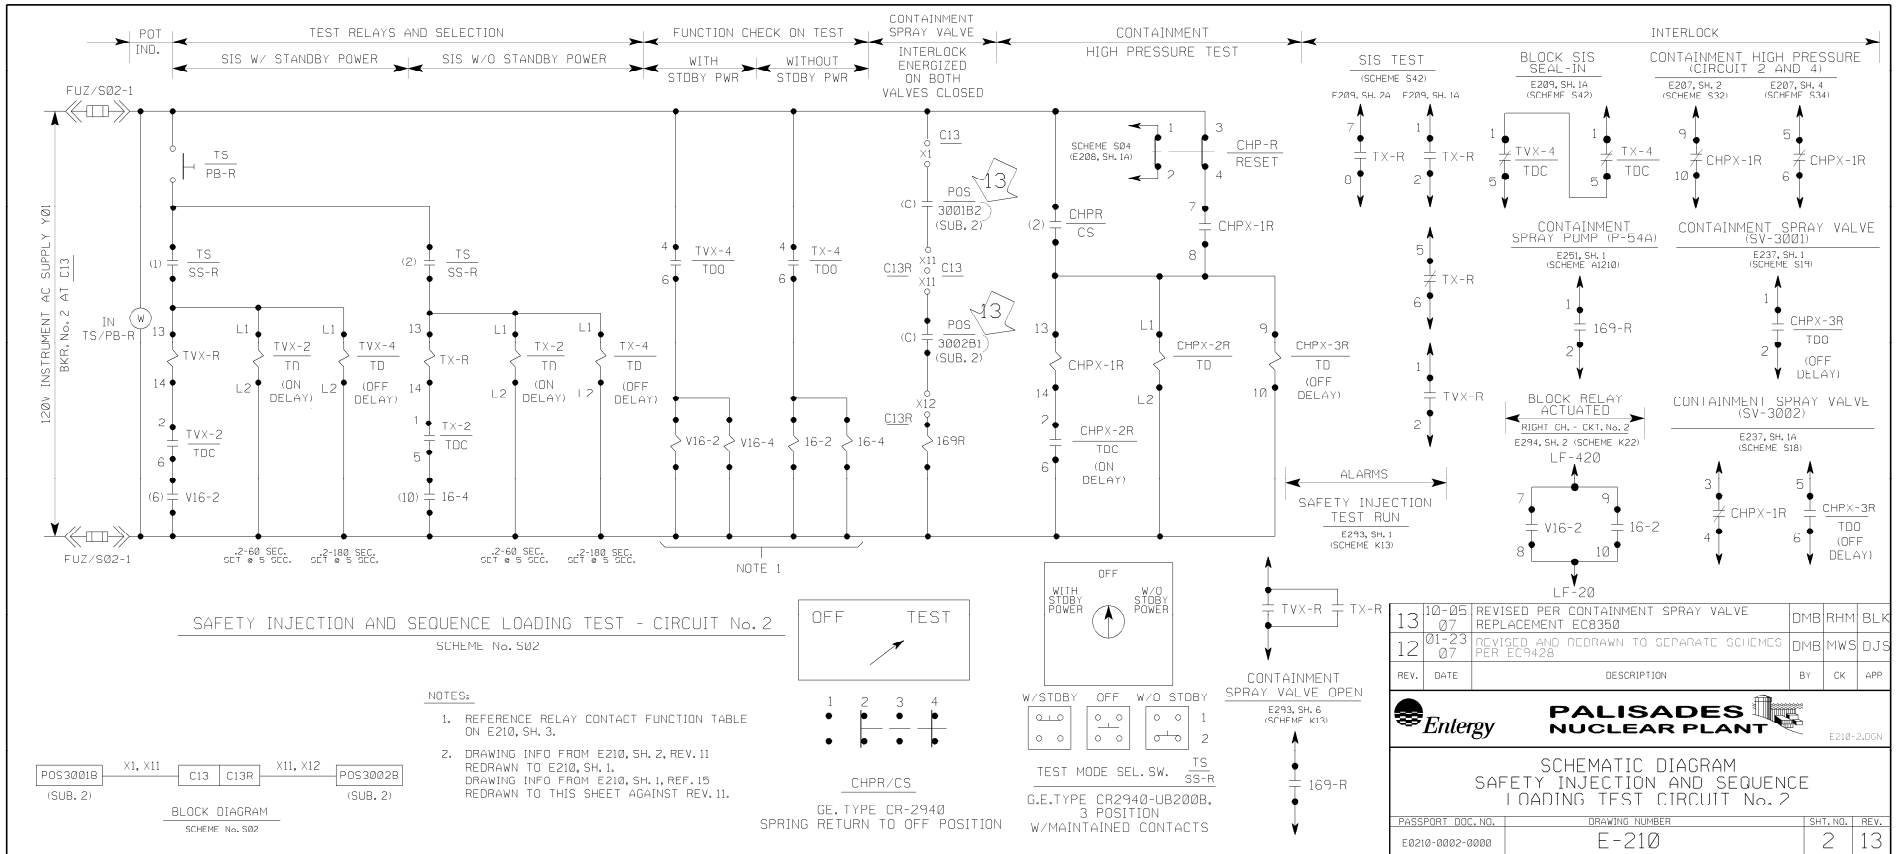

**SCHEMATIC DIAGRAM
SAFETY INJECTION AND SEQUENCE LOADING TEST CIRCUITS**

TEST RELAY TABLES

CONTACT NO.	CONTACT	FUNCTION ON TEST WITH STAND-BY POWER							
		LEFT (ODD NUMBERS)				RIGHT (EVEN NUMBERS)			
		RELAY V16-1	REF. DWG.	RELAY V16-3	REF. DWG.	RELAY V16-2	REF. DWG.	RELAY V16-4	REF. DWG.
1	• H •	LOW PRESSURE SAFETY INJECTION PUMP P67B	E-248	• F • BLKS BKR 52-7804 ⊕	E-135 SH.1	LOW PRESSURE SAFETY INJECTION PUMP P67A	E-247	CHARGING PUMP P55A	E-257 SH.1
2	• F •			• F • BLKS BKR 152-303 ⊕	E-132 SH.1			CHARGING PUMP P55B	E-257 SH.1
3	• F •	BORIC ACID GRAVITY FEED VALVE MOV 2169 ⊕	E-241	• F • BLKS BKR 152-102 ⊕	E-151	BORIC ACID PUMPED FEED VALVE MOV 2140 ⊕	E-241	BLOCK 30-1359	E-219 SH.3
4	• F •	BORIC ACID GRAVITY FEED VALVE MOV 2170 ⊕	E-241	• F • BLKS BKR 152-302 ⊕	E-131 SH.1	BLOCKING RELAYS ACTUATED SEE NOTE 1	E-210 SH.2	MAINTAIN OPEN CV-1359 ⊕ SEE NOTE 2	E-219 SH.3
5	• F •	MAINTAIN OPEN VOLUME CONTROL TANK MOV 2087 ⊕	E-242	• F • BLKS BKR 52-7701 ⊕	E-135 SH.1			• F • BLKS BKR 152-302 ⊕	E-131 SH.1
6	• H •	TEST START CIRCUIT NO 1	E-210	BORIC ACID PUMP P56B	E-203	TEST START CIRCUIT NO 2	E-210	• F • BLKS BKR 152-303 ⊕	E-132 SH.1
7	• H •	SERVICE WATER PUMP P7B	E-154 SH.1	HIGH PRESSURE INJECTION PUMP P66B	E-249	SERVICE WATER PUMP P7A	E-154 SH.1	HIGH PRESSURE INJECTION PUMP P66A	E-249
8	• H •	CHARGING PUMP P55C	E-257 SH.2	MAINTAIN OPEN CV-1359	E-219 SH.3	SERVICE WATER PUMP P7C	E-154 SH.2	• F • BLKS BKR 52-7701 ⊕	E-135 SH.1
9	• H •	COMPONENT COOLING PUMP P52A	E-259	• F • BLOCK 30-1359	E-219 SH.3	BORIC ACID PUMP P56A	E-203	• F • BLKS BKR 52-7804 ⊕	E-135 SH.1
10	• H •	COMPONENT COOLING PUMP P52C	E-259	BLOCKING RELAYS ACTUATED	E-210 SH.2	COMPONENT COOLING PUMP P52B	E-259	• F • BLKS BKR 152-102 ⊕	E-151

⊕ BLOCKS OPERATION ON TEST

CONTACT NO.	CONTACT	FUNCTION ON TEST WITHOUT STAND-BY POWER							
		LEFT (ODD NUMBERS)				RIGHT (EVEN NUMBERS)			
		RELAY 16-1	REF. DWG.	RELAY 16-3	REF. DWG.	RELAY 16-2	REF. DWG.	RELAY 16-4	REF. DWG.
1	• H •	LOW PRESSURE SAFETY INJECTION PUMP P67B	E-248	BORIC ACID PUMP P56B	E-203	LOW PRESSURE SAFETY INJECTION PUMP P67A	E-247	CHARGING PUMP P55A	E-257 SH.1
2	• H •	CONTAINMENT COOLER RECIRC. FAN V4A	E-217	HIGH PRESSURE SAFETY INJECTION PUMP P66B	E-249	HIGH PRESSURE SAFETY INJECTION PUMP P66A	E-249	MAINTAIN OPEN CV-1359 ⊕	E-219 SH.3
3	• H •	SERVICE WATER PUMP P7B	E-154 SH.1			SERVICE WATER PUMP P7A	E-154 SH.1	SERVICE WATER PUMP P7C	E-154 SH.2
4	• F •			BLOCK 30-1359	E-219 SH.3				
5	• H •	COMPONENT COOLING PUMP P52A	E-259	MAINTAIN OPEN CV-1359	E-219 SH.3	BLOCKING RELAYS ACTUATED	E-210 SH.2	CONTAINMENT COOLER RECIRC. FAN V2A	E-216
6	• H •	COMPONENT COOLING PUMP P52C	E-259	CHARGING PUMP P55C	E-257 SH.2	CONTAINMENT COOLER RECIRC. FAN V1A	E-216	CONTAINMENT COOLER RECIRC. FAN V3A	E-216
7	• H •			BLOCKING RELAYS ACTUATED	E-210 SH.2	BORIC ACID PUMP P56A	E-203	CHARGING PUMP P55B	E-257
8	• F •	MAINTAIN OPEN VOLUME CONTROL TANK MOV 2087 ⊕	E-242	BORIC ACID GRAVITY FEED VALVE MOV 2169 ⊕	E-241	SPARE		BORIC ACID PUMPED FEED MOV 2140 ⊕	E-241
9	• F •			BORIC ACID GRAVITY FEED VALVE MOV 2170 ⊕	E-241	SPARE		BLOCK 30-1359	E-219 SH.3
10	• H •			TEST START CIRCUIT NO. 1	E-210 SH.1	COMPONENT COOLING PUMP P52B	E-259	TEST START CIRCUIT NO 2	E-210

NOTES:

- RELAY V-16-2 CONTACT GROUP #4 IS CHANGED TO NORMALLY OPEN.
- CONTACTS CHANGED TO NORMALLY OPEN.


REV.	DATE	DESCRIPTION	BY	CK	APP
19	01-23 07	REVISED TO REFLECT AS-BUILT PER EC9428	DMB		DJS
18	11-4 93	REVISED RELAY V16-1 CONTACT 3 TO MOV 2169 PFR PER 93-1297	JFM	HE	

Consumers Energy
PALISADES PLANT E210-3.00A


SCHEMATIC WIRING DIAGRAM
SAFETY INJECTION & SEQUENCE
LOADING TEST CIRCUIT

DRAWING NUMBER	SHT. NO.	REV.
E-210	3	19


LOGIC DIAGRAM
CONTAINMENT HIGH PRESSURE SIGNAL

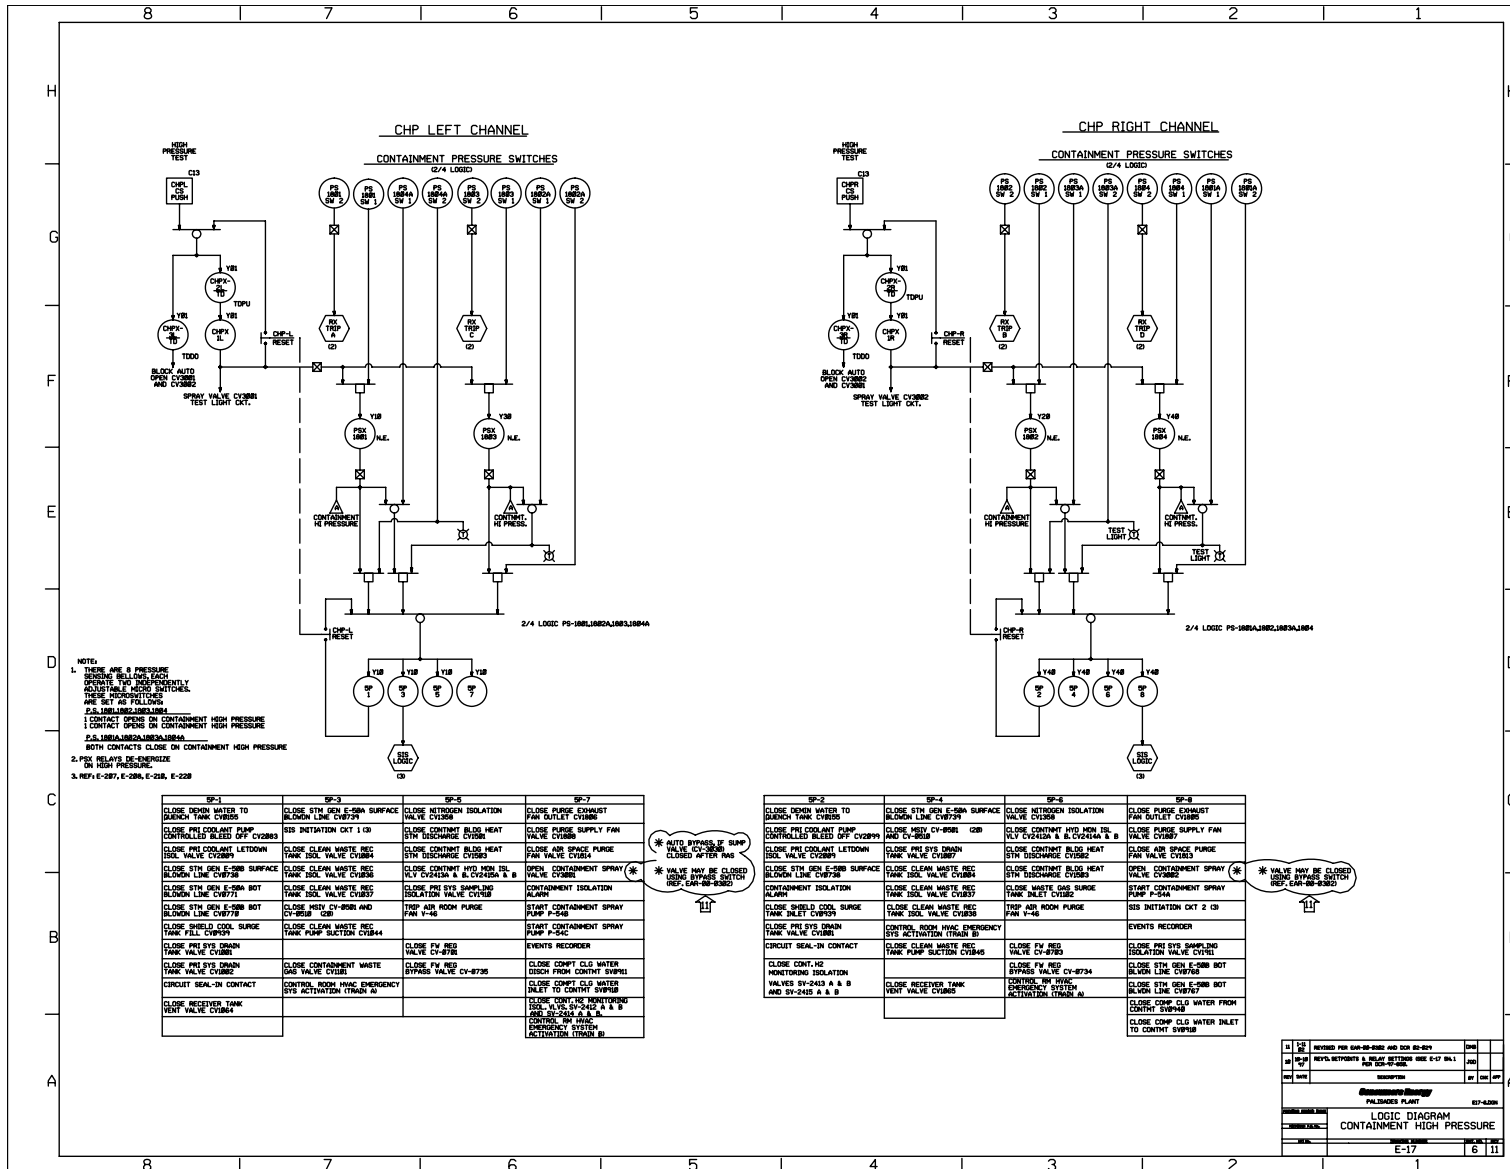


**SCHEMATIC DIAGRAM
CONTAINMENT HIGH PRESSURE, HIGH RADIATION AND SIRW TANK LOW LEVEL**

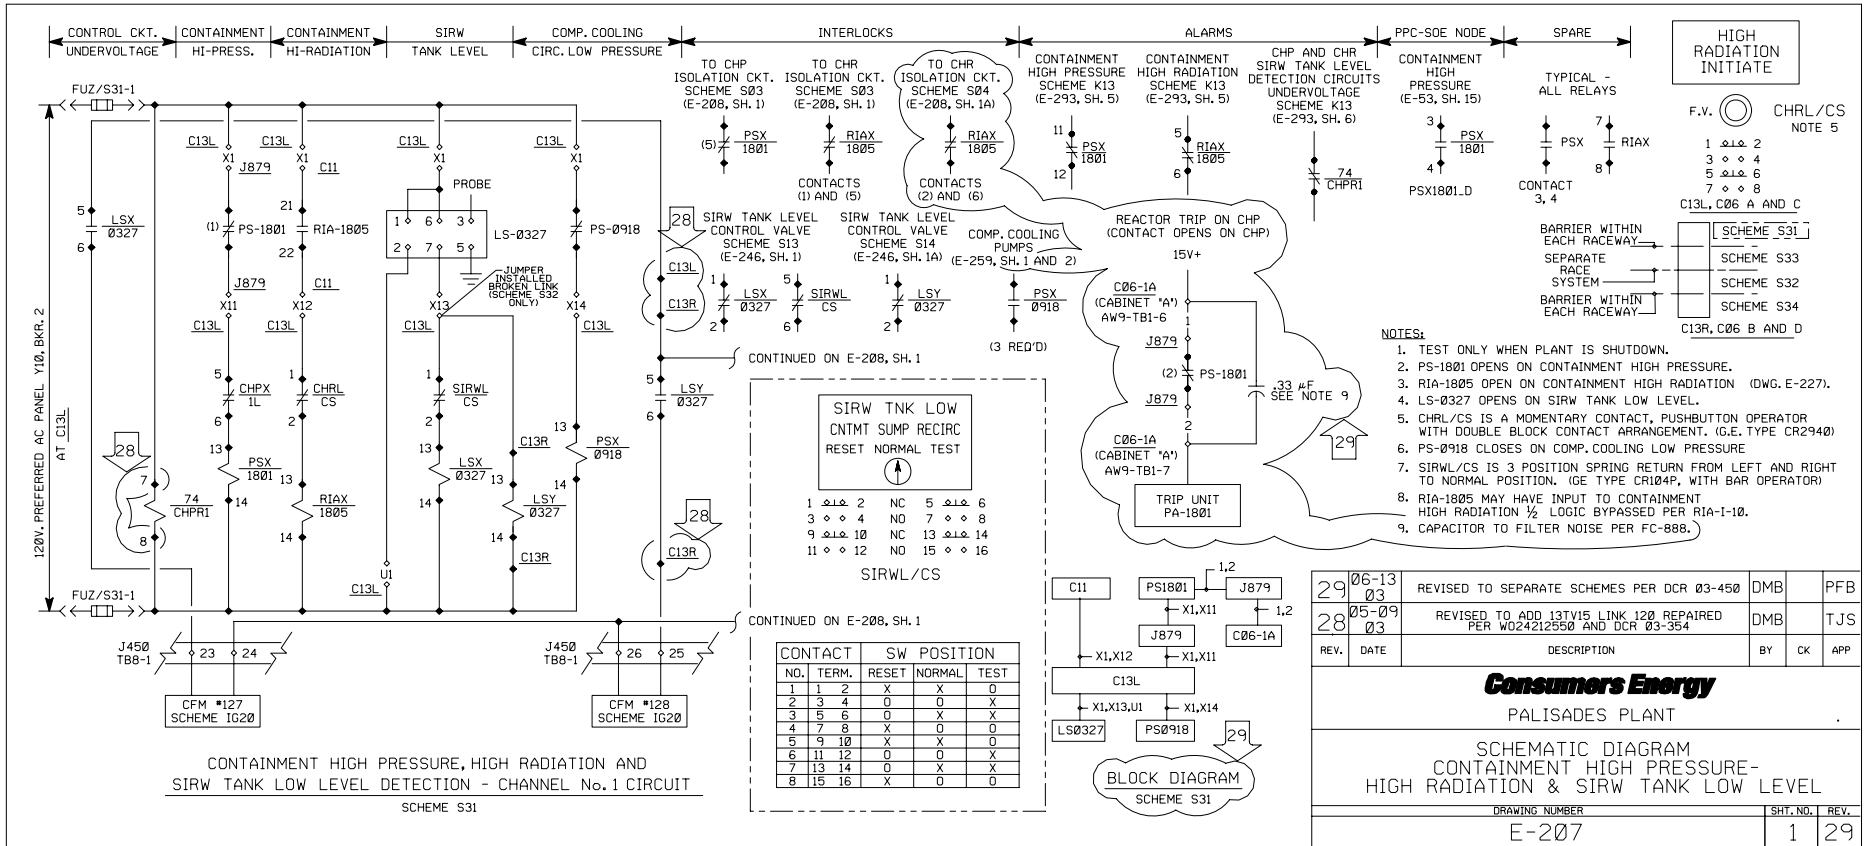

**SCHEMATIC DIAGRAM
CONTAINMENT HIGH PRESSURE, HIGH RADIATION AND SIRW TANK LOW LEVEL**

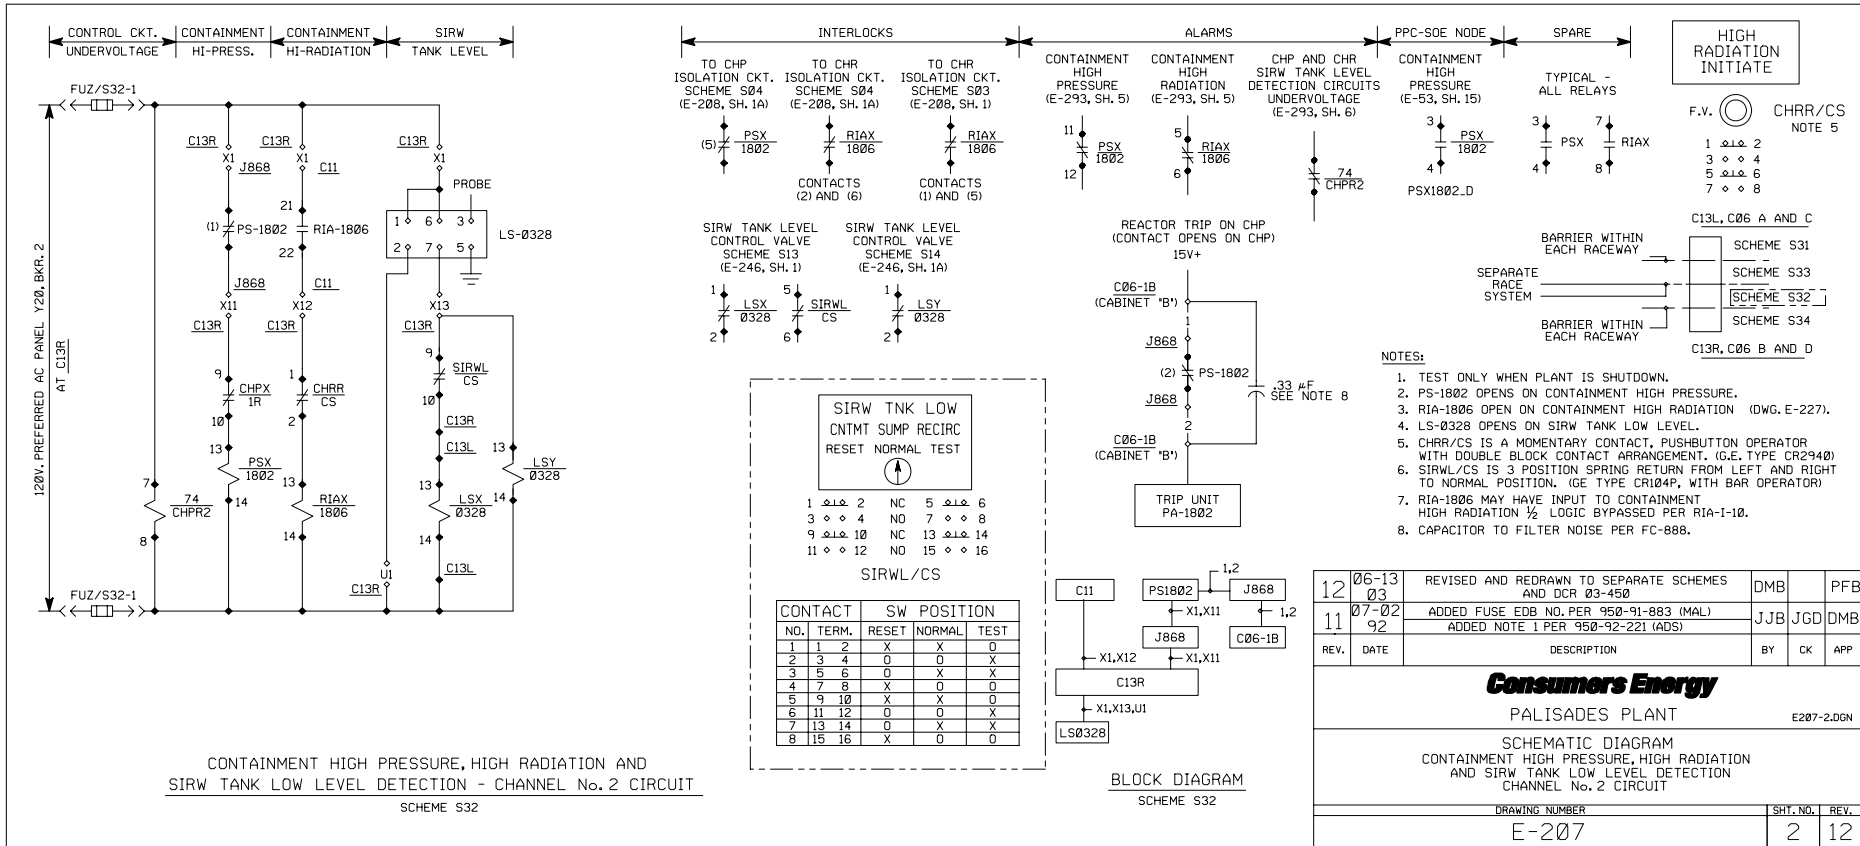

**SCHEMATIC DIAGRAM
CONTAINMENT ISOLATION ON HIGH PRESSURE OR HIGH RADIATION**

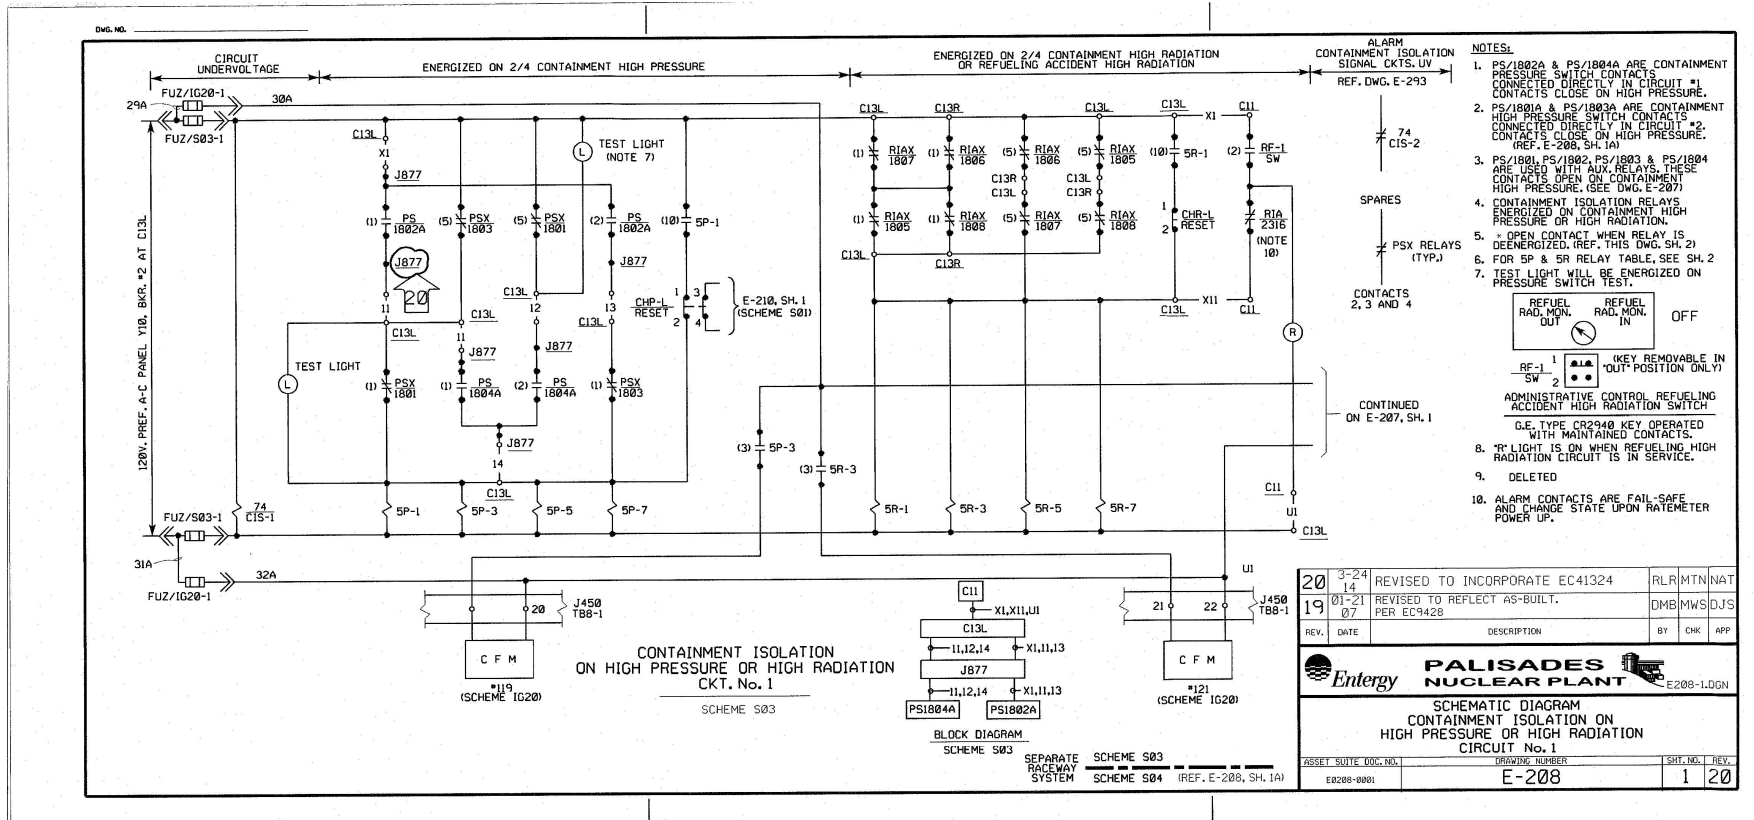

**SCHEMATIC DIAGRAM
CONTAINMENT ISOLATION ON HIGH PRESSURE OR HIGH RADIATION**

CONTAINMENT ISOLATION RELAY TABLE

CONTACTS	RELAYS 5P-1 & 5R-1	REF. DWG.	RELAYS 5P-3 & 5R-3	REF. DWG.	RELAYS 5P-5 & 5R-5	REF. DWG.	RELAYS 5P-7 & 5R-7	REF. DWG.
1	CLOSE DEMIN. WATER TO DRENCH TANK SV1065	E-235 SH.2	CLOSE STM. GEN. E-50A TOP BLOWN LINE SV0739	E-235 SH.3	DISABLE AUTO START OF ENG SFGRDS SUMP PUMP P-738 (5R-5 ONLY)	E-285 SH.1	CLOSE PURGE EXHAUST FAN OUTLET SV1006	E-221
2	CLOSE PRI. COOLANT PUMP CONTROLLED BLEED OFF SV2083	E-235 SH.2	*SIS INITIATION LKT.1 (5P-3 ONLY)	E-209 SH.1	CLOSE NITROGEN ISOLATION VALVE SV1358	E-235 SH.3	CLOSE PURGE SUPPLY FAN VALVE SV1808	E-221
3	CLOSE PRI. COOLANT LETDOWN ISOL. VALVE SV2003	E-235 SH.2	*CRITICAL FUNCTION MON. INPUTS: *I19 (FOR 5P-3), *I21 (FOR 5R-3)	E-208 SH.1	CLOSE CONTAINMENT BLDG. HEAT STM. DISCHARGE SV1502	E-235 SH.1	CLOSE AIR SPACE PURGE FAN VALVE SV1814	E-221
4	CLOSE STM. GEN. E-50B TOP BLOWN LINE SV0738	E-235 SH.3	CLOSE CLEAN WASTE REC. TANK ISOL. VALVE SV1004	E-235 SH.3	*CLOSE CV-0701 FW REG VLV (5P-5 ONLY)	E-69 SH.1	OPEN CONTAINMENT SPRAY VALVE SV3001 (5P-7 ONLY)	E-237
5	CLOSE STM. GEN. E-50A BOT. BLOWN LINE SV0771	E-235 SH.4	CLOSE CLEAN WASTE REC. TANK ISOL. VALVE SV1036	E-235 SH.3	CLOSE CONTAINMENT BLDG. HEAT STM. INLET SV1503	E-235 SH.3	*CONTAINMENT ISOLATION ALARM K11 #26	E-292 SH.2
6	CLOSE STM. GEN. E-50B BOT. BLOWN LINE SV0770	E-235 SH.4	CLOSE CLEAN WASTE REC. TANK ISOL. VALVE SV1037	E-235 SH.3	CLOSE CONT. HYD. MON. ISL. VLV. SV-2413A & B SV-2415A & B	E-235 SH.1	*START CONTAINMENT SPRAY PUMP P-548 (5P-7 ONLY)	E-251
7	CLOSE SHIELD COOL SURGE TANK INLET SV0939	E-235 SH.3	*CLOSE MSIV CV0501 & CV-0510 (5P-4 ONLY)	E-238 SH.1	CLOSE CONTAINMENT SUMP DR. VALVE SV1103 (RELAYS 5R-5 ONLY)	E-235 SH.1	*START CONTAINMENT SPRAY PUMP P-548 (5P-7 ONLY)	E-251
8	CLOSE PRI. SYS. DRAIN TANK VALVE SV1001	E-235 SH.3	CLOSE CLEAN WASTE REC. TANK PUMP SUCTION SV1044	E-235 SH.1	*CLOSE CV-738 FW REG BYPASS VLV (5P-5 ONLY)	E-69 SH.1	CLOSE CONT. H ₂ MONT. ISOL. VLV. SV-2412A & B SV-2414A & B	E-916 SH.2
9	CLOSE PRI. SYS. DRAIN TANK VALVE SV1002	E-235 SH.3	*SPARE	E-235 SH.1	CLOSE PRI. SYS. SAMPLING ISOLATION VALVE SV1910	E-235 SH.1	SYSTEM ACTIVATION (TRAIN B)	E-271 SH.8
10	*CIRCUIT SEAL-IN CONTACT	E-208 SH.10	CLOSE CONTAINMENT WASTE GAS INLET VALVE SV1101	E-235 SH.1	TRIP AIR ROOM PURGE FAN V-46	E-222 SH.1	CLOSE COMP. CLG. WTR DISCH. FROM CONT. SV0910 (5P-7ONLY)	E-235 SH.4
11	CLOSE RECEIVER TANK VENT VALVE SV1064	E-235 SH.1	CONTROL ROOM HVAC EMERGENCY SYS. ACTIVATION (TRAIN A)	E-271 SH.8	DISABLE AUTO START OF ENG SFGRDS SUMP PUMP P-738 (5R-5 ONLY)	E-285 SH.8	CLOSE COMP. CLG. WTR INLET TO CONT. SV-0910 (5P-7ONLY)	E-235 SH.4
12	SPARE		*SPARE		*SPARE		PPC-SOE NODE PT. ID. K59P.5R.D	E-53 SH.8

CONTACTS	RELAYS 5P-2 & 5R-2	REF. DWG.	RELAYS 5P-4 & 5R-4	REF. DWG.	RELAYS 5P-6 & 5R-6	REF. DWG.	RELAYS 5P-8 & 5R-8	REF. DWG.	RELAY 5P-6 (CON'T)	REF. DWG.
1	CLOSE DEMIN. WATER TO DRENCH TANK SV1065	E-235 SH.2	CLOSE STM. GEN. E-50A TOP BLOWN LINE SV0739	E-235 SH.3	CLOSE CONTAINMENT SUMP DR. VALVE SV1104 (RELAYS 5R-6 ONLY)	E-235 SH.1	CLOSE PURGE EXHAUST FAN OUTLET SV1006	E-221		
2	CLOSE PRI. COOLANT PUMP CONTROLLED BLEED OFF SV2083	E-235 SH.2	*CLOSE MSIV CV-0501 & CV-0510 (5P-4 ONLY)	E-238 SH.1	CLOSE NITROGEN ISOLATION VALVE SV1358	E-235 SH.3	CLOSE PURGE SUPPLY FAN VALVE SV1808	E-221		
3	CLOSE PRI. COOLANT LETDOWN ISOL. VALVE SV2003	E-235 SH.2	CLOSE PRI. SYS. DRAIN TANK VALVE SV1007	E-235 SH.1	CLOSE CONT. HYD. MON. ISL. VLV. SV-2412A & B SV-2414A & B	E-235 SH.2	CLOSE AIR SPACE PURGE FAN VALVE SV1813	E-221		
4	CLOSE STM. GEN. E-50B TOP BLOWN LINE SV0738	E-235 SH.3	CLOSE CLEAN WASTE REC. TANK ISOL. VALVE SV1004	E-235 SH.3	CLOSE CONTAINMENT BLDG. HEAT STM. DISCHARGE SV1502	E-235 SH.1	OPEN CONTAINMENT SPRAY VALVE SV3002 (5P-8 ONLY)	E-237		
5	*CONTAINMENT ISOLATION ALARM K11 #26	E-292 SH.2	*SPARE	E-235 SH.3	CLOSE CONTAINMENT BLDG. HEAT STM. INLET SV1503	E-235 SH.3	*CLOSE COMP. CLG. WTR DISC. CONMT SV-0940 (5P-8 ONLY)	E-235 SH.4A		
6	CLOSE CONT. H ₂ MONT. ISOL. VLV. SV-2413A & B SV-2415A & B	E-235 SH.1	CLOSE CLEAN WASTE REC. TANK ISOL. VALVE SV1037	E-235 SH.3	CLOSE WASTE GAS SURGE TANK INLET SV1102	E-235 SH.1	*START CONTAINMENT SPRAY PUMP P-548 (5P-8 ONLY)	E-251		
7	CLOSE SHIELD COOL SURGE TANK INLET SV0939	E-235 SH.3	CLOSE CLEAN WASTE REC. TANK ISOL. VALVE SV1038	E-235 SH.3	DISABLE AUTO START OF ENG SFGRDS SUMP PUMP P-728 (5R-6 ONLY)	E-285 SH.1	*SIS INITIATION CRT. 2 (RELAYS 5P-8 ONLY)	E-209 SH.1		
8	CLOSE PRI. SYS. DRAIN TANK VALVE SV1001	E-235 SH.3	CONTROL ROOM HVAC EMERGENCY SYS. ACTIVATION (TRAIN B)	E-271 SH.8	CONTROL ROOM HVAC EMERGENCY SYS. ACTIVATION (TRAIN A)	E-271 SH.8	CLOSE COMP. CLG. WTR INLET TO CONT. SV-0910 (5P-8 ONLY)	E-235 SH.4		
9	*SPARE		CLOSE CLEAN WASTE REC. TANK PUMP SUCTION SV1045	E-235 SH.1C	*CRITICAL FUNCTION MON. INPUTS: *I19 (FOR 5P-6), *I22 (FOR 5R-6)	E-208 SH.1A	CLOSE PRI. SYS. SAMPLING ISOLATION VALVE SV1911	E-235 SH.1		
10	*CIRCUIT SEAL-IN CONTACT	E-208 SH.10	*SPARE		TRIP AIR ROOM PURGE FAN V-46	E-222 SH.1	CLOSE STM. GEN. E-50B BOT. BLOWN LINE SV0767	E-235 SH.4		
11	*SPARE		CLOSE RECEIVER TANK VENT VALVE SV1065	E-235 SH.1	SPARE		CLOSE STM. GEN. E-50A BOT. BLOWN LINE SV0767	E-235 SH.4		
12	*SPARE		SPARE		DISABLE AUTO START OF ENG SFGRDS SUMP PUMP P-738 (5R-5 ONLY)	E-285 SH.1	PPC-SOE NODE PT. ID. K59P.5R.D	E-53 SH.8	*CLOSE FW REG BYPASS VALVE CV-0734	E-69 SH.1

NOTES:

- RELAYS WITH 8 OR LESS NC CONTACTS SHALL UTILIZE COIL TB113-3. RELAYS WITH 9 OR MORE NC CONTACTS SHALL UTILIZE COIL TB113-61.

*-NORMALLY OPEN CONTACT

REFERENCE DWGS:

- LOGIC DIAGRAM JLG-121(D) SH. 2
- SCHEMATIC DIAGRAMS E-271 SH. 1
- E-223
- E-224
- E-916
- E-69 SH. 1

SPARE CONTACTS		
RELAY	NORMALLY OPEN	NORMALLY CLOSED
5R-1	---	* 12
5P-3	* 9, 12	---
5R-3	* 2, 7, 9, 12	---
5P-5	* 1, 7, 11, 12	---
5R-5	* 4, 8, 12	---
5R-7	* 4, 6, 7, 10, 11	---
5P-2	* 9, 11, 12	---
5R-2	* 9, 11, 12	---
5P-4	* 5, 10	* 12
5R-4	* 2, 5, 10	* 12
5P-6	* 11	* 1
5R-6	* 11	---
5R-8	* 4, 5, 6, 7, 8	---
5P-1	---	* 12

30	06-13	REVISED TO SEPARATE SCHEMES PER DCR 03-450	DMB	PFB		
29	07-31	SPARED CONTACT NO. 12, RELAYS 5P-1, 5R-1, 5P-5, 5R-5, 5P-4 & 5R-4 & CONTACT NO. 11, RELAYS 5P-6 & 5R-6 PER FC-949 & DCR 95-608	DMB	FCM		
		REV. DATE	DESCRIPTION	BY	CK	APP

Consumers Energy


PALISADES PLANT

E288-2.DGN


SCHEMATIC DIAGRAM
CONTAINMENT ISOLATION ON
HIGH PRESSURE OR HIGH RADIATION

DRAWING NUMBER	SHL. NO.	REV.
E-208	2	30

**SCHEMATIC DIAGRAM
SIRW TANK AND CONTAINMENT SUMP VALVES**

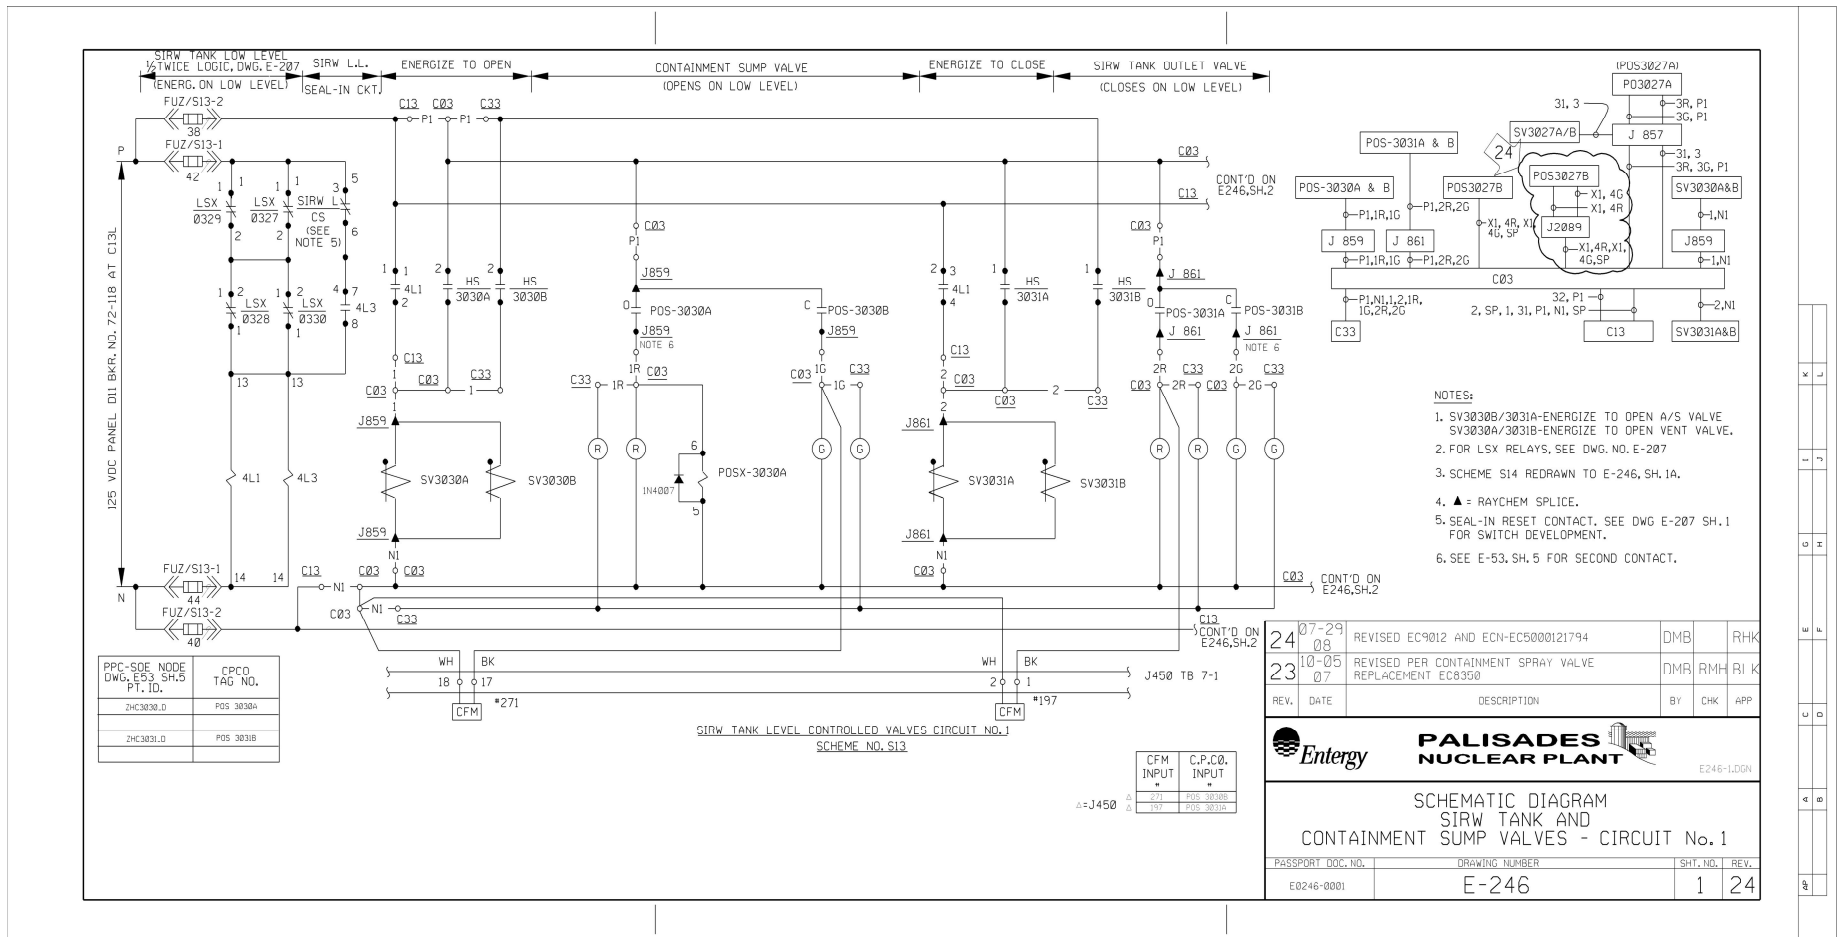

**SCHEMATIC DIAGRAM
SIRW TANK AND CONTAINMENT SUMP VALVES**

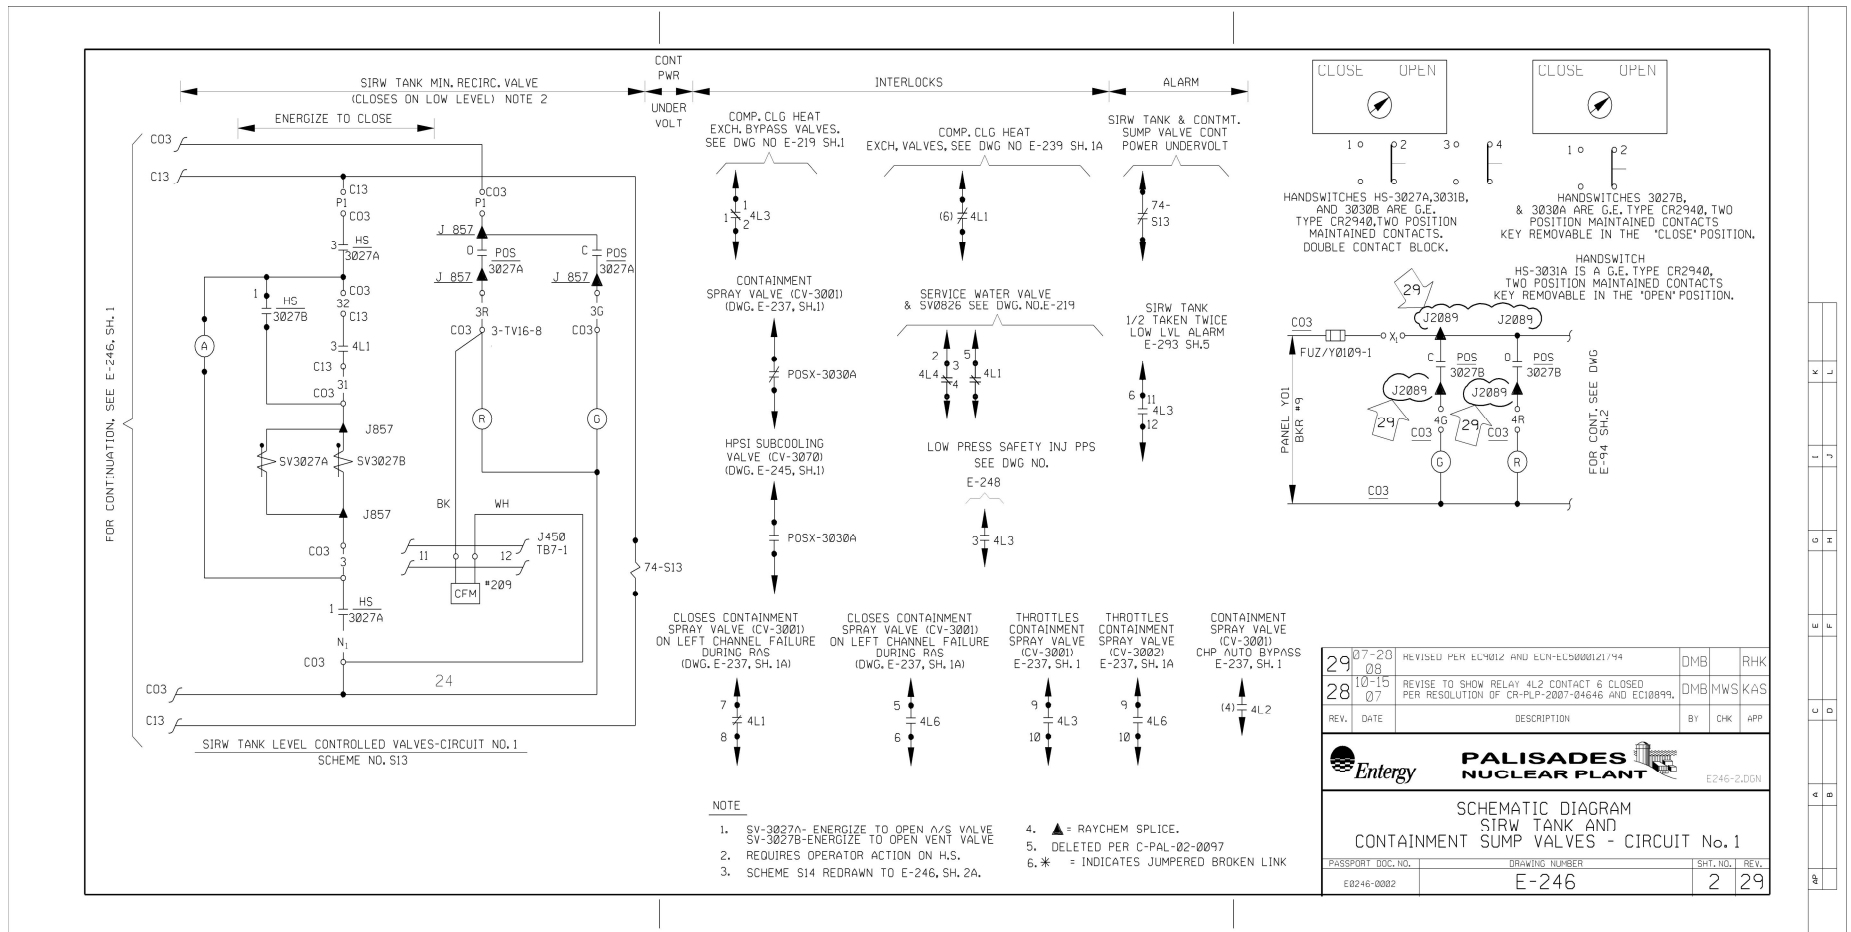

LOGIC DIAGRAM
LEGEND AND NOTES

FUNCTION	SYMBOL	MEANING	FUNCTION	SYMBOL	MEANING
AND		OUTPUT EXISTS WHEN ALL INPUTS EXIST.	CALIBRATION		CALIBRATING SET POINT INPUT TO PROVIDE A CALIBRATED SIGNAL.
OR		OUTPUT EXISTS WHEN ANY INPUT EXISTS.	LOW BISTABLE		DIGITAL OUTPUT EXISTS ONLY WHEN ANALOG INPUT IS LOWER THAN SET POINT.
COINCIDENCE MATRIX		OUTPUT EXISTS WHEN AT LEAST A OUT OF B INPUTS ARE PRESENT.	HIGH BISTABLE		DIGITAL OUTPUT EXISTS ONLY WHEN ANALOG INPUT IS HIGHER THAN SET POINT.
MEMORY		OUTPUT EXISTS WHEN MEMORY INPUT IS APPLIED AND IS RETAINED UNTIL RESET INPUT IS APPLIED. M AND R DENOTE MEMORY AND RESET RESPECTIVELY.	TEST DEVICE		TEST SIGNAL CAN BE INSERTED AUTOMATICALLY IN PLACE OF NORMAL SIGNAL.
NOT		OUTPUT EXISTS WHEN INPUT DOES NOT EXIST.	ISOLATION		OUTPUT IS ELECTRICALLY ISOLATED FROM INPUT.
ON TIME DELAY		OUTPUT EXISTS FOLLOWING A TIME DELAY AFTER THE INPUT IS CONTINUOUSLY APPLIED. OUTPUT CEASES WHEN THE INPUT IS NOT PRESENT.	STATUS ARRAY INDICATING LIGHT		INDICATES EQUIPMENT STATUS
OFF TIME DELAY		OUTPUT EXISTS WHEN THE INPUT IS PRESENT AND CONTINUES TO EXIST FOR A TIME AFTER THE INPUT CEASES.			

SALES & SERVICE B. NOVAK
 BECHTEL
 ANN ARBOR, MICHIGAN
 FALSADES PLANT
 CONSUMERS POWER COMPANY
 LOGIC DIAGRAM
 LEGEND AND NOTES
 JOB NO. 12447
 DRAWING NO. JLG-102 SH. 1 of 3
 REV. 2

DATE	BY	CHKD	APP'D	REV	DESCRIPTION
11/10/71	WJ	WJ	WJ	1	REVISED AS INDICATED
				2	REVISED AS INDICATED


LOGIC DIAGRAM
LEGEND AND NOTES

NOTES:

1. THESE LOGIC DIAGRAMS DESCRIBE EQUIPMENT/SYSTEM FUNCTIONS AND DO NOT NECESSARILY REFLECT THE ACTUAL HARDWARE IMPLEMENTATION.
2. THE STATE OF EQUIPMENT WILL NOT BE CHANGED BY A TRANSIENT OR LOSS OF POWER UNLESS OTHERWISE NOTED.
3. INHERENT EQUIPMENT INTERLOCKS, SUCH AS CIRCUIT BREAKER TRIP FREE AND REVERSING STARTER CROSS INTERLOCKS ARE NOT SHOWN UNLESS THE INTERLOCKS PERFORM A LOGICAL FUNCTION.
4. ANY SET POINTS SHOWN ON CONTROL LOGIC DIAGRAMS ARE APPROXIMATE. FOR EXACT VALUE REFER TO INSTRUMENT INDEX.
5. VALVE AND DAMPER RED AND GREEN LIGHTS ARE BOTH ON WHEN IN AN INTERMEDIATE POSITION.
6. REFER TO ELECTRICAL SCHEMATICS FOR DETAILS OF ELECTRICAL EQUIPMENT OVERCURRENT, SHORT CIRCUIT, AND DIFFERENTIAL PROTECTION.
7. EQUIPMENT WILL CHANGE STATE WHEN A CHANGE IS INITIATED AND WILL REMAIN IN THAT STATE UNTIL A CHANGE TO ANOTHER STATE IS INITIATED.


ABBREVIATIONS:

- CR - CONTROL ROOM
- LCP - LOCAL CONTROL PANEL
- CS - CONTROL SWITCH
- HS - HAND SWITCH
- PB - PUSH BUTTON
- CHP - CONTAINMENT HIGH PRESSURE
- SR TO N - SPRING RETURN TO NORMAL
- CHR - CONTAINMENT HIGH RADIATION
- AFAS - AUXILIARY FEEDWATER ACTUATION SYSTEM
- FOGG A - FEED ONLY GOOD STEAM GENERATOR A
- ISOLATE STEAM GENERATOR B
- FOGG B - FEED ONLY GOOD STEAM GENERATOR B
- ISOLATE STEAM GENERATOR A
- SIS - SAFETY INJECTION SIGNAL
- HVAC - HEATING, VENTILATION & AIR CONDITIONING
- SS - SELECTOR SWITCH
- POS - POSITION SWITCH
- SV - SOLENOID VALVE
- CV - CONTROL VALVE
- MO - MOTOR OPERATED
- PO - PNEUMATICALLY OPERATED
- SP - SET POINT


DATE	BY	REVISION	DESCRIPTION
12/14/77	B. NEVILL	1	ISSUED FOR USE
		2	REVISED AS INDICATED
		3	REVISED FOR RECORD
			
ANN ARBOR, MICHIGAN PALISADES PLANT CONSUMERS POWER COMPANY			
LOGIC DIAGRAM LEGEND AND NOTES			
JOB No.	DATE	SHEET	
12447	JLG-102 SH.3 of 3	2	

DATE	BY	REVISION	DESCRIPTION
12/14/77	B. NEVILL	1	ISSUED FOR USE
		2	REVISED AS INDICATED
		3	REVISED FOR RECORD


**SCHEMATIC DIAGRAM
STEAM GENERATOR LEVEL INSTRUMENTATION**

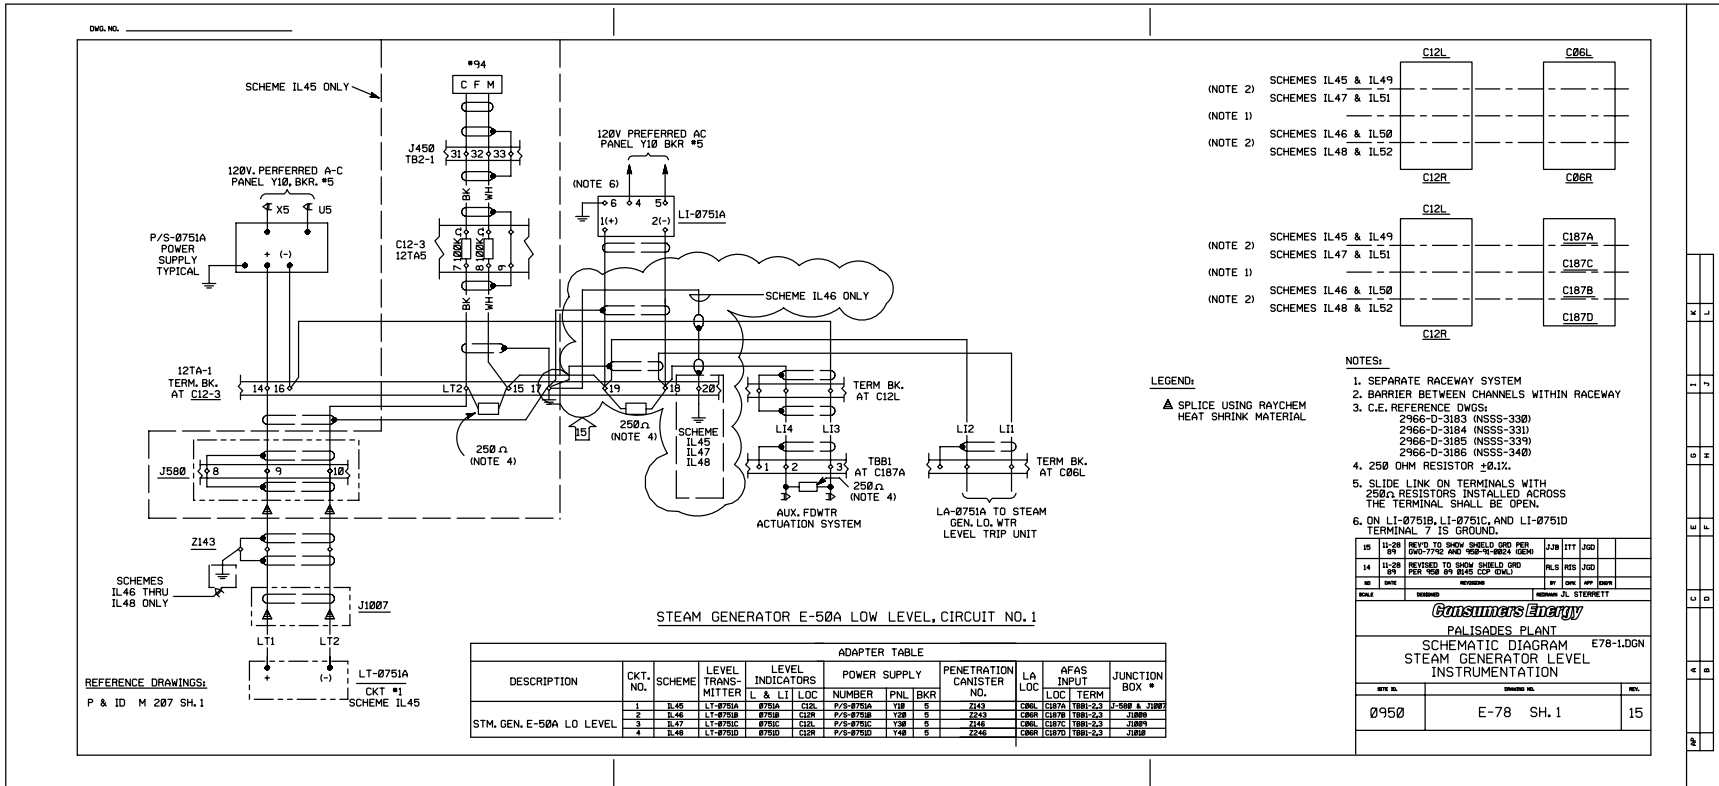


LOGIC DIAGRAM
AUXILIARY FEEDWATER ACTUATION SYSTEM

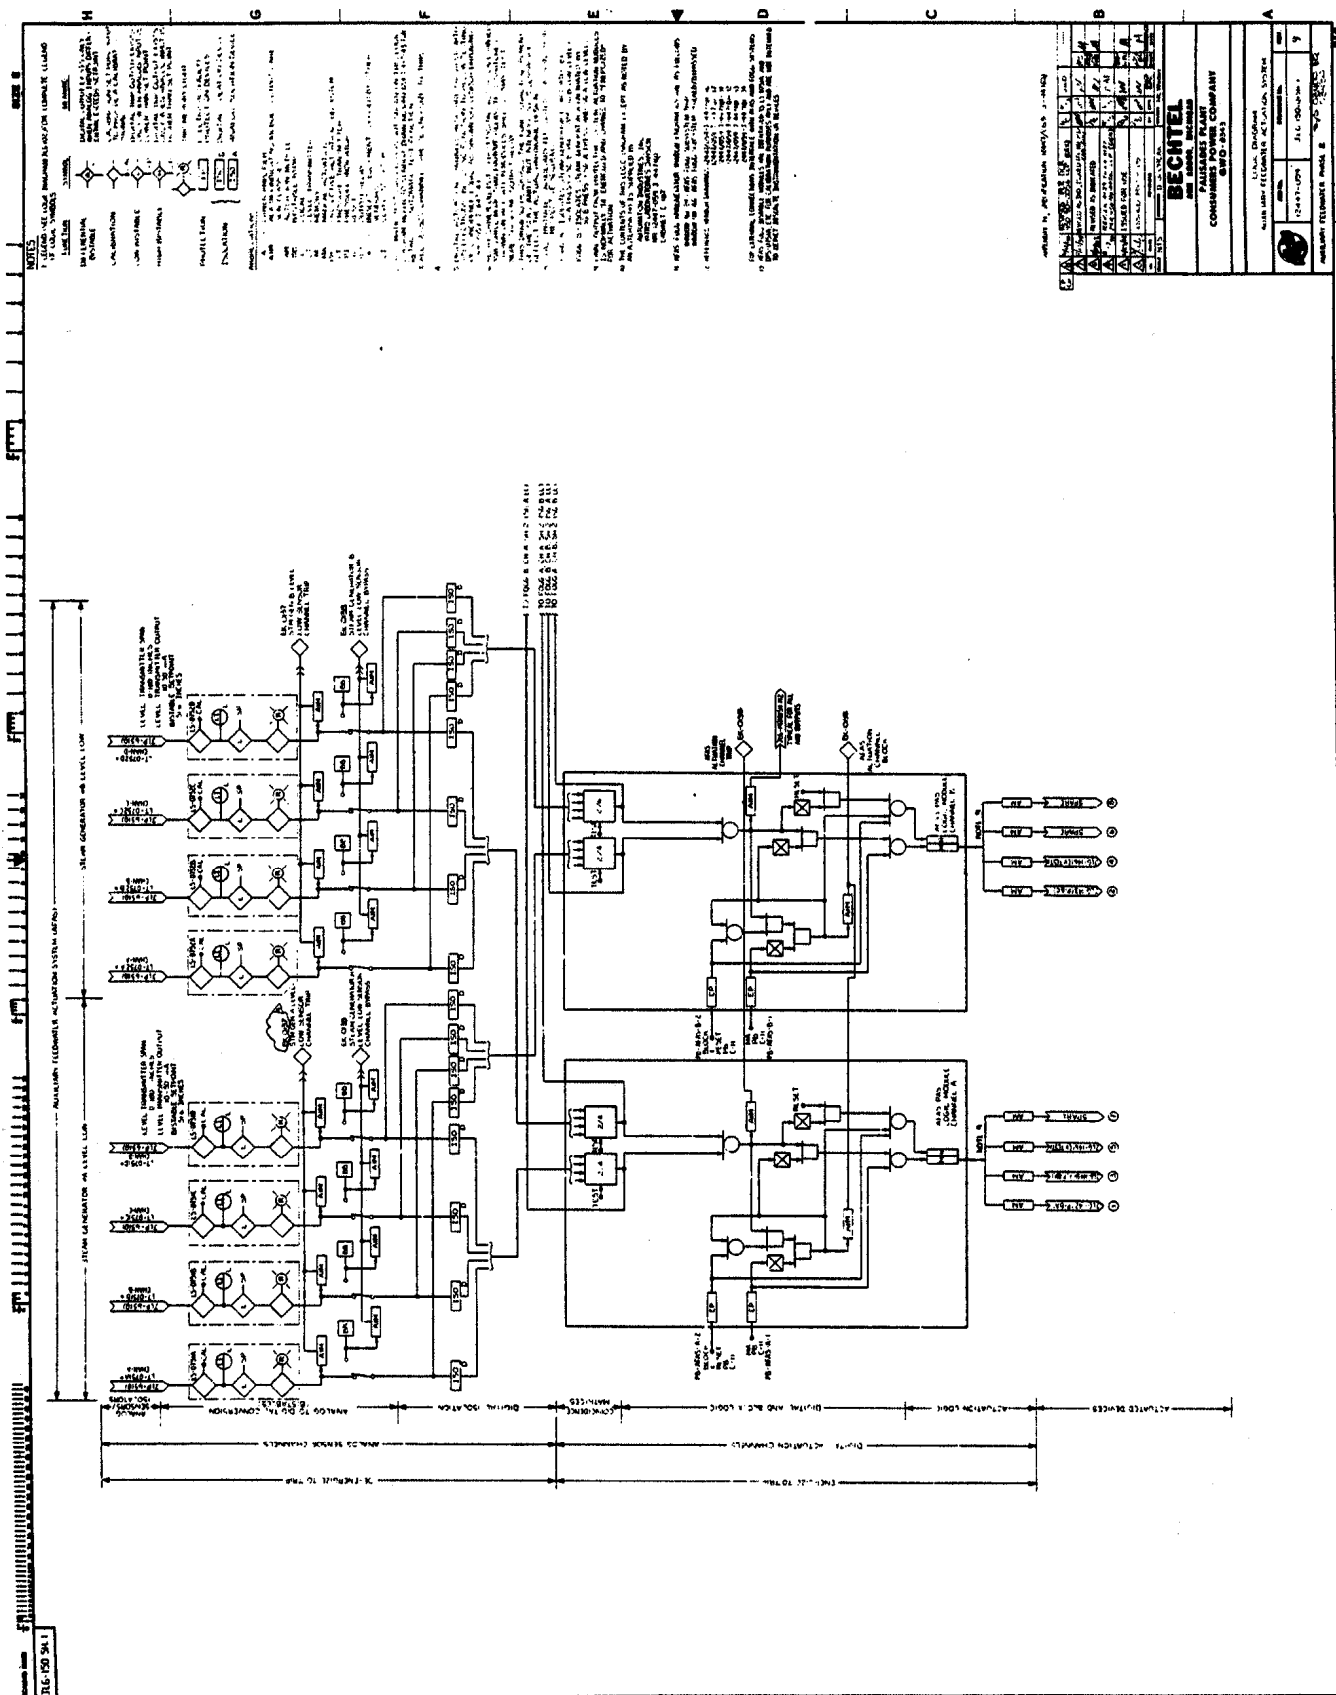


**LOGIC DIAGRAM
TURBINE DRIVEN AUXILIARY FEEDWATER PUMP P-8B**

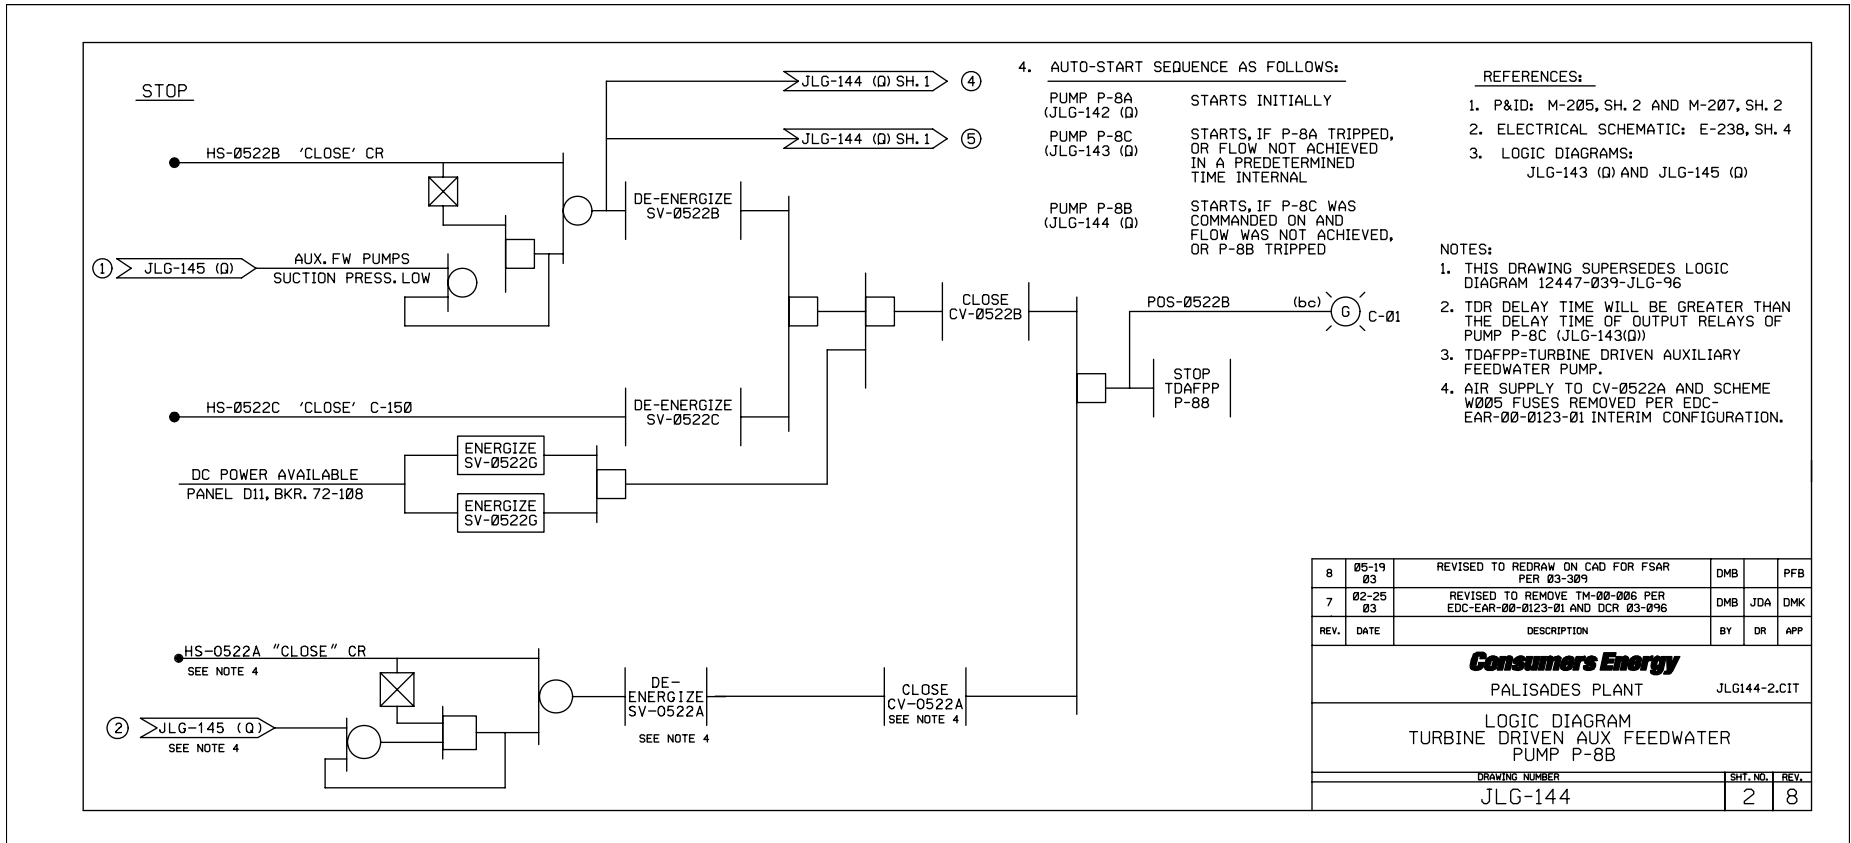


LOGIC DIAGRAM
TURBINE DRIVEN AUXILIARY FEEDWATER PUMP P-8B

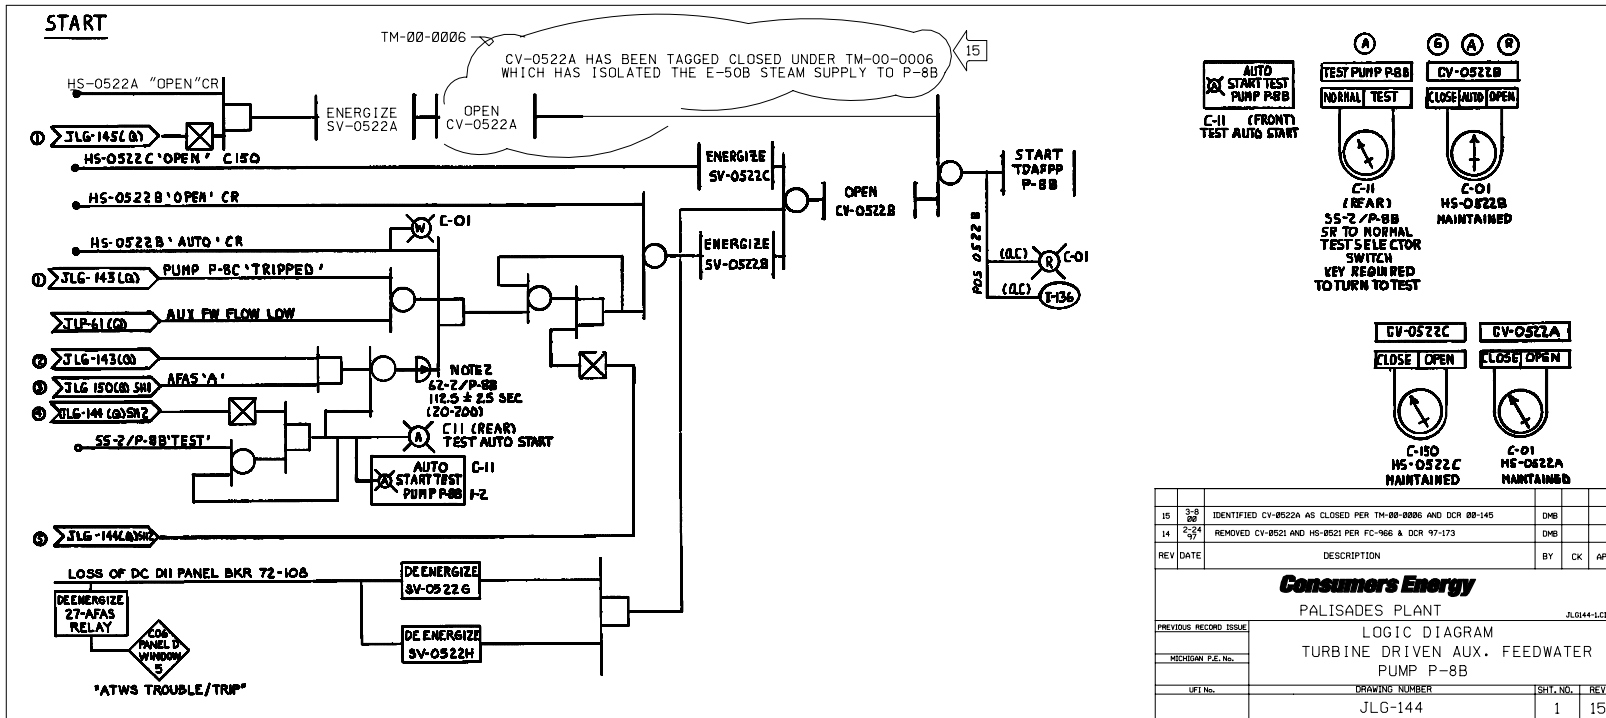


LOGIC DIAGRAM
TURBINE DRIVEN AUXILIARY FEEDWATER PUMP P-8B

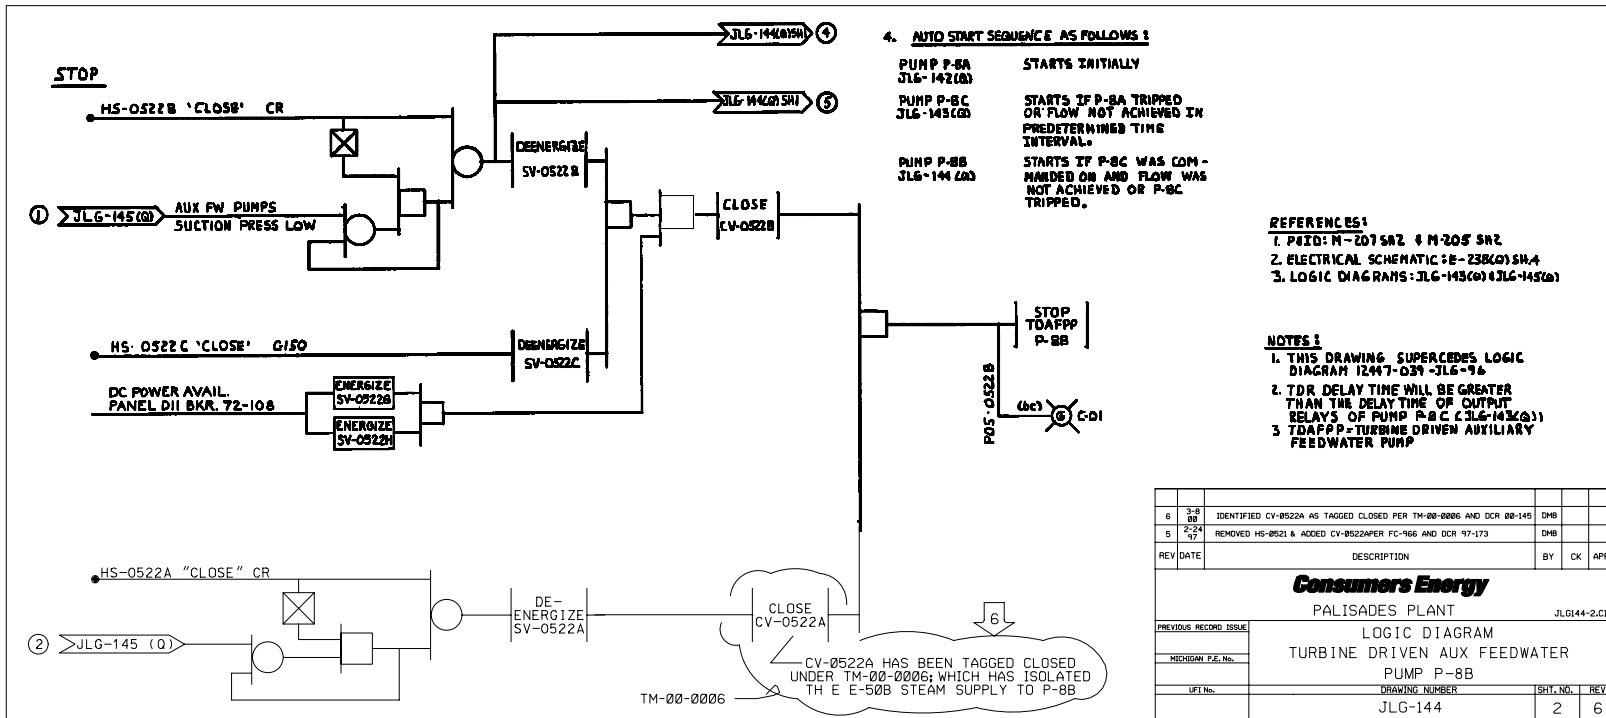


LOGIC DIAGRAM
AUXILIARY FEEDWATER PUMPS LOW SUCTION PRESSURE TRIP

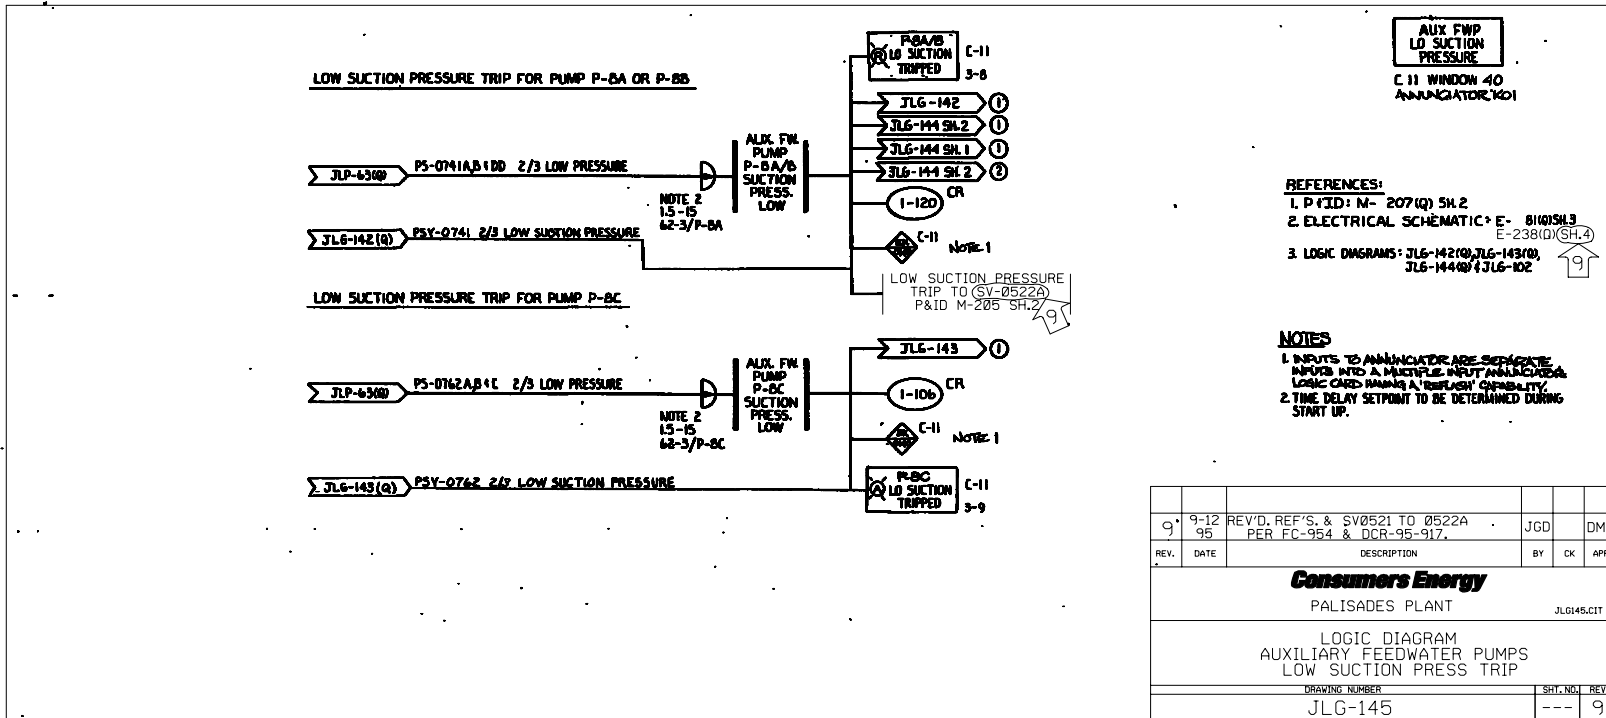


**INTERFACE LOOP DIAGRAM
FLOW CONTROL**

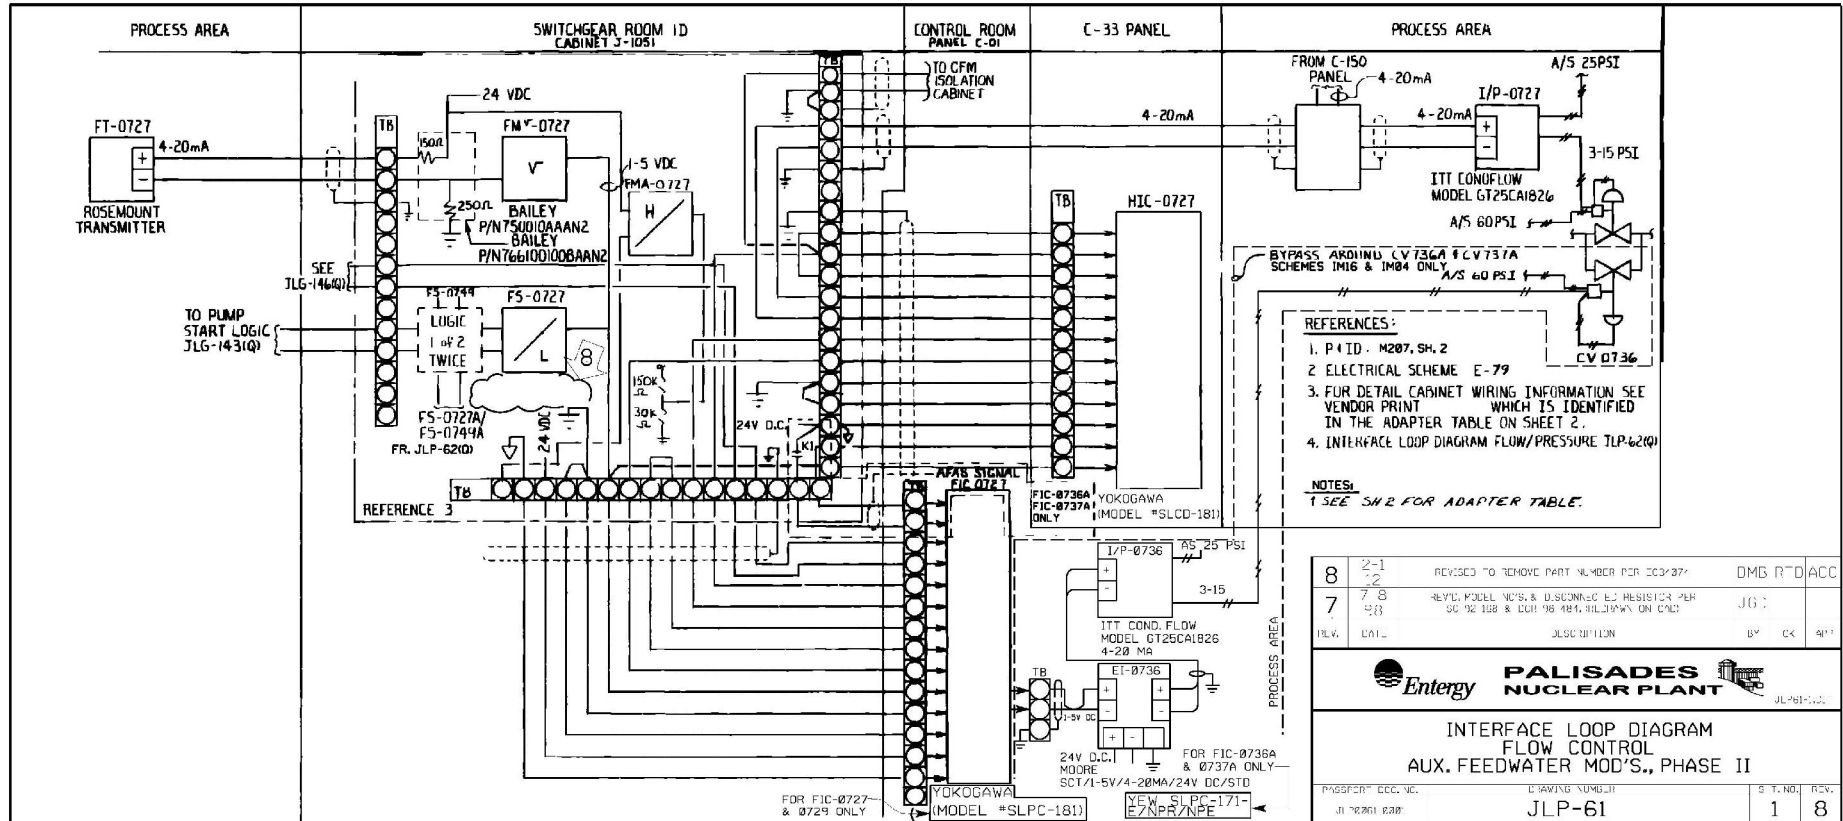

INTERFACE LOOP DIAGRAM
FLOW CONTROL

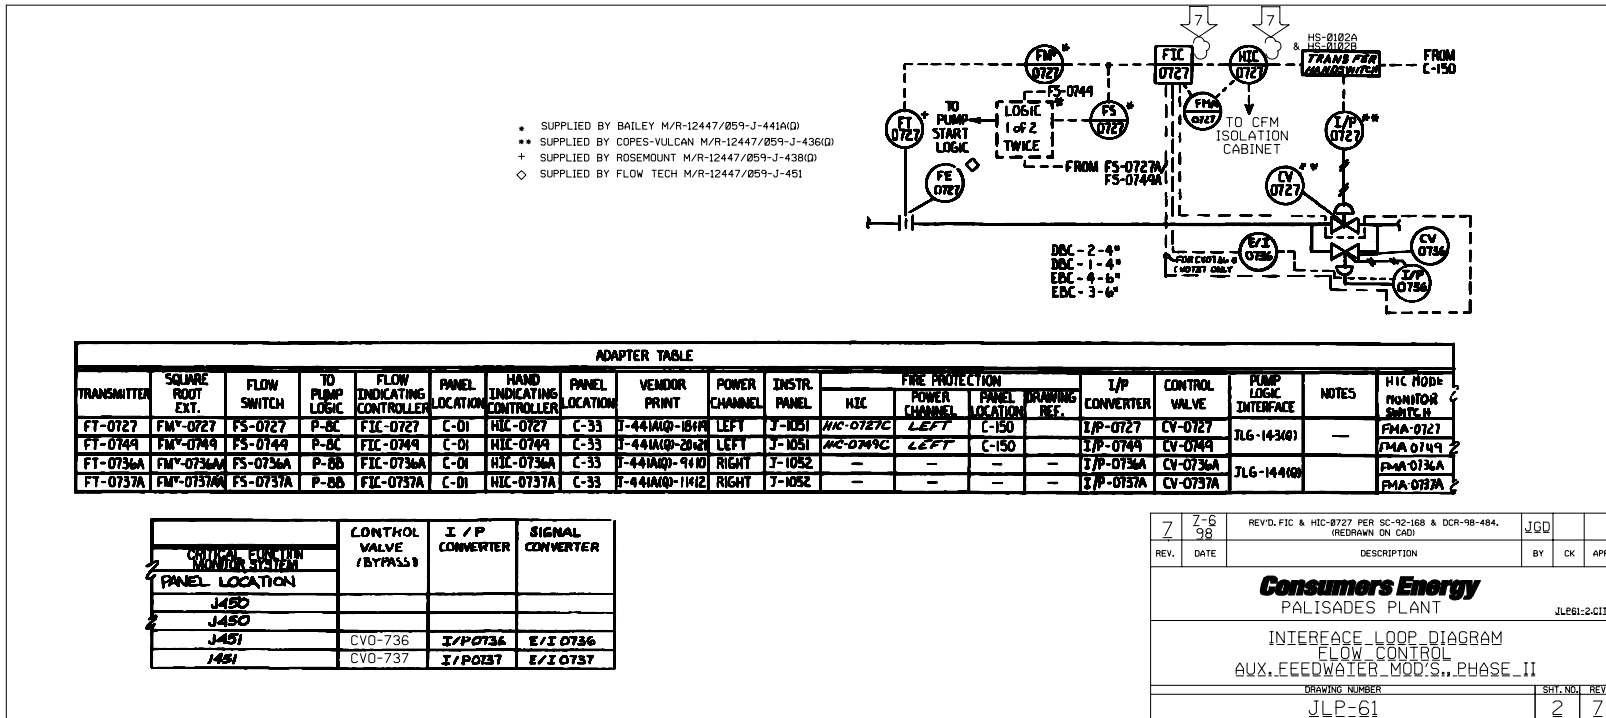

**INTERFACE DIAGRAM
FLOW AND PRESSURE INDICATION**

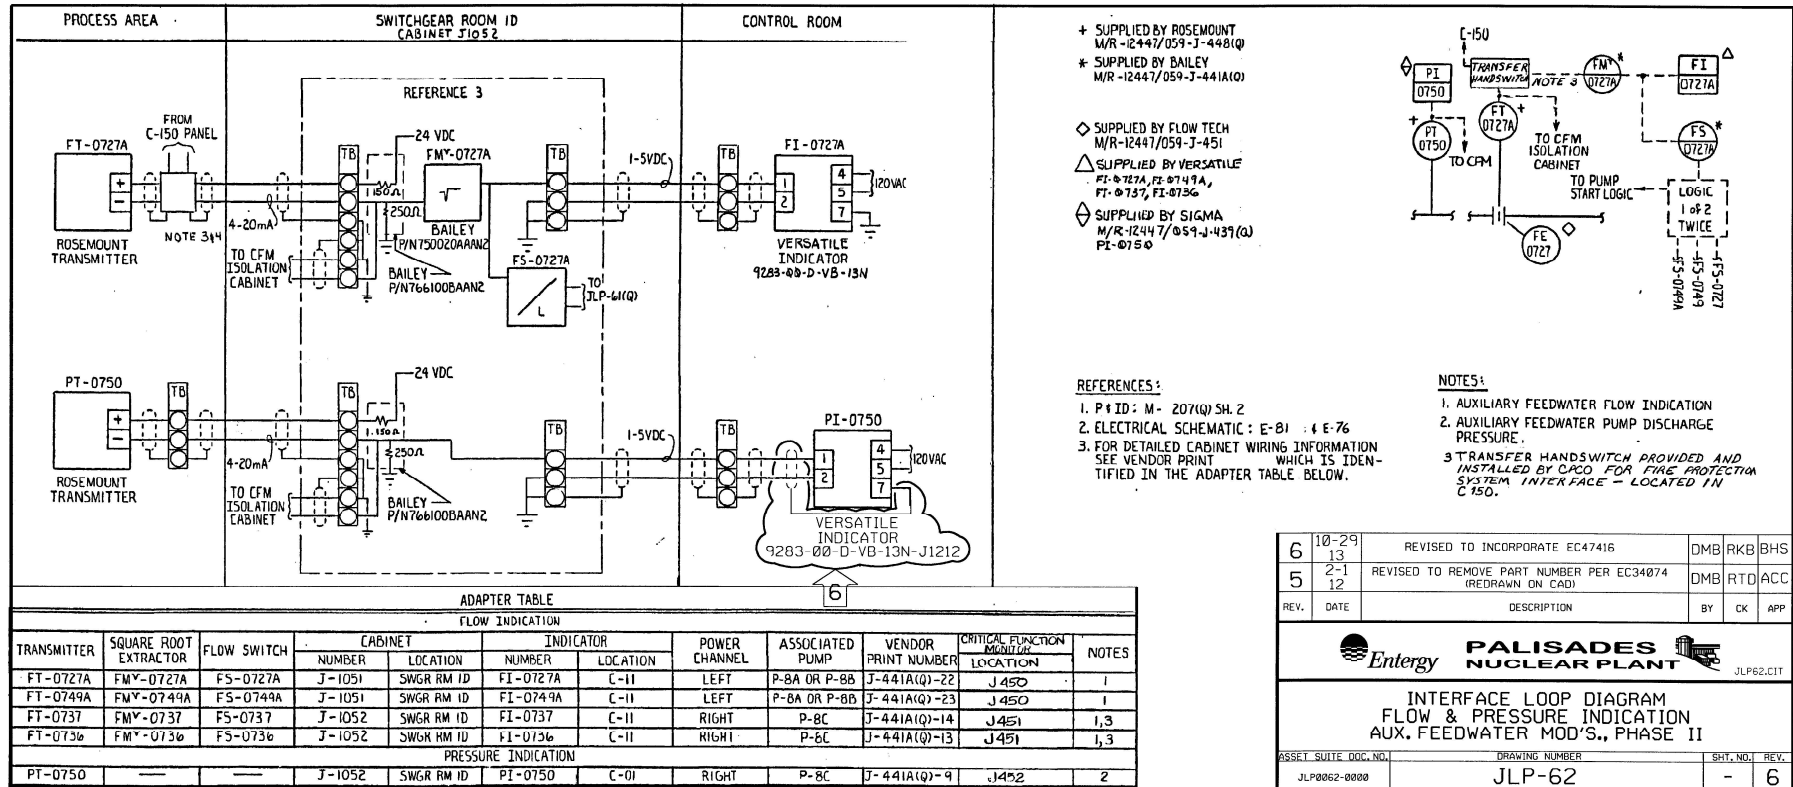


6	10-29	REVISED TO INCORPORATE EC47416	DMB	RKB	BHS
5	2-1	REVISED TO REMOVE PART NUMBER PER EC34074 (REDRAWN ON CAD)	DMB	RTD	ACC
REV.	DATE	DESCRIPTION	BY	CK	APP

Entergy PALISADES NUCLEAR PLANT


INTERFACE LOOP DIAGRAM
FLOW & PRESSURE INDICATION
AUX. FEEDWATER MOD'S., PHASE II

ASSET SUITE DOC. NO.	DRAWING NUMBER	SHT. NO.	REV.
JLP0062-0000	JLP-62	-	6


LOGIC DIAGRAM
AUX FEEDWATER FLOW CONTROL AND PUMP TEST LOGIC

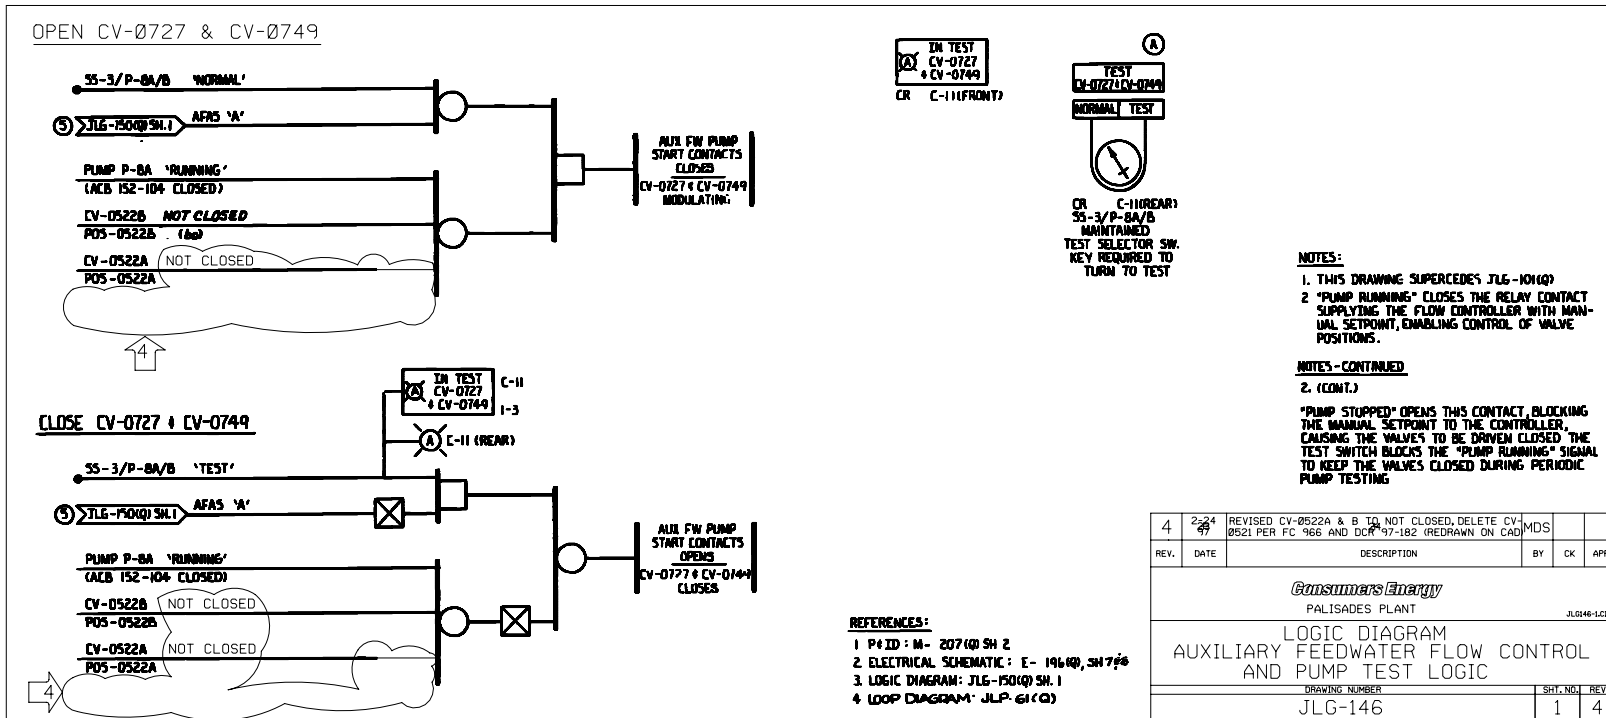


LOGIC DIAGRAM
AUXILIARY FEEDWATER FLOW CONTROL AND PUMP TEST LOGIC

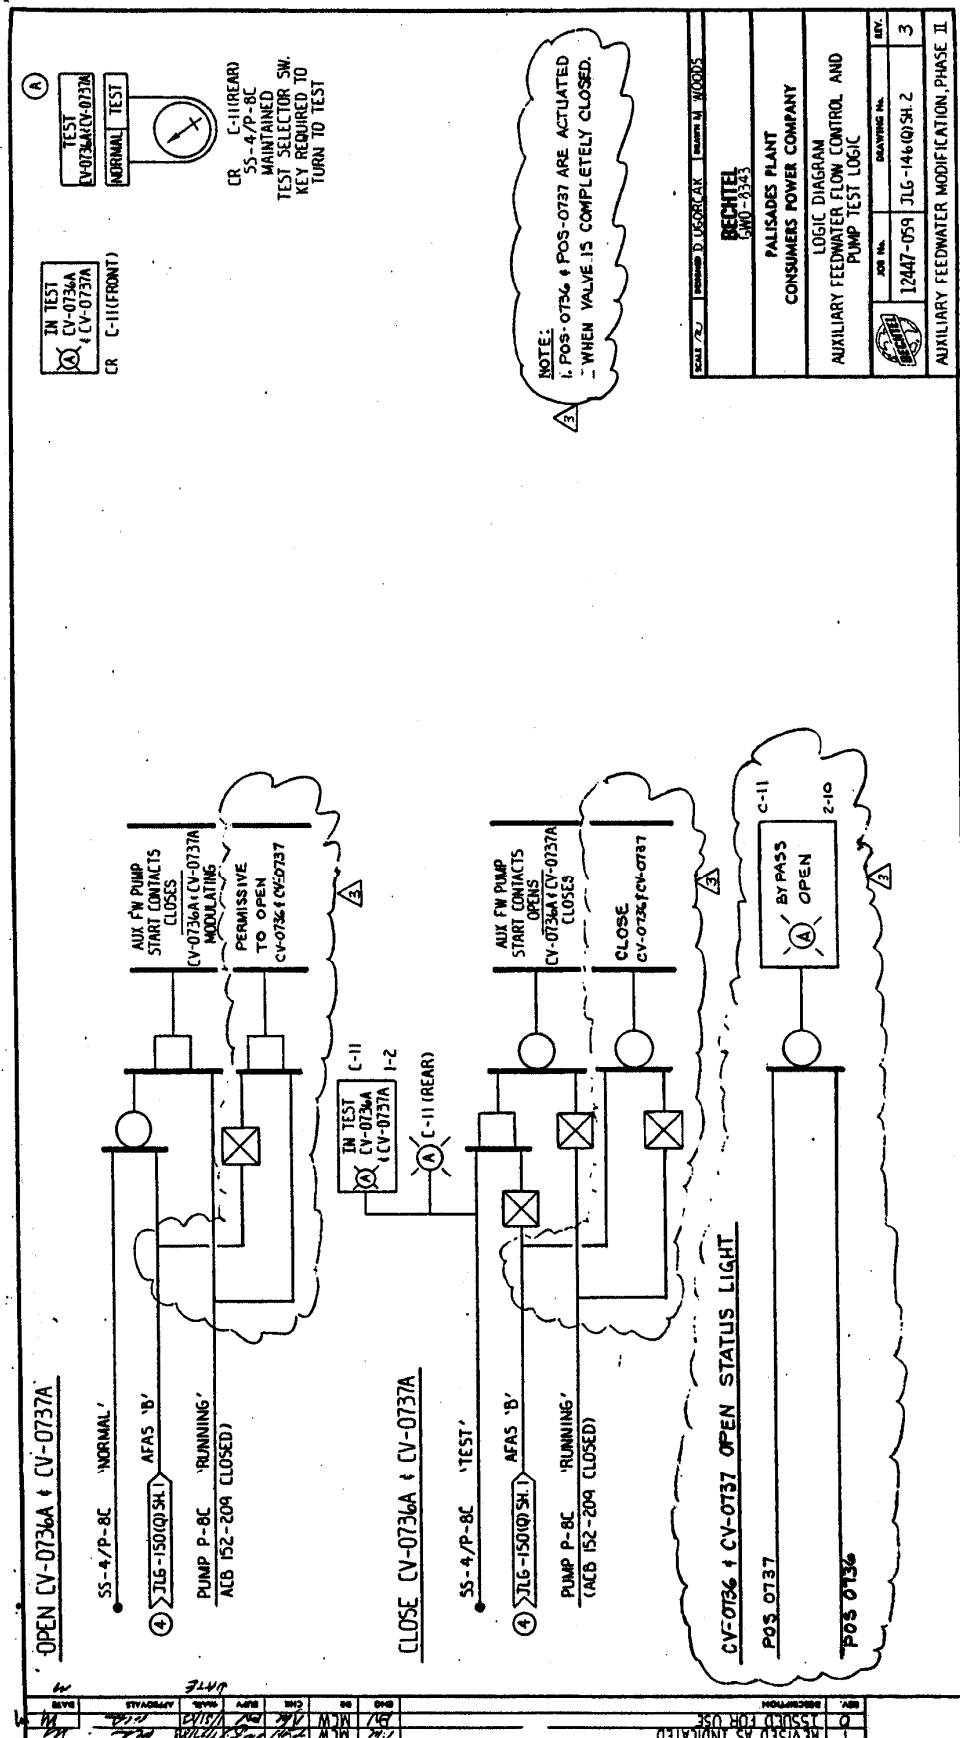


LOGIC DIAGRAM
AUXILIARY FEEDWATER – STEAM GENERATOR ISOLATION VALVES

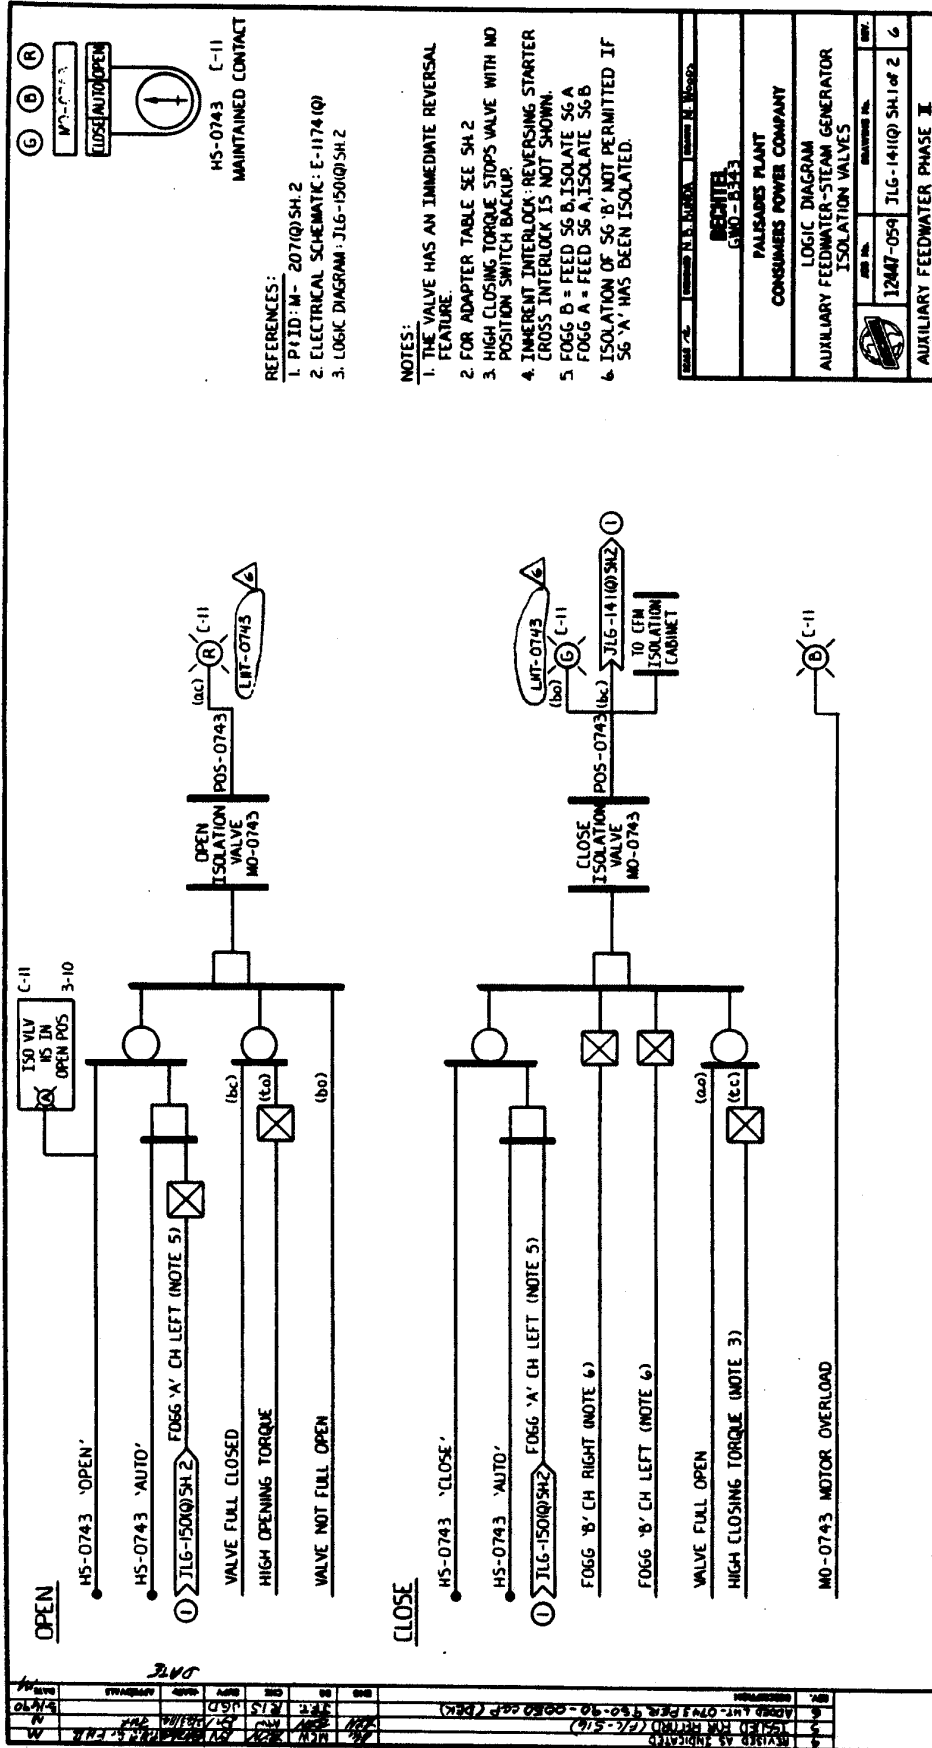


LOGIC DIAGRAM
AUXILIARY FEEDWATER – STEAM GENERATOR ISOLATION VALVES

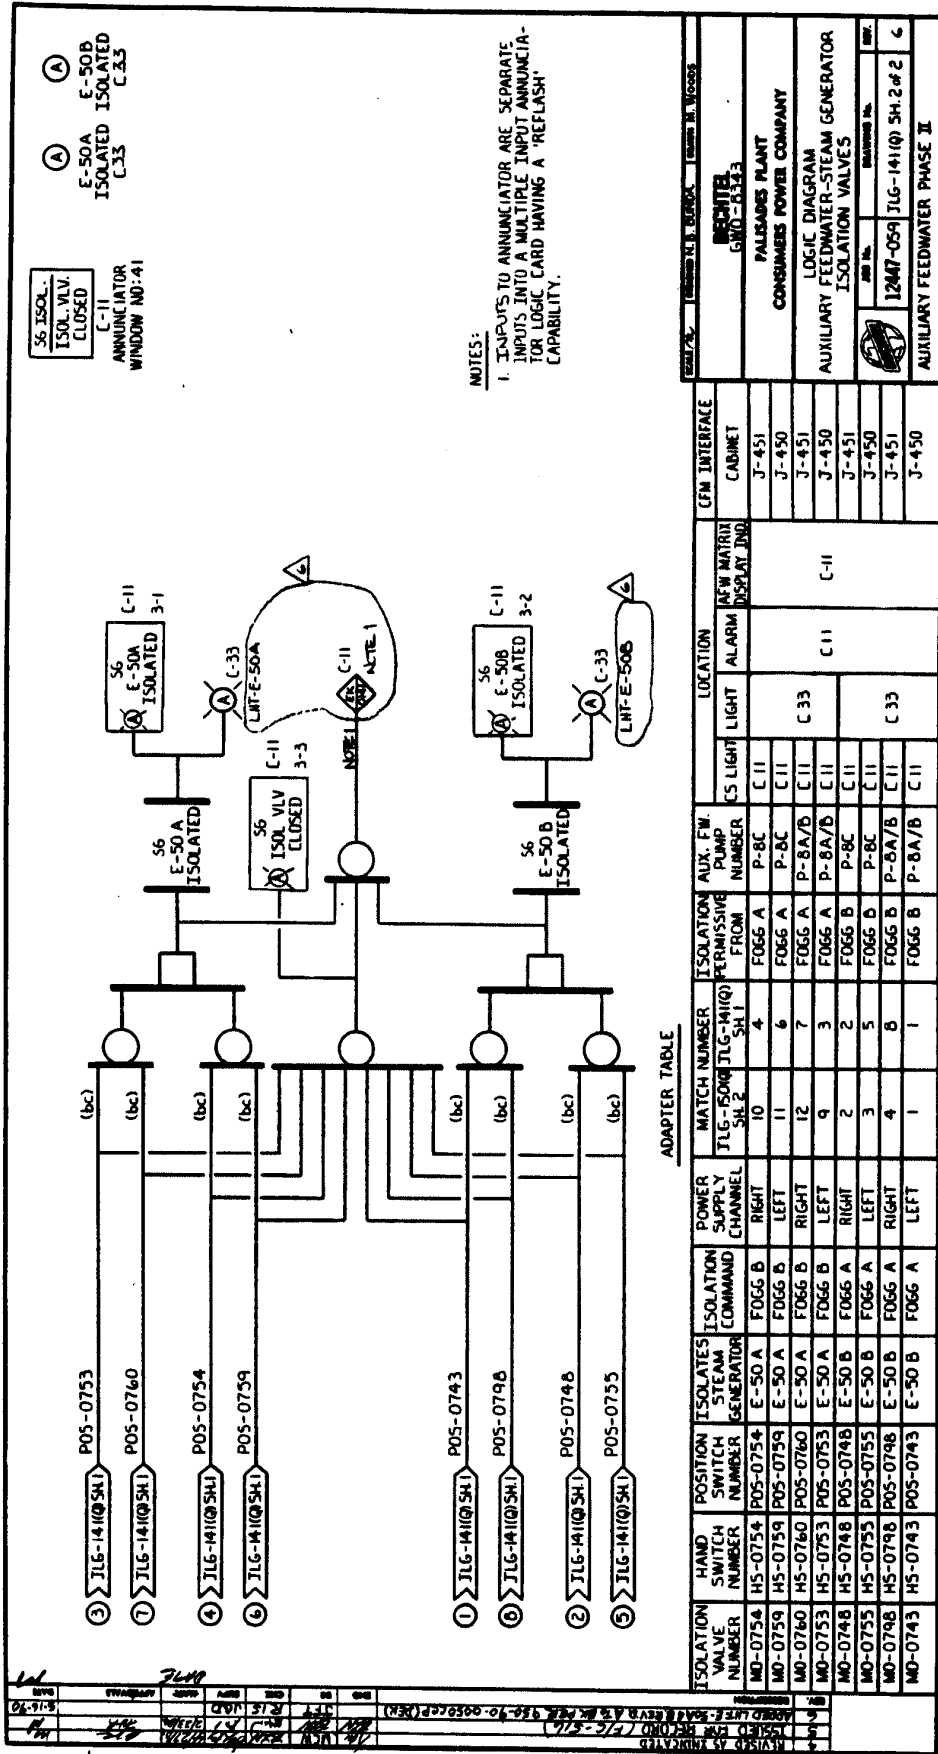


LOGIC DIAGRAM
AFAS-FOGG REMOTE DISPLAY AND ANNUNCIATOR ASSIGNMENT

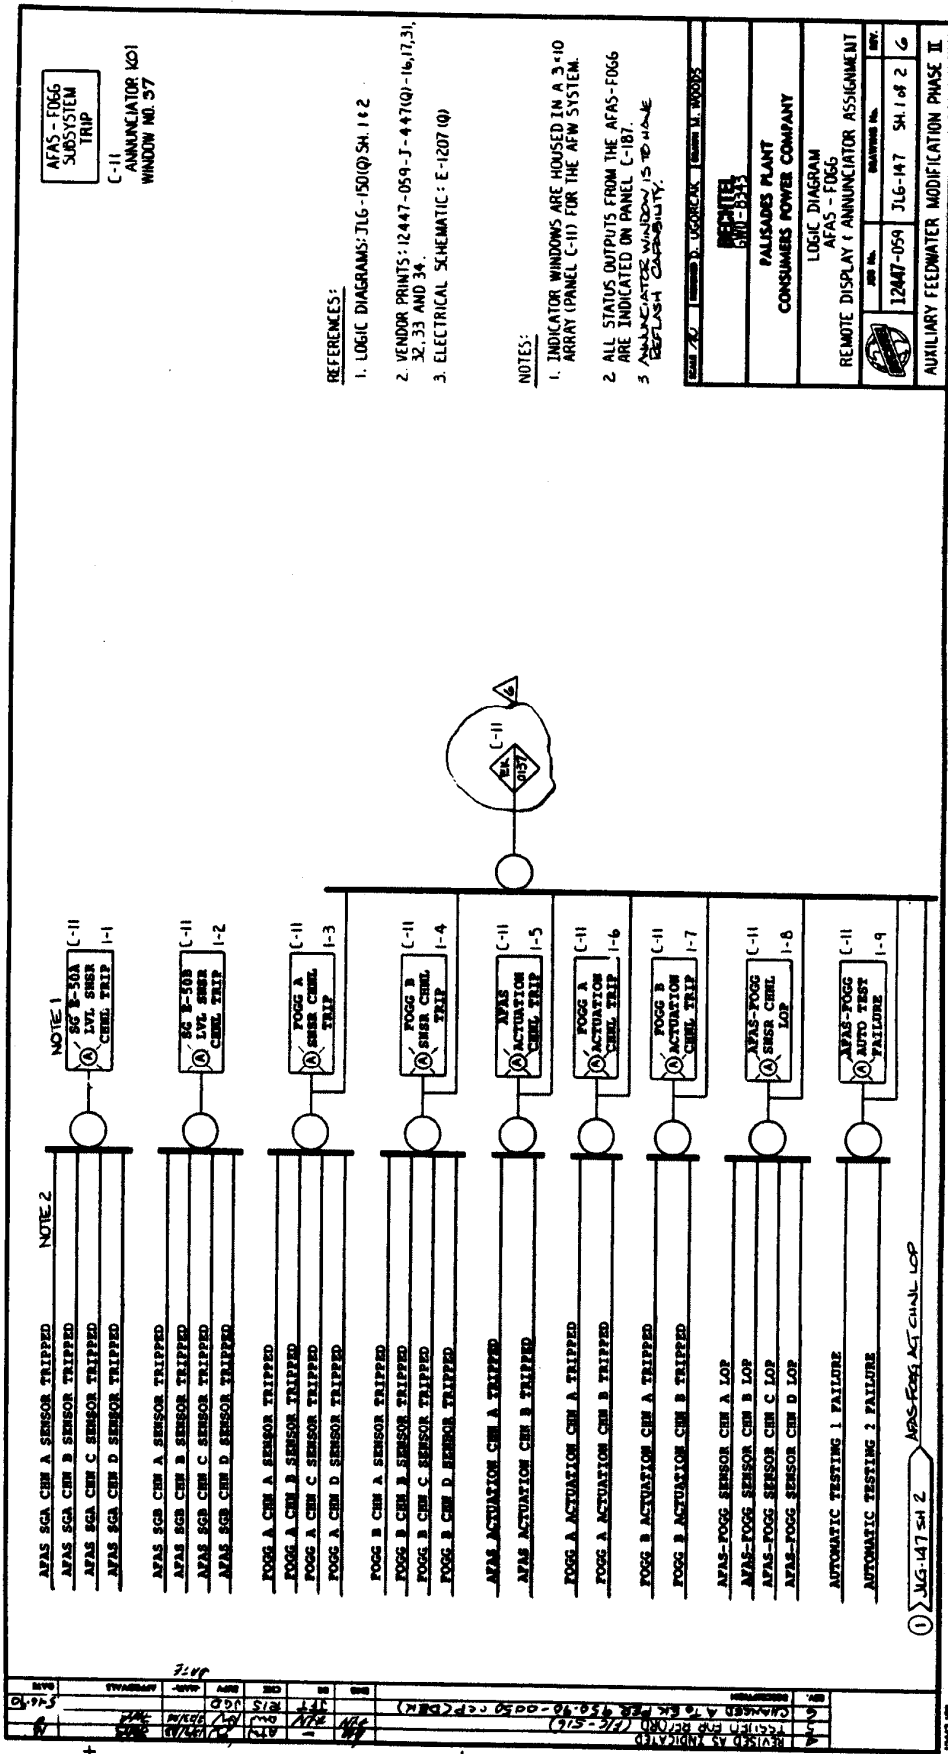


LOGIC DIAGRAM
AFAS-FOGG REMOTE DISPLAY AND ANNUNCIATOR ASSIGNMENT

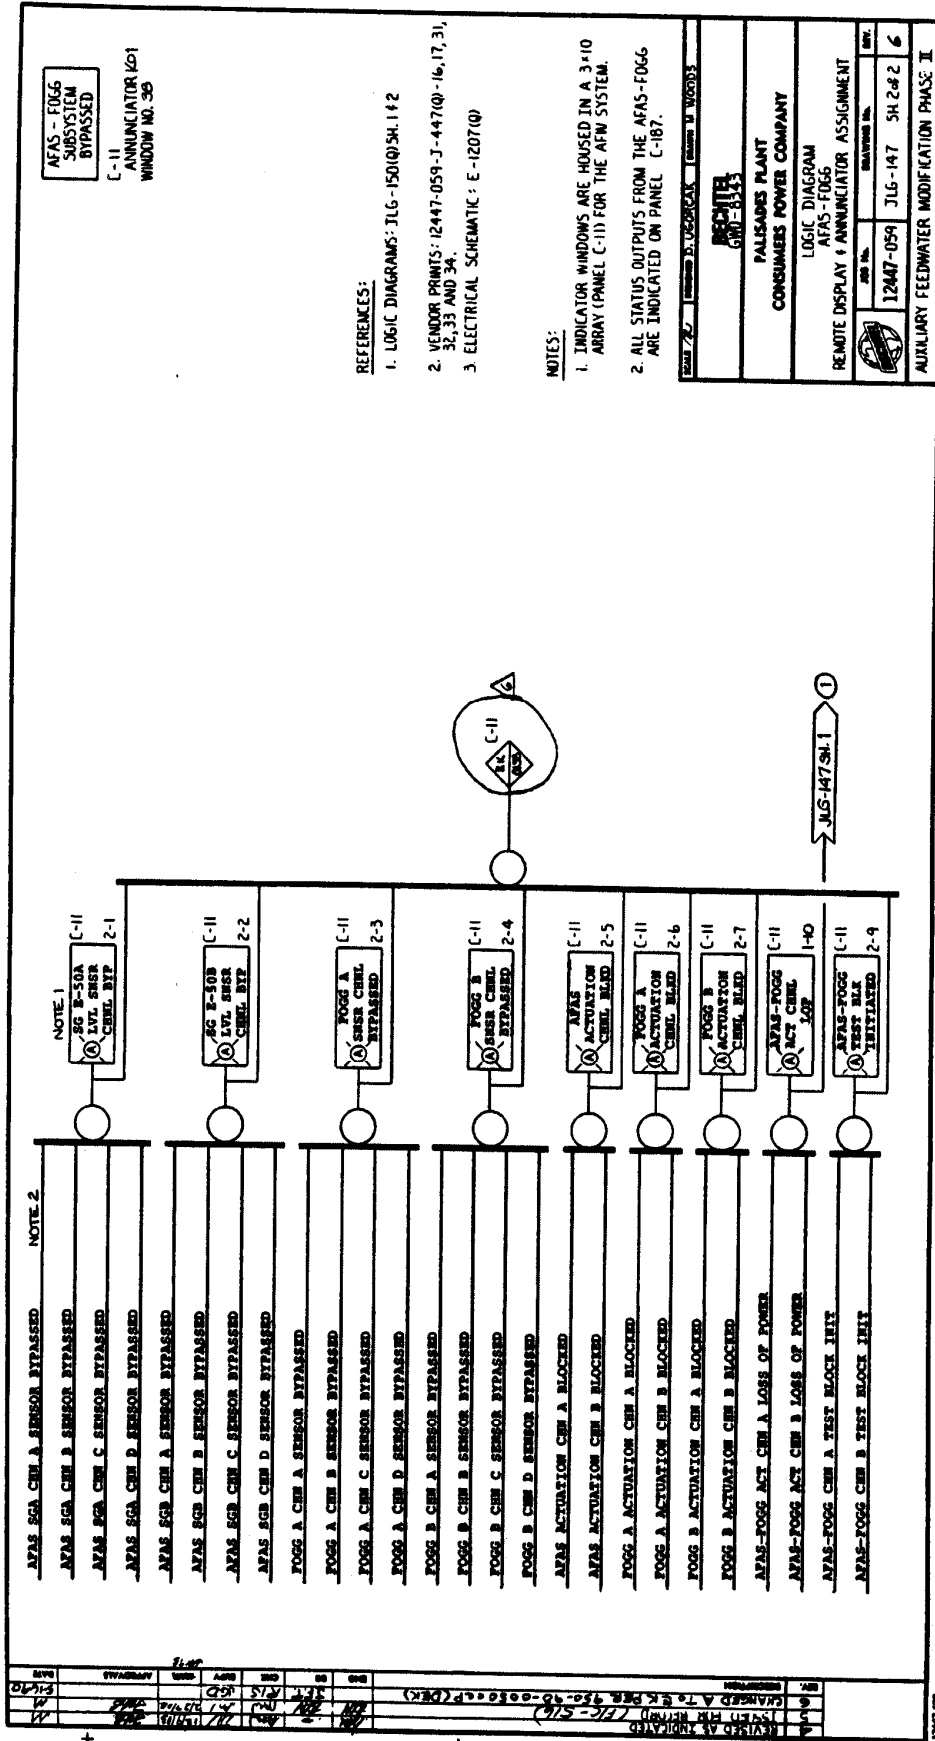


REACTOR SHUTDOWN CONTROLS

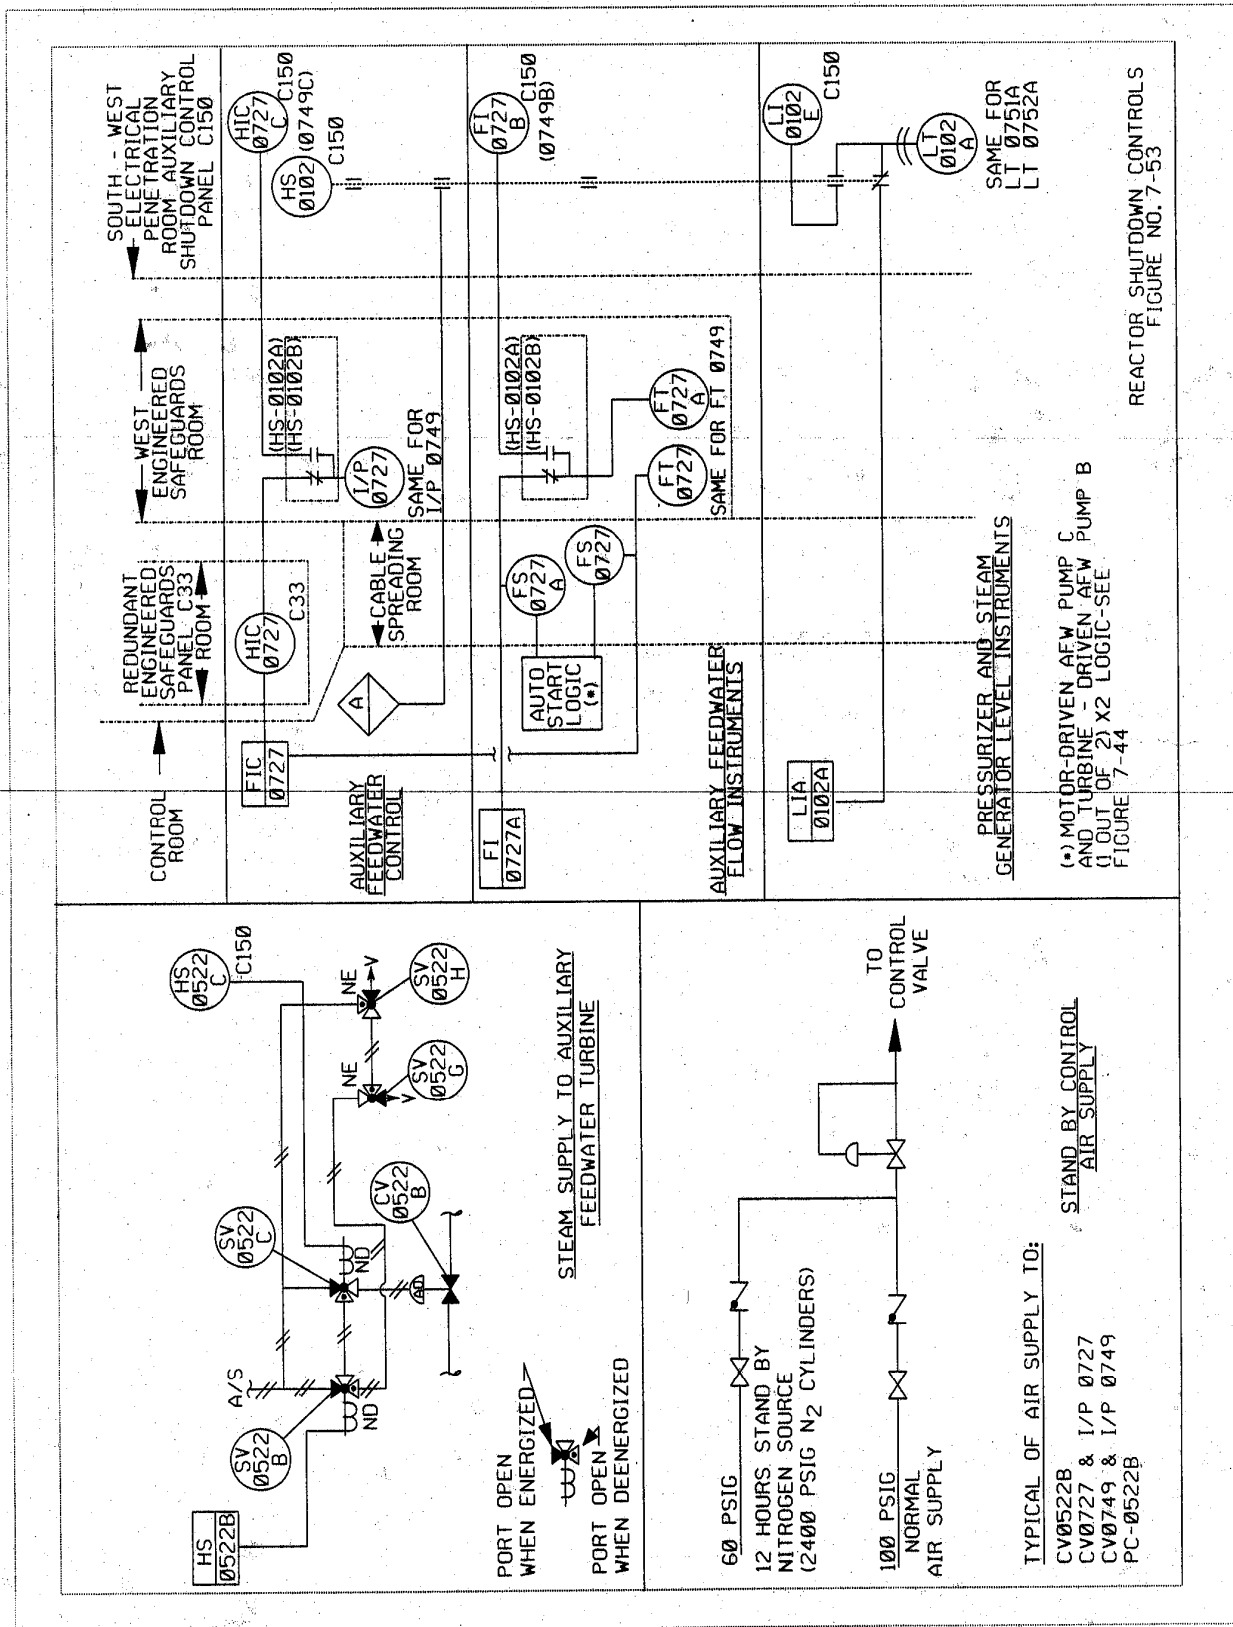


REACTOR REGULATING SYSTEM BLOCK DIAGRAM

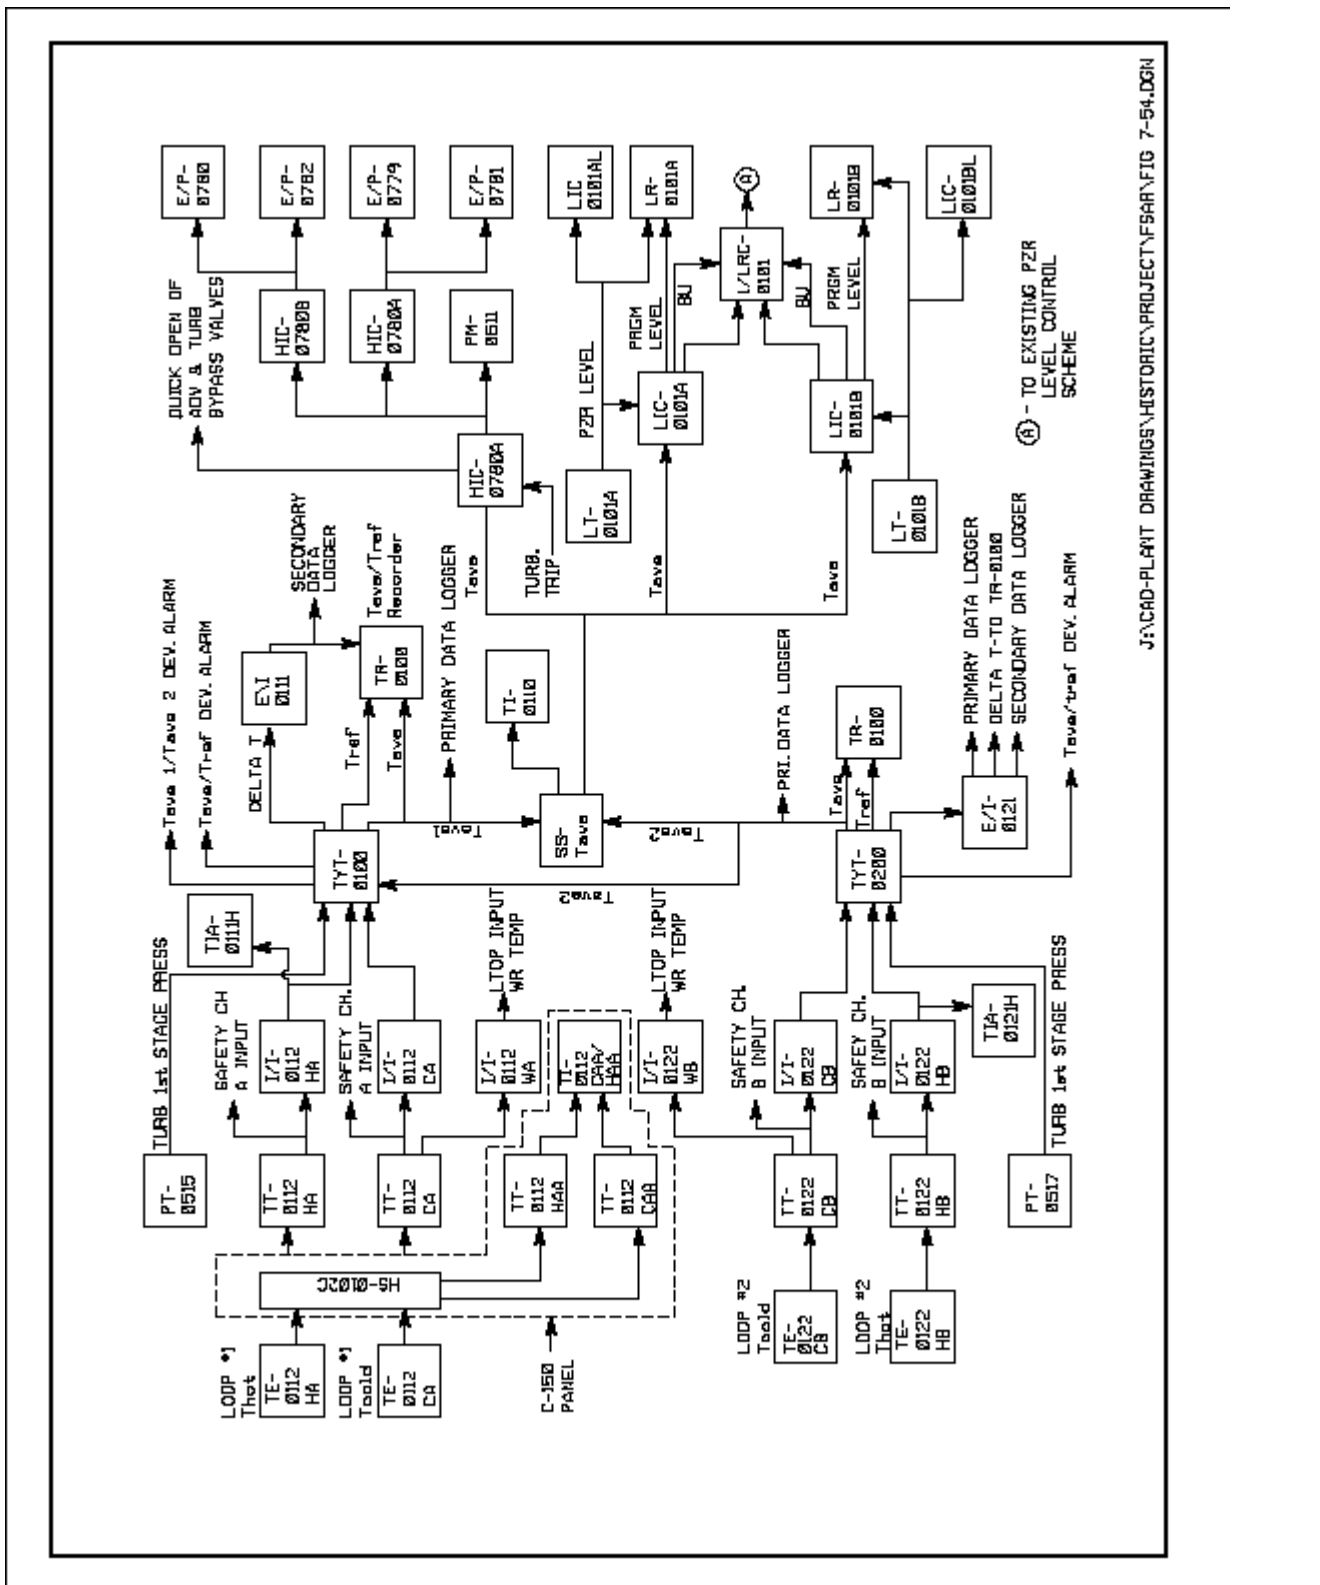

ROD DRIVE CONTROL SYSTEM SCHEMATIC DIAGRAM

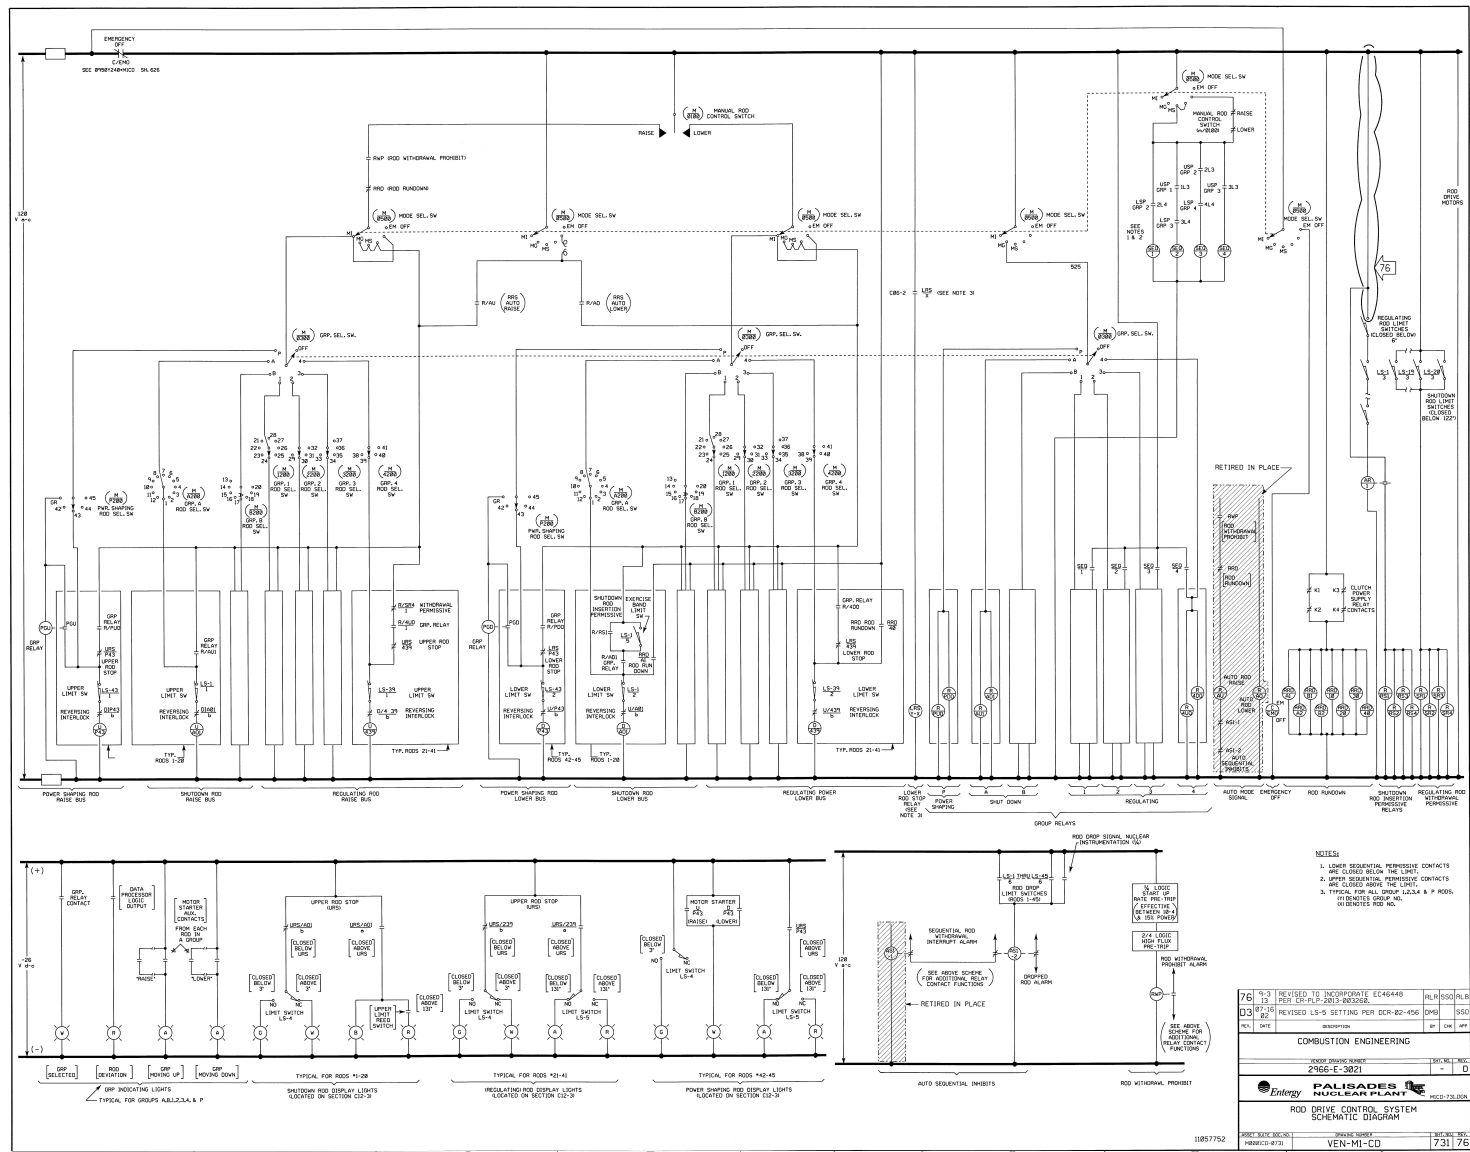


ROD POSITION SETPOINTS

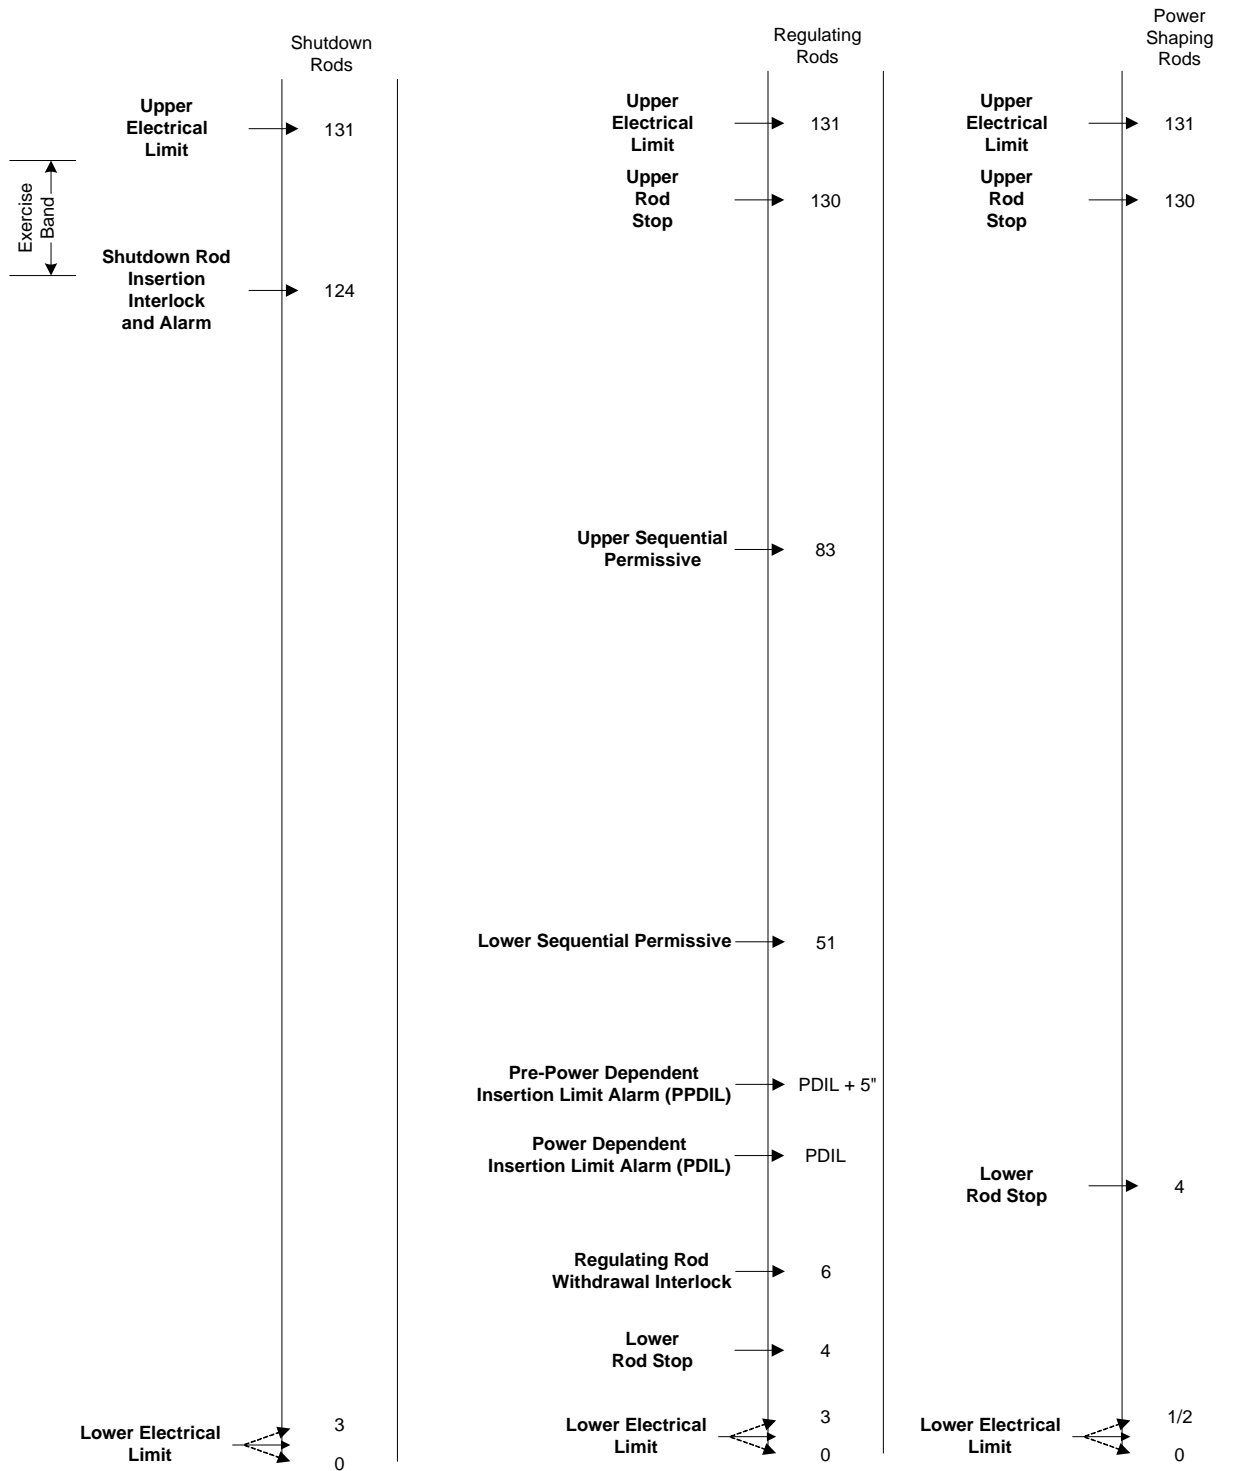

NOTE: All Setpoint are in inches from bottom.


PRESSURE CONTROL PROGRAM

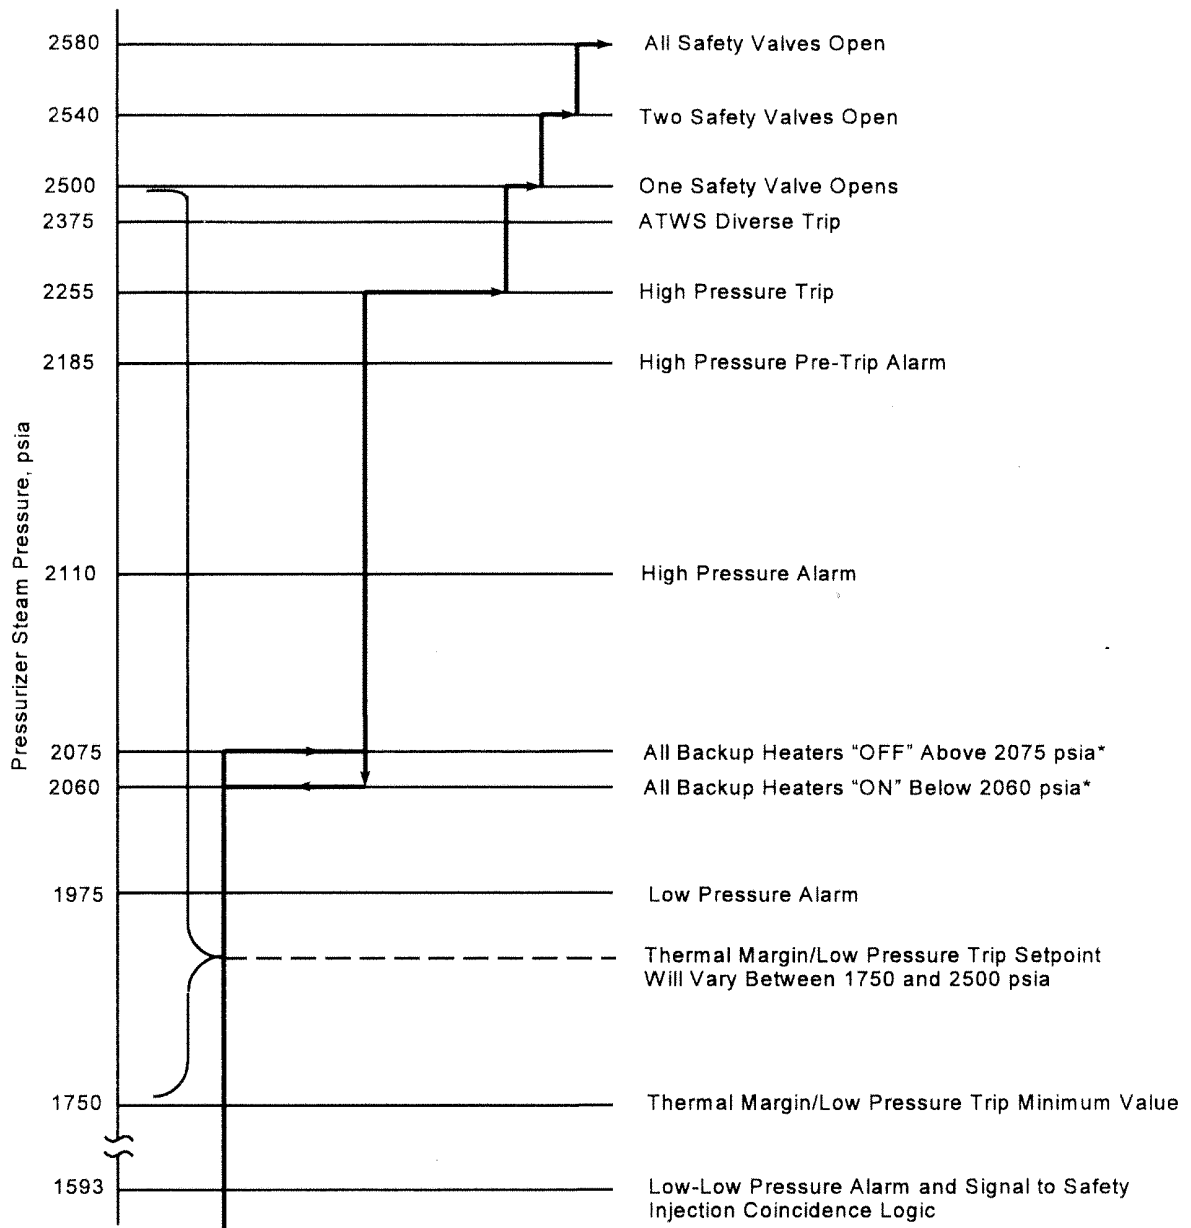


Pressurizer Normal Pressure Control	
Controller Output	Action
100%	Both Spray Valves Open
67%	Both Spray Valves Closed
33%	Proportional Heater "OFF"
0%	Proportional Heater "ON"

* Backup heaters normally operated in manual.

**BLOCK DIAGRAM
STEAM DUMP AND BYPASS SYSTEM**

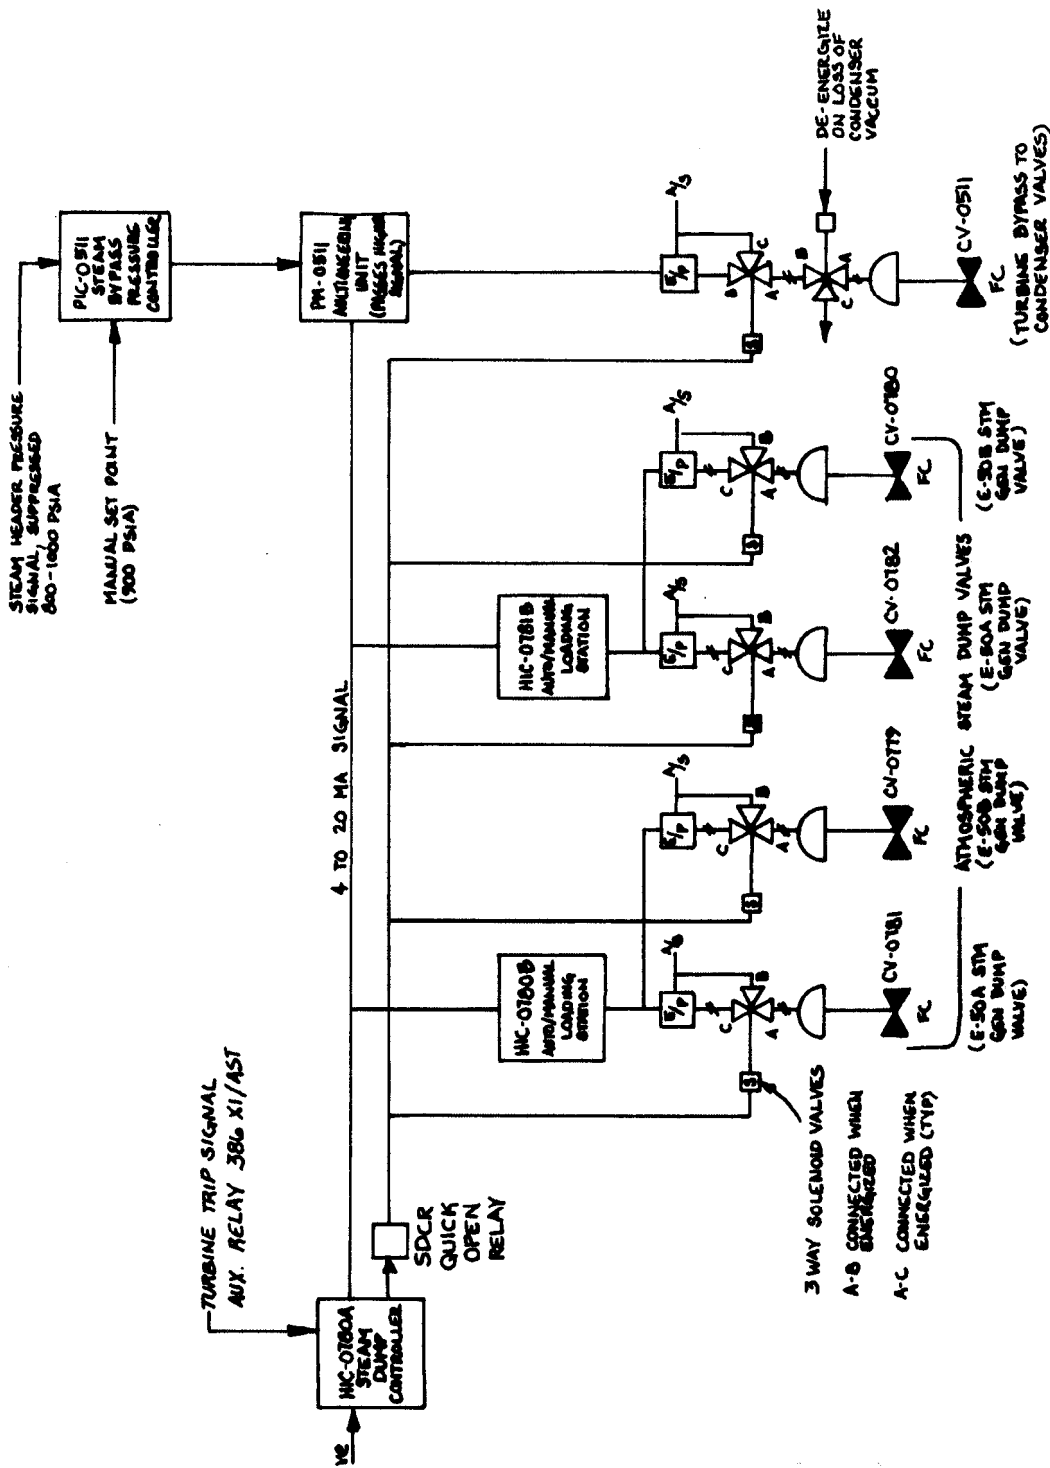

PRESSURIZER LEVEL CONTROL SYSTEM FAILURES STUDY
MODE "A" FAILURE

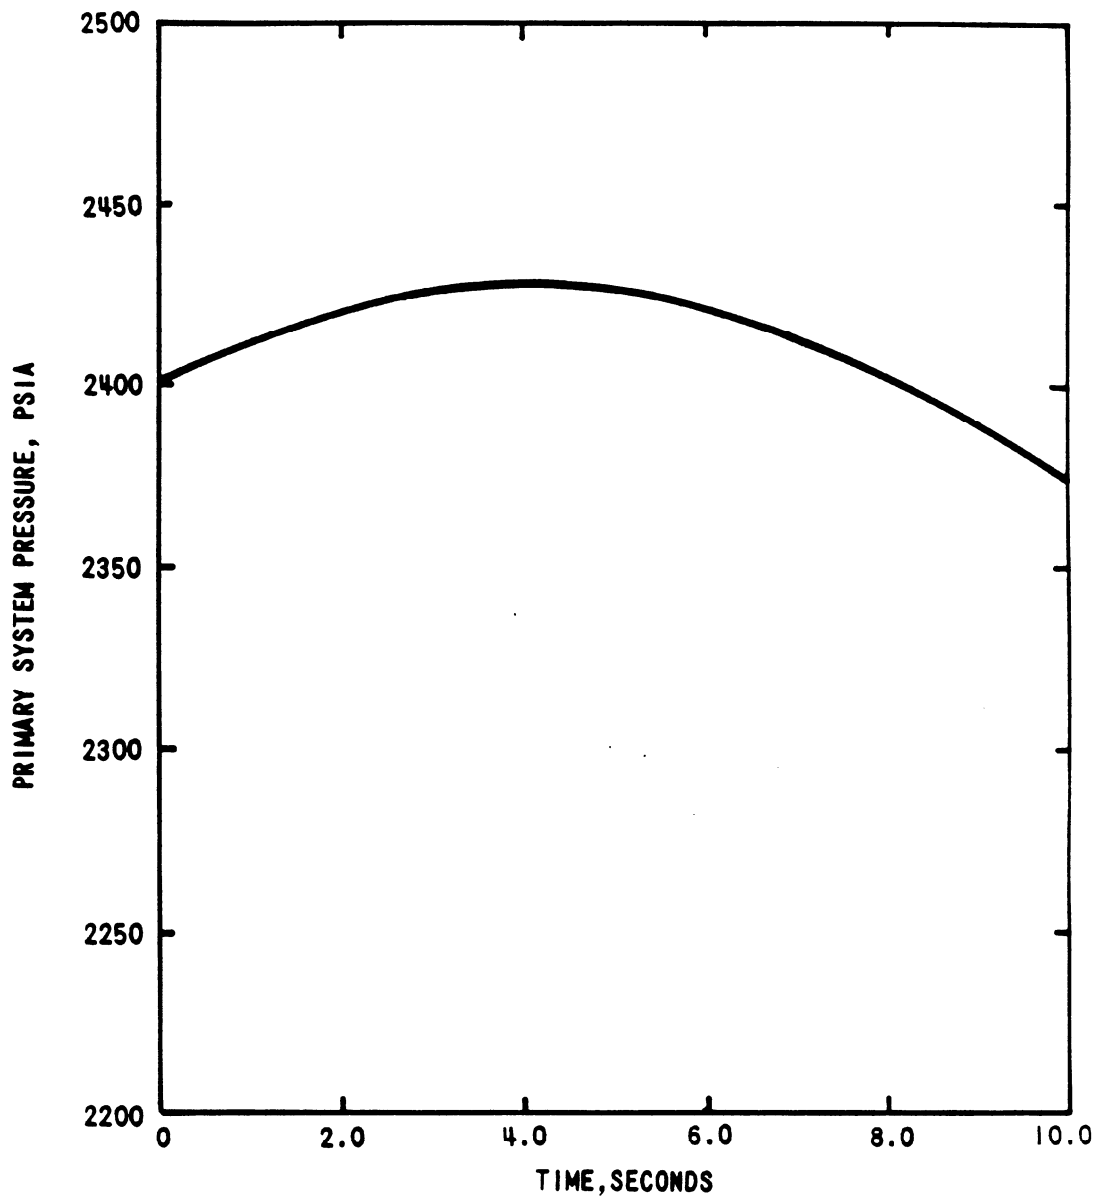


(REF P-ICE-900, 10/9/69)

**PIPING DRAWING
NUCLEAR DETECTOR WELLS**

Portions of this page have been
redacted per 10 CFR 2.390(d)(1).

**BLOCK DIAGRAM
CRITICAL FUNCTIONS MONITOR SYSTEM**

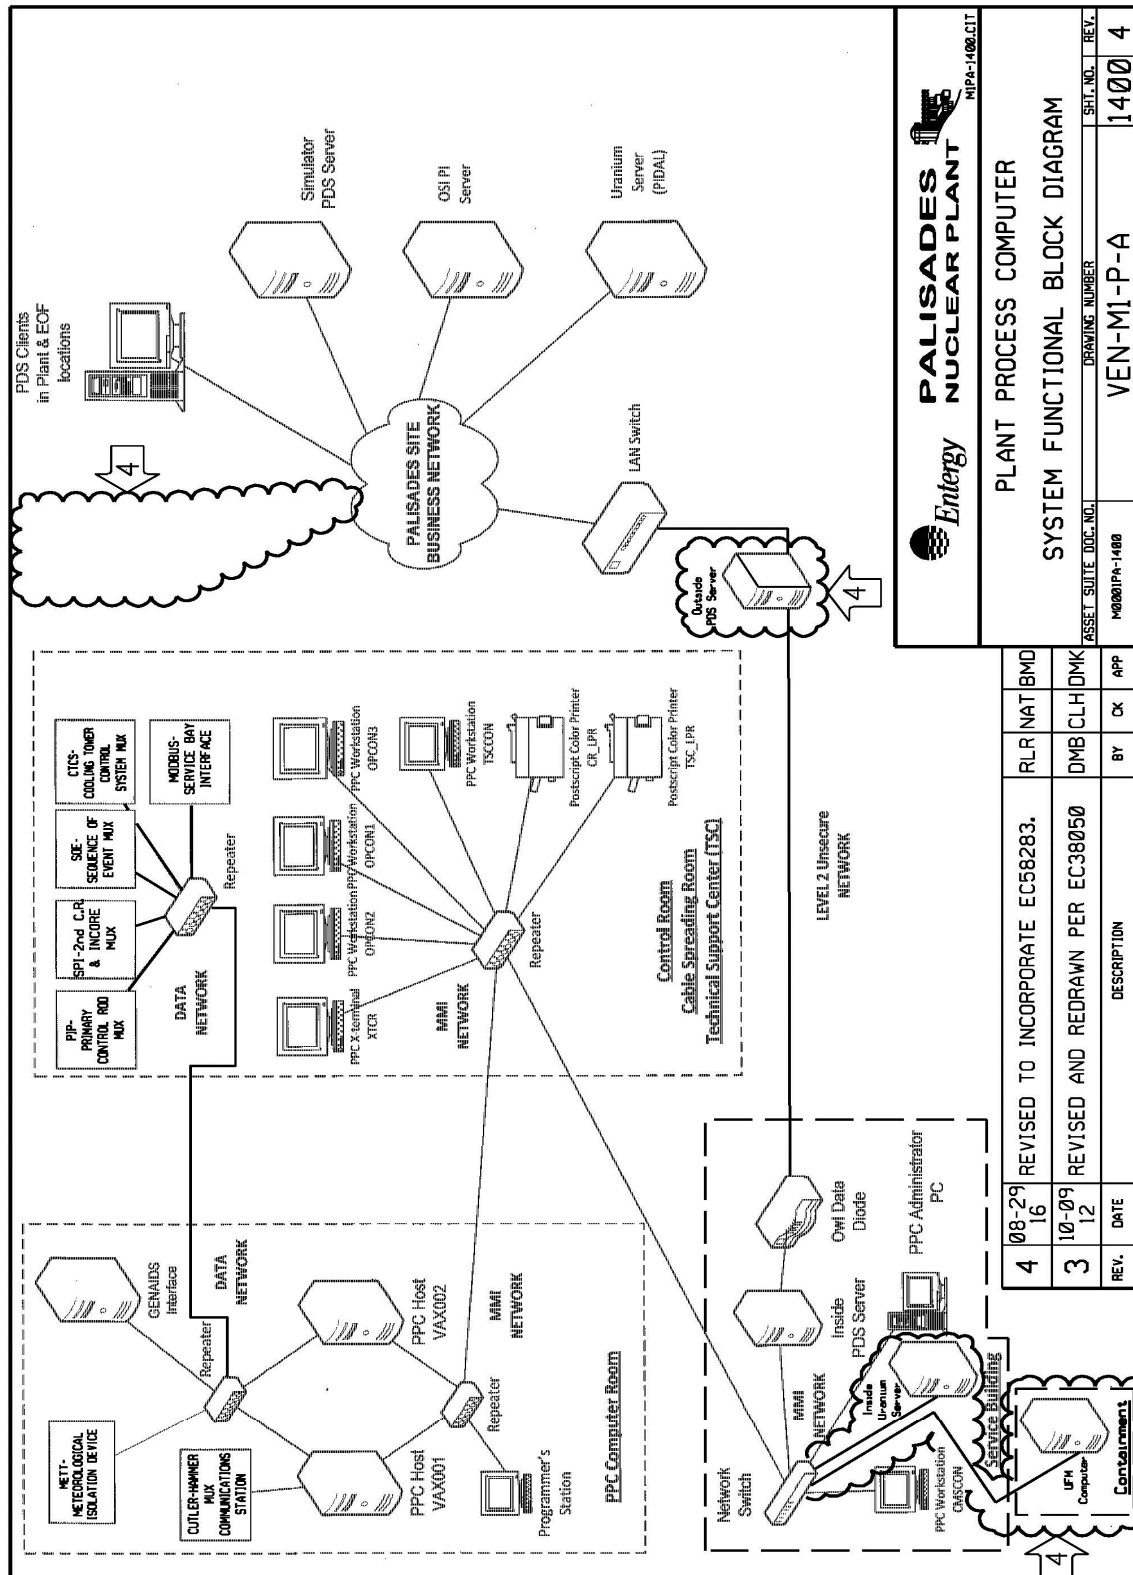

Palisades Nuclear Plant
Energy

**PLANT PROCESS COMPUTER
SYSTEM FUNCTIONAL BLOCK DIAGRAM**

ASSET SUITE DOC. NO. 14001PA-1400
DRAWING NUMBER VEN-M1-P-A
SRT. NO. 1400
REV. 4

NIPa-1400.CIT