

ROCHESTER GAS & ELECT. CORP.
GINNA NUCLEAR POWER STATION
UNIT NO. 1


MADE	CHKD	DRAWING NO.	SH. NO.	REV.						
	RBW	S-380-350	2							
SQ LDR	ENG INTERF	GILBERT ASSOCIATES, INC ENGINEERS AND CONSULTANTS READING, PA.								
SCALE	W.O.	ENGINEER APPROVAL	DEPT	DATE						
REV	MADE	CH	SQ L	AP-1	DATE	REV	MADE	CH	SQ L	APPROV

AS BUILT SKETCH

MAIN STEAM SUPPORT MK-MSG

MAIN STEAM SUPPORT MK-MSG

POOR ORIGINAL

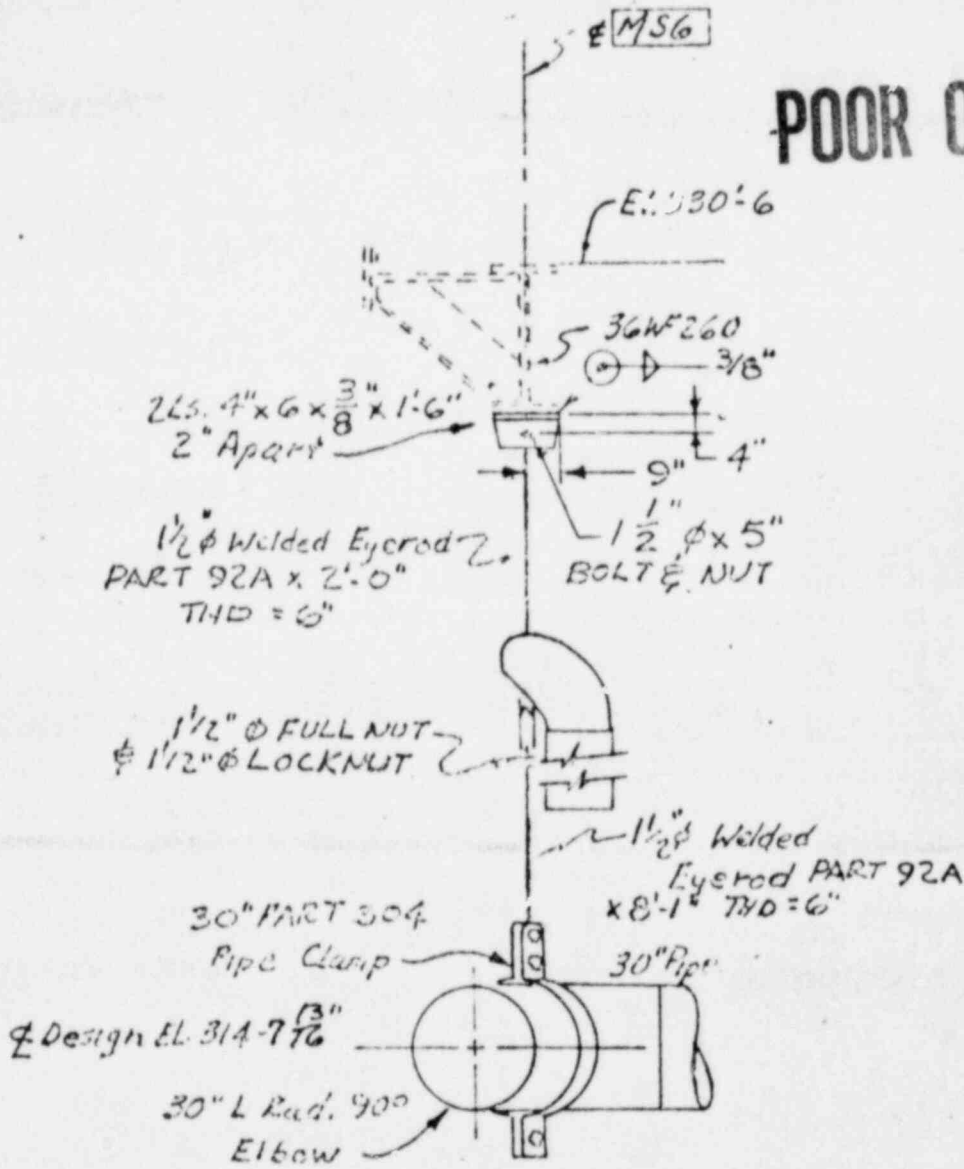

ENGR.
CONSTRUCTION
BIDDING PURPOSES
RELEASED FOR
DATE

MK-MSG

MK-MSG BERGEN CONSTANT SUPPORT
HANGER CSV TYPE LA1
FOR 3" TOTAL TRAVEL, SIZE 32

7910050297