


ROCHESTER GAS & ELECT. CORP. GINNA NUCLEAR POWER STATION UNIT NO. 1	MADE	CHKD	DRAWING NO.	SH. NO.	REV	
		RBW	S-380-354	6		
AS BUILT SKETCH	SQ LDR	ENG INTERF	GILBERT ASSOCIATES, INC. ENGINEERS AND CONSULTANTS READING, PA.			
RESIDUAL HEAT SUPPORT MK RH-2	SCALE					
	W.O.	ENGINEER APPROVAL		DEPT	DATE	
	REV	MADE	CH	SQ	APP	DATE

RESIDUAL HEAT SUPPORT MK RH-2

ENGR.
 BIDDING PURPOSES
 RELEASED FOR
 DATE

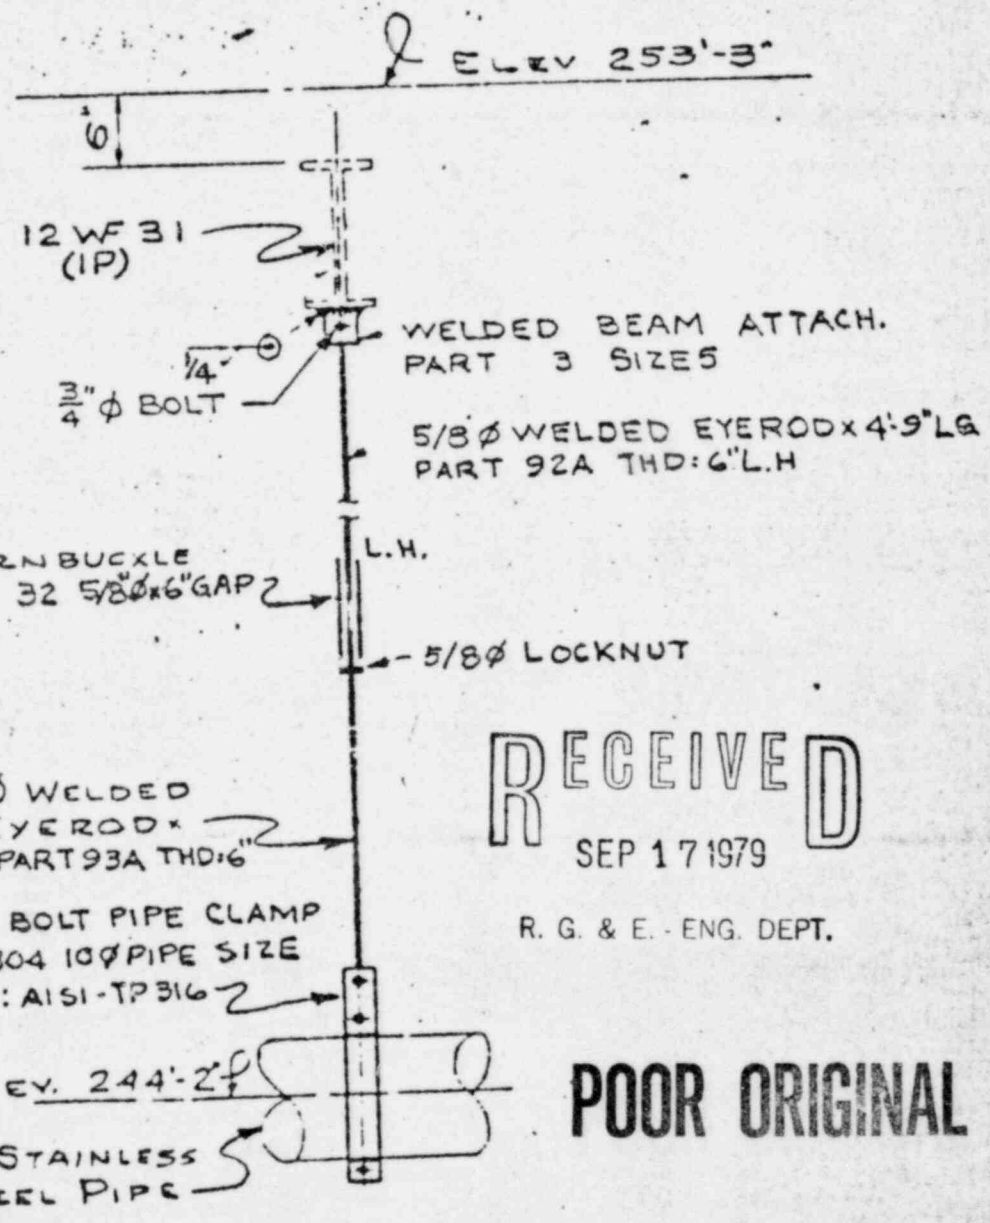

RECEIVED
SEP 17 1979

R. G. & E. - ENG. DEPT.

POOR ORIGINAL

MK-RH2
SECTION B-B