


ROCHESTER GAS & ELECT. CORP.
 GINNA NUCLEAR POWER STATION
 UNIT NO. 1

MADE	CHKD	DRAWING NO.	SH. NO.	REV
	RBW	S-230-354	11	
SQ LDR		ENG INTERF	GILBERT ASSOCIATES, INC. ENGINEERS AND CONSULTANTS READING, PA.	
SCALE		ENGINEER APPROVAL		
W.O.		DEPT	DATE	
REV	MADE	CH	SQ	APP

AS BUILT SKETCH
 RESIDUAL HEAT SUPPORT MK RH-7

RESIDUAL HEAT SUPPORT MK RH-7

ENGR.
 BIDDING PURPOSES
 RELEASED FOR
 DATE

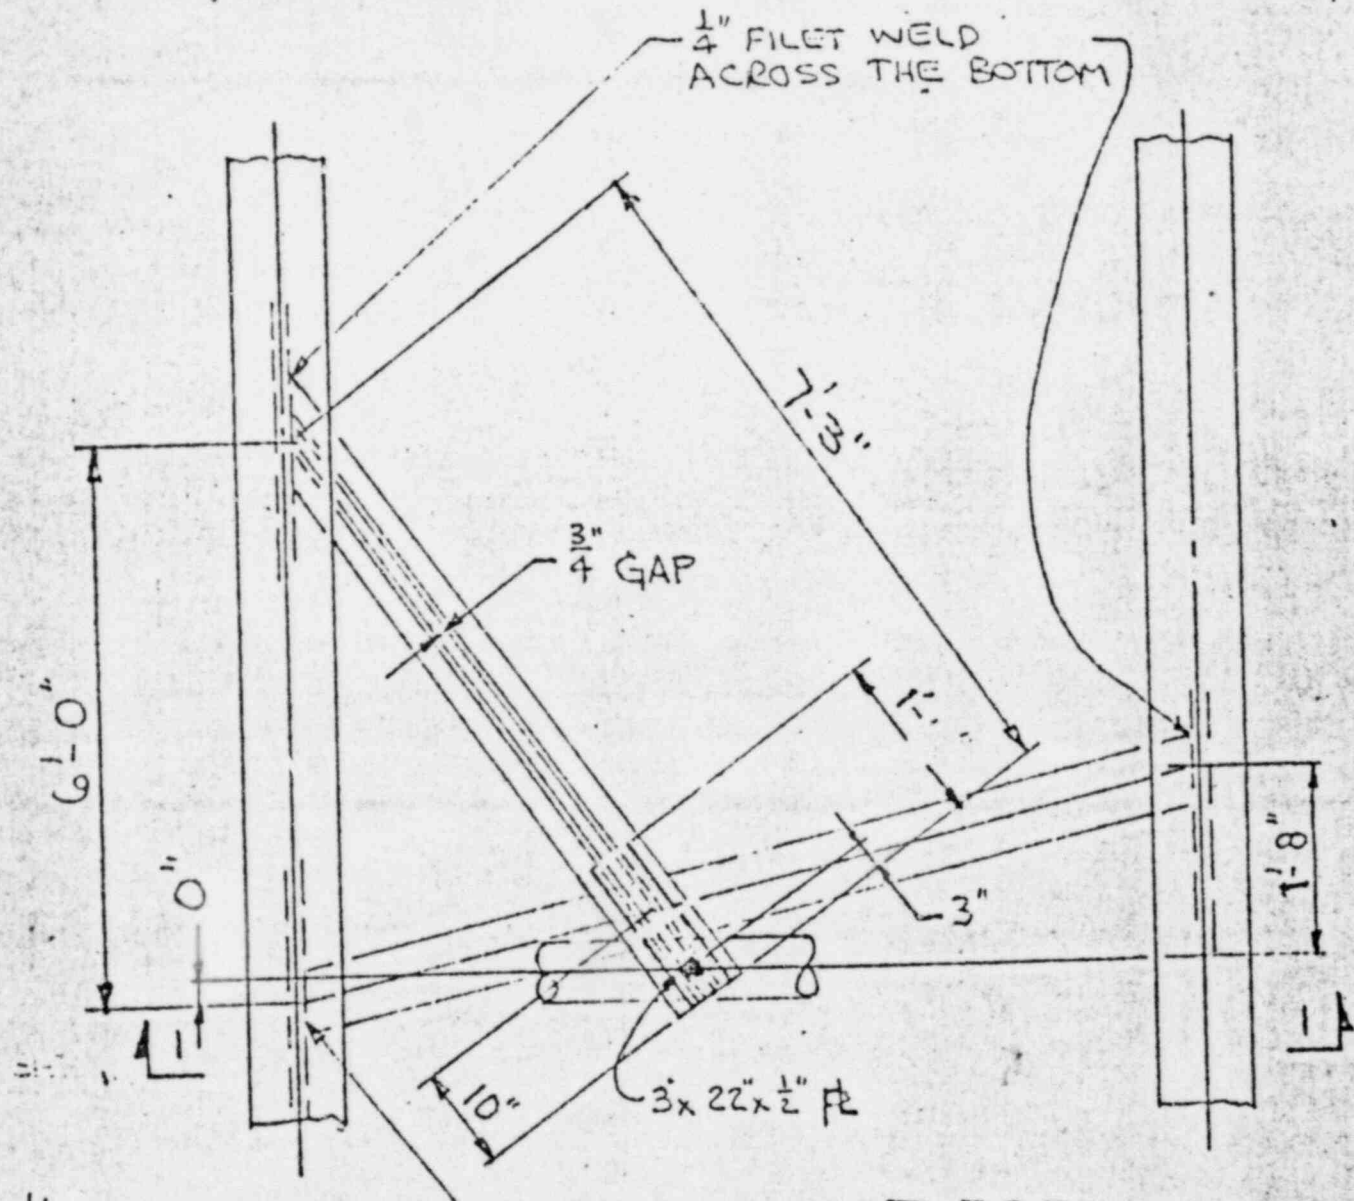

1/4" FILET WELD ACROSS
 THE BOTTOM

PLAN
 (RH-7)

RECEIVED
 SEP 17 1979

R. G. & E. - ENG. DEPT.

7910050317