



Regulatory

File Cy.



Consumers  
Power  
Company

General Offices: 212 West Michigan Avenue, Jackson, Michigan 49201 • Area Code 517 788-0550

June 27, 1972

Mr. John F. O'Leary, Director  
Directorate of Licensing  
US Atomic Energy Commission  
Washington, DC 20545

Re: Docket 50-155  
License DPR-6  
Errata - To Pro-  
posed Tech Spec-  
ification No 31


Dear Mr. O'Leary:

Please substitute the attached Drawing No 5.8 for the one submitted in our Request for Technical Specification Change No 31 dated June 16, 1972. Also, please accept our apology for the wrong salutation on the same letter - it should have read "Dear Mr. O'Leary" and not "Dear Mr. Bloch."


Yours very truly,

WGF/smm

R. B. Sewell  
Nuclear Licensing  
Administrator

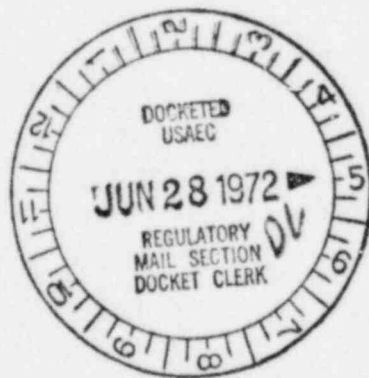

8101100257

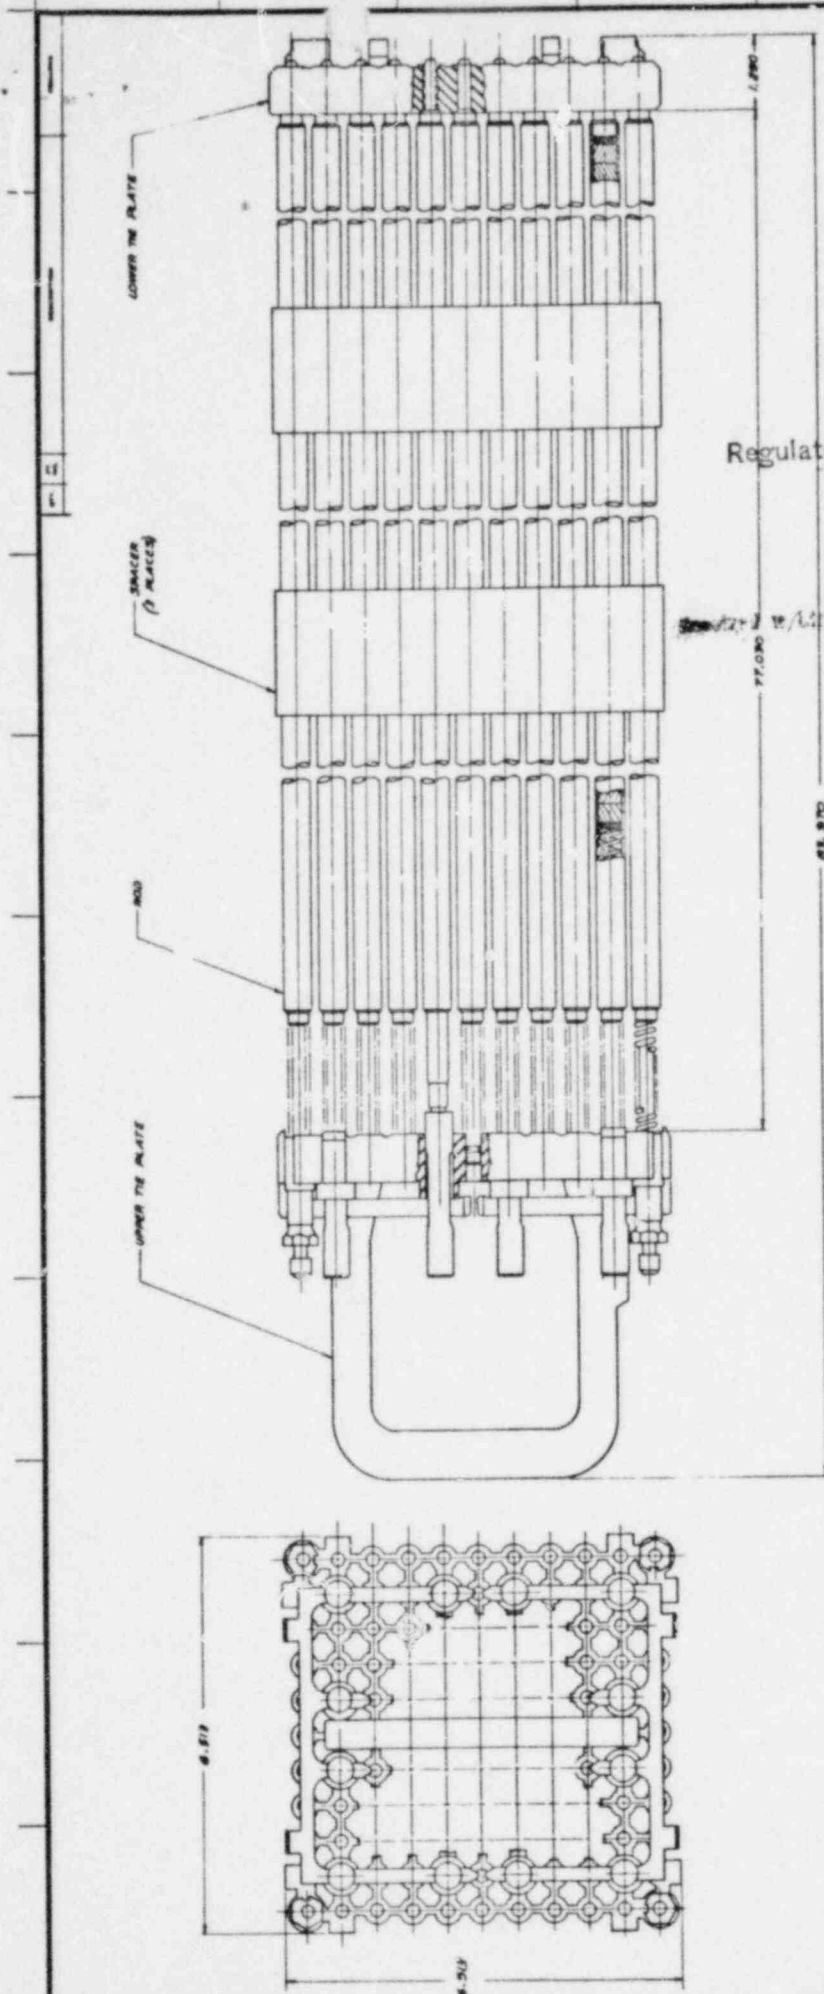

ITEM	MATERIAL
CLADDING	ZIRCALOY
SPACER	ZIRCALOY
TIE PLATE	CP-3 CASTING B37
FUEL	UO <sub>2</sub>

FIGURE 5.7

Jersey Nuclear Company  
 FUEL BUNDLE SCHEMATIC  
 BIG ROCK POINT  
 RELOAD-G  
 JN-300,667

Regulatory File Cy.

- 6-27-72
- ROD TYPE C - COBALT
  - ROD TYPE L - 2.3 W/O ENRICHED U-235
  - ROD TYPE M - 3.2 W/O ENRICHED U-235
  - ROD TYPE H - 4.6 W/O ENRICHED U-235
  - ROD TYPE P - 5.0 W/O FISSIONABLE PU + U
  - ROD TYPE X - UNFUELED Zr
  - ROD TYPE M<sub>50</sub> - 4.6 W/O ENRICHED U-235 WITH GADOLINIUM

OCTANT SYMMETRY



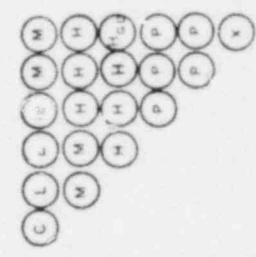


FIGURE 5.8

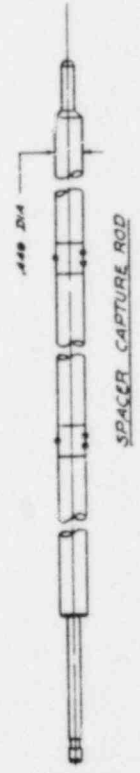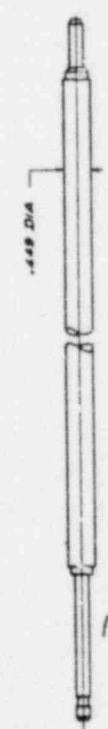

POOR ORIGINAL

AEC DISTRIBUTION FOR PART 50 DOCKET MATERIAL  
(TEMPORARY FORM)

CONTROL NO: 3527

FROM: Consumers Power Company Jackson, Michigan 49201 R.B. Sewell	DATE OF DOC: 6-27-72	DATE REC'D 6-28-72	LTR X	MEMO	RPT	OTHER
TO: Mr. John F. O'Leary	ORIG 3 signed	CC 37	OTHER	SENT AEC PDR <input checked="" type="checkbox"/> SENT LOCAL PDR		
CLASS: <b>U</b> PROP INFO	INPUT	NO CYS REC'D 40	DOCKET NO. 50-155			

DESCRIPTION: Ltr trans the following:

ENCLOSURES: Drawing No. 5.8 to be substituted in Tech Specs Change No. 31 dtd 6-16-72 also adv that sample ltr should read....

(40 cys encl rec'd)

**DO NOT REMOVE**

**ACKNOWLEDGED**

PLANT NAMES: Big Rock Plant

FOR ACTION/INFORMATION

DL 6-29-72

BUTLER(L) W/ Copies	KNIEL(L) W/ Copies	VASSALLO(L) W/ Copies	ZIEMANN(L) W/ 9 Copies	KNIGHTON(ENVIRO) W/ Copies
CLARK(L) W/ Copies	SCHWENCER(L) W/ Copies	H. DENTON W/ Copies	CHITWOOD(FM) W/ Copies	W/ Copies
GOLLER(L) W/ Copies	STOLZ(L) W/ Copies	SCHEMEL(L) W/ Copies	DICKER(ENVIRO) W/ Copies	W/ Copies

INTERNAL DISTRIBUTION

<del>REG FILES</del>	STELLO-L	VOLLMER-L	KARAS-L L/A PWR
✓ AEC PDR	MOORE-L	DENTON-L	MASON-L L/A BWR
✓ REG OPER (2)	LANGE-L	GRIMES-L	BROWN-L L/A PWR
✓ GC-RM P-500	PAWLICKI-L	GAMMILL-L	WILSON-L L/A PWR
✓ MUNTZING & STAFF	✓ THOMPSON-L	KNIGHTON-ENVIRO	KARI-L L/A BWR
GIAMBUSSO-L	TEDESCO-L	DICKER-ENVIRO	SMITH-L L/A BWR
BOYD-L-BWR	LONG-L	PROJ LDR ENVIRO:	GEARIN-L L/A BWR
DEYOUNG-L-PWR	LAINAS-L		DIGGS-L L/A
MULLER-L-ENVIRO	SHAO-L	SALTZMAN-IND.	TEETS-L L/A
✓ SKOVHOLT-L-OPER	BENAROYA-L	McDONALD-PLANS	WADE-L L/A ENVIRO
KNUTH-L	MORRIS-RO	NUSSBAUMER-FM	BRAITMAN-A/T
MACCARY-L	✓ DUBE-L	SMILEY-FM	HARLESS-ENVIRO
SCHROEDER-L	E. CASE-L	P. COLLINS-L	

EXTERNAL DISTRIBUTION

- |                                      |  |                          |
|--------------------------------------|--|--------------------------|
| 1-LOCAL PDR                          | 9-NATIONAL LAB'S<br>ANL/ORNL/BNWL        | 1-SAN/LA/NY--PDR         |
| ✓ 1-DTIE-(LAUGHLIN)                  | 1-R. CARROLL-OC, GT                      | 1-CHIEF WATER REACTORS   |
| ✓ 1-NSIC-(BUCHANAN)                  | 1-R. CATLIN, A-170, GT                   | 1-RD....E. HALL F-309 GT |
| 1-ASLB-YORE/SARYE<br>WOODWARD/H. ST. | 1-CONSULTANT'S<br>NEWMARK/BLUME/AGBABIAN |                          |
| ✓ 1-C. MILES-C-459, GT               | 1-DR. GERALD S. LELLOJCHE                |                          |
| ✓ 16 CYS ACRS-HOLDING                | BROOKHAVEN NATIONAL LAB                  |                          |

**POOR ORIGINAL**

~~877100257~~