


NUCLEAR PACKAGING, INC.

815 SO. 28TH STREET • TACOMA, WASHINGTON 98409 • (206) 572-7775 • 838-1243
TELEX: 152-556 "SEA"

71-9132
PDR-~~Page~~
~~2~~
Return
396-SS

July 26, 1982

Mr. Charles E. MacDonald, Chief
Transportation Certification Branch
Division of Fuel Cycle and Material
Safety
Nuclear Regulatory Commission
Washington, D.C. 20555

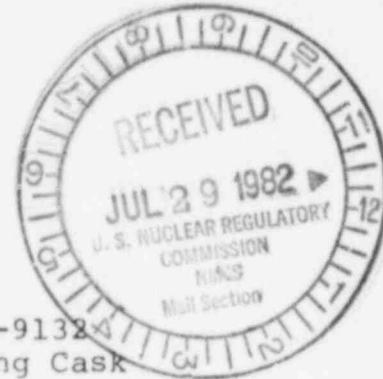

REFERENCE: Docket Number 71-9132-4
Model T-3 Shipping Cask

SUBJECT: Revision 9 Amendments submitted
July 23, 1982

Dear Mr. MacDonald:

Attached are eight (8) copies of Drawing E-4-61289, Revision 6, sheets 1, 2, and 3 of 4 which were inadvertently omitted from our July 23rd transmittal. For completeness, they should be inserted along with Sheet 4, Revision 6, which was previously submitted.

Thank you for your assistance.



Sincerely yours,

NUCLEAR PACKAGING, INC.

R. T. Haelsig
R. T. Haelsig

RTH/pro


cc: J. Berger, Westinghouse Hanford Co.

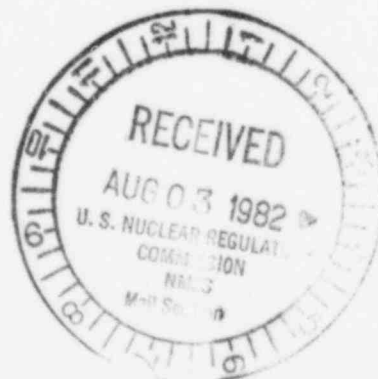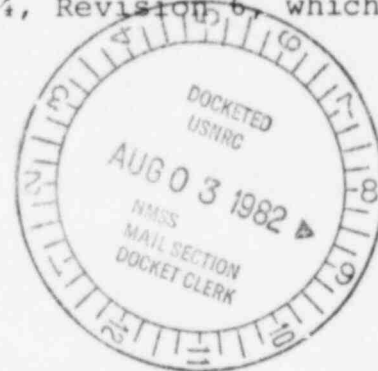



FEE EXEMPT
afjo


8208240633C

21026

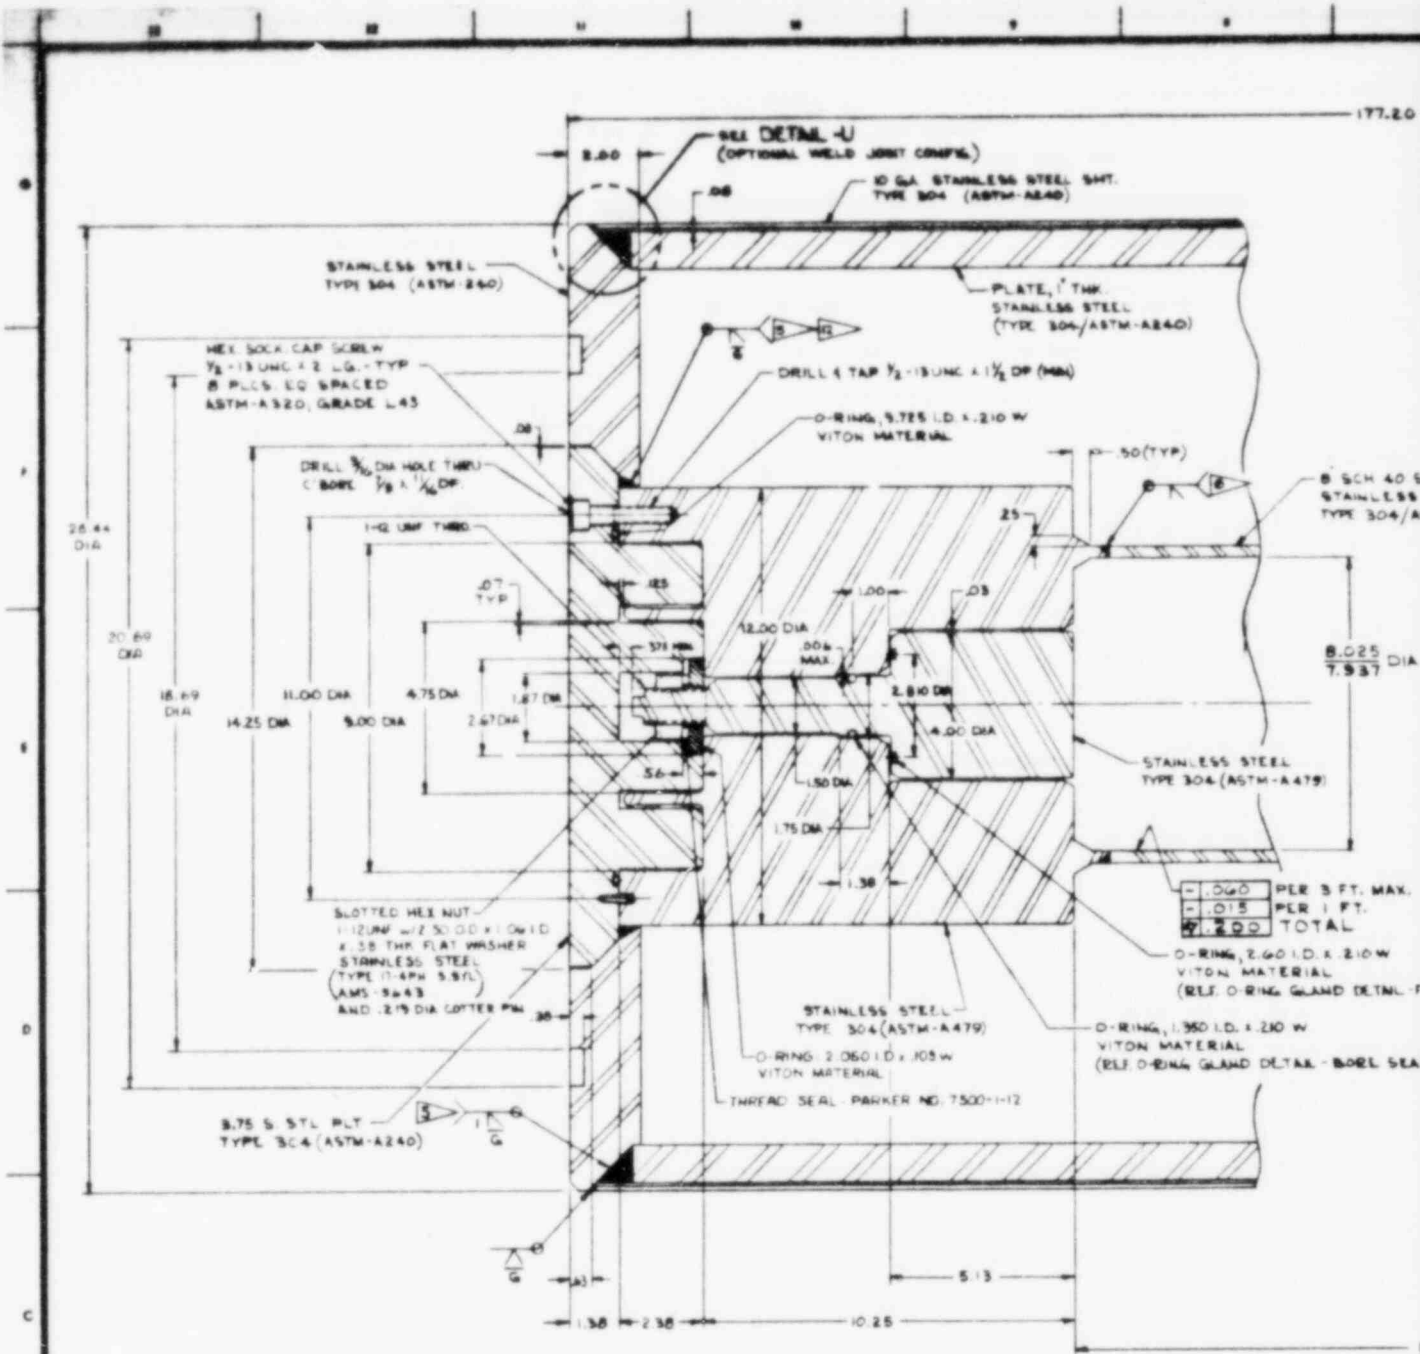

SECTION C-C
SCALE: 1/2

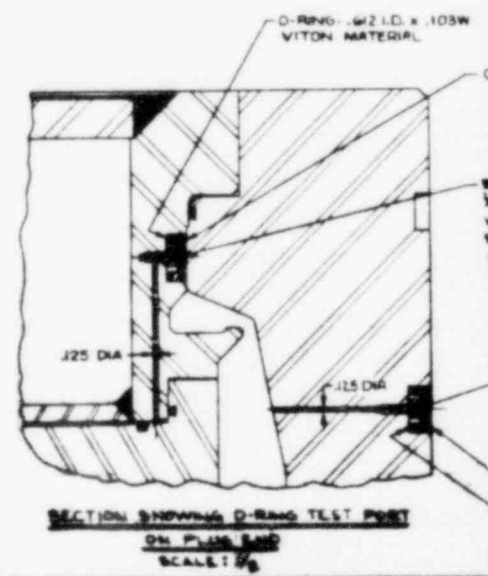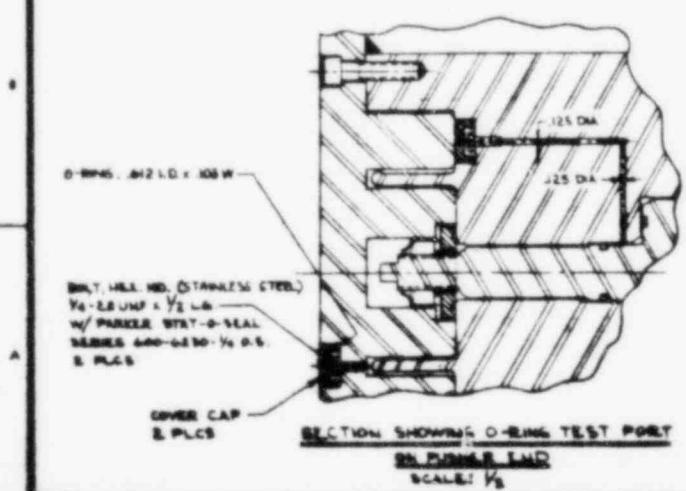

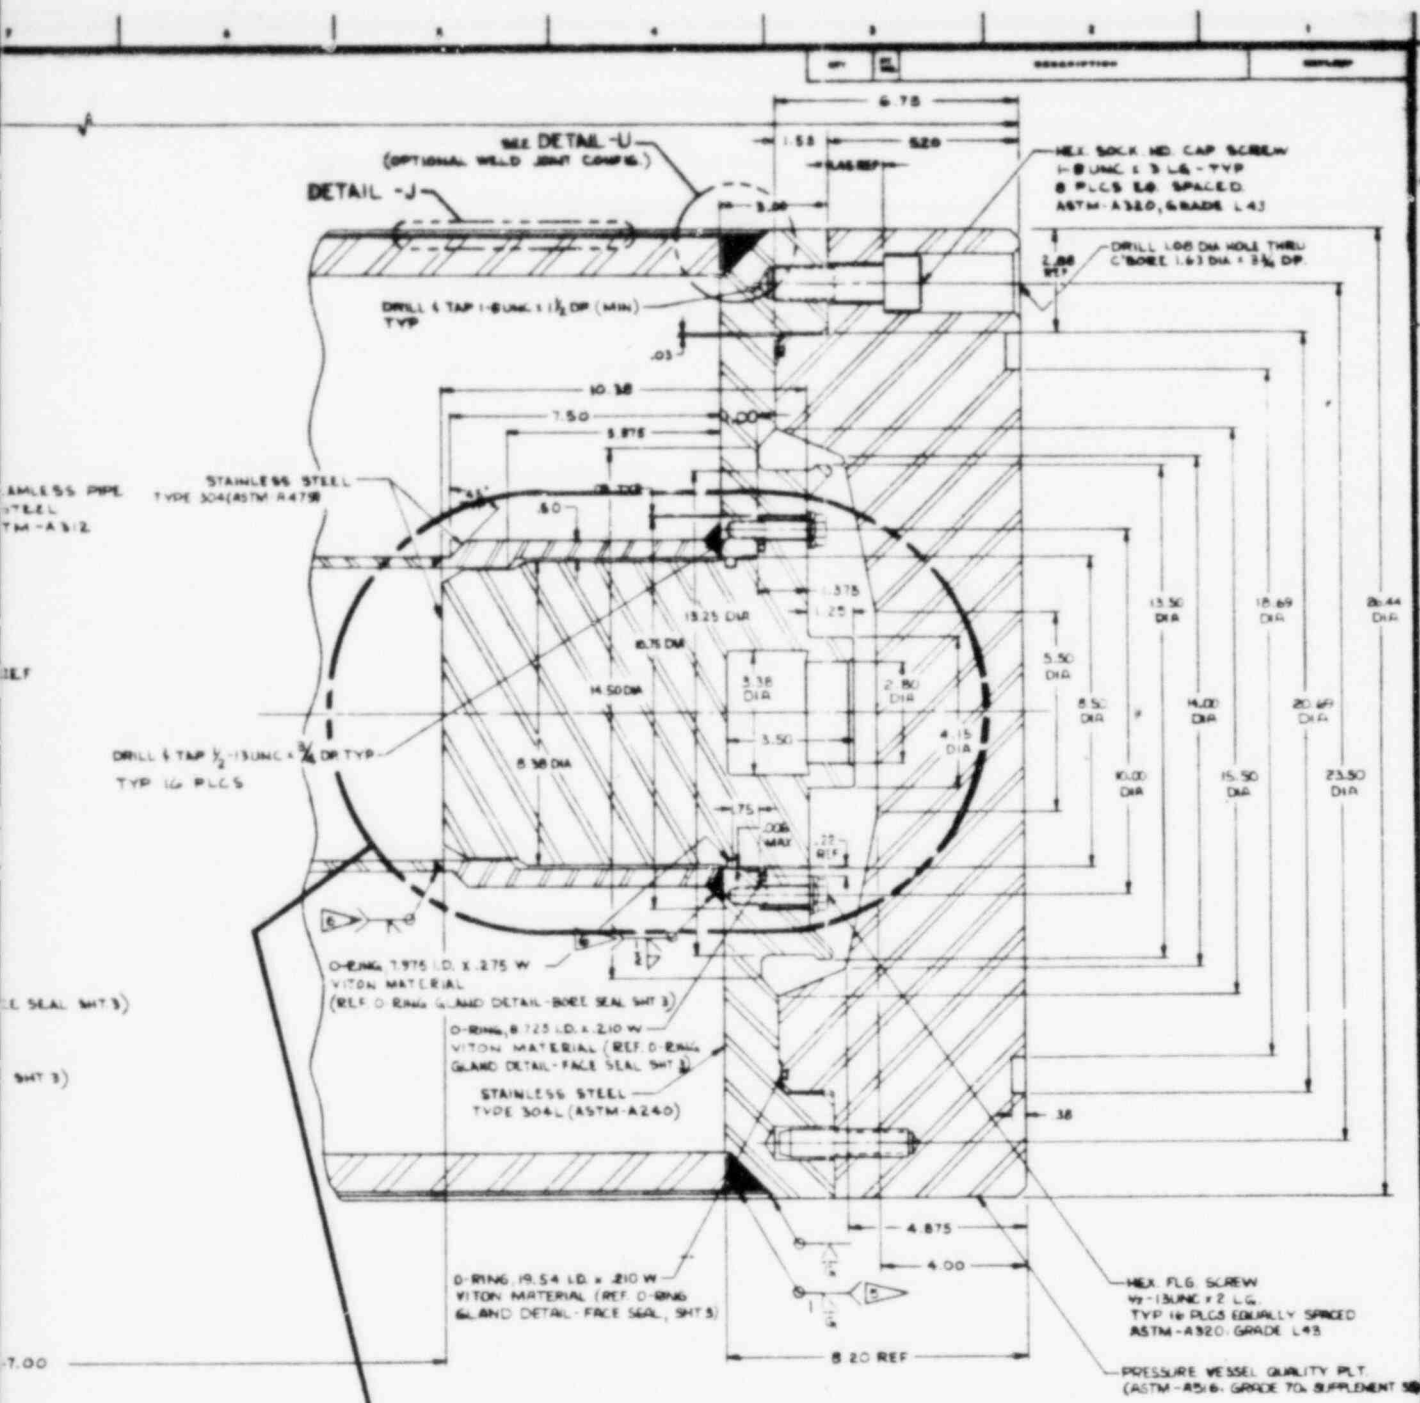

SECTION D-D
SCALE: 1/2









DETAIL - W

BOLT, HEX HD. (STAINLESS STEEL)
1/2-28 UNF x 1/2 LG
/ PARKER STAT-O-SEAL
SERIES 600-6230-1/4 O.S.
LOCATED BETWEEN 1/2-13 UNC
FLANGE SCREWS.


BOLT, HEX HD. (STAINLESS STEEL)
3/4-28 UNF x 1/2 LG
/ PARKER STAT-O-SEAL
SERIES 600-6230-1/4 O.S.

O-RING, 1.875 I.D. x .210 W
VITON MATERIAL

REV. SHEET		6
DESCRIPTION		
APPROVED FOR ISSUE BY		
DRAWING STATUS		
U.S. Department of Energy		
Nuclear Engineering Development Laboratory		
T-3 SHIPPING CABIN		
FAST FLUX TEST FACILITY		
DRAWING NO.		144-61289
REV.		2

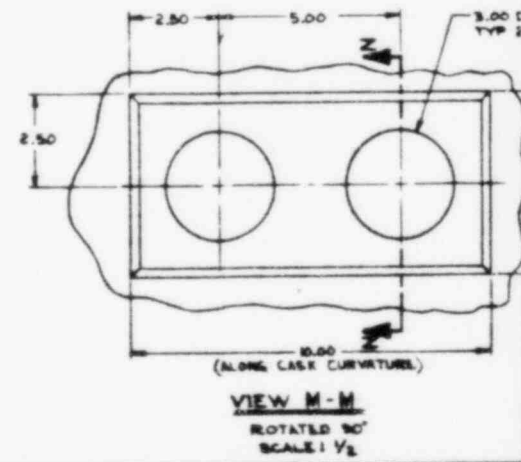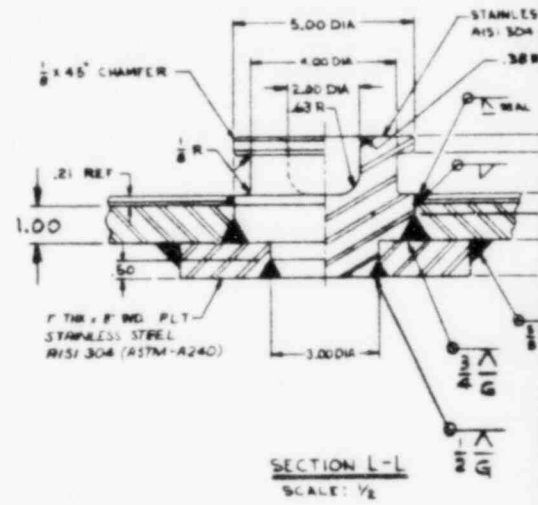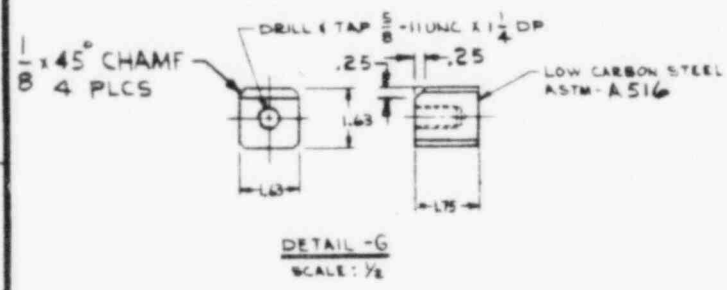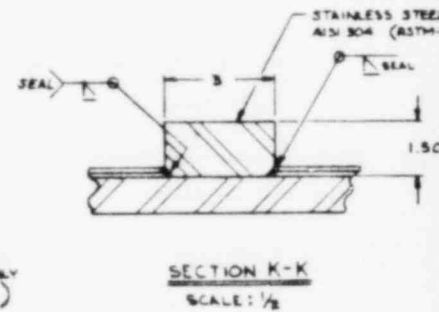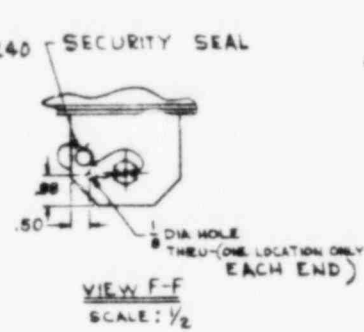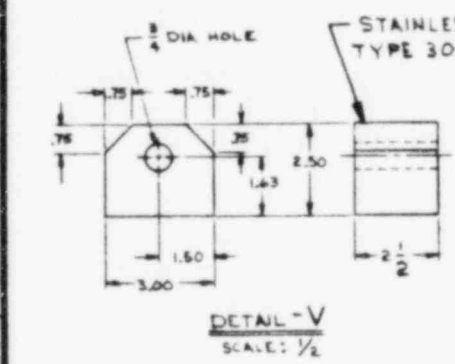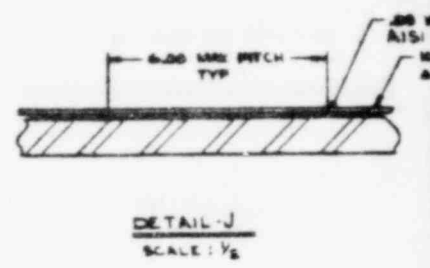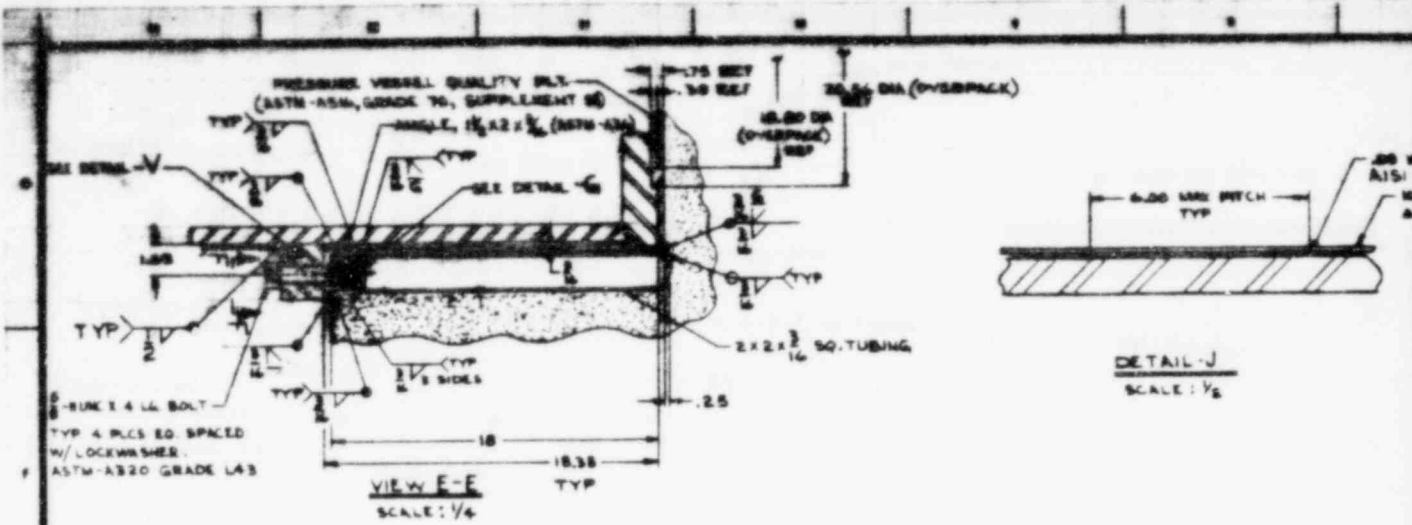


304 STAINLESS STEEL
304 (ASTM-A304)
304 STAINLESS STEEL
304 (ASTM-A304)

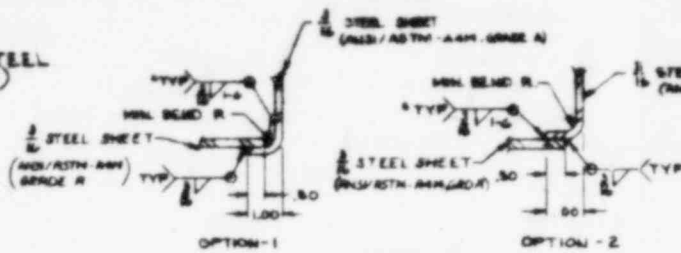


DETAIL - P

SCALE: 1/2

* NOT WELD ON FINAL CLOSURE SHEETS.

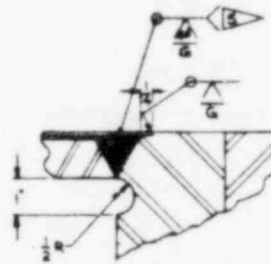

DETAIL - W
OPTIONAL WELD JOINT
(TYP BOTH ENDS)
SCALE: 1/2

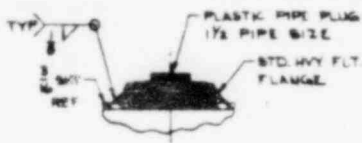


DETAIL - R
ROTATED 90°
SCALE: 1/2


STEEL
ASTM-A479

1.50
1.25
.50
.75
1.00


11R REF

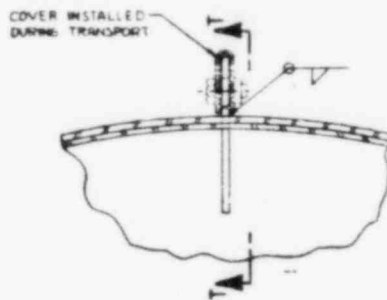


SECTION S-S
SCALE: 1/2

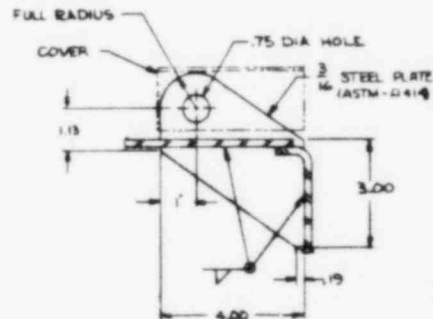

SECTION T-T
SCALE: 1/2

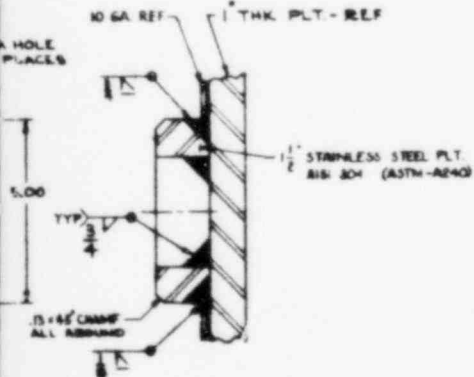

SECTION M-M
SCALE: 1/2

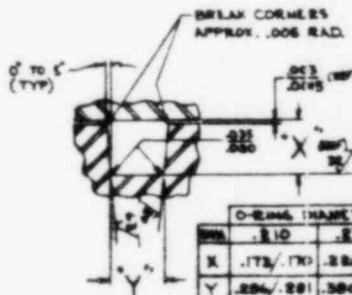

O-RING SEAL GLAND DETAIL
SCALE: 1/8 INCH
TYP ALL BORE SEALS



O-RING DIAMETER	
FIN	.103 .210
X	.081/.083.180/.180
Y	.083/.087.171/.175



O-RING SEAL GLAND DETAIL
SCALE: 1/8 INCH
TYP ALL BORE SEALS

REVISIONS		REV	DATE	DESCRIPTION

U.S. Department of Energy
Nuclear Engineering Development Laboratory
T-3 SHIPPING CASK
FIRST FLASK TEST FACILITY
N4-61213

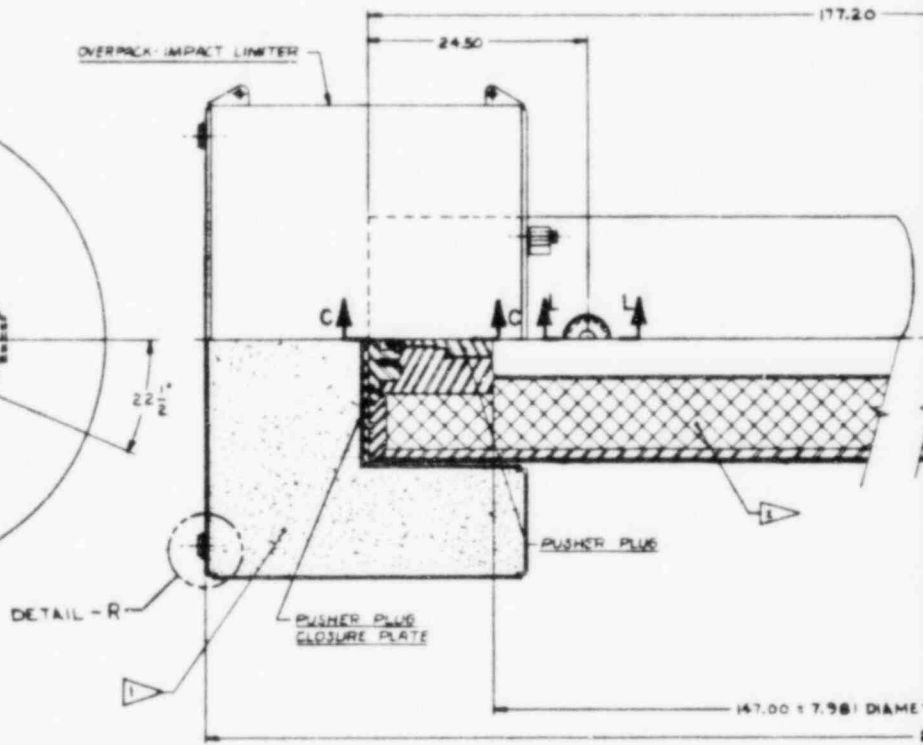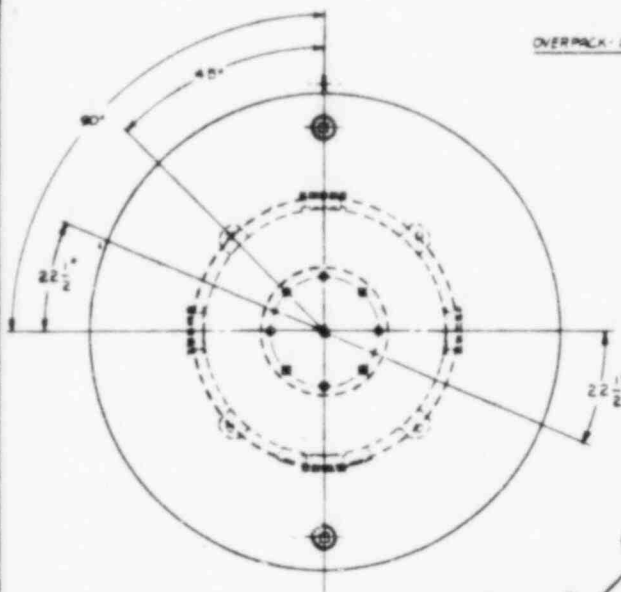

1. RADIOGRAPHIC INSPECTION SHALL BE PERFORMED IN ACCORDANCE WITH ASME CODE SECTION III, DIVISION 1, SUBSECTION NB, ARTICLE NB-5000 AND SECTION V, ARTICLE 2.

2. LIQUID PENETRANT INSPECTION SHALL BE PERFORMED ON WELD PASS AND FINAL PASS IN ACCORDANCE WITH ASME CODE SECTION III, DIVISION 1, SUBSECTION NB, ARTICLE NB-5000 AND SECTION V, ARTICLE 6.

4. THREADS PER ASA B1.1 1967 EDITION

5. REFERENCE DATA
 CASE WT. 37,500 LBS.
 PAYLOAD 500 LBS.
 GROSS WT. 38,000 LBS.

6. LEAD PER FEDERAL SPECIFICATION 99-L-17/L, GRADE A OR C.

7. SPIN FILL: 1,000 PSI CROSS STRENGTH 3065 POLYURETHANE PER SUPAC FORD SPECIFICATION SP1 - PA.

NOTE: UNLESS OTHERWISE SPECIFIED

8. OVERPACK GUIDE PINS OPTIONAL

9. THIS WELD SHALL BE MADE AFTER LEAD POUR IS COMPLETED.


11. TORQUE OVERPACK ATTACHMENT BOLT (1-8 UNC) TO 400 FT-LBS. ± 20 FT-LBS.

10. TORQUE PUSH ROD NUT (1-12 UNF) TO 50 FT-LBS. ± 10 FT-LBS.

9. TORQUE CONTAINMENT CLOSURE BOLTS (1/2"-13 UNC) TO 40 FT-LBS. ± 10 FT-LBS.

8. TORQUE END CLOSURE BOLTS (1/2"-11 UNC) TO 40 FT-LBS. ± 10 FT-LBS.

7. TORQUE END CLOSURE BOLTS (1-8 UNC) TO 400 FT-LBS. ± 20 FT-LBS.

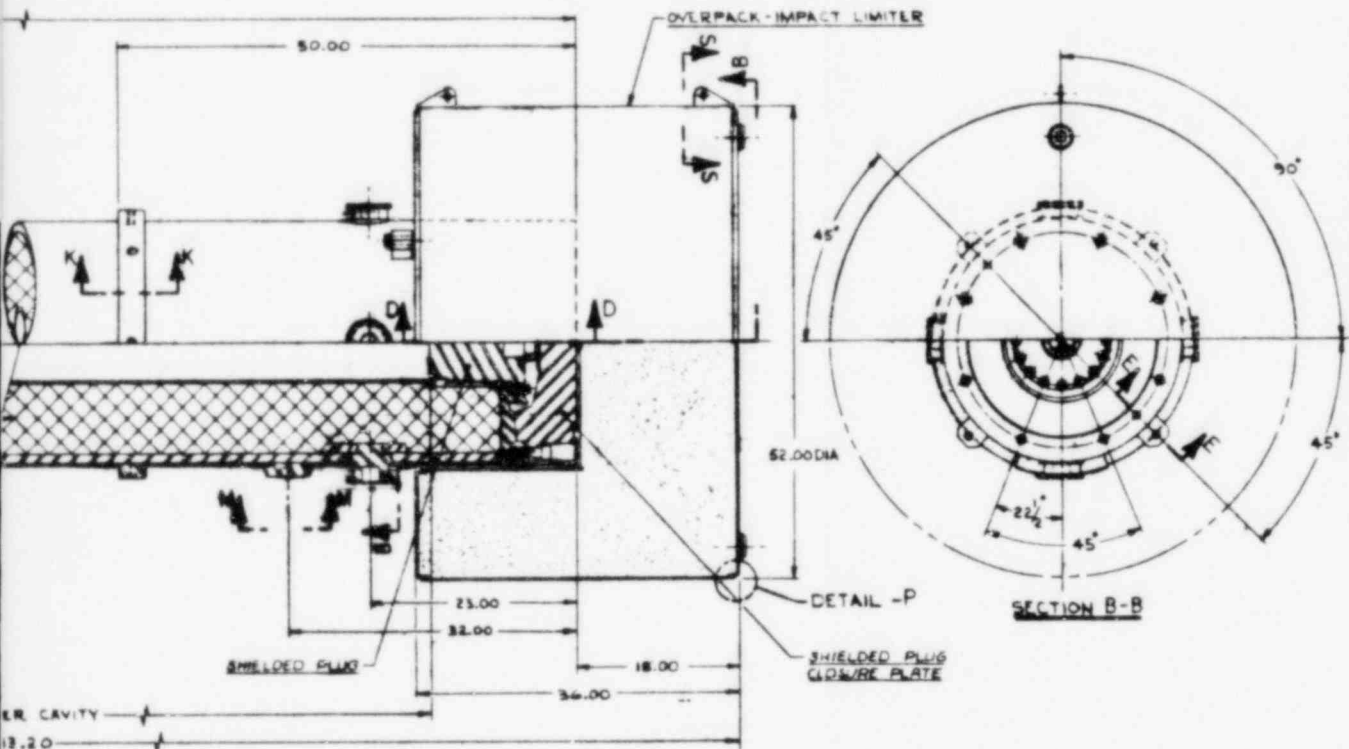

6	REMOVED HOLD DOWN RING DETAIL IN 4 REFERENCED Dwg N-3-5746 PL 514
5	ADDED DIMS TO DETAIL-X SH 4
4	ADDED ALTERNATE PLUG CONFIG., DET W. SH 4 DETAIL & H.D. RING DET.
3	REVISED PER S.A.R. CHANGES AND REVISIONS
2	REVISED PER S.A.R. CHANGES AND REVISIONS
1	REVISED PER S.A.R. CHANGES AND REVISIONS
0	ORIGINAL

U.S. Department of Energy
 Sanford Engineering Development Laboratory
 T-3 SHIPPING CASK
 PART FOUR TEST FACILITY
N4-61281