



GE Nuclear Energy

ABWR

Date 3/18/94

To Chet Postlusny

Fax No. —

This page plus 5 page(s)

From Jack Fox

Mail Code _____
175 Curtner Avenue
San Jose, CA 95125

Phone (408) 925-4824

FAX (408) 925-1193
or (408) 925-1687

Subject Revised response to DSEB (SECY-91-235)
outstanding Issue 31


Message Chet, please run this by
George Thomas. Note, this
subject appears on FSEB
page 5-33 and 5-34.

Jack

This is a revised response to DSER Open Item 2.31.

It was previously stated that the resolution to this issue was to trip the condensate pumps in the event of Level 8. In the SSAR this was further restricted to occur only if it was coincident with indication that the feedpump discharge valves were not fully closed. This solution imposes unreasonable restrictions on plant operation. From an operational standpoint, it is desirable to maximize the availability of the condensate pumps (short cycle cleanup mode to keep condensate in hotwell clean), even during shutdown periods, when a higher water level could be expected to be above Level 8.

The preferable solution is to close all feedpump discharge and bypass valves in the event of Level 8. This solution isolates the condensate pumps from the vessel, but allows them to remain available and operating for short cycle cleanup mode. It resolves the concern about vessel overpressurization by isolating the condensate pump from the feedwater piping sections in between the feedpump discharge valves and the feedwater injection valves. Therefore, even if the feedwater injection valves inadvertently open, the closed feedwater pump discharge and bypass valves prevent condensate flow to the vessel.

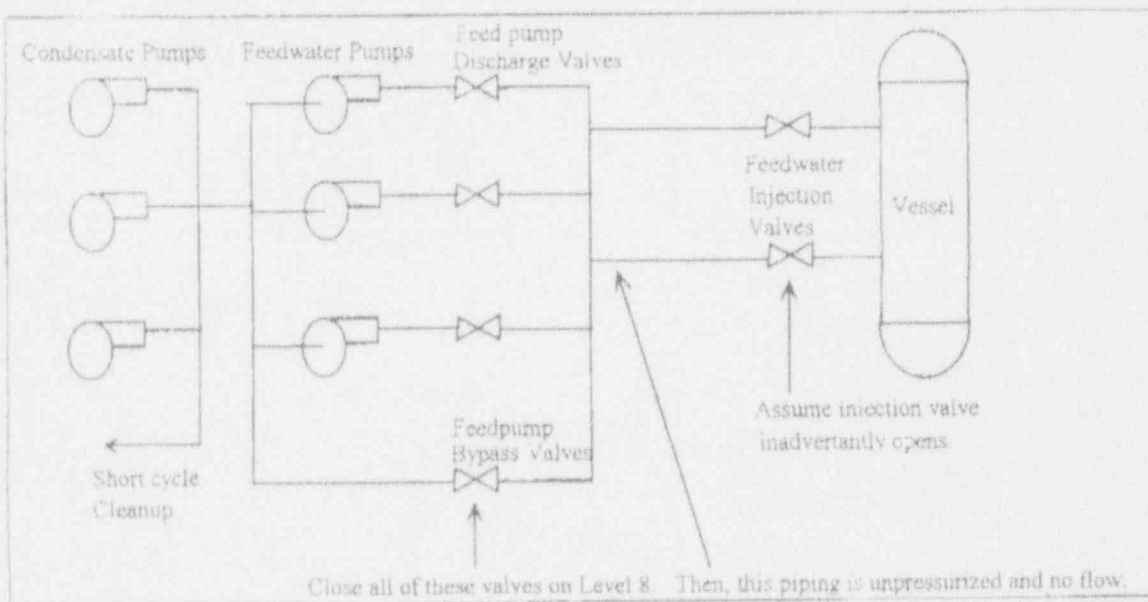

The attached markups show the changes to SSAR chapter 7.7.1.4 (9) (Interlocks) and Figures 7.7-8 and 7.7-9 to adopt this improvement. We plan to include these changes in Amendment 34.

flow control valve signal through a linearizing function generator and then to the feedpump flow control actuator.

In the single-element control mode, which is employed at lower feedwater flow rates, only a conditioned level error is used to determine the feedpump demand. The master level controller (proportional + integral) conditions the level error and sends it directly to the feedpump actuator linearizing function generator and then to the feedpump flow control actuator itself. When the reactor water inventory must be decreased, during very low steam flow rate conditions, the CUW System dump valve is controlled by the FWCS in single element control. Reactor water is dumped through the CUW System to the condenser.

Each feedpump flow control actuator can be controlled "manually" from the main control panel by selecting the manual mode for that feedpump. In manual mode, the operator may increase or decrease the demand that is sent directly to the linearizing function generator of the chosen feedpump flow control actuator.

(9) Interlocks

The level control system also provides interlocks and control functions to other systems. When the reactor water level reaches the Level 8 trip setpoint, the FWCS simultaneously annunciates a control room alarm, sends a trip signal to the Turbine Control System to trip the turbine generator, and sends trip signals to the Condensate, Feedwater and Condensate Air Extraction (CF&CAE) System to trip all feed pumps and to close the main feedwater discharge valves. This interlock is enacted to protect the turbine from damage from high moisture content in the steam caused by excessive carryover while preventing water level from rising any higher. *This interlock also prevents overpressurization of the vessel by isolating the condensate*

feed pump discharge valves

In the event that the feedwater pump discharge valves fail to close following the Level 8 trip signal, the FWCS automatically issues another signal to the CF&CAE System to trip all condensate pumps in order to avoid overpressurization of the vessel.

pumps from the vessel.

Upon detection of a loss of feedwater heating, the FWCS will send a signal to the Recirculation Flow Control System which will signal the Rod Control and Information System (RCIS) for initiation of automatic selected control rod run-in (SCRRI). This is done to minimize reactivity transient resulting from introduction of cold feedwater in such an event.

137C9504
 REVISIONS
 1 MB TORRES
 GENERAL DOCUMENT
 CHANGE NO. 0010
 ADDED NOTES 8/7/80
 BY DOME PRESS &
 DREW CHSC BUDDIS &
 CONTROL LOGIC LOSS
 OF 2N HEATING LOGIC
 CHG BY MB TORRES
 8/7/80

LOGIC OR ONE DMC TYPICAL OF AT THREE DMC'S IS SHOWN FOR REFERENCE PURPOSES ONLY. ANNUNCIATORS AND COMPUTER POINT SYMBOLS ARE SHOWN HERE. THESE OUTPUTS ARE ACTUALLY IMPLEMENTED BY VOICES AS SHOWN IN REFERENCE C31-1010.

DETAILED LOGIC IS TO ALLOW FOR VALVE STROKE TIME OF REP. RESEARCH VALVES AND CONDENSATE PUMPS. TRIP AT 1 SEC DELAY AFTER REACTOR WATER LEVEL EXCEEDS LEVEL 1.

THE FUNCTION SHOWN WITHIN EACH DMC IS PERFORMED BY INDEPENDENT MICROPROCESSOR NUMBER 1. ALL FUNCTIONS ARE PERFORMED BY MICROPROCESSOR NUMBER 1.

LOGIC FOR ATMS FEEDWATER RUMBACK SHOWN WITHIN DASHED LINES IS PERFORMED BY SAFETY SYSTEM LOGIC AND CONTROL LOGIC. IS FOR SSC ONLY AND TYPICAL FOR DIVISIONS B, D AND N.

SUPPLEMENTAL XXXXXXXX UNDER THE FOLLOWING DENOTES ARE TO BE USED IN CONNECTION WITH THIS DRAWING.

REFERENCE DESIGNATOR	DESCRIPTION
C31-1010	FEEDWATER CONTROL SYSTEM, ED
C81-1010	RECIRCULATION FLOW CONTROL SYSTEM, ED
N21-1010	CONDENSATE, FEEDWATER & CONDENSATE AIR EXTRACTION SYSTEM, PAIO
N21-1030	CONDENSATE, FEEDWATER & CONDENSATE AIR EXTRACTION SYSTEM, IB0
G31-1010	REACTOR WATER CLEANUP SYSTEM, PAIO
G31-1030	REACTOR WATER CLEANUP SYSTEM, IB0
921-1010	NUCLEAR BOILER SYSTEM, PAIO
B21-1030	NUCLEAR BOILER SYSTEM, IB0
C41-1010	PROCESS COMPUTER, ED
C81-1030	RECIRCULATION FLOW CONTROL SYSTEM, IB0
H11-4950	LEAN CONTROL ROOM PANEL, ARGENT
K32-1010	TURBINE CONTROL SYSTEM, ED
K31-1030	TURBINE CONTROL SYSTEM, IB0
C51-1010	NEUTRON MONITORING SYSTEM, ED

LOGIC OR ONE DMC TYPICAL OF AT THREE DMC'S IS SHOWN FOR REFERENCE PURPOSES ONLY. ANNUNCIATORS AND COMPUTER POINT SYMBOLS ARE SHOWN HERE. THESE OUTPUTS ARE ACTUALLY IMPLEMENTED BY VOICES AS SHOWN IN REFERENCE C31-1010.

LOGIC FOR ATMS FEEDWATER RUMBACK SHOWN WITHIN DASHED LINES IS PERFORMED BY SAFETY SYSTEM LOGIC AND CONTROL LOGIC. IS FOR SSC ONLY AND TYPICAL FOR DIVISIONS B, D AND N.

SUPPLEMENTAL XXXXXXXX UNDER THE FOLLOWING DENOTES ARE TO BE USED IN CONNECTION WITH THIS DRAWING.


REFERENCE DESIGNATOR	DESCRIPTION
C31-1010	FEEDWATER CONTROL SYSTEM, ED
C81-1010	RECIRCULATION FLOW CONTROL SYSTEM, ED
N21-1010	CONDENSATE, FEEDWATER & CONDENSATE AIR EXTRACTION SYSTEM, PAIO
N21-1030	CONDENSATE, FEEDWATER & CONDENSATE AIR EXTRACTION SYSTEM, IB0
G31-1010	REACTOR WATER CLEANUP SYSTEM, PAIO
G31-1030	REACTOR WATER CLEANUP SYSTEM, IB0
921-1010	NUCLEAR BOILER SYSTEM, PAIO
B21-1030	NUCLEAR BOILER SYSTEM, IB0
C41-1010	PROCESS COMPUTER, ED
C81-1030	RECIRCULATION FLOW CONTROL SYSTEM, IB0
H11-4950	LEAN CONTROL ROOM PANEL, ARGENT
K32-1010	TURBINE CONTROL SYSTEM, ED
K31-1030	TURBINE CONTROL SYSTEM, IB0
C51-1010	NEUTRON MONITORING SYSTEM, ED

TABLE OF CONTENTS

SH	SYMBOL	DESCRIPTION
1		NOTES, REFERENCE DOCUMENTS
2		FEEDWATER CONTROL SYSTEM INTERLOCKS
3		MODE SELECTION LOGIC
4		REP A INTERLOCKS AND CONTROLLER REINITIALIZATION
5		REP B INTERLOCKS AND CONTROLLER REINITIALIZATION
6		REP C INTERLOCKS AND CONTROLLER REINITIALIZATION
7		REP A MANUAL/AUTO STATION LOGIC
8		REP B MANUAL/AUTO STATION LOGIC
9		REP C MANUAL/AUTO STATION LOGIC
10		LECY MANUAL/AUTO STATION LOGIC
11		DUMP VALVE FLOW CONTROL MANUAL/AUTO STATION LOGIC
12		GJM DUMP VALVE LEVEL CONTROL MANUAL/AUTO STATION SETPOINT CHANGE LOGIC
13		GAIN CHANGE LOGIC
14		ACTIVATOR LOGIC, LOGIC RUMBACK LOGIC, DMC CONTROLLER FAILURE
15		LOSS OF FEEDWATER HEATING LOGIC

EMPLOYER CLASS CODE
 SAFETY RELATED
 THIS FIELD IS ON CONTROLS & SAFETY MATERIALS ONLY
 RELATED ITEM CLASS CODE
 GENERAL ELECTRIC
 DEPT. LOC. 5033 8550
 DCC TYPE: ED0
 FEEDWATER CONTROL SYSTEM
 TYP. CERE. PROJ. 137C9504
 DATE 5 MAY 1983
 DRAWN BY DIB 5248
 CHECKED BY C 1 003
 10


Page 1 of Fig. 7.7-8

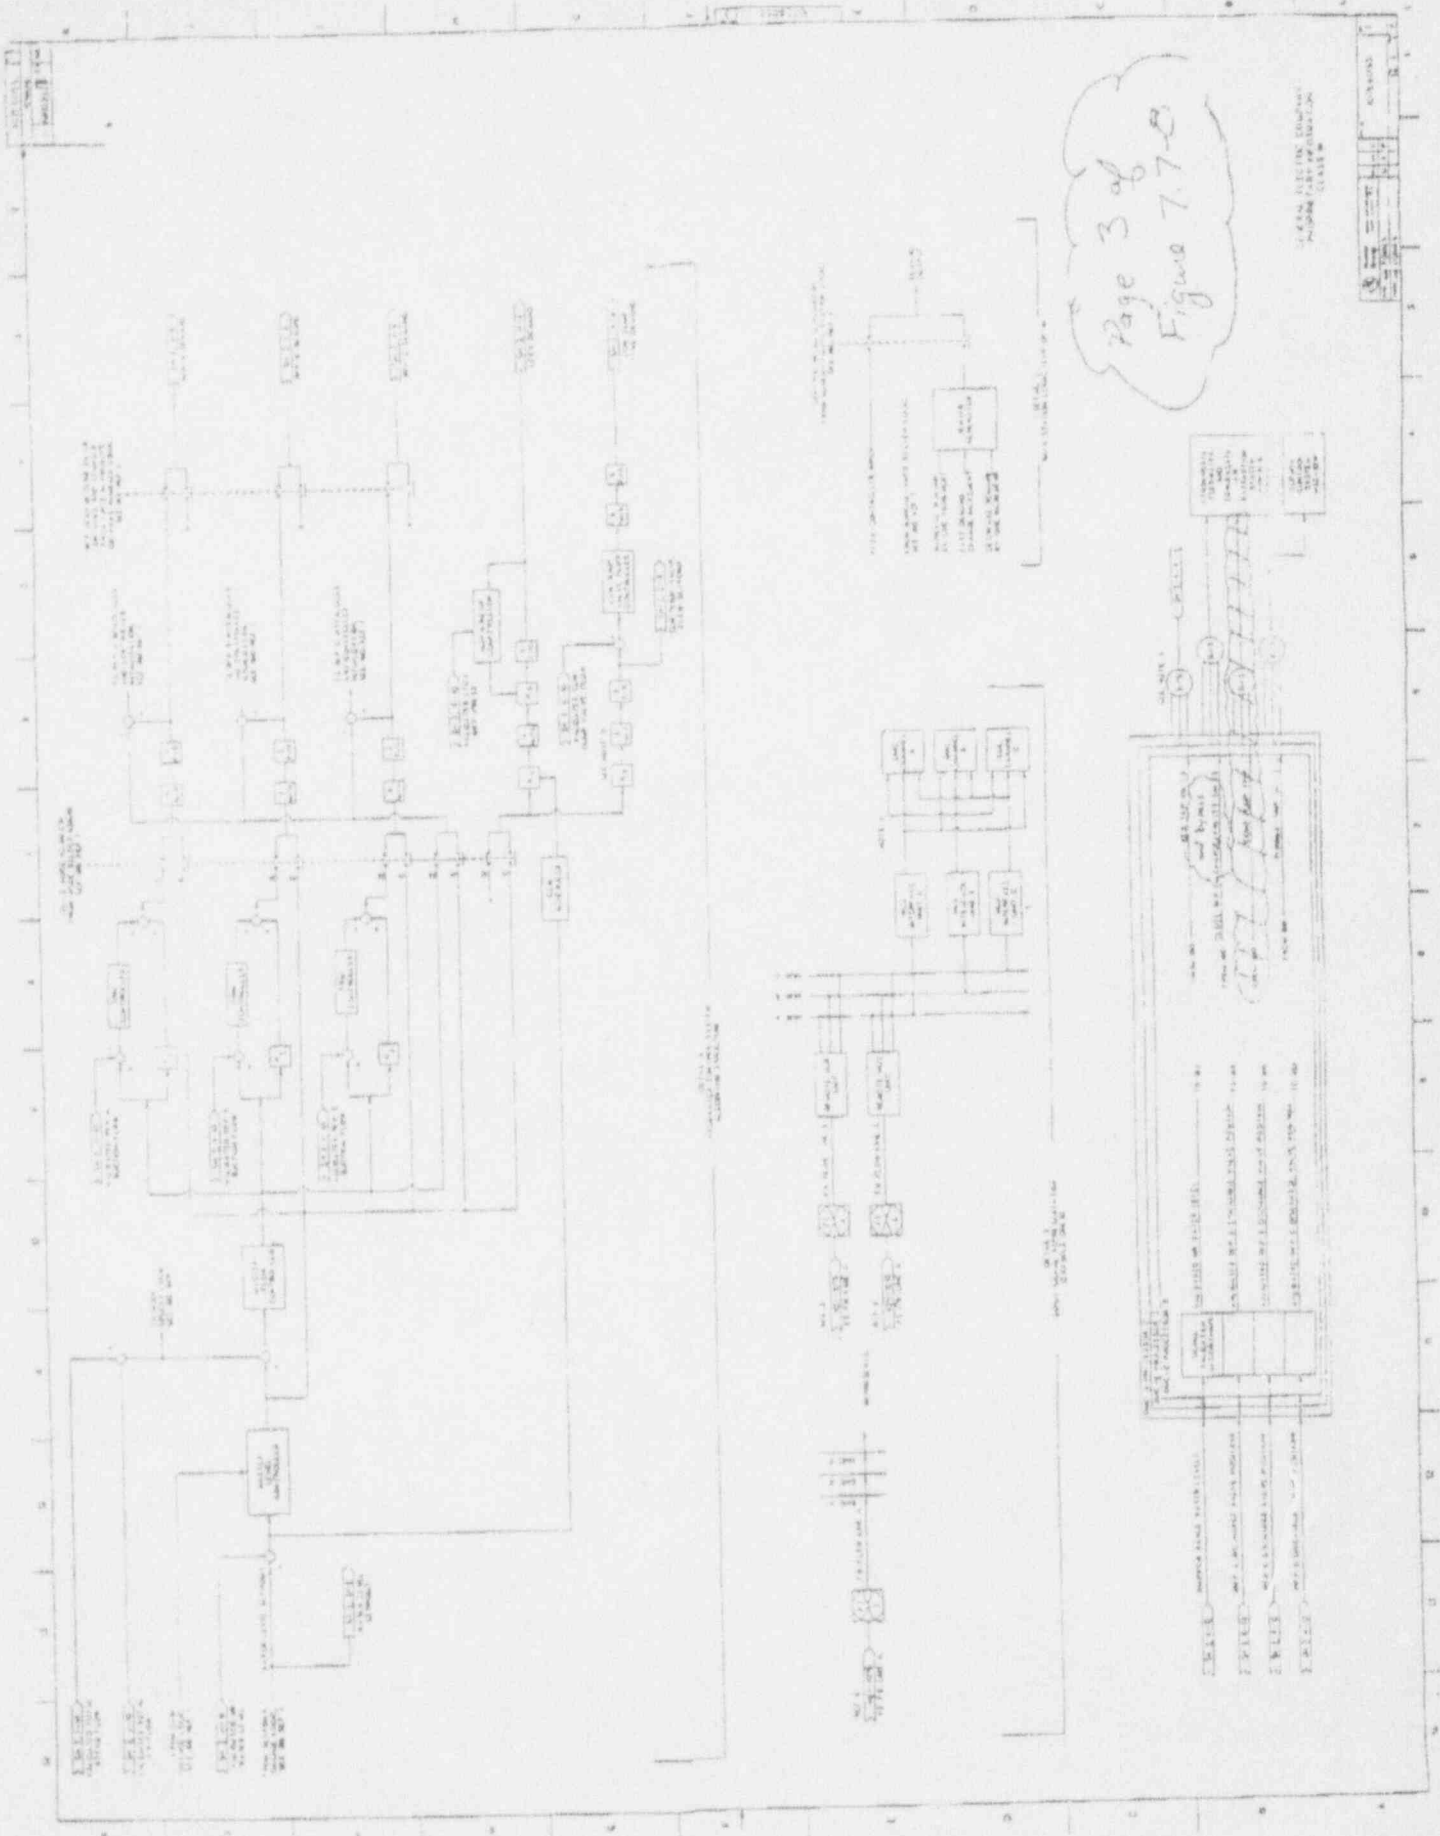

Page 3 of
Figure 7.7-B


13 FEB 64 11:29:53 P. PICHLER JW HOWE

Page 2
of Figure 77-9

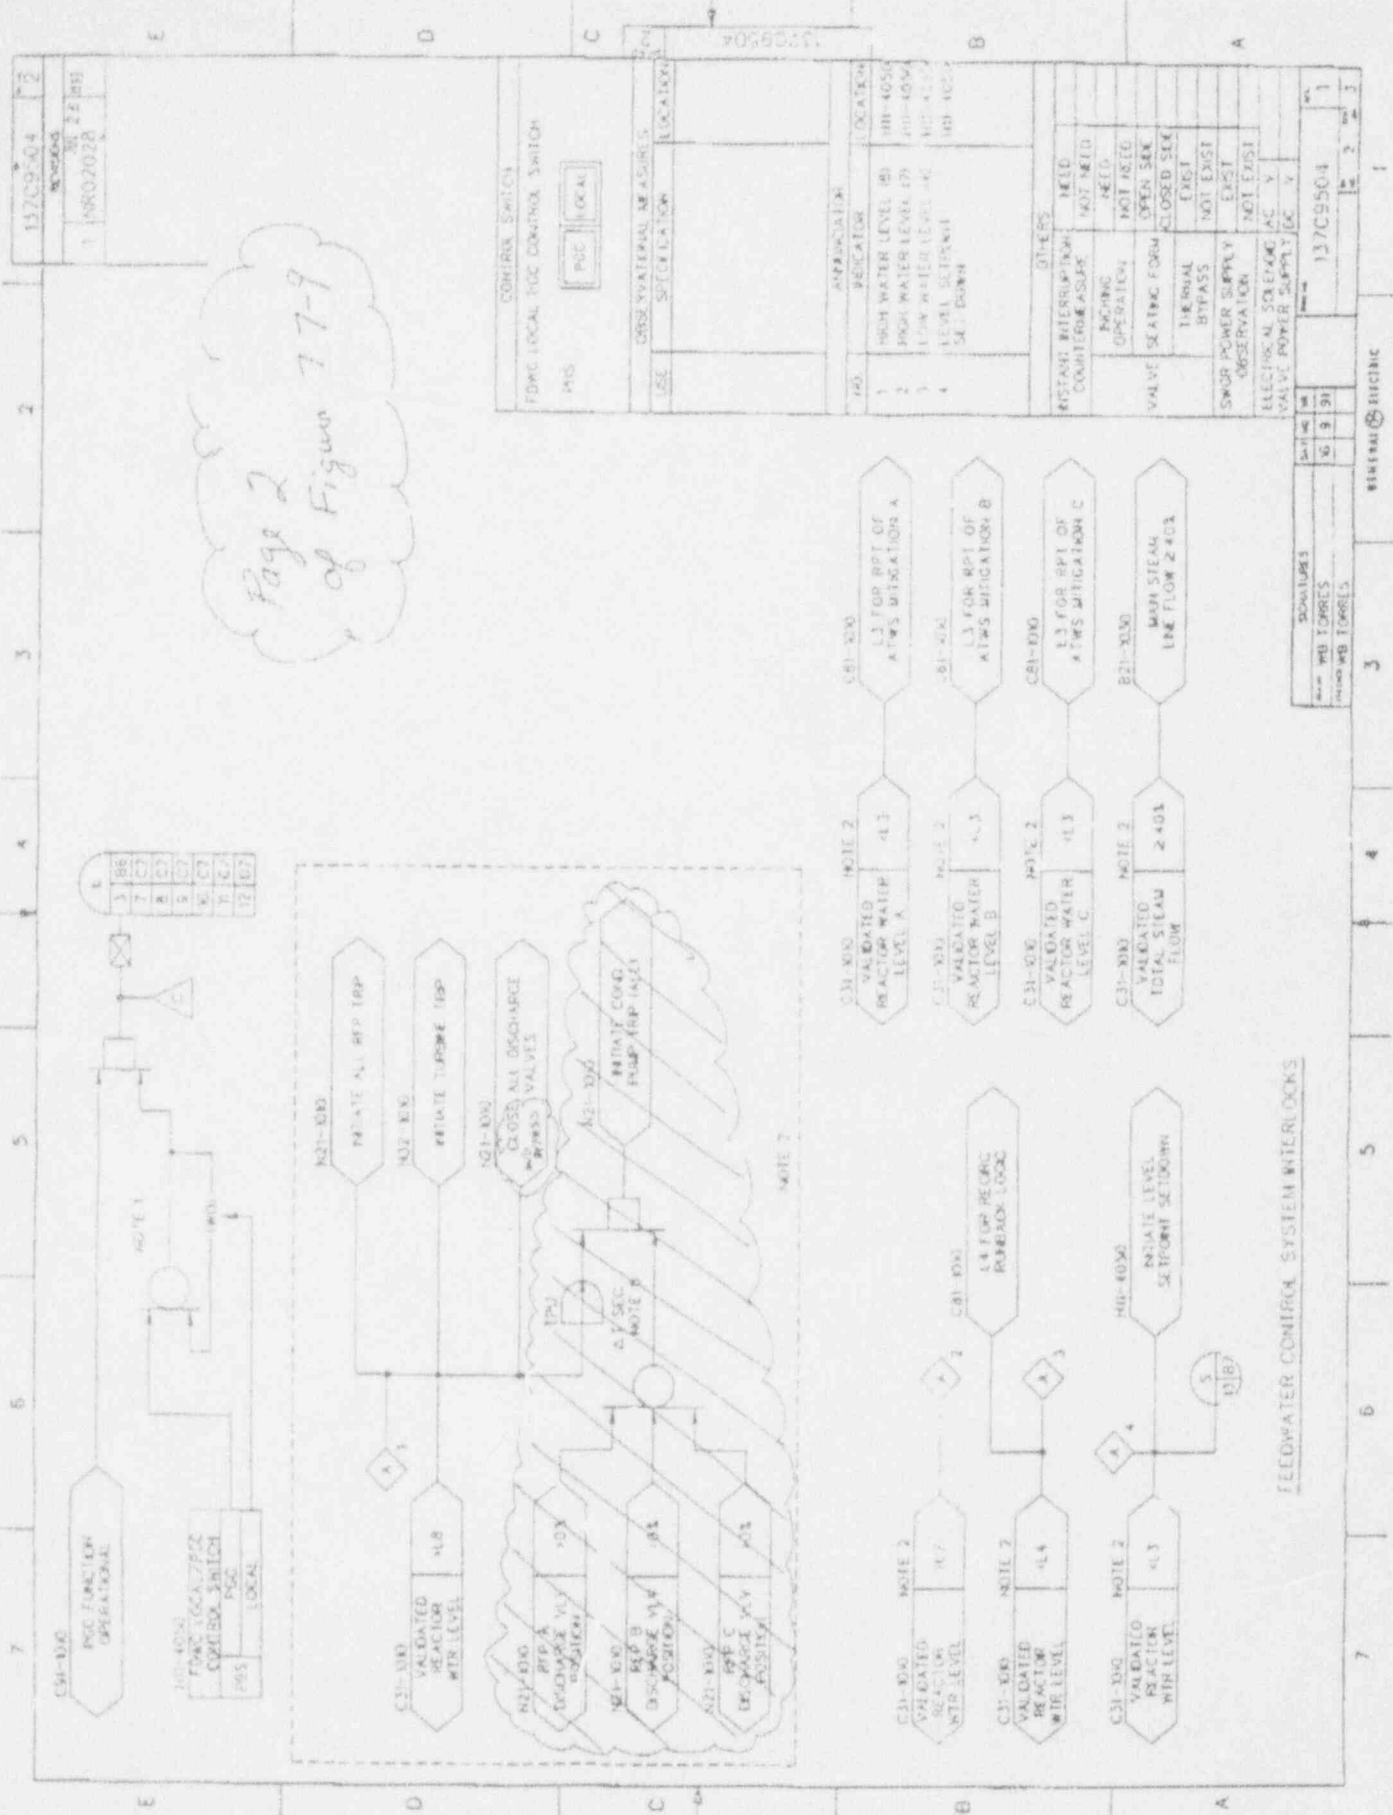

NO.	APPROPRIATION	LOCATION
1	HIGH WATER LEVEL (H)	H-10-100
2	HIGH WATER LEVEL (H)	H-10-100
3	LOW WATER LEVEL (L)	H-10-100
4	LEVEL SETPOINT SET DOWN	H-10-100

NO.	APPROPRIATION	LOCATION
OTHERS		
	RESTRICTION INTERRUPTOR	FIELD
	COUNTERMEASURE	NOT FIELD
	INITIATION	FIELD
	OPERATION	NOT FIELD
	VALVE SEATING FORM	OPEN SET
		CLOSED SET
	THERMAL BYPASS	FIELD
	SWGR POWER SUPPLY	NOT FIELD
	OBSERVATION	NOT FIELD
	ELECTRICAL SOLENOID	FIELD
	VALVE POWER SUPPLY	FIELD

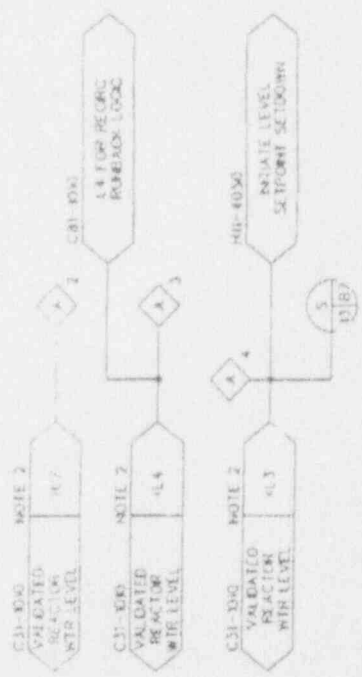

FEEDWATER CONTROL SYSTEM INTERLOCKS

NO.	VALUES	UNITS
1	10	PSI
2	5	PSI
3	10	PSI

GENERAL ELECTRIC

< TRANSACTION REPORT >

03-16-1994(FRI) 10:31

[RECEIVE]

NO.	DATE	TIME	DESTINATION STATION	PG.	DURATION	MODE	RESULT
935	3-16	10:27	408 925 1687	6	0'03'10"	NORM.E	OK
				6	0'03'10"		