

PROCEDURES, LICENSE AND SAFETY ANALYSIS REPORT

FOR

CHEM-NUCLEAR SYSTEMS, INC.

CNS 6-101

TYPE A RADWASTE SHIPPING CASK

Chem-Nuclear systems, Inc.

Corporate/Western Operations
P.O. Box 1866
Bellevue, WA 98009

March 1, 1983

TABLE OF CONTENTS

	Page
1.0 GENERAL INFORMATION	1
1.1 Introduction	1
1.2 Package Description	1
1.3 Appendix - CNS 6-101 Shipping Cask Drawing	2
2.0 STRUCTURAL EVALUATION	3
2.1 Structural Design	3
2.2 Weights and Centers of Gravity	3
2.3 Mechanical Properties of Materials	4
2.4 General Standards for All Packages	4
2.5 Standards for Type B and Large Quantity Packaging	4
2.6 Normal Conditions of Transport	5
2.7 Check Hypothetical Accident Conditions	12
2.8 Appendix	13
3.0 Thermal	18
4.0 Containment	18
5.0 Shielding Evaluation	18
6.0 Criticality Evaluation	18
7.0 Operating Procedures	19
7.1 Procedure for Loading the Package	19
7.2 Procedure for Unloading the Cask	20
8.0 Acceptance Tests and Maintenance Program	21

1.0 GENERAL INFORMATION

1.1 Introduction

This Safety Analysis Report describes a reusable shipping package designed to protect radioactive material during normal conditions of transport. The package is designated as the Model CNS 6-101 package.


1.2 Package Description

1.2.1 Packaging

The container is an end loaded lead shielded steel rectangular box for low specific activity radioactive material held in secondary containers. The container is constructed of 4-inch thick steel walls welded to form a 34-inch wide by 40-inch high by 13-foot long cavity. One inch thick lead sheets are bonded to 1/4-inch steel plates mounted on the interior of the 4-inch thick steel plates along part of the sides and back. Positive closure of the 4-inch thick by 38-inch by 48-inch hydraulically actuated door is accomplished with twelve (12), 1.5-inch bolts. Four (4) mounting feet are welded to the cask bottom, and four (4) lifting lugs are welded to sides along the top. The package gross weight is 58,400 pounds.


1.2.2 Contents of Packaging

The packaging is for the shipment of solid and solidified waste, meeting the requirements for low specific activity radioactive materials, in secondary containers which meet the requirements for Type A (49 CFR 173.389(j)) packaging. The secondary container is secured within the container cavity by means of shoring material as required. The maximum weight of the contents, secondary containers and shoring will not exceed 6,000 pounds.

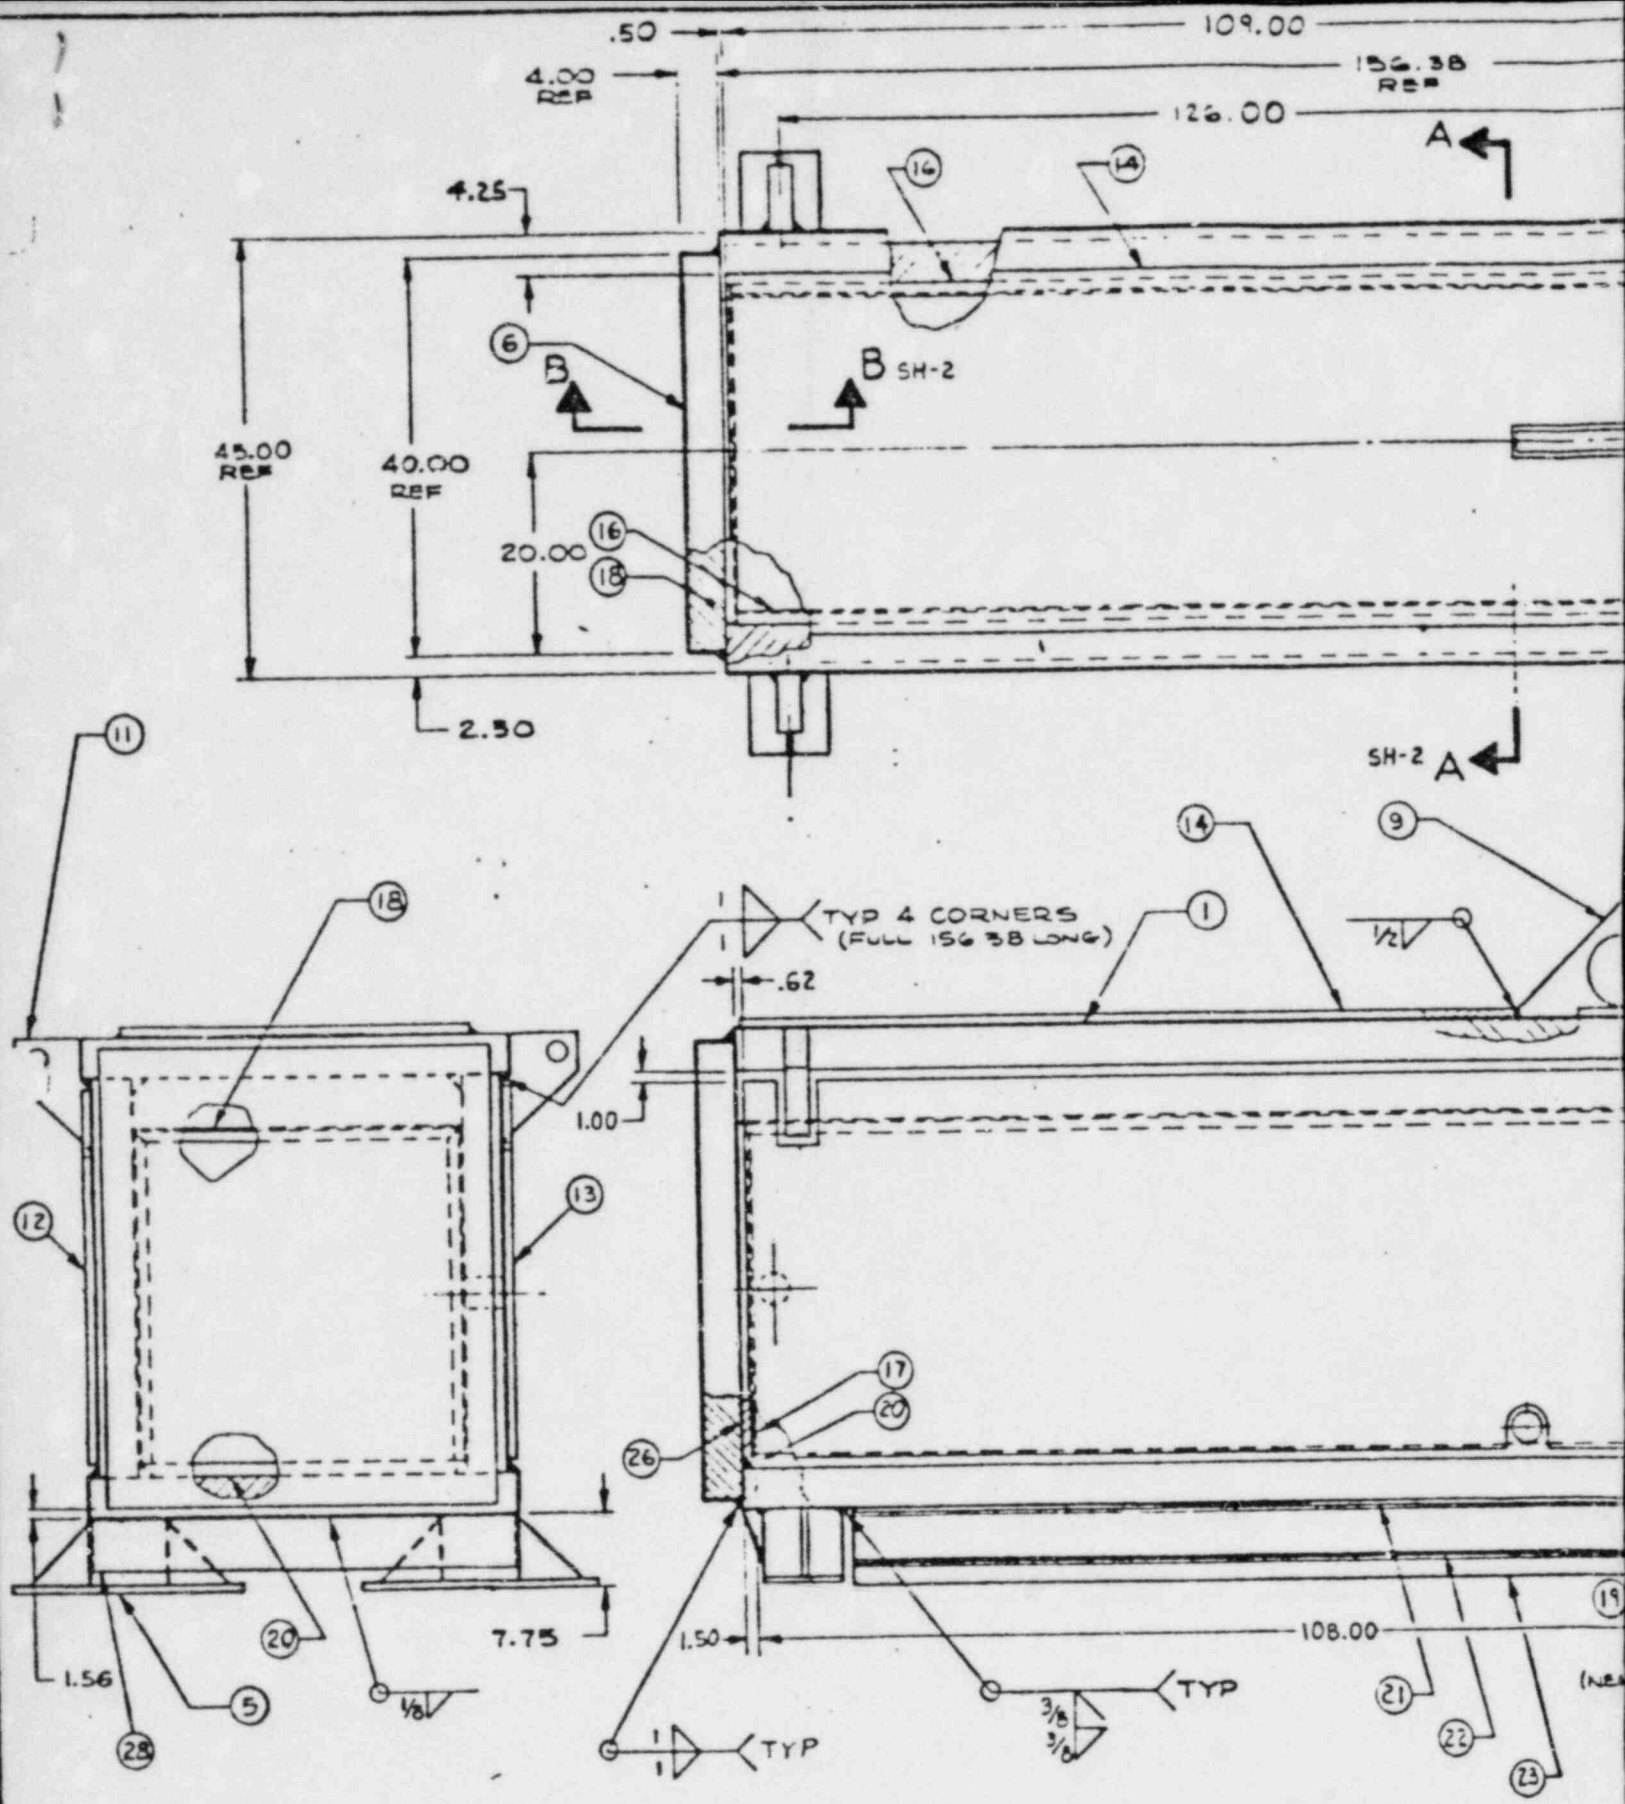


NOTES:

- 1. ITEMS 10 AND 7 TO BE IN ITEM NO.
- 2. WELDING PROCEDURES & WELDS PER ASME SECTION 9.
- 3. ITEMS 24, 25 & 26 TO HAVE TO 1/4" STEEL PLATES.

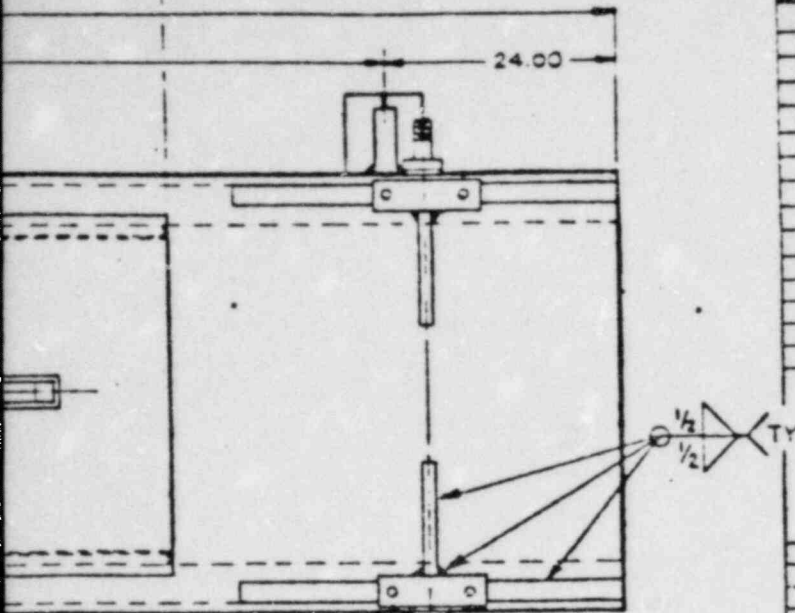


ITEM	DESCRIPTION	WEIGHT	QTY	
1	1 TOP PLATE 45.00 X 50.38 X 4.00	7966	1	
2	2 BOTTOM PLATE 45.00 X 50.38 X 4.00	7966	1	
3	2 SIDE PLATE RIGHT 41.00 X 15.38 X 4	725	1	
4	2 SIDE PLATE LEFT 41.00 X 15.38 X 4	725	1	
5	4 FOOT MOUNTING	364	4	
6	1 REAR PLATE 40.00 X 46.00 X 4.00	2383	1	
7	2 SUPPORT BEARING	101.5	203	2
8	4 GUSSET	20	40	2
9	1 PLATE ANCHOR	112	1	
10	1 STUD, PIVOT LOWER ARM	9	18	2
11	1 LUG, LIFTING	25	100	4
12	1 SHIELD PLATE R.H.	1,420	1	
13	1 SHIELD PLATE L.H.	1,425	1	
14	1 SHIELD PLATE TOP	1,111	1	
15	1 SHIELD PLATE FRONT SIDE	263	52	2
16	1/2 1 1/2 X 1 1/2 X 1/4 = 106.50 LG.	21	42	2
17	1/2 1 1/2 X 1 1/2 X 1/4 = 34.75 LG.	6.5	26	4
18	1/2 1 1/2 X 1 1/2 X 1/4 = 34.50 LG.	6.7	1	1
19	1 BAR 3/8 X 1 1/4 = 106.50 LG.	7.1	14.2	2
20	1 BAR 3/16 X 1 1/4 = 34.50 LG.	2.3	4	2
21	1 BAR 3/8 X 3 1/2 = 117.00 LG.	43.5	87.0	2
22	1/2 5 X 10.0 = 116.00 LG.	96.7	193.4	2
23	1/2 2 1/2 X 2 1/2 X 5/16 = 117.00 LG.	49.8	99.6	2
24	1 LEAD SHIELD R.H.	1,825	1	
25	1 LEAD SHIELD L.H.	1,820	1	
26	1 LEAD SHIELD REAR	453	1	
27	1 GUARD FRONT	9.5	1	
28	1 GUARD REAR	22.5	1	

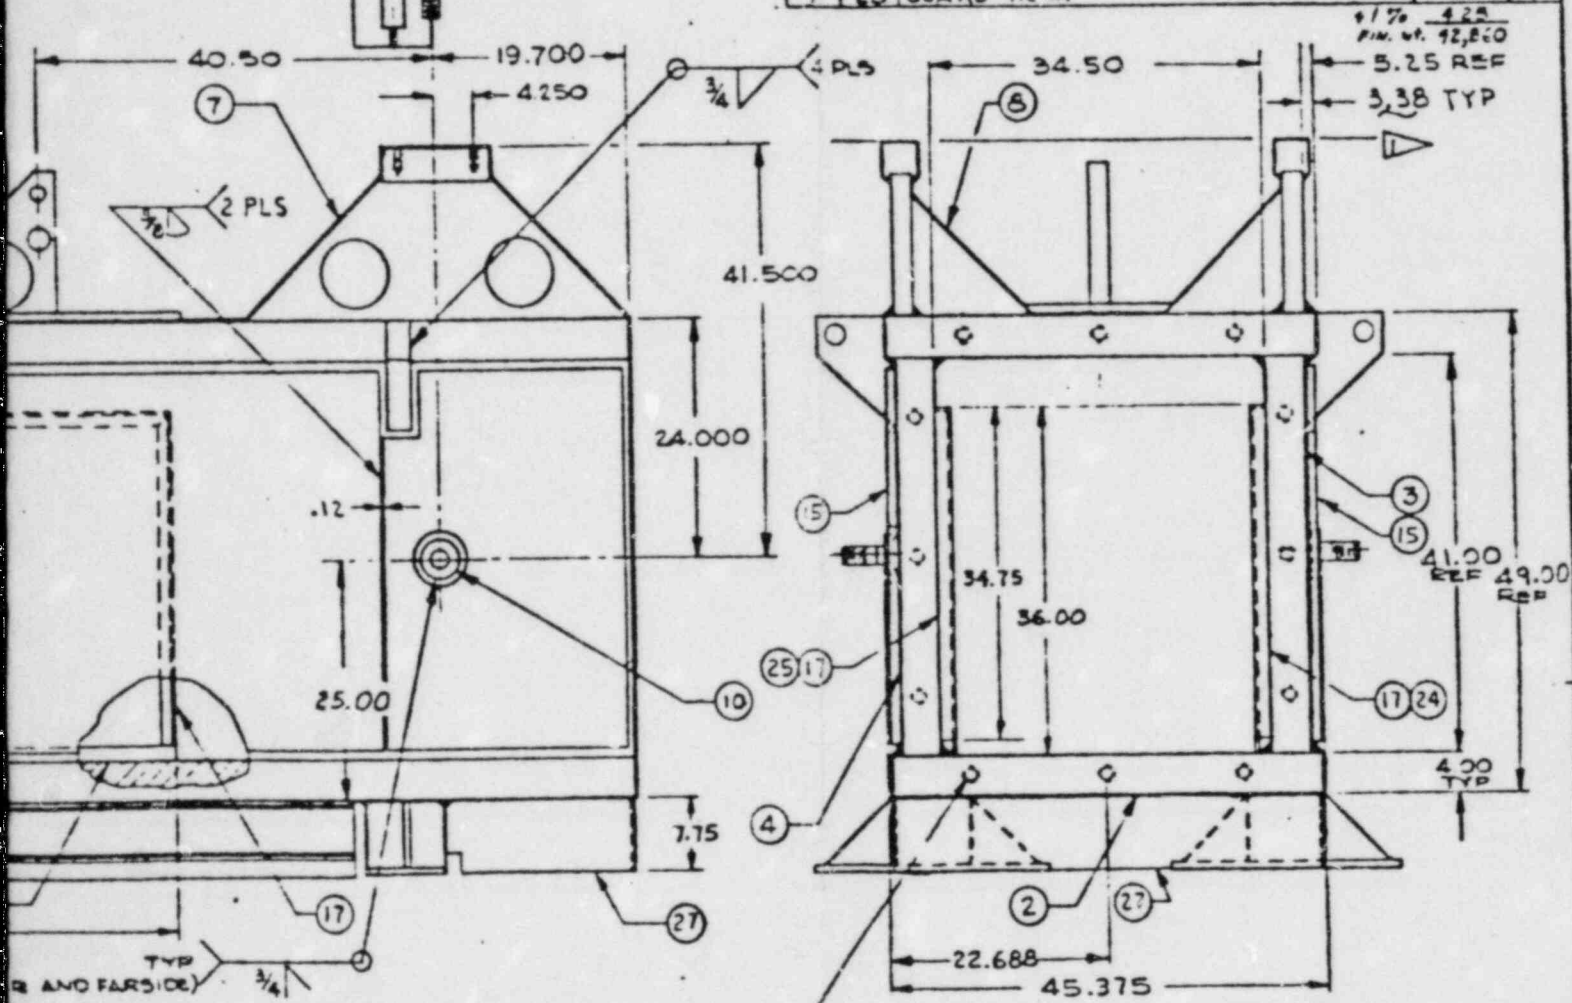


LINE WITH MATCHING
 R QUALIFICATIONS
 LEAD SHEETS BONDED

APPROVED K. HETTMAN 6/17 R. H.	CHEM-NUCLEAR SYSTEMS, INC. SHIELD, CONTAINER RADWASTE CARRIER I 2000-D-201 E 1/10 107 43,860 117
STL. ASTM-A36	42,800

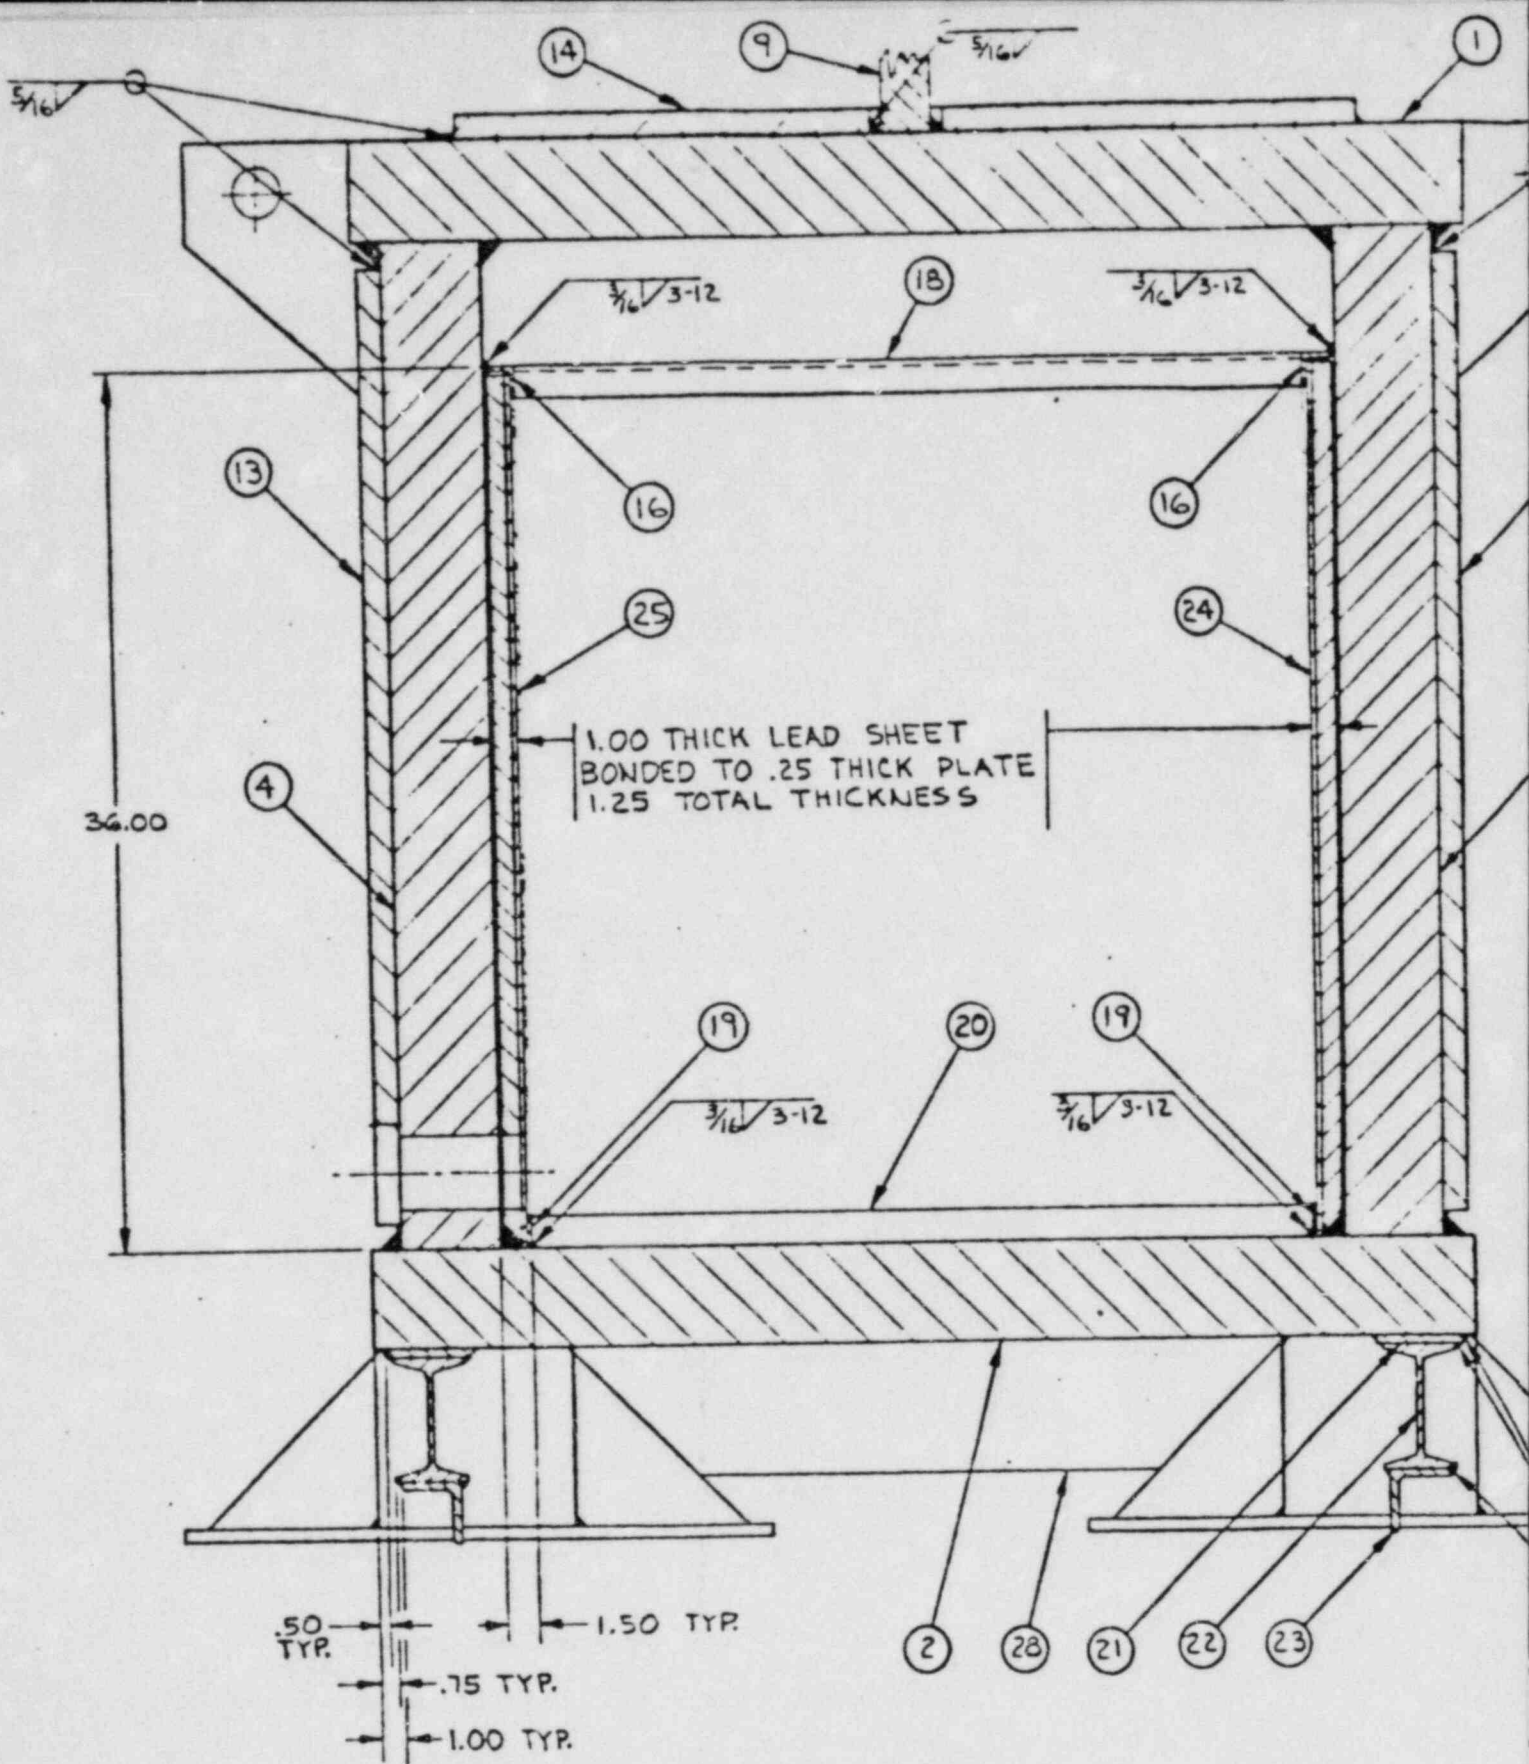


SECTION A-A sm-1

REVISIONS			
ZONE	LTN	DESCRIPTION	DATE
B		ADDED NEW SH 2 TO AS DW LT REV.	11-3-78

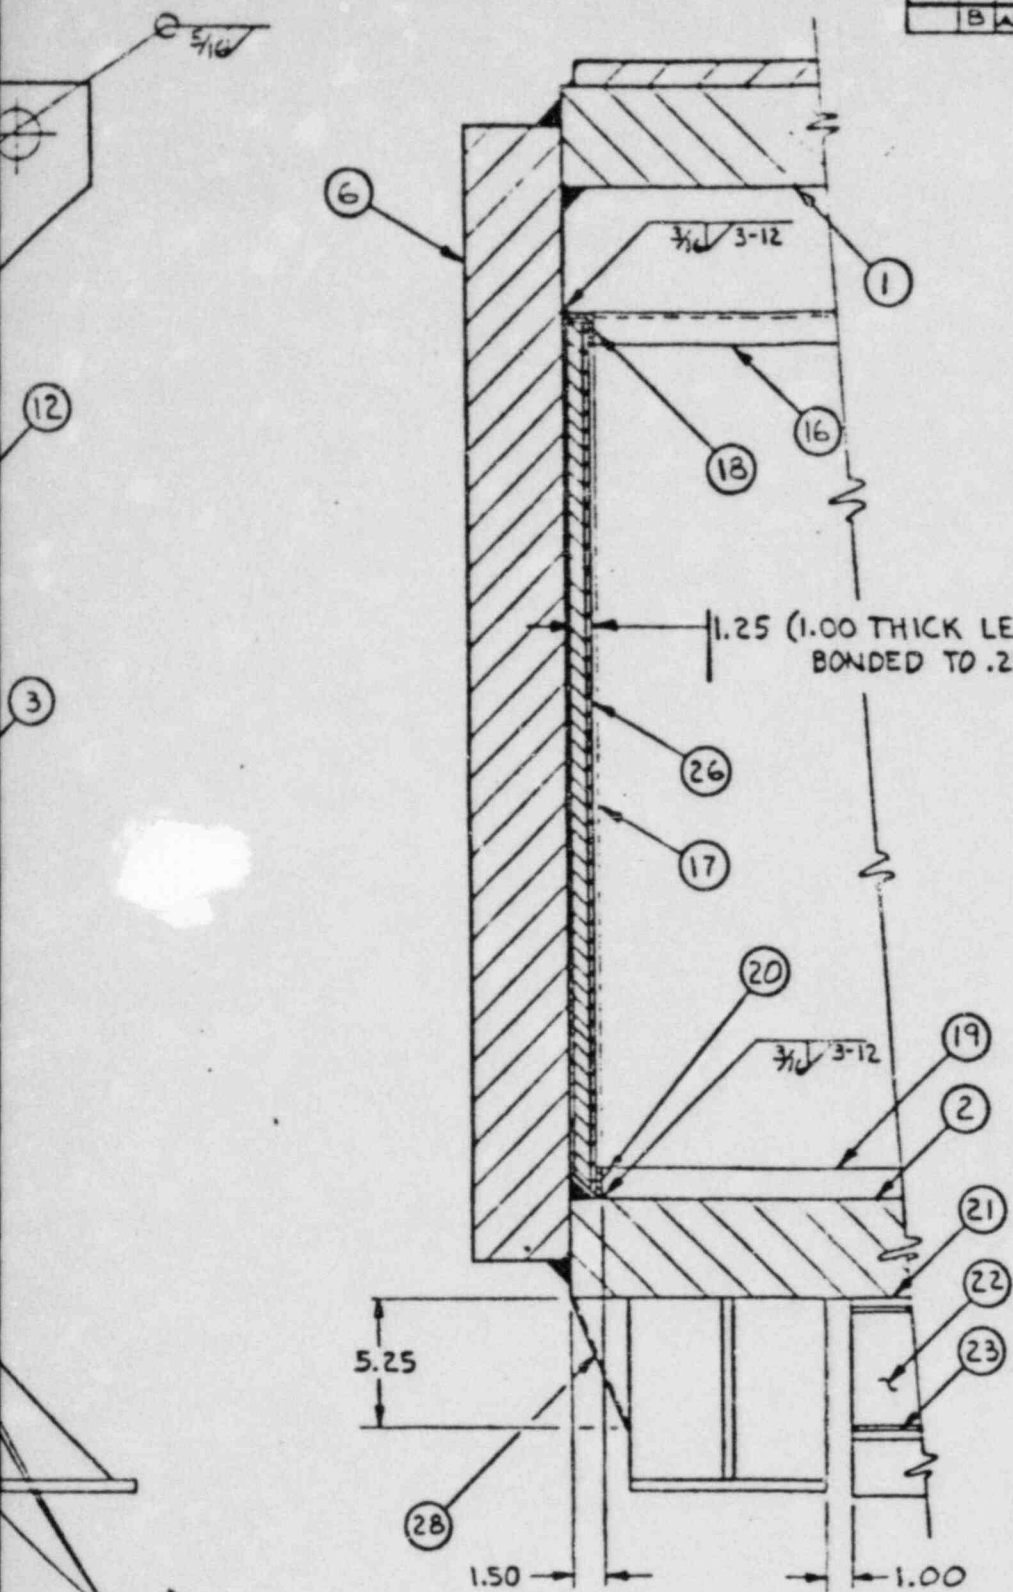


SECTION B-B SH-1



ITEM	QTY	CODE IDENT	NUMERICAL OR DESCRIPTION	PART NO
PARTS LIST				
UNLESS OTHERWISE SPECIFIED DIMENSIONS ARE IN INCHES FINISH: UNLESS TOLERANCES ARE SHOWN MATERIAL:			CONTRACT NO. TANI 11-3-78 CHECKED BY: K. WETTMAN 11-9-78 DATE:	CHEM-NUCLEAR SYSTEMS, INC. SHIELD, CONTAINER RADWASTE CARRIER I
NEXT ASSEMBLY	USED FOR	FINISH	SIZE	REV
			D · 2000-D-201	B
APPLICATION			SCALE 1/4" = 1"	SHEET 1 OF 1

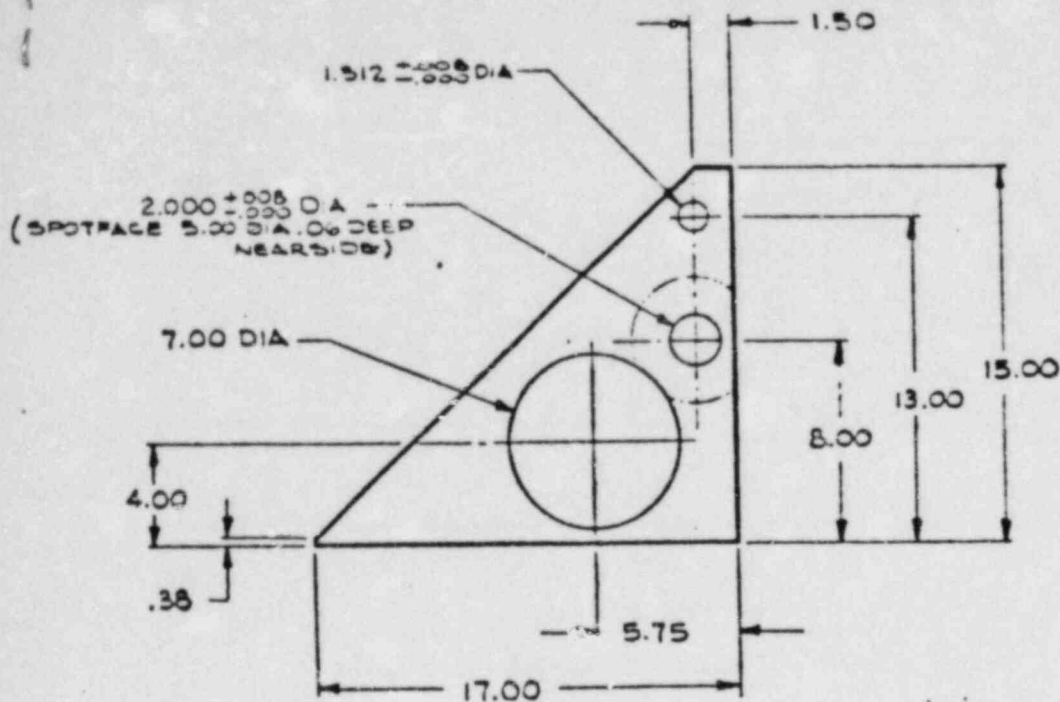


ITEM 9
 MATL; HRS 2.00 THICK
 1 REQD
 (SCALE 1/4)

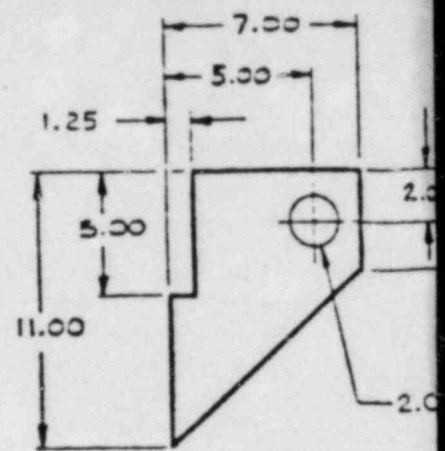


ITEM 11
 MATL; HRS 2.00 THICK
 4 REQD
 (SCALE 1/4)

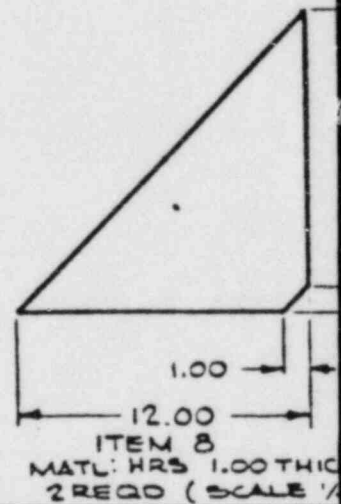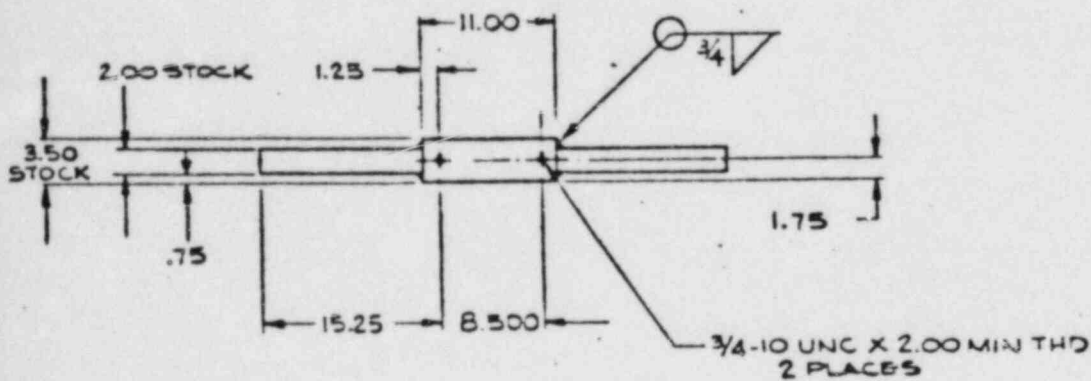

ITEM 8
 MATL; HRS 1.00 THICK
 2 REQD (SCALE 1/4)

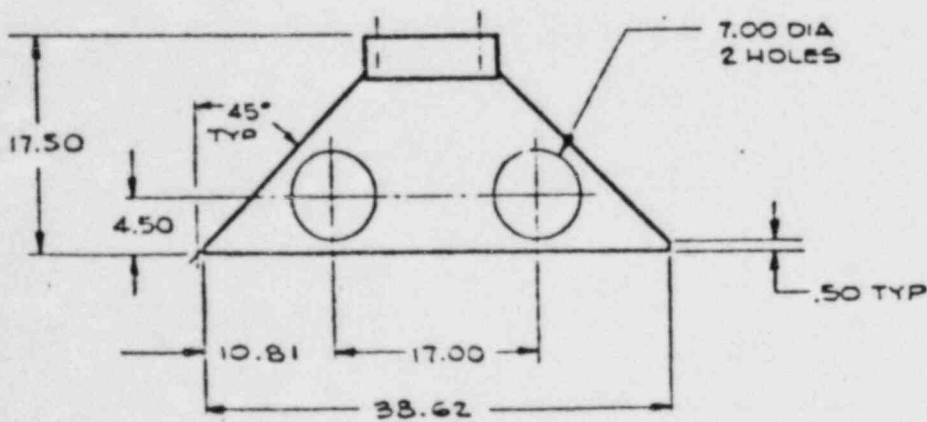


ITEM 7
 MATL; HRS 2.00 THK PLATE + 550 X 550 BAR
 2 REQD
 (SCALE 1/8)

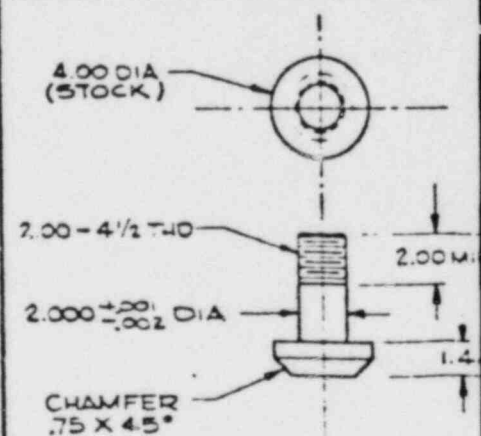

ITEM 10
 MATL; HRS 4" DIA RD
 2 REQD
 (SCALE 1/4)


4.00
 O DIA

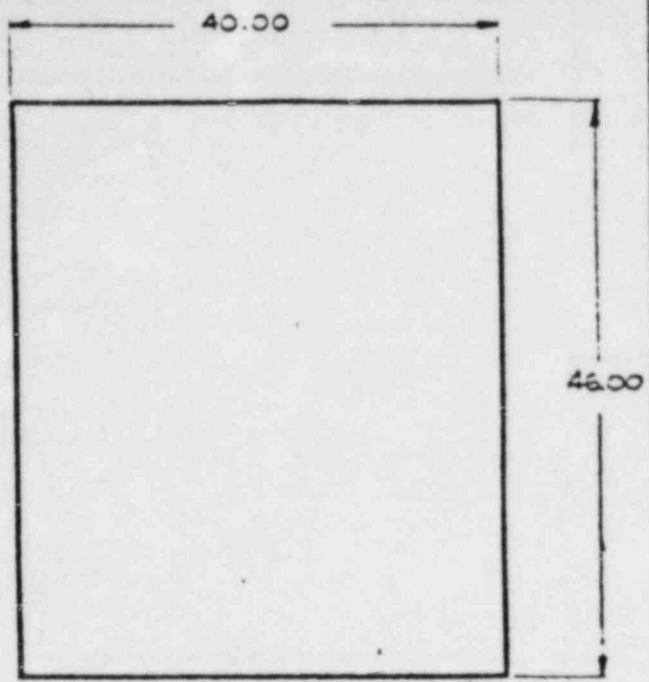

ITEM 6
 MATL; HRS 4.00 THICK
 1 REQD
 (SCALE 1/8)

REV. 5 24 63	DATE 4 22 63
ZONE 18	DATE 4 22 63
REVISED AS BUILT	3 4 1963

12.00
 1.00

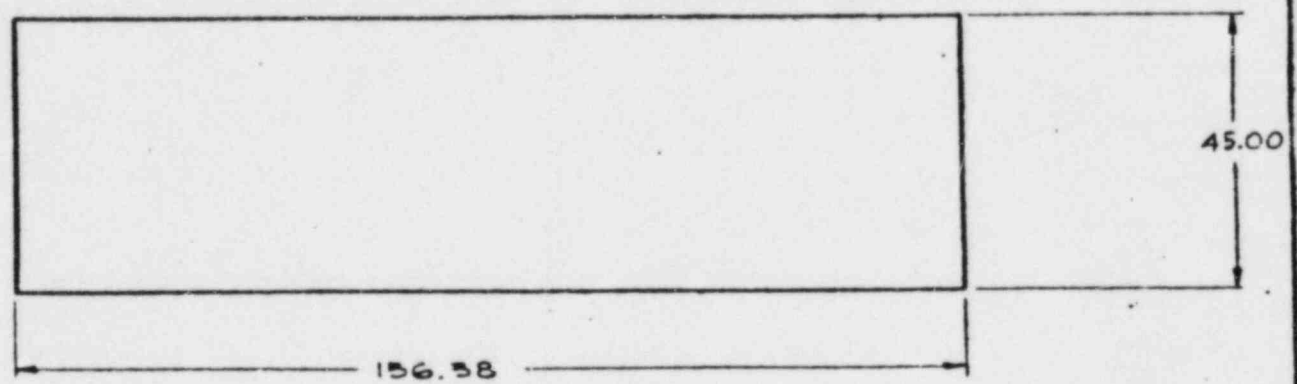


ITEM 1 AND ITEM 2
 MATL; HRS 4.00 THICK
 1 EACH REQD
 (SCALE 1/16)


K
 2)

5.70


DATE	NO	REVISION	BY
09 030			
HRS ASTM A 36 H. HETTMAN 1/1/63 AT		CHEM-NUCLEAR SYSTEMS, INC. DETAILS, SHIELD CONTAINER RADWASTE CARRIER I	
D		2000-D-201 B	
NOTED		1-3-	

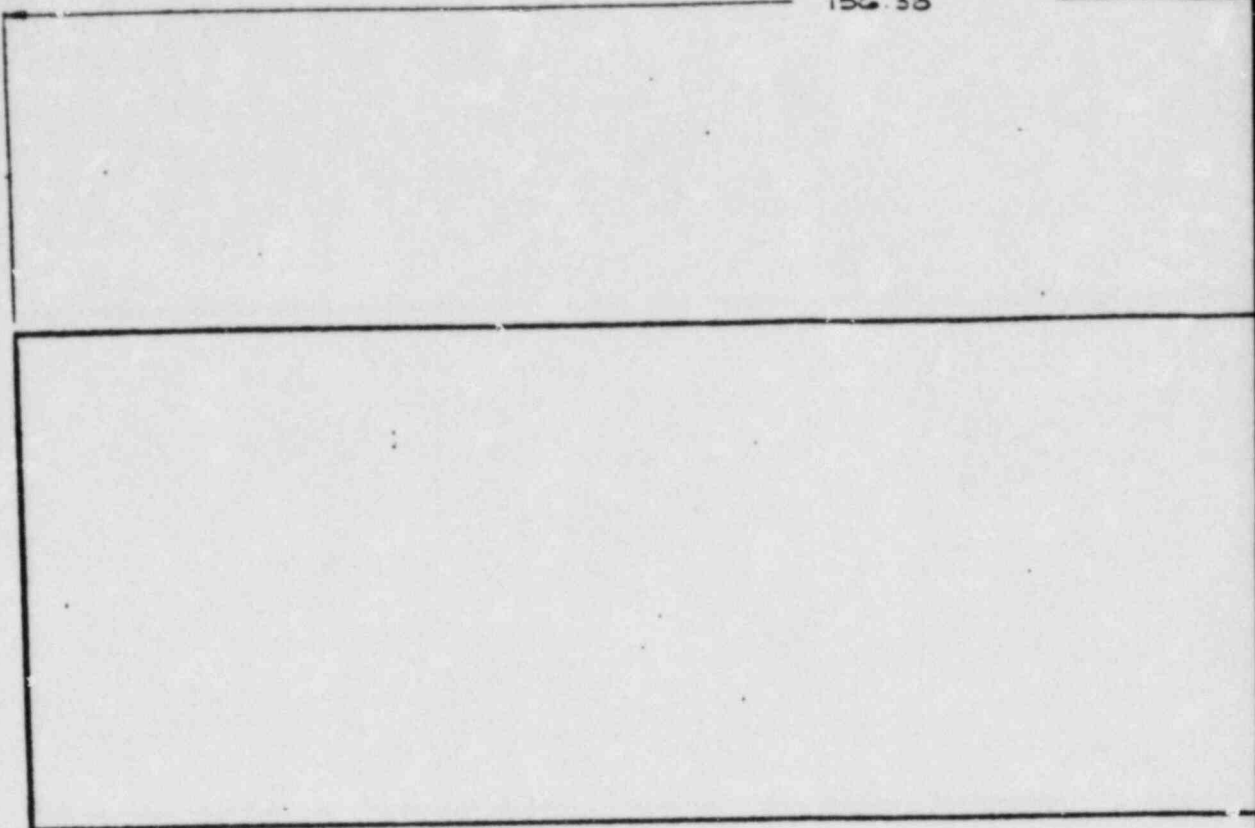





ITEM 3
 MATL: HRS 4.00 THK
 1 REQD (SCALE 1/8)

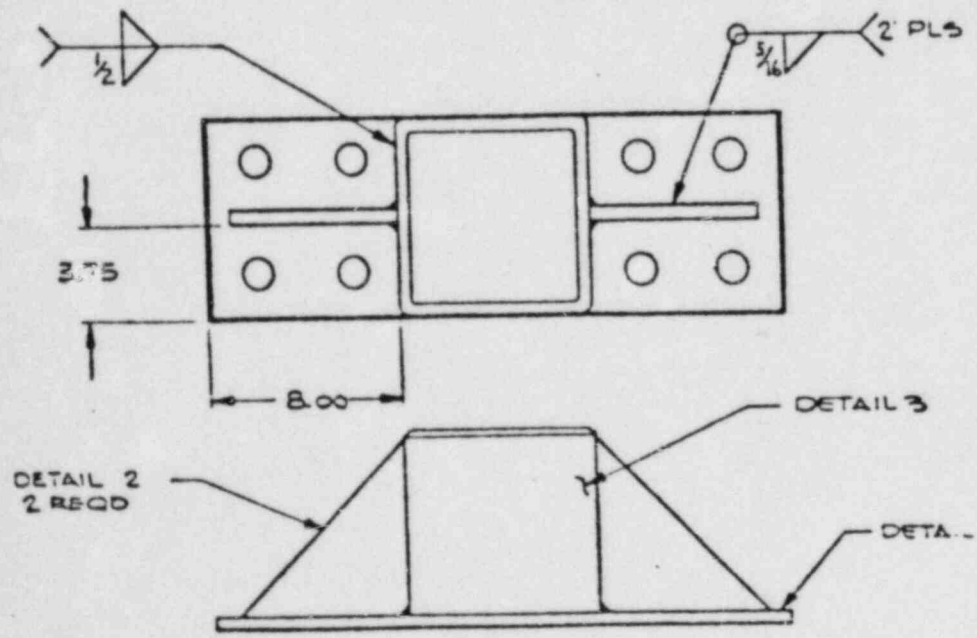


ITEM 5
 MATL: NOTED
 4 REQD
 (SCALE 1/4)

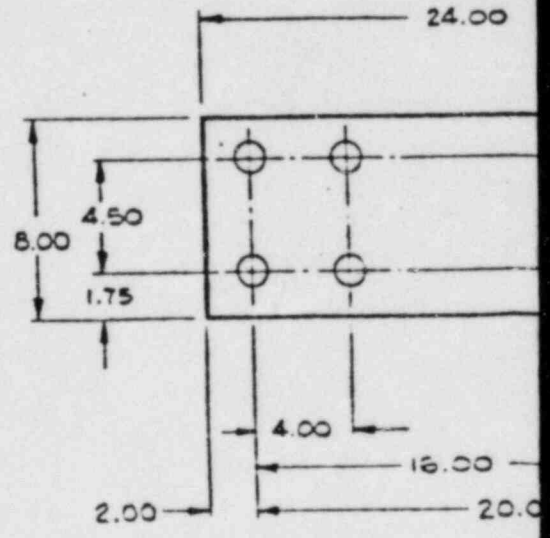

DETAIL 1
 MATL: HRS .50 T
 1 REQD
 (SCALE 1/4)

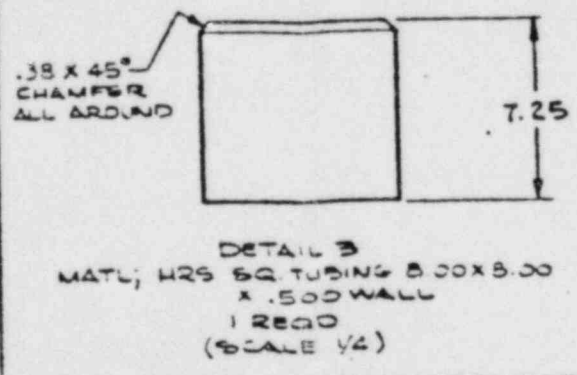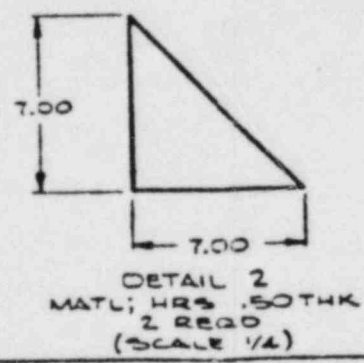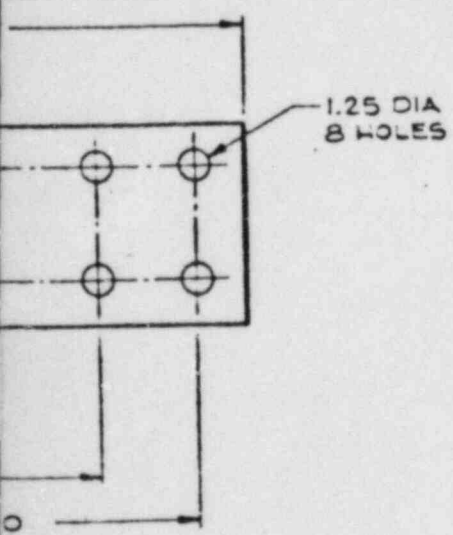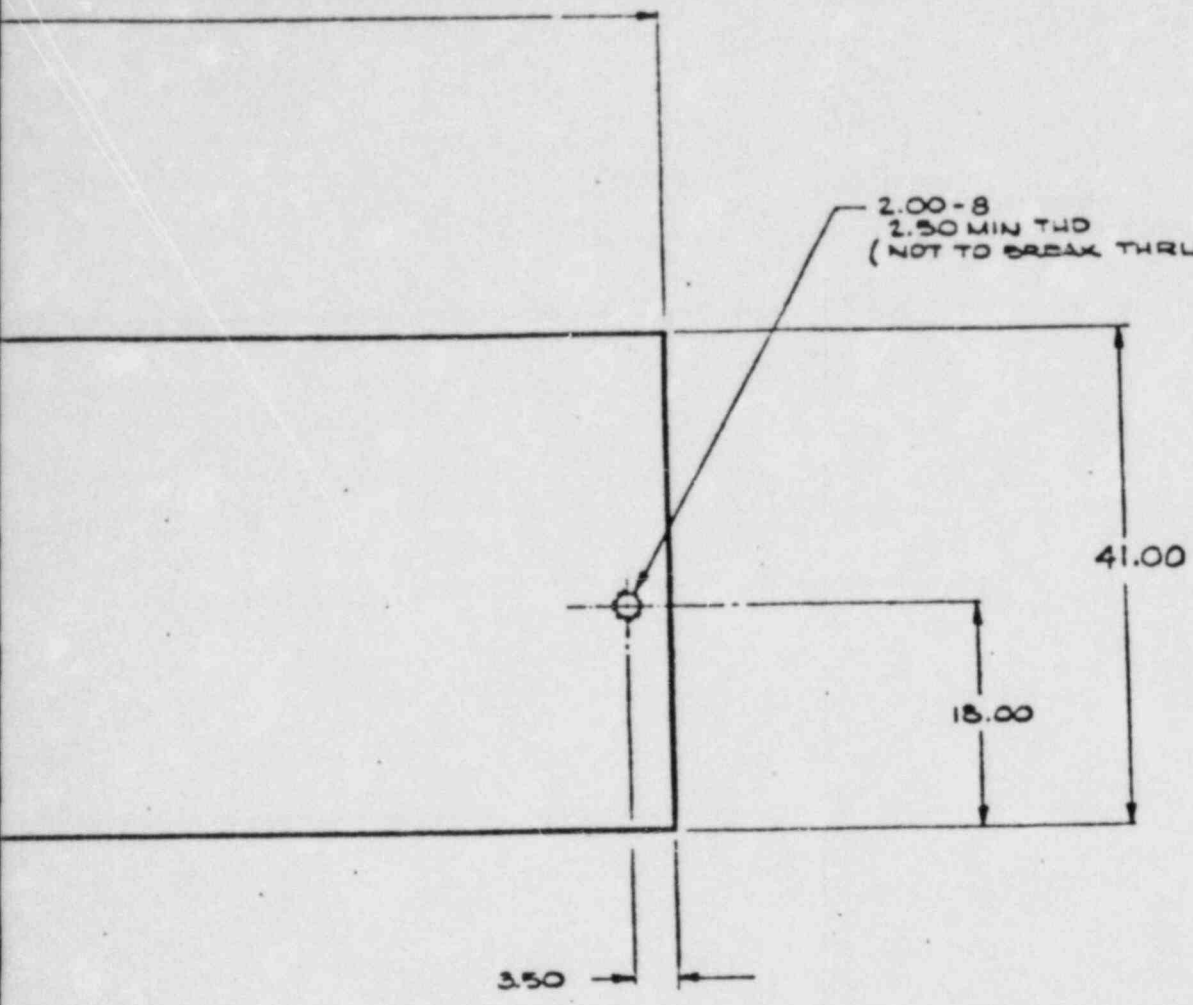


DESIGNED	K UETTMAN	DATE	1-27-78
DRAWN			
CHECKED			
APPROVED	<i>[Signature]</i>		
DATE	1-27-78		
CHEM-NUCLEAR SYSTEMS, INC.			
SIDE PLATE, RIGHT RADWASTE CARRIER I			
D 2000-D-20 E			

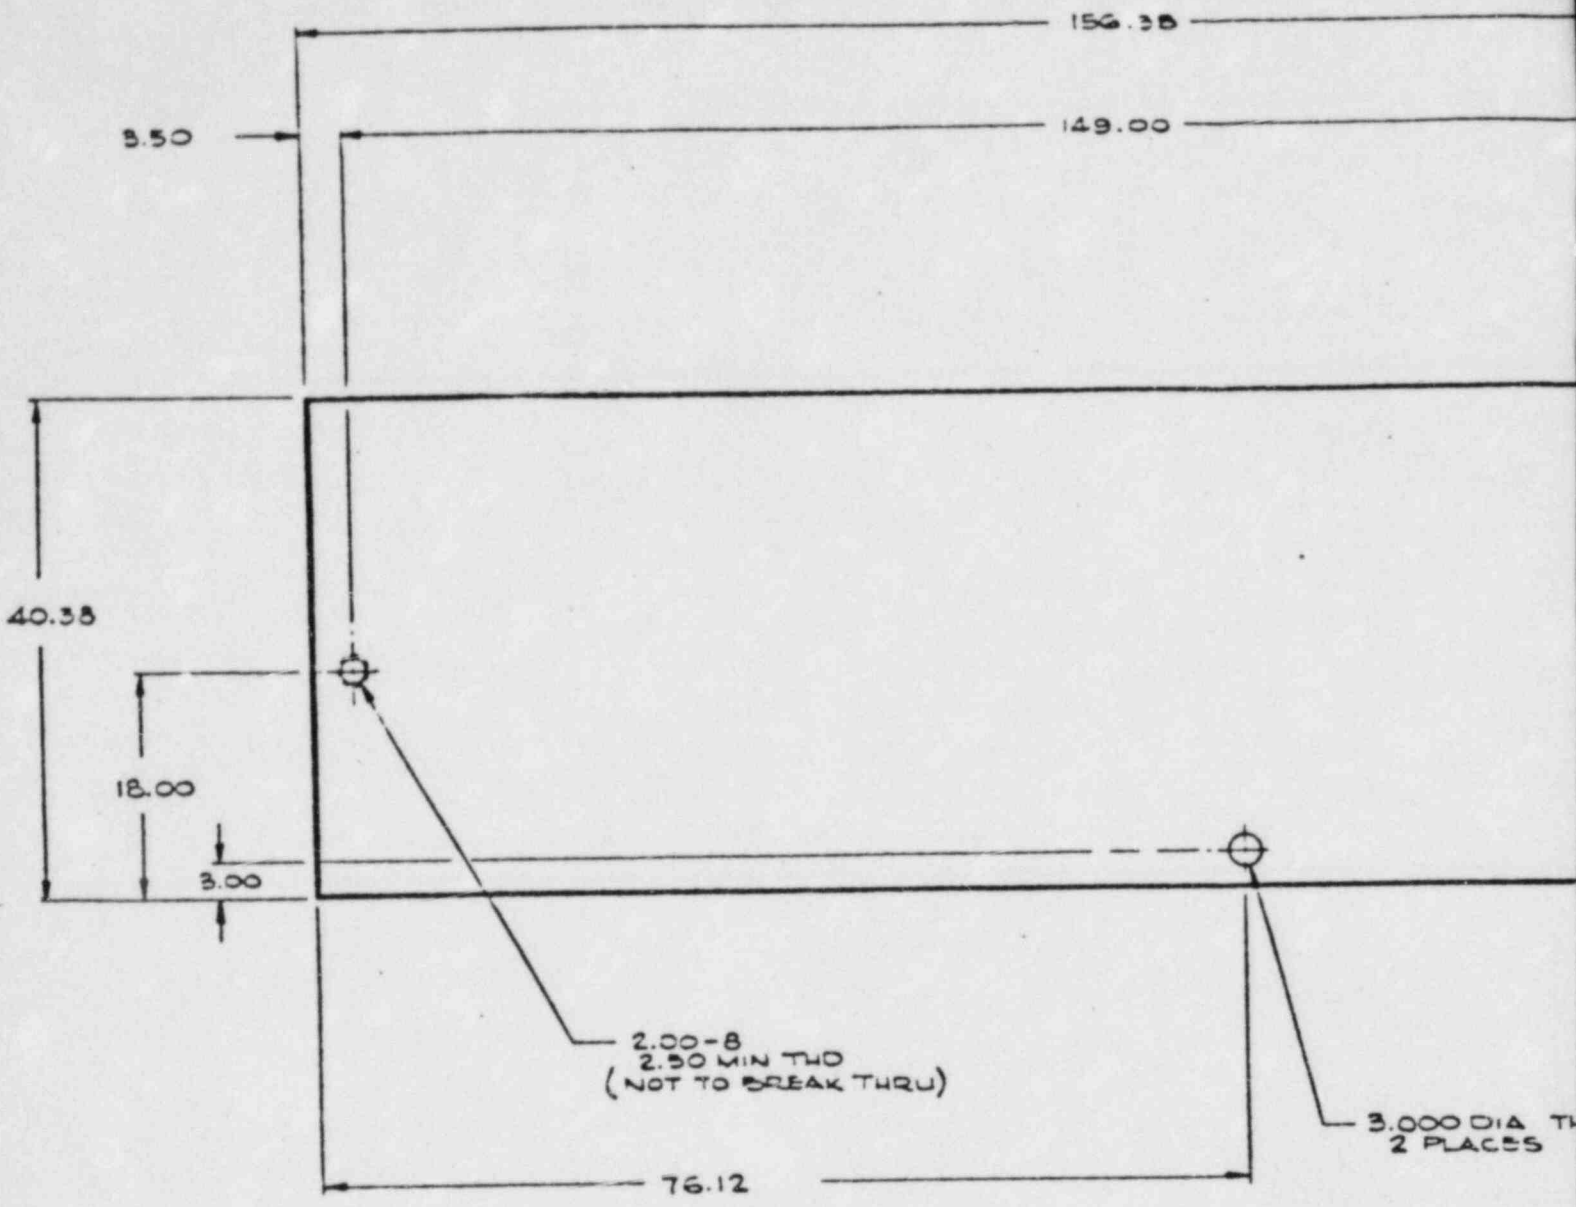

ITEM 4
MATL; HRS 4.00 THK
1 REQD


REV. NO.	DESCRIPTION	DATE APPROVED
B	REVISED AS BUILT	B. TRAW C.

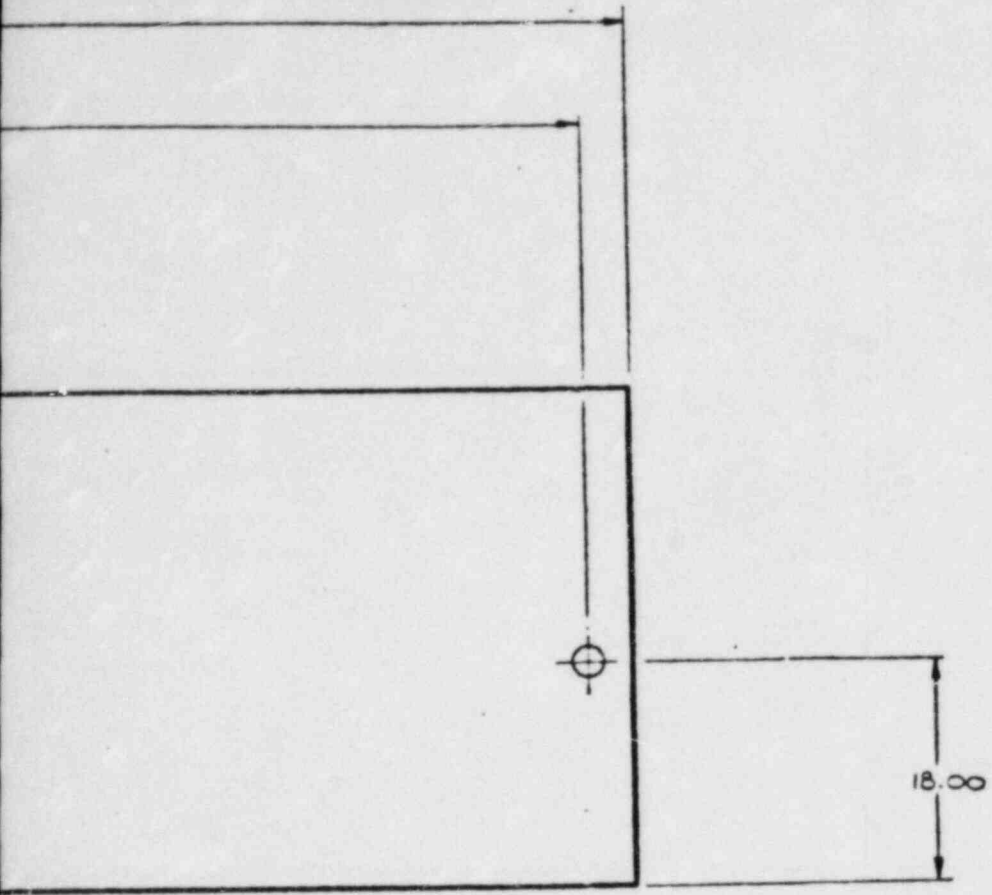


RU

DRAWN		TANIS		DATE	NOV 30 70
CHECKED		K. HETTMAN		DATE	11-27-70
ENGINEER					
APPROVED					
APPROVED		NWS SHEET 5 OF DRAWING NO. EC			
		D 2000-D-20: B			

2011/8 00000/ORDERS
 CHEM-NUCLEAR SYSTEMS, INC.
 SIDE PLATE, LEFT
 RADWASTE CARRIER I

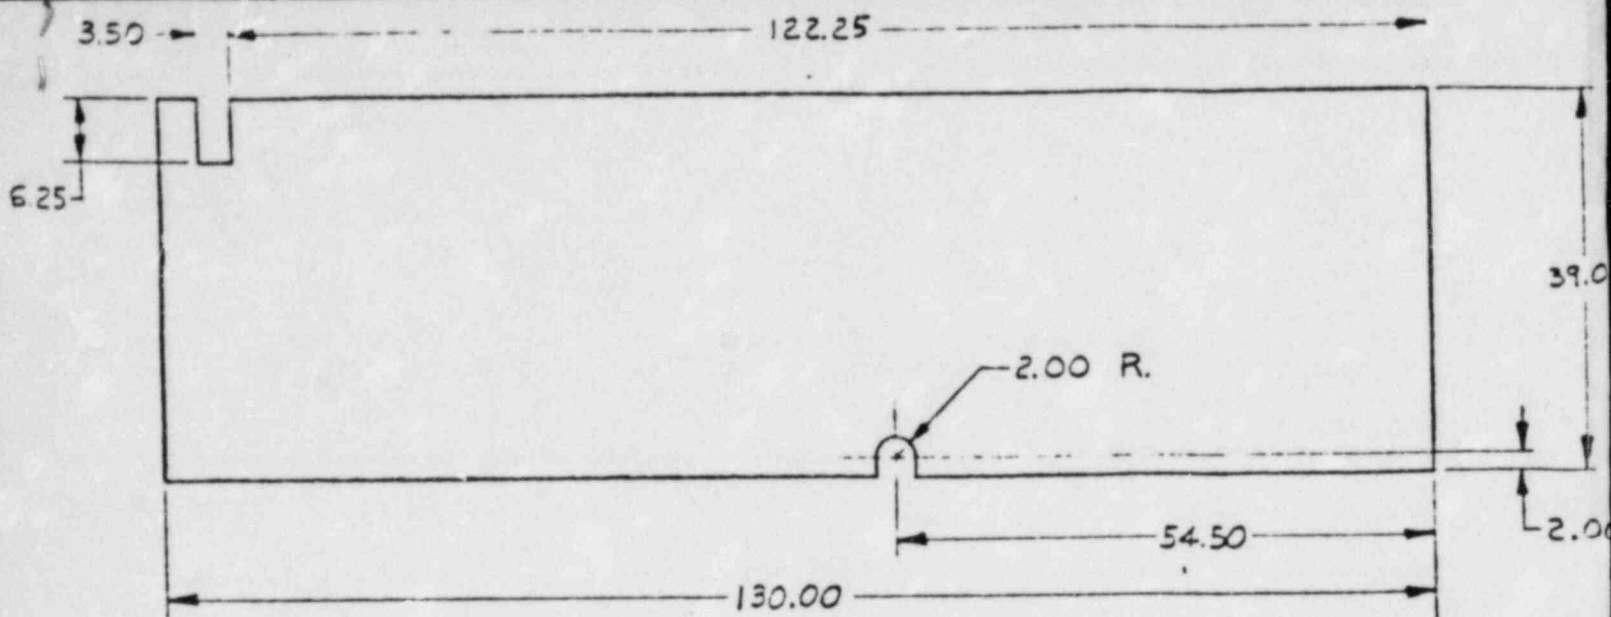


ITEM 13
 MATL: HRS 1.00 THICK
 1 REQD
 (SCALE 1/10)

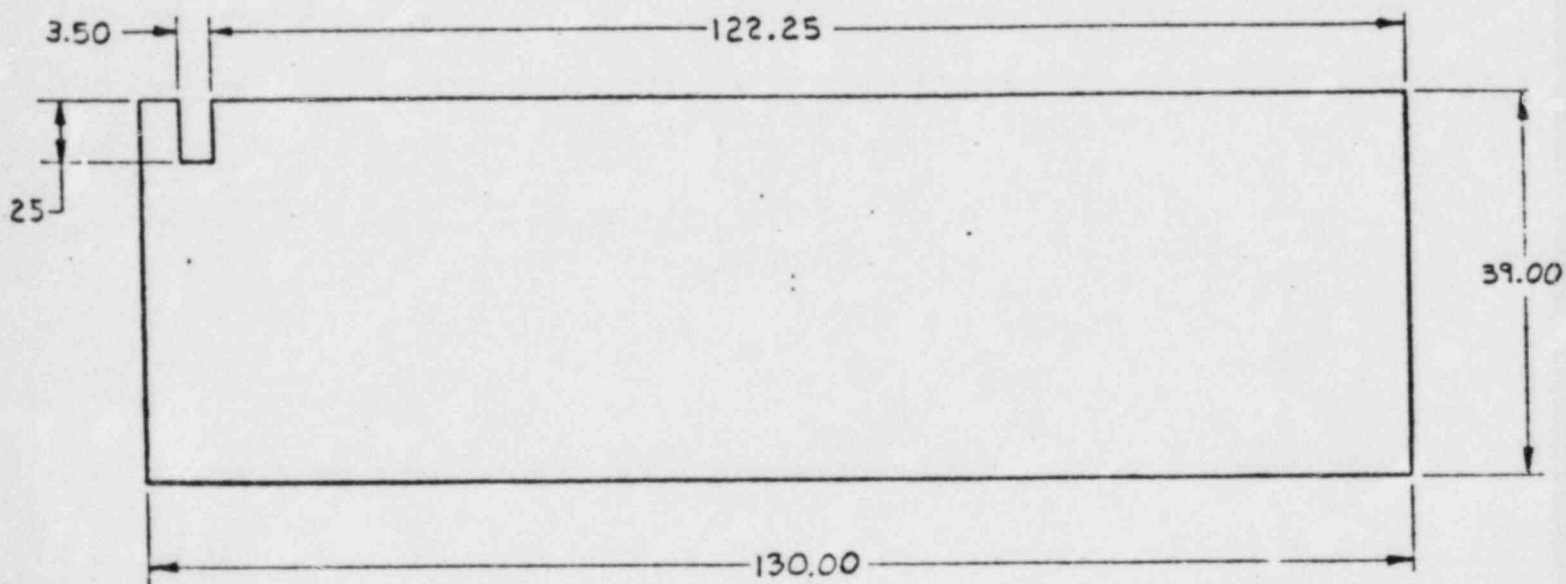


ITEM 12
 MATL: HRS 1.00 THICK
 1 REQD
 (SCALE 1/10)


ZONE LTR	DESCRIPTION	DATE	APPROVED
25	ADDED SH TO TO AS BUILT REV.	1-8-83	

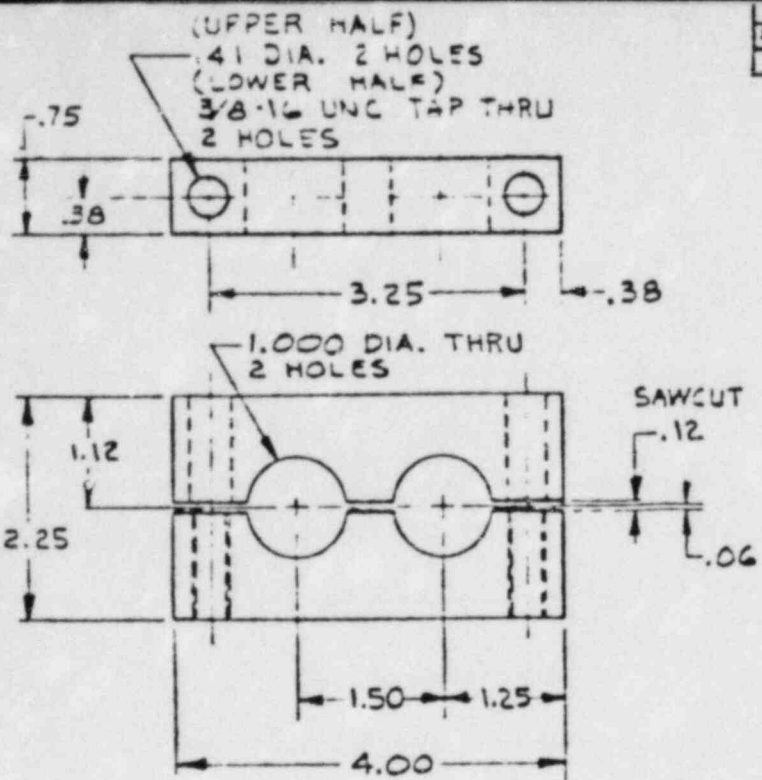

ITEM
MATL: HRS .75 THK
5 REQD
(SCALE FULL)

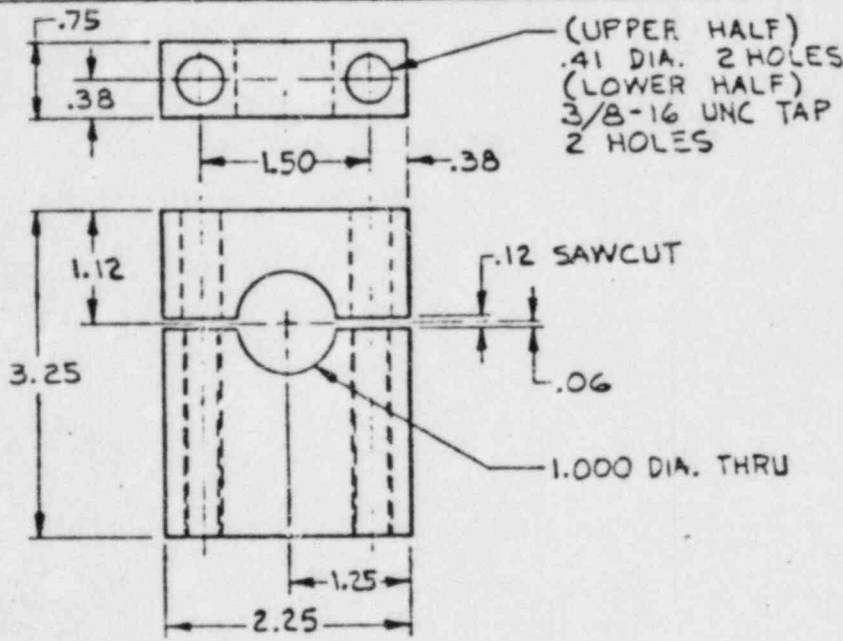


ITEM
MATL: HRS .75 THK
2 REQD
(SCALE FULL)


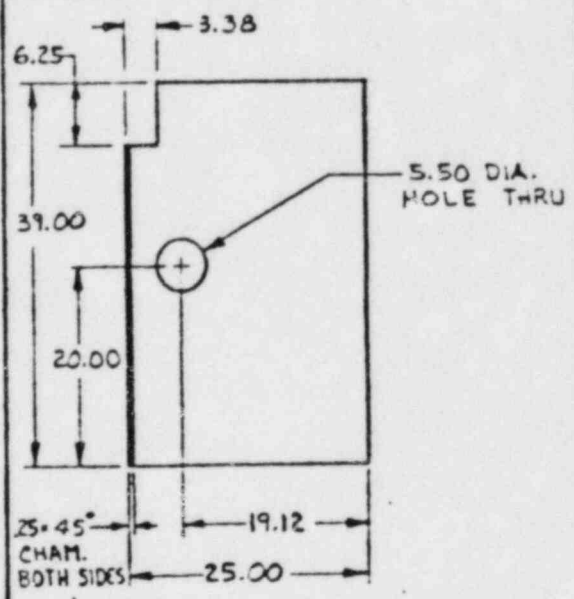


ITEM 15
MATL: HRS 1.00 THK
2 REQD
(SCALE 1/10)

ITEM	QTY	CODE IDENT	NOMENCLATURE OR DESCRIPTION	PART NO
PARTS LIST				
HOLDING DIMENSIONS SPECIFIED DIMENSIONS ARE IN INCHES LINEAR TOLERANCES: .06 ANGULAR TOLERANCES: .030			CONTRACT NO.	
MATERIAL SEE L/M			DRAWN: TANIS DATE: 12-27-77 CHECKED: K. WETTMAN 1/22/78	
NEXT ASSEMBLY USED ON:			CREM-NUCLEAR SYSTEMS, INC.	
APPLICATION:			SHIELD, CONTAINER RADWASTE CARRIER I	
FINISH:			SIZE: D 2000-D-201	
SCALE AS NOTED:			SHEET: 3	

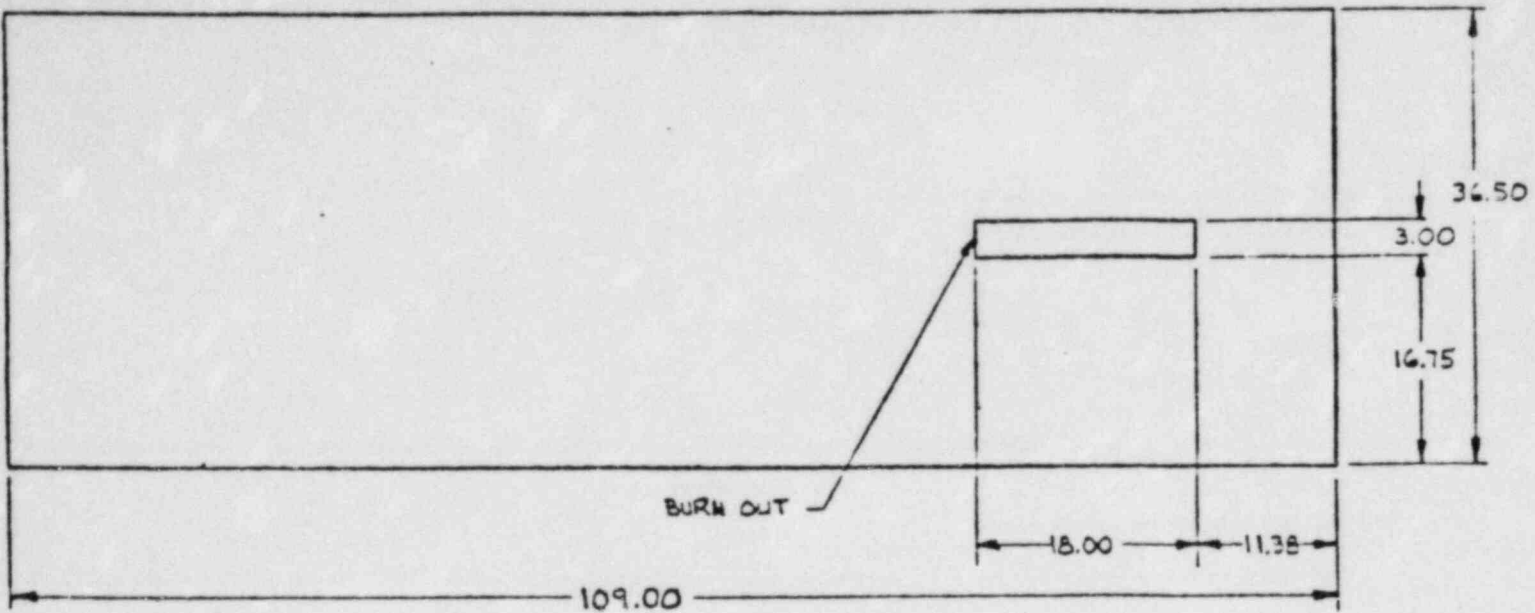


ITEM 14
 MATL; HRS 1.00 THK
 1 REOD

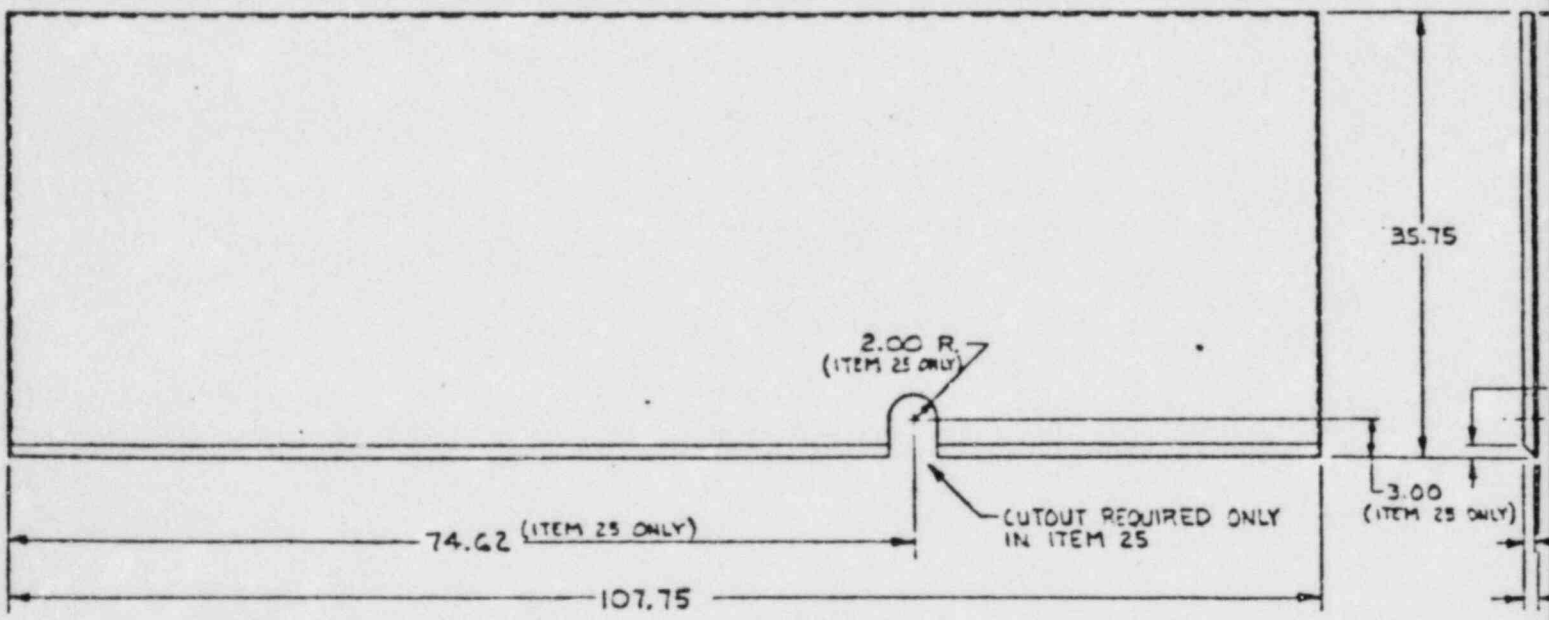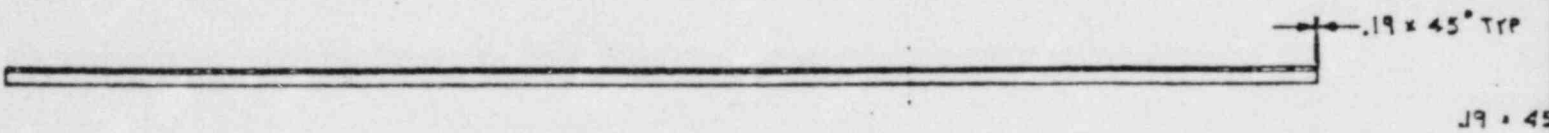


3 ITEM 24 & 25
 MATL; LEAD-1.00 THK
 STEEL-HRS .25 THK
 1 ITEM 24 REOD
 1 ITEM 25 REOD


ZONE/LTR	DESCRIPTION	DATE	APPROVED
1	ADDED SH 7 TO AS BUILT REV.	8-18-78	

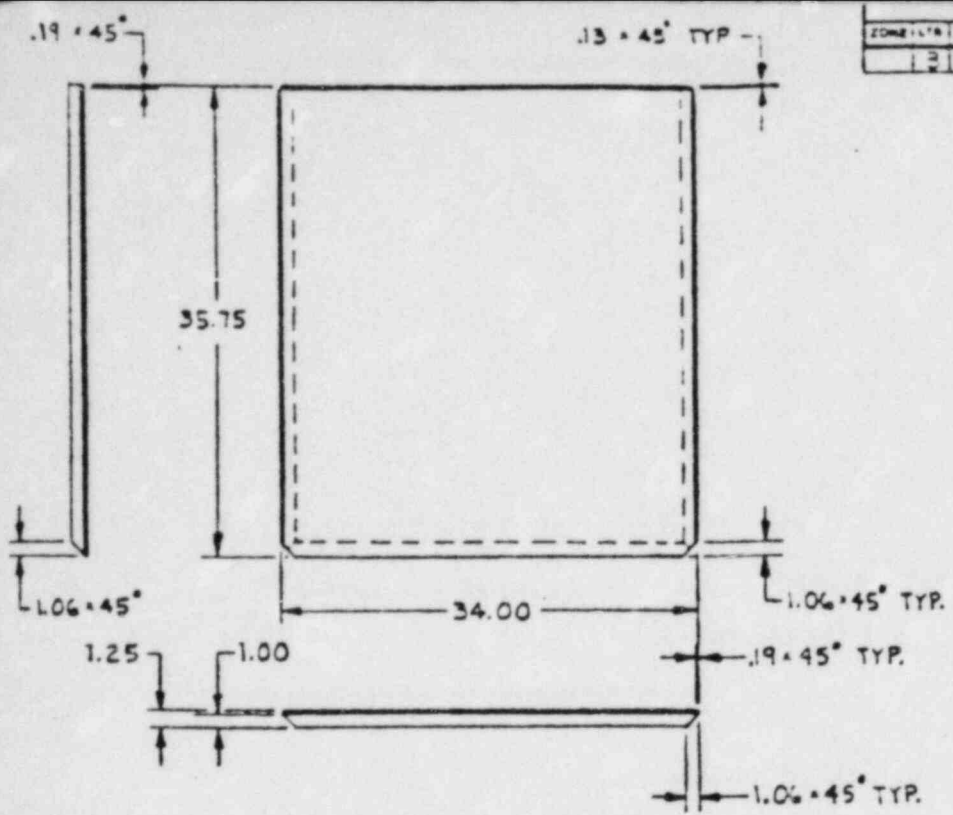

ITEM 26
 MATL: LEAD - 1.00 THK
 STEEL - HRS .25 THK
 1 REQD


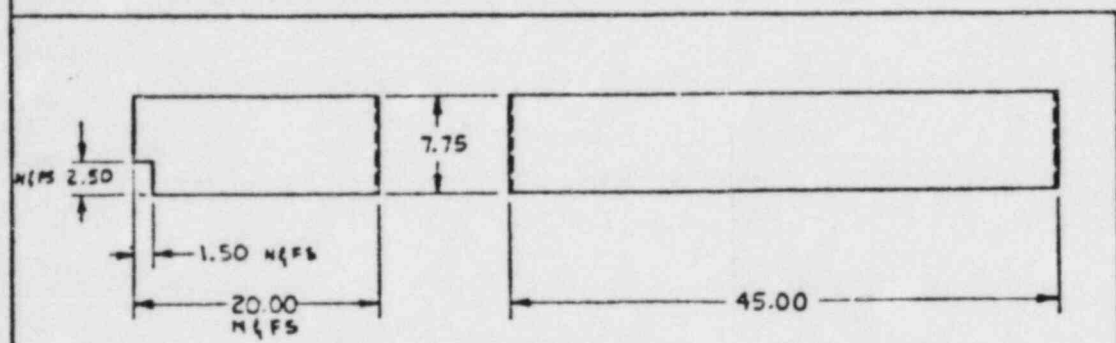


ITEM 27
 MATL: HRS SHT. 11GA.
 1 REQD

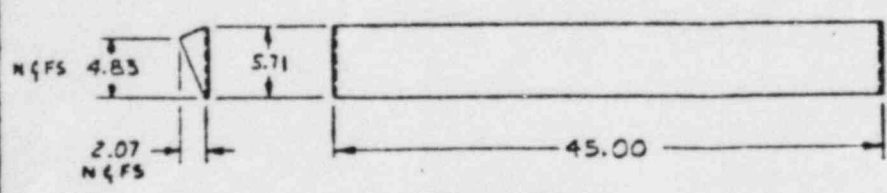

ITEM 28
 MATL: HRS SHT. 11GA.
 1 REQD


ITEM	QTY	CODE IDENT	NO	DESCRIPTION	PART NO.
PARTS LIST					
MATERIAL			CONTRACT NO.		CHEM-NUCLEAR SYSTEMS, INC.
NEXT ASSEMBLY USED OR FINISH			TANIS		
APPLICATION			DATE		SHIELD, CONTAINER RADWASTE CARRIER I
			1-8-78		
			CHECKED		D-2000-D-201
			L. WETTMAN		
			QUALITY		SHEET 3 OF 3
			SCALE 1:1		

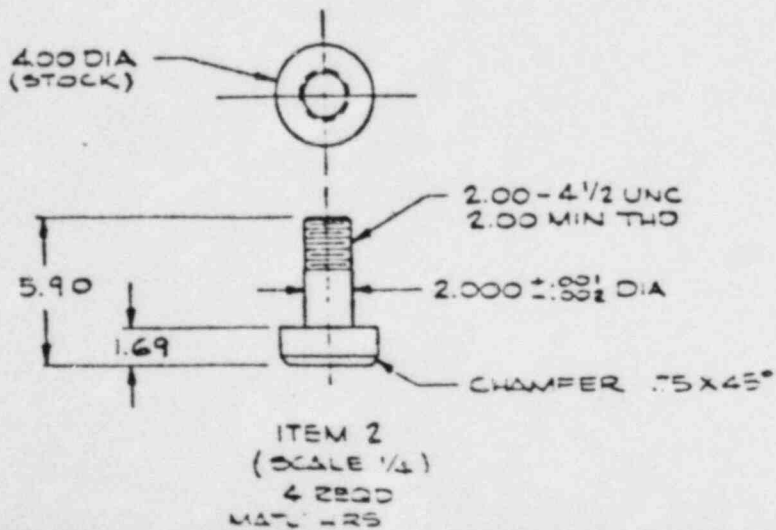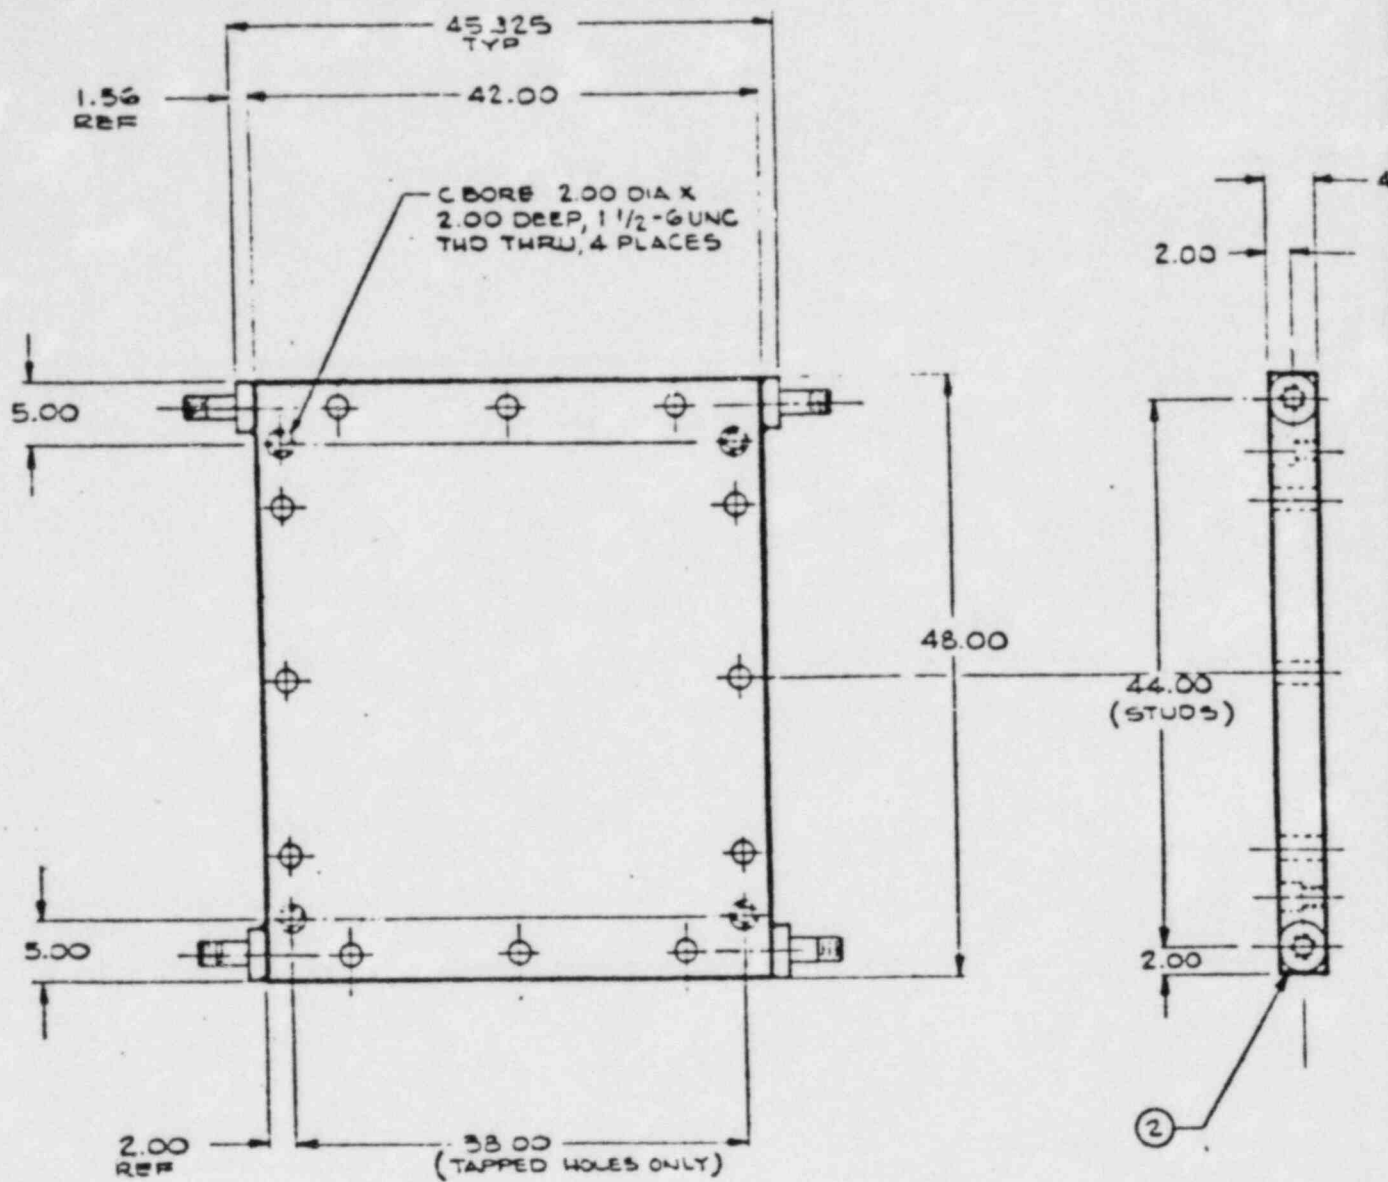

REVISIONS				LIST OF MATERIALS		
NO.	DESCRIPTION	DATE	APPROVED	ITEM	DESCRIPTION	WEIGHT
1	REVISED AS BUILT	PL 30-17108 647		1	PLATE HRS	2257
2				2	STD	38
3				3	WASHER FLAT	08
4				4	TURNBUCKLES	34

1321

00 STOCK

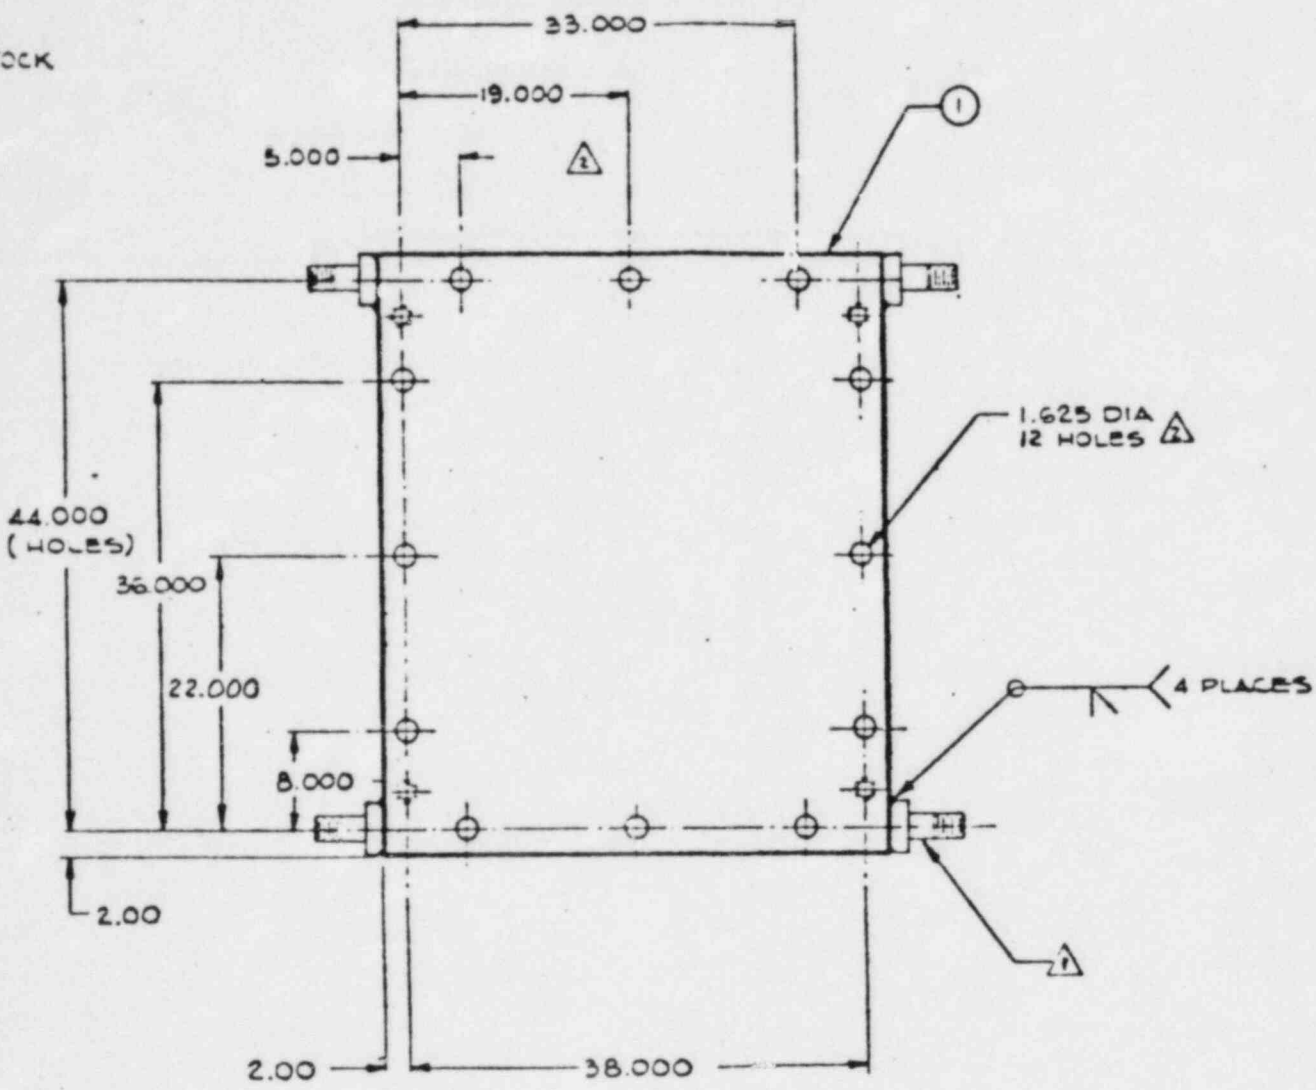

CHEM-NUCLEAR SYSTEMS, INC.	
DOOR SHIELD CONTAINER	
RADWASTE CARRIER I	
HRS ASTM A 36	2000-D-202 F

1.3 Appendix

CNS 6-101 Shipping Cask Drawing

2.0 STRUCTURAL EVALUATION

2.1 Structural Design

Structural Design is addressed in other areas of this package.

2.2 Weights and Centers of Gravity

Weights

The weights for the 6-101 cask were calculated and submitted under previous SAR Docket No. 9105. These calculations have been summarized in the following table with the actual calculations included as Appendix 2.8. Item numbers refer to part numbers on Drawing 2000-D-201.

TABLE

<u>Item No.</u>	<u>Weight (lbs.)</u>
1	7982
2	7982
3	7272
4	7272
5	315
6	2087
7	376
8	41
9	50
10	17
11	120
12	1133
13	1133
14	1113
15	2(262)
16 and 17	69
18	7
19	14
20	2
21	2(44)
22	2(97)
23	2(49)
24	1808
25	1808
26	510
27	23
28	10
<hr/>	
Subtotal (Items 1-28)	42048
<hr/>	
Total plus door weight (2325 lbs)	44373
<hr/>	
Total (including door, contents, and misc. mechanical)	58,373
<hr/>	

2.3 Mechanical Properties of Materials

The cask is constructed out of mild carbon steel and lead. A nominal yield stress of 36,000 psi is used for base material or otherwise as specified in the appropriate analysis.

2.4 General Standards for All Packages

2.4.1 Chemical and Galvanic Reactions

The cask is constructed of mild carbon steel and lead in a welded and bolted construction. The cask is not prone to any significant chemical or galvanic reaction in the environment that would normally be seen.

2.4.2 Positive Closure

Positive closure of the 4 inch thick by 38 inch by 48 inch hydraulically actuated door is accomplished with twelve 1.5 inch bolts.

2.4.3 Lifting Devices

Two sling pickup:

$$I = \frac{bh^3}{12}; \frac{45(49)^3}{12} - \frac{37(41)^3}{12} = 229,000 \text{ in}^4$$

$$M_{\max} = \frac{WL}{8} \quad \text{where} \quad \begin{array}{l} W = \text{calculated total weight} \\ L = \text{length} \end{array}$$

$$M_{\max} = \frac{(58,000)(160)}{8} = 1,160,000 \text{ in-lbs.}$$

$$\sigma_{\text{bend}} = \frac{Mv}{I} \quad (\text{bending stress}) \quad \begin{array}{l} \text{maximum when} \\ v \text{ is maximum distance} \\ \text{from neutral axis} = D/2 \end{array}$$

$$\sigma_{\text{bend}} = \frac{(1,116,000)(24.5)}{229,000} = 124 \text{ psi at 1 G}$$

$$f_{\text{bend}} = 3(\sigma_{\text{bend}}) = 3(124) = 372 \text{ psi} \ll \text{yield}$$

therefore, lifting devices are adequate.

2.5 Standards for Type B and Large Quantity Packaging

This container is not intended for use with Type B or large quantity materials.

2.6 Normal Conditions of Transport

The normal conditions of transport have been addressed for secondary containers for heat, cold, pressure, vibration and water spray as required by 10CFR71.35. These conditions need not be addressed for the CNS 6-101 transport cask.

DROP ANALYSIS

The C-101 cask is evaluated for a one foot free drop in the attitudes detailed in this section

Five Drop Attitudes to be investigated:

- 1) flat bottom drop
- 2) long edge impact (160 in)
- 3) flat end drop
- 4) short edge drop impact (45 or 49 in)
- 5) corner drop

1) FLAT BOTTOM DROP

Impact surface 160 x 45 inches

Energy = 58,000 (12) = 696,000 in-lbs.

$$\text{Volume steel} = \frac{696,000}{36,000} = 19.3 \text{ in}^3$$

$$\text{Body area} = 2(4)(160) = 1280 \text{ in}^2$$

$$\Delta = \frac{19.3 \text{ in}^3}{1280 \text{ in}^2} = .015 \text{ in.}$$

Note that $\Delta = 0.015 \text{ in.}$ is very conservative (i.e. high load factor results) value since crushing of appendages is neglected.

$$\text{"G" factor} = \frac{h}{\Delta} = \frac{12}{.015} = 796 \text{ G}$$

Check bending top plate under own weight:

$$\text{Partial fixity at ends} = \frac{wl^2}{16}$$

$$W_{\text{steel}} = \frac{490}{1728} (4) = 1.13 \text{ psi}$$

$$\frac{wl^2}{16} = \frac{1.13 (34.5)^2}{16} = 84.4 \text{ in-lbs/in.}$$

$$f_{\text{bend}} = \frac{M}{\sigma} = \frac{84.4 (6)}{(4)^2} = 31.6 \text{ psi at 1G}$$

$$\text{Impact stress} = 796(31.6) = 25,187 \text{ psi} < \text{yield}$$

Check weldment at end:

Item 6 weight = 2087 lbs.

1 inch fillet $16(0.928) = 14.85 \text{ kips/in.}$ allowed

body length = $(40 + 46) 2 = 172 \text{ in.}$

capacity one side = $(14.85) (172) = 2554 \text{ kips}$

actual = $2087 \text{ lbs} (796) = 1661 \text{ kips} < 2554 \text{ kips}$

therefore, end weld is adequate.

12 bolts in door:

1-1/2" - 6 UNC $\sigma = 130,000 \text{ psi}$ yield

For SAE 429, Grade 8, shear area = 1.7671 in.^2

$$F_v = 0.3F_y = 0.3 (130,000) = 39,000 \text{ psi} = 39 \text{ ksi}$$

$$\text{Capacity at shear yield} = \frac{130,000 (1.7671)}{2}$$

$$= 115 \text{ kips each at } \frac{y}{2}$$


$$\text{Allowed strength} = \sqrt{\frac{130,000}{3}} = 75.1 \text{ ksi}$$

$$\text{Bolt capacity} - 75.1 \text{ ksi} \times (\text{area}) = 133 \text{ kips}$$

$$\text{total 12 bolts} = 1592 \text{ kips}$$

Since very conservative "G" factor used, bolts are adequate.


2) LONG EDGE IMPACT

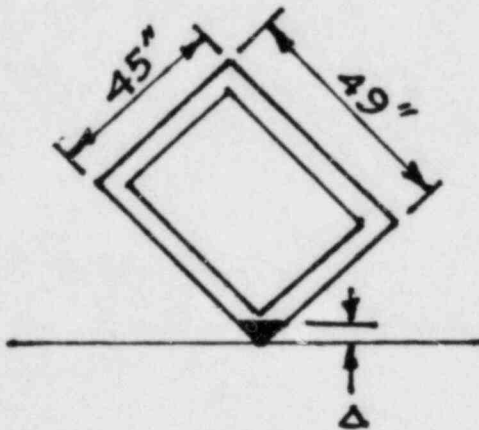

$$\tan \phi = \frac{49}{45} = 1.09$$

$$\tan^{-1} 1.09 = \phi = 47.44^\circ$$

Deformation Sketch - material volume calculation

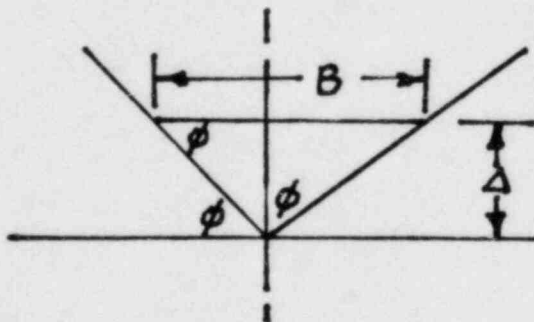

$$\frac{\Delta}{\tan \phi} + \Delta \tan \phi = B = \frac{\Delta}{1.09} + 1.09\Delta = 2.01\Delta$$

$$\text{Volume} = \frac{\Delta (2.01)}{2} \Delta (160) = 160\Delta^2 = 19.3 \text{ in}^3$$

$$\Delta^2 = \frac{19.3}{160}$$


$$\Delta = 0.35 \text{ inch}$$

$$\text{"G" factor} = \frac{12}{0.35} = 34.5$$

$$F_I = 2.01(0.35)(160)(36000) = 4052 \text{ kips}$$

$$\text{"G" factor} = \frac{4052}{58} = 70$$

Check sidewall strength with contents:

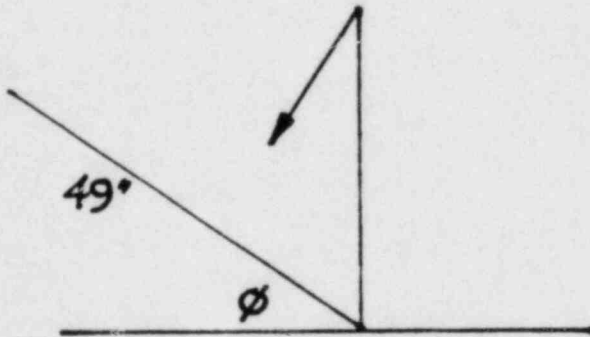

$$6000 \cos \phi = 4058$$

$$\text{Design moment value} = \frac{Wl^2}{16}$$

$$W_{\text{dead weight}} = \frac{490 (4) \cos \phi}{1728} = 0.77 \text{ psi}$$

$$W_{\text{contents}} = \frac{4058}{144(36)} = 0.78 \text{ psi}$$

$W_{\text{dead weight}} + W_{\text{contents}} = 1.55 \text{ psi at 1G vertical}$

$$\frac{wl}{16} = \frac{1.55(41)^2(70)}{16} = 11,420 \text{ in-lbs/in at 70G.}$$

where 70 = load factor

$$f_{\text{bend}} = \frac{M}{\sigma} = \frac{11,420(6)}{(4)^2} = 4282 \text{ psi} < \text{yield}$$

therefore, edge bend is adequate
Weld check at corners.

$$M = 11,420 \text{ in-lbs/in}$$

1 inch fillet weld good 14.85 k/in

$$4(14.85) = 59.4 \text{ in-kips/in} > 11.4$$

therefore, weld is adequate.

3) FLAT END IMPACT


$$\text{Body area} = (45 + 45 + 41 + 41)4 = 688^2 \text{ in.}$$

$$\Delta = \frac{19.3}{688} = 0.028 \text{ in}$$

$$\text{"G" factor} = \frac{12}{0.028} = 428$$

Flat end impact less critical than flat bottom drop.

4) SHORT EDGE IMPACT

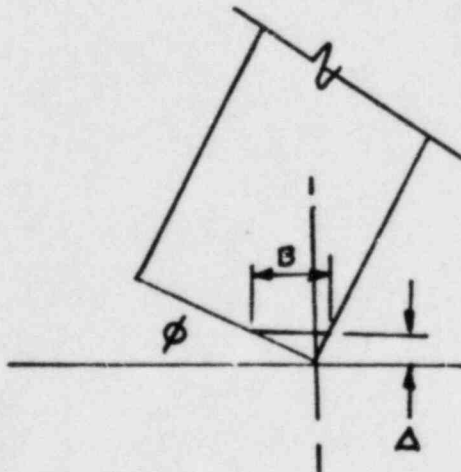

$$\phi = \tan^{-1} \frac{49}{160} = 17.03^\circ$$

$$B = \frac{\Delta}{\tan \phi} + \Delta \tan \phi = \frac{\Delta}{0.31} + 0.31\Delta = 3.58\Delta$$

$$\text{Volume} = \frac{3.58\Delta^2 (45)}{2} = 80.4\Delta$$

$$\Delta = \sqrt{\left[\frac{19.3}{80.4} \right]} = 0.49 \text{ in.}$$

$$\frac{2h}{\Delta} = \frac{2(12)}{0.49} = 49 \text{ G}$$

$$F_I = B(45) (\text{yield}) = 3.58(0.49)(45)(36,000) = 2842 \text{ kips}$$

$$G = \frac{2842}{58} = 49 \text{ G}$$

$$W = 1.13 + \frac{6000}{24(36)} = 8 \text{ psi, which is conservative}$$

$$W = 8(49) = 396 \text{ psi}$$

Two-way plate action:

$$\beta \frac{qb^2}{t^2} = \beta \frac{396(34.5)^2}{(4)^2} = 29.432\beta \text{ psi}$$

$$\beta = 0.38, \text{ for } \frac{a}{b} = \frac{41}{34.5} = 1.2$$

Maximum stress = 11,200 psi < yield

therefore, the plate strength is adequate

Check weld/bolts:


$$\text{load at } 49 \text{ G} = 49(6000 + 2325) = 408 \text{ kips}$$

$$12 \text{ bolts at } 130(1.7671) \text{ each} = 2757 \text{ kips} > 408$$

therefore, bolts are adequate

welds not critical at 14.85 k/in (other end)

5) CORNER DROP IMPACT

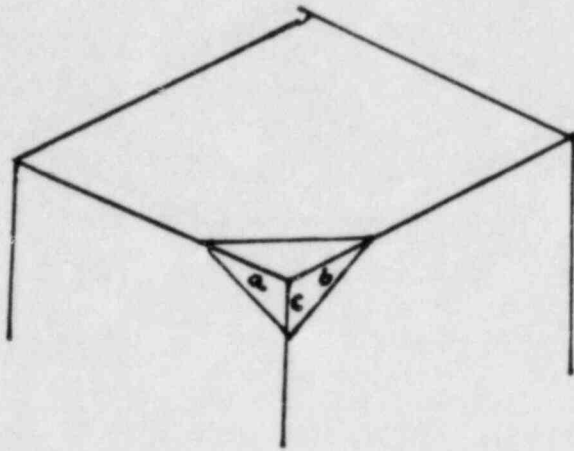

$$Ax + By + Cz + D = 0$$

A, B, C are direction cosines of a normal to the plane.

CG taken as 0,0,0

Corner point P taken as $\frac{45}{2}$, $\frac{49}{2}$, $\frac{160}{2}$

$$\text{Length of CG to Point P} = \sqrt{[(22.5)^2 + (24.5)^2 + (80)^2]} = 86.64$$

$$\cos = \frac{22.5}{86.64} = 0.26$$

$$\cos B = \frac{24.5}{86.64} = 0.28$$

$$\cos = \frac{80}{86.64} = 0.92$$

$$\text{therefore, } 0.26x + 0.28y + 0.92z + D = 0$$

$$\text{volume} = \frac{abc}{6} = 19.3 \text{ in}^3$$

Intercepts along edges:

$$x = \frac{-D}{0.26} = a = 7.654 \text{ inches}$$

$$y = \frac{-D}{0.28} = b = 7.03 \text{ inches}$$

$$z = \frac{-D}{0.92} = c = 2.153 \text{ inches}$$

Equal volume

$$19.3 = \frac{abc}{6} = \frac{-D^3}{(0.068)(6)}$$

$$-D^3 = 6(0.068)(19.3) = 7.852$$

$$D = -1.99$$

2.7 Check Hypothetical Accident Conditions.

Not applicable for Type A container.

APPENDIX 2.8

LOADS

Weights

$$\text{Item 1: } \frac{156.38(45.0)(4)(490)}{1728} = 7982 \text{ lbs. each}$$

$$\text{Item 3: } \frac{156.38(41.0)(4)(490)}{1728} = 7272 \text{ lbs. each}$$

Type of material - A36 plate.

$$\text{Item 6: } \frac{40(46)(4)(490)}{1728} = 2087 \text{ lbs.}$$

Total open end box excluding accessories

$$\begin{array}{rcl} 7982 (2) & = & 15,964 \\ 7272 (2) & = & 14,544 \\ 2087 & = & 2,098 \\ \hline & & 32,595 \text{ lbs.} \end{array}$$

Additional steel plate and lead:

Top steel plate

$$\text{Item 14: } \frac{109(36)(1)(490)}{1728} = 1113 \text{ lbs.}$$

Side steel plate (extension)

$$\text{Items 12,13: } \frac{108(37)(1)(490)}{1728} = 1133 \text{ lbs.}$$

Interior 1" lead + 1/4" steel lining

$$\text{Items 24,25: } \frac{108(34.75)(1)(710)}{1728} = 1542 \text{ lbs. each}$$

$$\frac{108(34.75)(0.25)(490)}{1728} = 266 \text{ lbs. each}$$

Additional weight total:

$$\begin{array}{r} 1542(2) = 3084 \\ 266(2) = 532 \\ 1113 = 1113 \\ 1133(2) = 2266 \\ \hline 6995 \end{array}$$

Items 17, 16:

$$\begin{array}{l} \text{Wt} = 234 \text{ lbs/ft.} \\ k = 5/8 \text{ inch} \end{array}$$

$$\text{Inches cap angle} = (34.75) 4 + (108) 2 = 355.0 \text{ inches}$$

$$\text{Total weight} = \frac{355.0 (2.3)}{12} = 69.2 \text{ lbs.}$$

Front plates L and R, extension

$$\text{Item 15: } \frac{25(37)(1)(490)}{1728} = 262 \text{ lbs. each}$$

UNDERSIDE SHIELDING:

$$\text{Item 21: } \frac{3.5(117)(0.375)(490)}{1728} = 43.54 \text{ lbs. each}$$

Item 22: S 5 x 10.0 at 116 inches

$$\frac{10 (116)}{12} = 97 \text{ lbs. each side}$$

Item 23: L 2 1/2 x 2 1/2 x 5/16 at 117 inches

$$\frac{5 (117)}{12} = 49 \text{ lbs. each}$$

COVERS:

$$\text{Item 28: } \frac{45.373(6)(0.125)(490)}{1728} = 10 \text{ lbs.}$$

$$\text{Item 27: } \frac{(45.375 + 39)(7.75)(0.125)(490)}{1728} = 23 \text{ lbs}$$

REAR SHIELD - interior

Item 18: $\frac{345}{12} (2.34) = 7 \text{ lbs.}$

Item 19: $3/16 \frac{(1.25)(108)(490)}{1728} = 7 \text{ lbs. each}$

Item 20: $3/16 \frac{(1.25)(34.5)(490)}{1728} = 2 \text{ lbs. each}$

Item 26: $\frac{34.5(36)(1)(710)}{1728} = 510 \text{ lbs.}$

Totals Excluding Appendages (Items 5, 7-11):

1	7982	18	7
2	7982	19	14
3	7272	20	4
4	7272	21	44 (2)
6	2087	22	97 (2)
12	1133	23	49 (2)
13	1133	24	1542 + 266
14	1113	25	1542 + 266
15	262 (2)	26	510
16	69 (total)	27	23
7		28	10

41131 lbs.

Item 5: Foot manufacturing

8 holes 1-1/4

Details:

1. 24 x 8 x 1/2 plate A-36
2. 1/2 inch plate
3. Tube 8 x 8 - 1/2 ASTM A501

Weight = $\frac{24 \times 8 \times .5}{1728} \times 490 = 27 \text{ lbs.}$

$\frac{(7)^2(0.5)(490)}{1728} = 7 \text{ lbs two pieces}$

$\frac{47.37 (9.25)}{12} = 29 \text{ lbs.}$

Total each item 5 = 63 lbs.

Item 7: Support door lift assembly

Weight = $\frac{(11 + 38.62)(13.8)(2)(490)}{2 \times 1728} = 194 \text{ lbs.}$

$$\frac{(3 \frac{1}{2} \times 3 \frac{1}{2} \times 11)}{1728} 490 = 38 \text{ lbs.}$$

Total each Item 7 = 232 lbs.

$$\text{Holes } \frac{\pi(7)^2}{4} (2) \frac{(490)}{1728} = 22 \text{ lbs. each}$$

Net each Item 7 = 232 - 44 = 188 lbs.

Item 8: Gasket

$$\text{Weight} = \frac{(12)^2(1)490}{1728} = 41 \text{ lbs. (2)}$$

Item 9: Anchor plate

$$\text{Weight} = \frac{15(17)(2)(490)}{2 \cdot 1728} = 72 \text{ lbs.}$$

Net - 72 - 22 = 50 lbs.

Item 11: Lifting lug Drawing 2000-0-201 Rev. A

$$\text{Weight} = \frac{(4 + 11)(8)(2)(490)}{2 \cdot 1728} = 34 \text{ lbs.}$$

$$\frac{1(5)(2)(490)}{1728} = 3 \text{ lbs.}$$

Net = 30 lbs. each.

Door - Drawing 2000-D-202 Rev. F

$$\text{Weight} = \frac{42(48)(4)(490)}{1728} = 2287 \text{ lbs.}$$

$$\text{Studs} = \frac{38 \text{ lbs.}}{2325 \text{ lbs.}}$$

SUMMARY

1 - 4, 6, 12 - 28	41.131
5	313
7	376
8	41
9	50
10	17
11	121
Door	<u>2325</u>
	44,375 lbs. excluding contents

Contents

6 drums at 1000 lbs. each = 6000 lbs.

Miscellaneous Mechanical

8000 lbs: Generator, Hydraulic, etc.

3.0 THERMAL

The solid steel construction of this package with lead lining provide an inherent stable structure for the temperature range normally seen by the package, as specified in 10CFR71.35.

4.0 CONTAINMENT

The structural evaluation has demonstrated that there will be no significant reduction in containment for Type A secondary container during normal conditions of transport. The rectangular steel box provides no containment capability, and therefore the use of this cask is based on the containment provided by DOT Type A secondary containers.

5.0 SHIELDING EVALUATION

There will be no significant reduction of shielding effectiveness as a result of normal conditions of transport.

6.0 CRITICALITY EVALUATION

This section is not applicable to the CNS 6-101 cask.

7.0 OPERATING PROCEDURES

This section describes the general procedure for loading and unloading of the CNS 6-101 cask.

7.1 Loading

- 7.1.1 Position the transport cask on a level surface at the shield door opening at the nuclear facility.
- 7.1.2 Perform a pre-operational check of hydraulic and electrical systems.
- 7.1.3 Prepare to open cask door. Remove seal wire from cask door bolt.

CAUTION: TREAT THE INSIDE OF THE SHIELD DOOR, THE INSIDE SURFACES OF THE CASK, THE CONVEYORS, AND ANY BOLTS OR SEALS REMOVED AS CONTAMINATED.

- 7.1.4 Remove the twelve (12) 1-1/2 inch bolts from the door.
- 7.1.5 Raise cask door.
- 7.1.6 Place one of the removed bolts in one of the lower door bolt holes.
- 7.1.7 Inspect gasket and replace as necessary.
- 7.1.8 Operate conveyors to load drums to maximum of six (6) drums. Remove bolt placed in lower hole of cask door.

NOTE: AS EACH DRUM MOVES THROUGH THE BUILDING SHIELD DOOR, IT SHALL BE SURVEYED FOR RADIATION AND CONTAMINATION. IF CONTAMINATION IS NOTED, STOP ALL LOADING OPERATIONS AND NOTIFY THE RAD-WASTE SUPERVISOR IMMEDIATELY. CONTAMINATED DRUMS SHALL BE RETURNED FOR DECONTAMINATION.

- 7.1.9 Close cask door.

- 7.1.10 Survey cask to assure dose rate does not exceed requirements of 49 CFR 173.393 (j).
- 7.1.11 Install the twelve (12) 1-1/2 inch bolts in cask door. Torque to 250 ft/lb.
- 7.1.12 Attach lead wire seal to designated door bolt.
- 7.1.13 Before cask leaves facility, the following shall be confirmed.
See (a) That trailer placarding and cask labelling meet DOT Specifications (CFR 49, Part 172).
(b) That exterior radiation levels do not exceed 10 mR/hr at 6 feet and 2 mR/hr in the tractor cab, in accordance with 49 CFR 173.393 (j).
(c) That the cask door is sealed with an anti-tamper seal.
- 7.1.14 Complete the user check-off sheet and appropriate documentation.

7.2 Unloading

NOTE: ALL PERSONNEL HANDLING FILLED DRUMS SHALL OBSERVE ESTABLISHED SITE RADIATION PROTECTION PROCEDURES.

- 7.2.1 Position cask at disposal area.
- 7.2.2 Remove lead wire seal.
- 7.2.3 Loosen and remove cask door bolts.
- 7.2.4 Open cask door.
- 7.2.5 Place one of the removed bolts in one of the lower door bolt holes.
- 7.2.6 Remove contents of cask by operating conveyors allowing the drums to go off the end rollers of the conveyor into the disposal area.

- 7.2.7 Cask shall be inspected for damage and removed from service when repair is required.
- 7.2.8 Operate conveyors to load drums to a maximum of six (6) drums. Remove bolt placed in lower hole of cask door.
- 7.2.9 Close cask door.
- 7.2.10 Install bolts. Torque to 250 ft/lb.
- 7.2.11 Attach seal wire to designated door bolt.
- 7.2.12 Perform cask surveys and complete appropriate documentation.

8.0 ACCEPTANCE TESTS AND MAINTENANCE PROGRAM

A mechanical and electrical check shall be performed on the complete system relative to each use. Maintenance and periodic inspection shall be performed on a routine basis, or as required, after repair or storage.