



**Commonwealth Edison**  
One First National Plaza, Chicago, Illinois  
Address Reply to: Post Office Box 767  
Chicago, Illinois 60690

October 31, 1983

Mr. Harold R. Denton, Director  
Office of Nuclear Reactor Regulation  
U.S. Nuclear Regulatory Commission  
Washington, DC 20555

Subject: LaSalle County Station Units 1 and 2  
Preliminary Evaluation of the Service  
Water System as a Backup to the Fire  
Protection System  
NRC Docket Nos. 50-373 and 50-374

Reference (a): License NPF-11, Technical Specification  
3.7.5.1, Actions a. and b.1.

Dear Mr. Denton:

Enclosed please find the subject preliminary evaluation. This preliminary evaluation was made at the request of the NRC staff to provide additional justification for our use of the service water system as a backup (not necessarily equivalent) fire suppression water system. We are continuing our review of the adequacy of the fire protection water supply.

To the best of my knowledge and belief the statements contained herein and in the enclosure are true and correct. In some respects these statements are not based on my personal knowledge but upon information furnished by other Commonwealth Edison employees and contractor employees. Such information has been reviewed in accordance with Company practice and I believe it to be reliable.

If there are any further questions regarding this matter, please contact this office.

Very truly yours,

*C.W. Schroeder 10/3, /83*

8311040130 831031  
PDR ADOCK 05000373  
F PDR

C. W. Schroeder  
nuclear Licensing Administrator

lm

Enclosure

cc: J. G. Keppler l/l  
W. Guldemond l/0

Boo2  
1/1  
DRAWINGS TO REB FILE

ENCLOSURE

Preliminary Evaluation of the Service Water System as a  
Back-Up to the Fire Protection System at LaSalle

The fire protection water distribution system is capable of supplying cooling lake water to the plant fire hydrants, the water sprinkler and deluge systems, and the hose valve stations under all conditions. The system is normally kept pressurized by fire protection jockey pumps. If a system demand occurs, the pressure decreases in the fire protection system, thereby automatically starting a diesel fire pump. A second diesel fire pump is available should the system pressure continue to drop. Each fire pump has a capacity of 2,500 gpm at 315 feet TDH.

By comparison, each of the five service water pumps has a capacity of 16,000 gpm at 215 feet TDH. By backing the service water pumps down their head capacity curve and reducing service water loads, the service water pumps may be used as a back-up should the diesel fire pumps both be inoperable. This report represents an assessment (the calculations were made independent of the original fire pump sizing and design calculations) of the limitations imposed on the current fire protection system when the service water system is used as a back-up supply.

The conclusions are:

1. The service water pumps can provide 750 gpm at 65 psi to the refuel floor at el. 848'6" - Attachment A.
2. The service water pumps cannot provide 1000 gpm (+750 gpm for hose stations) at 75 psi to the Unit 1 cable spreading room at el. 753'6" - Attachment B.
3. Operating the service water pumps at low flow requires reducing service water load to the station and maintaining minimum cooling requirements for service water pumps (2400 gpm).

Attachment A

The attachment discusses the use of the service water pumps to supply 750 gpm at 65 psi to the refuel floor. The following comments apply:

- (1) Sensitivity estimates show that the service water system could also provide the two worst hose stations (there are 10 total on the refuel floor) with 100 gpm at approximately 65 psi. In this case, the fire protection system flow would be 200 gpm.
- (2) The calculations in the attachments are based on a C of 100. This is conservative. A header flow test (LST 82-177) was conducted in July 1982 at LaSalle and the results of this test were compared against calculations with the following conclusions for three fire pump flows:

<u>Q = 2975 gpm</u>		<u>psi calculated</u>	
<u>Hydrant</u>	<u>psi measured</u>	<u>C = 100</u>	<u>C = 120</u>
507	112	105	110
504	108	101	108
503	106	98	106
501	105	94	103
515	<u>100</u>	<u>91</u>	<u>100</u>
▲ P from 507-515 = 12		14	10

<u>Q = 2800 gpm</u>		<u>psi calculated</u>	
<u>Hydrant</u>	<u>psi measured</u>	<u>C = 100</u>	<u>C = 120</u>
507	119	111	116
504	115	108	114
503	113	105	112
501	112	102	110
515	<u>111</u>	<u>99</u>	<u>107</u>
▲ P from 507-515 = 8		12	9

<u>Q = 2550 gpm</u>		<u>psi calculated</u>	
<u>Hydrant</u>	<u>psi measured</u>	<u>C = 100</u>	<u>C = 120</u>
507	129	118	122
504	126	116	120
503	124	113	119
501	123	110	117
515	<u>122</u>	<u>108</u>	<u>115</u>
▲ P from 507-515 = 7		10	7

These numbers indicate that a C of 100 is conservative by at least 15-20% in the prediction of pressure drops.

Attachment B

This attachment discusses the use of the service water system to supply 1000 gpm at 75 psi to the U1 cable spreading room. It includes a paragraph stating that the fire pumps can meet this demand but the service water pumps cannot. The following comment applies:

- (1) The cable spreading room was designed for a spray density of 0.3 gpm/sq.ft. The combustible material in this zone consists of Division 2 control and instrumentation cable insulation. The design basis of fire protection system is to protect the cables in the cable trays. A cable tray spray system was designed to meet the intent of NFPA-15 with spray nozzles located in the trays. There is also a sprinkler system to meet the intent of NFPA-13. LaSalle uses qualified cable, solid bottom cable trays to prevent the propagation of cable fires and is designed such that in the unlikely event of a fire that completely destroyed the cable spreading room there is an alternate path whereby Unit 1 could be brought to a safe shutdown.

The recommended density in Section 4-4.1.4 of NFPA 15 is 0.15 gpm/sq.ft. for extinguishment of fire which originates within the cable. We interpret Section 4-4.3.3(d) to recommend a density of 0.3 gpm/sq.ft. to protect cables from an exposure fire.

A demonstration was conducted in the cable spreading room at LaSalle on March 12, 1982 at which time a spray density of 0.32 gpm/sq.ft. was measured from one nozzle at a pressure of 10 psi.

7538N

Evaluation of Service Water System  
As Back-Up to Fire Protection System  
at the Refueling Floor

#### 1.0 INTRODUCTION

The fire protection water distribution system is capable of supplying cooling lake water to the plant fire hydrants, the water sprinkler and deluge systems, and the hose valve stations under all conditions. The system is normally kept pressurized by one of two fire protection jockey pumps. If a system demand occurs, the pressure decreases in the fire protection system, thereby automatically starting a diesel fire pump. Each fire pump has a capacity of 2,500 gpm @ 315 feet TDH. The sizing basis for the fire pumps was Nuclear Mutual, Limited (NML) Standards.

The diesel fire pumps take suction from the water tunnel in the lake screen house. The tunnel has multiple intakes from the LSCS cooling lake. As a backup to the diesel fire pumps, water can be supplied from the service water system. The service water system is connected to the fire protection system through a 12-inch line at each pump discharge line.

#### 2.0 PURPOSE

The purpose of this calculation/report is to demonstrate that the Service Water System can back-up the Fire Protection

2.0 PURPOSE (continued)

System demand in the event both diesel fire pumps are inoperable by supplying 750 gpm @ 65 psig to the highest fire suppression system. This system consists of fire hose streams on the refuel floor at elevation 848'-6".

3.0 ASSUMPTIONS

We have assumed the pipe to be "old". This implies a Hazen-Williams coefficient of 100. The equivalent length for the butterfly valves was obtained from Crane's TP-410 paper ( $L/D=40$ ). There are two strainers in the calculation where we assumed conservative pressure drops.

The flow branching off the service water piping is assumed to be 750 gpm. This condition assumes that valves downstream of the branch point will be partially closed (throttled) if such a need arises. We assumed that 375 gpm are diverted to the Unit 2 side of the refueling floor due to symmetry in pipe routings. Each fire hose has been assumed to have a flow of 75 gpm. (Figures 1 and 2 show the ten hose stations on the refueling floor.).

#### 4.0 DESIGN INPUT

The head loss calculations were performed using Sargent & Lundy Standards MES-2.10 and MES-2.16. The pipe routing and calculations are in Appendix A. The pipe routing was developed from the current single line and outdoor piping drawings. The calculations were performed using Form MES-2.16.1.

#### 5.0 REFERENCES

- 5.1 Goulds Pumps, Inc., Characteristic Curve for Service Water Pumps
  - IWS01PA - A-19376
  - IWS01PG - A-19377
  - OWS01P - A-19375
- 5.2 NML Standards for Nuclear Generating Stations
- 5.3 Crane TP No. 410 - Flow of Fluids
- 5.4 Cameron Hydraulic Data, 14th Edition
- 5.5 P&ID's
  - M-68 , Rev. P, Service Water
  - M-71-01, Rev. AB, Fire Protection
  - M-72-02, Rev. U, Fire Protection
- 5.6 Structural Drawings
  - S-119, Rev. R, Plumbing Underground Piping
  - S-120, Rev. T, Plumbing Underground Piping

5.0 REFERENCES (continued)

5.7 Mechanical Drawings

M-766-06, Rev. G, Outdoor Piping

M-766-07, Rev. D, Outdoor Piping

M-766-08, Rev. F, Outdoor Piping

M-766-09, Rev. K, Outdoor Piping

M-783 , Rev. K, Lake Screen House Piping

M-785 , Rev. M, Lake Screen House Piping

M-787 , Rev. M, Lake Screen House Piping

M-788 , Rev. J, Lake Screen House Piping

M-814 , Rev. H, Fire Protection Piping-Reactor Building

M-814-02, Rev. G, Fire Protection Piping-Reactor Building

M-814-03, Rev. J, Fire Protection Piping-Reactor Building

M-814-04, Rev. F, Fire Protection Piping-Reactor Building

M-814-05, Rev. G, Fire Protection Piping-Reactor Building

M-814-06, Rev. G, Fire Protection Piping-Reactor Building

M-814-07, Rev. G, Fire Protection Piping-Reactor Building

5.8 Instrument Location Number

M-1312-03, Rev. B

5.9 Piping Design Tables

PDT "002LS" and "100LS"

6.0 SUMMARY

The calculations demonstrate that the head loss due to friction between the WS pumps and the hose stations approximately 23 feet of water. A static head of 161 feet exists between the WS pumps and the hose stations. Section V of the

6.0 SUMMARY (continued)

Nuclear Mutual, Limited Standards require a water supply pressure at the highest hose nozzle location of 150 feet of water. Hence, the discharge head of the WS pumps must equal 334 feet.

The discharge nozzle of the service water pumps are located below the elevation of the cooling lake. The difference in elevation results in a static suction head to the WS pumps of approximately 12.5 feet. Hence, the total developed head for three pumps equals 321.5 feet (assuming negligible suction friction).

At this discharge head three WS pumps provide approximately 10,600 gpm. This flow exceeds the minimum flow requirement specified by the pump vendor in Specification J-2535.

Figure 3 presents characteristic curves for the various pump schemes considered and the systems' resistance curve. With one and two pumps in parallel, the combined flows equal approximately 4000 gpm and 7600 gpm, respectively.

The Service Water System is concluded to be adequate to provide the water supply to the Fire Protection System based upon the calculations and Figure 3. A pressure transmitter and indicator on the WS piping can be used to determine when adequate pressure is achieved.

## 7.0 RECOMMENDATIONS

The WS system can supply 750 gpm at 65 psig to the refueling floor. To accomplish this, WS valves downstream of the fire protection branch must be partially closed. The proper pressure can be obtained by reading pressure indicator 1PI-WS007. With three pumps operating the indicator, located on the discharge nozzle of pump 1WS01PA, must reflect a pressure of approximately 144.6 psig (334 ft. H<sub>2</sub>O). In addition to the pressure indicator, a pressure transmitter (1PT-WS009) is also available to detect line pressure. The transmitter must reflect a pressure of 138.2 psig (319 ft. H<sub>2</sub>O).

In order to provide adequate water supply to the FP system, the WS pumps must be backed up on their characteristic curve. By doing this, the capacity is sacrificed and as such, will require the operator to shed load. Although one WS pump can provide the necessary flow, it would be prudent to operate with three pumps in parallel. With the three pumps operating, more service water would be available to other heat loads.

APPENDIX A

APR 20 1965

(89) 24'-6" (10) 26'-0" (11) 26'-0" (12) 26'



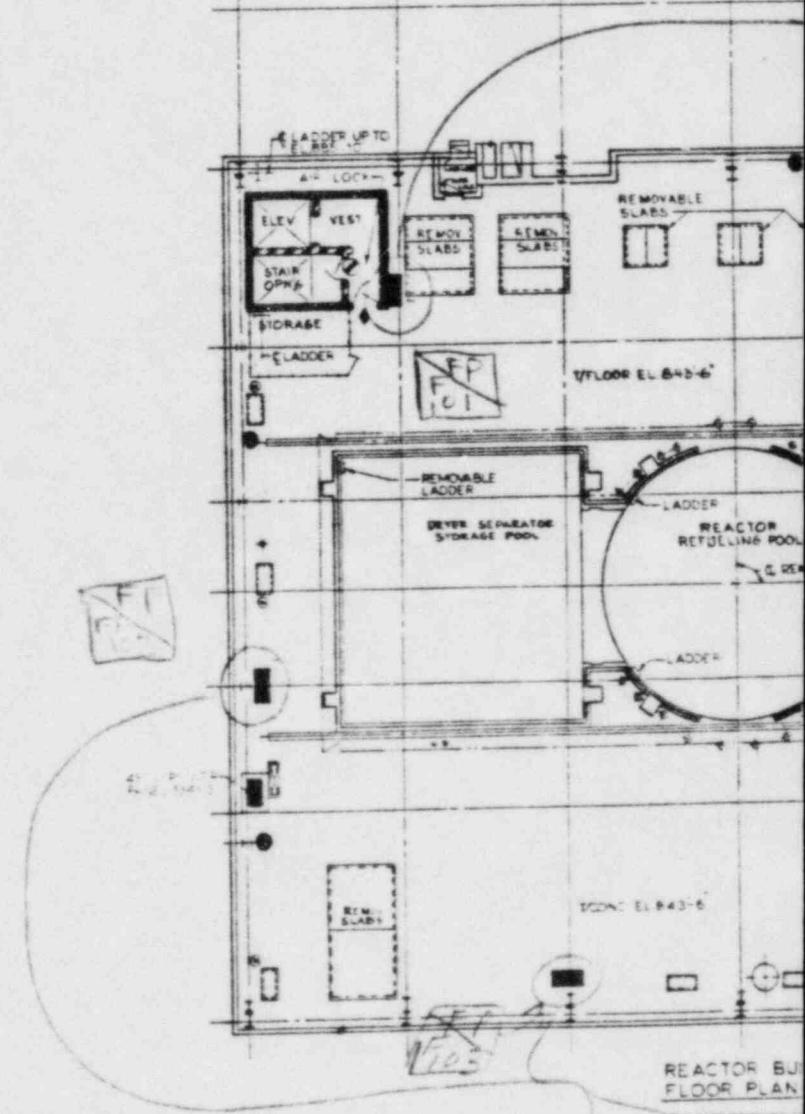


FIGURE 1

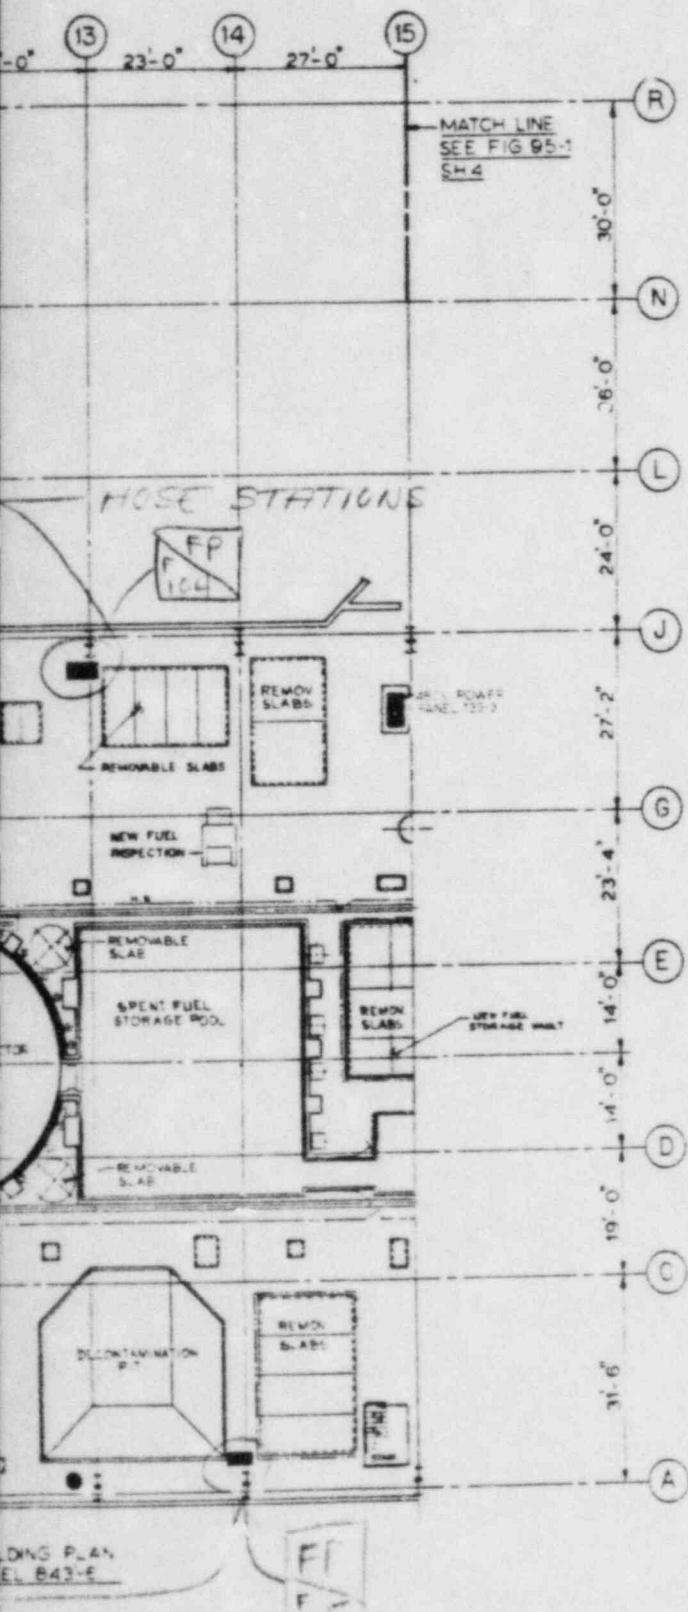

# PRC APERTURE CARD

Also Available On  
Aperture Card

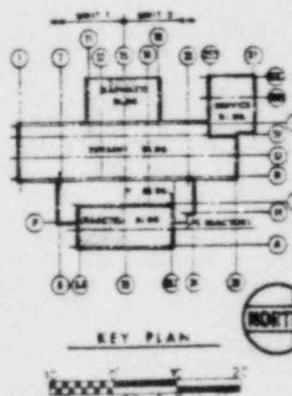

8311040130-01

LA SALLE COUNTY STATION

FINAL SAFETY ANALYSIS REPORT

FIGURE 95-1  
FIRE PROTECTION SYSTEM

SHEET 3 OF 4


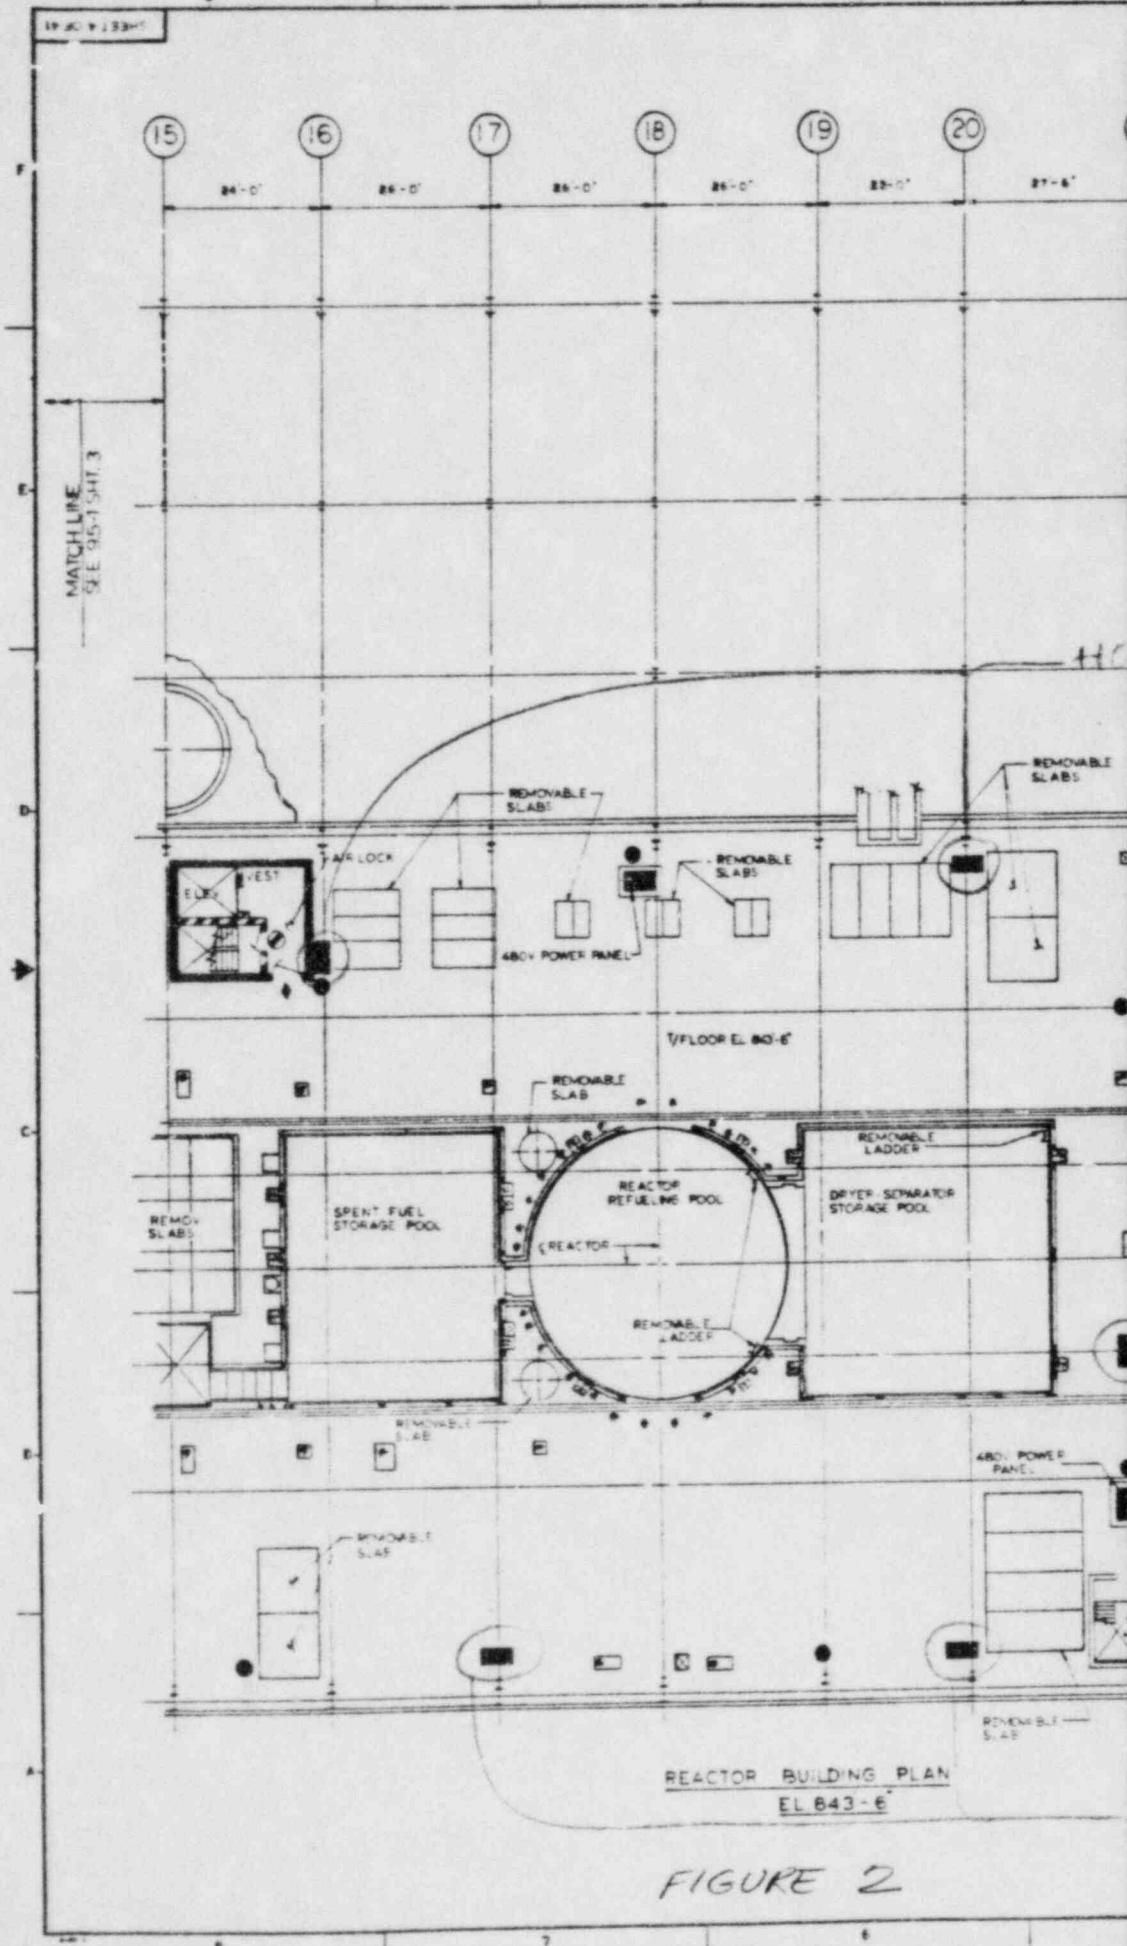


FIGURE 2

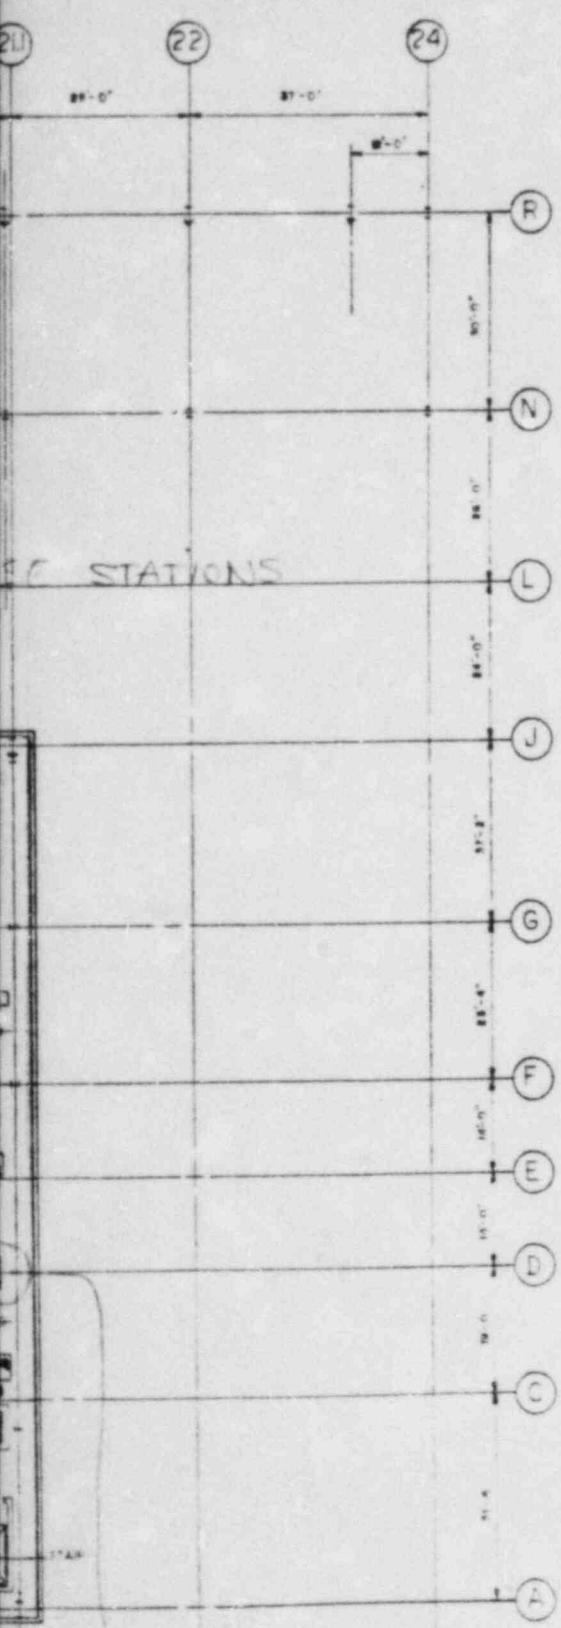


## STATIONS

## 400 C STATION

卷之三

Also Available On  
Aperture Card

PRC  
APERTURE  
CARD

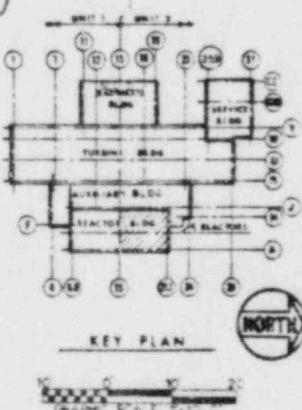

8311040130-62

**LA SALLE COUNTY STATION**

FINAL SAFETY ANALYSIS REPORT


FIGURE 9.5-1


• 100 •

PAGE 9

FIGURE 3

H-Q curves for  
3 pump schemes

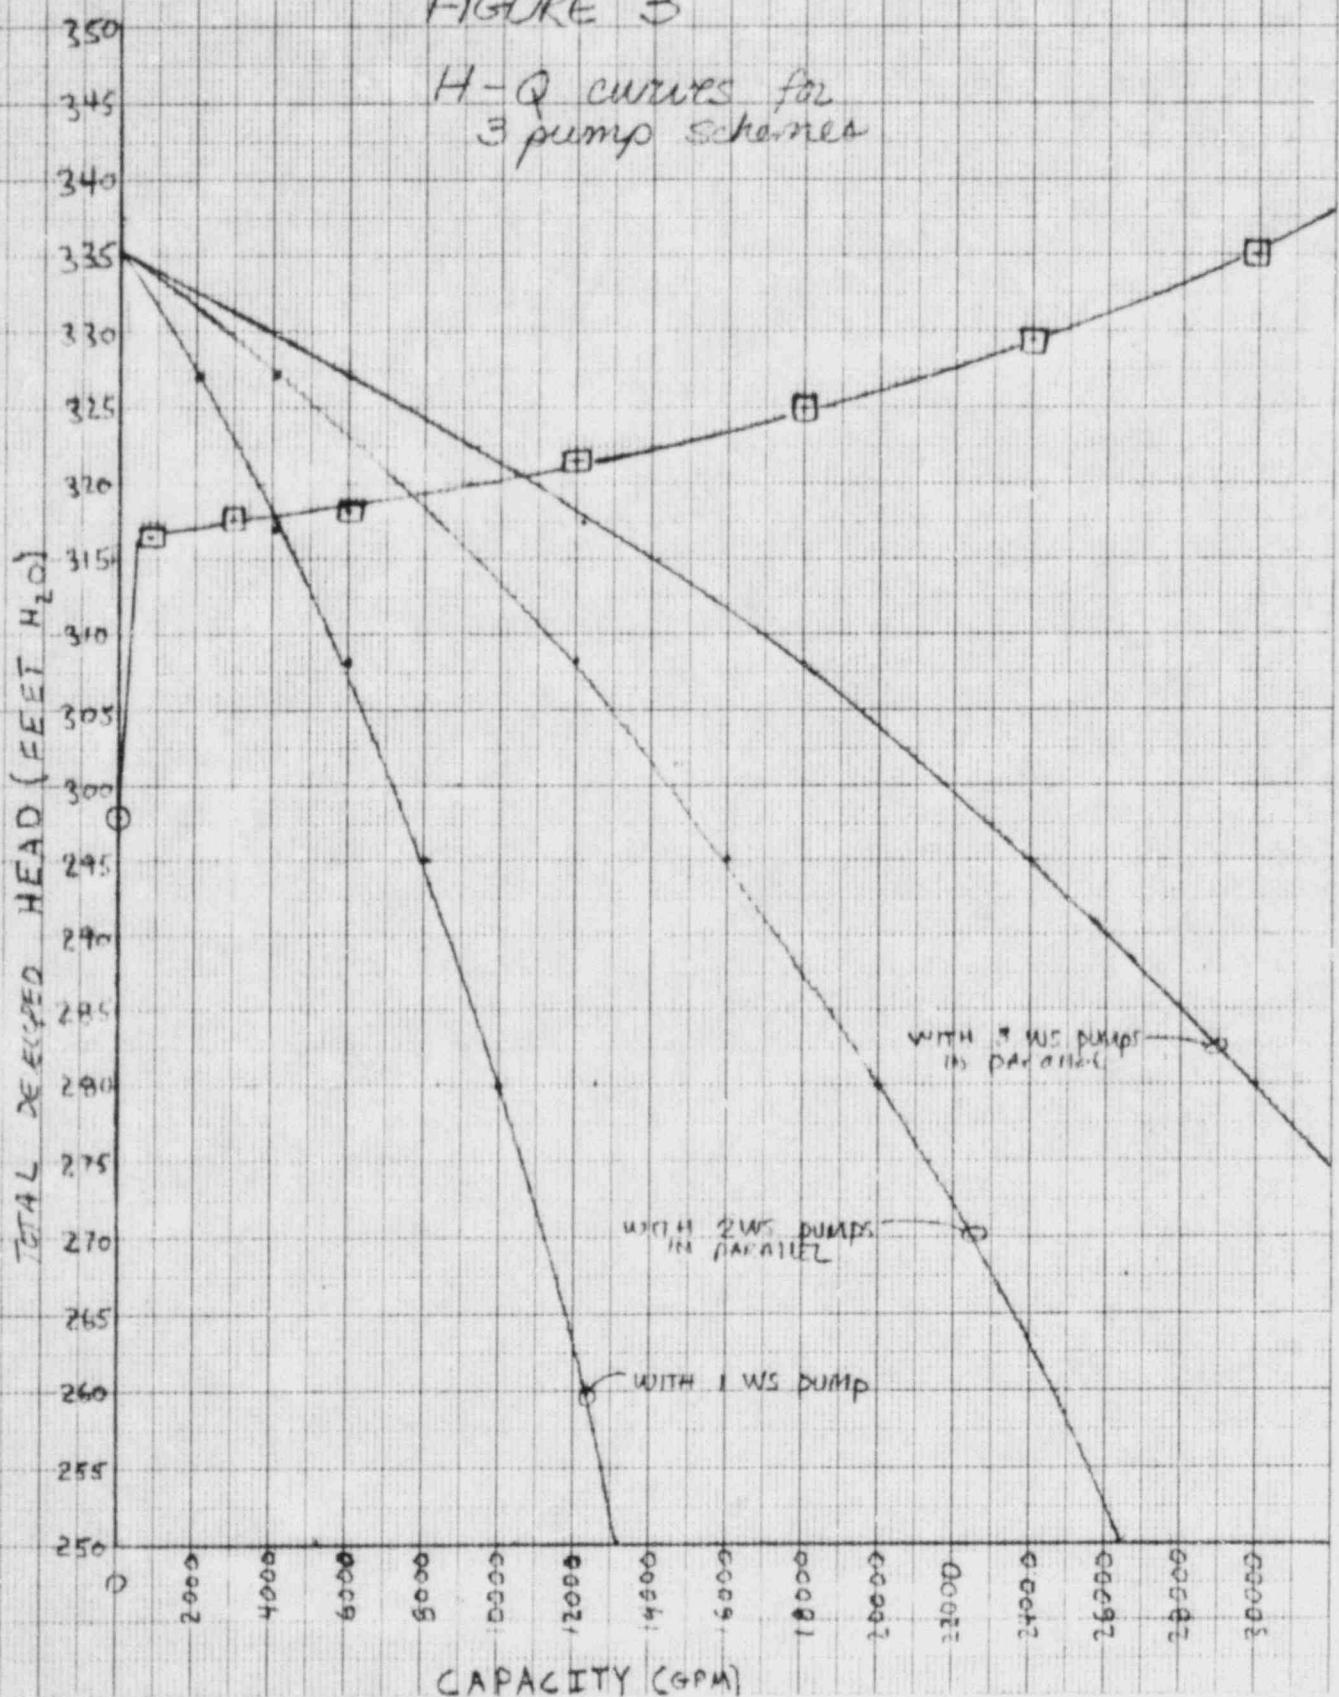

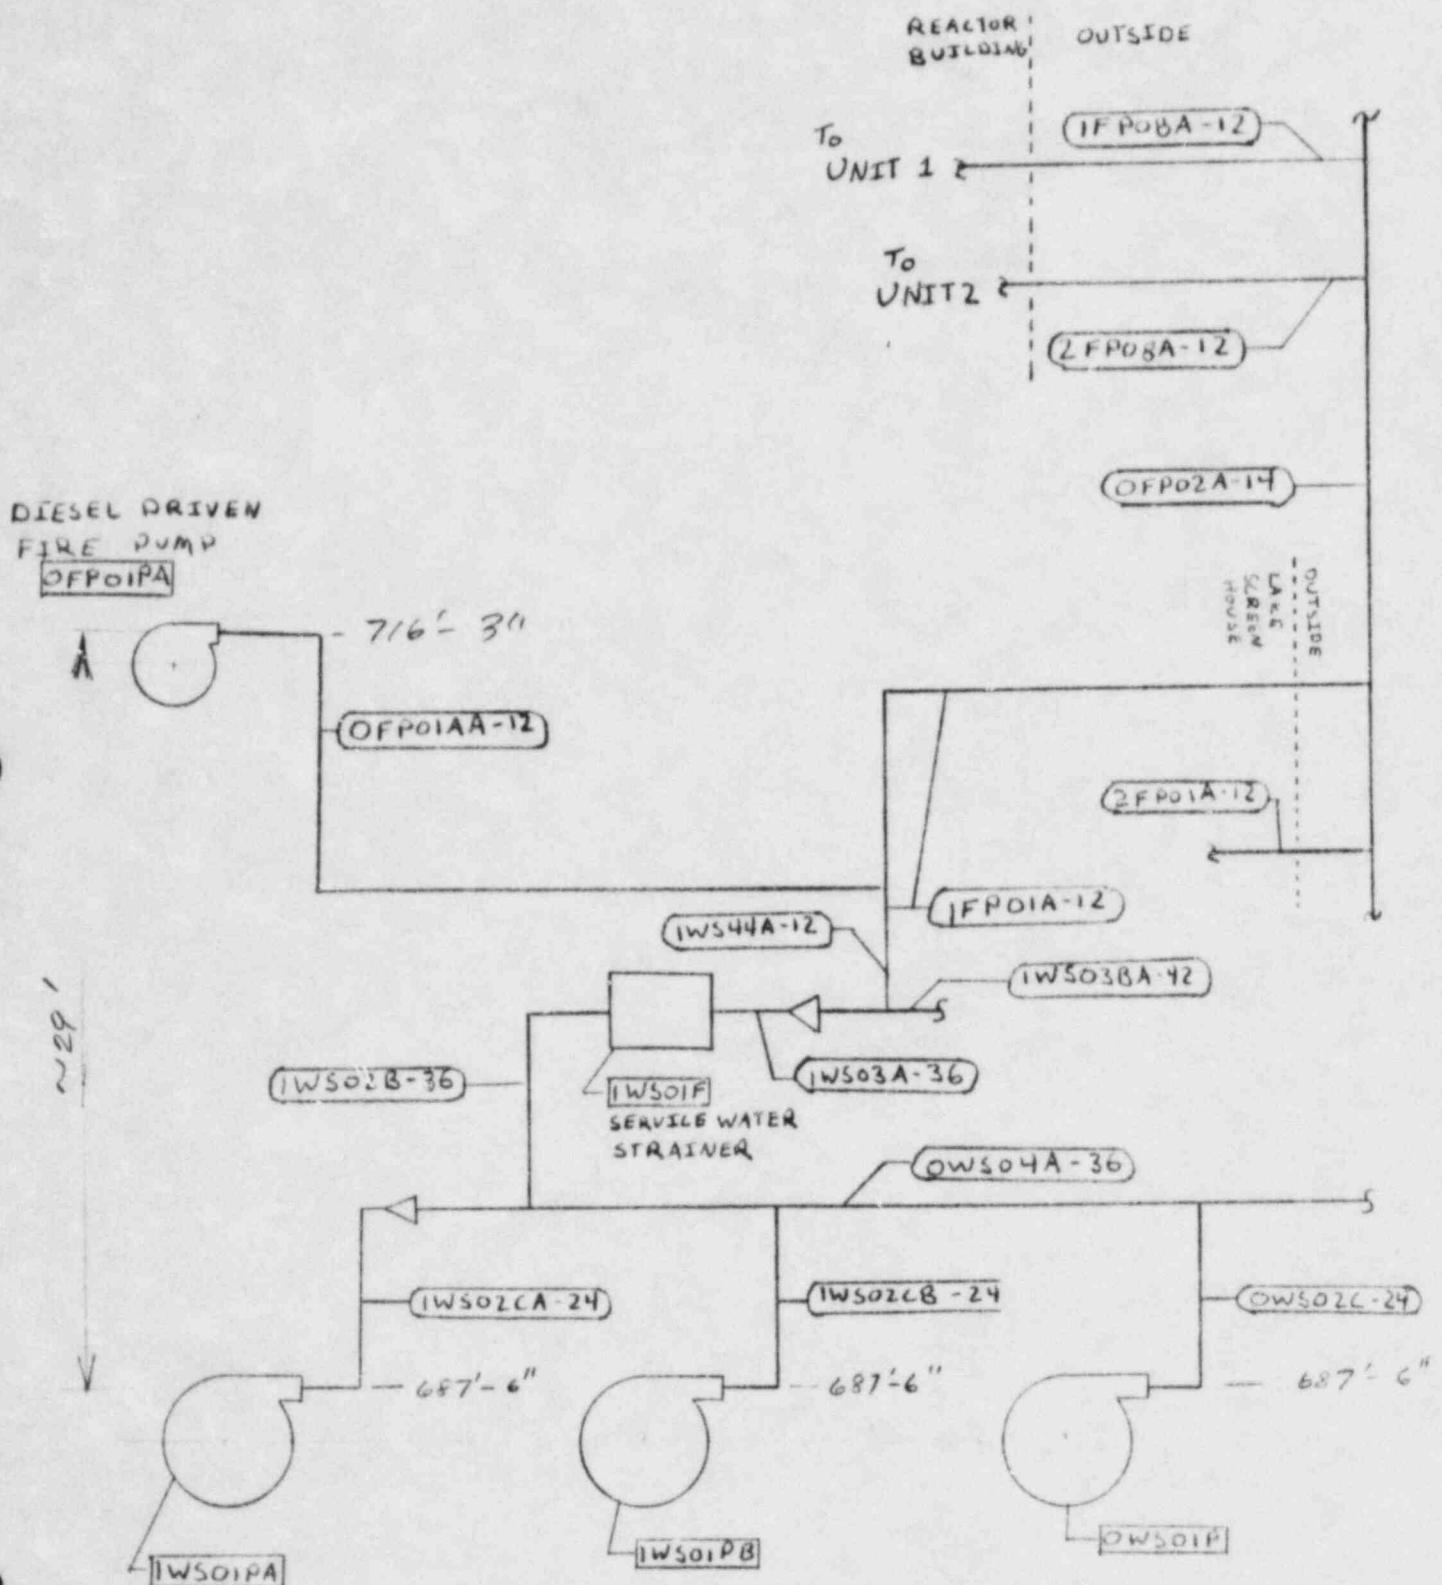

SERVICE WATER PUMPS - UNIT 1

### **SYSTEM ISOMETRIC**

1. BASED ON P&ID DRAWING NUMBER M-\_\_\_\_\_ DATED \_\_\_\_\_  
2. BASED ON PIPING DRAWING NUMBER M-\_\_\_\_\_ DATED \_\_\_\_\_

see figure 1  
for physics

## B. PIPING

**PROCESS FLOW DATA POINT**

A. EQUIPMENT (HT. EXCH., FILTERS, STRAINERS, FLOW NOZZLES, ETC.)

ASSUME DROP ACROSS  $\Delta$  IWSOIF = 1 ft H<sub>2</sub>O  
SCANNER

$$\Delta H_A(FT) = \quad \quad \quad$$

#### **REFERENCES:**

- (a) ME-2.16 PIPING - PRESSURE DROP THROUGH FITTINGS,  
VALVES AND DISCONTINUITIES.
  - (b) ME-2.12, ME-2.13, OR ME-2.14 PIPE SIZE SELECTION
  - (c) IF BACKING RINGS ARE OMITTED L/D CAN BE REDUCED BY 20% FOR ELBOWS

from Cameron Hydraulic Data, 1924-45, 14<sup>th</sup> Ed.

pump operator

## AND VALVES

FROM VANGUARD TO POINT A

C. ENTRANCE/EXIT LOSSES AND  
CHANGES IN PIPE SECTION

Typically, the velocity head is very small and when multiplied by  $\rho$ , the result is even smaller; e.g.,

#### D. CONTROL VALVES

Also Available On  
Aperture Card

$$\Delta H_F = \Delta H_A + \Delta H_B + \Delta H_C + \Delta H_D$$

$$\Delta H_F = \Delta H_A + \Delta H_B + \Delta H_C + \Delta H_D$$

$$\Delta H_F^{\circ}(\text{FT}) = 2 \cdot 0.55$$

S IN PIPING SEGMENT: \_\_\_\_\_

[View all reviews](#) | [Write a review](#)

---

JOB NO.

**STANDARDS**

STANDARD

**INT'L COND'Y SYSTEMS OF ENGINEERS**

CHICAGO

FOR OFFICE USE ONLY  
NOT TO BE SENT OUTSIDE OF  
SARGENT & LUNDY

HEAD LOSS IN PIPING SEGMENT: \_\_\_\_\_

**PROJECT** \_\_\_\_\_

CLIENT \_\_\_\_\_ JOB NO. \_\_\_\_\_

DESIGN BY:	DATE:	
CHECKED BY:	DATE:	
REVISED BY:	DATE:	



**STANDARD**

SYSTEM

SHOOT

8

8311040130-03

PAGE A-1

### SYSTEM ISOMETRIC

1. BASED ON P&ID DRAWING NUMBER M- \_\_\_\_\_ DATED \_\_\_\_\_  
2. BASED ON PIPING DRAWING NUMBER M- \_\_\_\_\_ DATED \_\_\_\_\_

**PROCESS FLOW DATA POINT**

A. EQUIPMENT (HT. EXCH., FILTERS, STRAINERS, FLOW NOZZLES, ETC.)

assume drop across

$$WFC/F = 2.0 \text{ ft } \frac{1}{2}$$

$$\Delta H_A(FT) = -20$$

## REFERENCES:

- (a) ME-2.16 PIPING - PRESSURE DROP THROUGH FITTINGS,  
VALVES AND DISCONTINUITIES.
  - (b) ME-2.12, ME-2.13, OR ME-2.14 PIPE SIZE SELECTION
  - (c) IF BACKING RINGS ARE OMITTED L/D CAN BE REDUCED BY 20% FOR ELBOWS

A) - expect 1/2

AND VALVES				C. ENTRANCE/EXIT LOSSES AND CHANGES IN PIPE SECTION						
DESCRIPTION (a)	L/D	QUANTITY L/D x QUANTITY OF FITTINGS FOR SIZES LISTED			(a) PAGE	DESCRIPTION	LINE SIZE	K	$v_a^2$ (FPS)	$\Delta H$ (FT.)
		1/2	3/4	1						
LONG RAD. ELBOW	20	3/4								
LONG RAD. ELBOW	12			1/2						
TEE (BRANCH FLOW)	60		1/2	1/2						
TEE (RUN FLOW)	20		1/2	1						
GLOBE VALVE	340									
CHECK VALVE	135	1/2								
GATE VALVE	13									
Flow Three P.T. 1/2" NPT	50	1/2								
Flow Three P.T. 1/2" NPT	40	1/4	1/4							
Butterfly Valve	40	1/4		1/8						
L/D		3/25	60	60	152					
PIPE DIAMETER (FT)		1.9375	2.957	2.957	2.957					
STR. PIPE (1x2) (FT)		630	175	175	443					
HT PIPE (FT)		49	6.83	15	14					
EQUIV. LENGTH (3+4)(FT)		679	192	190	457					
(%)										
(FT)		679	192	190	457					
(LB/HR) OR (GPM)		4000	8000	12000	12000					
HY v <sub>a</sub> (b) (FPS)		3.006 <sup>(*)</sup>	1.61 <sup>(*)</sup>	4.00 <sup>(*)</sup>	4.00 <sup>(*)</sup>					
00'(b) (FT/100 FT)		0.2016 <sup>(*)</sup>	1.015 <sup>(*)</sup>	2.02 <sup>(*)</sup>	2.02 <sup>(*)</sup>					
$\Delta H$ (5x10) (FT)		1.3689	.1945	.41	.41					
SELECTED		24	36	36	36					
NUMBER										
L $\Delta H$ (ITEM 11) FOR ALL SIZES, $\Delta H_B$ (FT)= 0.310										

$$\Delta H = K \frac{v_a^2}{64.4}$$

#### D. CONTROL VALVES

PRC  
APERTURE  
CARD  
Also Available On  
Aperture Card

$$\Delta H_D \text{ (FT)} =$$

$$\Delta H_F = \Delta H_A + \Delta H_B + \Delta H_C + \Delta H_D$$

$$\Delta H_F \text{ (FT)} = \approx 5.0$$

FOR OFFICE USE ONLY NOT TO BE SENT OUTSIDE OF SARGENT & LUNDY				HEAD LOSS IN PIPING SEGMENT: _____			
DESIGN BY:	DATE:	PROJECT _____	STANDARD _____				
CHECKED BY:	DATE:	CLIENT _____	JOB NO. _____				
REVISED BY:	DATE:	SARGENT & LUNDY ENGINEERS CHICAGO	SYSTEM _____ SHEET _____ 2 OF 8				

8311040130-04

PAGE A-2

### SYSTEM ISOMETRIC

1. BASED ON P&ID DRAWING NUMBER M-
  2. BASED ON PIPING DRAWING NUMBER M

DATED \_\_\_\_\_

SEE Figures 1, 2, 3  
for physiALS

 PROCESS FLOW DATA POINT

A. EQUIPMENT (HT. EXCH., FILTERS, STRAINERS, FLOW NOZZLES, ETC.)

IF P04M - 12" STRAINER - ASSUME 10.1 PSI DROP  
Y-TYPE STRAINER

conservatively assumed  
since Leslie Pathog Bulletin  
70/3-11 indicates a mean  
rainfall equals  $0.015^{+0.6}$  ft  $\Delta H_A(FT) = 1.231$  ft

#### REFERENCES:

- (a) ME-2.16 PIPING - PRESSURE DROP THROUGH FITTINGS,  
VALVES AND DISCONTINUITIES.
  - (b) ME-2.12, ME-2.13, OR ME-2.14 PIPE SIZE SELECTION
  - (c) IF BACKING RINGS ARE OMITTED L/D CAN BE REDUCED BY 20% FOR ELBOWS

(\*) - from Cameron Hydraulic Data, pg 41 & 42, 13th Ed.

AND VALVES "A" TO "U2" & "U2" TO "B"					C. ENTRANCE/EXIT LOSSES AND CHANGES IN PIPE SECTION						
DESCRIPTION (a)	L/D	QUANTITY L/D X QUANTITY OF FITTINGS FOR SIZES LISTED				(a) PAGE	DESCRIPTION	LINE SIZE	K	$v_a^2$ (FPS)	$\Delta H$ (FT.)
ING RAD. ELBOW	20	1 20 3	60		7 140						
ING RAD. ELBOW	12		672	448							
EE (BRANCH FLOW)	60										
EE (RUN FLOW)	20										
GLOBE VALVE	340										
CHECK VALVE	135	1 735									
ATE VALVE	13	1 13	1 13		1 13						
GS w/ REDUCED E BRANCHES	39	1 39									
Values - fully expanded	40		1 40	2 60	1 40	2 80					
Three Run	54										
ed 3/8" Branch Three Branch	57			1 14		1 14					
/D		207	185	242	193	248					
DE DIAMETER) (FT)		1.0	1.0	1.104	1.0	1.104					
STR. PIPE (1x2) (FT)		207	185	267.2	193	273.8					
T PIPE (FT)		8.4	729.2	203	210	123					
QUIV. LENGTH (3+4)(FT)		215.4	914.2	470.2	403	396.8					
(O %)											
	(FT)	215	914	470	403	397					
	(LB/HR) OR (GPM)	750	750	375	375	750					
Y $v_a$ (b) (FPS)		2.15	2.15	0.93 (*)	1.07 (*)	1.745 (*)					
$\Delta H$ (b) (FT/100 FT)		0.25	0.25	0.047 (*)	0.065 (*)	0.15 (*)					
$\Delta H$ (5x10) (FT)		1.54	1.25	0.22	0.274	0.60					
SELECTED		12	12	14	12	14					
NUMBER		10.504A	IFPCIA	CFP02A	IFP05A	CFP07A					
$\Delta H$ (ITEM 11) FOR ALL SIZES, $\Delta H_B$ (FT) = 3.934											

$$\Delta H_c \text{ (FT)} = 0$$

ASSUMED NEGIGIBLE

$$\Delta H = K \frac{v_a^2}{54.4}$$

#### D. CONTROL VALVES

APERTURE  
CARD

Also Available On  
Aperture Card

$$\Delta H_D \text{ (FT)} = 0$$

$$\Delta H_F = \Delta H_A + \Delta H_B + \Delta H_C + \Delta H_D$$

$$\Delta H_F \text{ (FT)} = 4.16 \text{ ft}$$

HEAD LOSS IN PIPING SEGMENT: \_\_\_\_\_

PROJECT \_\_\_\_\_  
CLIENT \_\_\_\_\_ JOB NO. \_\_\_\_\_

FOR OFFICE USE ONLY  
NOT TO BE SENT OUTSIDE OF  
SARGENT & LUNDY

DESIGN BY:	DATE:
CHECKED BY:	DATE:
REVISED BY:	DATE:



STANDARD	SYSTEM	SHEET OF
		3 8

8311040130-05

PAGE A-3



VALVES

-103-

## C. ENTRANCE/EXIT LOSSES AND CHANGES IN PIPE SECTION

DESCRIPTION (a)	L/D	QUANTITY L/D x QUANTITY OF FITTINGS FOR SIZES LISTED			(a) PAGE	DESCRIPTION	LINE SIZE	K	$v_a^2$ (FPS)	$\Delta H$ (FT.)
		E → F	F → J							
90° RAD. ELBOW	20	1/20	0	2/40						
90° RAD. ELBOW	12	1/12	0	0						
TE (BRANCH FLOW)	60	0	0	0						
TE (RUN FLOW)	20	0	0	0						
LOBE VALVE	340	0	0	0						
CHECK VALVE	135	0	0	0						
ATE VALVE	13	1/13	1/13	0						
Flow Thru Branch	50	1/50	0							
Flow Thru Branch w/ Reduced Area	53	1/53								
Flow Thru Branch	24	3/73								
Flow Thru Branch	42	1/42								
D		95	181	40						
PIPE DIAMETER) (FT)		.6651	.5054	.2058						
STR. PIPE (1x2) (FT)		63.18	91.48	8.232						
WT PIPE (FT)		25.23	117.25	7						
QUIV. LENGTH (3+4)(FT)		88.4	208.73	15.232						
( <u>0.4</u> )										
(FT)		88	209	15.2						
(LB/HR) OR (GPM)		225	75	75						
$v_a$ (b) (FPS)		1.44	.825 (*)	5.03						
$\delta H$ (b) (FT/100 FT)		0.41	-10 (*)	7.55						
$\delta H$ (5x10) (FT)		.169	.21	1.1476						
ELECTED		8	6	2.12						
NUMBER		1FP18A	1FP5CA	1FP5CE						
$\Delta H$ (ITEM 11) FOR ALL SIZES, $\Delta H_B$ (FT)= 1.32										

$$\Delta H = K \frac{v_a^2}{64.4}$$

D. CONTROL VALVES  
APERTURE  
CARDAlso Available On  
Aperture Card

$$\Delta H_D$$
 (FT) = 0

$$\Delta H_F = \Delta H_A + \Delta H_B + \Delta H_C + \Delta H_D$$

$$\Delta H_F$$
 (FT) = 1.52  $\Delta H$

HEAD LOSS IN PIPING SEGMENT:			
PROJECT _____		STANDARD _____	
CLIENT _____		JOB NO. _____	
DESIGN BY:	DATE:	SYSTEM	SHEET 4 OF 8
CHECKED BY:	DATE:	SARGENT & LUNDY ENGINEERS CHICAGO	
REVISED BY:	DATE:		

8311040130-66  
PAGE A-4



AND VALVES

-105-

## C. ENTRANCE/EXIT LOSSES AND CHANGES IN PIPE SECTION

DESCRIPTION (a)	L/D	QUANTITY L/D X QUANTITY OF FITTINGS FOR SIZES LISTED			(a) PAGE	DESCRIPTION	LINE SIZE	K	$v_a^2$ (FPS)	$\Delta H$ (FT.)
		F → G	G → I							
90° RAD. ELBOW	20	1/20	6/120	8.5 <sup>(*)</sup>						
90° RAD. ELBOW	12	4/48	2/24	2.4						
TE (BRANCH FLOW)	60	0	0	0						
TE (RUN FLOW)	20	0	0	1/20						
LOBE VALVE	340	0	0	0						
HECK VALVE	135	0	0	0						
ATE VALVE	13	0	1/12	0						
Flow thru non flowing w/ branch	46	1/46	0	0						
Flow thru long fitting w/ branch	53	0	1/53	0						
flow thru	42	0	1/42	0						
flow thru	30	3/90	0	0						
flow thru	20	1/20	6	0						
flow thru	40		1/40	0						
flow thru	25		2/50	0						
D		224	342	214						
PIPE DIAMETER) (FT)		.6651	.5054	.2058						
STR. PIPE (1x2) (FT)		149	172.8	44.0						
WT PIPE (FT)		107.7	93.2	128.0						
QUIV. LENGTH (3+4)(FT)		257	266.0	172						
(%)										
(FT)	257	266	172							
(LB/HR) OR (GPM)	150	75	75							
$v_a$ (b) (FPS)	.96 <sup>(*)</sup>	.835 <sup>(*)</sup>	5.63							
$\Delta H$ (b) (FT/100 FT)	.091 <sup>(*)</sup>	.10 <sup>(*)</sup>	7.55							
$\Delta H$ (5x10) (FT)	.23	.27	13.0							
ELECTED	8	6	2 1/2							
NUMBER	IFP18A	IFP10A	IFP90B							
$\Delta H$ (ITEM 11) FOR ALL SIZES, $\Delta H_B$ (FT)= 13.67										

$$\Delta H_c \text{ (FT)} = 0$$

$$\Delta H = K \frac{v_a^2}{64.4}$$

## D. CONTROL VALVES

PRC  
APERTURE  
CARDAlso Available On  
Aperture Card

$$\Delta H_D \text{ (FT)} = 0$$

$$\Delta H_F = \Delta H_A + \Delta H_B + \Delta H_C + \Delta H_D$$

$$\Delta H_F \text{ (FT)} = 13.7 \text{ ok}$$

HEAD LOSS IN PIPING SEGMENT: \_\_\_\_\_

PROJECT \_\_\_\_\_  
CLIENT \_\_\_\_\_ JOB NO. \_\_\_\_\_

DESIGN BY:	DATE:	SARGENT & LUNDY ENGINEERS CHICAGO	STANDARD
CHECKED BY:	DATE:	SYSTEM	SHEET OF 8
REVISED BY:	DATE:		

BOW

8311040130-07

PAGE A-5

### SYSTEM ISOMETRIC

F4/104

1. BASED ON P&ID DRAWING NUMBER M- \_\_\_\_\_ DATED \_\_\_\_\_  
2. BASED ON PIPING DRAWING NUMBER M- \_\_\_\_\_ DATED \_\_\_\_\_

## B. PIPING A

**PROCESS FLOW DATA POINT**

- A. EQUIPMENT (HT. EXCH., FILTERS, STRAINERS, FLOW NOZZLES, ETC.)

$$\Delta H_A(\text{FT}) =$$

#### **REFERENCES:**

(+) assumed  $\Delta H = 0$

- (a) ME-2.16 PIPING - PRESSURE DROP THROUGH FITTINGS,  
VALVES AND DISCONTINUITIES.  
(b) ME-2.12, ME-2.13, OR ME-2.14 PIPE SIZE SELECTION  
(c) IF BACKING RINGS ARE OMITTED L/D CAN BE REDUCED BY 20% FOR ELBOWS

(\*) From Cameron Puds. Data, 13<sup>th</sup> Ed., Pg 38, 76.

END VALVES

-104-

## C. ENTRANCE/EXIT LOSSES AND CHANGES IN PIPE SECTION

DESCRIPTION (a)	L/D	QUANTITY L/D X QUANTITY OF FITTINGS FOR SIZES LISTED					(a) PAGE	DESCRIPTION	LINE SIZE	K	$v_a^2$ (FPS)	$\Delta H$ (FT.)
		1	2	3	4	5						
S RAD. ELBOW	20	2	40	8	160	2	60	4	80			
G RAD. ELBOW	12	0	2	24	2	24	0					
(BRANCH FLOW)	60	0	1	60	0	0						
(RUN FLOW)	20	1	20	0	0	0						
LOBE VALVE	340	0	0	0	0	0						
NECK VALVE	135	0	0	0	0	0						
TE VALVE	13	2	210	1	13	0	0					
Three run	46	1	46	0	0	0						
Two run	30	1	30	0	0	0						
One run	20	0	2	40	0	0						
in branch	53	0	0	1	53	0						
one run	25	0	0	2	50	0						
		162	297	187	80							
DIA. DIAMETER) (FT)	.6651	.6651	.5054	.2058								
TR. PIPE (1x2) (FT)	107.8	197.5	94.5	16.5								
PIPE (FT)	82.4	132.5	44.5	49.75								
UTV. LENGTH (3+4)(FT)	190.2	330.0	139.0	65.75								
(%)												
(FT)	190	330	139	66								
(LB/HR) OR (GPM)	75	75	75	75								
$v_a$ (b) (FPS)	0.015	0.015	.835*	5.03								
'(b) (FT/100 FT)	0.022	0.022	.10 <sup>14</sup> )	7.55								
H (5x10) (FT)	0.04	0.08	139	4.98								
SELECTED	8	9	6	7 <sup>1</sup> / <sub>2</sub>								
BER	1FP1RA	1FP92A	1FP70	F007H								
$\Delta H$ (ITEM 11) FOR ALL SIZES, $\Delta H_B$ (FT) = 5.24												

$$\Delta H = K \frac{v_a^2}{64.4}$$

## D. CONTROL VALVES

FRC  
APERTURE  
CARDAlso Available On  
Aperture Card

$$\Delta H_D \text{ (FT)} = 0$$

$$\Delta H_F = \Delta H_A + \Delta H_B + \Delta H_C + \Delta H_D$$

$$\Delta H_F \text{ (FT)} = 5.24 + 6$$

HEAD LOSS IN PIPING SEGMENT: \_\_\_\_\_

PROJECT \_\_\_\_\_  
CLIENT \_\_\_\_\_ JOB NO. \_\_\_\_\_

DESIGN BY:	DATE:	STANDARD	
CHECKED BY:	DATE:	SYSTEM	
REVISED BY:	DATE:	SHEET OF 8	

SARGENT & LUNDY  
ENGINEERS  
CHICAGO

8311040130-09

PAGE A-6

### SYSTEM ISOMETRIC

1. BASED ON P&ID DRAWING NUMBER M- \_\_\_\_\_ DATED \_\_\_\_\_  
2. BASED ON PIPING DRAWING NUMBER M- \_\_\_\_\_ DATED \_\_\_\_\_

FP 102

SEE figure 4 and 5  
for Phycals.

B. PIPING A	
(a) PAGE	
ITEM	DES
7	3 90° LOM
7	4 45° LOM
7	5 STD. TE
7	6 STD. TE
6	1a CONV. G
6	4a SWING C
6	5a DISC GA
8	8-4 ft
8	8-6 ft
8	8-6 ft
9	6-2 ft
1.	TOTAL L
2.	D (INSID)
3.	EQUIV. S
4.	STRAIGHT
5.	TOTAL EQ
6.	MARGIN
7.	TOTAL
8.	FLOW
9.	VELOCITY
10.	$\Delta H/100$
11.	TOTAL $\Delta$
12.	SIZES S
13.	LINE NUM
SUM OF TOTAL	

PROCESS FLOW DATA POINT

- A. EQUIPMENT (HT. EXCH., FILTERS, STRAINERS, FLOW NOZZLES, ETC.)

$$\Delta H_A(FT) = 0$$

#### REFERENCES:

- (a) ME-2.16 PIPING - PRESSURE DROP THROUGH FITTINGS,  
VALVES AND DISCONTINUITIES.
  - (b) ME-2.12, ME-2.13, OR ME-2.14 PIPE SIZE SELECTION
  - (c) IF BACKING RINGS ARE OMITTED L/D CAN BE REDUCED BY 20% FOR ELBOWS

(\*) Casuistische Begriffe, 1979, 14<sup>th</sup> Ed.

END VALVES

-102-

## C. ENTRANCE/EXIT LOSSES AND CHANGES IN PIPE SECTION

DESCRIPTION (a)	L/D	QUANTITY X L/D X QUANTITY OF FITTINGS FOR SIZES LISTED				(a) PAGE	DESCRIPTION	LINE SIZE	K	$v_a^2$ (FPS)	$\Delta H$ (FT.)
		B-C	C-D	D-E	E-F						
90 RAD. ELBOW	20	3	60	3	60	20					
90 RAD. ELBOW	12	5	60	3	36	48					
BRANCH FLOW	60	0	0	0	0						
RUN FLOW	20	1	20	0	0	20					
LOBE VALVE	340	0	0	0	0						
CHECK VALVE	135	0	0	0	0						
TE VALVE	13	1	13	1	13	0					
in line run	30	3	90	0	0						
in line run	46	1	46	0	0						
in line branch	53	1	53	0	0						
flow line run	25	4	100	0	0						
D	342	209	69	20							
PIPE DIAMETER (FT)	.6851	.5054	.2058	1.0							
TR. PIPE (1x2) (FT)	227.5	105.6	14.0	20							
PIPE (FT)	142.7	118	64	5.0							
NET LENGTH (3+4)(FT)	370.2	224	78	25							
(O %)											
(FT)	370	224	78	25							
(LB/HR) OR (GPM)	150	75	75	150							
$v_a$ (b) (FPS)	0.96	0.84	5.63	0.43							
'(b) (FT/100 FT)	.091 <sup>(+)</sup>	10 <sup>(+)</sup>	7.55	0.011							
H (5x10) (FT)	.34	.22	5.87	~0.006							
SELECTED	8	6	2 $\frac{1}{2}$	12							
NUMBER	1F10SE	1FP79A	FPAD	1EP08A							
$\Delta H$ (ITEM 11) FOR ALL SIZES, $\Delta H_B$ (FT)=	6.45										

6x2 $\frac{1}{2}$  reduced  $\Delta H_C$  (FT) 0.3

"K" assumed to equal .75

$$\Delta H = K \frac{v_a^2}{64.4} = 0.75 \left( \frac{5.63^2}{64.4} \right) = 0.3$$

This is worst case all other cases are more gradual.

## D. CONTROL VALVES

PVC

APERTURE CARD

Also Available On  
Aperture Card

$$\Delta H_D$$
 (FT) = 2

$$\Delta H_F = \Delta H_A + \Delta H_B + \Delta H_C + \Delta H_D$$

$$\Delta H_F$$
 (FT) = 6.8

HEAD LOSS IN PIPING SEGMENT: \_\_\_\_\_

PROJECT \_\_\_\_\_  
CLIENT \_\_\_\_\_ JOB NO. \_\_\_\_\_FOR OFFICE USE ONLY  
NOT TO BE SENT OUTSIDE OF  
SARGENT & LUNDY

DESIGN BY:	DATE:
CHECKED BY:	DATE:
REVISED BY:	DATE:



STANDARD

SYSTEM

SHEET  
7 OF 88311040130-09  
PAGE A-7

### SYSTEM ISOMETRIC

E8101

1. BASED ON P&ID DRAWING NUMBER M- \_\_\_\_\_ DATED \_\_\_\_\_  
2. BASED ON PIPING DRAWING NUMBER M- \_\_\_\_\_ DATED \_\_\_\_\_

## B. PIPING A

(8)  
PAGE

ITEM	DES
7 3	90° LONG.
7 4	45° LONG.
7 5	STD. TUBE
7 6	STD. TUBE
6 1a	CONV. C
6 4a	SWING C
6 5a	DISC G
?	8-6
?	6-24
8B	6-27
1. TOTAL	
2. D (INS)	
3. EQUIV.	
4. STRAIG.	
5. TOTAL	
6. MARGIN	
7. TOTAL	
8. FLOW	
9. VELOC	
10. $\Delta H$ /	
11. TOTAL	
12. SIZES	
13. LINE	
SUM OF TOT	

PROCESS FLOW DATA POINT

A. EQUIPMENT (H. EXCH., FILTERS, STRAINERS, FLOW NOZZLES, ETC.)

$$\Delta H_A(FT) = 0$$

#### REFERENCES:

(a) ME-2.16 PIPING - PRESSURE DROP THROUGH FITTINGS,  
VALVES AND DISCONTINUITIES.

(b) ME-2.12, ME-2.13, OR ME-2.14 PIPE SIZE SELECTION  
VALVES AND DISCONTINUED

(b) ME-2.12, ME-2.13, OR ME-2.14 PIPE SIZE SELECTION  
(c) IF BACKING RINGS ARE OMITTED L/D CAN BE REDUCED BY 20% FOR ELBOWS

(\*) from Cancer Incidence Data, Jan 39, 5th Ed.

ND VALVES

- 101 -

## C. ENTRANCE/EXIT LOSSES AND CHANGES IN PIPE SECTION

DESCRIPTION (a)	L/D	QUANTITY L/D X QUANTITY OF FITTINGS FOR SIZES LISTED				(a) PAGE	DESCRIPTION	LINE SIZE	K	$v_a^2$ (FPS)	$\Delta H$ (FT.)
		C	1/2	3/4	1						
90 RAD. ELBOW	20	5	100	120	240	40					
90 RAD. ELBOW	12	1	12	24	24	0					
TE (BRANCH FLOW)	60	1	60	0	0	0					
TE (RUN FLOW)	20	1	20	20	0	0					
LOBE VALVE	340	0	0	0	0	0					
HECK VALVE	135	0	0	0	0	0					
ATE VALVE	13	2	26	13	0	0					
flow thru run	46	1	46	0	0	0					
flow thru run	25	0	0	2	50	0					
flow thru branch	42	0	0	0	0	42					
L/D		264	77	114	82						
PIPE DIAMETER (FT)		.6651	.6651	.5054	.2058						
STR. PIPE (1x2) (FT)		175.6	51	57.6	16.88						
HT PIPE (FT)		71.7	84.2	64.6	25.5						
EQUIV. LENGTH (3+4)(FT)		247.3	135.2	122.2	42.38						
(%)											
(FT)		247	135	122	42.4						
(LB/HR) OR (GPM)		75	75	75	75						
TX $v_a$ (b) (FPS)		0.48	0.48	0.84	5.03						
100' (b) (FT/100 FT)		0.022	0.022	.10 <sup>12</sup>	7.55						
$\Delta H$ (5x10) (FT)		0.06	0.03	.012	3.2						
SELECTED		8	8	6	2 1/2						
NUMBER		1F1008	1F177A	1F177B	1F177C						
AL $\Delta H$ (ITEM 11) FOR ALL SIZES, $\Delta H_B$ (FT)= 3.3											

$$\Delta H = K \frac{v_a^2}{64.4}$$

PRC  
APERTURE  
CARD

## D. CONTROL VALVES

Also Available On  
Aperture Card

$$\Delta H_D \text{ (FT)} = 0$$

~~$$\Delta H_F = \Delta H_A + \Delta H_B + \Delta H_C + \Delta H_D$$~~

~~$$\Delta H_F \text{ (FT)} = 3.3 \text{ ft}$$~~


HEAD LOSS IN PIPING SEGMENT:			
PROJECT _____		JOB NO. _____	
CLIENT _____		STANDARD _____	
DESIGN BY:	DATE:	SYSTEM	SHEET
CHECKED BY:	DATE:	8 OF 8	
REVISED BY:	DATE:		
SARGENT & LUNDY ENGINEERS CHICAGO			


8311040130-10

PAGE A-8


K-E ISOMETRIC ORTHOGRAPHIC #1943  
HELMET & GEAR CO., MADE IN U.S.A.

47 4030

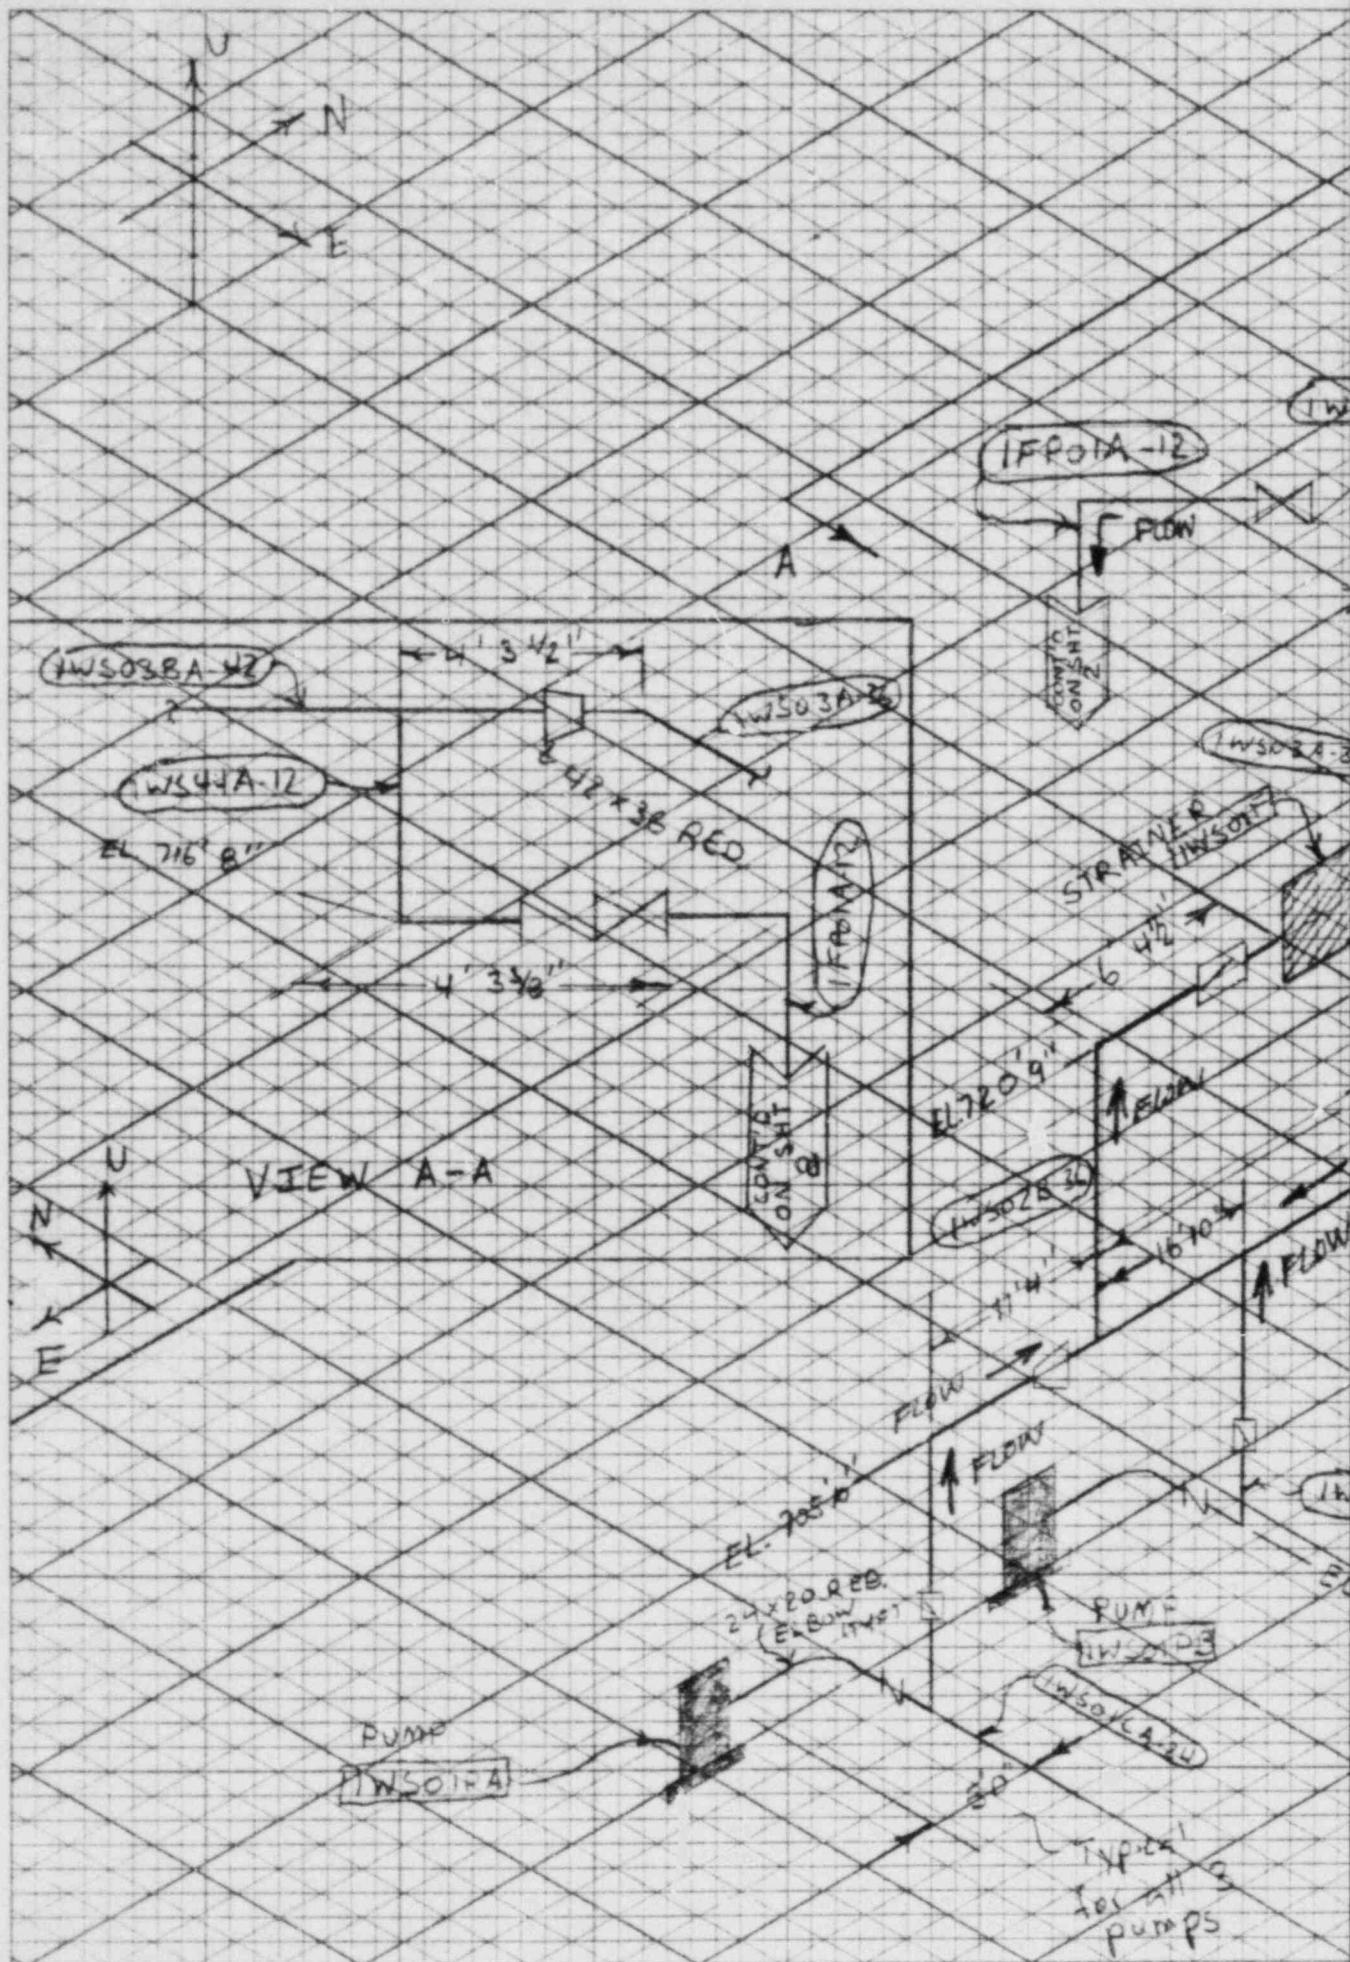

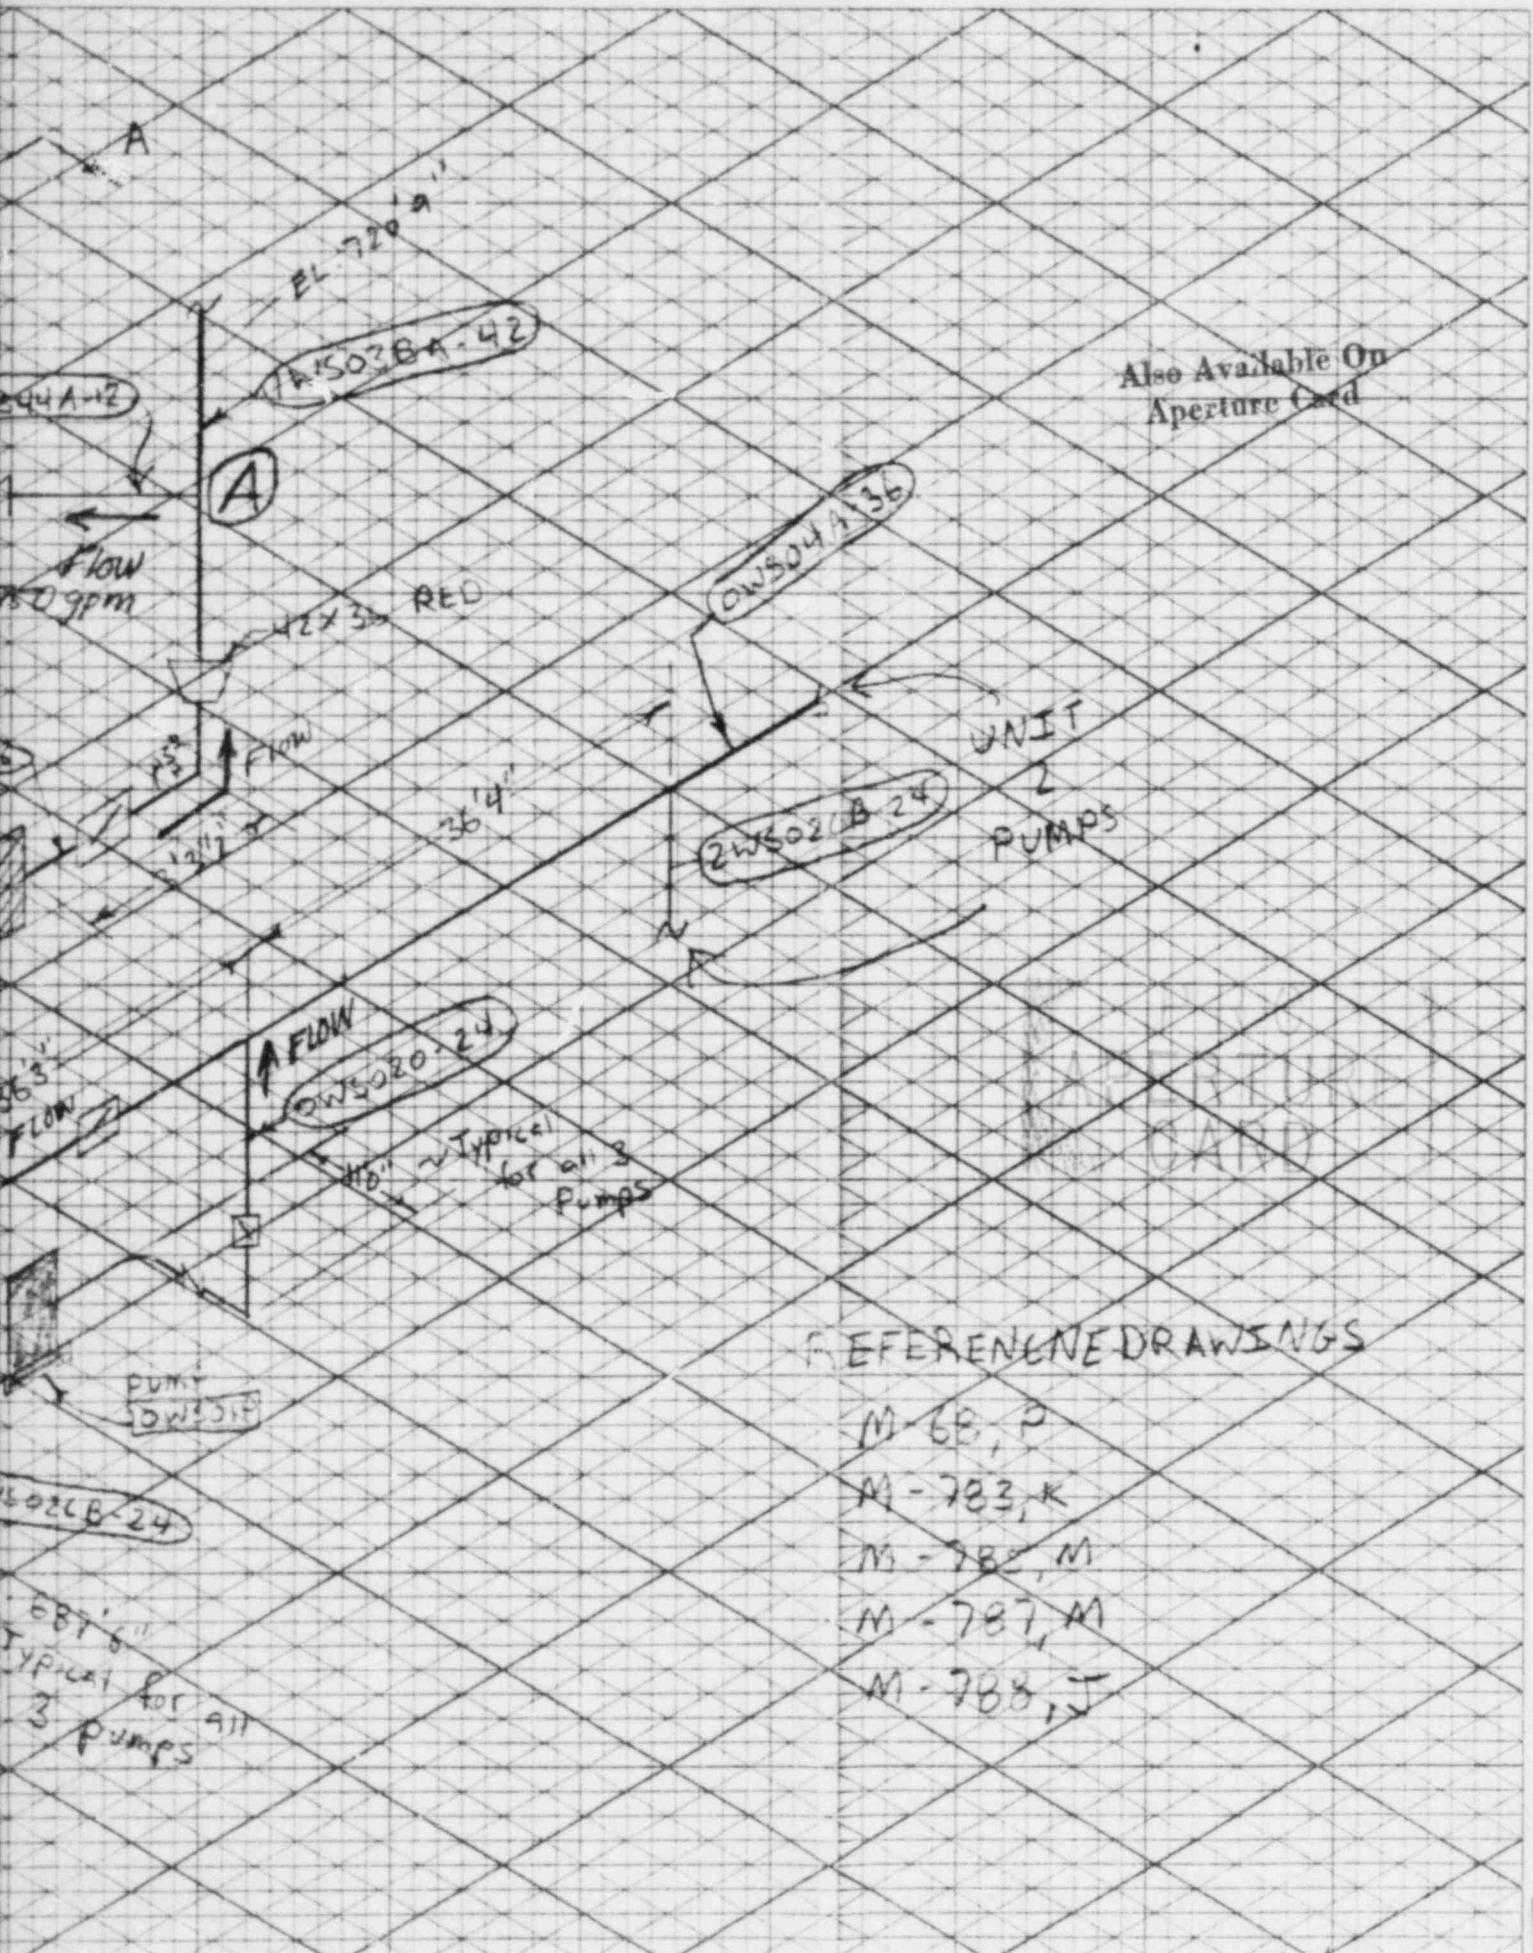

SHT 1/8  
8311040130-11

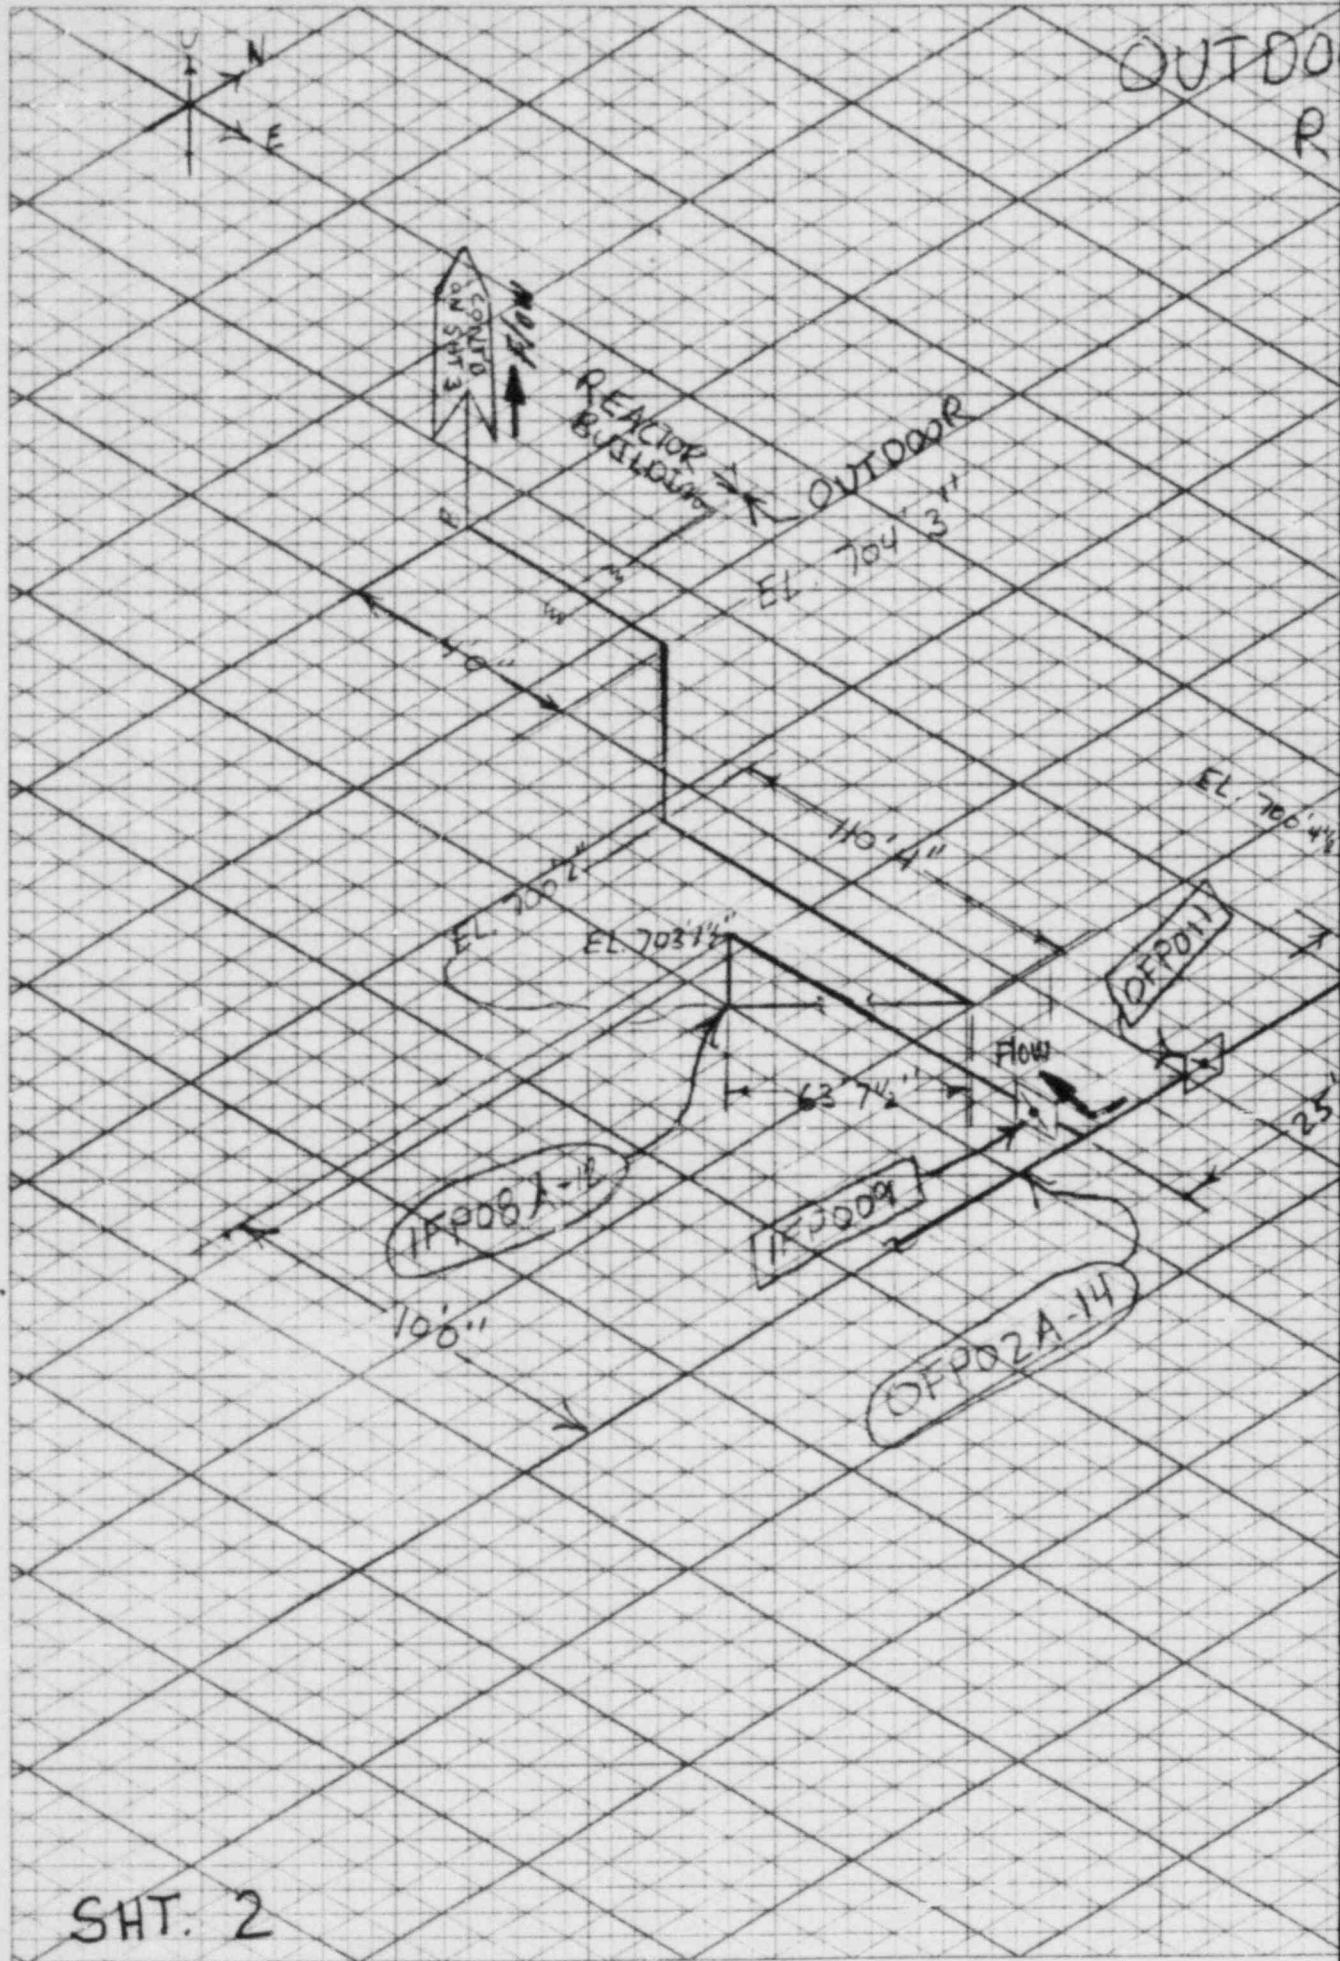

SHT. 2

## ~~OR PIPING~~

# ~~REFERENCE DRAWINGS~~

~~(M-71-01) AB~~

~~S-120, T~~

~~-193~~

~~M-766-06, G~~

三

-08, F

-09, K

~~Also Available On  
Aperitif Card~~



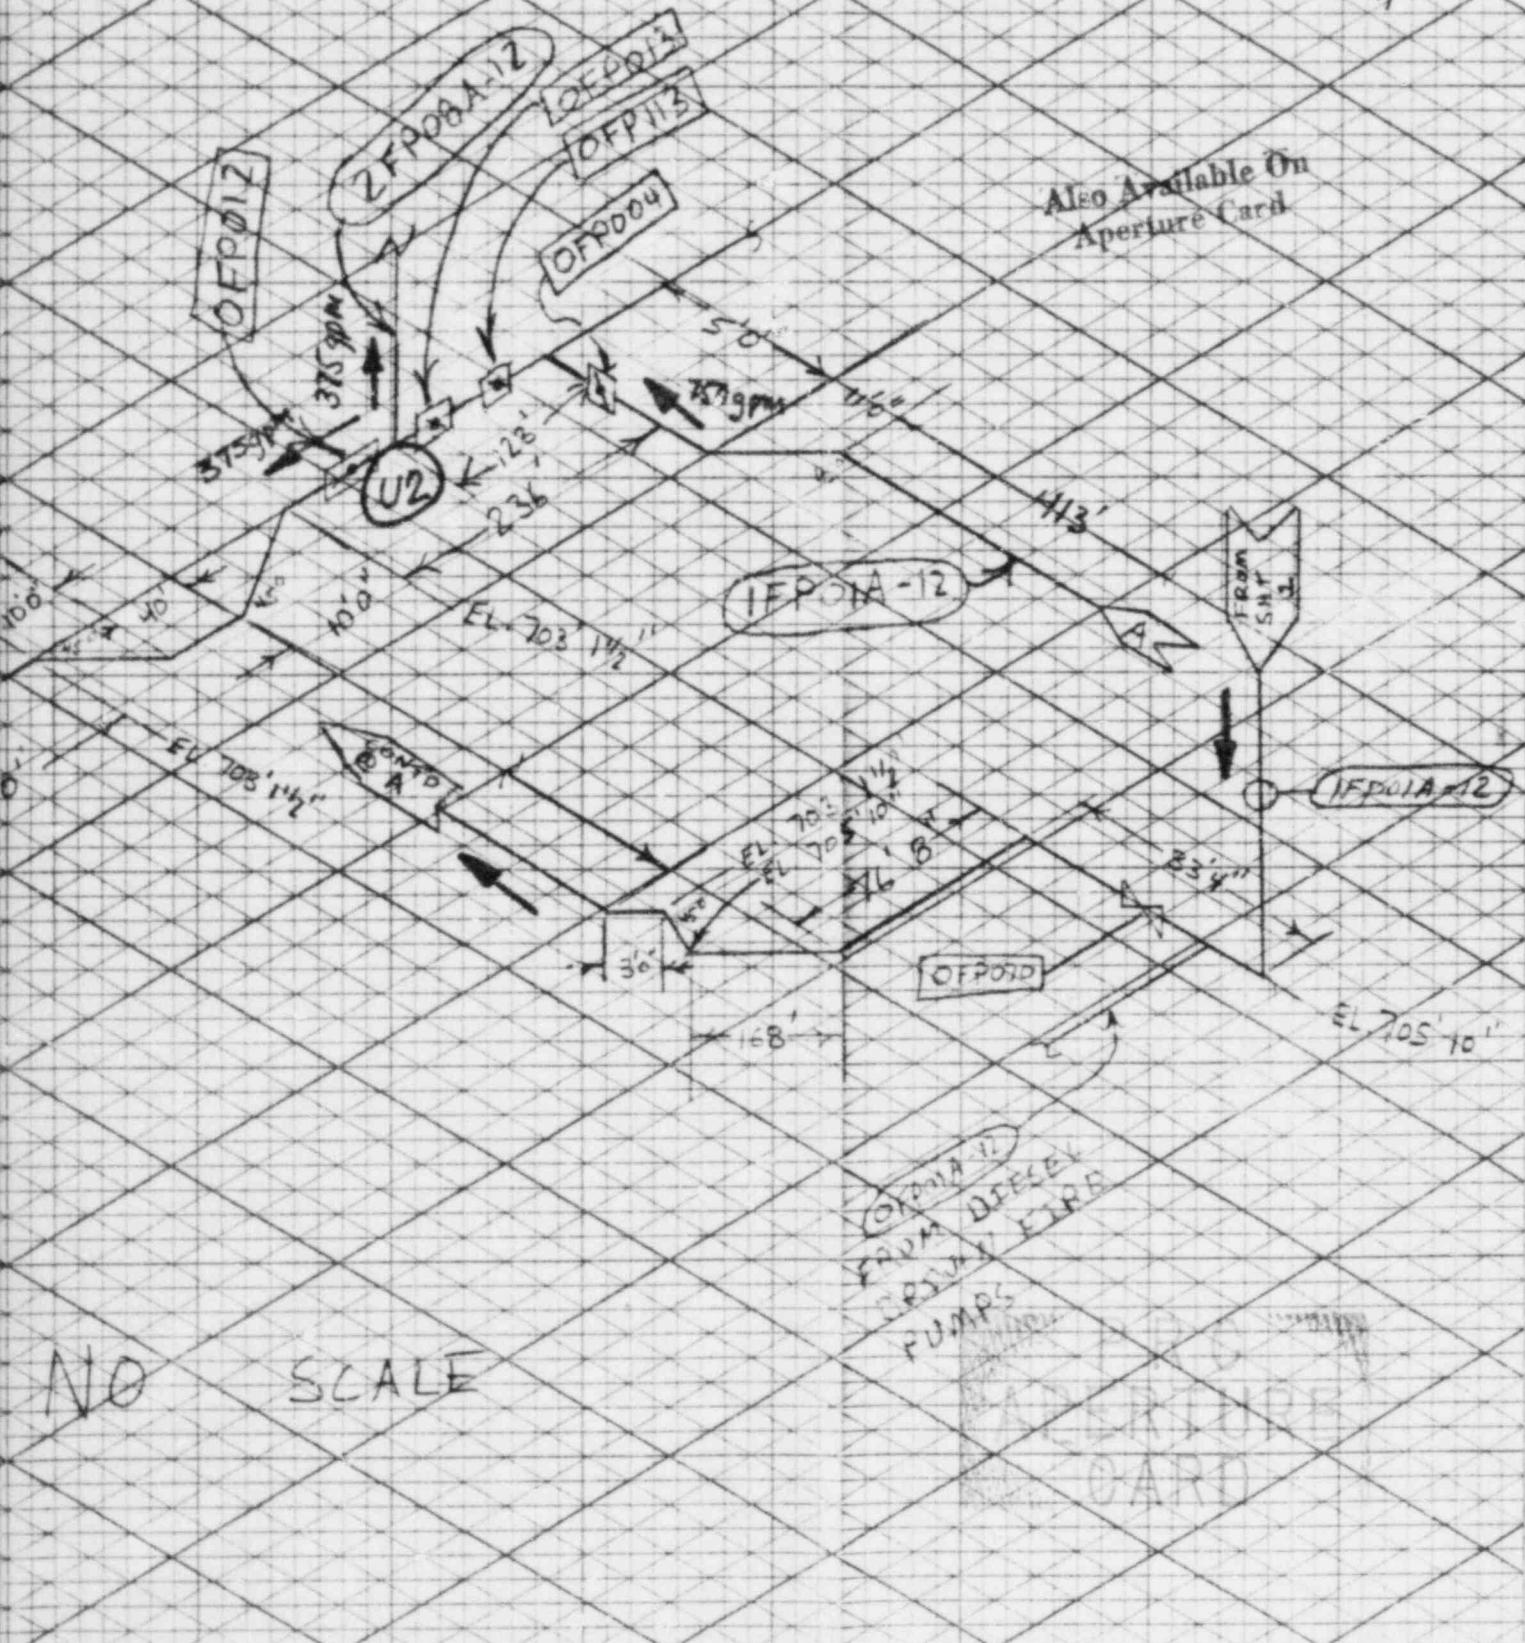


Figure 2/8

8311040130-12

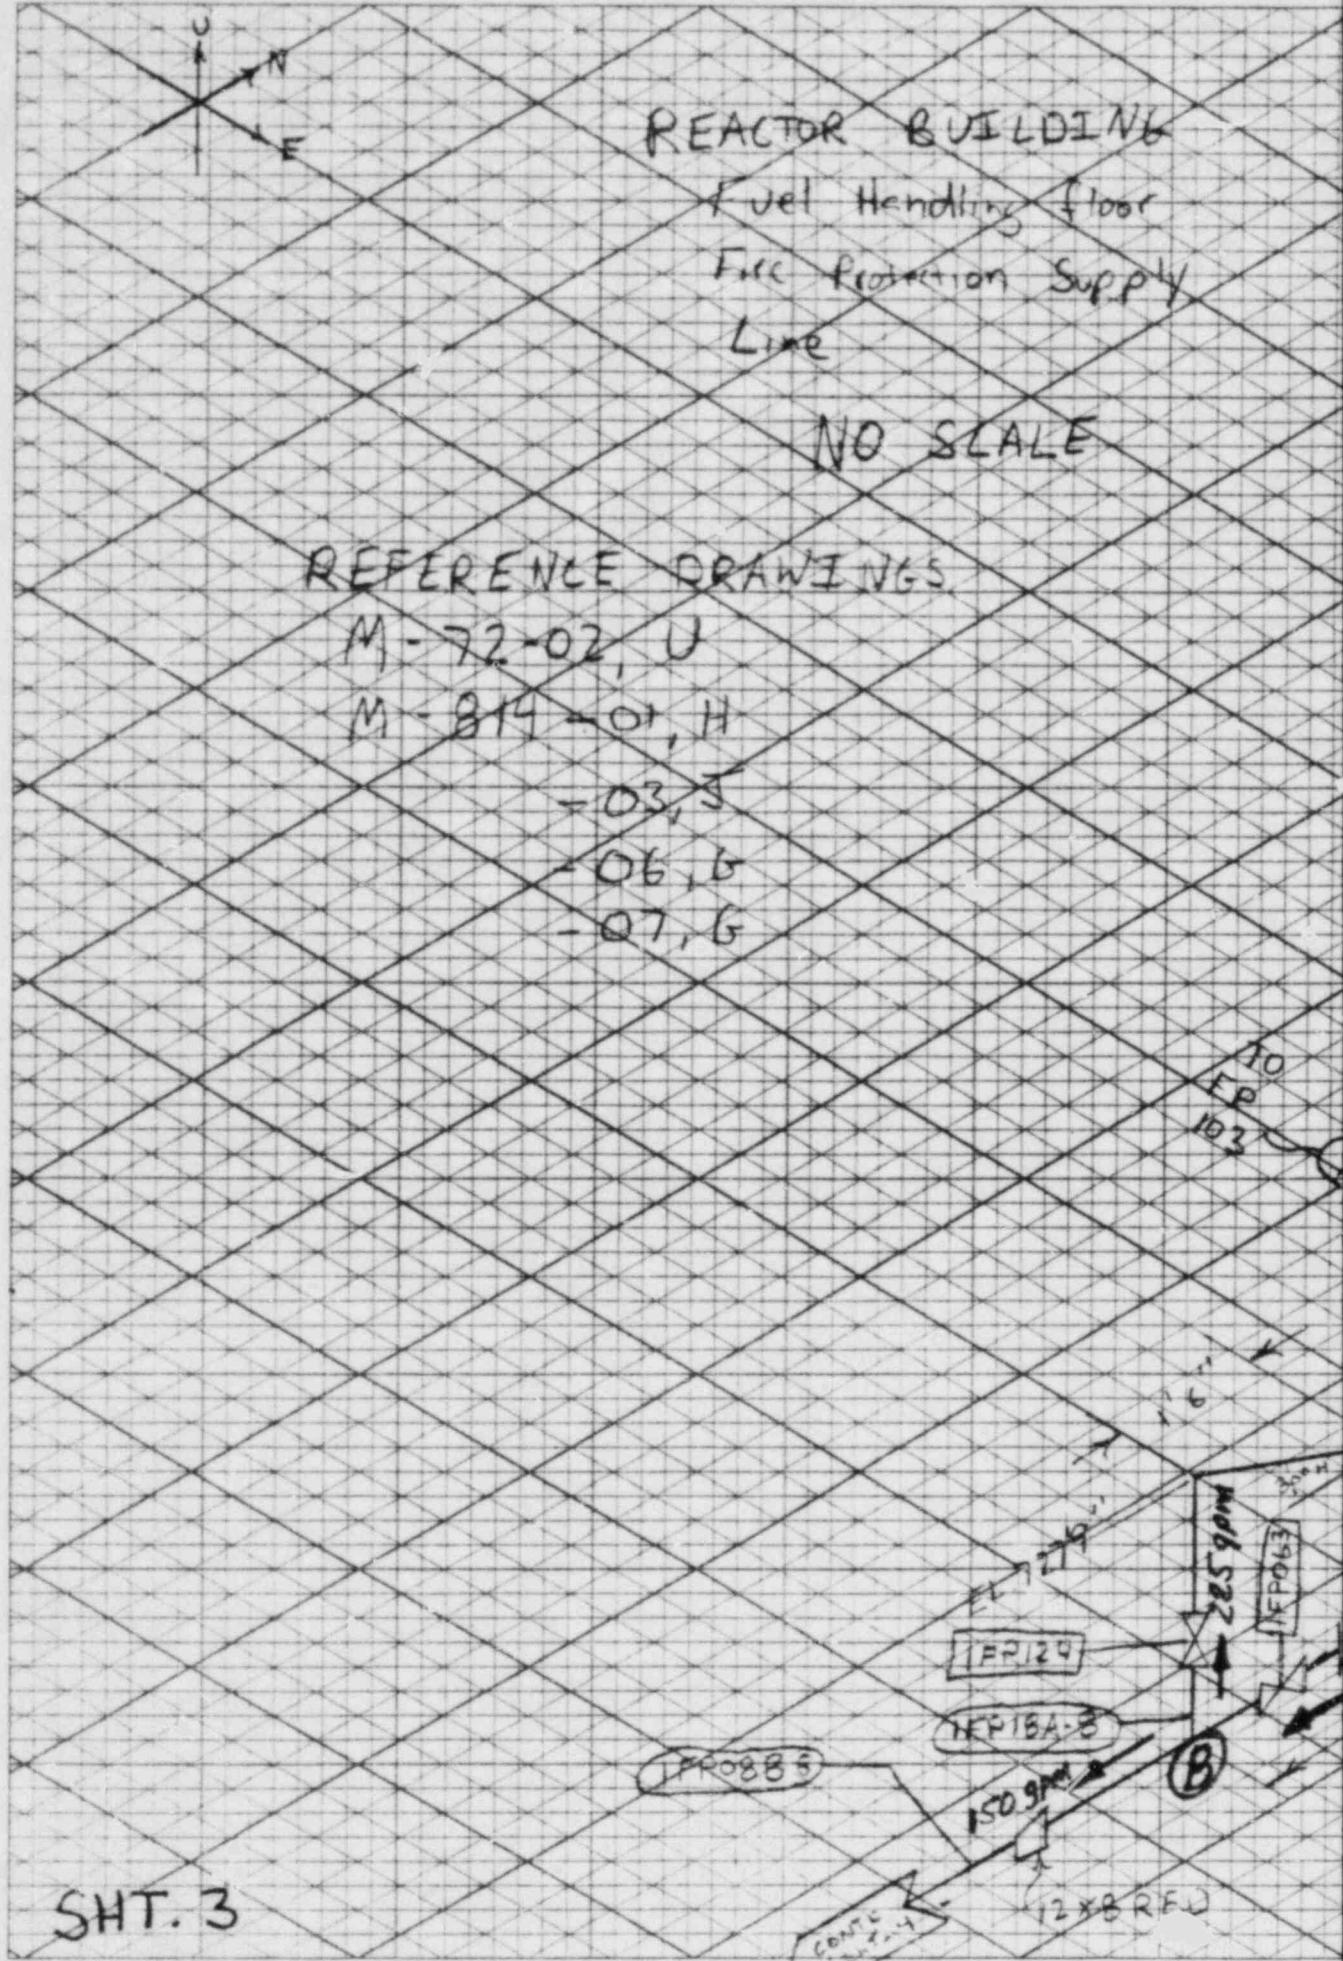

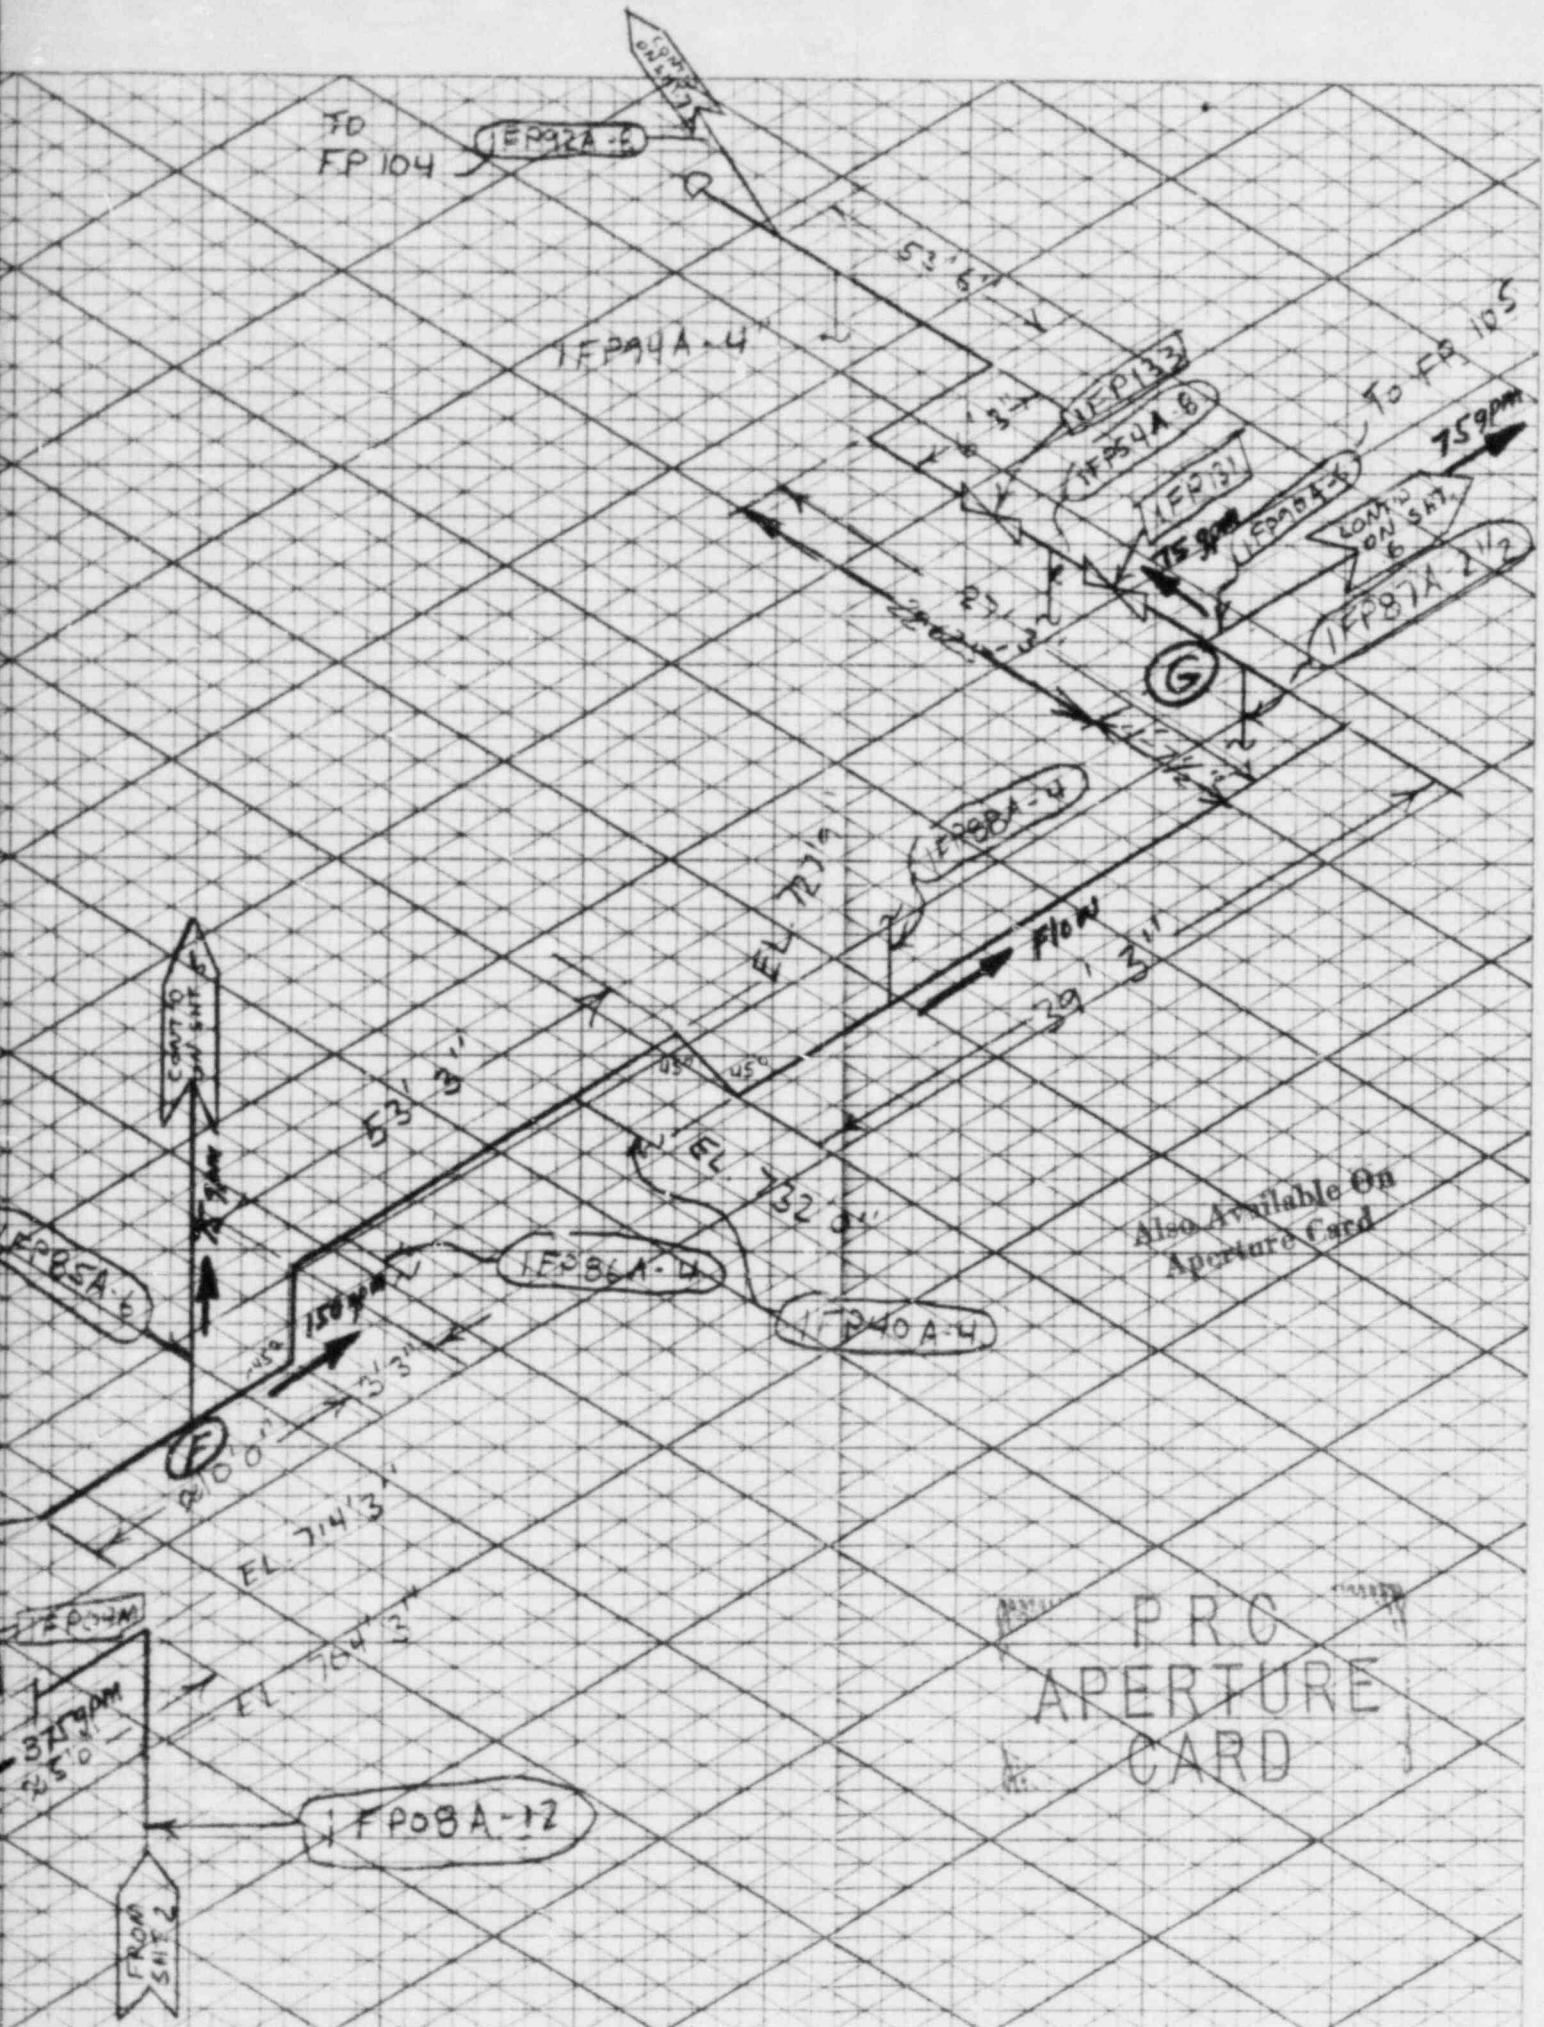

8311040130-13 Figure 3/8




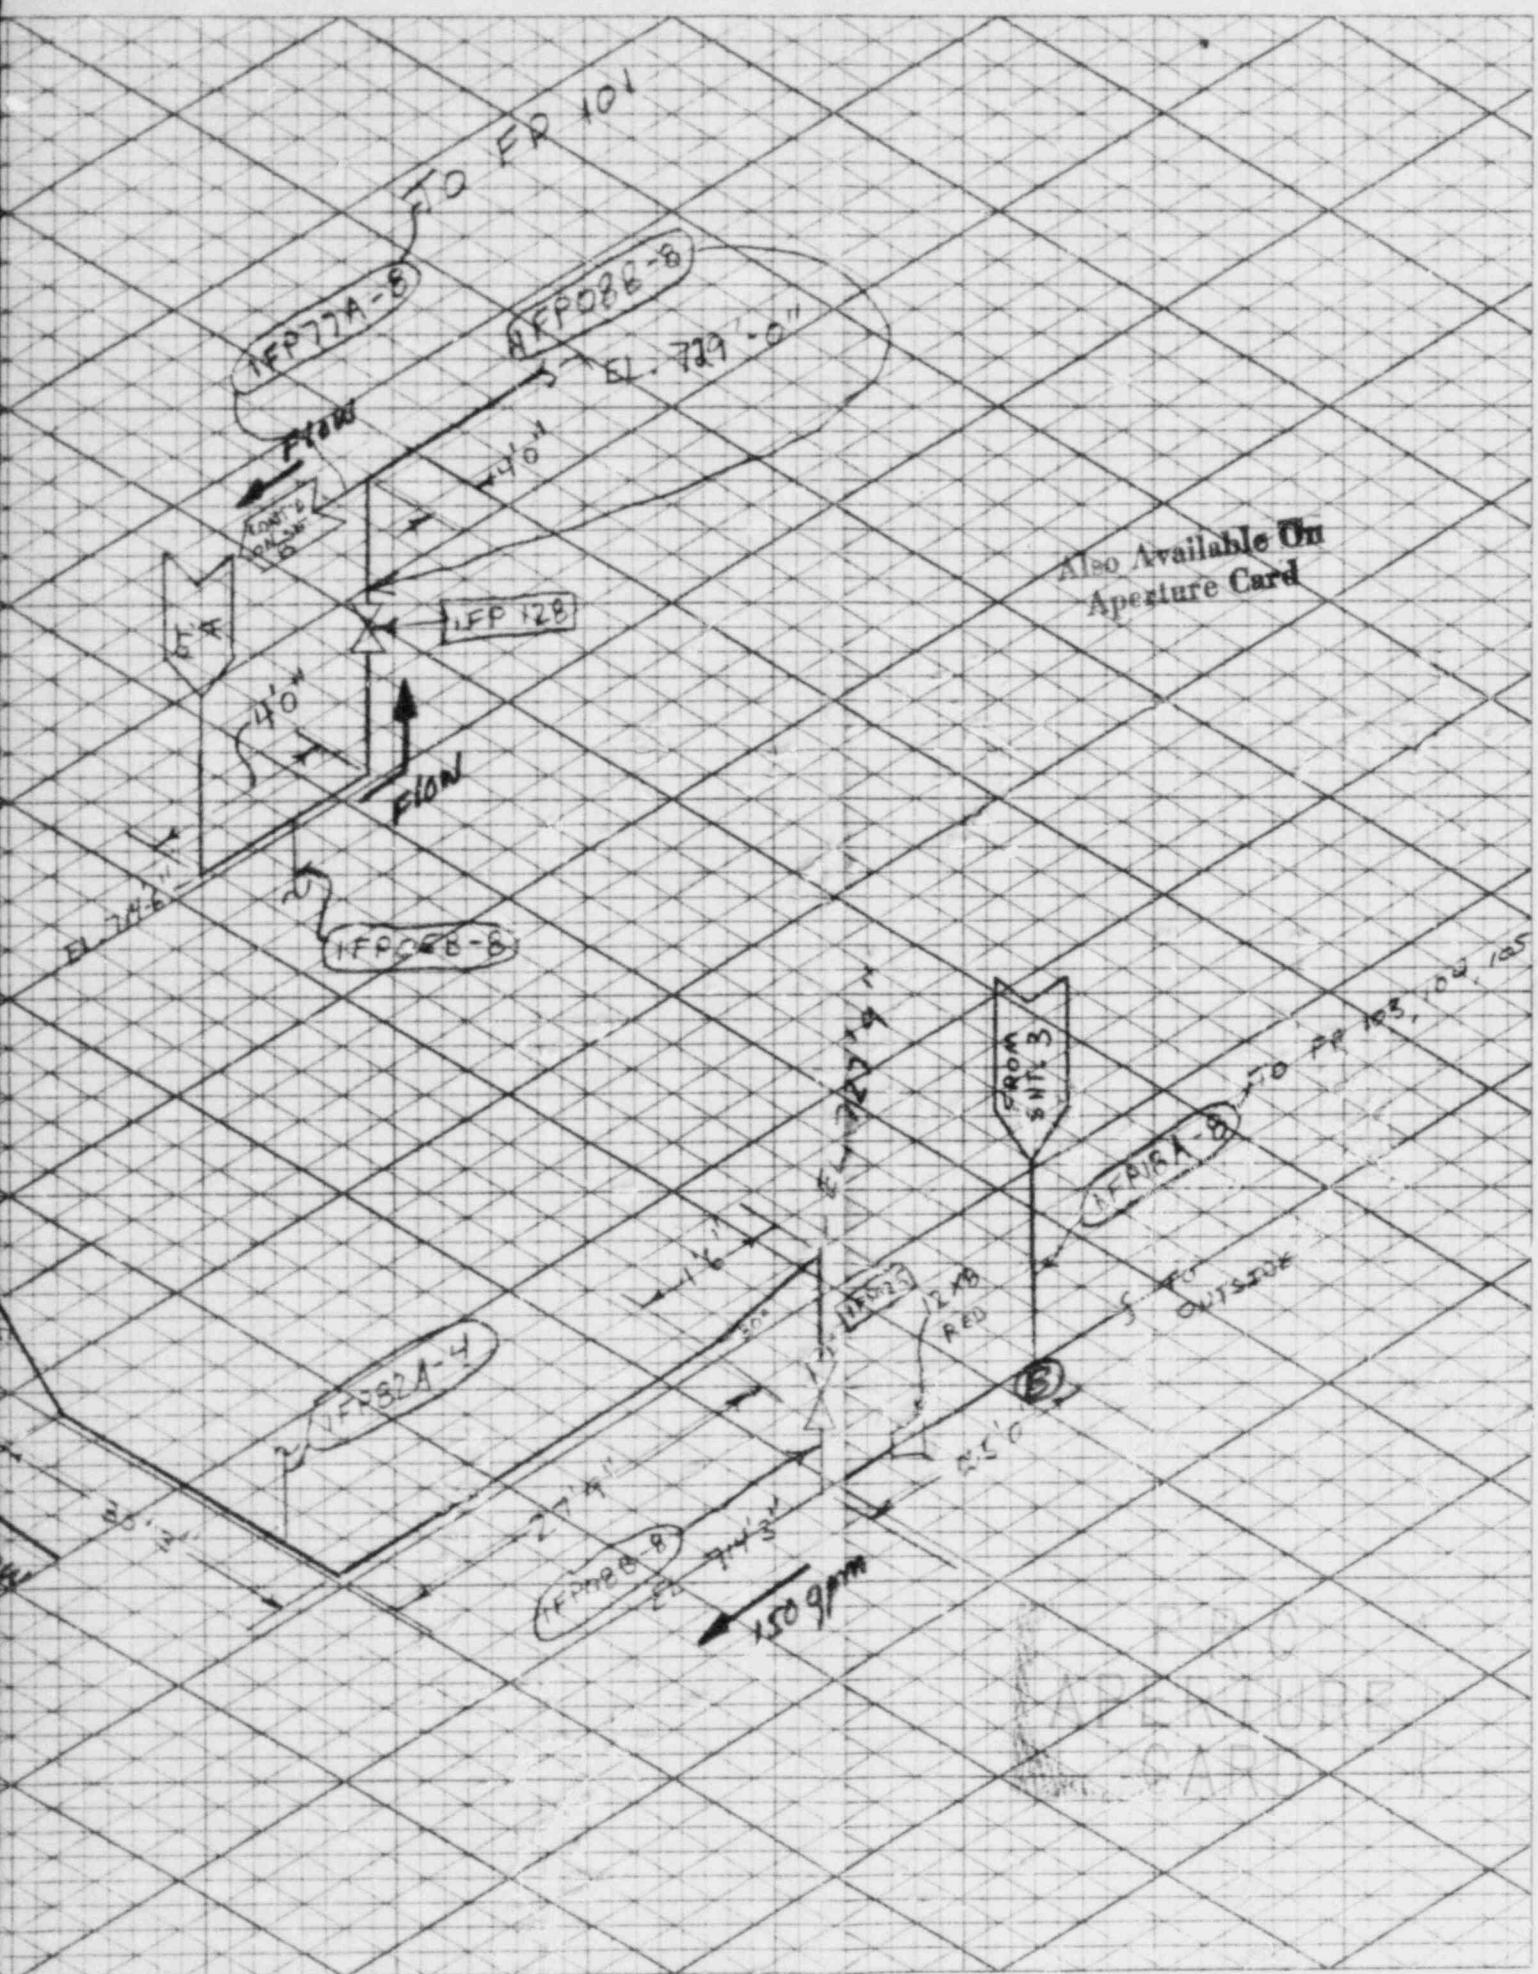


Figure 4/8




SHT. 5

FROM  
SHT. 5

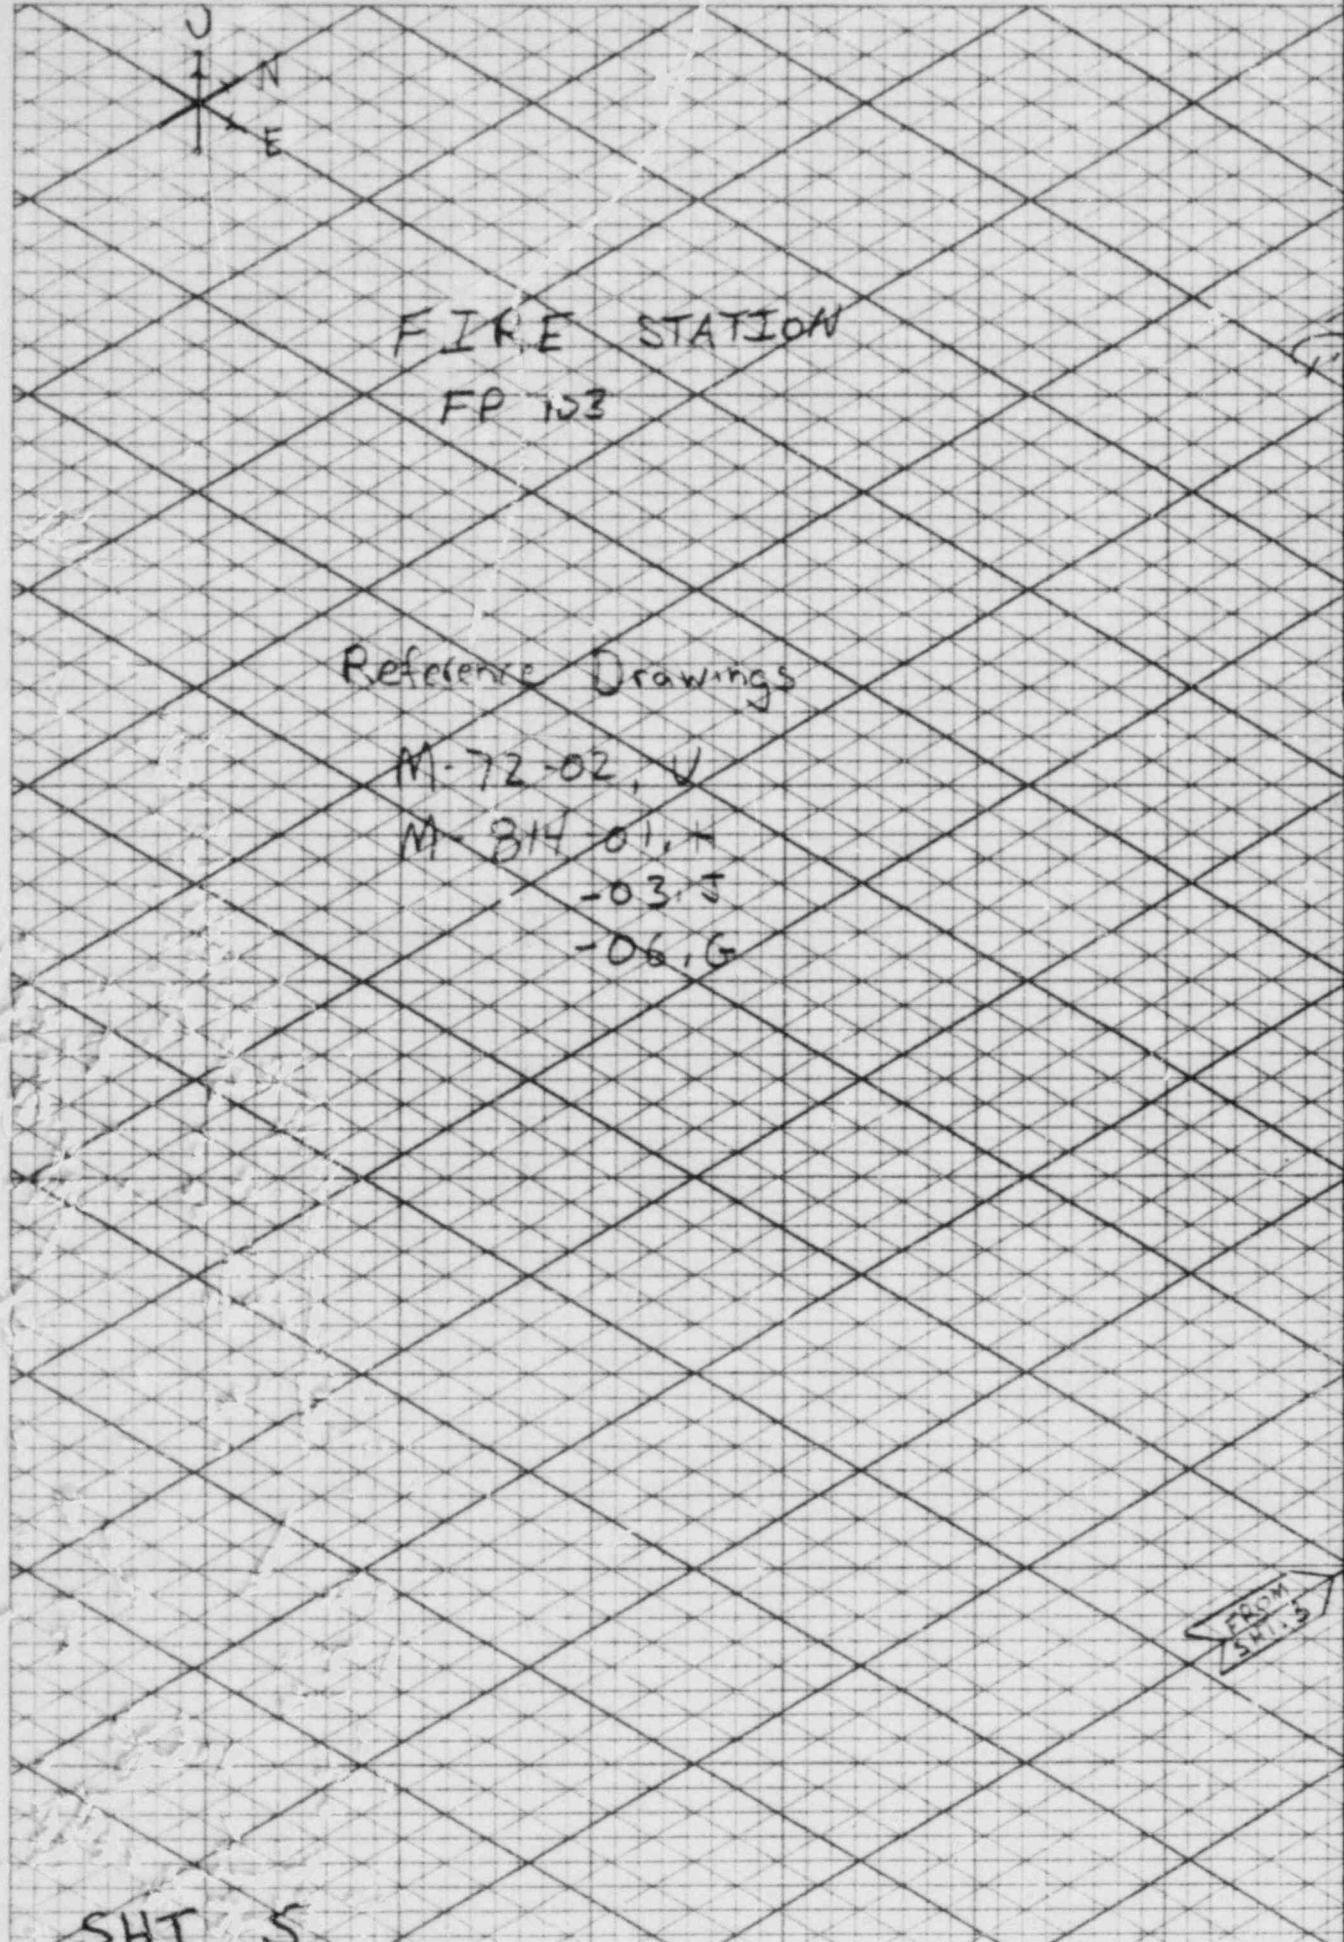

K-E ISOMETRIC-ORTHOGRAPHIC #1043  
KEUFFEL & FISHER CO. MADE IN U.S.A.

47 4030

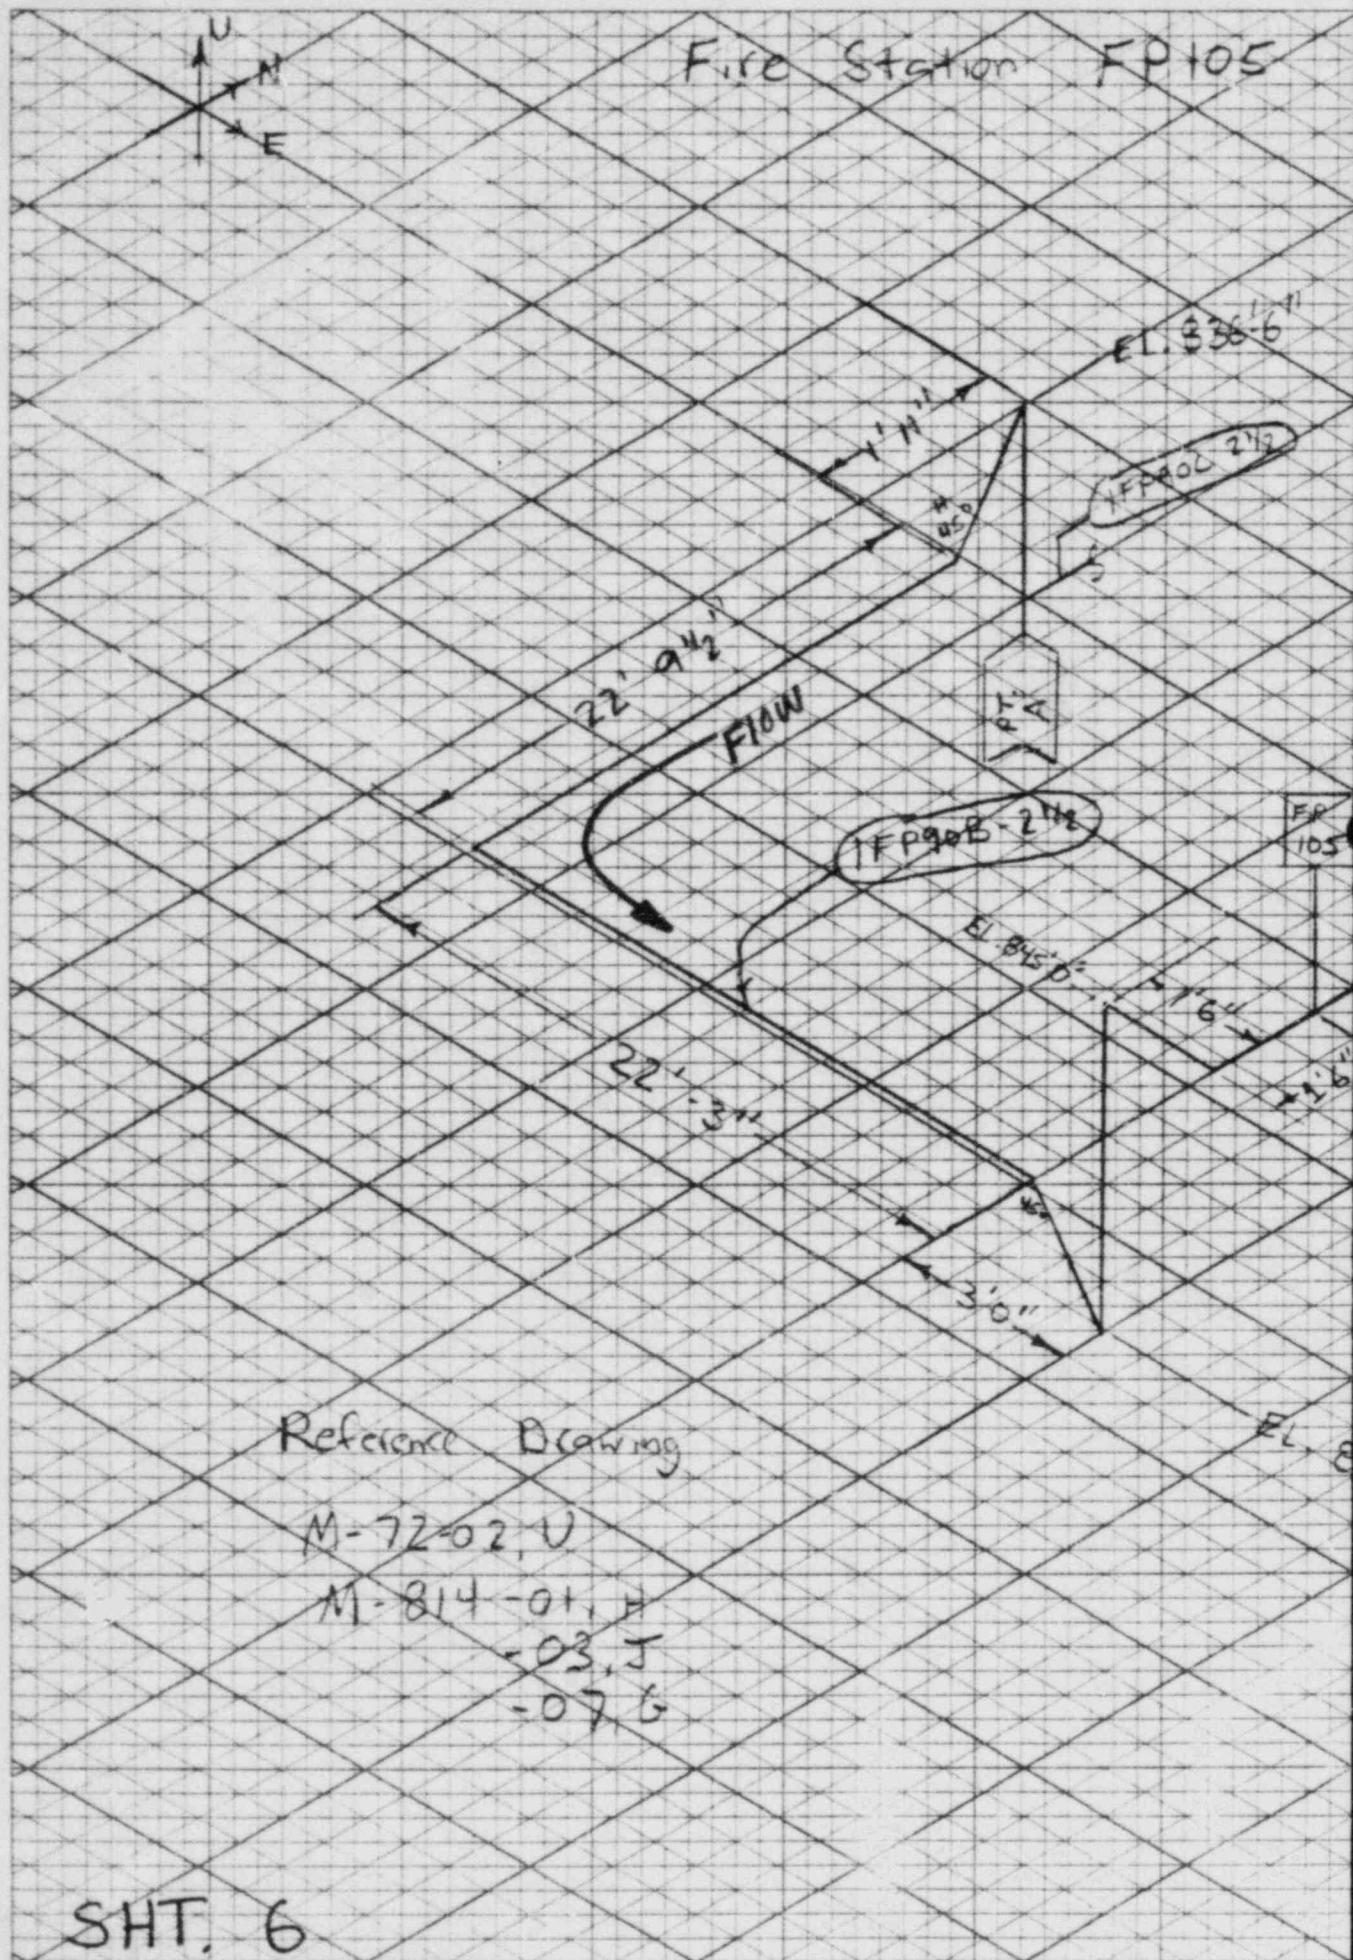

~~NO SCALE~~

V  
CONT.

111

~~1 F 9910 B-242~~

~~short radius~~

11

五

~~EL, 8+8 8~~

10

~~1F0139~~

~~IEP6SA~~

337

四

1.FP9DE

7370

~~IFPGD-212~~

*Also Available On  
Aperture Card*

66

三


~~FP18A-B~~

347

~~8311040190-16~~

831.00010

Figure 6/8

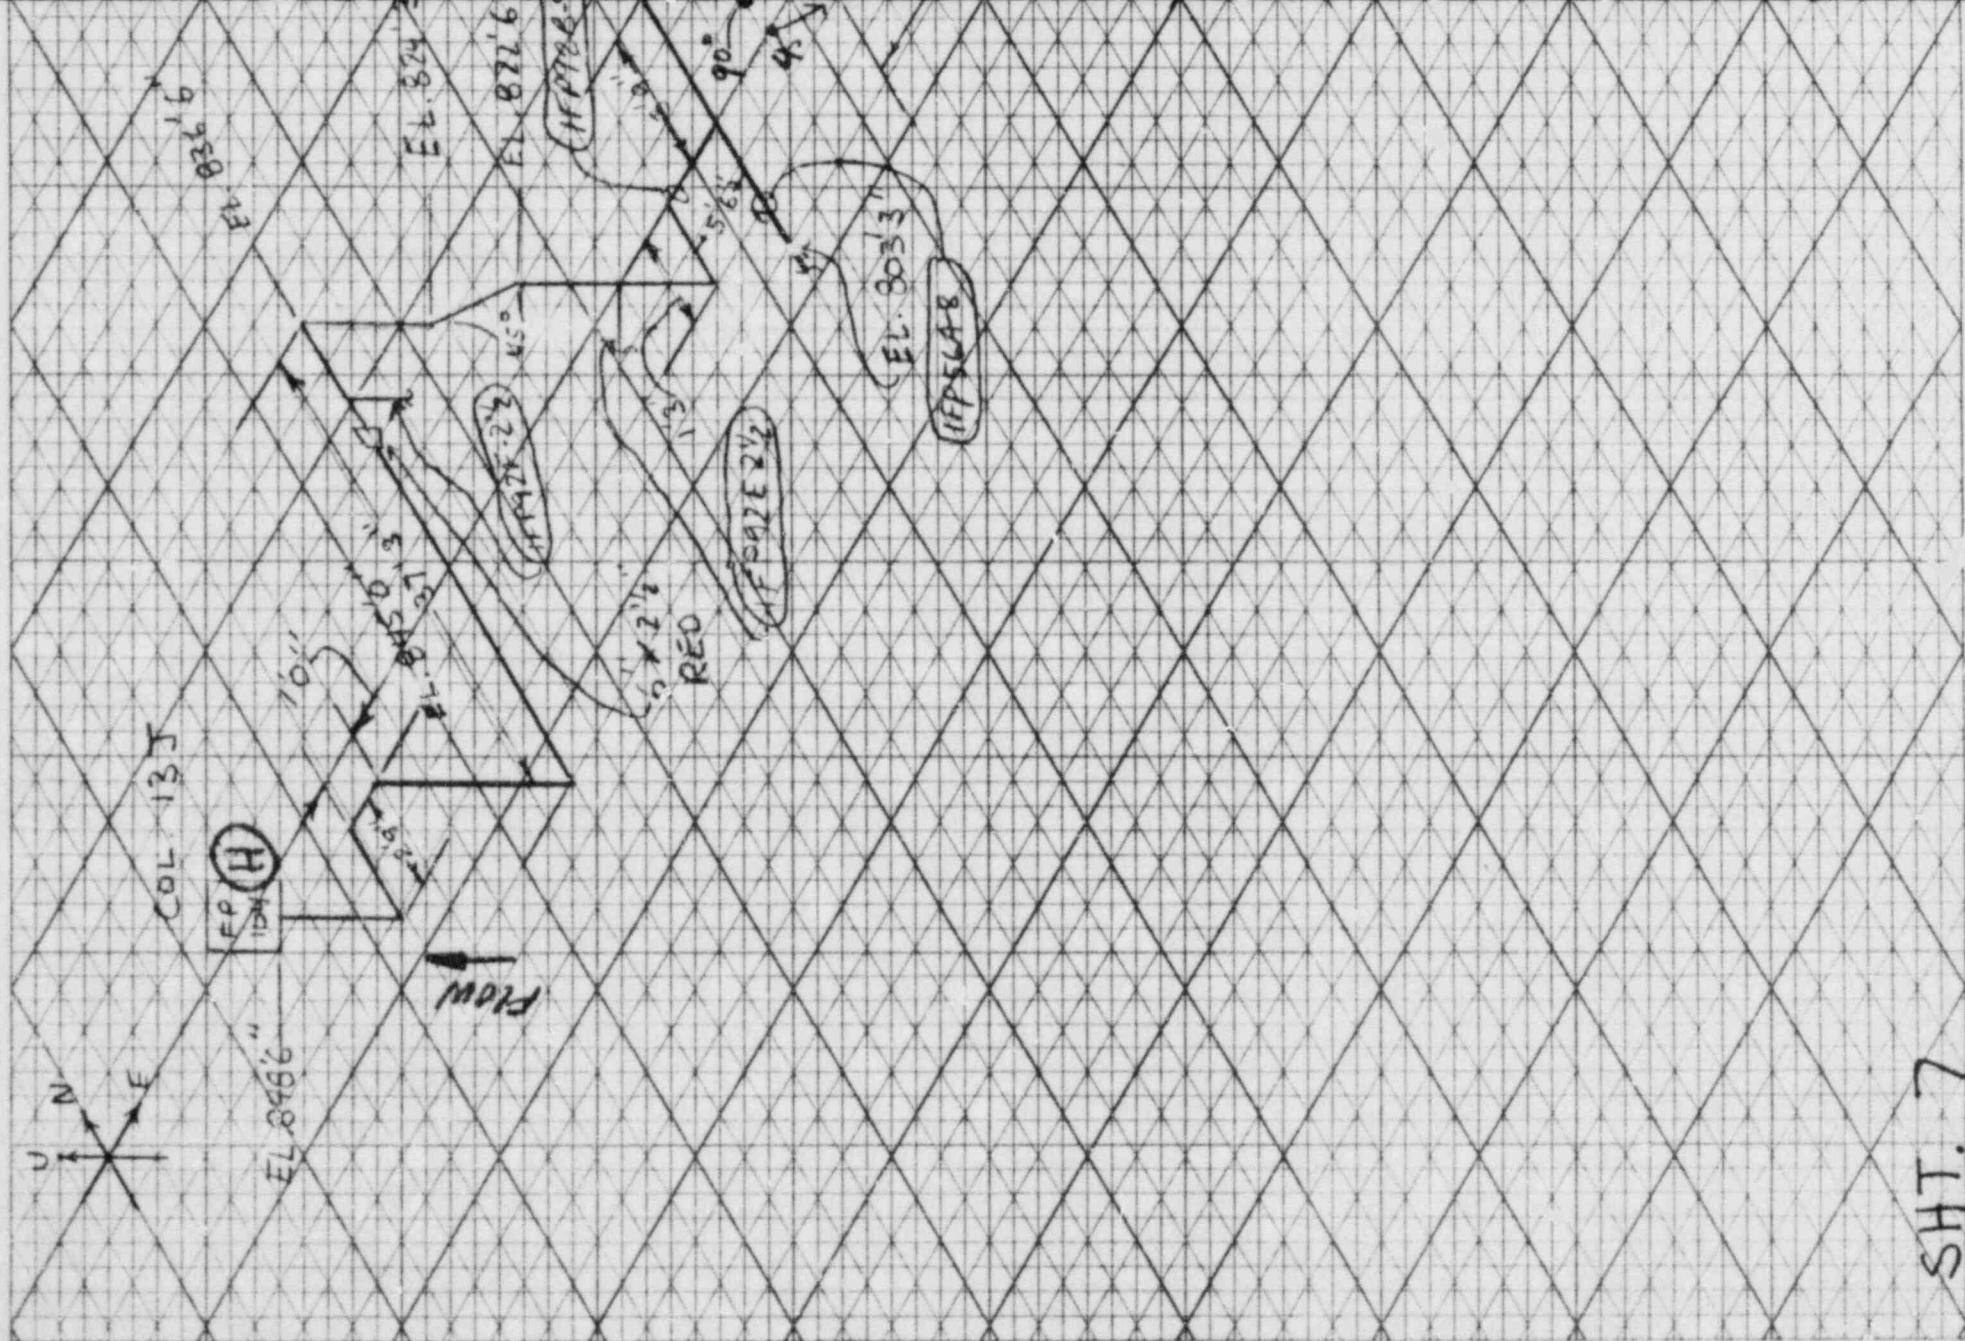

47 4030

K-E ISOMETRIC-DIMOGRAPHIC 51943

SHT. 7

PAGE A-15

~~REALTOR BUILDING~~ FP 104  
Fuel Handling Floor E 843 6"

References

M-72-02, U  
M-814-01, H  
-03, J  
OB, G

NO SCALE

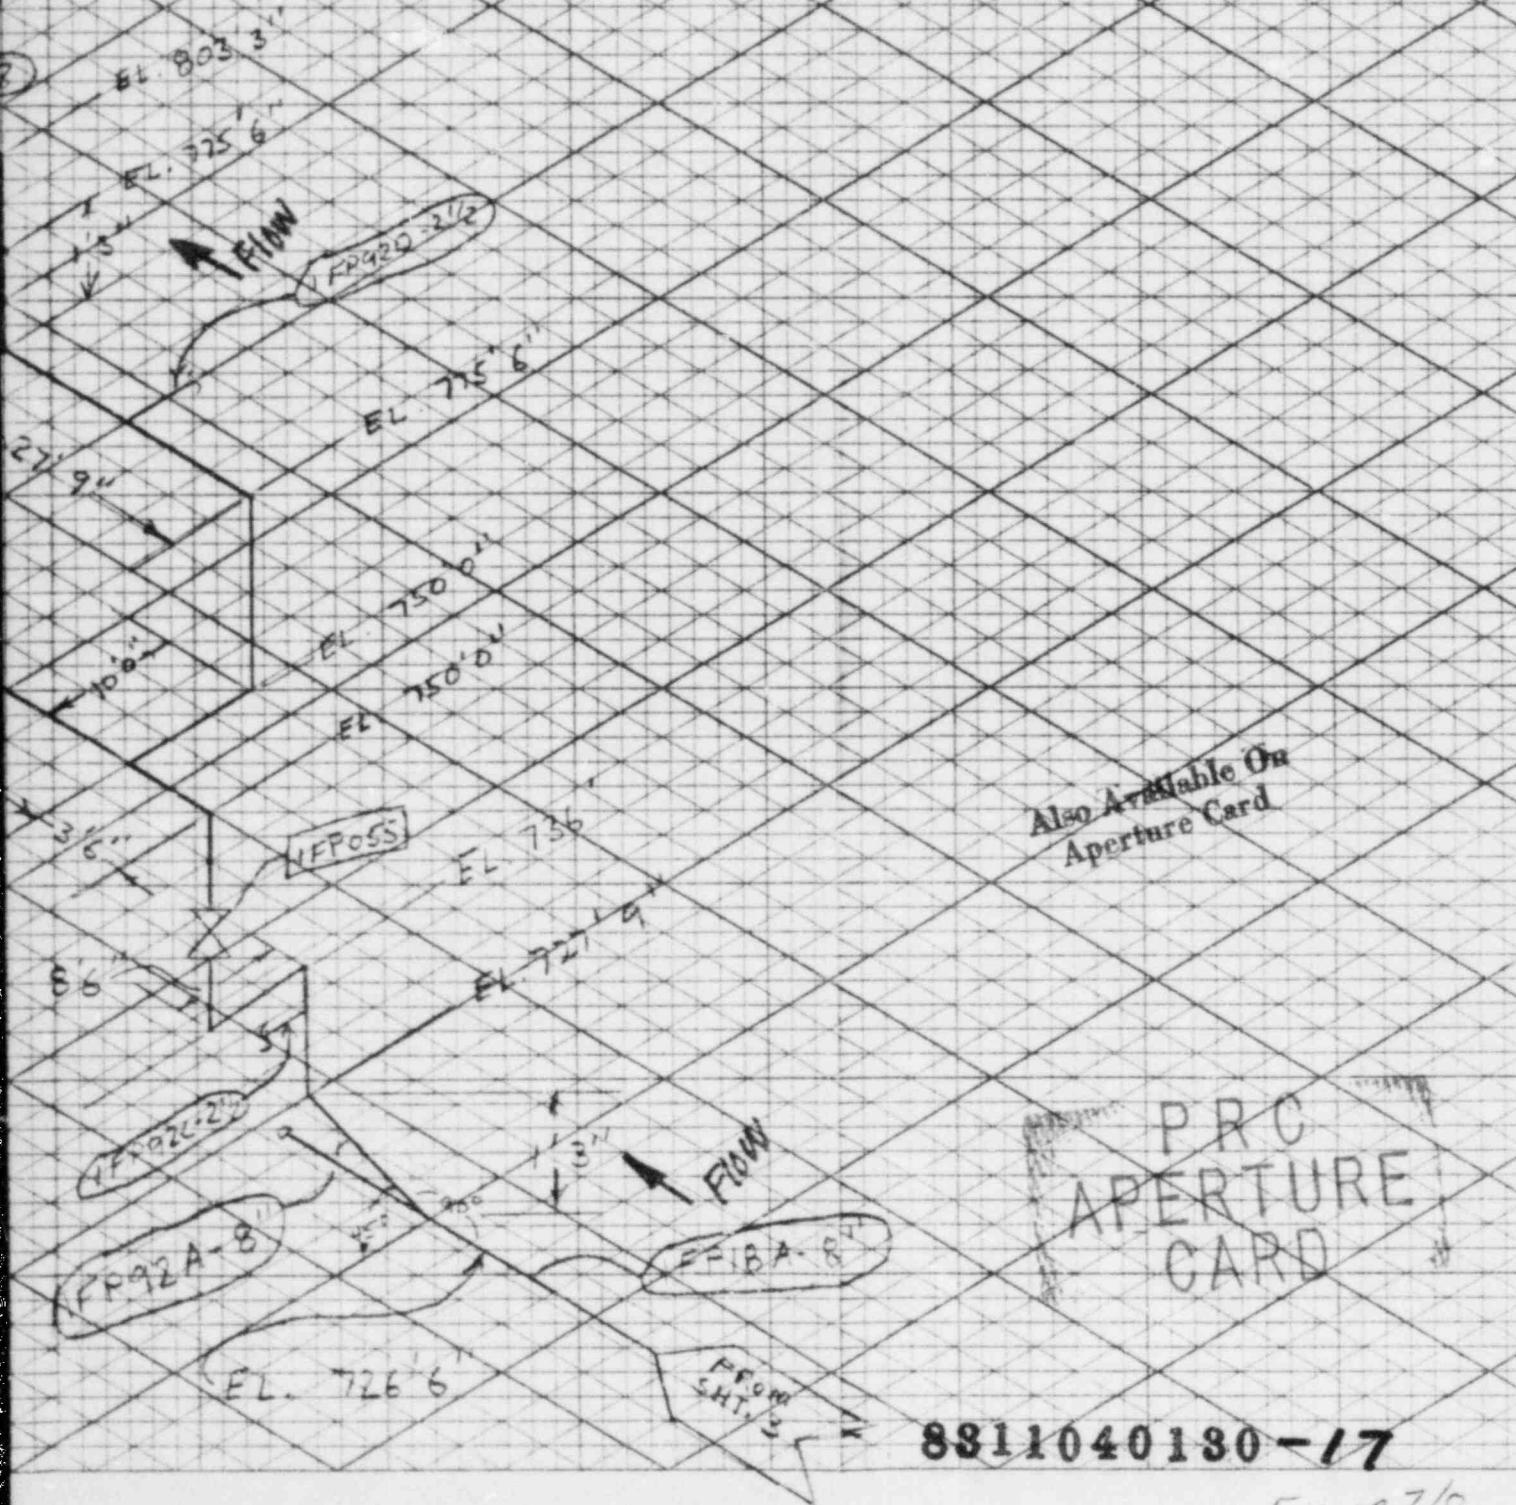


Figure 7/8

## ~~FP-101~~ File Station

## ~~Reference Drawings~~

- ~~M-72-02, U  
M-814-01, H  
M-814-02, G  
M-814-04, F  
M-814-05, G  
M-814-06, G~~




SHT. 8

~~NO SCALE~~

~~FP > 102~~

*Also Available On  
Aperture Card*

~~NO SCALE~~

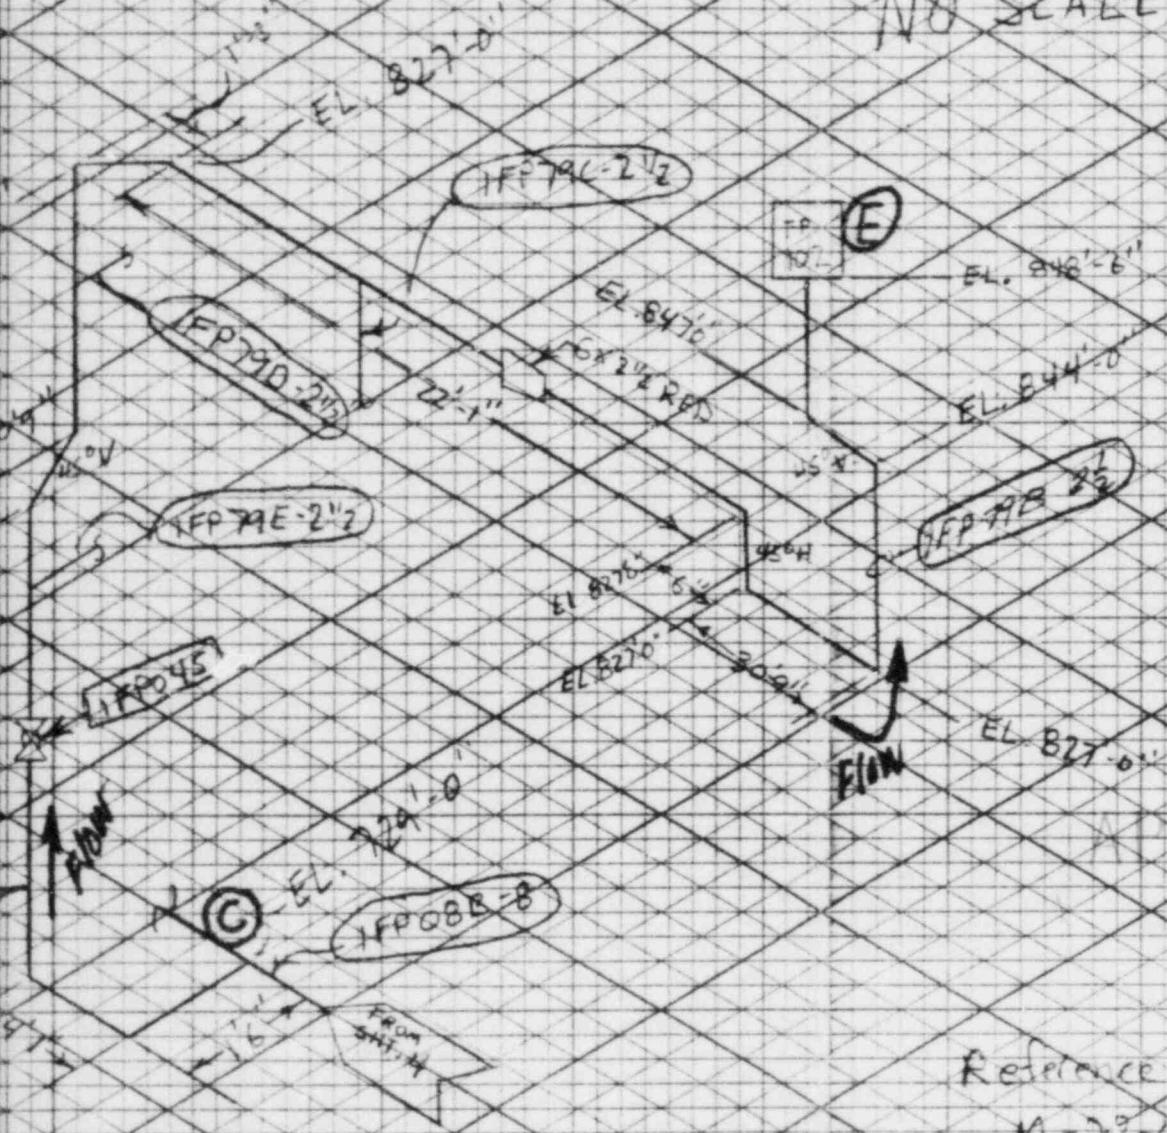

## Reference Drawing

~~H-22-02~~ V

~~M-814-01, B~~

~~M-814-02, G~~

~~W-01704~~, F

~~M-814-05~~

~~8911040130-13~~

PRELIMINARY

EVALUATION OF SERVICE WATER SYSTEM  
AS BACK-UP TO FIRE PROTECTION SYSTEM  
AT THE CABLE SPREADING ROOM  
FOR THE  
LASALLE COUNTY STATION - UNIT 1

#### 1.0 INTRODUCTION

The fire protection water distribution system is capable of supplying cooling lake water, to the plant fire hydrants, the water sprinkler and deluge systems, and the hose valve stations under all conditions. The diesel fire pumps take suction from the water tunnel in the lake screen house. As a backup to the diesel fire pumps, water can be supplied from the service water system. The service water system is not an equivalent or redundant fire protection system. The service water system is connected to the fire protection system through a 12-inch line at each pump discharge line.

#### 2.0 PURPOSE

The purpose of this calculation/report is to demonstrate that the Service Water System can back up the Fire Protection System demand at the Unit 1 Cable Spreading Room in the event both diesel fire pumps are inoperable. The LaSalle Safety Evaluation Report (SER) states that the

2.0 PURPOSE (continued)

greatest water demand for areas containing or exposing safety-related equipment is 1000 gpm. An additional 750 gpm is required for hose streams, totals a water demand of 1750 gpm. This water flow requirement corresponds to the Cable Spreading Room.

This report will also demonstrate as a corollary that the Fire Protection System can supply a water demand of 1750 gpm to the Cable Spreading Room.

3.0 ASSUMPTIONS

We have assumed the pipe to be "old". This implies a Hazen-Williams coefficient of 100. The equivalent length for the butterfly valves was obtained from Crane's paper TP-410 (L/D=40). We assumed conservative pressure drops for the strainers. The reducers were assumed to have negligible effect to the head loss because velocity magnitudes are very small.

The 750 gpm dedicated for the hose streams was divided amongst four outlets. Two hose stations were assumed to have 125 gpm each. The remaining 500 gpm was divided equally between two fire hydrants.

4.0 DESIGN INPUT

The head loss calculations were performed using Sargent & Lundy Standards MES-2.10 and MES-2.16. The pipe routings and calculations are in Appendix A. The pipe routing was developed from the current single line and outdoor piping drawings. The calculations were performed using Form MES-2.16.1

5.0 REFERENCES

5.1 Goulds Pumps, Inc. Characteristic Curve for Service Water Pumps

IWS01PA        OWS01P        A-19377

IWS01PB        A-19376        A-19375

5.2 Peerless Pump Division, FMC Corporation Characteristic Curve for Fire Protection Pump

OFP01PA        C14645B

OFP01PB        C14645B (Identical pumps)

5.3 Nuclear Mutual, Limited (NML) Standards for Nuclear Generating Stations

5.4 Crane Paper TP-410 - Flow of Fluids

5.5 Cameron Hydraulic Data, 14th Edition

5.6 P&ID's

M-68 , Rev. P , Service Water

M-71-01, Rev. AB, Fire Protection

M-72-01, Rev. T , Fire Protection

5.0 REFERENCES (continued)

5.7 Structural Drawings

S-117, Rev. M, Plumbing Underground Piping  
S-118, Rev. Z, Plumbing Underground Piping  
S-119, Rev. R, Plumbing Underground Piping  
S-120, Rev. T, Plumbing Underground Piping  
S-102, Rev. U, Plumbing Underground Piping

5.8 Mechanical Drawings

M-766-06, Rev. G, Outdoor Piping  
M-766-07, Rev. E, Outdoor Piping  
M-766-08, Rev. F, Outdoor Piping  
M-766-09, Rev. K, Outdoor Piping  
M-783 , Rev. K, Lake Screen House Piping  
M-784 , Rev. F, Lake Screen House Piping  
M-785 ; Rev. M, Lake Screen House Piping  
M-786 , Rev. G, Lake Screen House Piping  
M-787 , Rev. M, Lake Screen House Piping  
M-788 , Rev. J, Lake Screen House Piping  
M-814-08, Rev. L, Fire Protection Piping-Turbine &  
Auxiliary Building  
M-814-09, Rev. R, Fire Protection Piping-Turbine &  
Auxiliary Building  
M-814-10, Rev. H, Fire Protection Piping-Turbine &  
Auxiliary Building

5.8 Mechanical Drawings (continued)

M-814-11, Rev. K, Fire Protection Piping-Turbine &  
Auxiliary Building

M-814-12, Rev. K, Fire Protection Piping-Turbine &  
Auxiliary Building

M-814-13, Rev. K, Fire Protection Piping-Turbine &  
Auxiliary Building

M-814-15, Rev. N, Fire Protection Piping-Turbine &  
Auxiliary Building

5.9 Instrument Location Drawing

M-1312-04, Rev. A

5.10 Piping Design Tables

PDT "002LS" and "100LS"

6.0 SUMMARY

The calculations demonstrate that the head loss due to friction between the WS pumps and the cable spreading room approximately equals 148 feet of water (64 psi). A static head of 66 feet exists between the WS pumps and the cable spreading room. The residual pressure at the isolation valve (1FP147) is 74.9 psi (173 ft. H<sub>2</sub>O). Hence, the discharge head of the WS pumps must equal 387 feet.

The discharge nozzle of the Service Water pumps is located below the elevation of the cooling lake (700'-0"). The

6.0 SUMMARY (continued)

difference in elevations results in a static suction head of approximately 12.5 feet. Hence, the total developed head for the WS pumps approximately equals 374.5 feet (assuming negligible suction friction).

The service water pumps cannot provide the cable spreading room with 1000 gpm @ 74.9 psi, since the shutoff head to the pumps equals 335 feet. The service water pumps can provide the cable spreading room with 1000 gpm @ 55 psi (127 ft. H<sub>2</sub>O).

The fire protection system was designed to provide the cable spreading room demand of 1000 gpm @ 740 psi (173 feet). The head loss due to friction between the FP pump and the cable spreading room approximately equals 147 feet of H<sub>2</sub>O (64 psi). The static head between the two points approximately equals 37 feet. Hence, the discharge head of the FP pump must be approximately 357 feet.

The discharge nozzle of the FP pumps is located above the elevation of the cooling lake (700'-0"). The difference in elevation results in a suction lift of approximately 16 feet. Hence, the total developed head for the FP pump

6.0 SUMMARY (continued)


approximately equals 373 feet (162 psi). At this discharge head, the FP pump provides a flow of approximately 1750 gpm. Hence, the fire protection system is concluded to be adequate.

A pressure indicator and transmitter on the piping can be used to determine when adequate pressure is achieved by the WS pumps.


7.0 RECOMMENDATIONS


The WS system can supply 1000 gpm to the fire protection system at 55 psi. To accomplish this, the service water valves downstream of the fire protection branch must be closed. The proper pressure can be obtained by reading pressure indicator 2PI-WS007. The indicator is located on the discharge nozzle of pump 2WS01PA, it must reflect a pressure of approximately 147.6 psig (341 ft. H<sub>2</sub>O). In addition to the pressure indicator, a pressure transmitter (2PT-WS009) is also available to detect line pressure. The transmitter must reflect a pressure of 139.6 psig (323 ft. H<sub>2</sub>O).

In order to provide adequate water supply to the FP system, the WS pumps must be backed up on their characteristic curve.

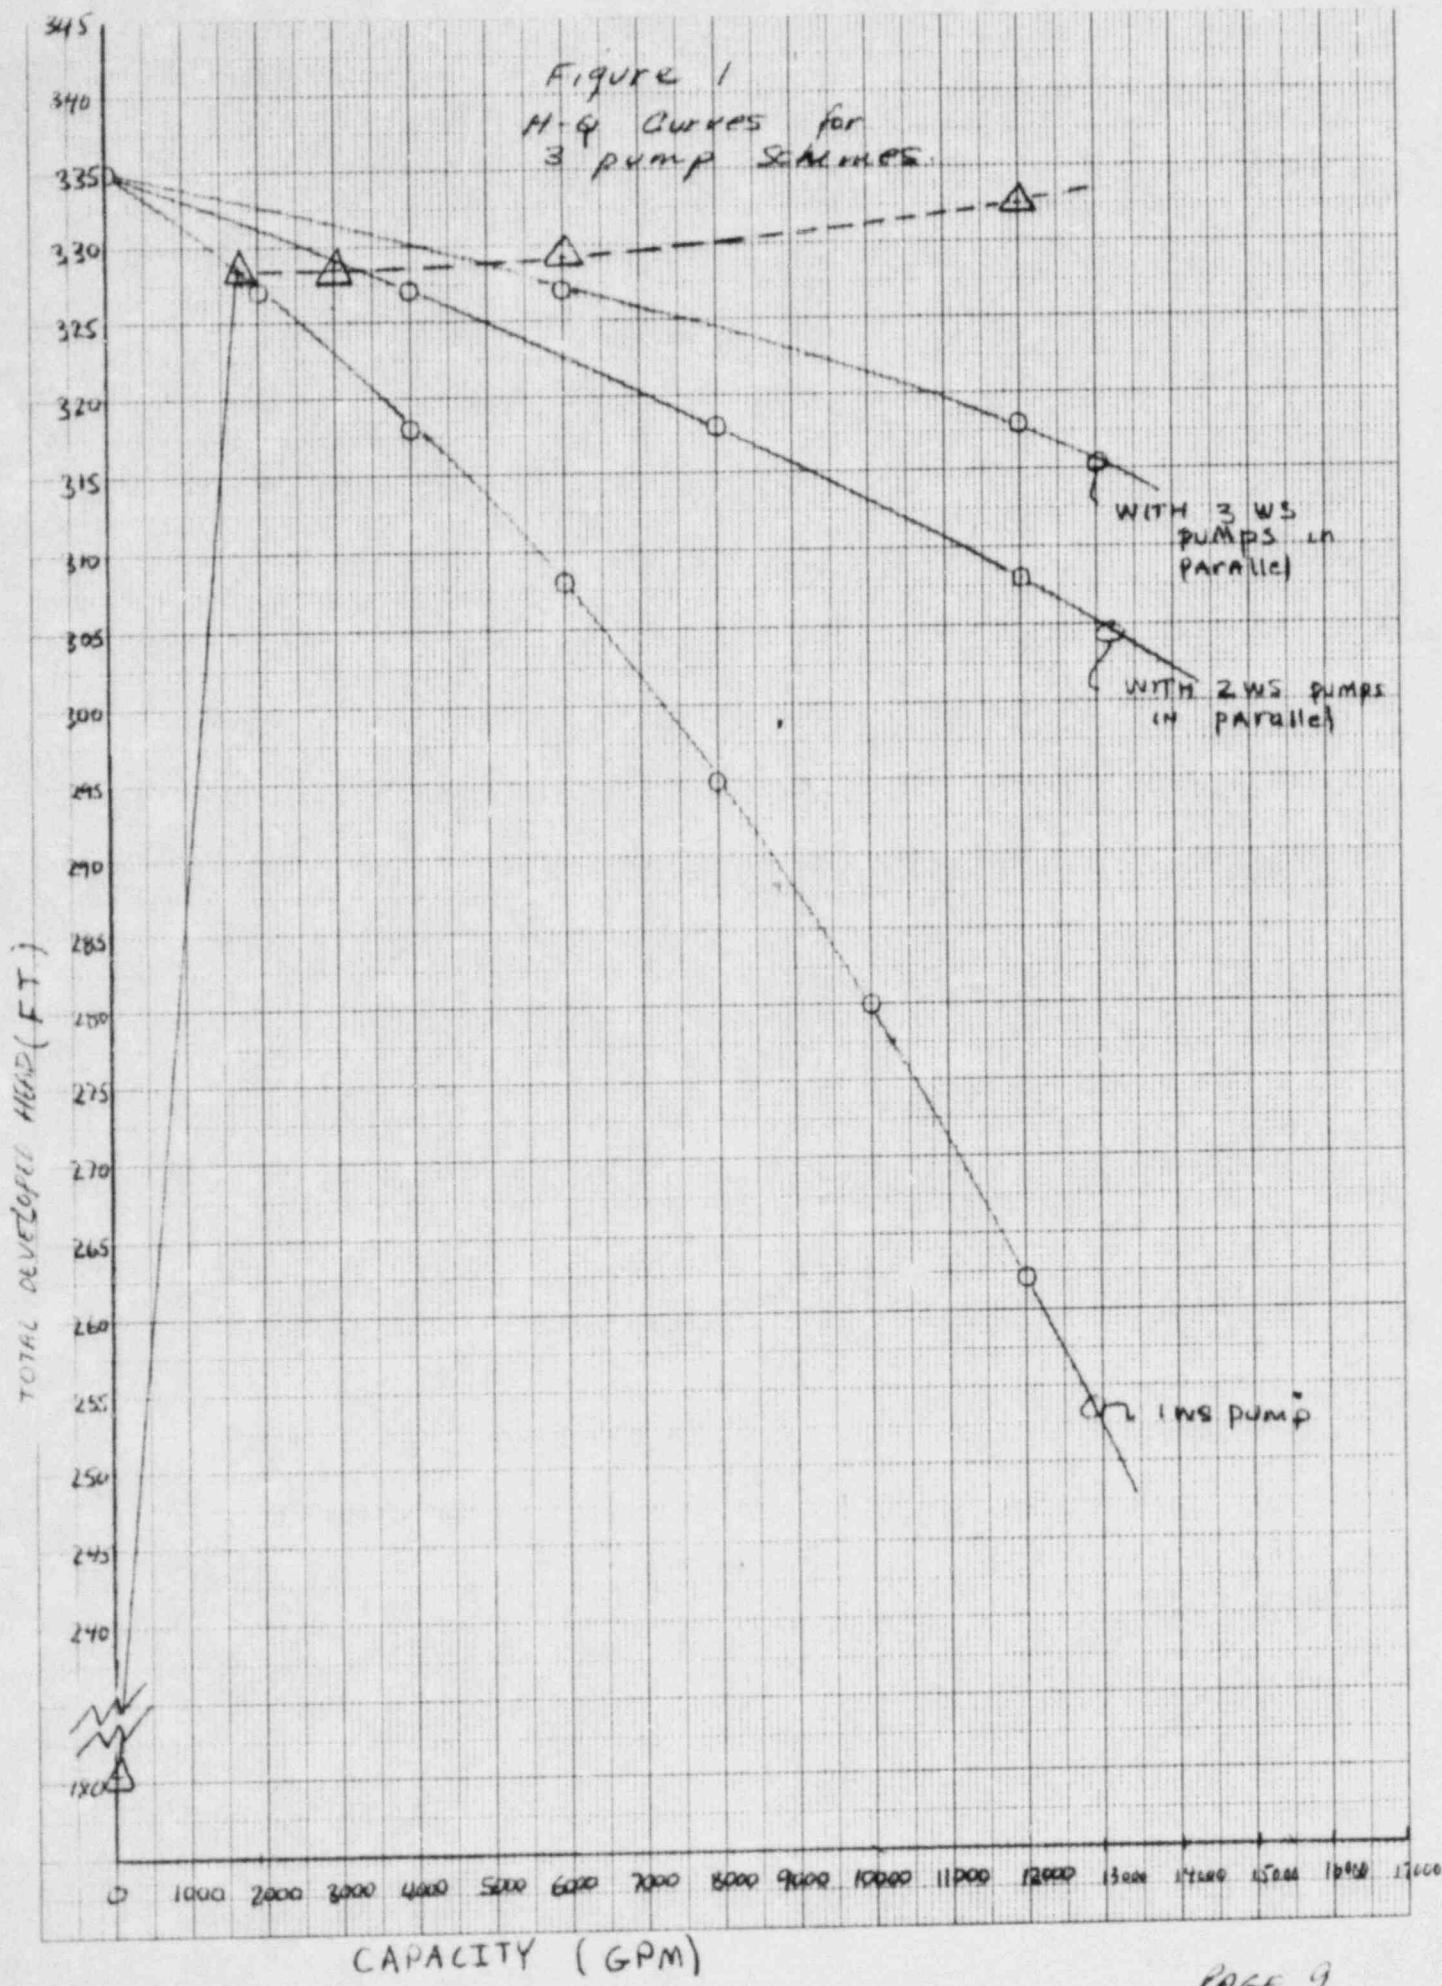

APPENDIX A

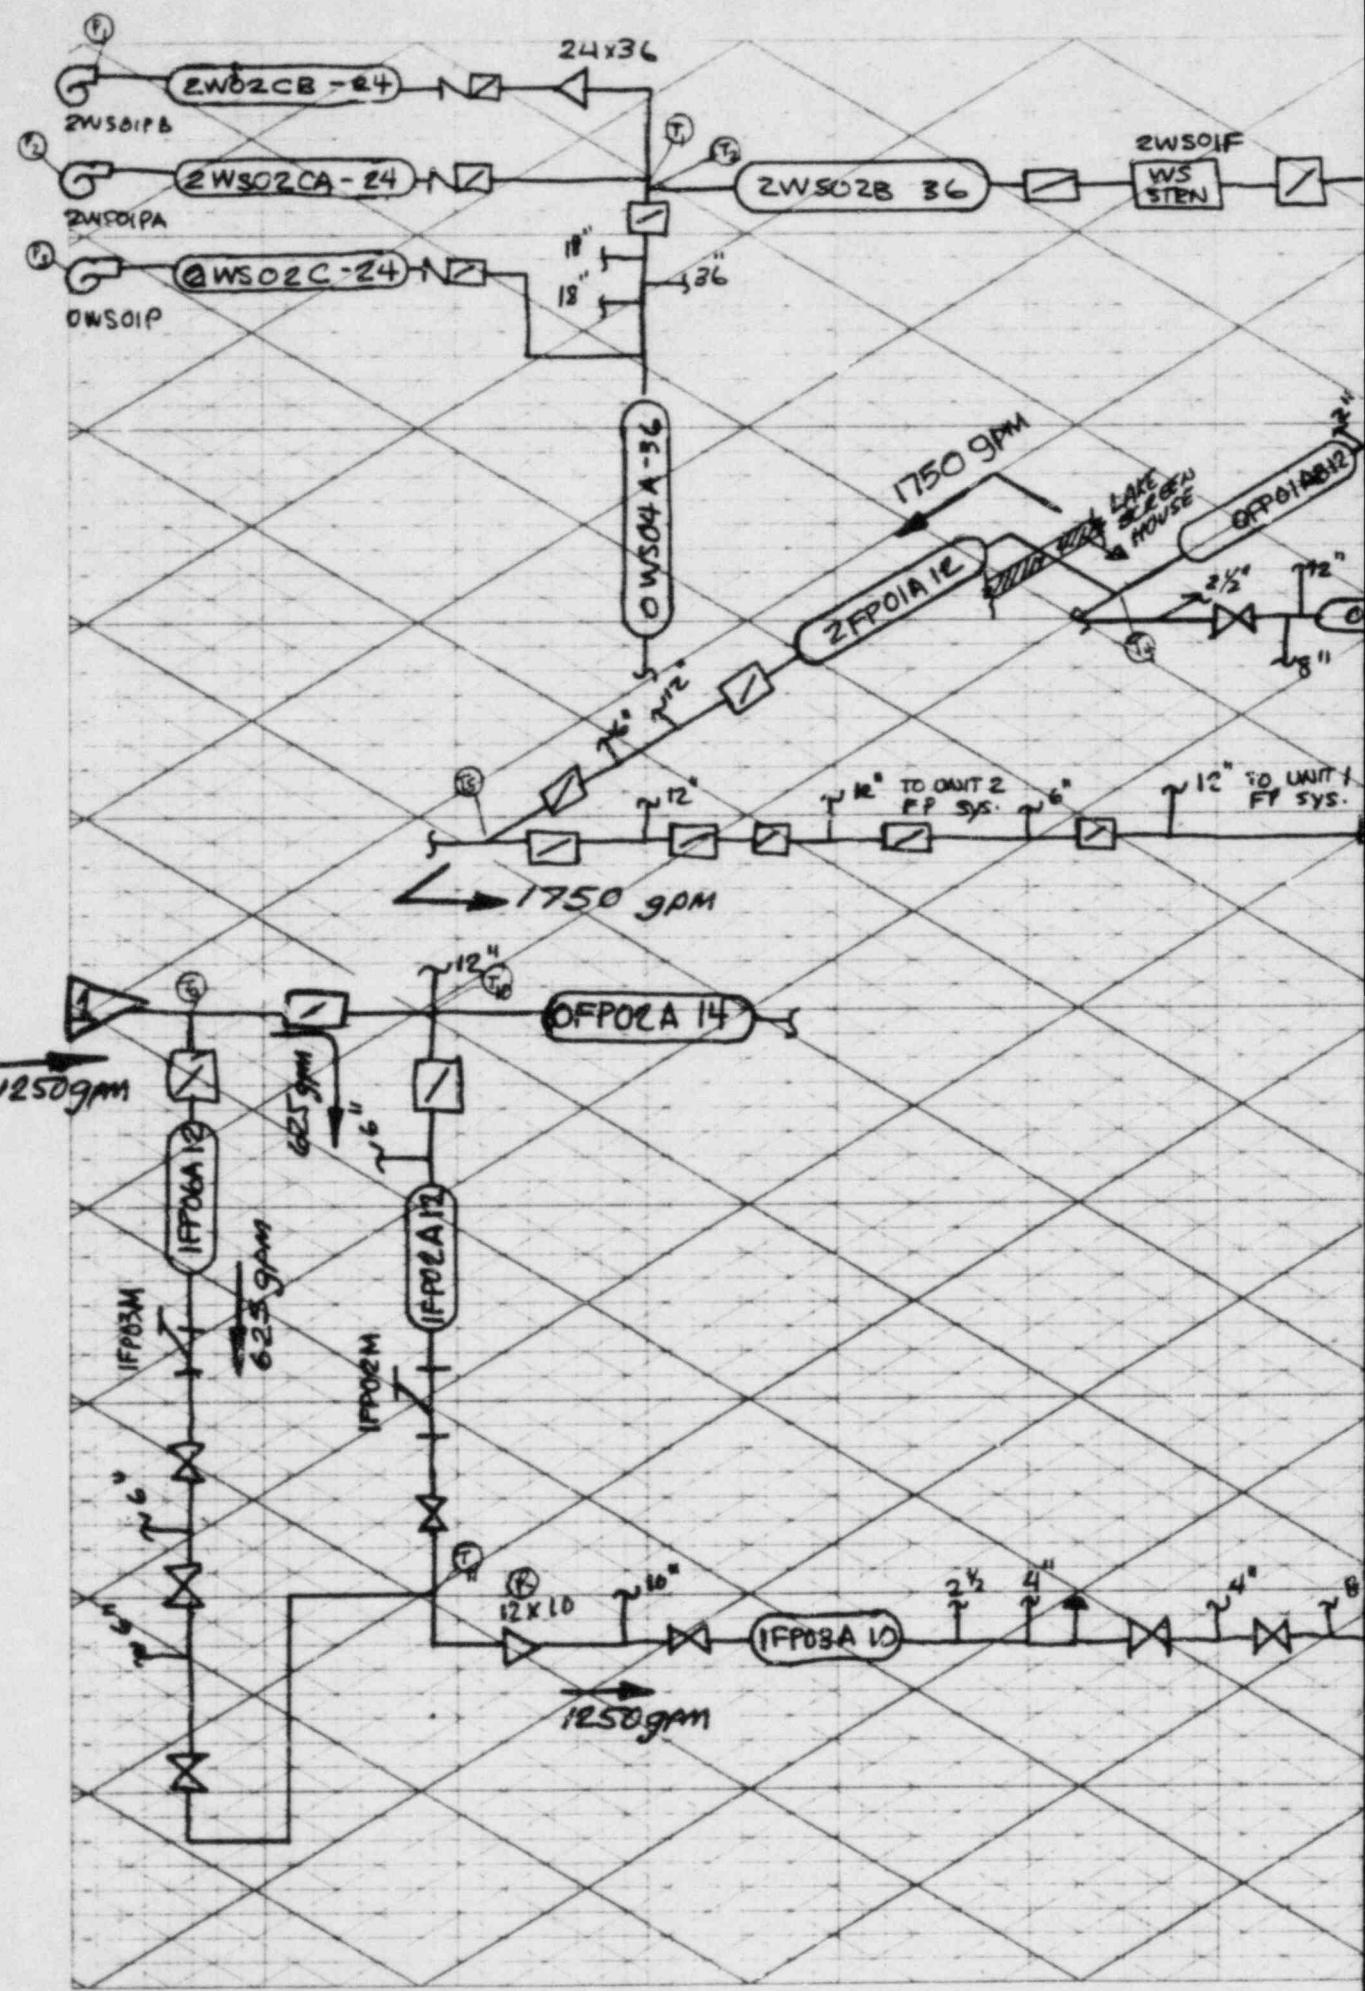


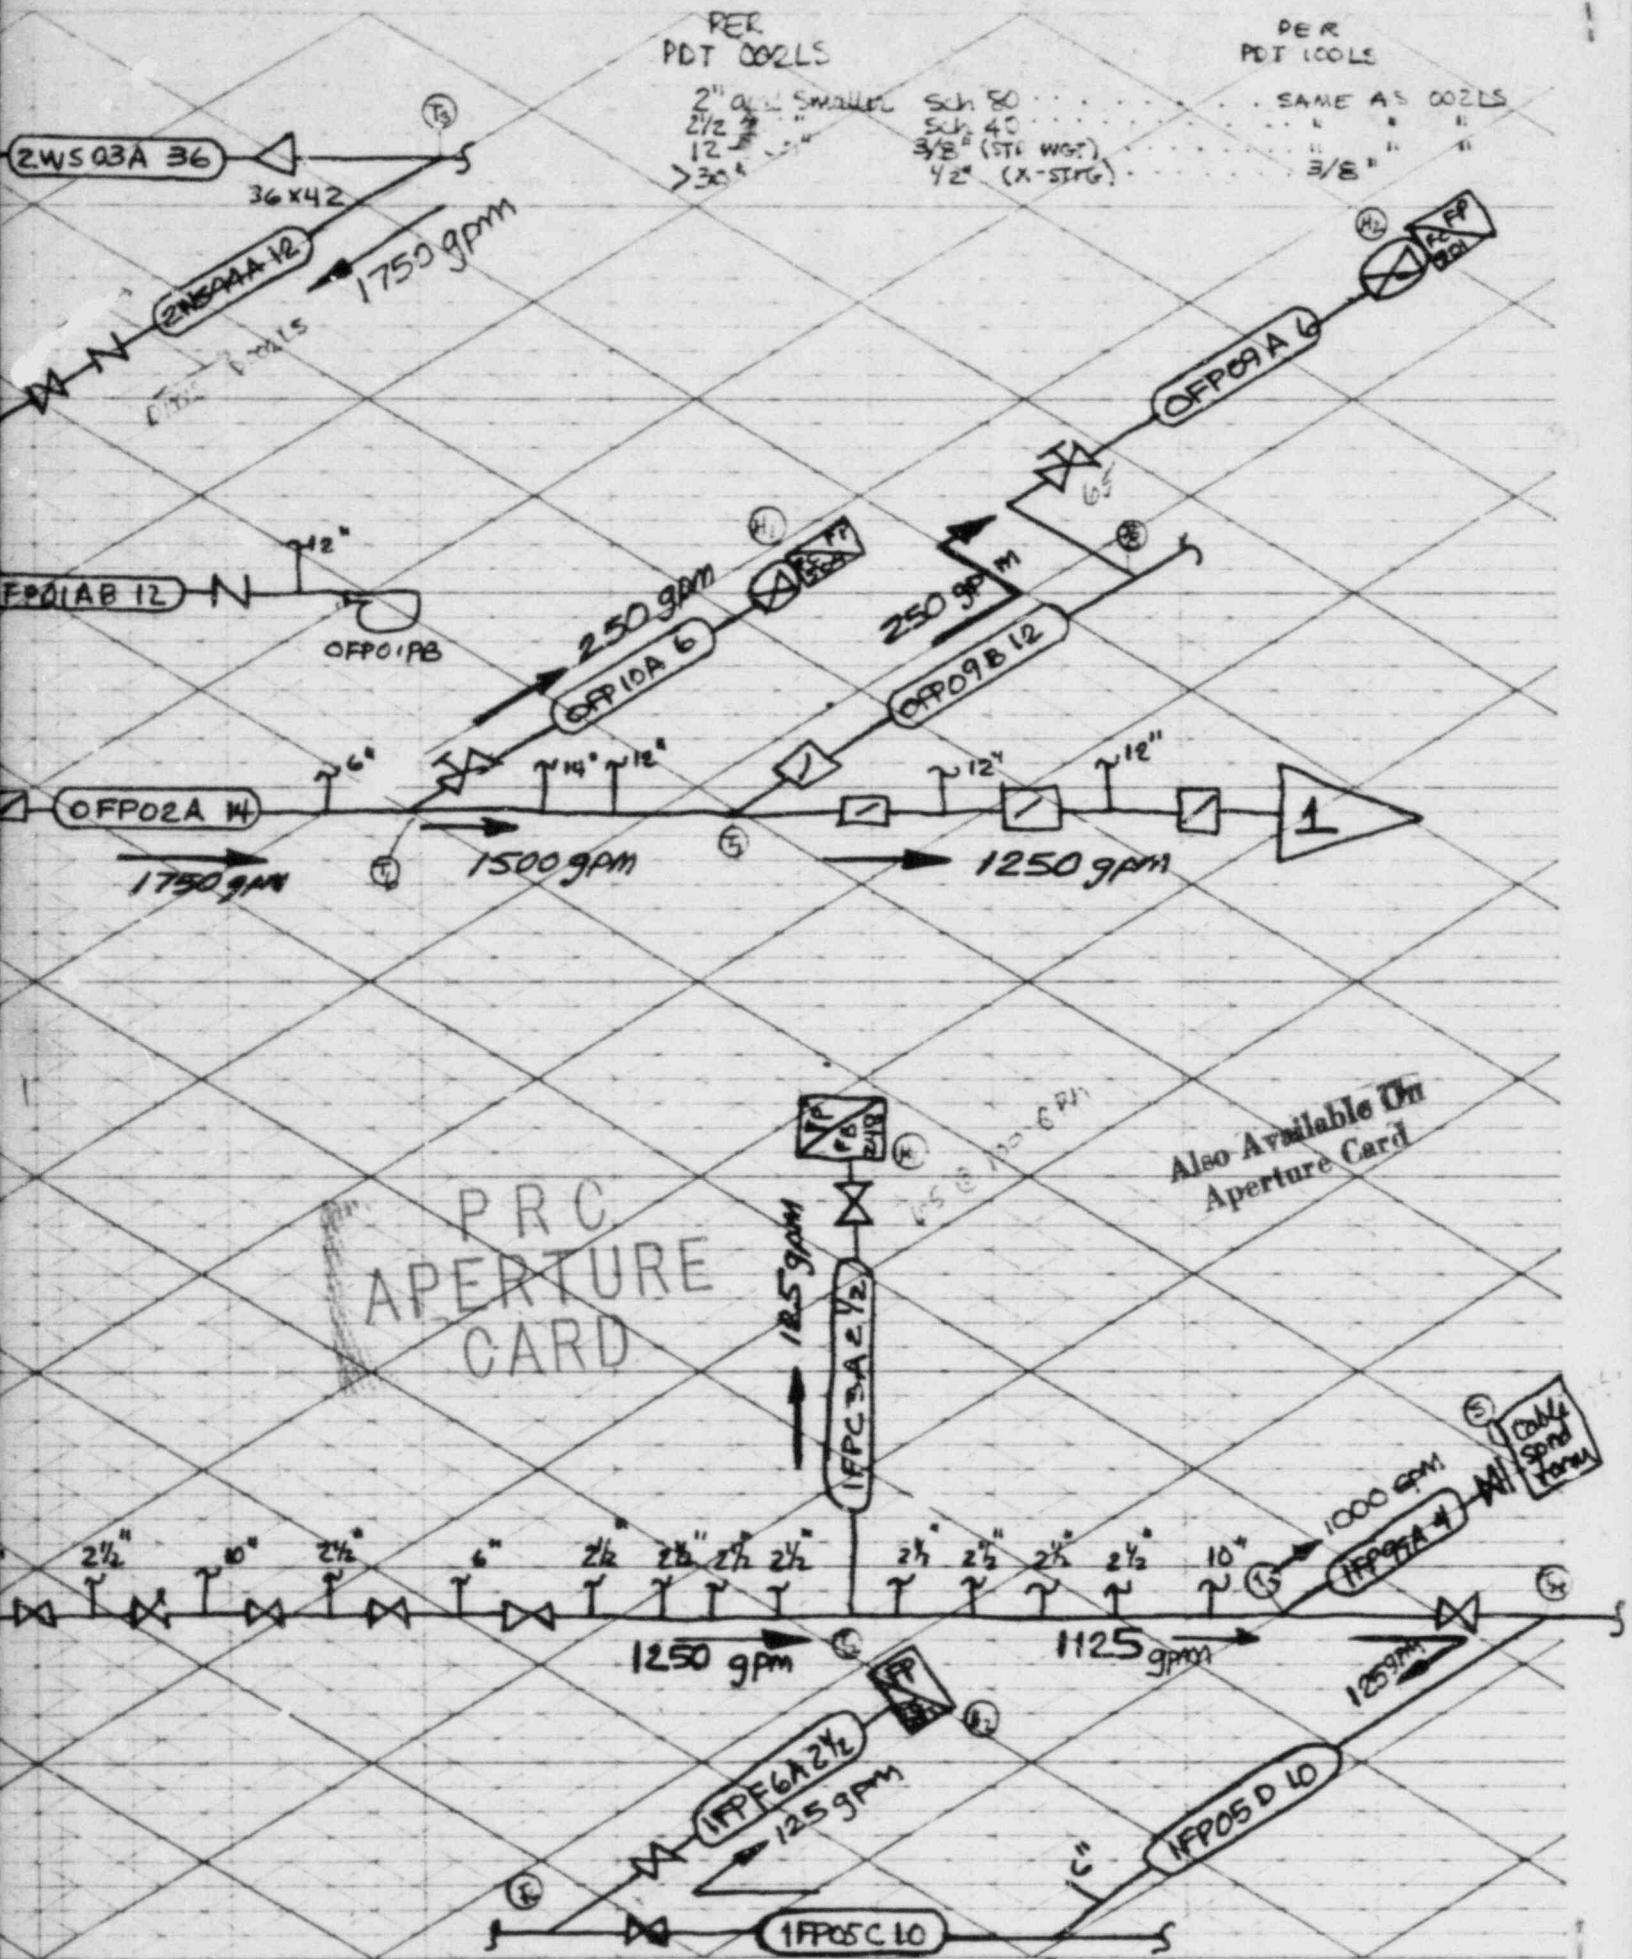

8311040130-19

PAGE A-1



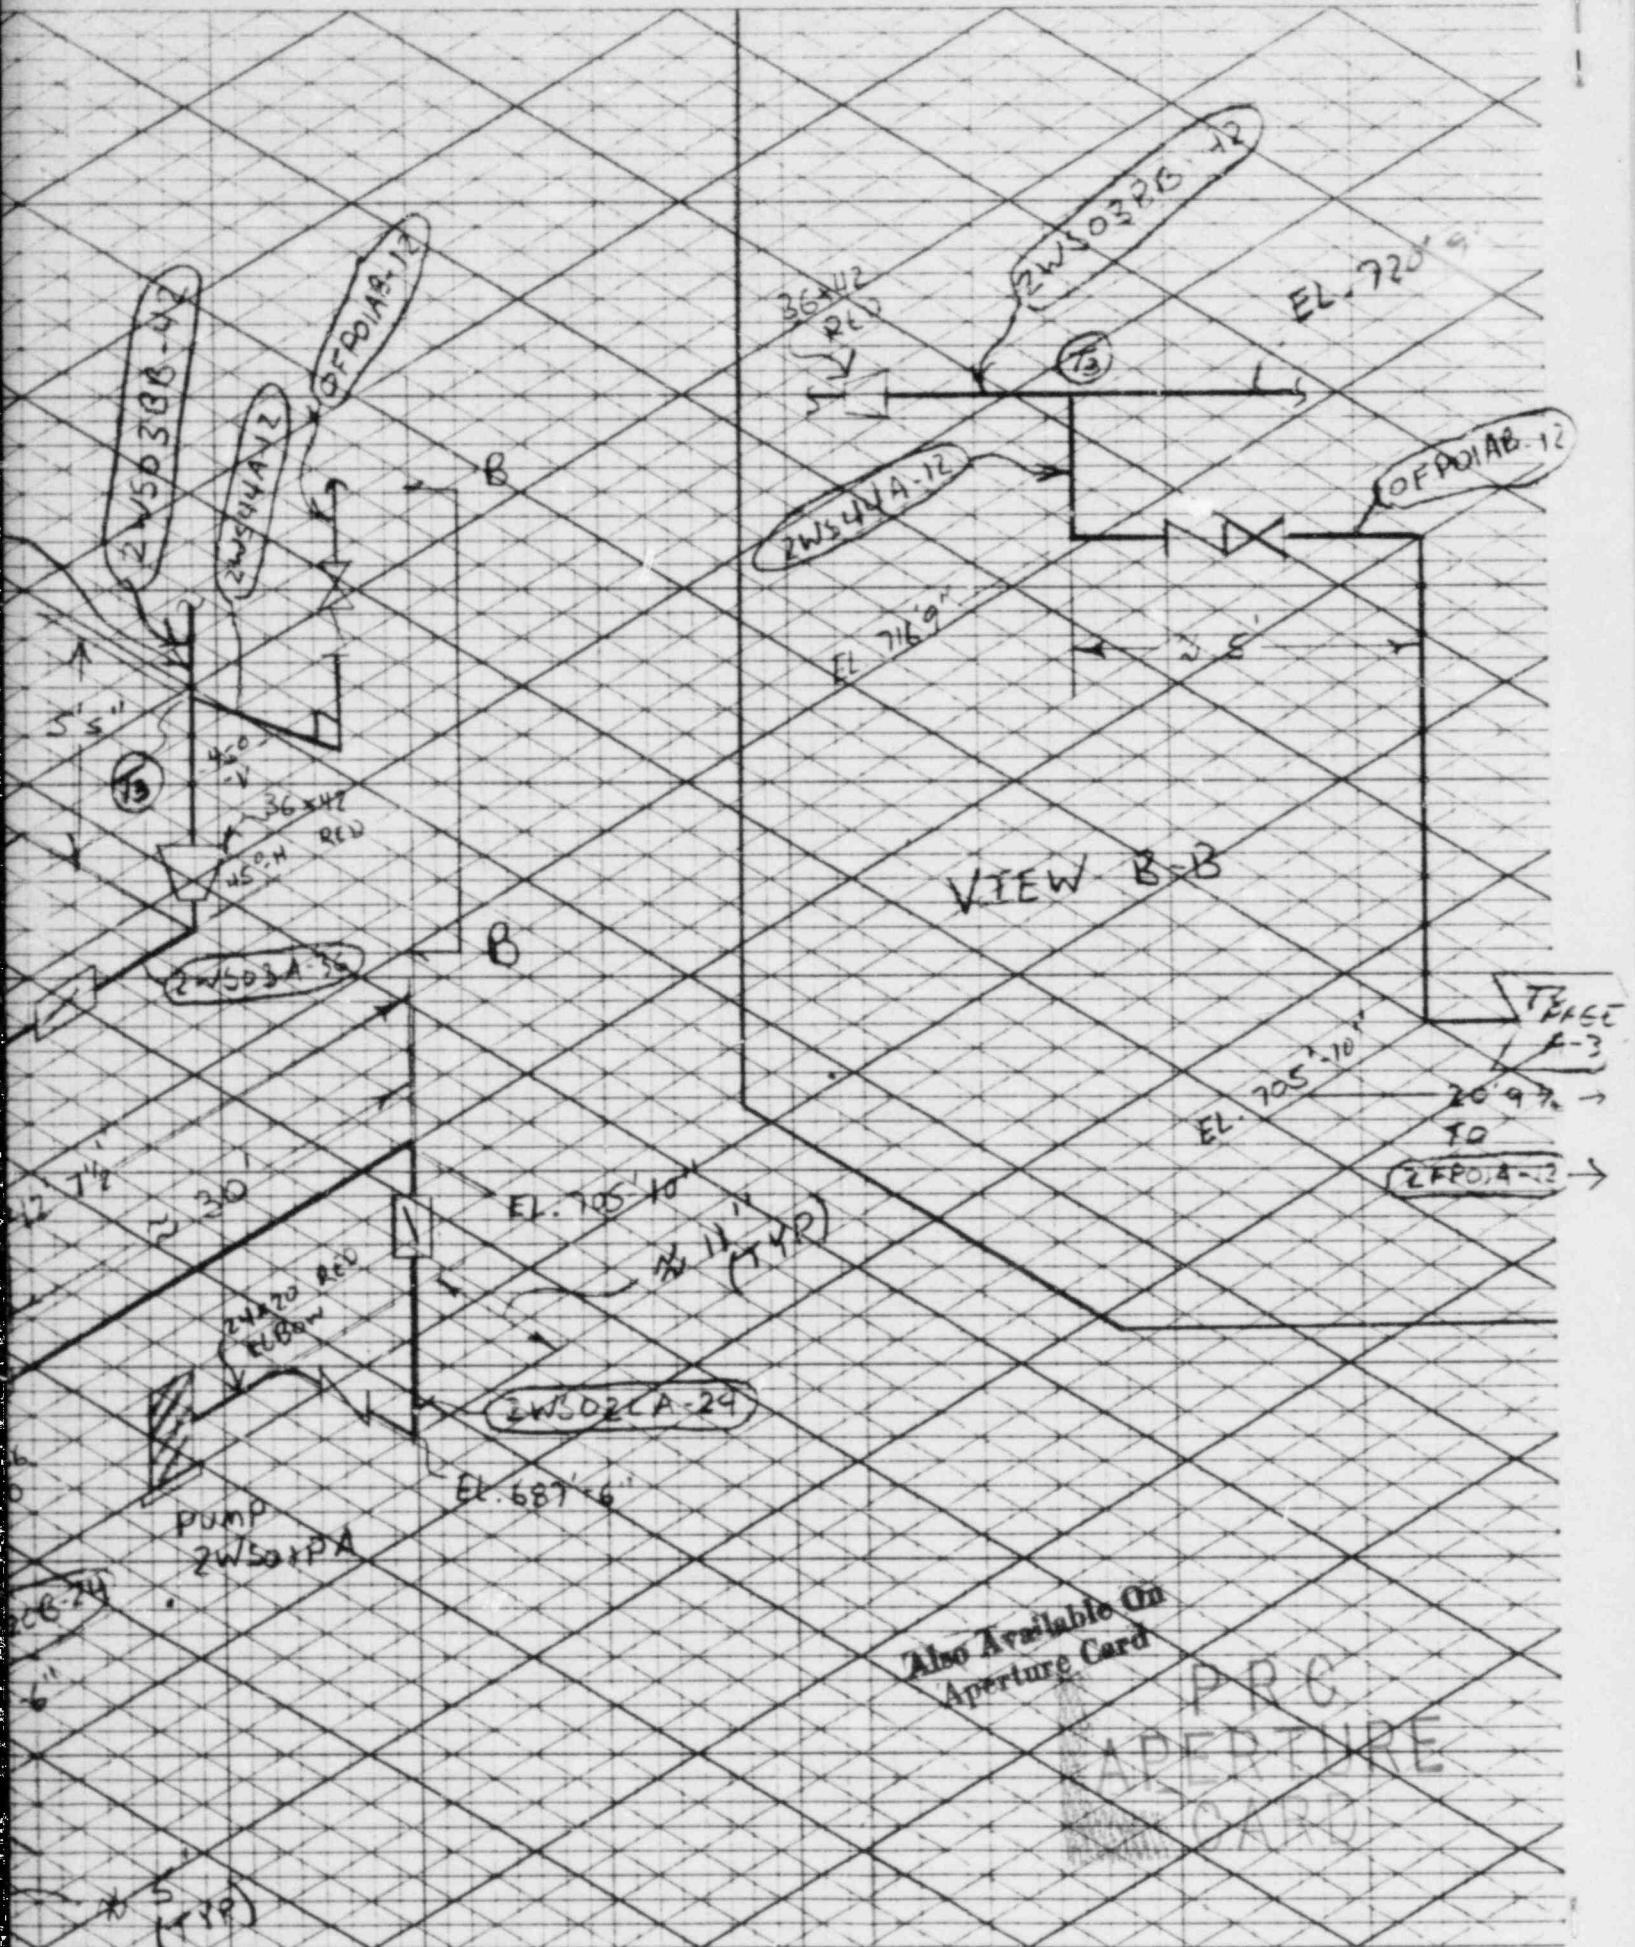



*Also Available On  
Aperture Card*

~~e Card  
PRG  
ADDED DURE  
CARDS~~

8311040130-20


PAGE F-2

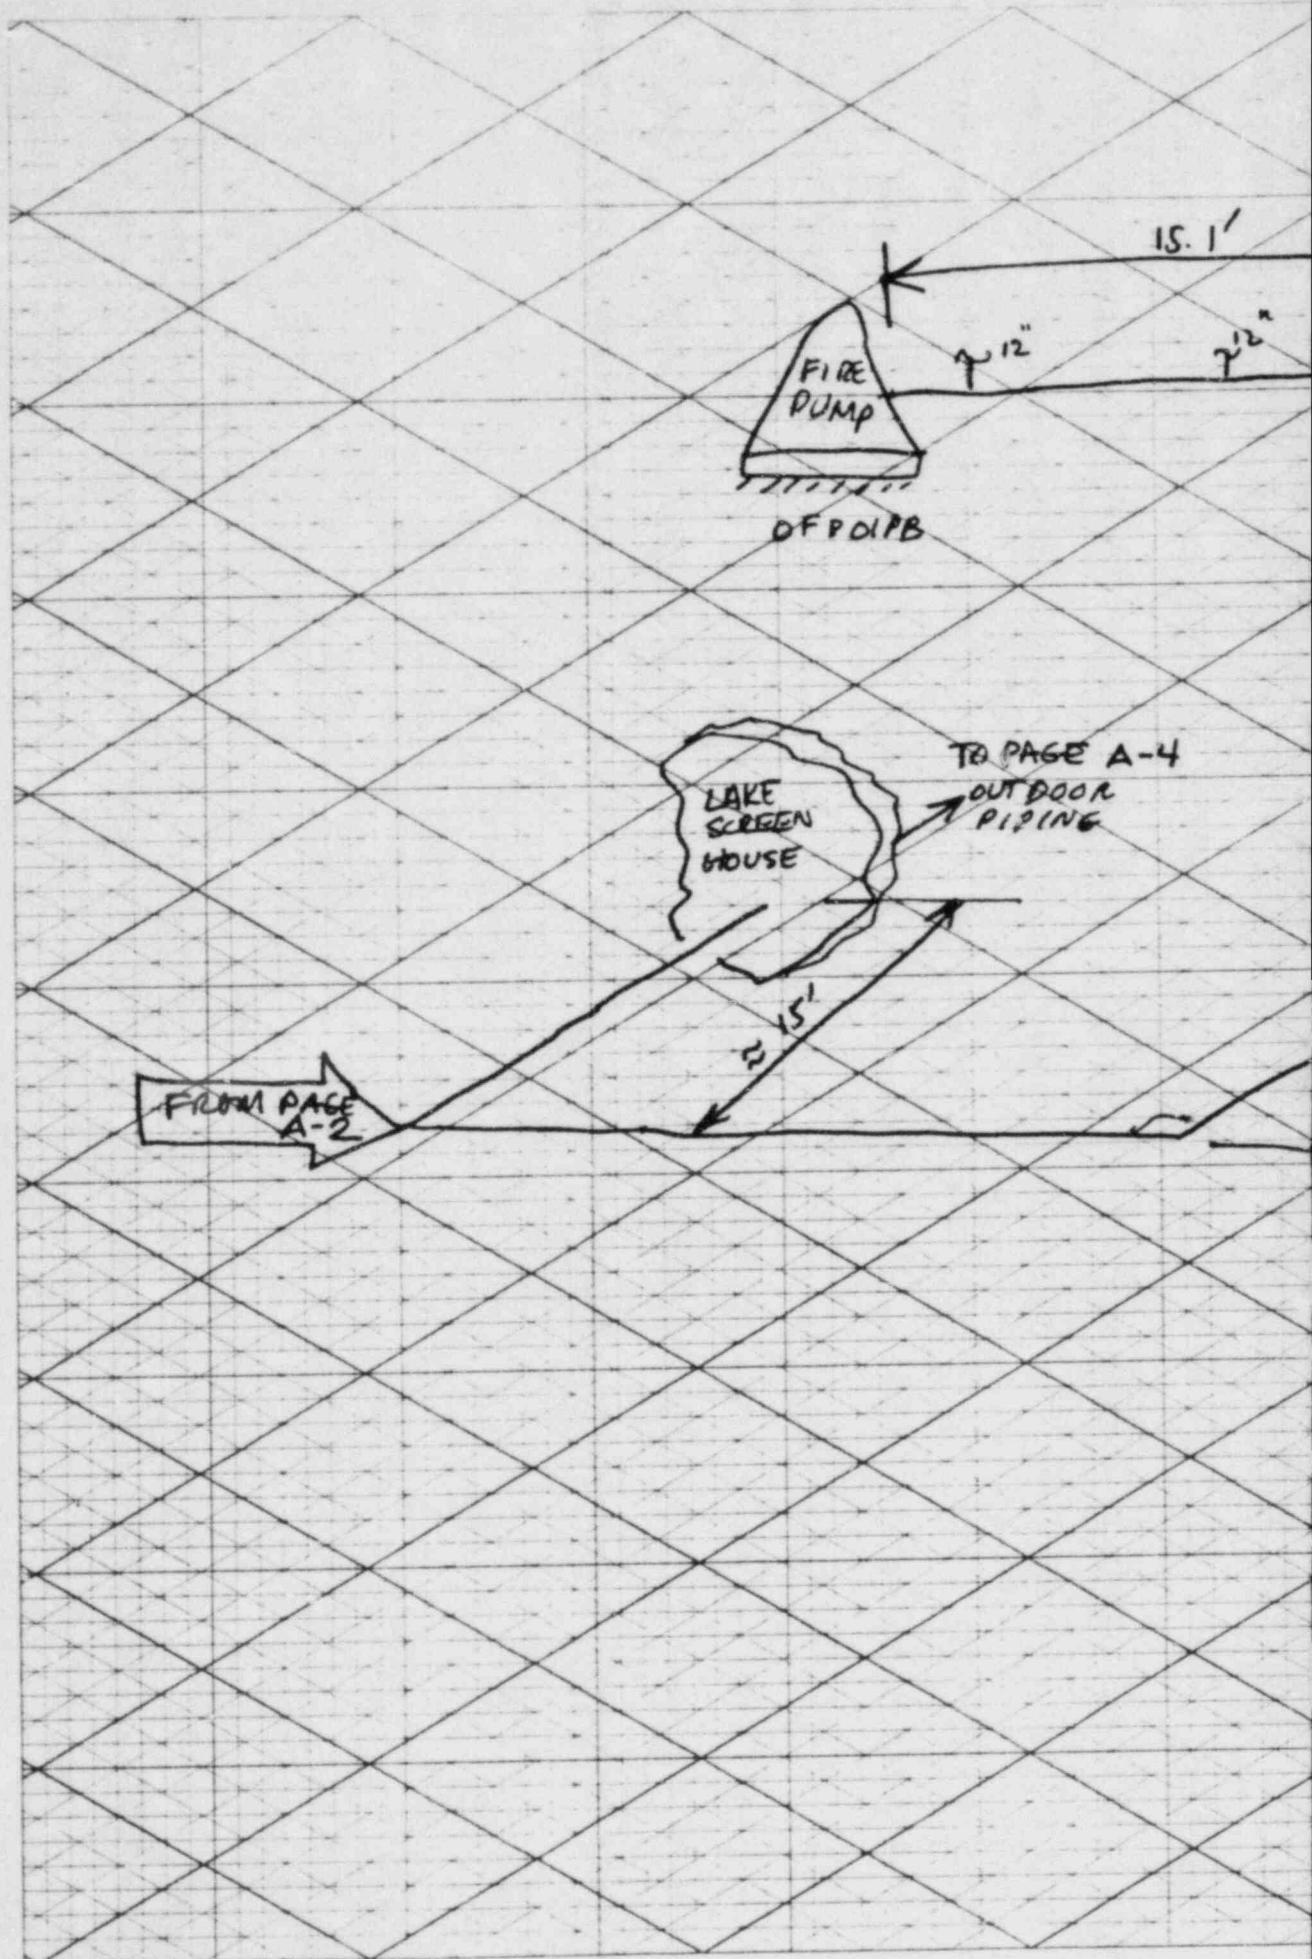


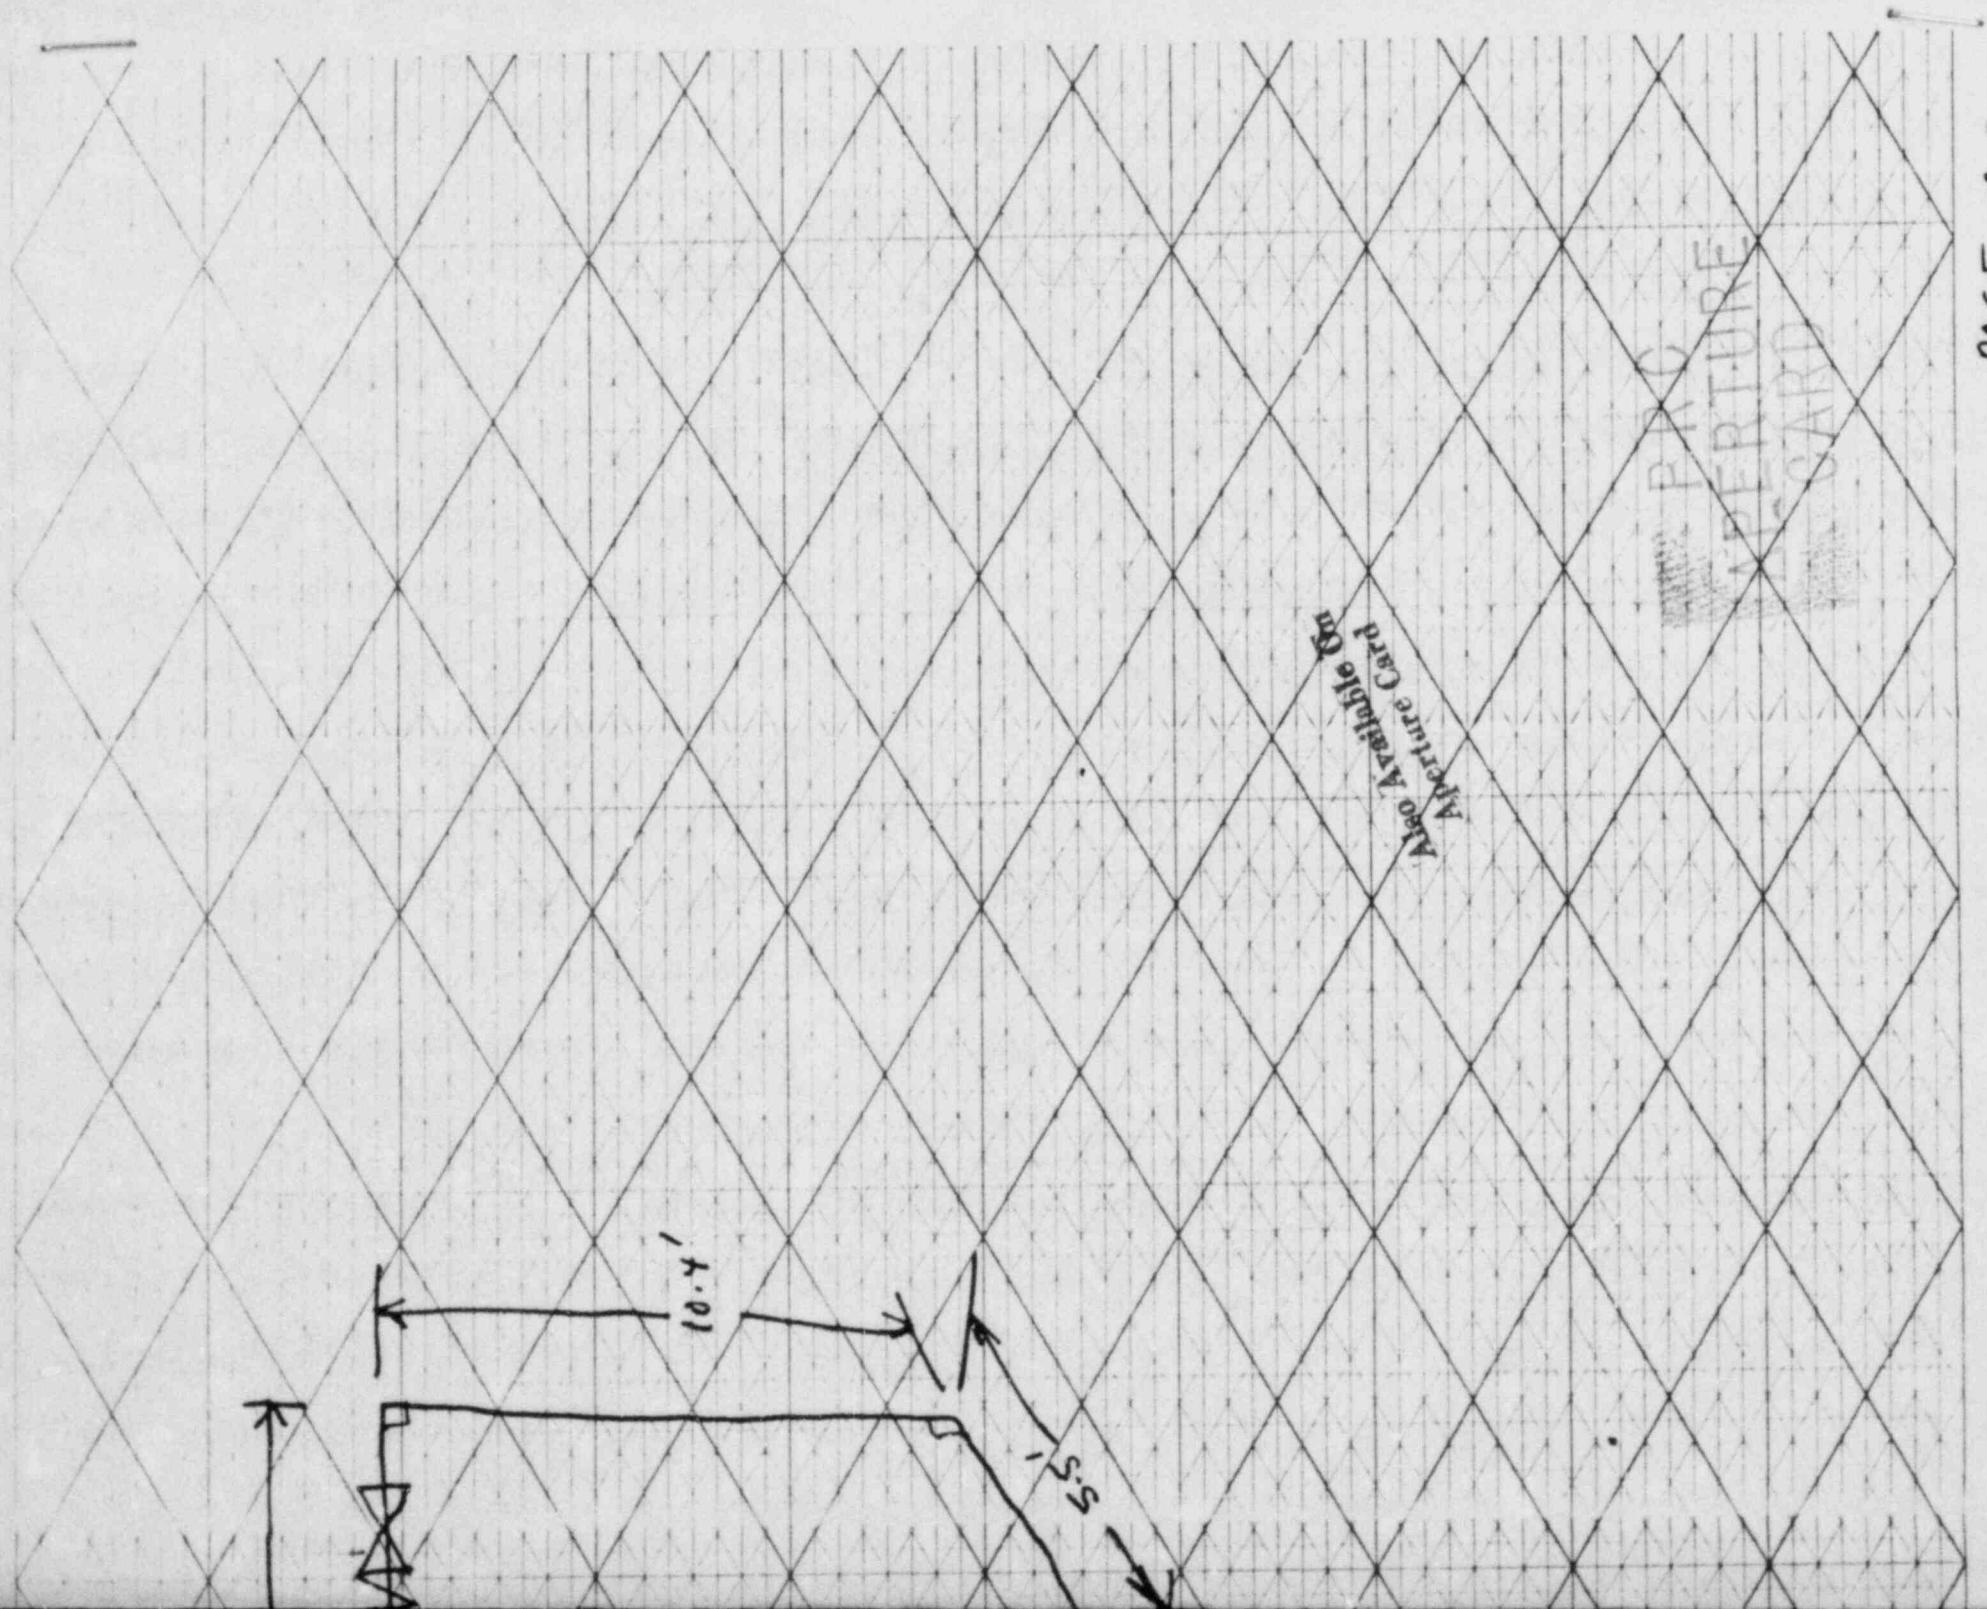



ISOMETRIC-ORTHOGRAPHIC 1943

47 4030

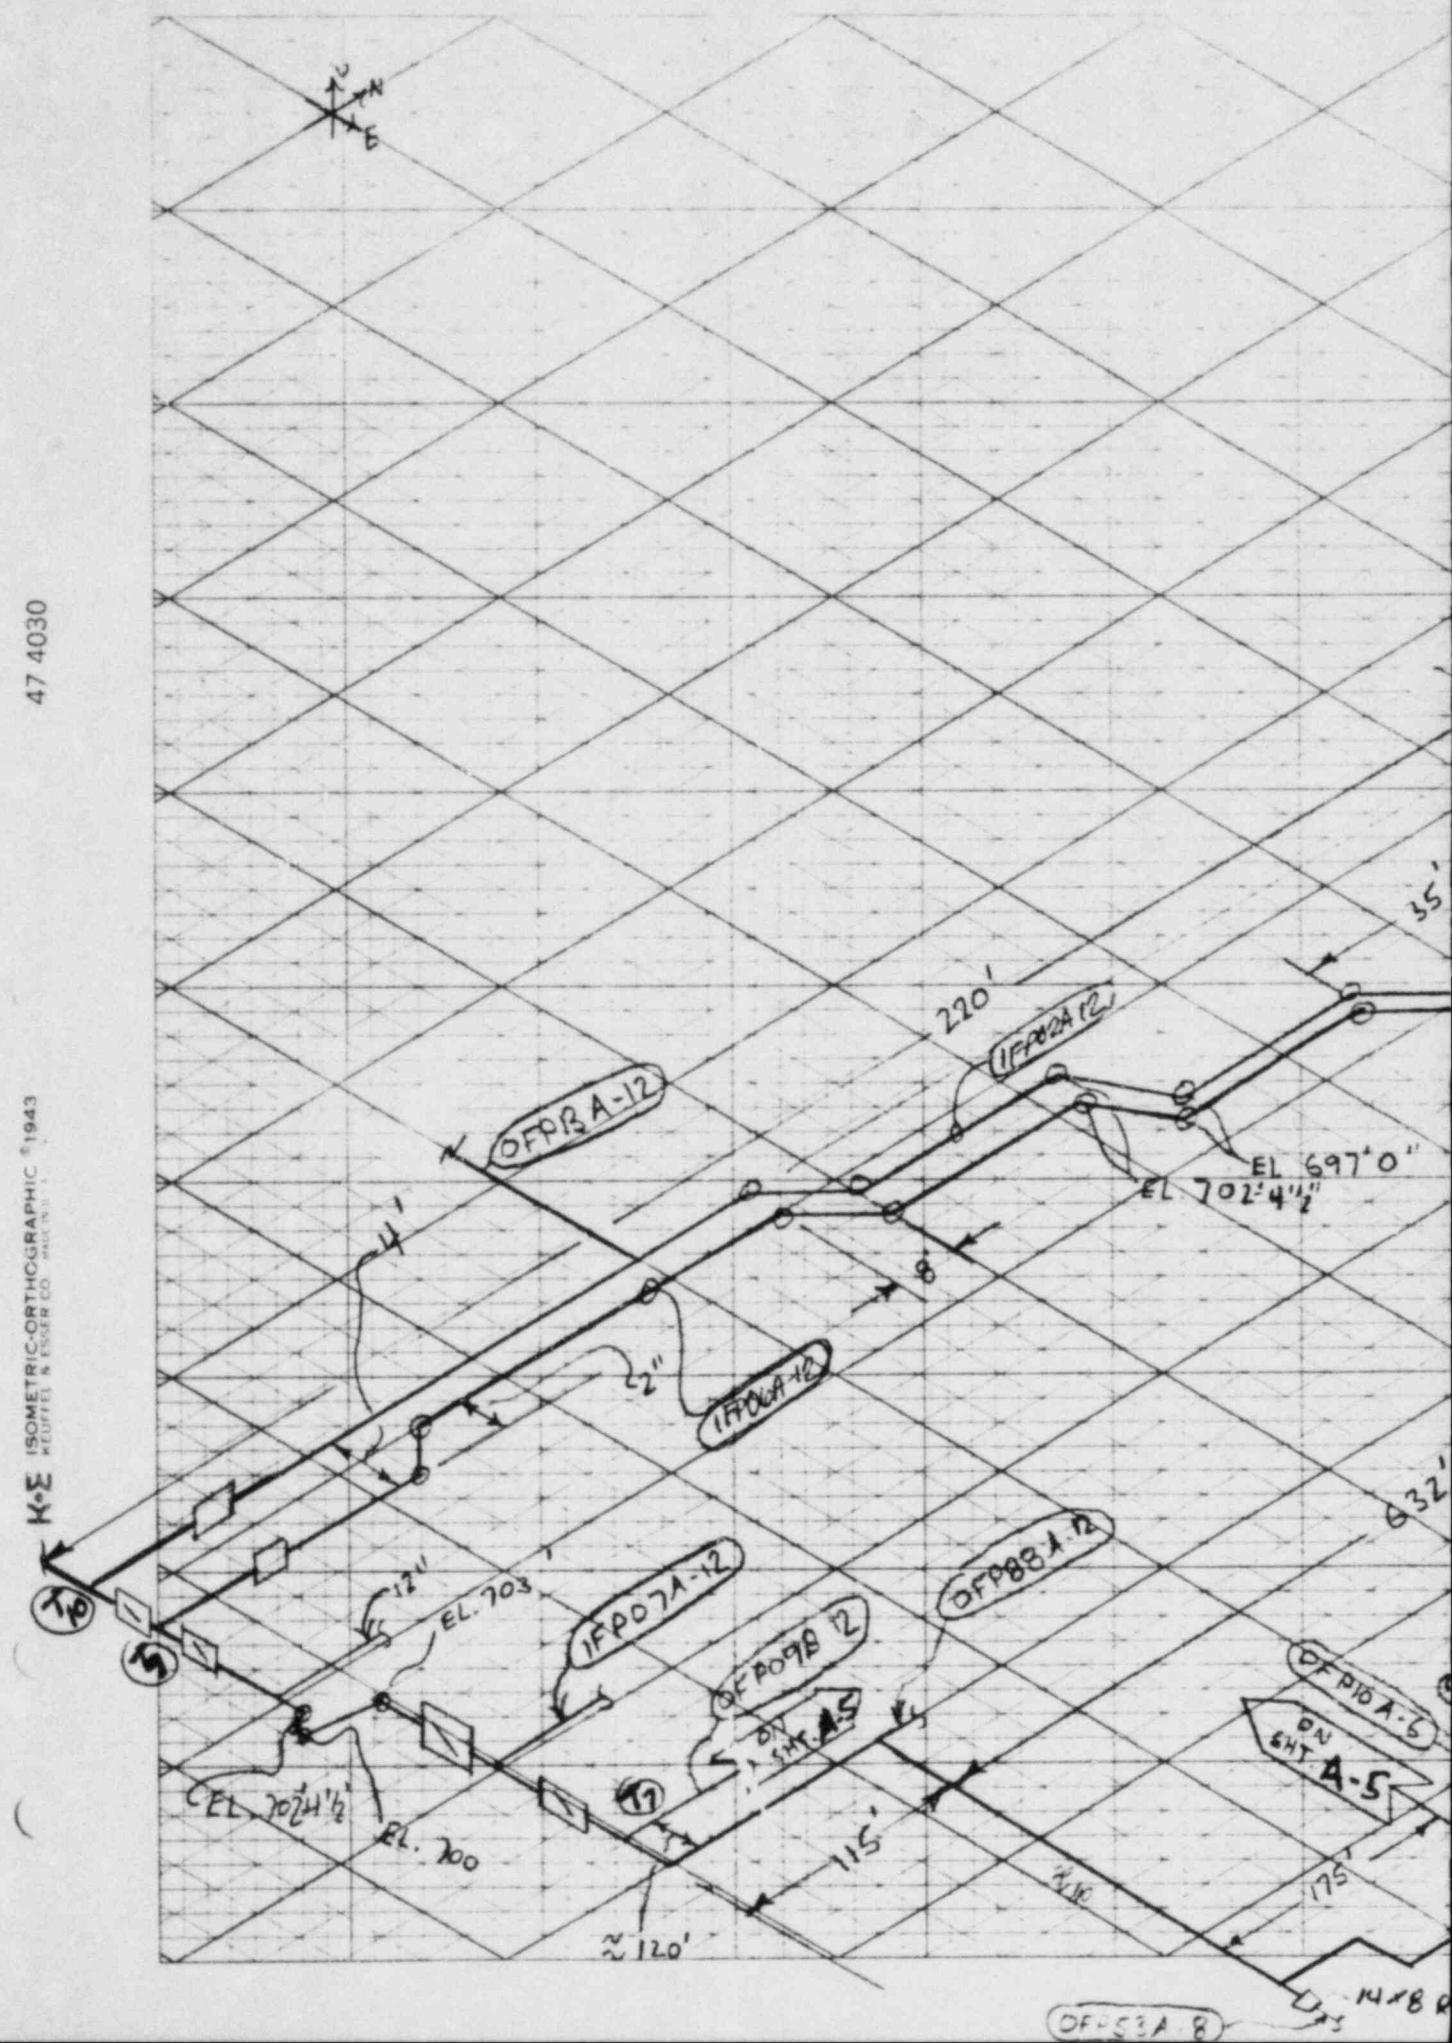

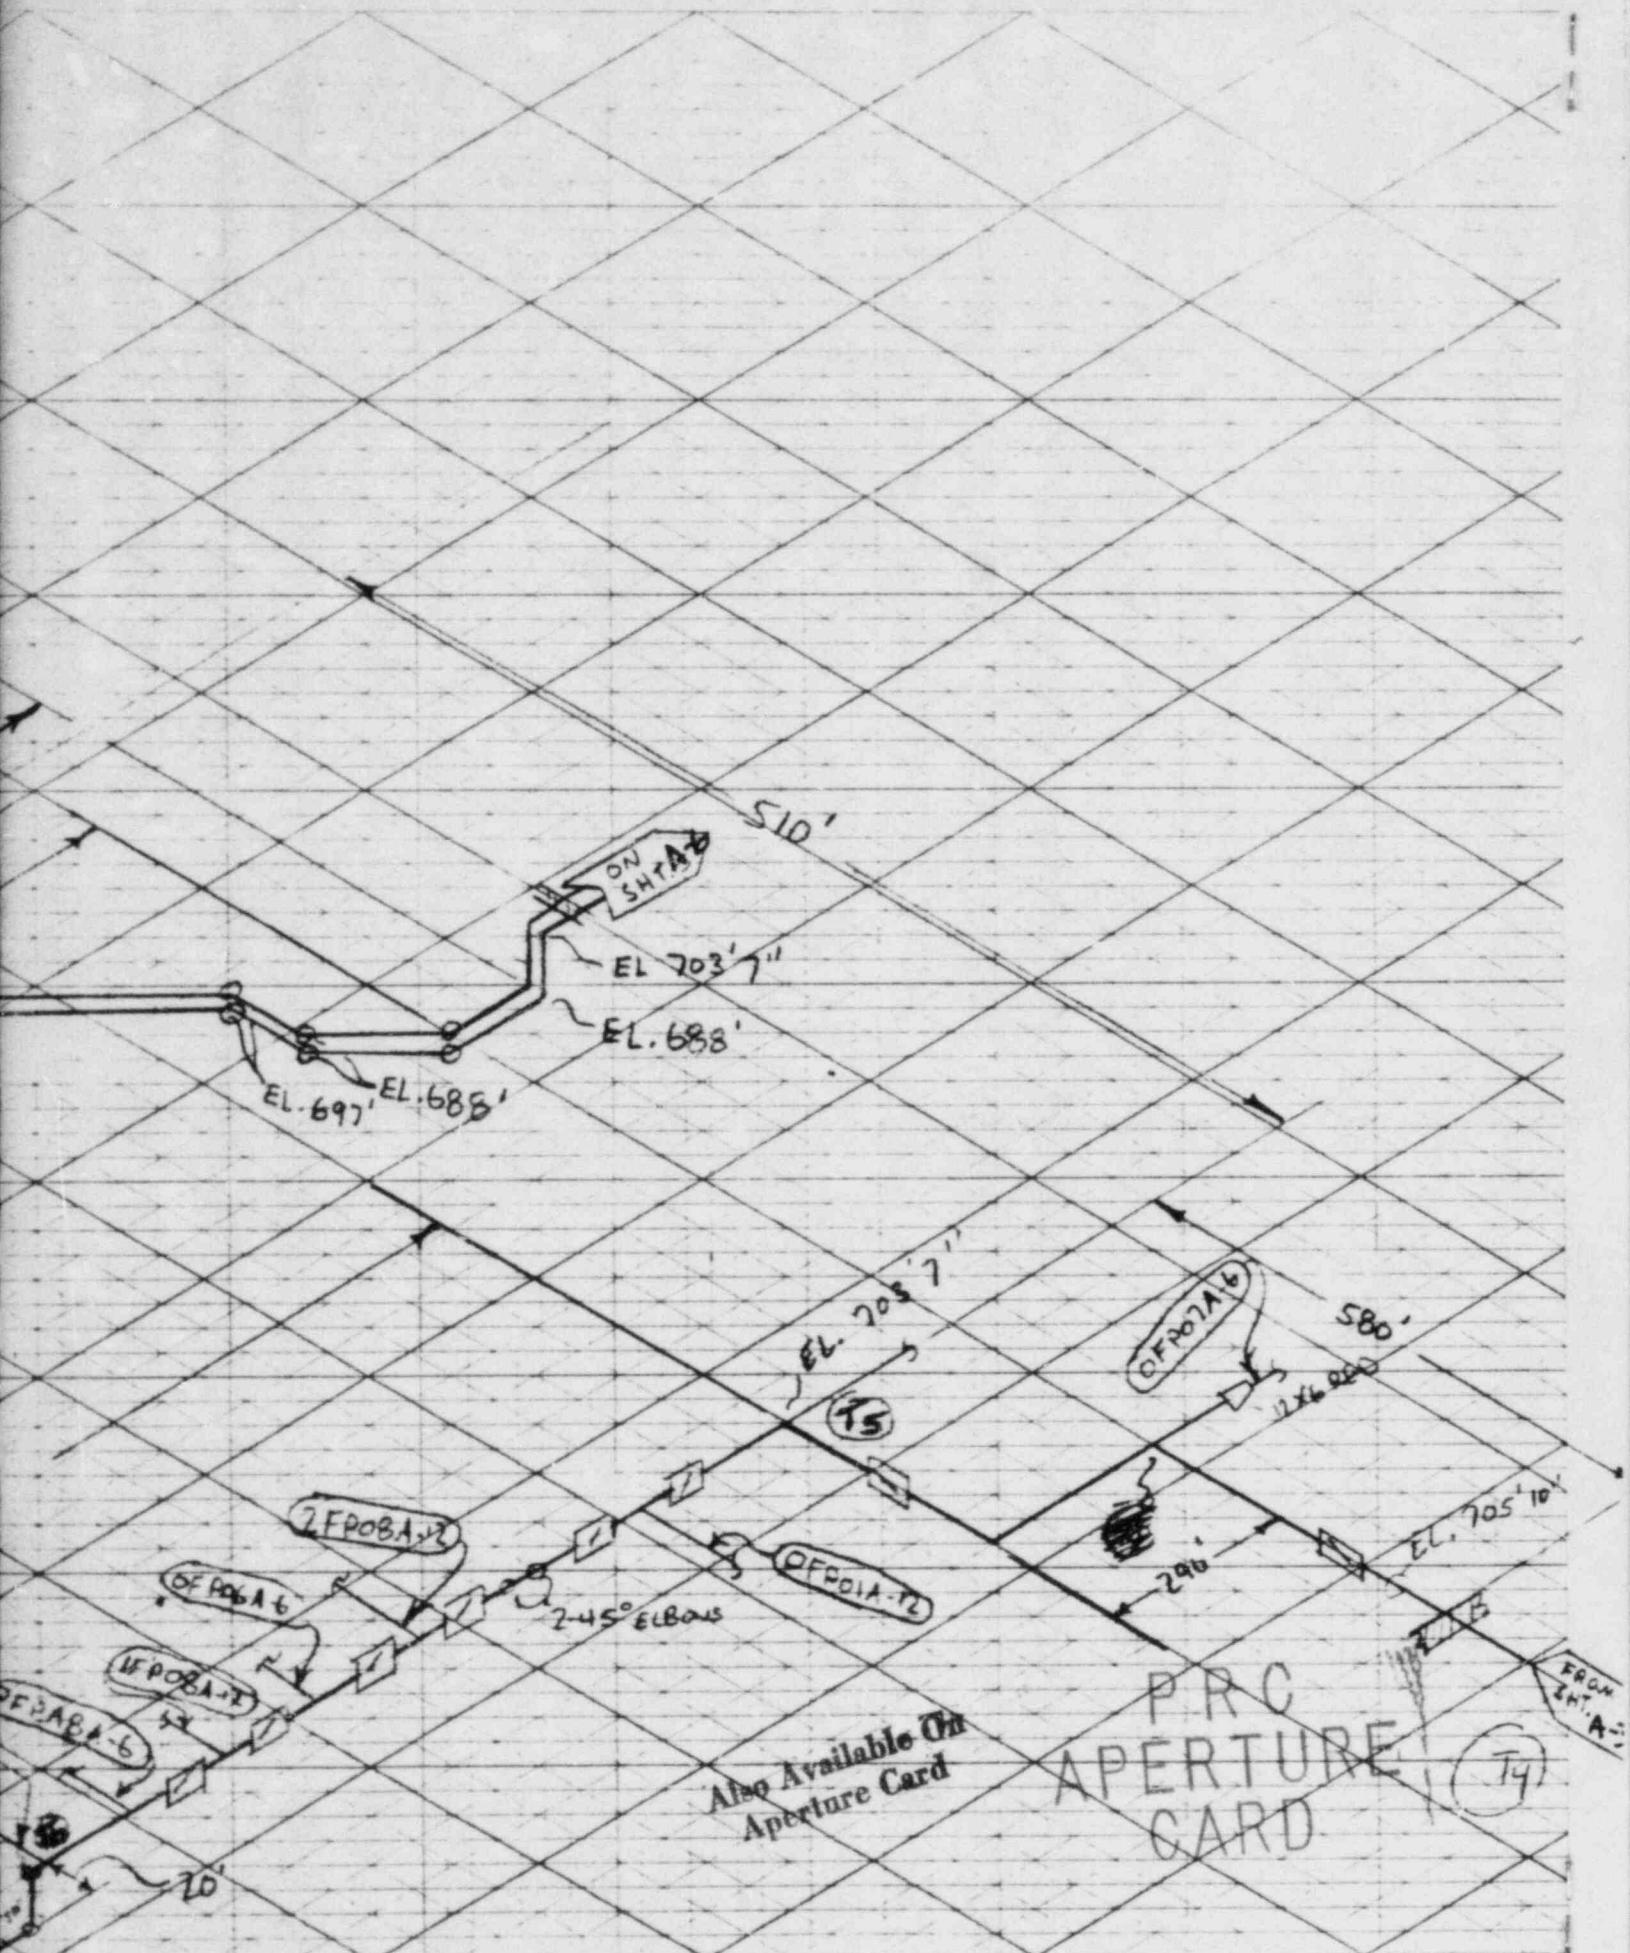

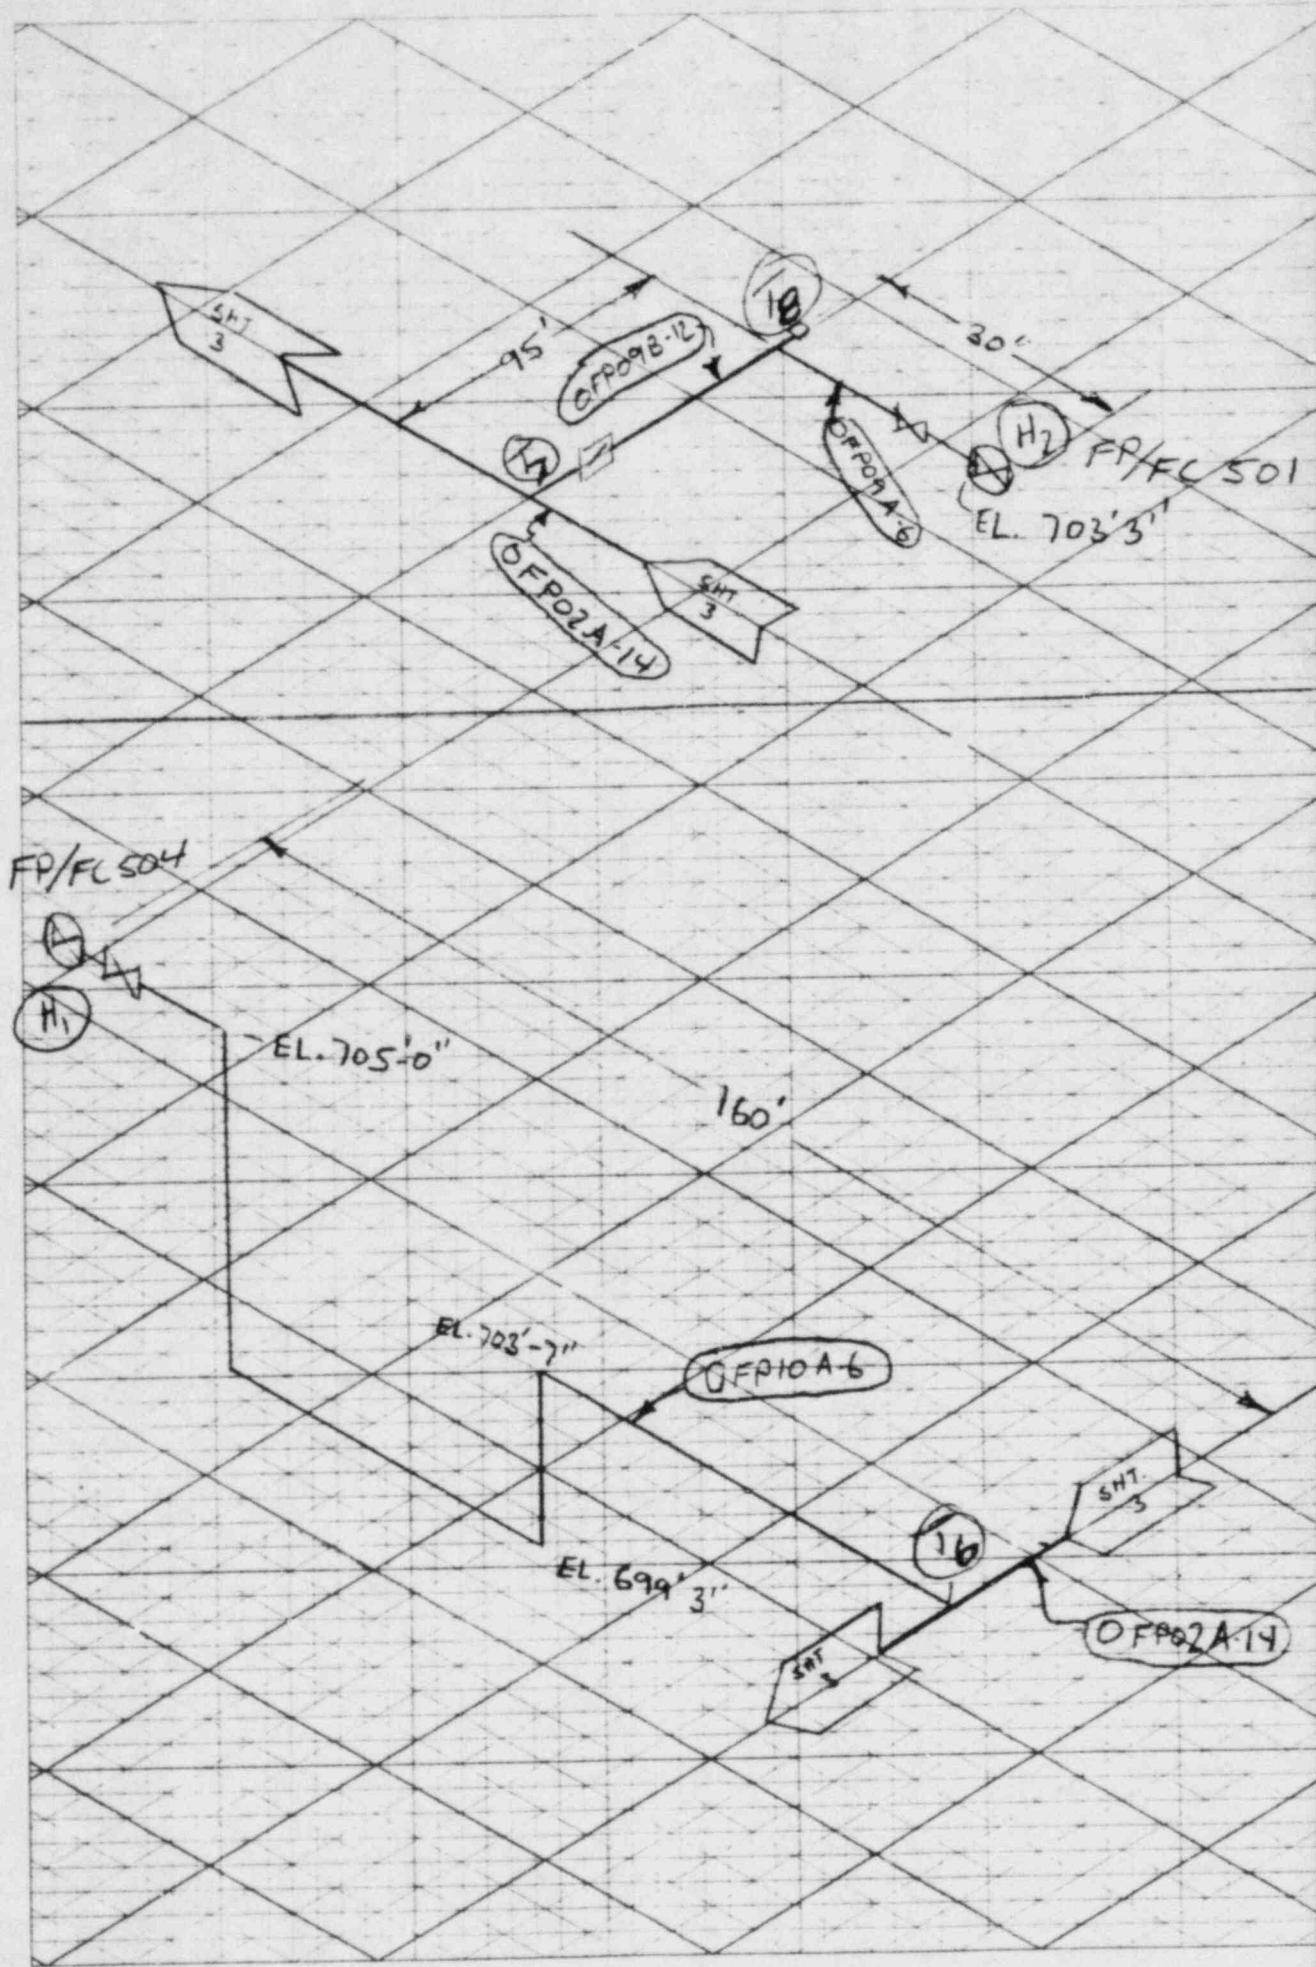

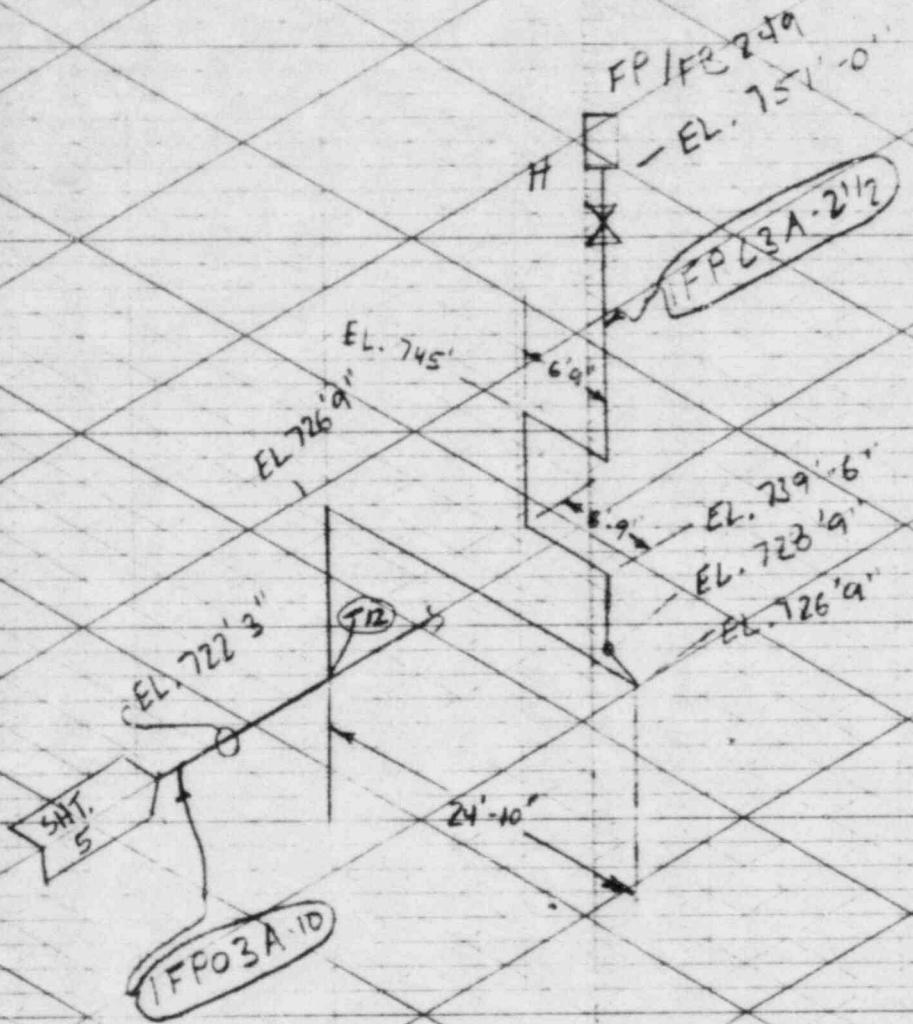


## HOSE STATIONS FOR CABLE SPREADING AREA


Also Available On  
Aperture Card

PRC  
APERTURE  
CARD

KODAK ISOMETRIC-ORTHOGRAPHIC '1943  
KLEFFEL & FISSEN CO., HANNOVER

47 4030

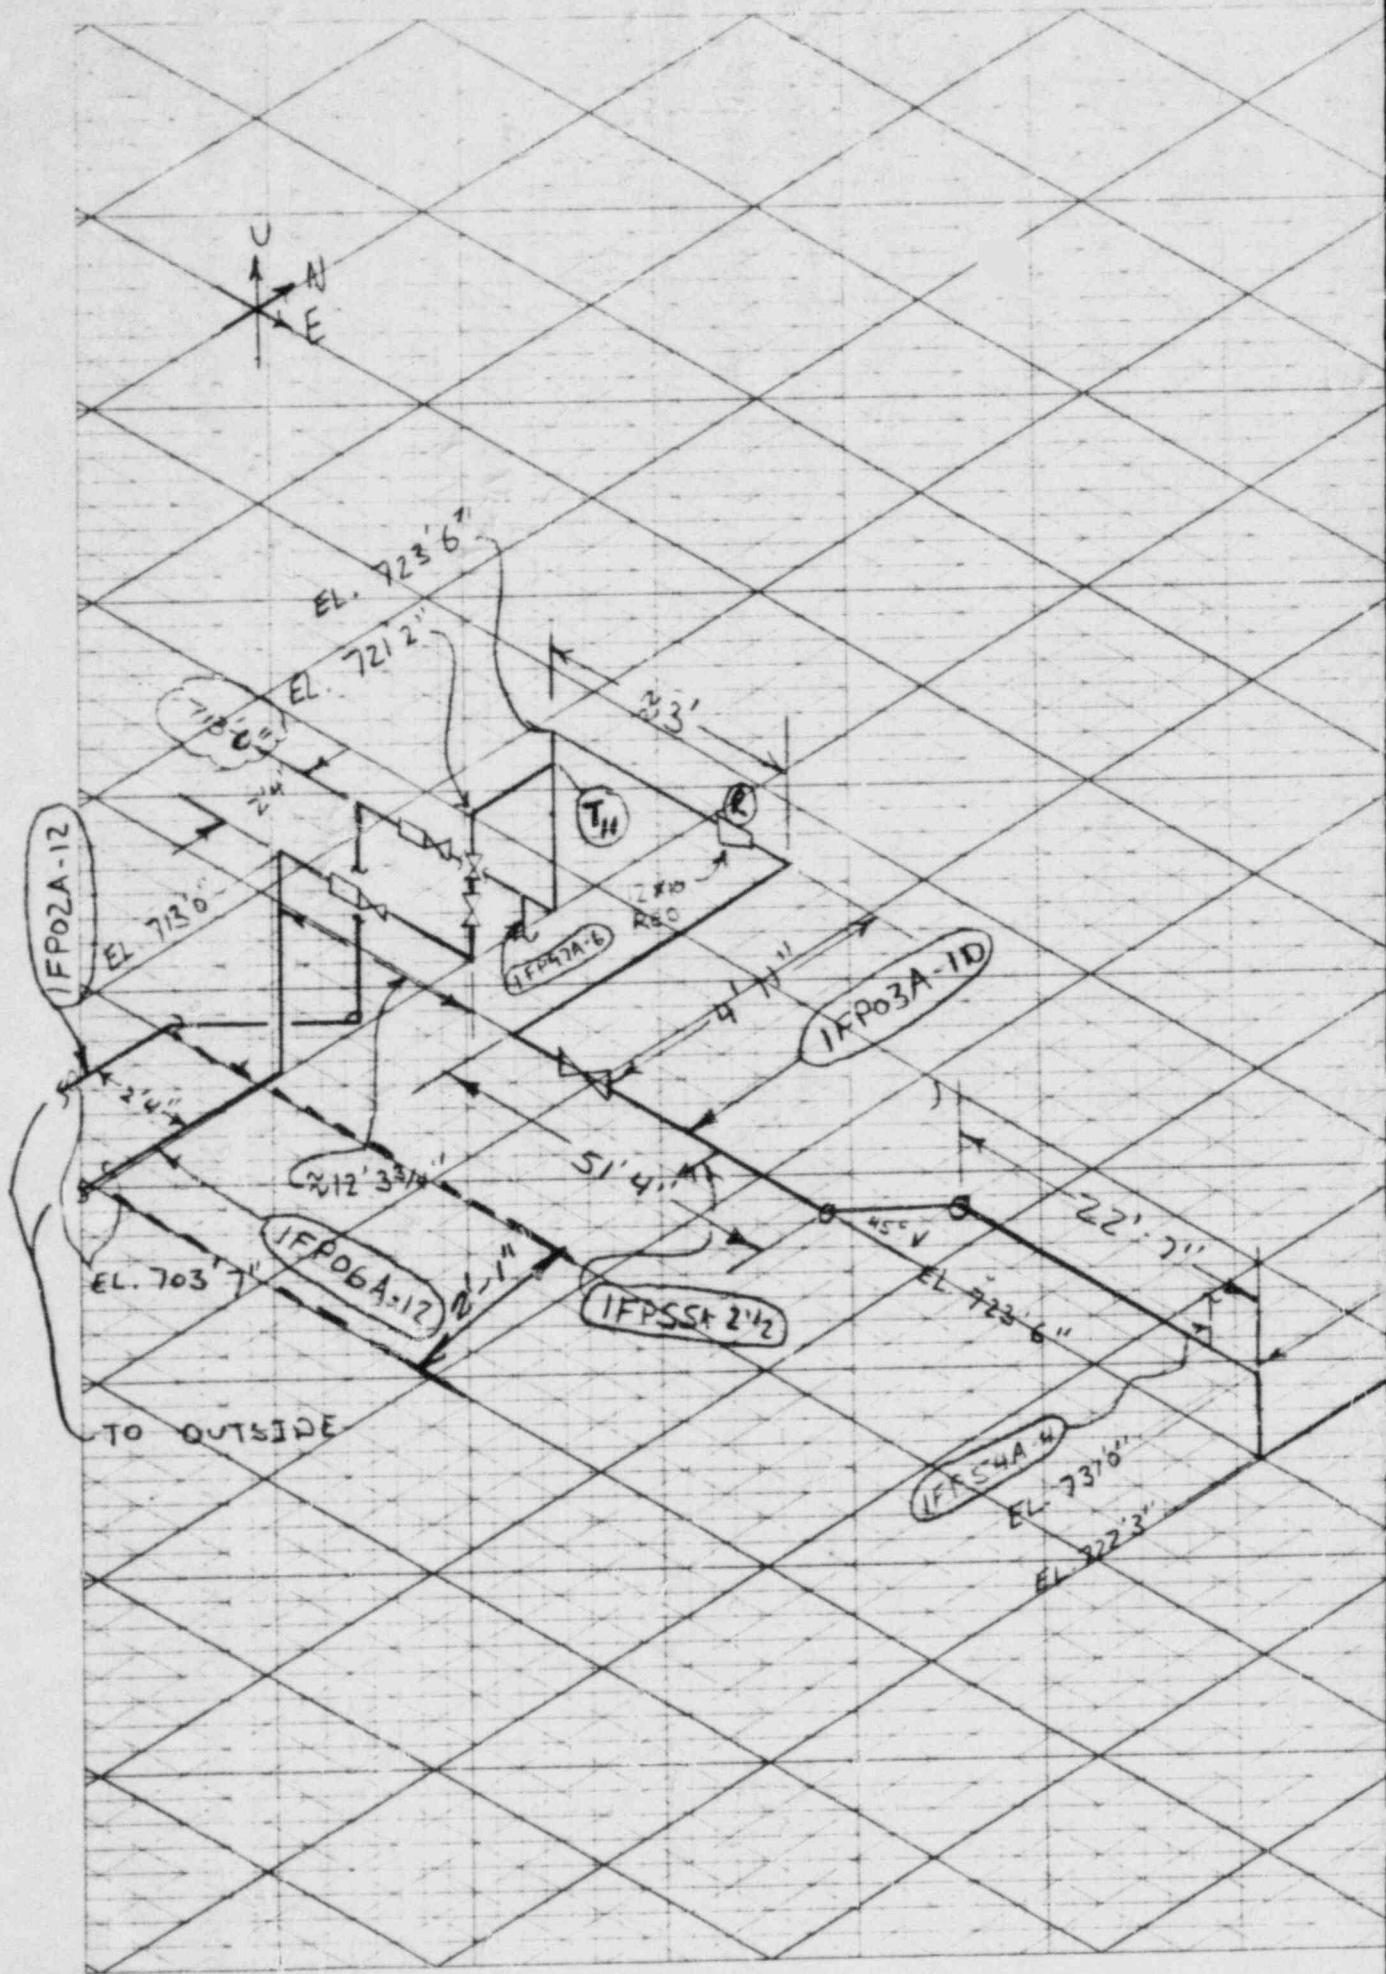

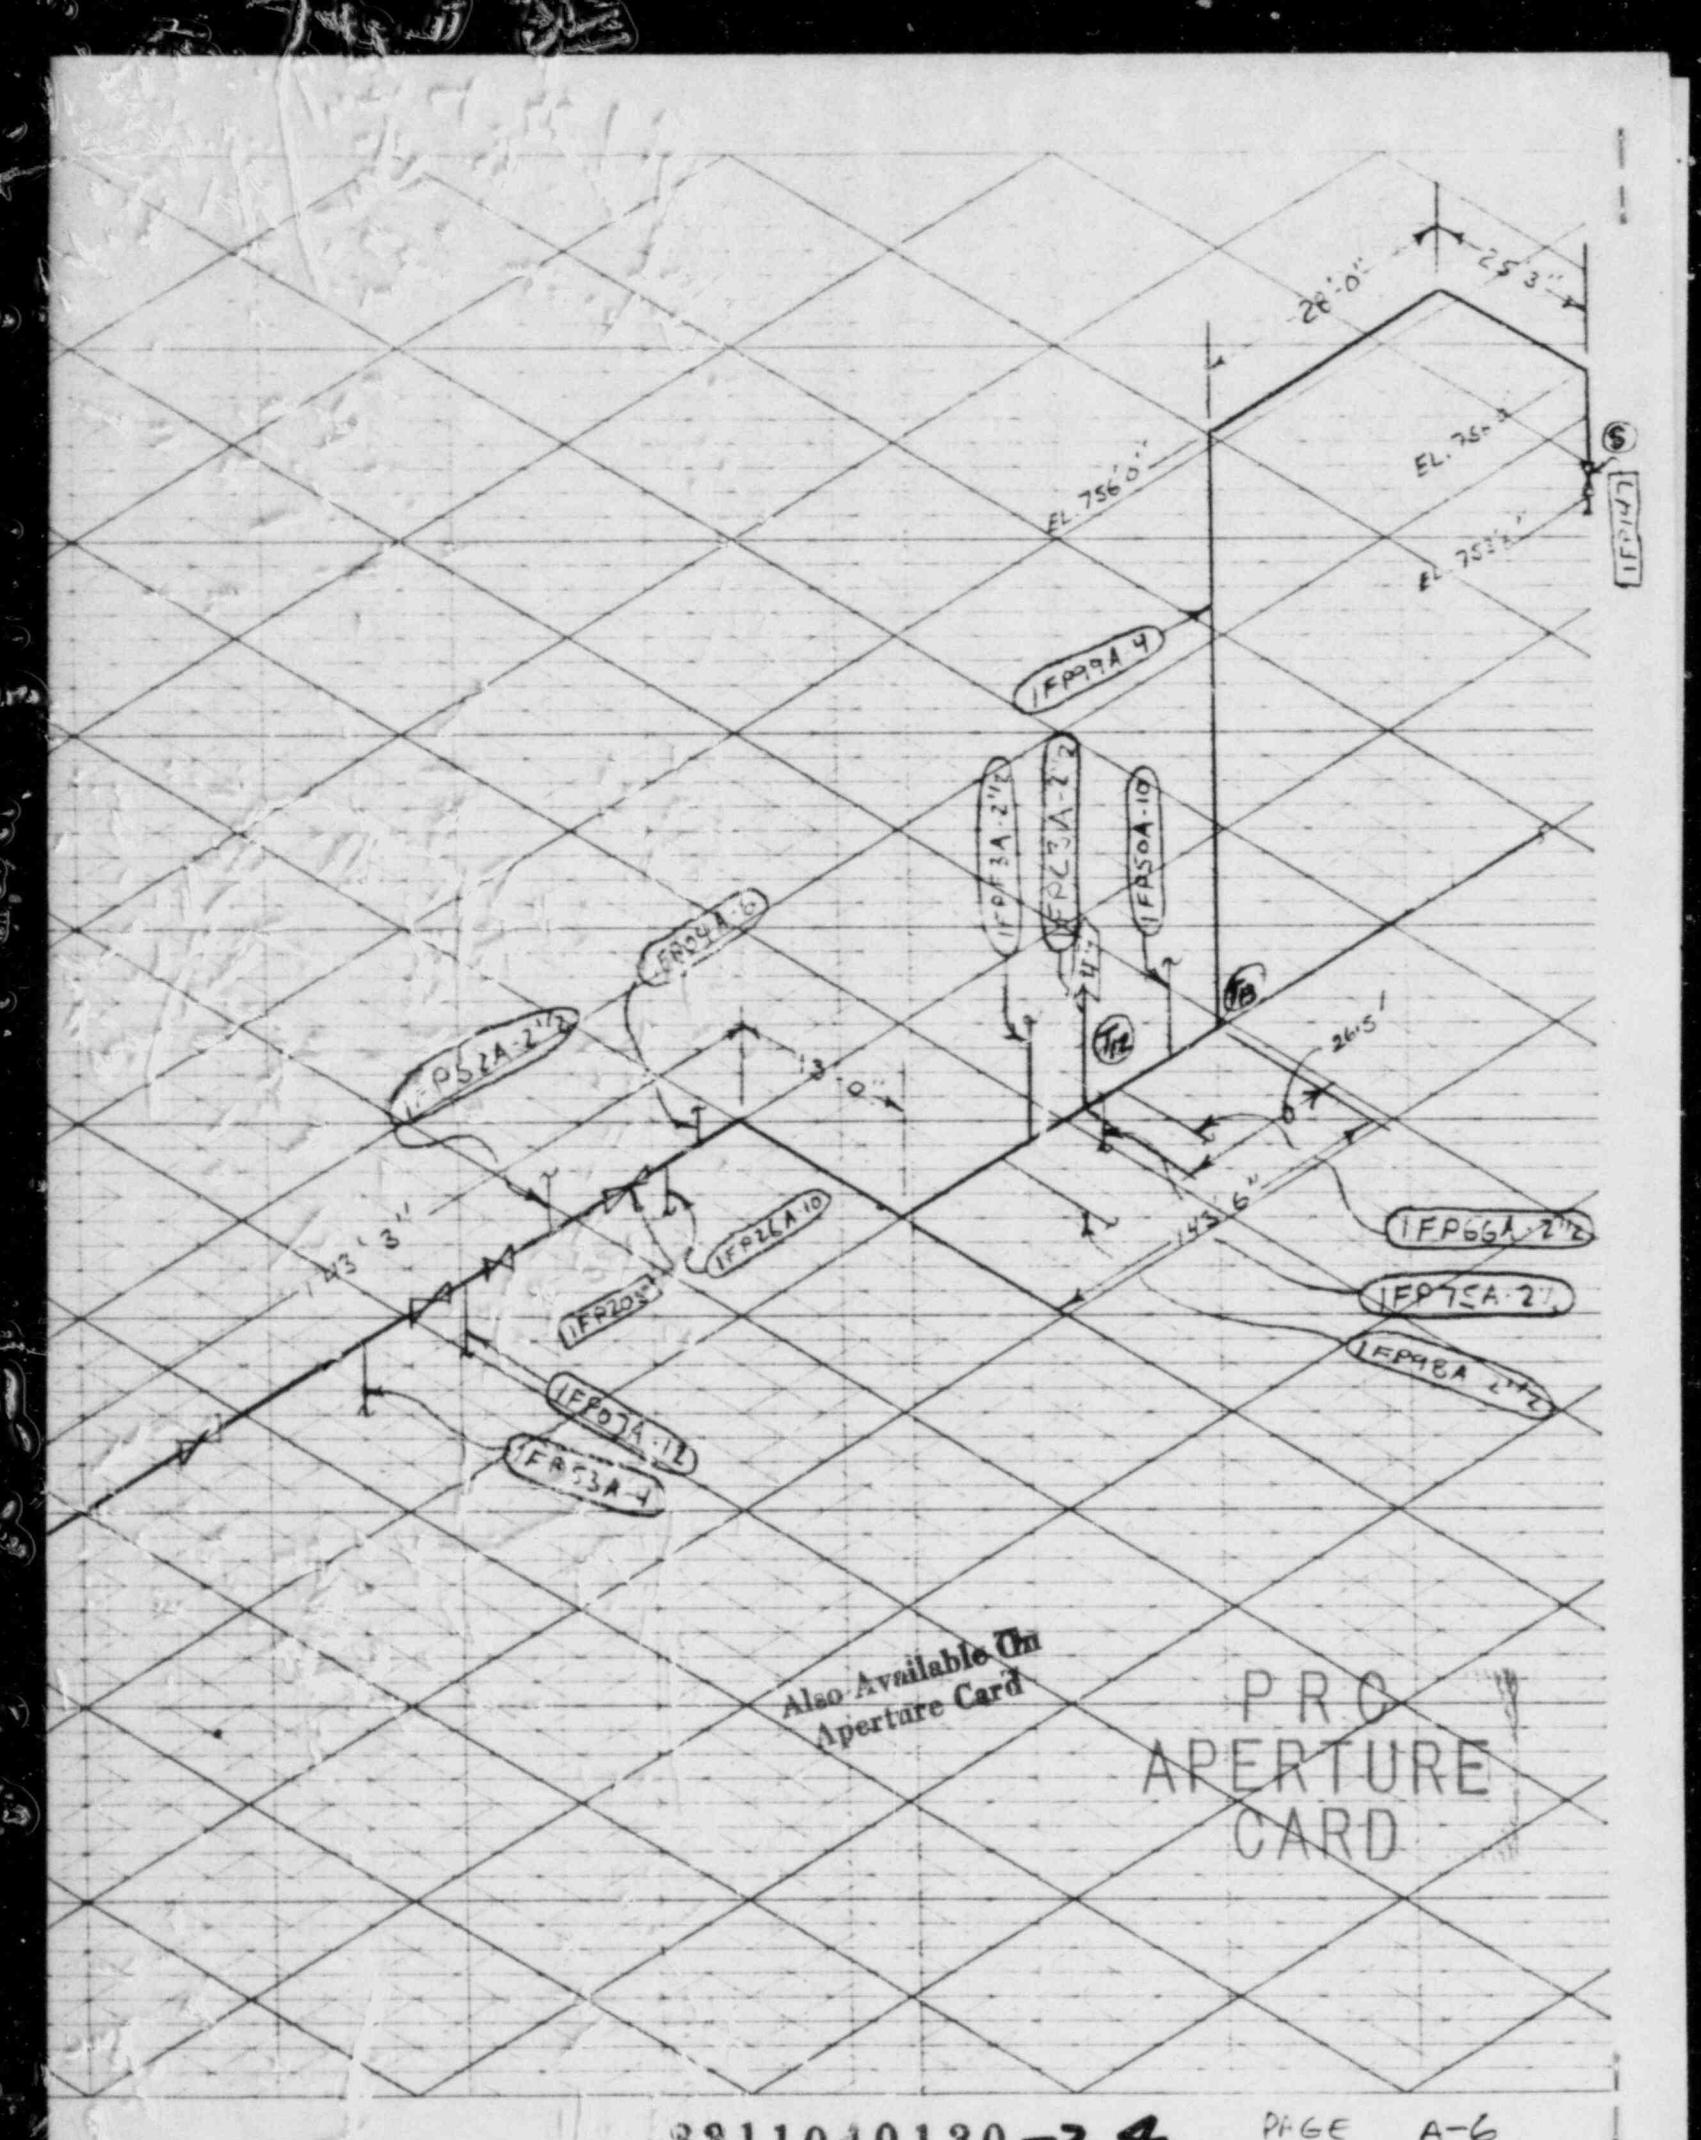

Form MES-2.16.1 Approved by H. A. Hargrove  
Dept. Rev. Orig. (2-1-73)

SYSTEM ISOMETRIC		B. PIPE
1. BASED ON P&ID DRAWING NUMBER M-	DATED _____	(a) PAGE
2. BASED ON PIPING DRAWING NUMBER M-	DATED _____	ITEM
		7 3 90° 7 4 45° 7 5 STI 7 6 STI 6 1a COM 6 4a SWI 6 5a DIS
<span style="font-size: 2em;">○</span> PROCESS FLOW DATA POINT		1. TOTA 2. D (I 3. EQUI 4. STRA 5. TOTA 6. MARG 7. TOTA 8. FLOW 9. VELO 10. Δ H 11. TOTA 12. SIZE 13. LINE SUM OF T
A. EQUIPMENT (HT. EXCH., FILTERS, STRAINERS, FLOW NOZZLES, ETC.)		$\Delta H_A$ (FT) = _____ SYSTEM: _____ <input type="checkbox"/> SAFETY-RELATED <input type="checkbox"/> NON-SAFETY-RELATED
REFERENCES: (a) MES-2.16 PIPING - PRESSURE DROP THROUGH FITTINGS, VALVES AND DISCONTINUITIES (b) MES-2.10.1, MES-2.10.2 OR MES-2.10.3 PIPE SIZE SELECTION (c) IF BACKING RINGS ARE OMITTED L/D CAN BE REDUCED BY 20% FOR ELBOWS		PREPARED BY _____ REVIEWED BY _____ APPROVED BY _____

## NG AND VALVES

## C. ENTRANCE/EXIT LOSSES AND CHANGES IN PIPE SECTION

DESCRIPTION (a)	(c) L/D	QUANTITY	L/D x QUANTITY OF FITTINGS FOR SIZES LISTED				(a) PAGE	DESCRIPTION	LINE SIZE	K	$v_a^2$ (FPS)	$\Delta H$ (FT.)
			20	12	60	20						
LONG RAD. ELBOW	20	2	40									
LONG RAD. ELBOW	12											
TEE (BRANCH FLOW)	60				1	60						
TEE (RUN FLOW)	20											
GLOBE VALVE	340											
CHECK VALVE	135	1	135									
SC GATE VALVE	13											
Hy. valves	40	1	40									
valves	0	1	0									
36 ← 36 FLOW THRU BRANCH	50				1	50						
← 12 ← 12 Flow thru branch	13		1	13	1	13						
L L/D		215	13	123								
INSIDE DIAMETER) (FT)	(FT)	1.9375	2.9167	2.9167								
V. STR. PIPE (1x2) (FT)	(FT)	416.6	37.9	358.8								
IGHT PIPE (FT)	(FT)	63.4	24.4	0								
L EQUIV. LENGTH (3+4) (FT)	(FT)	480	62.3	358.8								
IN (%)												
L (FT)	(FT)	480	62	360								
(LB/HR) OR (GPM)		583.33	1166.67	583.33								
CITY $v_a$ (b) (FPS)	(FPS)	440	389	195								
/100' (b) (FT/100 FT)		.005	.023	.011								
L $\Delta H$ (7x10) (FT)	(FT)	.022	.002	.004								
S SELECTED		24	36	36								
C NUMBER		2W1228	1A304A	1A304A								
TOTAL $\Delta H$ (ITEM 11) FOR ALL SIZES, $\Delta H_B$ (FT)= 0.125												

reduce to negligible effect due to very small velocities.

$$\Delta H = K \frac{v_a^2}{64.4}$$

## D. CONTROL VALVES

PRC  
APERTURE  
CARD  
Also Available On  
Aperture Card

$$\Delta H_D \text{ (FT)} =$$

$$\Delta H_F = \Delta H_A + \Delta H_B + \Delta H_C + \Delta H_D$$

$$\Delta H_F \text{ (FT)} = 0$$


		PROJECT: _____	MECHANICAL DEPARTMENT STANDARD		
		CLIENT: _____	JOB NO. _____	HEAD LOSS IN PIPING SEGMENT: _____	
		CALC. NO. _____			
DATE		FOR OFFICE USE ONLY - NOT TO BE SENT OUTSIDE OF SARGENT & LUNDY			REV. DATE
DATE					
DATE					

SARGENT & LUNDY

Page \_\_\_\_ of \_\_\_\_

REFERENCES:

- (a) MES-2.16 PIPING - PRESSURE DROP THROUGH FITTINGS,  
VALVES AND DISCONTINUITIES
- (b) MES-2.10.1, MES-2.10.2 OR MES-2.10.3 PIPE SIZE  
SELECTION
- (c) IF BACKING RINGS ARE OMITTED L/D CAN BE  
REDUCED BY 20% FOR ELBOWS

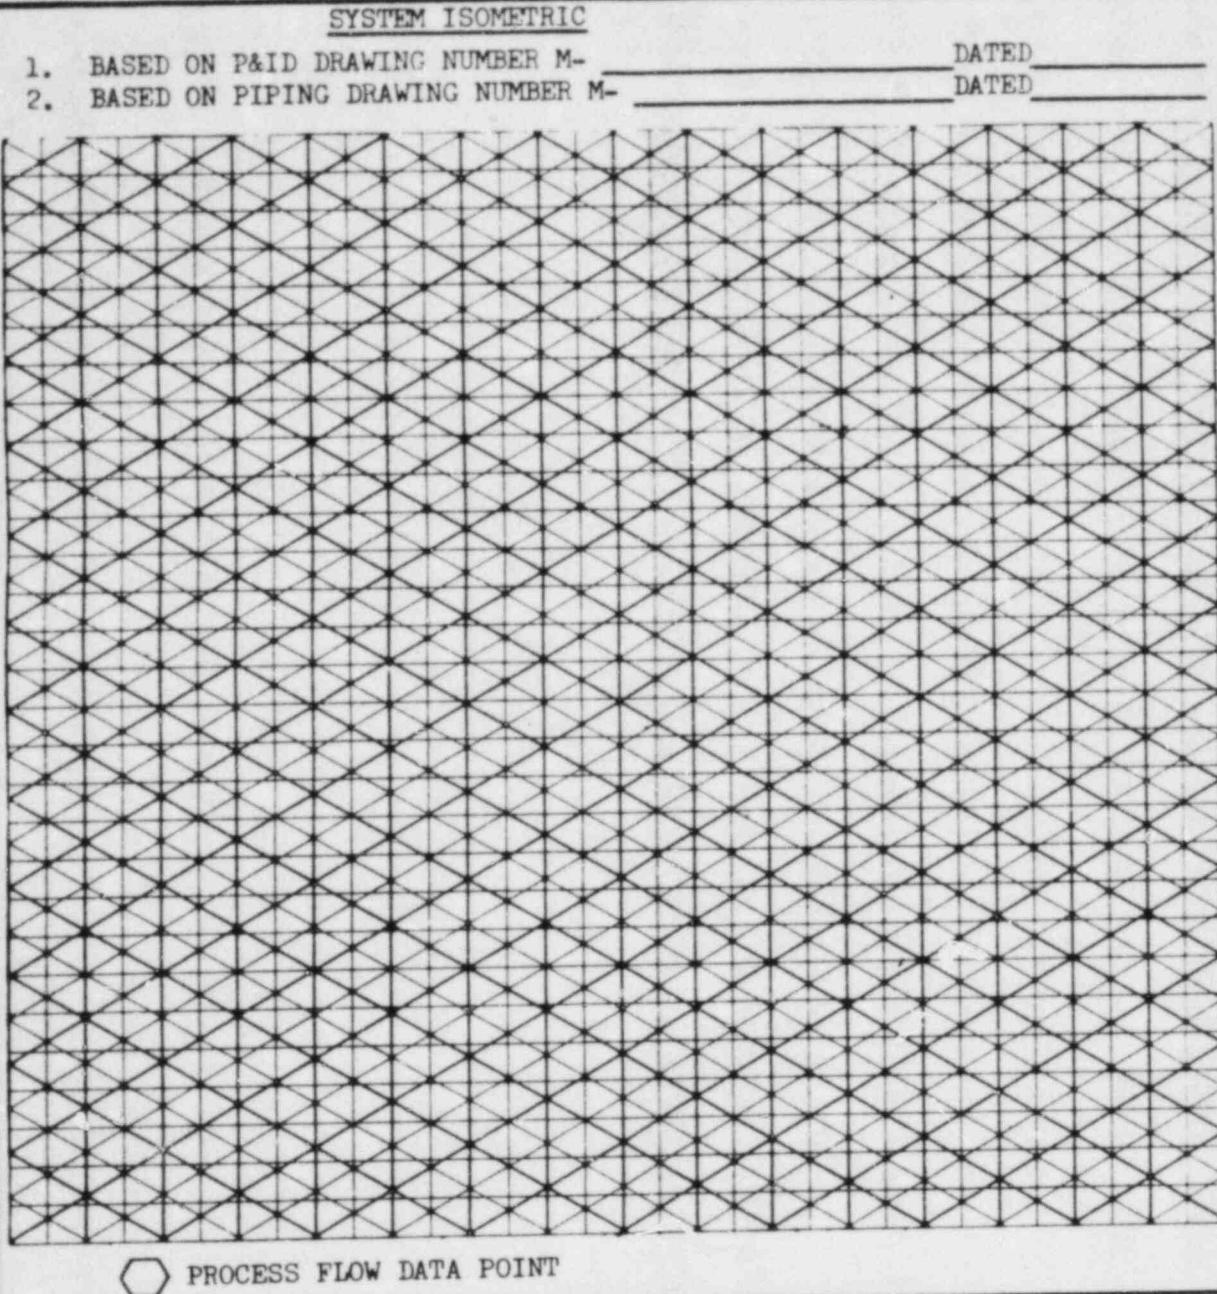

A. EQUIPMENT (HT. EXCH., FILTERS, STRAINERS, FLOW NOZZLES, ETC.)

STRAINER

$$\approx \Delta H = 1.0 \text{ ft}$$

*Strainer  
2 W.S. if  
conservative  
value of  $\Delta H$ .*

$$\Delta H_A (\text{FT}) = 1.0$$

B. PIPING	
(a)	PAGE
ITEM	D
7	3 90°
7	4 45°
7	5 STD.
7	6 STD.
6	1a CONV
6	4a SWIN
6	5a DISC
	EJ
	36
	2
1. TOTAL	
2. D (IN)	
3. EQUIV	
4. STRAI	
5. TOTAL	
6. MARGI	
7. TOTAL	
8. FLOW	
9. VELOC	
10. $\Delta H$	
11. TOTAL	
12. SIZES	
13. LINE	
SUM OF TO	

SYSTEM:

- SAFETY-RELATED
- NON-SAFETY-RELATED

PREPARED BY

REVIEWED BY

APPROVED BY

G AND VALVES

DESCRIPTION (a)	(c) L/D	QUANTITY L/D x QUANTITY OF FITTINGS FOR SIZES LISTED				(a) PAGE	DESCRIPTION	LINE SIZE	K	$v_a^2$ (FPS)	$\Delta H$ (FT.)
		$T_2 - T_3$	$T_2$	$T_3 - T_4$	$T_3$						
LONG RAD. ELBOW	20		20'								
LONG RAD. ELBOW	12			12'							
TEE (BRANCH FLOW)	60		168					160			
TEE (RUN FLOW)	20										
GLOBE VALVE	340										
CHECK VALVE	135							135			
GATE VALVE	13							13			
WELL Valve	40		40	40							
X+2' RED											$\Delta H_C$ (FT)
-42 Flangeless Branch	39							39			
42 Flangeless Branch	39							39			
L/D		140	52	6	307						
SIDE DIAMETER) (FT)		2.917	2.917	2.412	1.0						
STR. PIPE (1x2) (FT)		15	151.7	20.32	307						
GHT PIPE (FT)		26.25	8	5.5	54.5						
EQUIV. LENGTH (3+4) (FT)		376.3	159.7	26.0	361.0						
N (%)											
(FT)		376	160	260	362						
(LB/HR) OR (GPM)		1750	1750	1750	1750						
ITY $v_a$ (b) (FPS)		544	544	451	4,964						
100' (b) (FT/100 FT)		.006	.006	.073	.11607						
$\Delta H$ (7x10) (FT)		023	-010	0	0.2						
SELECTED		36"	36	42	12"						
NUMBER		2WS028	2WS032	2WS038	2WS04A OFF01A						
TOTAL $\Delta H$ (ITEM 11) FOR ALL SIZES, $\Delta H_B$ (FT)=		4.233									

C. ENTRANCE/EXIT LOSSES AND  
CHANGES IN PIPE SECTION

$$\Delta H = K \frac{v_a^2}{64.4}$$

36x42 RED  $\Delta H=0$   
DUE TO small velocity

## D. CONTROL VALVES

Also Available On  
Aperture CardPRC  
APERTURE  
CARD

$$\Delta H_F = \Delta H_A + \Delta H_B + \Delta H_C + \Delta H_D$$

1


$$\Delta H_F (\text{FT}) \approx 52 \text{ ft}$$

PROJECT: _____		MECHANICAL DEPARTMENT STANDARD			
CLIENT: _____		HEAD LOSS IN PIPING SEGMENT: _____			
CALC. NO. _____					
DATE		FOR OFFICE USE ONLY - NOT TO BE SENT OUTSIDE OF SARGENT & LUNDY			
DATE					
DATE					
REV. DATE					
Page _____ of _____					

SARGENT &amp; LUNDY

## SYSTEM ISOMETRIC

1. BASED ON P&ID DRAWING NUMBER M- \_\_\_\_\_ DATED \_\_\_\_\_  
2. BASED ON PIPING DRAWING NUMBER M- \_\_\_\_\_ DATED \_\_\_\_\_

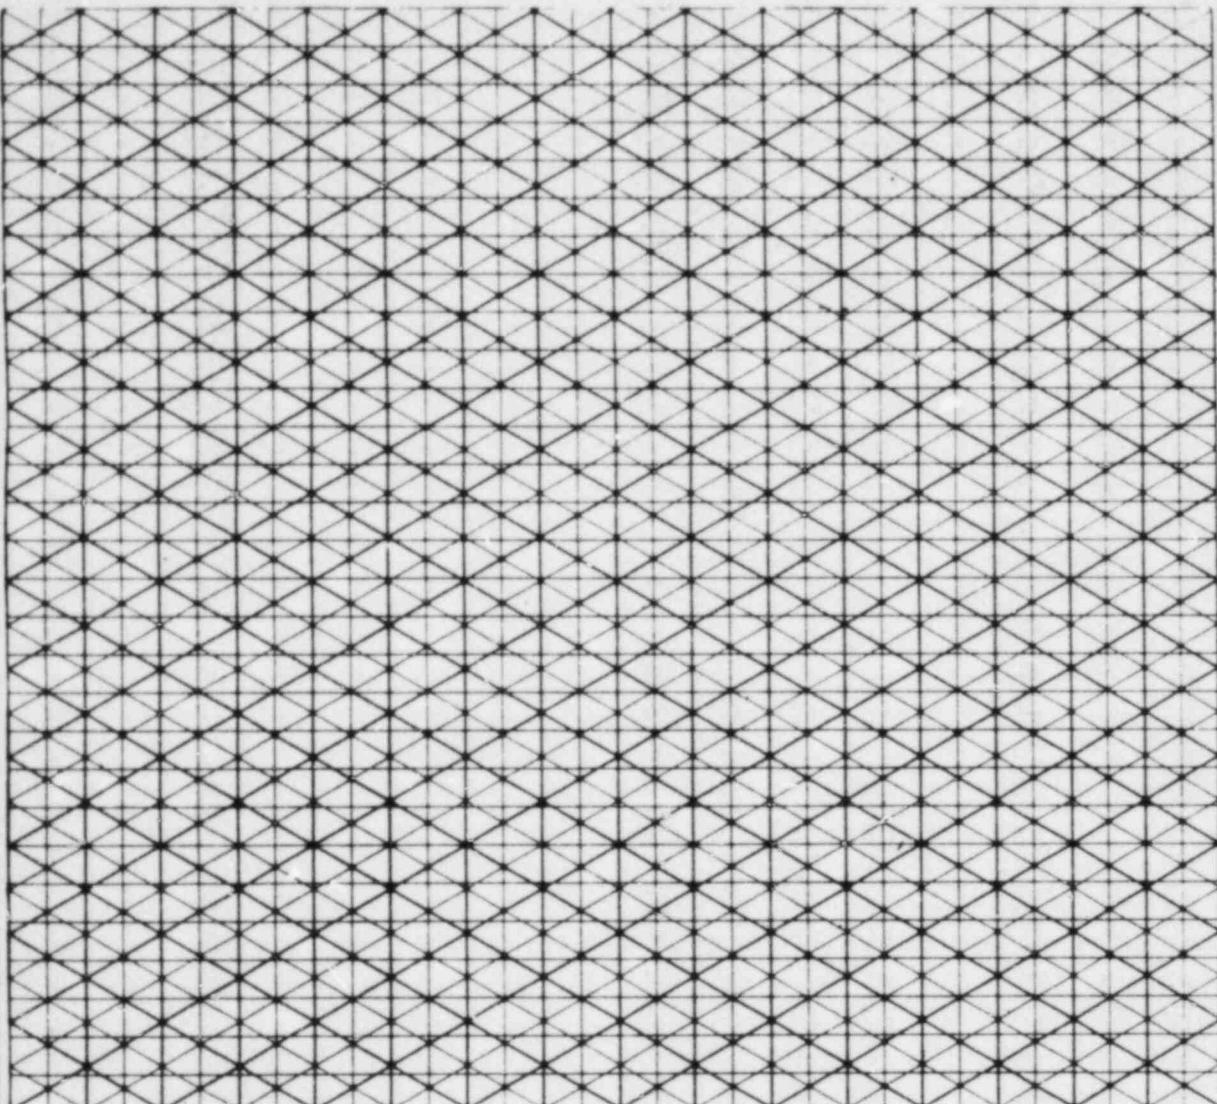

 PROCESS FLOW DATA POINT

- A. EQUIPMENT (HT. EXCH., FILTERS, STRAINERS, FLOW NOZZLES, ETC.)

$$\Delta H_A(FT) =$$

## **REFERENCES:**

- (a) MES-2.16 PIPING - PRESSURE DROP THROUGH FITTINGS,  
VALVES AND DISCONTINUITIES

(b) MES-2.10.1, MES-2.10.2 OR MES-2.10.3 PIPE SIZE  
SELECTION

(c) IF BACKING RINGS ARE OMITTED L/D CAN BE  
REDUCED BY 20% FOR ELBOWS

### SYSTEM:-

SAFETY-RELATED

NON-SAFETY-RELATED

PREPARED BY

**REVIEWED BY**

APPROVED BY

AND VALVES

C. ENTRANCE/EXIT LOSSES AND  
CHANGES IN PIPE SECTION

DESCRIPTION (a)	(c) L/D	QUANTITY L/D x QUANTITY OF FITTINGS FOR SIZES LISTED				(a) PAGE	DESCRIPTION	LINE SIZE	K	$v_a^2$ (FPS)	$\Delta H$ (FT.)
		T <sub>1</sub> -T <sub>2</sub>	T <sub>2</sub> -T <sub>3</sub>	T <sub>3</sub> -T <sub>4</sub>	T <sub>4</sub> -T <sub>5</sub>						
LONG RAD. ELBOW	20		3	60							
LONG RAD. ELBOW	12	4	48	2	24						
TEE (BRANCH FLOW)	60			1	60						
TEE (RUN FLOW)	20										
GLOBE VALVE	340										
CHECK VALVE	135										
GATE VALVE	13										
WELL Valve	40	3	120		6	240	2	80			
1/4 Flow thru Run	18	4	72	2	36	4	5				$\Delta H_C$ (FT)
1/4 Flow thru Run	9			1	9	3	27				
1/4 Flow thru Branch	57						1	57			
L/D		240	189	363	237						
PIPE DIAMETER (FT)		1.1042	1.1042	1.1042	1.0						
STR. PIPE (1x2) (FT)		265	265.7	400.8	237						
ET PIPE (FT)		123	528	457	870						
EQUIV. LENGTH (3+4) (FT)		389	736.7	857.8	1107						
(%)											
	(FT)	348	737	858	1107						
(LB/HR) OR (GPM)		1250	1500	1750	1750						
ITY $v_a$ (b) (FPS)		2.91	3.49	4.07	4.07						
00' (b) (FT/100 FT)		.395	.542	.723	.160						
$\Delta H$ (7x10) (FT)		1.49	3.99	6.20	12.85						
SELECTED		14"	14"	14"	12"						
NUMBER		OFF02A	OFF02A	OFF02A	ZFP02A						
ALL $\Delta H$ (ITEM 11) FOR ALL SIZES, $\Delta H_B$ (FT)= 24.5											

$$\Delta H = K \frac{v_a^2}{64.4}$$

## D. CONTROL VALVES

APERTURE  
CARD

Also Available On  
Aperture Card

$$\Delta H_D$$
 (FT) =

$$\Delta H_F = \Delta H_A + \Delta H_B + \Delta H_C + \Delta H_D$$

$$\Delta H_F$$
 (FT) = 24.5 Ft.

PROJECT:

MECHANICAL DEPARTMENT STANDARD

CLIENT: \_\_\_\_\_ JOB NO. \_\_\_\_\_

HEAD LOSS IN PIPING SEGMENT: \_\_\_\_\_

CALC. NO.

TE  
TE  
TEFOR OFFICE USE ONLY - NOT TO BE  
SENT OUTSIDE OF SARGENT & LUNDY

REV DATE

SARGENT &amp; LUNDY

Page of


8311040130-27

PAGE A-9

## SYSTEM ISOMETRIC

1. BASED ON P&ID DRAWING NUMBER M- \_\_\_\_\_  
 2. BASED ON PIPING DRAWING NUMBER M- \_\_\_\_\_

DATED \_\_\_\_\_  
 DATED \_\_\_\_\_

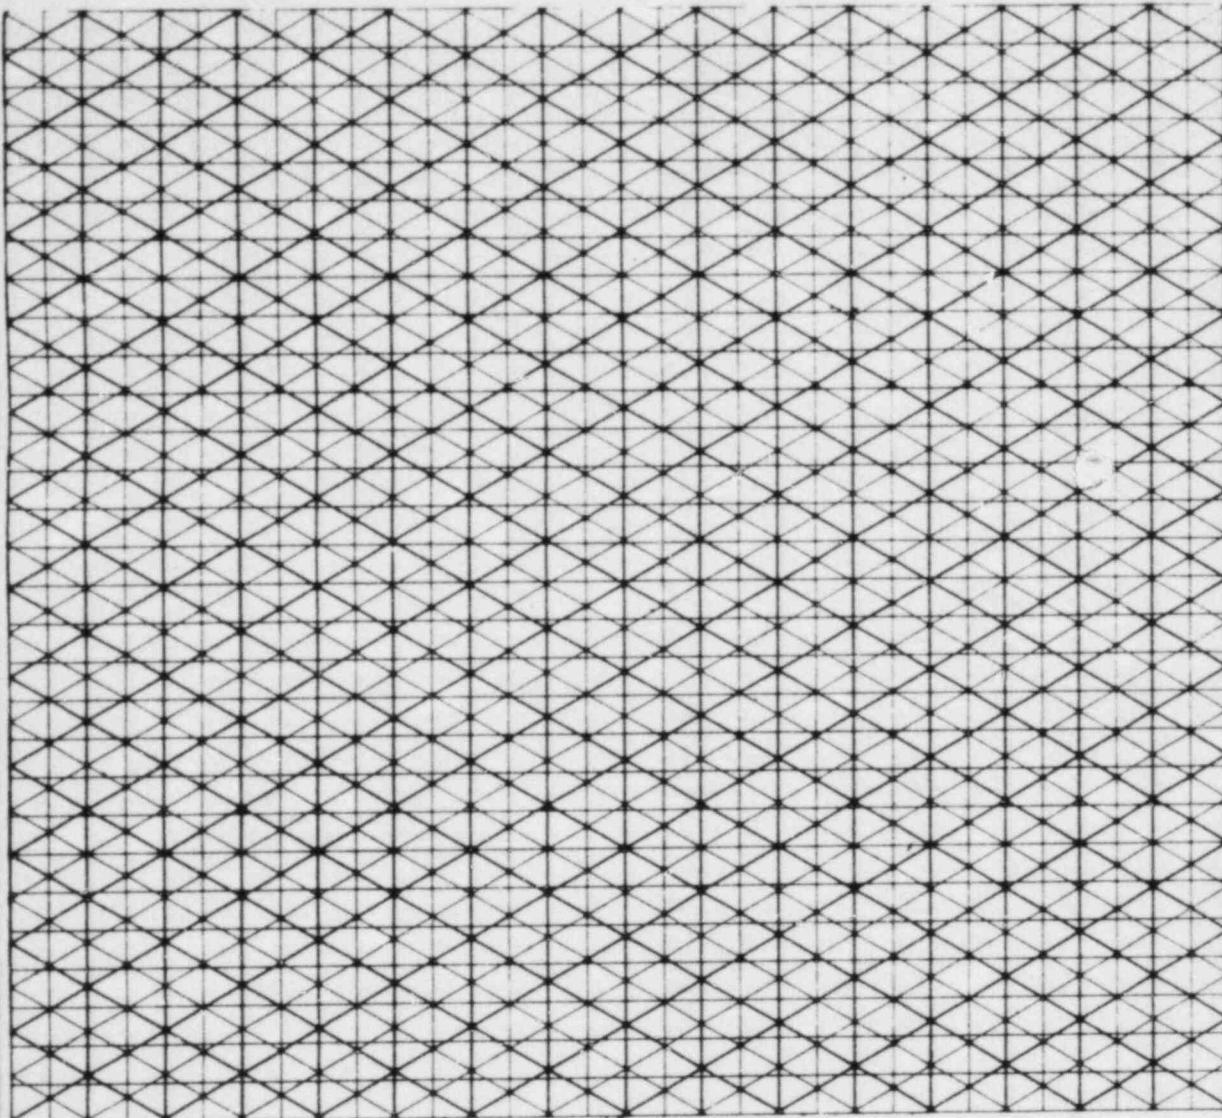

PROCESS FLOW DATA POINT

Form MES-2.16.1 Approved by \_\_\_\_\_  
 Dept. \_\_\_\_\_  
 Rev. Orig. (2-1-73)

## A. EQUIPMENT (HT. EXCH., FILTERS, STRAINERS, FLOW NOZZLES, ETC.)

STRAINERS "Y" TYPE  
 ASSUME PRESSURE DROP =  $\geq (5) \ell$

$$\Delta H_A (\text{FT}) = 1.0$$

## REFERENCES:

- (a) MES-2.16 PIPING - PRESSURE DROP THROUGH FITTINGS,  
VALVES AND DISCONTINUITIES
- (b) MES-2.10.1, MES-2.10.2 OR MES-2.10.3 PIPE SIZE  
SELECTION
- (c) IF BACKING RINGS ARE OMITTED L/D CAN BE  
REDUCED BY 20% FOR ELBOWS

## SYSTEM:

- SAFETY-RELATED  
 NON-SAFETY-RELATED

PREPARED BY	D
REVIEWED BY	D
APPROVED BY	D

ITEM	L
7	3 90°
7	4 45°
7	5 STD.
7	6 STD.
6	1a CONV.
6	4a SWIM.
6	5a DISC.
	1
	2
	3
1. TOTAL
2. D (IN)
3. EQUIV.
4. STRAI.
5. TOTAL
6. MARGI.
7. TOTAL
8. FLOW
9. VELOC.
10.  $\Delta H$ /
11. TOTAL
12. SIZES
13. LINE
- SUM OF TO

(a)  
PAGE

## G AND VALVES

## C. ENTRANCE/EXIT LOSSES AND CHANGES IN PIPE SECTION

DESCRIPTION (a)	(c) L/D	QUANTITY			L/D x QUANTITY OF FITTINGS FOR SIZES LISTED			(a) PAGE	DESCRIPTION	LINE SIZE	K	$v_a^2$ (FPS)	$\Delta H$ (FT.)
		$T_{10} \rightarrow T_1$	$T_1 \rightarrow T_2$	$T_2 \rightarrow T_3$									
LONG RAD. ELBOW	20	5	100	6	120								
LONG RAD. ELBOW	12	9	108	10	120								
TEE (BRANCH FLOW)	60			1	60								
TEE (RUN FLOW)	20		120										
GLOBE VALVE	340												
CHECK VALVE	135												
GATE VALVE	13	1	13	3	39								
flow thru run	10	1	10	2	20								
Butterfly valve	40	1	40	1	40								
flow thru gear	57	1	57	1	57								
flow thru run	18				36								
L/D		348	456	76									
SIDE DIAMETER) (FT)		1.0	1.0	1.042									
STR. PIPE (1x2) (FT)		348	456	92.9									
GHT PIPE (FT)		218	672.6	4.1									
EQUIV. LENGTH (3+4) (FT)		626	729.6	88									
N (%)													
		626	730	88									
		625	625	625									
ITY $v_a$ (b) (FPS)		1.7729	1.7729	1.45									
100' (b) (FT/100 FT)		173	173	107									
$\Delta H$ (7x10) (FT)		1.08	1.26	1.07									
SELECTED		12	12	14									
NUMBER		1FPL7A	1FP06A	1FPL7A									
TOTAL $\Delta H$ (ITEM 11) FOR ALL SIZES, $\Delta H_B$ (FT) = $\frac{1.07 + 1.26 + 1.07}{2}$ = 1.22													

## D. CONTROL VALVES

PRO  
APERTURE  
CARD

Also Available On  
Aperture Card

$$\Delta H_D \text{ (FT)} =$$


$$\Delta H_F = \Delta H_A + \Delta H_B + \Delta H_C + \Delta H_D$$

$$\Delta H_F \text{ (FT)} = 2.3$$

PROJECT:		MECHANICAL DEPARTMENT STANDARD	
CLIENT: _____ JOB NO. _____		HEAD LOSS IN PIPING SEGMENT: _____	
CALC. NO.			
DATE		REV.	DATE
DATE			
DATE			
FOR OFFICE USE ONLY - NOT TO BE SENT OUTSIDE OF SARGENT & LUNDY		SARGENT & LUNDY JOURNALISTS	
		Page	of

## SYSTEM ISOMETRIC

1. BASED ON P&ID DRAWING NUMBER M- \_\_\_\_\_ DATED \_\_\_\_\_  
2. BASED ON PIPING DRAWING NUMBER M- \_\_\_\_\_ DATED \_\_\_\_\_

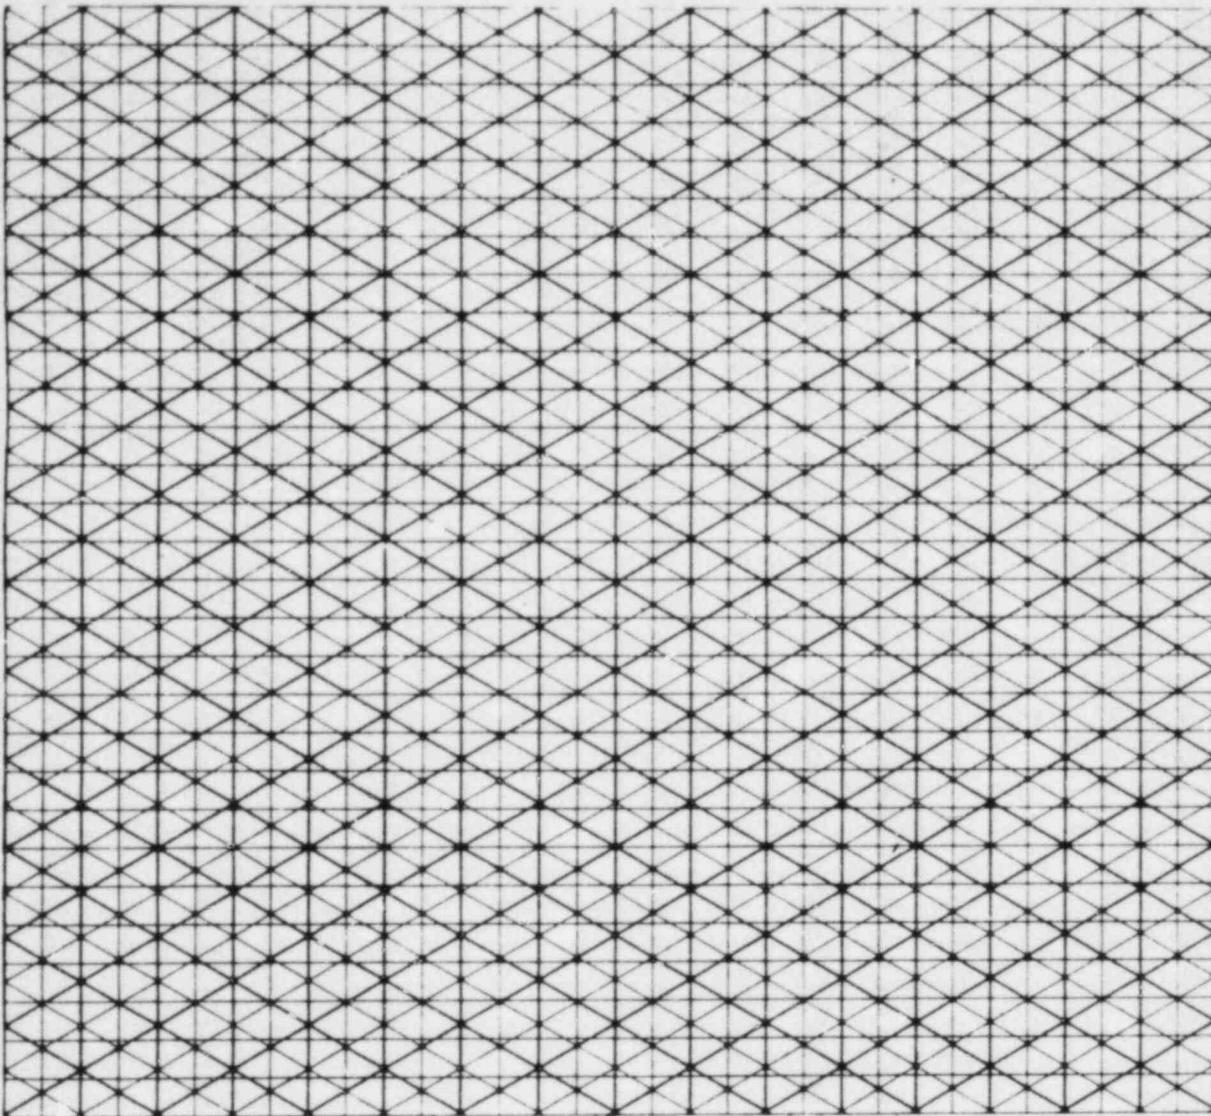

 PROCESS FLOW DATA POINT

#### A. EQUIPMENT (HT. EXCH., FILTERS, STRAINERS, FLOW NOZZLES, ETC.)

$$\Delta H_A(FT) =$$

Form MES-2.16.1 Approved by  
Rev. Orig. (2-1-73)

#### **REFERENCES:**

- ERENCES:  
(a) MES-2.16 PIPING - PRESSURE DROP THROUGH FITTINGS,  
VALVES AND DISCONTINUITIES  
(b) MES-2.10.1, MES-2.10.2 OR MES-2.10.3 PIPE SIZE  
SELECTION  
(c) IF BACKING RINGS ARE OMITTED L/D CAN BE  
REDUCED BY 20% FOR ELBOWS

### SYSTEM:

SAFETY-RELATED

NON-SAFETY-RELATED

PREPARED BY

REVIEWED BY

APPROVED BY

## C AND VALVES

## C. ENTRANCE/EXIT LOSSES AND CHANGES IN PIPE SECTION

DESCRIPTION (a)	(c) L/D	QUANTITY L/D x QUANTITY OF FITTINGS FOR SIZES LISTED				(a) PAGE	DESCRIPTION	LINE SIZE	K	$v_a^2$ (FPS)	$\Delta H$ (FT.)
		T <sub>1</sub> -H <sub>1</sub>	T <sub>2</sub> -H <sub>2</sub>	T <sub>3</sub> -T <sub>8</sub>	T <sub>8</sub> -H <sub>2</sub>						
LONG RAD. ELBOW	20	5	100	4	80						
LONG RAD. ELBOW	12	1	12								
TEE (BRANCH FLOW)	60										
TEE (RUN FLOW)	20										
GLOBE VALVE	340										
CHECK VALVE	135										
GATE VALVE	13	1	13	1	13						
10 Flow + 10 Branch	375	1	375								
14 Flow + 14 Branch	44		1	44							
12 Flow + 12 Branch	45				1	45					
Valve	40			1	40						
Flow + 14 Branch	56			1	56						
L/D		162.5	137	96	58						
PIPE DIAMETER (FT)		.194	.5054	1.0	.5054						
STR. PIPE (1x2) (FT)		31.5	59.2	96	29.3						
HGT PIPE (FT)		68	170	95	30						
EQUIV. LENGTH (3+4) (FT)		700	239.2	191	79.3						
(%)											
(FT)		100	239.2	191	79.3						
(LB/HR) OR (GPM)		125	125	125	125						
TY $v_a$ (b) (FPS)		9.5	1.40	<.57	1.40						
OO'(b) (FT/100 FT)		26.5	.24	<.021	.24						
$\Delta H$ (7x10) (FT)		26.5	.574	<.04	.19						
SELECTED		2½"	6"	12"	6"						
NUMBER		1FFL3A	OFP10A	OFP09B	OFP07A						
ALL $\Delta H$ (ITEM 11) FOR ALL SIZES, $\Delta H_B$ (FT)=											

$$\Delta H_C = K \frac{v_a^2}{64.4}$$

PRC  
APERTURE  
CARD

## D. CONTROL VALVES

Also Available On  
Aperture Card


$$\Delta H_D (FT) =$$

$$\Delta H_F = \Delta H_A + \Delta H_B + \Delta H_C + \Delta H_D$$

$$\Delta H_F (FT) =$$

PROJECT: CLIENT: _____ JOB NO. _____ CALC. NO. _____		MECHANICAL DEPARTMENT STANDARD			
		HEAD LOSS IN PIPING SEGMENT: _____			
TE	TE	FOR OFFICE USE ONLY - NOT TO BE SENT OUTSIDE OF SARGENT & LUNDY	REV.	DATE	
TE	TE		SARGENT & LUNDY ENGINEERS		
TE	TE		Page	of	

*H. H. Dugan*  
Approved by \_\_\_\_\_  
Dept. No. \_\_\_\_\_  
Form MES-2.16.1 Approved by \_\_\_\_\_  
Rev. Orig. (2-1-73)

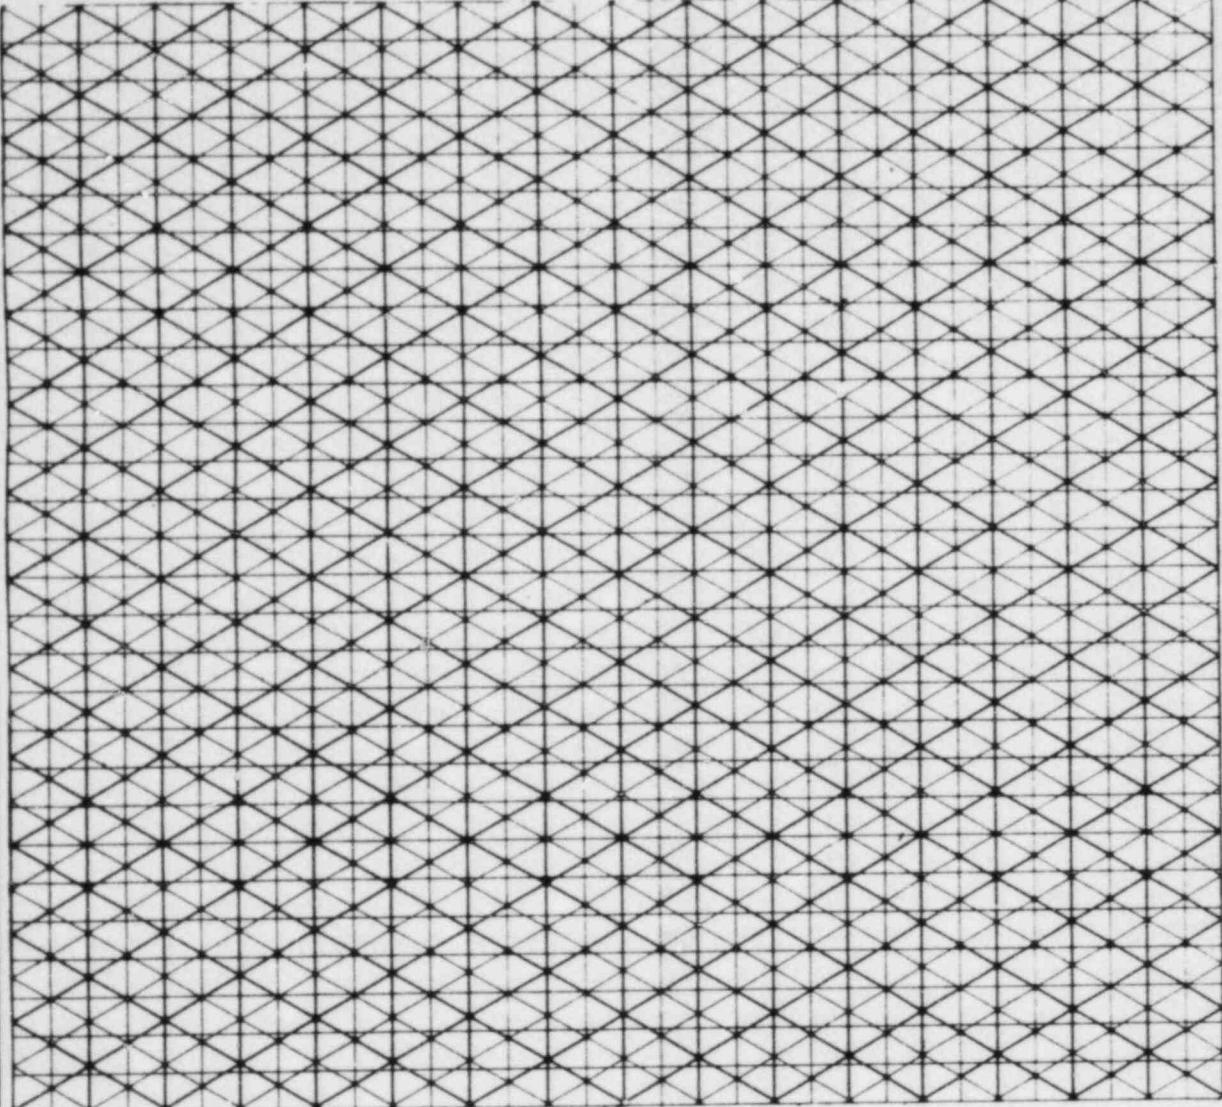SYSTEM ISOMETRIC		B. PIPING
1. BASED ON P&ID DRAWING NUMBER M-	DATED _____	(a) PAGE
2. BASED ON PIPING DRAWING NUMBER M-	DATED _____	ITEM
 <span style="border: 1px solid black; padding: 2px;">○</span> PROCESS FLOW DATA POINT		1. 3 90°
		2. 4 45°
		3. STD.
		4. STD.
		5. CONV.
		6. SWIN.
		7. DISC.
		8. FLO.
		9. ID.
		10. L.
		11. F.
		12. FC.
		13. FLO.
		14. R.
		1. TOTAL
		2. D (IN)
		3. EQUIV.
		4. STRAI.
		5. TOTAL
		6. MARGI.
		7. TOTAL
		8. FLOW
		9. VELOC.
		10. Δ H.
		11. TOTAL
		12. SIZES
		13. LINE
		SUM OF TO
A. EQUIPMENT (HT. EXCH., FILTERS, STRAINERS, FLOW NOZZLES, ETC.)		Δ H <sub>A</sub> (FT) = _____
REFERENCES:		SYSTEM: _____
(a) MES-2.16 PIPING - PRESSURE DROP THROUGH FITTINGS, VALVES AND DISCONTINUITIES		<input type="checkbox"/> SAFETY-RELATED
(b) MES-2.10.1, MES-2.10.2 OR MES-2.10.3 PIPE SIZE SELECTION		<input type="checkbox"/> NON-SAFETY-RELATED
(c) IF BACKING RINGS ARE OMITTED L/D CAN BE REDUCED BY 20% FOR ELBOWS		PREPARED BY _____
		REVIEWED BY _____
		APPROVED BY _____


## MECHANICAL DEPARTMENT STANDARD

### **HEAD LOSS IN PIPING SEGMENT:**

	PROJECT: _____	MECHANICAL DEPARTMENT STANDARD
	CLIENT: _____ JOB NO. _____	HEAD LOSS IN PIPING SEGMENT: _____
	CALC. NO.	
DATE		
DATE		
DATE		
FOR OFFICE USE ONLY - NOT TO BE SENT OUTSIDE OF SARGENT & LUNDY		 <p>REV. DATE</p> <p>Page of</p>

### **SYSTEM ISOMETRIC**

1. BASED ON P&ID DRAWING NUMBER M- \_\_\_\_\_ DATED \_\_\_\_\_  
2. BASED ON PIPING DRAWING NUMBER M- \_\_\_\_\_ DATED \_\_\_\_\_

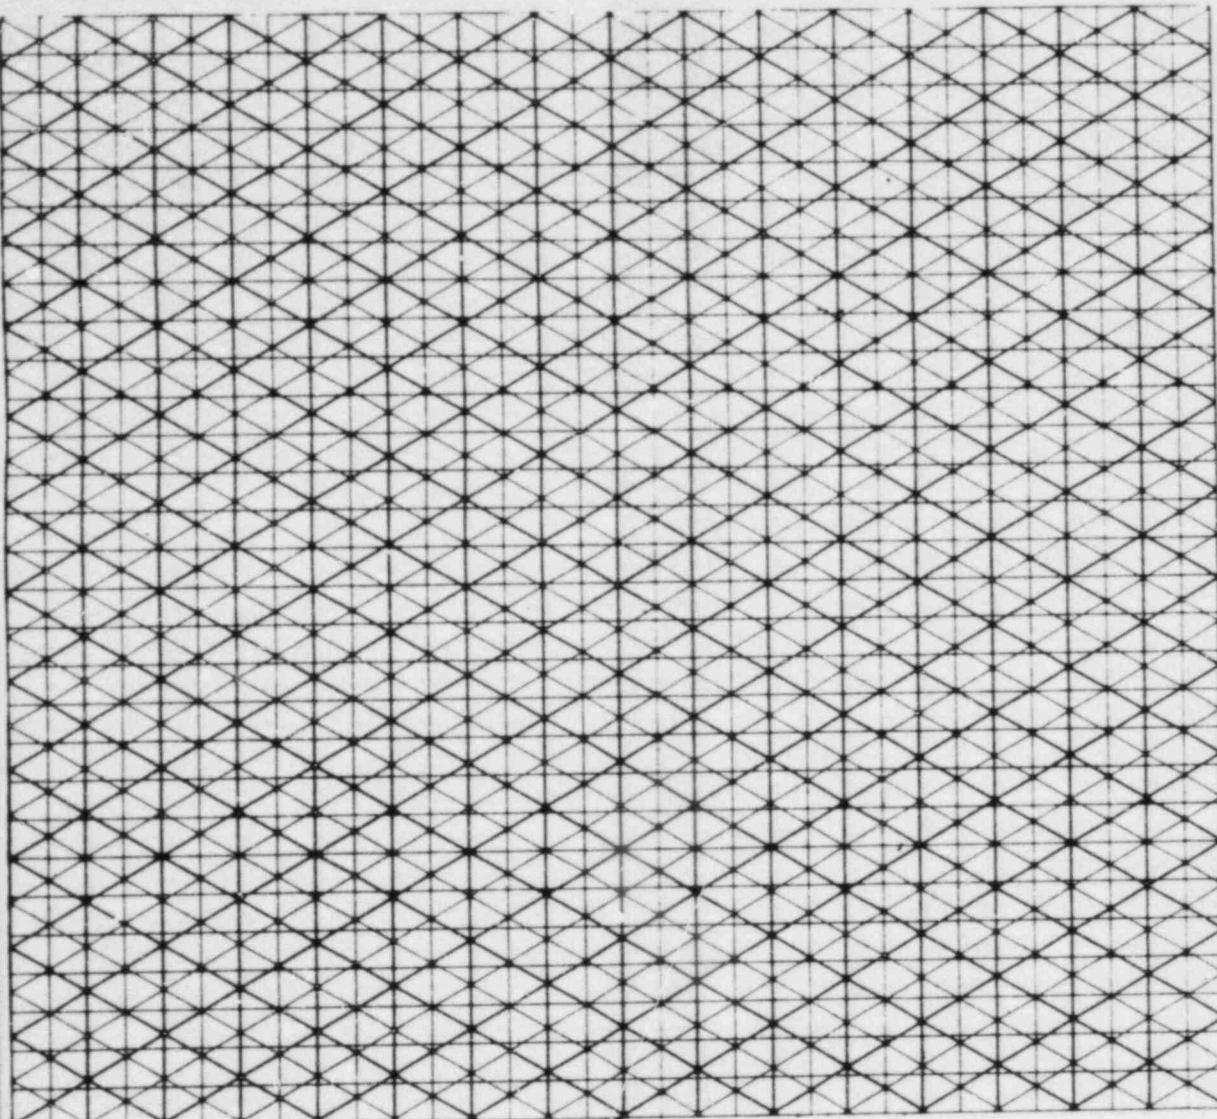

 PROCESS FLOW DATA POINT

EQUIPMENT (HT. EXCH., FILTERS, STRAINERS, FLOW NOZZLES, ETC.)

### $\Delta H_f$ (FT)

Form MES-2.16.1 Approved by  
Rev. Orig. (2-1-73)

## REFERENCES:

- REFERENCES:**

  - (a) MES-2.16 PIPING - PRESSURE DROP THROUGH FITTINGS,  
VALVES AND DISCONTINUITIES
  - (b) MES-2.10.1, MES-2.10.2 OR MES-2.10.3 PIPE SIZE  
SELECTION
  - (c) IF BACKING RINGS ARE OMITTED L/D CAN BE  
REDUCED BY 20% FOR ELBOWS

### SYSTEM:

SAFETY-RELATED

NON-SAFETY-RELATED

PREPARED BY

REVIEWED BY

APPROVED BY

	PROJECT: _____	MECHANICAL DEPARTMENT STANDARD
	CLIENT: _____ JOB NO. _____	HEAD LOSS IN PIPING SEGMENT: _____
	CALC. NO.	
DATE	FOR OFFICE USE ONLY - NOT TO BE SENT OUTSIDE OF SARGENT & LUNDY	
DATE		
DATE		
		REV. DATE _____ Page _____ of _____

8311040130-31

PAGE A-13