



IES Utilities Inc.
200 First Street S.E.
P.O. Box 351
Cedar Rapids, IA 52406-0351
Telephone 319 398 8162
Fax 319 398 8192

John F. Franz, Jr.
Vice President, Nuclear

September 15, 1995
NG-95-2236

Mr. William T. Russell, Director
Office of Nuclear Reactor Regulation
U. S. Nuclear Regulatory Commission
Attn: Document Control Desk
Mail Station P1-37
Washington, DC 20555-0001

Subject: Duane Arnold Energy Center
Docket No: 50-331
Op. License No: DPR-49
Requests for Relief from ASME Section XI Requirements:
NDE-012 through NDE-018

References: 1) Letter from J. Franz (IES Utilities Inc.) to W. Russell (NRC),
NG-94-3888 dated November 4, 1994
2) Letter from G. Kelly (NRC) to L. Liu (IES) dated
November 30, 1994, Request for Additional Information
on Relief Request

File: A-100, A-286b, A-351

Dear Mr. Russell:

In Reference 1, IES Utilities Inc. submitted requests for relief from certain ASME Code requirements. Your Staff asked that we revise these requests using guidance provided in Reference 2. We have revised the previously submitted relief requests (NDE-012 through NDE-015) accordingly. In addition, we have identified the need for three new relief requests (NDE-016 through NDE-018). The relief requests and supporting information are included as an attachment.

We request approval of the reliefs by March 15, 1996 in order to support examination scheduling for our next refueling outage, currently planned to begin in October, 1996.


250032
9509250210 950915
PDR ADOCK 05000331
PDR

A047

Mr. William T. Russell
September 15, 1995
NG-95-2236
Page 2

Should you have any questions regarding this matter, please contact this office.

Sincerely,

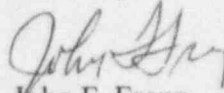

John F. Franz
Vice President, Nuclear

Attachment

JFF/CJR/smz

N:\Iowa\Licensing\NG-95\95-2236

cc: C. Rushworth
L. Liu (w/o)
L. Root (w/o)
B. Fisher (w/o)
G. Kelly (NRC-NRR)
H. Miller (Region III)
NRC Resident Office
Docu

DUANE ARNOLD ENERGY CENTER
2ND 10-YEAR INTERVAL
REQUEST FOR RELIEF NO. NDE-012

I SYSTEM/COMPONENT(S) FOR WHICH RELIEF IS REQUESTED

HEA-CC-08 (1 through 4) Residual Heat Removal (RHR) Heat Exchanger Integral Attachment Welds

EXAMINATION CATEGORY C-C, ITEM(S) C3.10

II CODE REQUIREMENT

Section XI (1980 W81 ADD), Table IWC-2500-1 Category C-C, Item C3.10 requires a surface examination of essentially 100% of weld length once during the ten year interval.

III CODE REQUIREMENT FROM WHICH RELIEF IS REQUESTED

Relief is requested from performing essentially 100% of the weld length for HEA-CC-08 (1 through 4).

IV BASIS FOR RELIEF

The design of the support does not allow access to the entire length of weld as required for the code examination. In order to perform the surface examination of the inaccessible portion of 14" on each support, the RHR heat exchanger would be required to be supported by alternate supports while the bolts were removed to allow access for the examination. The dose rates in this area are 50 to 70 mr/hr. Examining the 14" of weld for each support has only a small potential for increasing plant safety margins and a very disproportionate impact on expenditures of plant manpower and radiation exposure.

V ALTERNATE EXAMINATIONS


IES Utilities Inc. proposes to perform a surface examination of the accessible 82.5% of the weld length for each of the four welds (HEA-CC-08, 1 through 4). The examination coverage specified in Code Case N-460 will be utilized.

VI JUSTIFICATION FOR THE GRANTING OF RELIEF

To perform an examination of the inaccessible 14" of weld length, the RHR heat exchanger would be required to be supported by alternate supports while the bolts were removed to allow access for the examination. Performing this activity in order to examine the additional 14" results in only a small potential for increasing plant safety margins and a very disproportionate impact on expenditures of plant manpower and radiation exposure.

VII IMPLEMENTATION SCHEDULE

This relief request will be implemented during the 2nd Ten Year Interval.

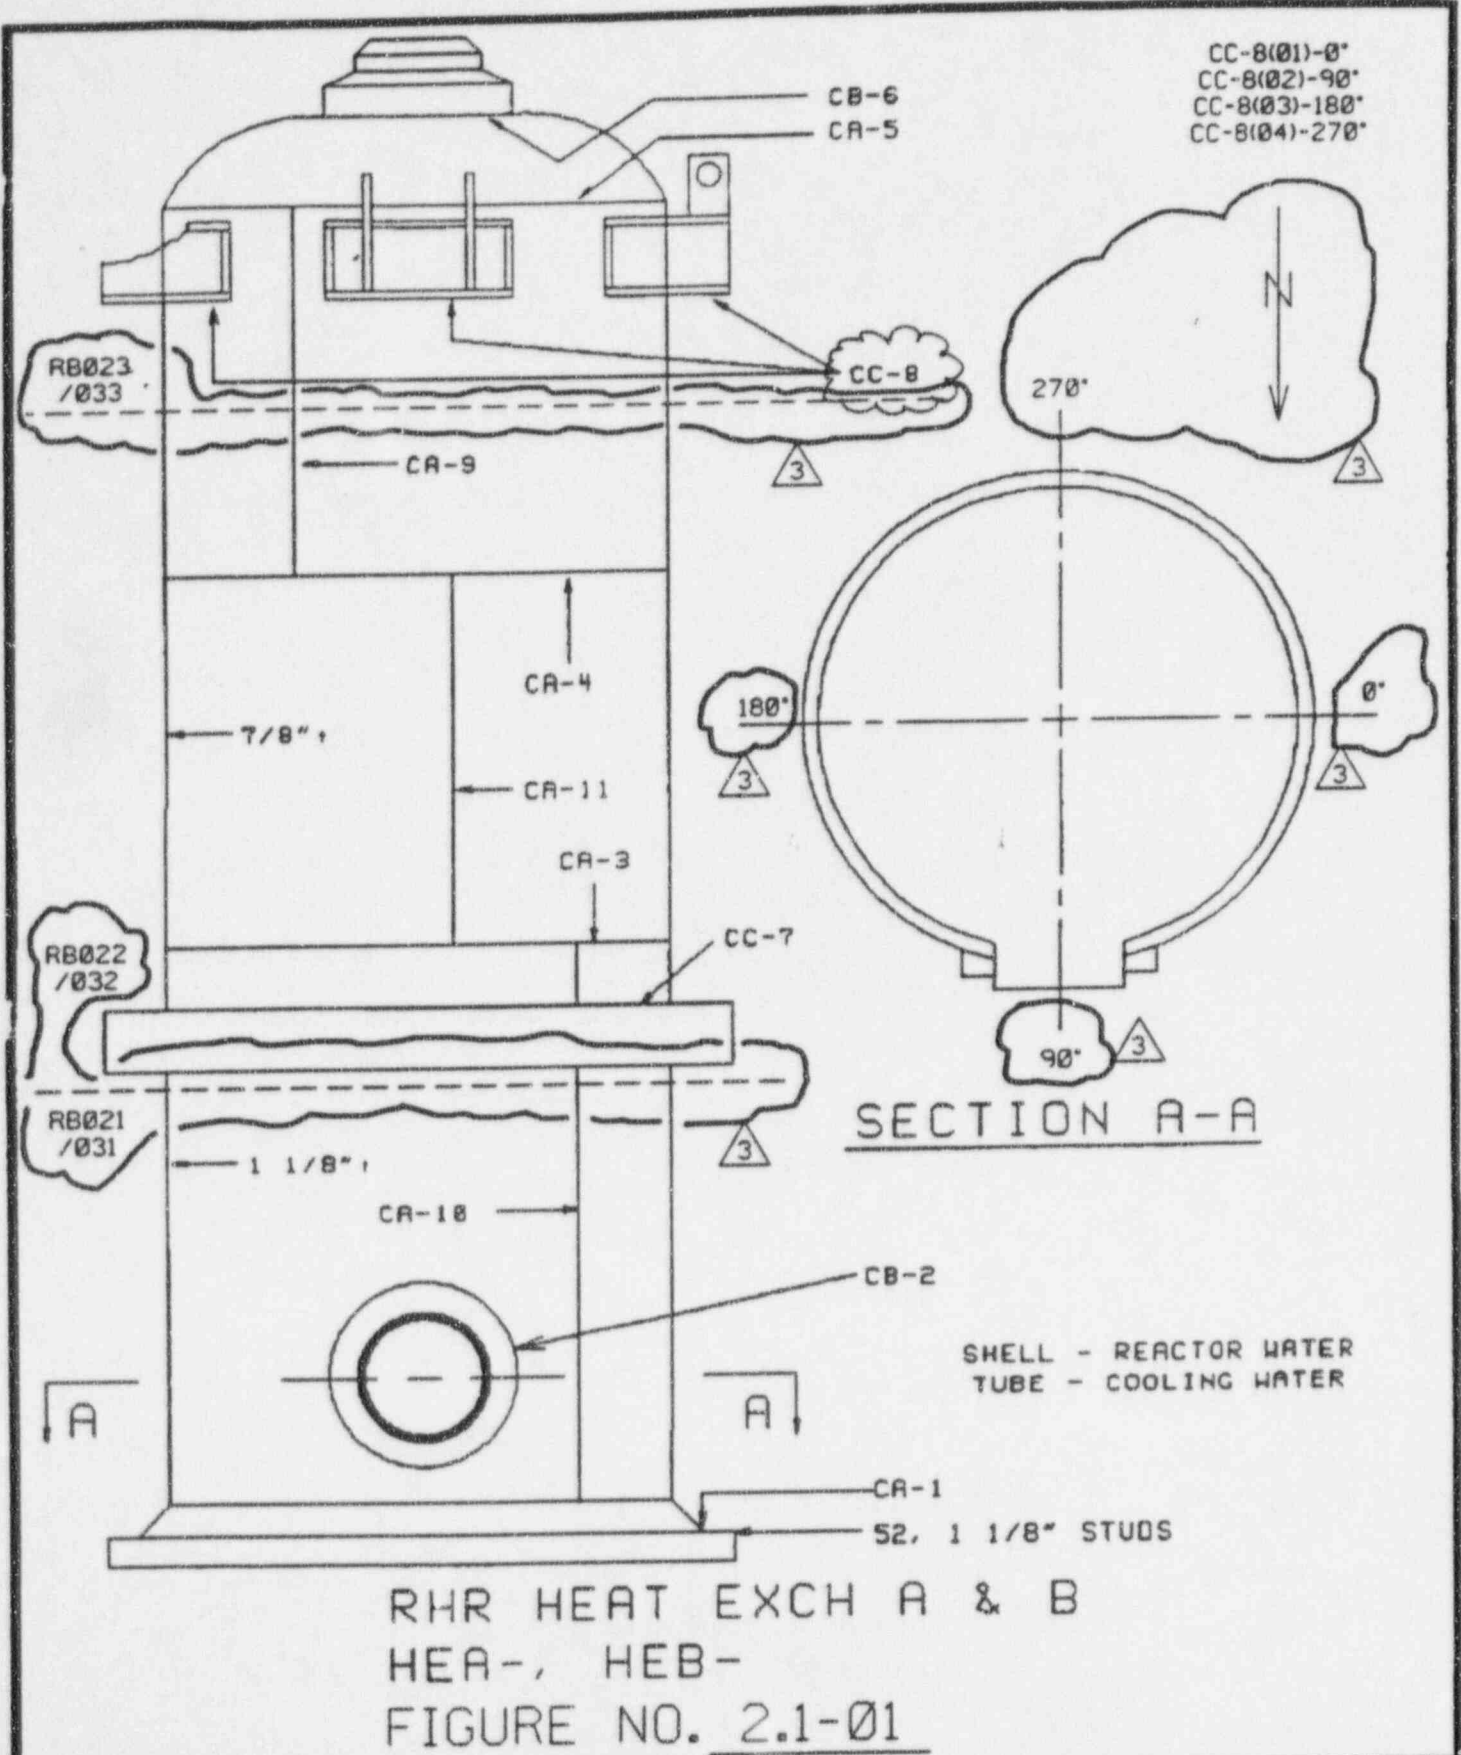

DRAWING RELEASE RECORD

REV	DATE	PREPARED	REVIEWED	APPROVED	PURPOSE
1	4-26-86	SML	SML	RCM	ISO'S FOR 2nd 10 YEAR PLAN
2	9-18-90	<i>[Signature]</i>	<i>[Signature]</i>	<i>[Signature]</i>	ISO'S TO CAD FORMAT AS PER NC-89-0794
3	8/23/94	DA	FED 8/23/94	<i>[Signature]</i>	REVISED PER ISI INSPECTION WALKDOWN

RECORD OF NONDESTRUCTIVE EXAMINATION
 MAGNETIC PARTICLE - (DRY OR WET METHOD) MT-1

MAR NO NA MIF STEP NA DCP/PMF NO NA TRAVELER NO NA INDEX ITEM NA
 GIR NO. NA ISI NO 91-308 309 310 311 MCR NO NA
 COMPONENT OR SYSTEM HEA-CL-2 (1-10-10) DWG. OR ISO NO 2.1-1
 THICKNESS 1" PROCEDURE NO. 2162.4 REV 0 PCN NA ACCEPT STD 6.10.1
 EQUIPMENT NO. ID 30-15C CAL DUE DATE 7-9-93 (AC) DC
 DC CURRENT GUN NA CAL DUE DATE NA
 YOKE/PROD SPACING 5-9" AMP NA DRY POWDER: RED NA BLACK NA
 MX-WCP BATCH NO NA 9 CH RED BATCH NO NA 7 C-F BLACK BATCH NO 99LKB

ITEM	INITIAL INSPECTION		DEFECT CODE#	INITIAL INSPECTION REMARKS (SIZE/LOCATION)	REINSPECTION		DEFECT CODE#	REINSPECTION REMARKS (SIZE/LOCATIO)
	ACC	REJ			ACC	REJ		
91-304 #1 0° PE	✓		N/A					
91-309 #2 90° PE	✓		NA					
91-510 #3 180° PE	✓		NA					
91-511 #4 270° PE	✓	✗	LI	SEE BELOW				



91-304
91-309
91-510
91-511

SEE Attached Evaluation

NOTE - BLACK CONTRAST PAINT USE

DEFECT CODE

P - POROSITY, R - ROUNDED, LI - LINEAR INDICATION, LA - LAMINATION, O - OTHER

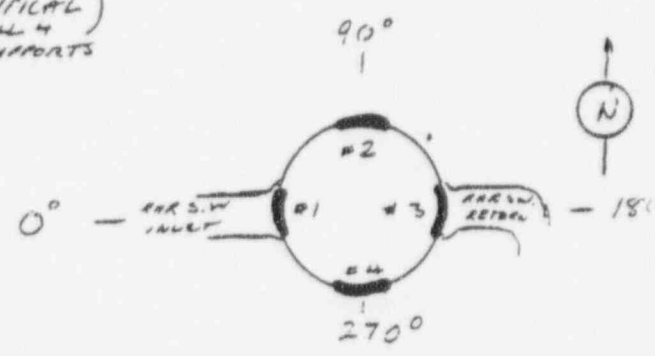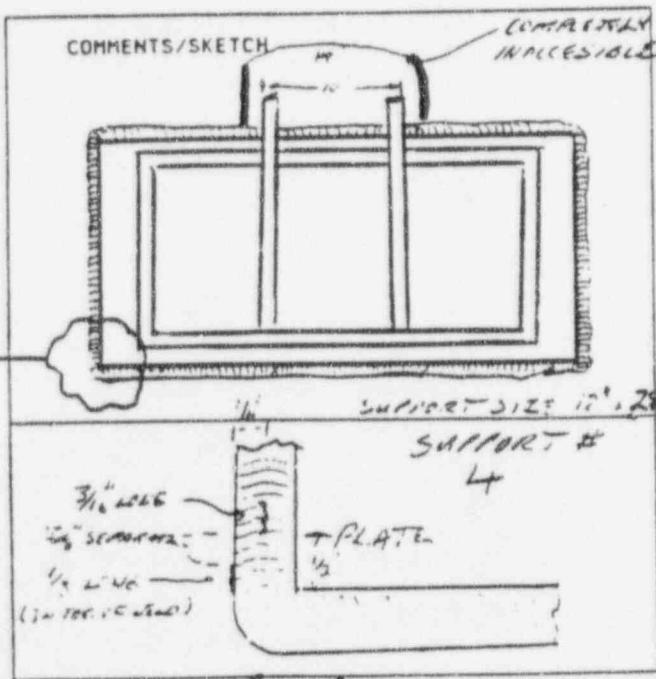

ORIENTATION
 EXAMINER: [Signature] 1-14-93
 SIGNATURE/LEVEL/DATE
 REVIEWED BY: Frank E. Schmen 1-16-93
 LEVEL III SIGNATURE/DATE
 REVIEWED BY: [Signature] 1-2-93
 ANII SIGNATURE/DATE

RECORD COPY

122

DUANE ARNOLD ENERGY CENTER
2ND 10-YEAR INTERVAL
REQUEST FOR RELIEF NO. NDE-013

I SYSTEM/COMPONENT(S) FOR WHICH RELIEF IS REQUESTED

RBA-J007 Recirculation Bypass weld

EXAMINATION CATEGORY B-J, ITEM(S) B9.11

II CODE REQUIREMENT

Section XI (1980 W81 ADD), Table IWB-2500-1 Category B-J, Item B9.11 requires a volumetric examination which includes essentially 100% of weld length once during the ten year interval.

III CODE REQUIREMENT FROM WHICH RELIEF IS REQUESTED

Relief is requested from performing essentially 100% of the weld length for Recirculation Bypass Weld RBA-J007.

IV BASIS FOR RELIEF

The weld is a tee-to-flange configuration which limits the volumetric (UT) examination to a one-sided exam from the tee side. In addition, the tee configuration limits the one-side examination to 85% of the weld length. In order to perform a radiograph of the weld, the recirculation system would be required to be drained, thus increasing exposure to personnel by a factor of 1.7 (50 mr/hr vs 29 mr/hr) for a total of 120 mr for the additional 15% coverage. This is the additional exposure for the examination, installation and removal of insulation and shielding; it does not include any additional exposure resulting from the time spent performing valve line-ups or system draining. Examining the additional 15% of weld length has only a small potential for increasing plant safety margins and a very disproportionate impact on expenditures of plant manpower and radiation exposure to perform the radiography.

V ALTERNATE EXAMINATIONS

IES Utilities Inc. proposes to perform volumetric examination of the accessible weld, obtaining a total of 85% coverage for this weld length. The examination coverage specified in Code Case N-460 will be utilized.


VI JUSTIFICATION FOR THE GRANTING OF RELIEF

To perform the additional 15% of weld length the Recirculation System would be required to be drained, thus increasing exposure to personnel. Examining the additional 15% of weld length has only a small potential for increasing plant safety margins and a very disproportionate impact on expenditures of plant manpower and radiation exposure to perform the radiography.

VII IMPLEMENTATION SCHEDULE

This relief request will be implemented during the 2nd Ten Year Interval. This weld was included in the Refueling Outage (RFO) 8 Summary Report.

REV	DATE	PREPARED	REVIEWED	APPROVED	PURPOSE
1	3-19-86	SJL	SJL	RCM	ISO'S FOR 2nd 10 YEAR PLRN
2	9-24-90	DR	DR	KKH	ISO'S TO CAD FORMAT AS PER NC-83-8794
3	4-2-95	DA	GP		ADDED FLANGE
4					REVISED PER ISI INSPECTION WALKDOWN

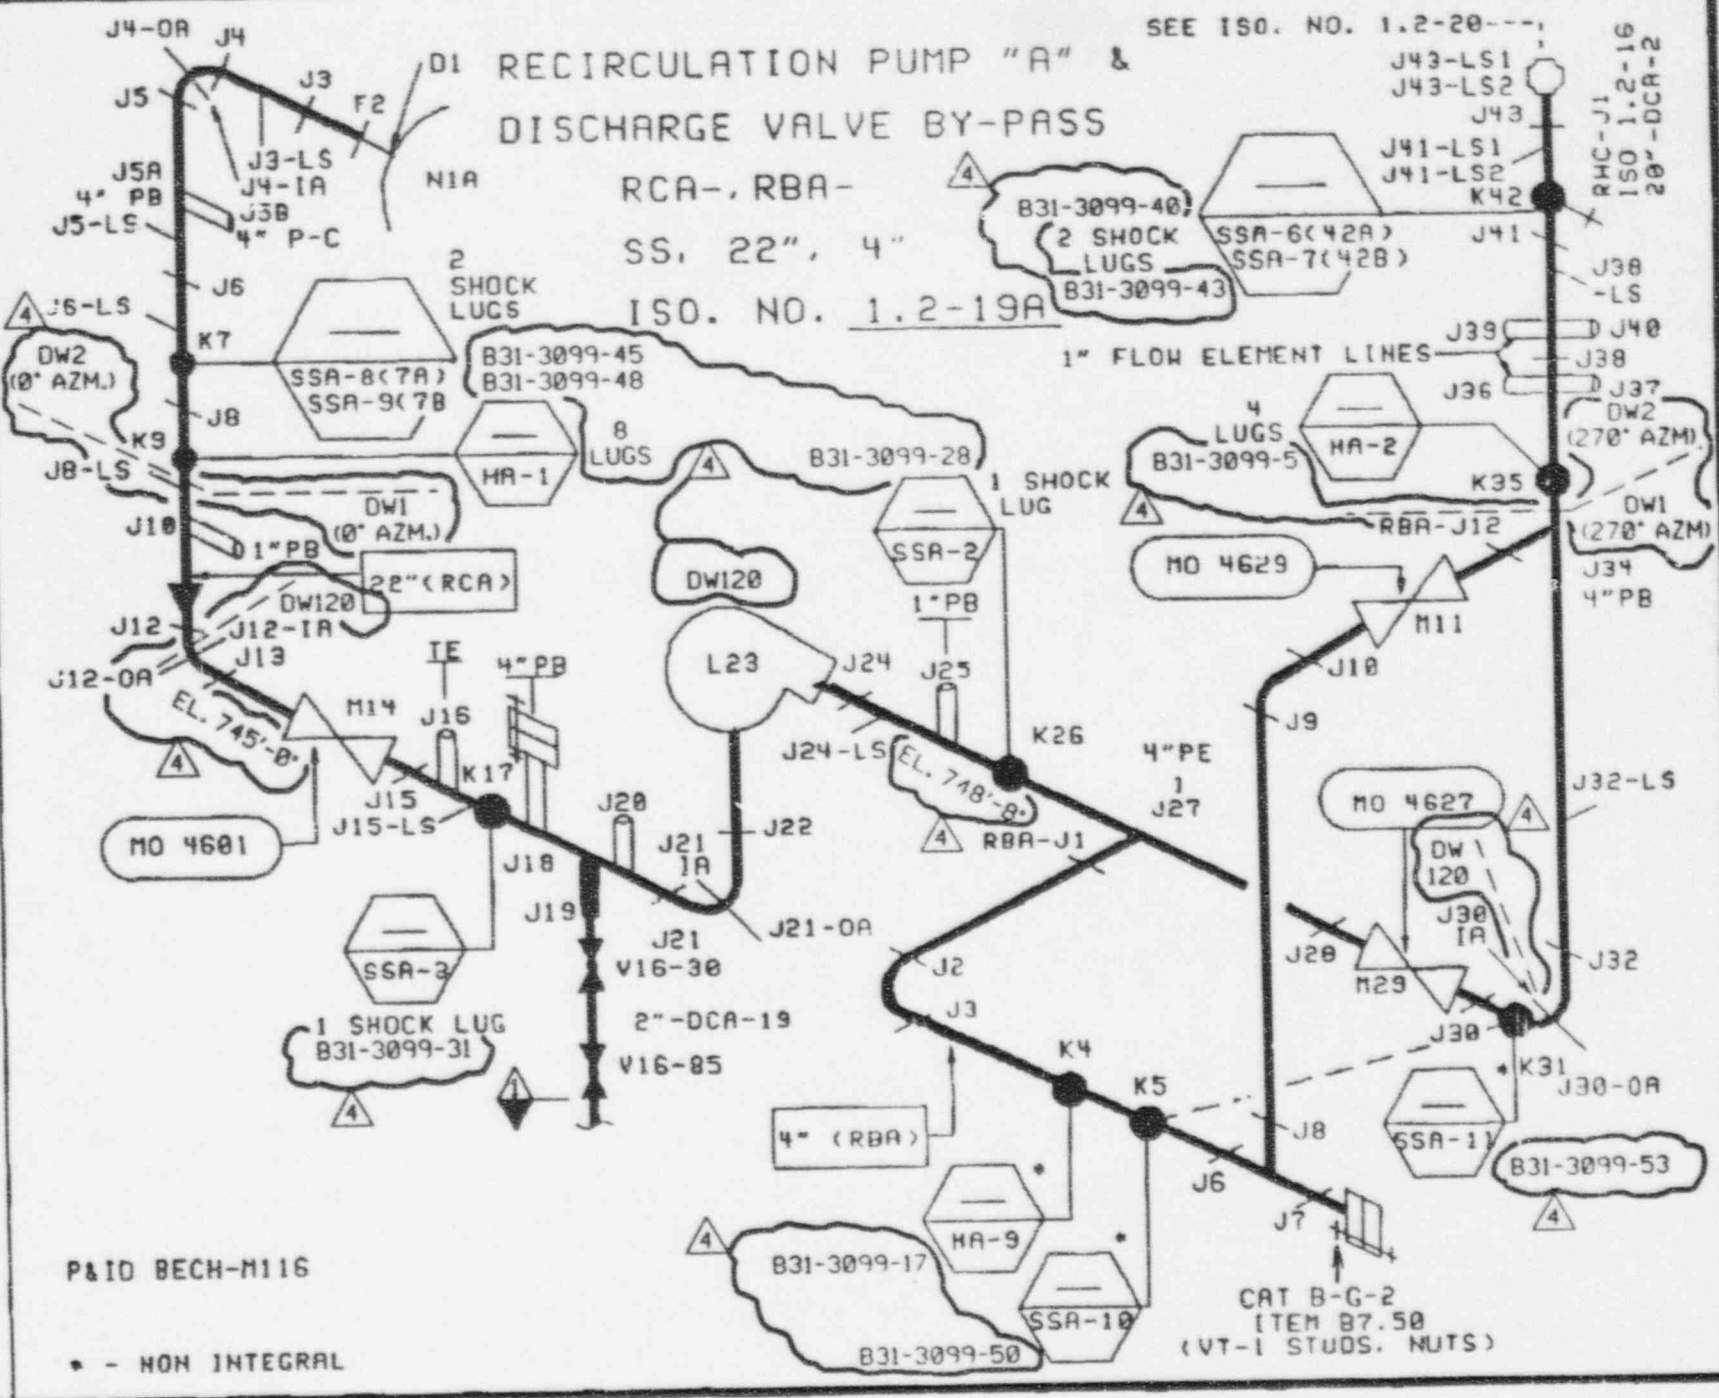

P&ID BECH-M116

• - NON INTEGRAL

SEE ISO. NO. 1.2-20---

DREC INSERVICE INSPECTION REHE SECTION XI ISOMETRIC

DRAWING RELEASE RECORD



GE Nuclear Energy

RESOLUTION SHEET

REPORT NO.:

R-158

PROJECT: DUANE ARNOLD

PROCEDURE: GE-UT-102 REV. 2 FRR NO. N/A
N/A REV. N/A FRR NO. N/A
N/A REV. N/A FRR NO. N/A

SYSTEM: RECIRCULATION

NDE METHOD: MT PT UT VT

WELD NO.: RBA-3007

WELD TYPE: CIRCUMFERENTIAL
 LONGITUDINAL OTHER N/A

CONFIGURATION: TEE TO FLANGE

EXAMINER: H. SCHWARTZ LEVEL II

CAL SHEET NO.(S) C-097

EXAMINER: N/A LEVEL N/A

EXAMINER: N/A LEVEL N/A

REPORT NO.(S) R-158 ISI No. 89-186

DURING THE MANUAL EXAMINATION OF THE ABOVE REFERENCED WELD, NO INDICATIONS ASSOCIATED WITH IG SCC WERE RECORDED UTILIZING A 45° SHEAR WAVE SEARCH UNIT.

PREVIOUS DATA WAS REVIEWED PRIOR TO THIS RESOLUTION WITH NO SIGNIFICANT CHANGE NOTED.

[Handwritten signature and initials]

Ronald C. Law LEVEL II DATE 7-17-90
 RESOLUTION BY

Kevin P. Schmidt LEVEL III DATE 7-17-90
 REVIEWED
Kevin P. Schmidt LEVEL III DATE 7-18-90
 REVIEWED

PAGE 1 OF 3

FORM 135 12-8-89

[Handwritten initials and date]
 7-24-90



GE Nuclear Energy

WALL THICKNESS PROFILE SHEET

ISI NO. 89-186

SITE: DUANE ARNOLD UNIT: E

REPORT NO.

PROJECT NO: CT 662

R-15B

POSITION	0°	90°	180°	270°
1			.52	
2			.44	
3	N/A		.40	N/A
4			N/A	
5			N/A	

SYSTEM ID RELIRC



WELD ID NO. RBA-J007

CROWN HEIGHT: .05"

CROWN WIDTH: .5"

NOM. DIAMETER: 4.0"

WELD LENGTH: 14.5"

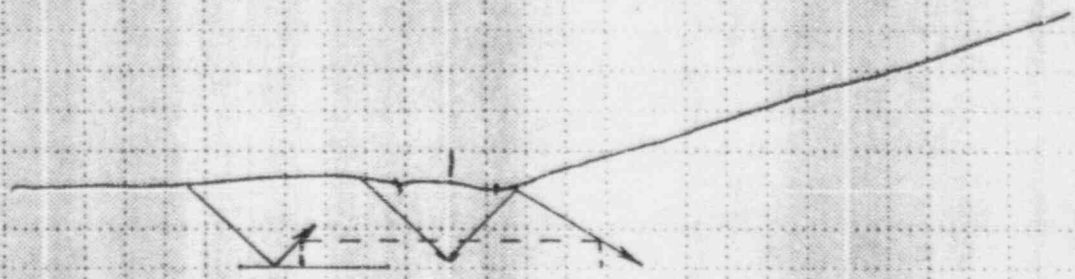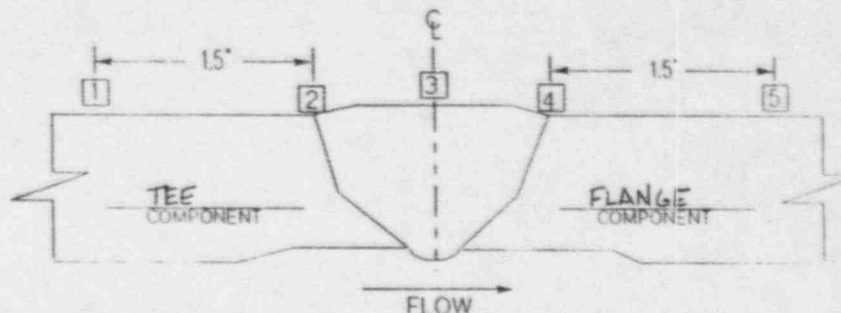

PROPOSED COVERAGE PLOT



AP
7-24-90

RECURRY COPY

[Signature]
Examiner

E 7/16/90
Level Date

[Signature]
Reviewed By

II 7/17/90
Level Date

KPS
Reviewed By

III 7/18/90
Title Date

Page 2 of 3

FORM 135 1-13-90

Attachment to
NG-95-2236
Page 7 of 52

ISI NO. 89-186



GE Nuclear Energy

ULTRASONIC EXAMINATION DATA SHEET (MANUAL PIPING)

SITE: DUANE ARNOLD UNIT: 1
PROJECT NO: CT-662

REPORT NO. R-158
CALIBRATION SHEET NO. C-097


PROCEDURE: GE-UT-102 REV 2 FRR N/A
SYSTEM: RECIRC
WELD ID: RBA-3007
START TIME 1136
FINISH TIME 1144

MATERIAL TYPE: CS SS OTHER N/A
EXAM SURFACE ID OD
EXAM SURFACE TEMP 80 °F
THERMOMETER S/N 1956
AXIAL SCAN SENSITIVITY 46 dB
CIRC SCAN SENSITIVITY 52 dB

L REFERENCE RULE # 1 TDC

W REFERENCE WELD E

1. WITH FLOW
2. AGAINST FLOW
3. CLOCKWISE
 - a. upstream b. downstream
4. COUNTER CLOCKWISE
 - a. upstream b. downstream
5. L-WAVE BASE METAL
6. OTHER N/A

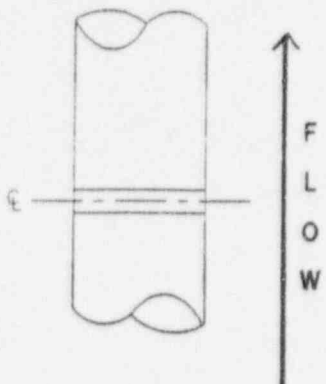

	PERFORMED		INDICATIONS	
	YES	NO	YES	NO
1	✓			✓
2		✓		✓
3a	✓			✓
3b		✓		✓
4a	✓			✓
4b		✓		✓
5		✓		✓
6		✓		✓

INDICATION NO.	L (in) FROM REF			W (in) FROM REF			MAX AMP % DAC	SWEEP READING			EXAM 1-6	NOMINAL SCANNING ANGLE
	L ₁	L _{MAX}	L ₂	W ₁	W _{MAX}	W ₂		SW ₁	SW _{MAX}	SW ₂		
NO RECORDABLE INDICATIONS											1, 3a, 4a	45°

REMARKS EXAMS 1, 3a, 4a LIMITED TO A "W" OF .65" FOR 1" CW + CCW OF L₀, DUE TO CONFIGURATION OF TEE.
NO EXAM PERFORMED DOWNSTREAM DUE TO CONFIGURATION OF FLANGE. ID AND OD GEOMETRY OBSERVED AT LESS THAN RECORDABLE LEVELS.

<u>Rehly</u> Examiner	II	7-16-90	<u>Ronald G. Law</u> Reviewed	II	7-17-90
<u>Thibault</u> Examiner	I	7-16-90	<u>KV</u> Reviewed	II	7-18-90



GE Nuclear Energy

ULTRASONIC CALIBRATION DATA SHEET

(MANUAL EXAMINATION)

SITE: DUANE ARNOLD UNIT: 1
 PROJECT NO: CT-662

CALIBRATION SHEET NO. C-097
 LINEARITY SHEET NO. L-005

Procedure No. GE-UT-102 Rev. 2 FRR No.: N/A

Instrument KRAUTKRAMER USK-75 31459-1548
Manufacturer Model Serial No.


Search Unit KBA .25" 2.25 MHz 45°/S K24938
Manufacturer Size Freq. Angle/Mode Serial No.

Cable RG-174 6' 2
Type Length Connectors

Calibration Standard IE-18 SS .35" 72°F
Serial No. Material Thickness Temp.

Couplant ULTRACEL II 8976 Thermometer 1956
Brand Batch No. Serial No.

DAC

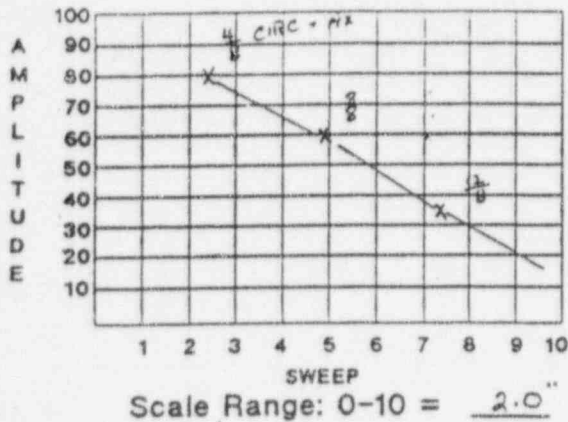

INSTRUMENT SETTINGS

DAC Construction		Sensitivity	
Gain - Axial Scan	<u>32</u> dB	Gain - Axial Scan	<u>32</u> dB
Gain - Circ. Scan	<u>38</u> dB	Gain - Circ. Scan	<u>38</u> dB
Freq.	<u>Auto</u>	Rep Rate	<u>Fixed</u>
Range	<u>2.5</u>	Resolution	<u>Fixed</u>
Sweep	<u>3.75</u>	Damping	<u>Pos I</u>
Delay	<u>10.06</u>	Reject	<u>OFF</u>
Filter	<u>Fixed</u>		

Jack R T

FIELD SIMULATOR: N/A SIN: N/A

CALIBRATION VERIFICATION

REFLECTOR	N/A	INITIAL CALIBRATION TIME	1030	VERIFICATION TIMES	
MAX. AMP.		FINAL VERIFICATION TIME	1510	1300	
SWEEP				N/A	N/A

WELDS EXAMINED	REPORT NO.	COMMENTS: WELDS CONT.	REPORT NO.
RBA-J001	R-153		
RBA-J002	R-155	RBA-J010	R-161
RBA-J003	R-156		
RBA-J006	R-157		
RBA-J007	R-158		
RBA-J008	R-159		
RBA-J009	R-160		

Aschelt II 7-16-90
Examiner Level Date
John I 7-16-90
Examiner Level Date

[Signature] II 7-17-90
Reviewed Level Date
[Signature] III 7-18-90
Reviewed Title Date

LMT-UTX1 10/77

Lambert • MacGill • Thomas, Inc.



Testing • Engineering • Service • Training
 515 Aldo Avenue
 Santa Clara, CA 95050
 408-980-9333

Location DAEC
 Report No. 97-157
 Cal. No. 3F-10 Time 152
 Job No. TEL-03-
 Date 3-31-87
 Page 1 of 1

REPORT OF VISUAL AND ULTRASONIC EXAMINATION

ISI ID: RBA-RJ-7 ⁴⁻³⁻⁸⁷

I T E M	Description <u>TEE / PIPE</u> Size <u>4" SCH 80</u> Material <u>SS</u> S/N(s) <u>RD-N-A9-7-S</u>									
	<u>A LOOP</u> ISI ID: <u>RBA-RJ-7</u> ⁴⁻³⁻⁸⁷									
	Location <u>DRY WELL</u>	Preparation <u>AS WELDED</u> Temp <u>70°</u>								
S I G N	Examiner/Level <u>J. Flint</u> Examiner/Level <u>R.E. COE II</u> Review/Level <u>J.P.M. 4-29-87</u>									
	Authorized Inspector <u>J. Brent</u> 4-3-87 Customer <u>Kump, S. Smead</u> 4-3-87									
E Q U I P C O N T	Tester 1 <u>NOATEC 131-D</u> S/N <u>417</u> 2 <u>SLAVE</u> S/N <u>20</u>									
	Recorder 1 <u>N/A</u> S/N <u>N/A</u> 2 <u>N/A</u> S/N <u>N/A</u>									
	Transducer 1 <u>C3354, HARI, SONIC, SXS, 1.54MHz</u> 2 <u>N/A</u>									
	3 <u>N/A</u> 4 <u>N/A</u>									
	Couplant <u>LMT-GEL</u> Cable <u>COAX 6'</u> Marker <u>N/A</u> Photo <u>N/A</u>									
P R O C	Calibration Procedure <u>UT-41</u> Rev. <u>S, FC, 1, 2, & 3</u>									
	Examination Procedure <u>UT-41</u> Rev. <u>S, FC, 1, 2, & 3</u>									
	Recording Procedure <u>N/A</u> Rev. <u>N/A</u>									
C A L I B	Calib. Blk. <u>PIPE SEQ. 90359</u> Temp. <u>70°</u> Ref. <u>IDMOTEN</u> Amp. <u>80%</u> Sweep <u>2.0 DIV</u>									
	Ref. Gain <u>52/55</u> Damp. <u>OFF</u> Reject <u>OFF</u> Gate <u>1-10 DIV</u>									
	Alarm <u>N/A</u> Mag. Tape Count <u>N/A</u> Chart <u>N/A</u> Cal. Check Time <u>1540</u>									
E X A M I N A T I O N	Cal. Ref. Blk. <u>RAMPAS</u> Ref. Refl. <u>1" x 2" MP</u> Amp. <u>95%</u> Sweep Position <u>4.0 & 8.0 DIV</u>									
	Scan Gain <u>64/67</u> Ref. Dwg. <u>1.2-19</u> Reject Level <u>ASME XI</u> Report Level <u>ASME XI</u>									
	NAD = No Apparant Disc. L = Linear G = Geometry S = Spot M = Multiples									
	Scan	Type	Disp.	Scan	Type	Disp.	Scan	Type	Disp.	
	<u>N/A</u>	<u>N/A</u>	<u>N/A</u>	<u>N/A</u>	<u>N/A</u>	<u>N/A</u>	<u>N/A</u>	<u>N/A</u>	<u>N/A</u>	
	1	↓ FLOW	NAD	7	45° SKEW FLOW	N/A	13			
	2	↑ FLOW	N/A	8	45° SKEW FLOW	N/A	14			
	3	CW	NAD	9	N/A	N/A	15			
	4	CCW	NAD	10			16			
	5	45° SKEW FLOW	NAD	11			17			
	6	45° SKEW FLOW	NAD	12			18			
				Scan Description of Indications 1 SCAN LIMITED TO ONE SIDE & LIMITED SCAN DUE TO CONFIGURATION (11 TO 1 O'CLOCK) 2, 7, 8 NO SCAN DUE TO CONFIGURATION.						
	111114 RWD Sketch									

Lambert • MacGill • Thomas, Inc.

Testing • Engineering • Service • Training

515 Aldo Avenue
Santa Clara, CA 95050
408-980-9333

Location L.A.E.
Cal No. GE-10 Time 448
Job No. TEL-034
Date 3-31-87
Page 1 of 1

REPORT OF ULTRASONIC CALIBRATION

SIGN
Examiner/Level J. Flint II Examiner/Level D.E. Coz II Review/Level D.M. ...
Authorized Inspector J. Flint 4-3-87 Customer Kum-Su ... 4-3-87

EQUIPMENT

Instrument NORTEC 1.31 D S/N 417 ReCal Due 5-20-87 SU Cable 6' COAX
Instrument SLAVE S/N 20 ReCal Due 6-4-87
Recorder N/A S/N N/A ReCal Due N/A
Recorder N/A S/N N/A ReCal Due N/A

VERTICAL LINEARITY CHECK Check Completed by J. Flint II

SIGNAL 1	100	90	80	70	60	50	40	30	20	10
SIGNAL 2	50	45	40	35	30	25	20	15	10	5

Signal 2 shall equal 50% of Signal 1 within $\pm 5\%$ of full scale.

AMPLITUDE CONTROL LINEARITY CHECK Check Completed by J. Flint II

SENSITIVITY	SET	-6	-12	SET	-12	SET	-6
ACCEPT RANGE	80%	32 to 48	18 to 24	20%	64 to 96	40%	64 to 96
ACTUAL VALUE	XXX	40	20	XXX	80	XXX	80

Signal amplitude must fall within listed values.

SEARCH UNITS
S/N C3354 Mfg. HARISONIC Type S/W Size 5"x.5" Freq. 1.5MHz Index .35 Angle 45°
S/N N/A Mfg. N/A Type N/A Size N/A Freq. N/A Index N/A Angle N/A

PROC
Procedure UT-4 Rev 5 Date 3-7-87 Field Change 4,2,3 Date 3-27-87 FC
3-18-87 FC

Cal. Block Type PIPE SEGMENT S/N 80359 Ref. Refl. NOTCH Temp. 70°F
Verification/Ref. Bk. ROMPAS S/N LMT037 Ref. Refl. 1", 2" MP Temp. 70°F

CALIBRATION

INSTRUMENT SETTINGS				DAC	CAL. CHECK TIME
	0°	Angle Beam	Digital		
Gain	N/A	52/55	1.0 = 1"		1457
Sweep	1	10/966	4.0 = 4"		1519
Delay	1	1/002	5.0 = 5"		1522
Reject	1	OFF	N/A		1540
Damp.	1	OFF	1		1547
Freq.	1	2.25MHz	1		
Video/Filt.	1	1+	1		
Rep. Rate	N/A	1K	N/A		

IRD	.4	.75	1.25	1.7	1.85
MP	.49	1.08	1.48	2.08	2.43

DUANE ARNOLD ENERGY CENTER
2ND 10-YEAR INTERVAL
REQUEST FOR RELIEF NO. NDE-014

I SYSTEM/COMPONENT(S) FOR WHICH RELIEF IS REQUESTED

RBA-J012 Recirculation Bypass Weld

EXAMINATION CATEGORY B-J, ITEM(S) B9.11

II CODE REQUIREMENT

Section XI (1980 W81 ADD), Table IWB-2500-1 Category B-J, Item B9.11 requires a volumetric examination which includes essentially 100% of weld length once during the ten year interval.

III CODE REQUIREMENT FROM WHICH RELIEF IS REQUESTED

Relief is requested from performing essentially 100% of the weld length for Recirculation Bypass Weld RBA-J012.

IV BASIS FOR RELIEF

This weld is a valve-to-weldolet configuration which limits the volumetric examination coverage to 76% of the weld length. In order to perform a radiograph of the weld, the recirculation system would be required to be drained, thus increasing exposure to personnel by a factor of 1.7 (50 mr/hr vs 29 mr/hr) for a total of 435 mr for the additional 24% coverage. This is the additional exposure for the examination, installation and removal of insulation and shielding; it does not include any additional exposure resulting from the time spent performing valve line-ups or system draining. Examining the additional 24% of weld length has only a small potential for increasing plant safety margins and a very disproportionate impact on expenditures of plant manpower and radiation exposure to perform the radiography.

V ALTERNATE EXAMINATIONS


IES Utilities Inc. proposes to perform volumetric examination utilizing the required 45° shear supplemented with a 70° Refracted Longitudinal exam of the accessible weld, obtaining a total of 76% coverage for this weld. The alternative examination coverage specified in Code Case N-460 will be utilized.

VI JUSTIFICATION FOR THE GRANTING OF RELIEF

Examining the additional 24% of weld length would require draining the Recirculation System which would result in increased exposure to personnel. This additional examination has only a small potential for increasing plant safety margins and a very disproportionate impact on expenditures of plant manpower and radiation exposure to perform the radiography.

VII IMPLEMENTATION SCHEDULE

This relief request will be implemented during the 2nd Ten Year Interval. RBA-J012 was included in the Refueling Outage (RFO) 8 Summary Report.

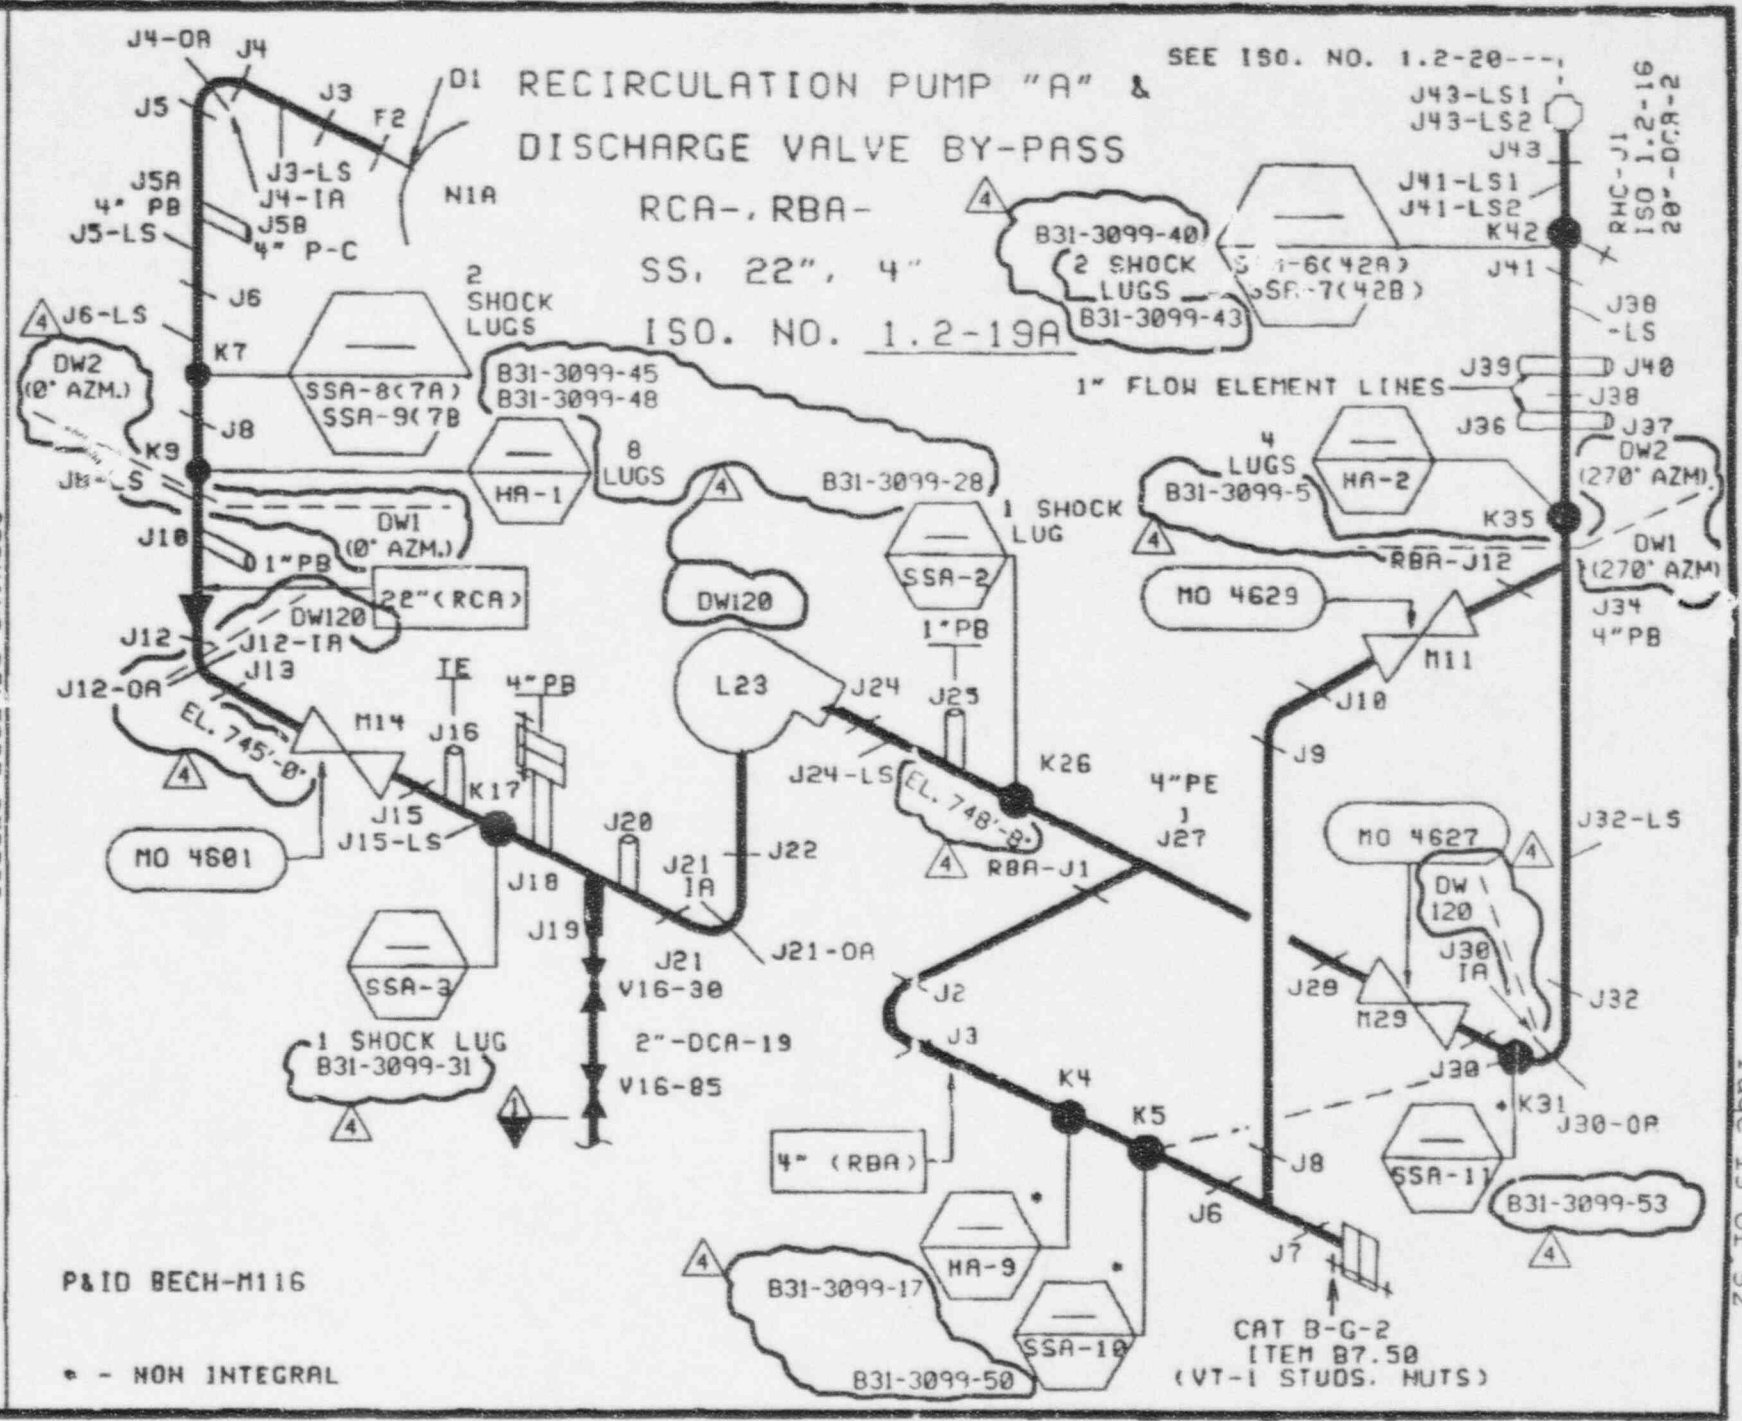

DRAWING RELEASE RECORD

PURPOSE

REV

DATE

PREPARED

REVIEWED

APPROVED

ISO'S FOR 2nd 10 YEAR PLAN

ISO'S TO CND FORMAT AS PER MC-89-8794

ADDED FLANGE

REVISED PER ISI INSPECTION WALKDOWN

1

5-13-86

SNL

SNL

RCH

KKH

KKH

KKH

KKH

2

9-24-90

DA

DA

3

4-2-95

DA

DA

4

P&ID BECH-M116

* - NON INTEGRAL

DREC INSERVICE INSPECTION ASME SECTION XI ISOMETRIC

Attachment to
NG-95-2236
Page 13 of 52

 <p>GE Nuclear Energy</p>	<p align="center">RESOLUTION SHEET</p>	<p>REPORT NO.: <u>R-178</u></p>
<p>PROJECT: <u>DUANE ARNOLD</u></p>	<p>PROCEDURE: <u>GE-UT-102</u> REV. <u>2</u> FRR NO. <u>N/A</u> <u>N/A</u> REV. <u>N/A</u> FRR NO. <u>N/A</u> <u>N/A</u> REV. <u>N/A</u> FRR NO. <u>N/A</u></p>	
<p>SYSTEM: <u>RECIRCULATION</u> WELD NO.: <u>RBA-3012</u> CONFIGURATION: <u>VALVE TO WELD-O-LET</u> EXAMINER: <u>H. SCHLORTT</u> LEVEL <u>II</u> EXAMINER: <u>N/A</u> LEVEL <u>N/A</u> EXAMINER: <u>N/A</u> LEVEL <u>N/A</u></p>	<p>NDE METHOD: <input type="checkbox"/> MT <input type="checkbox"/> PT <input checked="" type="checkbox"/> UT <input type="checkbox"/> VT</p> <p>WELD TYPE: <input checked="" type="checkbox"/> CIRCUMFERENTIAL <input type="checkbox"/> LONGITUDINAL <input type="checkbox"/> OTHER <u>N/A</u></p> <p>CAL SHEET NO(S): <u>C-118, C-119</u></p> <p>REPORT NO.(S) <u>R-178</u> ISI No. <u>89-190</u></p>	


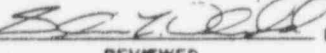

DURING THE MANUAL EXAMINATION OF THE ABOVE REFERENCED WELD, NO INDICATIONS ASSOCIATED WITH IGSCC WERE RECORDED UTILIZING A 45° SHEAR WAVE SEARCH UNIT.


A SUPPLEMENTAL EXAMINATION WAS PERFORMED UTILIZING A 70° REFRACTED LONGITUDINAL WAVE SEARCH UNIT RESULTING IN NO RECORDABLE INDICATIONS. THIS EXAMINATION WAS PERFORMED DUE TO THE CONFIGURATION OF THE VALVE AND WELD-O-LET.

DUE TO THE ABOVE MENTION CONFIGURATION THE 45° SHEAR WAVE EXAMINATION WAS LIMITED TO CIRCUMFERENTIAL SCANS ONLY. THE 70° R.L. WAS UTILIZED FOR THE AXIAL SCANS.

PREVIOUS DATA WAS REVIEWED PRIOR TO THIS RESOLUTION WITH NO SIGNIFICANT CHANGE NOTED.

RECORD COPY

<p> RESOLUTION BY LEVEL <u>II</u> DATE <u>7-18-90</u></p>	<p> REVIEWED LEVEL <u>III</u> DATE <u>7-18-90</u>  REVIEWED LEVEL <u>III</u> DATE <u>7-20-90</u></p>	<p>PAGE <u>1</u> OF <u>4</u> FORM 135 12-8-89</p>
---	--	---

 AP
7-31-90



GE Nuclear Energy

WALL THICKNESS PROFILE SHEET

ISI No. 89-190

SITE: DJANE ARNOLD UNIT: I

REPORT NO.

PROJECT NO: CT-662

R-178

POSITION	0°	90°	180°	270°
1	1.0			
2	.75			
3	.62		N/A	
4	N/A			
5	N/A			

SYSTEM ID RECIRC


WELD ID NO. RBA-J012

CROWN HEIGHT: .05


CROWN WIDTH: .8

NOM. DIAMETER: 4.0

WELD LENGTH: 14.5

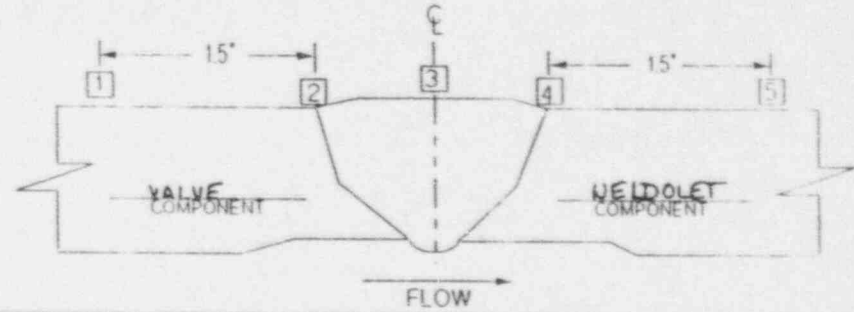

RECORD COPY

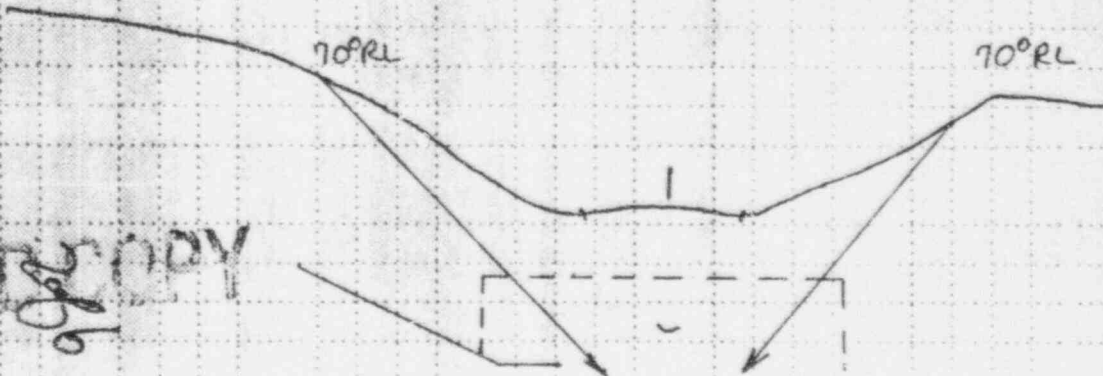

ANII
Review
7-21-90

PROPOSED COVERAGE PLOT 45° SHEAR WAVE UTILIZED ON CIRCUMFERENTIAL SCANS

70° R.L. SUPPLEMENTAL FOR AXIAL SCANS

[Signature]
Examiner

I 7-14-90
Level Date

[Signature]
Reviewed By

II 7-18-90
Level Date

KB
Reviewed By

III 7-20-90
Title Date

Page 2 of 4
FORM 1.18 1-13-90

Attachment to
NG-95-2236
Page 15 of 52




GE Nuclear Energy

ULTRASONIC EXAMINATION DATA SHEET (MANUAL PIPING)

 SITE: DUANE ARNOLD UNIT: 1
 PROJECT NO: CT-662

 REPORT NO. R-178
 CALIBRATION SHEET NO. C-118
PROCEDURE: GE-UT-102 REV 2 FRR N/ASYSTEM: RecircWELD ID: RBA-J012START TIME 0805FINISH TIME 0812MATERIAL TYPE: CS SS OTHER N/AEXAM SURFACE ID ODEXAM SURFACE TEMP 80 °FTHERMOMETER S/N 1802AXIAL SCAN SENSITIVITY 48 dBCIRC SCAN SENSITIVITY 58 dBL_o REFERENCE Rule #1 TDCW_o REFERENCE Weld Cr

1. WITH FLOW
2. AGAINST FLOW
3. CLOCKWISE
 - a. upstream b. downstream
4. COUNTER CLOCKWISE
 - a. upstream b. downstream
5. L-WAVE BASE METAL
6. OTHER N/A

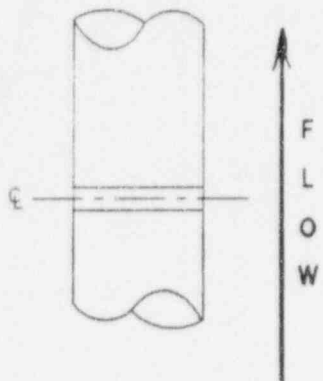

	PERFORMED		INDICATIONS	
	YES	NO	YES	NO
1		✓		✓
2		✓		✓
3a	✓			✓
3b	✓			✓
4a	✓			✓
4b	✓			✓
5		✓		✓
6		✓		✓

INDICATION NO.	L (in) FROM REF			W (in) FROM REF			MAX AMP % DAC	SWEEP READING			EXAM 1-6	NOMINAL SCANNING ANGLE
	L ₁	L _{MAX}	L ₂	W ₁	W _{MAX}	W ₂		SW ₁	SW _{MAX}	SW ₂		
NO RECORDABLE INDICATIONS											3-4	45°

 REMARKS NO EXAMS PERFORMED ON VALVE OR WELD-O-LET DUE TO COMPONENT CONFIGURATION
CIRC SCANS #3 + 4 PERFORMED ON WELD CROWN ONLY

<u>Rehltt</u> Examiner	II	7-18-90	<u>Pomilio</u> Reviewed	II	7-18-90	Page <u>3</u> of <u>4</u>
N/A Examiner	Level	Date	ICPS Reviewed	Level	Date	
				III	7-20-90	
				Title	Date	


 AP
 7-31-90



GE Nuclear Energy

ULTRASONIC EXAMINATION DATA SHEET (MANUAL PIPING)

SITE: DUANE ARNOLD UNIT: 1 REPORT NO. R-178
 PROJECT NO: CT-662 CALIBRATION SHEET NO. C-119

PROCEDURE: GE-UT-102 REV 2 FRR N/A
 SYSTEM: RECIRC
 WELD ID: RBA-J012
 START TIME: 0855
 FINISH TIME: 0910

MATERIAL TYPE: CS SS OTHER N/A
 EXAM SURFACE ID OD
 EXAM SURFACE TEMP 80 °F
 THERMOMETER S/N 1802
 AXIAL SCAN SENSITIVITY 60 dB
 CIRC SCAN SENSITIVITY 60 dB

L₀ REFERENCE Rule #1 TDC W₀ REFERENCE Weld &

1. WITH FLOW
 2. AGAINST FLOW
 3. CLOCKWISE
 a. upstream b. downstream
 4. COUNTER CLOCKWISE
 a. upstream b. downstream
 5. L-WAVE BASE METAL
 6. OTHER N/A

	PERFORMED		INDICATIONS	
	YES	NO	YES	NO
1	✓			✓
2	✓			✓
3a		✓		✓
3b		✓		✓
4a		✓		✓
4b		✓		✓
5		✓		✓
6		✓		✓

Weld-0-1ct
 IDENTITY
 VALVE
 IDENTITY

INDICATION NO.	L (in) FROM REF			W (in) FROM REF			MAX AMP % DAC	SWEEP READING			EXAM 1-6	NOMINAL SCANNING ANGLE
	L ₁	L _{MAX}	L ₂	W ₁	W _{MAX}	W ₂		SW ₁	SW _{MAX}	SW ₂		
NO RECORDABLE INDICATIONS											1-2	70° RL
RECORDED												

REMARKS SCANNED at Reference sensitivity to maintain 30% noise level
SUPPLEMENTAL EXAM PERFORMED DUE TO COMPONENT CONFIGURATION

<u>Wschlitz</u> Examiner	<u>II</u> Level	<u>7-18-90</u> Date	<u>[Signature]</u> Reviewed	<u>II</u> Level	<u>7-18-90</u> Date	Page <u>4</u> of <u>4</u>
<u>N/A</u> Examiner			<u>[Signature]</u> Reviewed	<u>III</u> Title	<u>7-20-90</u> Date	

Review
 7-31-92



GE Nuclear Energy

ULTRASONIC CALIBRATION DATA SHEET

(MANUAL EXAMINATION)

SITE: DUANE ARNOLD UNIT: 1
 PROJECT NO: CT-662

CALIBRATION SHEET NO. C-118
 LINEARITY SHEET NO. L-005

Procedure No. GE-UT-102 Rev. 2 FRR No.: N/A

Instrument KRAUTHRAMER USK-75 31459-1548
Manufacturer Model Serial No.


Search Unit KBA .25" 2.25 MHz 45°/S K24938
Manufacturer Size Freq. Angle/Mode Serial No.

Cable RG-174 6' 2
Type Length Connectors

Calibration Standard IE-17 SS .52" 78 °F
Serial No. Material Thickness Temp.

Couplant ULTRAGEL II 8976 Thermometer 1802
Brand Batch No. Serial No.

DAC

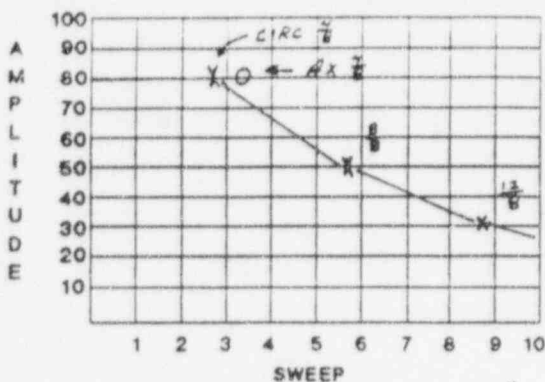

INSTRUMENT SETTINGS

DAC Construction	Sensitivity
Gain - Axial Scan <u>34</u> dB	Gain - Axial Scan <u>34</u> dB
Gain - Circ. Scan <u>44</u> dB	Gain - Circ. Scan <u>44</u> dB
Freq. <u>Auto</u>	Rep Rate <u>FIXED</u>
Range <u>.5</u>	Resolution <u>FIXED</u>
Sweep <u>989</u>	Damping <u>DOS. 1</u>
Delay <u>10.0</u>	Reject <u>OFF</u>
Filter <u>FIXED</u>	

Jack R T

FIELD SIMULATOR: N/A SIN: N/A

CALIBRATION VERIFICATION

REFLECTOR	N/A	INITIAL CALIBRATION TIME	<u>0735</u>	VERIFICATION TIMES
MAX. AMP.		FINAL VERIFICATION TIME	<u>0840</u>	
SWEEP				

WELDS EXAMINED RBA-J012 REPORT NO. R-178

COMMENTS: NONE

RECORDED
Eden

Robert II 7-18-90
Examiner Level Date
N/A N/A N/A
Examiner Level Date

[Signature] II 7-18-90
Reviewed Level Date
[Signature] III 2-20-96
Reviewed Title Date

ANII
 AP
 7-31-90



GE Nuclear Energy

ULTRASONIC CALIBRATION DATA SHEET

(MANUAL EXAMINATION)

SITE: DUANE ARNOLD UNIT: 1
 PROJECT NO: CT-662

CALIBRATION SHEET NO. C-119
 LINEARITY SHEET NO. L-005

Procedure No. GE-UT-102 Rev. 2 FRR No.: N/A

Instrument KRAUT KRAMER USK-75 31459-1548
Manufacturer Model Serial No.


Search Unit HARISONIC 1/4" x 1/2" 2.25MHZ 70°/R_L B10669
Manufacturer Size Freq. Angle/Mode Serial No.

Cable (2)RG-174 6' 4
Type Length Connectors

Calibration Standard IE-17 SS .52" 78°F
Serial No. Material Thickness Temp.

Couplant ULTRACAL II 8976 Thermometer 1802
Brand Batch No. Serial No.

DAC

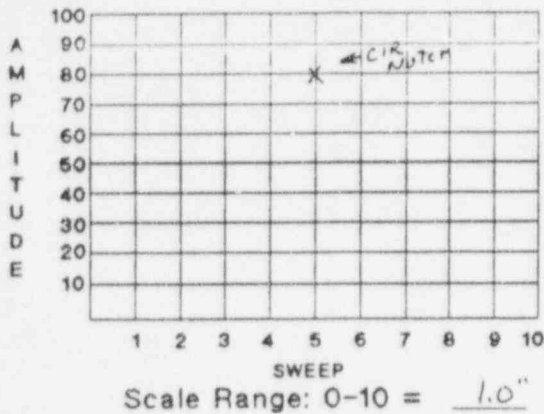

INSTRUMENT SETTINGS

DAC Construction		Sensitivity	
Gain - Axial Scan	<u>60</u> dB	Gain - Axial Scan	<u>60</u> dB
Gain - Circ. Scan	<u>60</u> dB	Gain - Circ. Scan	<u>60</u> dB
Freq.	<u>Auto</u>	Rep Rate	<u>FIXED</u>
Range	<u>.5</u>	Resolution	<u>FIXED</u>
Sweep	<u>883</u>	Damping	<u>DUAL</u>
Delay	<u>994</u>	Reject	<u>OFF</u>
Filter	<u>FIXED</u>		

Jack R T

FIELD SIMULATOR: N/A S/N: N/A

CALIBRATION VERIFICATION

REFLECTOR		INITIAL CALIBRATION TIME	<u>0850</u>	VERIFICATION TIMES	
MAX. AMP.	<u>N/A</u>	FINAL VERIFICATION TIME	<u>0955</u>	<u>N/A</u>	<u>A</u>
SWEEP		COMMENTS: <u>NONE</u>			

WELDS EXAMINED RBA-J012 REPORT NO. R-178

[Handwritten signature]

[Signature] II 7-18-90
Examiner Level Date
N/A N/A N/A
Examiner Level Date

[Signature] II 7-18-90
Reviewed Level Date
[Signature] III 7-20-90
Reviewed Title Date

Page 1 of 1

[Circular stamp and handwritten notes]

Lambert • MacGill • Thomas, Inc.



Testing • Engineering • Service • Training

515 Aldo Avenue
 Santa Clara, CA 95050
 408-980-9333

Location DAEC
 Report No. 87-431
 Cal. No. GE-11 Time 1203
 Job No. LEL-034
 Date 4-1-87
 Page 1 of 1

REPORT OF VISUAL AND ULTRASONIC EXAMINATION

PA
RF300
name

I T E M
 Description VALVE TO PIPE Size 4" Material SS S/N(s) RD-NA10-A22-F
A LOOP ISI ID: RBA-BJ-1R 10/1/87
 Location DRY WELL Preparation AS WELDED Temp. 72°F

S I G N
 Examiner/Level A. Flint Examiner/Level D.E. Coe II Review/Level DR Mac Gill II
 Authorized Inspector J. Grant 4-8-87 Customer Kennel Service 4-6-87

E Q U I P M E N T
 Tester 1 NORTEC 1310 S/N 111 2 N/A S/N N/A
 Recorder 1 N/A S/N N/A 2 N/A S/N N/A
 Transducer 57A092A, AUTOMATION, 1.5MHz N/A
3 285221 N/A 4 N/A
 Couplant LMT GEL Cable 12' COAX Marker N/A Photo N/A
702186

P R O C
 Calibration Procedure UT-41 Rev. 5, FC1-2-3
 Examination Procedure UT-41 Rev. 5, FC1-2-3
 Recording Procedure N/A Rev. N/A

C A L I B
 Calib. Blk. 80359 Temp. 68°F Ref. 1.0 NOTCH Amp. 80% Sweep 2.0
 Ref. Gain 58/60 Damp. OFF Reject OFF Gate 1-10 DIV.
 Alarm N/A Mag. Tape Count N/A Chart N/A Cal. Check Time 1232

R O M P A S
 Cal. Ref. Blk. LMT037 Ref. Refl. 1, 2" MP Amp. 75% Sweep Position 4.0, 8.0
 Scan Gain 70/72 Ref. Dwg. 1.2-19 Reject Level ASME XI Report Level ASME XI

E X A M I N A T I O N

NAD = No Apparant Disc. L = Linear G = Geometry S = Spot M = Multiples

Scan	Type	Disp.	Scan	Type	Disp.	Scan	Type	Disp.
<u>N/A</u>	<u>N/A</u>	<u>N/A</u>	<u>N/A</u>	<u>N/A</u>	<u>N/A</u>	<u>N/A</u>	<u>N/A</u>	<u>N/A</u>
<u>1</u>	<u>LW FLOW</u>	<u>N/A</u>	<u>7</u>	<u>45° SKEW FLOW</u>	<u>N/A</u>	<u>13</u>		
<u>2</u>	<u>LA FLOW</u>	<u>N/A</u>	<u>8</u>	<u>45° SKEW FLOW</u>	<u>N/A</u>	<u>14</u>		
<u>3</u>	<u>LL CW</u>	<u>NAD</u>	<u>9</u>	<u>N/A</u>	<u>N/A</u>	<u>15</u>		
<u>4</u>	<u>LL CCW</u>	<u>NAD</u>	<u>10</u>			<u>16</u>		
<u>5</u>	<u>45° SKEW FLOW</u>	<u>N/A</u>	<u>11</u>			<u>17</u>		
<u>6</u>	<u>45° SKEW FLOW</u>	<u>N/A</u>	<u>12</u>	<u>N/A</u>	<u>N/A</u>	<u>18</u>	<u>N/A</u>	<u>N/A</u>

Sketch

Scan: 1, 2, 5
6, 7, 8

Description of Indications:
NO SCAN DUE TO CONFIGURATION.

Lambert • MacGill • Thomas, Inc.

Testing • Engineering • Service • Training

515 Aldo Avenue
Santa Clara, CA 95050
408-980-9333

Location DHCL
Cal. No. GF-11 Time 1203
Job No. IEL-034
Date 4-1-87
Page 1 of 1

REPORT OF ULTRASONIC CALIBRATION

SIGN

Examiner/Level H. Flint/II Examiner/Level D.E. Coz II Review/Level D.E. Coz II
Authorized Inspector J. Coz 4-8-87 Customer Genl. Service 4-6-87

EQUIPMENT

Instrument NORTEC 131D S/N 111 ReCal Due 5-5-87 SU Cable 12' COAX
Instrument N/A S/N N/A ReCal Due N/A
Recorder N/A S/N N/A ReCal Due N/A
Recorder N/A S/N N/A ReCal Due N/A

VERTICAL LINEARITY CHECK

Check Completed by D.E. Coz

SIGNAL 1	100	90	80	70	60	50	40	30	20	10
SIGNAL 2	50	45	40	35	30	25	20	15	10	5

Signal 2 shall equal 50% of Signal 1 within $\pm 5\%$ of full scale.

AMPLITUDE CONTROL LINEARITY CHECK

Check Completed by D.E. Coz

SENSITIVITY	SET	-6	-12	SET	-12	SET	-6
ACCEPT RANGE	80%	32 to 48	18 to 24	20%	64 to 96	40%	64 to 96%
ACTUAL VALUE	XXX	40	20	XXX	80	XXX	80

Signal amplitude must fall within listed values.

SEARCH UNITS

S/N 572089 Mfg. AUTONATION Type SW Size .375" x .375" Freq. 1.5 MHz Index 3 Angle 45°
S/N N/A Mfg. N/A Type N/A Size N/A Freq. N/A Index N/A Angle N/A

PROC


Procedure UT-41 Rev 5 Date 3-7-87 Field Change 1-2-3 Date 3-27-87 FCI 2
3-17-87 FCI 3

CALIBRATION

Cal. Block Type PIPE SEGMENT S/N 80359 Ref. Refl. 1.0. NOTCH Temp. 68°F
Verification/Ref. Blk. ROMPAS S/N LMT037 Ref. Refl. 1", 2" MP Temp. 68°F

INSTRUMENT SETTINGS

	0°	Angle Beam	Digital
Gain	N/A	58/60	1.0 = 1"
Sweep		5/400	4.0 = 4"
Delay		1/342	N/A
Reject		OFF	
Damp.		OFF	
Freq.		2.25 MHz	
Video/Filt.		1+	
Rep. Rate	N/A	1K	N/A

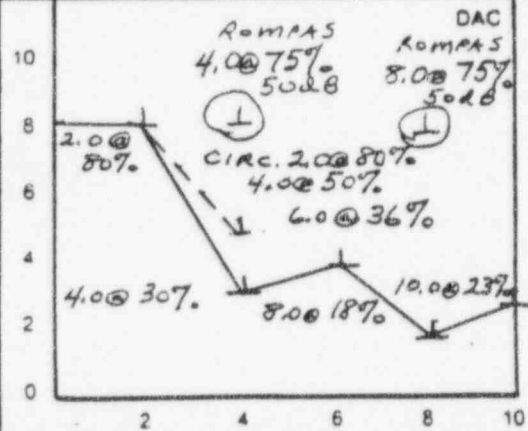

IRD	.4	.75	1.1	1.45	1.85
MP	.49	.97	1.39	1.93	2.35

DUANE ARNOLD ENERGY CENTER
2ND 10-YEAR INTERVAL
REQUEST FOR RELIEF NO. NDE-015

I SYSTEM/COMPONENT(S) FOR WHICH RELIEF IS REQUESTED

CUB-F004 Reactor Water Cleanup (RWCU) Weld

EXAMINATION CATEGORY B-F, ITEM(S) B5.130

II CODE REQUIREMENT

Section XI (1980 W81 ADD), Table IWB-2500-1 Category B-F, Item B5.130 requires a volumetric examination which includes essentially 100% of weld length once during the ten year interval.

III CODE REQUIREMENT FROM WHICH RELIEF IS REQUESTED

Relief is requested from performing essentially 100% of the weld length for RWCU Weld CUB-F004.

IV BASIS FOR RELIEF

This weld is a elbow-to-valve configuration which limits the volumetric (UT) coverage to a one-sided exam. This results in approximately 70% coverage of the weld length. In order to perform a radiograph of the weld, the RWCU System would be required to be drained, which would result in an increase in exposure to personnel by a factor of 1.7 (17 mr/hr vs 10 mr/hr) for a total of 70 mr for the additional 30% coverage. This is the additional exposure for the examination, installation and removal of insulation and shielding; it does not include any additional exposure resulting from the time spent performing valve line-ups or system draining. Examining the additional 30% of weld length has only a small potential of increasing plant safety margins and a very disproportionate impact on expenditures of plant manpower and radiation exposure.

V ALTERNATE EXAMINATIONS


IES Utilities Inc. proposes to perform volumetric examination of the 70% weld length. The alternative examination coverage allowed by Code Case N-460 will also be used.

VI JUSTIFICATION FOR THE GRANTING OF RELIEF

To perform an examination of the additional 30% of weld length, the Reactor Water Cleanup System would be required to be drained, thus increasing exposure to personnel. The benefit of examining the additional 30% has only a small potential of increasing plant safety margins and a very disproportionate impact on expenditures of plant manpower and radiation exposure to perform the radiography.

VII IMPLEMENTATION SCHEDULE

This relief request will be implemented during the 2nd Ten Year Interval. This weld was included in the Refueling Outage (RFO) 9 Summary Report.

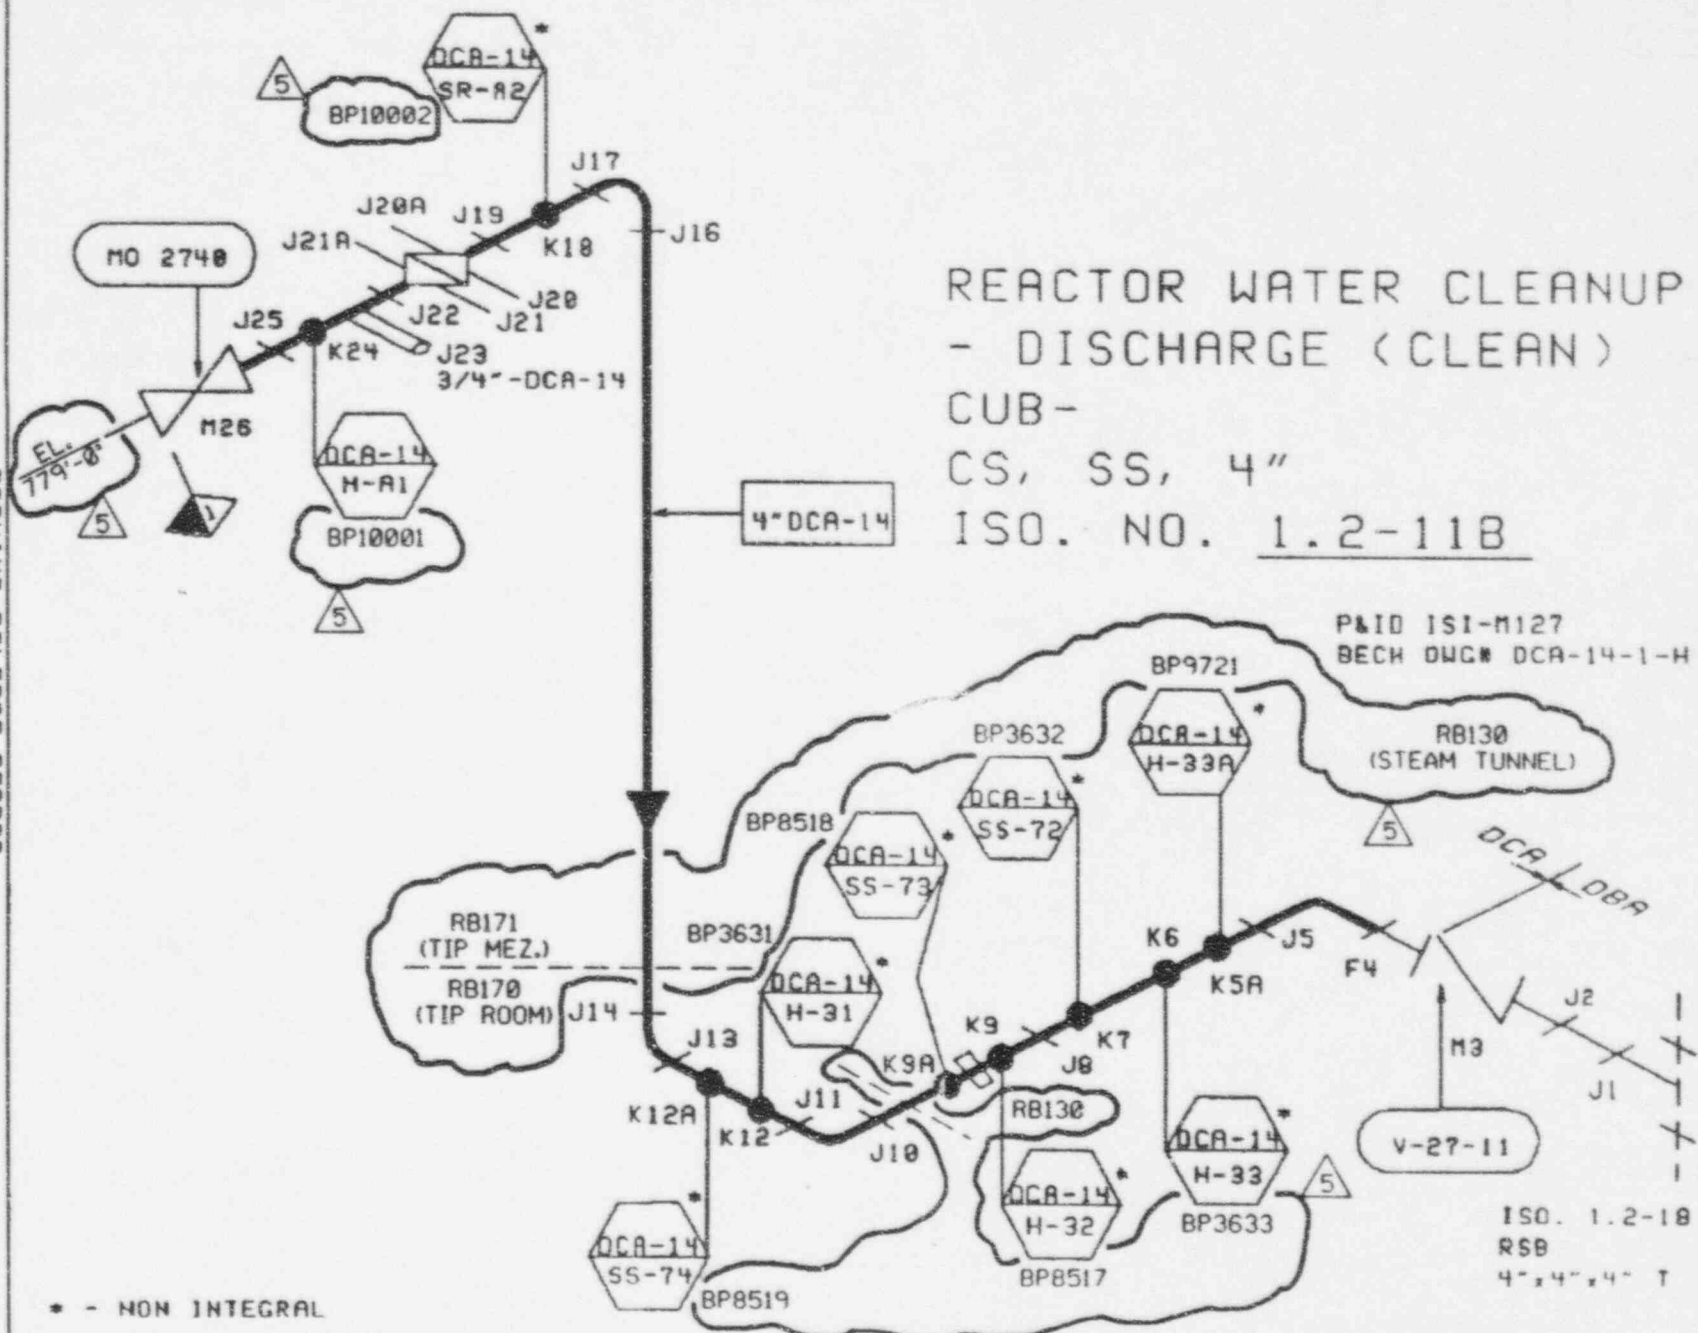

REACTOR WATER CLEANUP
 - DISCHARGE (CLEAN)
 CUB-
 CS, SS, 4"
 ISO. NO. 1.2-118

P&ID ISI-M127
 BECH DWG# DCA-14-1-H

ISO. 1.2-18
 RSB
 4" x 4" x 4" T

* - NON INTEGRAL

DRAWING RELEASE RECORD

REV	DATE	PREPARED	REVIEWED	APPROVED	PURPOSE
1	3-12-86	SNL	SNL	RCH	ISO'S FOR 2nd 10 YEAR PLAN
2	9-24-90	DA	GP	KKH	ISO'S TO CAD FORHAT AS PER MC-89-8794
3	9-24-90	DA	GP	KKH	DCP 1464, RUCU NONCLASS REPLACEMENT
4	4-2-95	DA	GP	KKH	RODED PENETRATION
5	7-24-97	DA	GP	KKH	REVISED PER ISI INSPECTION WALKDOWN

DMCC INSERVICE INSPECTION ASME SECTION XI ISOMETRIC

Lambert • MacGill • Thomas, Inc.



Testing • Engineering • Service • Training

515 Aldo Avenue
 Santa Clara, CA 95050
 408-980-9333

Report No. 88-181
 Cal. No. LR0009 Time 204
 Job No. IEL-039
 Date 10-8-88
 Page 1 of 1


REPORT OF VISUAL AND ULTRASONIC EXAMINATION

I T E M	Description <u>FL/VALVE</u> Size <u>4"</u> Material <u>SS</u> S/N(s) <u>CUB-BF-4</u>
	Location <u>STEAM TUNNEL</u> Preparation <u>AS FOUND</u> Temp <u>95°F</u>
S I G N	Examiner/Level <u>R Davis II</u> Examiner/Level <u>DA Affelt</u> Review/Level <u>DA Affelt</u>
	Authorized Inspector <u>R Davis II</u> Customer <u>Kevin P. Schneider</u>
E Q U I P M E N T	Tester 1 <u>NORTEC 131-D S/N 167</u> 2 <u>NA</u> S/N <u>NA</u>
	Recorder 1 <u>NA</u> S/N <u>NA</u> 2 <u>NA</u> S/N <u>NA</u>
	Transducer 1 <u>5" KBA 15M2 #H10142</u> 2 <u>NA</u>
	3 <u>NA</u> 4 <u>NA</u>
	Couplant <u>5488</u> Cable <u>6' ENC/MP</u> Marker <u>NA</u> Photo <u>NA</u>
P R O C	Calibration Procedure <u>UT-41</u> Rev. <u>8 FC-2</u>
	Examination Procedure <u>UT-41</u> Rev. <u>8 FC-2</u>
	Recording Procedure <u>UT-41</u> Rev. <u>8 FC-2</u>
C A L I B	Calib. Blk. <u>80359</u> Temp. <u>98°F</u> Ref. <u>ID NOTCH</u> Amp. <u>80%</u> Sweep <u>2.0 div</u>
	Ref. Gain <u>47dB</u> Damp. <u>OFF</u> Reject <u>OFF</u> Gate <u>1.5-10 div</u>
	Alarm <u>NA</u> Mag. Tape Count <u>NA</u> Chart <u>NA</u> Cal. Check Time <u>2059</u>

Cal. Ref. Blk. 80359 Ref. Refl. ID NOTCH Amp. 80% Sweep Position 2.0 div
 Scan Gain 59dB Ref. Dwg. 12-11B Reject Level NA Report Level PER PROC.

NAD = No Apparant Disc. L = Linear G = Geometry S = Spot M = Multiples

Scan	Type	Disp.	Scan	Type	Disp.	Scan	Type	Disp.
1	T WITH FLOW	NAD	7	NA	NA	13	NA	NA
2	NA	NA	8			14		
3	II CW	NAD	9			15		
4	II CCW	NAD	10			16		
5	SCW CW FLOW	IVAD	11			17		
6	SCW CCW FLOW	NAD	12			18		

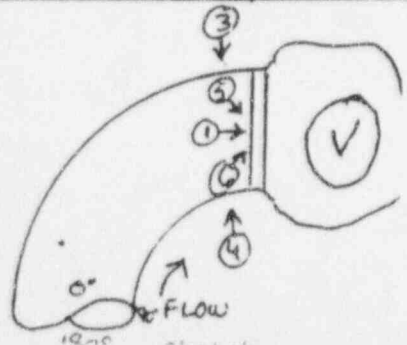

Scan	Description of Indications
1	ID GEO. LESS THAN 50% DAC
2, 7 & 8	NO SCAN DUE TO VALVE CONFIG & CS
3 & 4	LIMITED TO WELD AND UP SIDE ONLY

Lambert • MacGill • Thomas, Inc.

Testing • Engineering • Service • Training
 515 Aldo Avenue
 Santa Clara, CA 95054
 408-980-9333

Location DAEC
 Cal No 40-009 Time 1955
 Job No IEL-058
 Date 10-9-88
 Page 1 of 1

REPORT OF ULTRASONIC CALIBRATION

FOR:

SIGN
 Examiner/Level LR Davis II Examiner/Level DAAFFELDT II Review/Level DAFFELDT II
 Authorized Inspector DAFFELDT II Customer Kevin P. Schneider

EQUIPMENT
 Instrument NORTEC 131-D SIN 167 ReCal Due 12-1-88 SU Cable GONC/190
 Instrument NA SIN NA ReCal Due NA
 Recorder NA SIN NA ReCal Due NA

VERTICAL LINEARITY CHECK

SIGNAL 1	100	90	80	70	60	50	40	30	20	10
SIGNAL 2	50	45	40	35	31	26	20	15	10	5

Signal 2 shall equal 50% of Signal 1 within ± 5% of full scale

AMPLITUDE CONTROL LINEARITY CHECK

SENSITIVITY	SET	-8	-12	SET	+12	SET	+8
ACCEPT RANGE	80%	32 to 48	18 to 24	20%	84 to 96	40%	64 to 96
ACTUAL VALUE	XXX	40	20	XXX	80	XXX	80

Signal amplitude must fall within listed values.

SEARCH UNITS


SIN H10142 Mfg. KBA Type SW Size 1.5" Ø Freq. 1.5MHZ Index Angle 45°
 SIN NA Mfg. NA Type NA Size NA Freq. NA Index NA Angle NA
 Couplant LMT GEL Batch No. 5458

PROC
 Procedure UT 41 Rev. 8 Date 8-9-88 Field Change FC 2 Date 10-6-88

Cal. Block Type PIPE SEG SIN 80359 Ref. Refl. ID NOTCH Temp. 90°F
 Verification/Ref. Blk. ROMPAS SIN 050 Ref. Refl. DIG. ONLY Temp. 90°F

CALIBRATION

INSTRUMENT SETTINGS			
	0°	Angle Beam	Digital
Gain	NA	47dB	NA
Sweep		25/588	
Delay		11436	
Reject		OFF	
Damp.		OFF	
Freq		WB	
Video/Filt.		+	
Rep. Rate		25K	

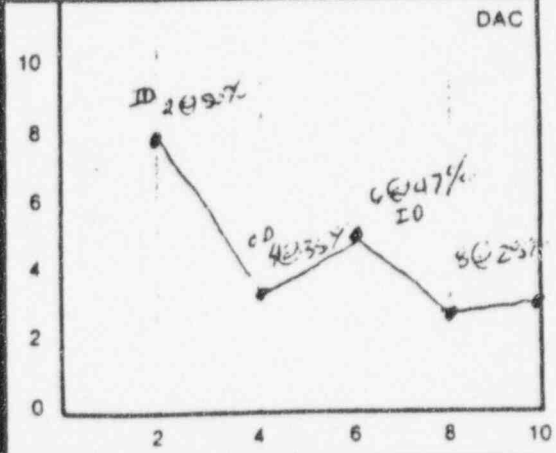

DAC	CAL CHECK TIME
	2009
	2038
	2040
	2054
	FINAL
	2133
	2030%

IRD	35	.7	1.05	1.35	1.75
MP	48	.98	1.48	1.97	2.50

DUANE ARNOLD ENERGY CENTER
2ND 10-YEAR INTERVAL
REQUEST FOR RELIEF NO. NDE-016

I SYSTEM/COMPONENT(S) FOR WHICH RELIEF IS REQUESTED

RHB-J002 Residual Heat Removal (RHR) Weld

EXAMINATION CATEGORY B-J, ITEM(S) B9.31

II CODE REQUIREMENT

Section XI (1980 W81 ADD), Table IWB-2500-1 Category B-J, Item B9.31 requires a volumetric and surface examination which includes essentially 100% of weld length once during the ten year interval.

III CODE REQUIREMENT FROM WHICH RELIEF IS REQUESTED

Relief is requested from performing volumetric examination of essentially 100% of the weld length for RHR Weld RHB-J002.

IV BASIS FOR RELIEF

This weld is a branch connection-to-weldolet configuration which limits the volumetric (UT) coverage to a one-sided exam. This results in approximately 75% coverage of the weld length. Performing a radiograph of the weld would require the RHR System to be drained, which would increase exposure to personnel by a factor of 1.7 due simply to the pipe being empty (340 mr/hr vs 200 mr/hr) for a total of 140 mr for the additional 25% coverage. This is the additional exposure for the examination, installation and removal of insulation and shielding; it does not include any additional exposure resulting from the time spent performing valve line-ups or system draining. Examining the additional 25% of weld length has only a small potential for increasing plant safety margins and a very disproportionate impact on expenditures of plant manpower and radiation exposure.

V ALTERNATE EXAMINATIONS

IES Utilities Inc. proposes to perform volumetric examination of the 75% weld length. The alternative examination coverage allowed by Code Case N-460 will also be used.

VI JUSTIFICATION FOR THE GRANTING OF RELIEF

To perform an examination of the additional 25% of weld length, the RHR System would be required to be drained, thus increasing exposure to personnel. Examining the additional 25% of weld length has only a small potential of increasing plant safety margins and a very disproportionate impact on expenditures of plant manpower and radiation exposure to perform the radiography.

VII IMPLEMENTATION SCHEDULE

This relief request will be implemented during the 2nd Ten Year Interval. This weld was included in the Refueling Outage (RFO) 13 Summary Report.



GE Nuclear Energy

EXAMINATION SUMMARY SHEET

REPORT NO.:
 195039

PROJECT: DUANE ARNOLD 1DX36 Task: 1FJPV	PROCEDURE: UT-DAC-102V0	REV: 0	FRR: N/A
SYSTEM: RHR	2162.1	REV: 2	FRR: N/A
WELD NO.: RHB-J002			N/A
CONFIGURATION: PIPE TO BRANCH CONNECTION	N/A	REV: N/A	FRR: N/A
EXAMINER: D. HEBERT	LEVEL: II		
EXAMINER: H. KOMPENIEN	LEVEL: II		
EXAMINER: N/A	LEVEL: N/A		
		<input type="checkbox"/> MT <input checked="" type="checkbox"/> PT <input checked="" type="checkbox"/> UT <input type="checkbox"/> VT	
		<input checked="" type="checkbox"/> CIRCUMFERENTIAL	
		WELD TYPE: <input type="checkbox"/> LONGITUDINAL <input type="checkbox"/> OTHER N/A	
DATA SHEET NO.(S): DM-073 DM-074 PT-013	CAL SHEET NO.(S): CM-074 CM-075		

During the manual ultrasonic examination of RHB-J002, no recordable indications as per ASME Section XI or NUREG 0313 were detected utilizing a 45° shear wave search unit

No examination was performed downstream due to the branch connection.

A supplemental 60° RL examination was performed, to increase required Code examination coverage, and resulted in no recordable indications.

A liquid penetrant examination was performed prior to the ultrasonic examination resulting in no recordable indications.

Examined 75% of the Code required volume.

<input type="checkbox"/> EXAM COMPLETE	<input checked="" type="checkbox"/> PARTIALLY EXAMINED (EXPLAIN IN COMMENTS)	<input type="checkbox"/> EXAM COMPLETE IN COMBINATION WITH DATA SHEETS BELOW	RWP NO.: 40213
ADDITIONAL DATA SHEETS: N/A	COMPARED TO: <input type="checkbox"/> PSI <input checked="" type="checkbox"/> ISI REPORT NO.(S): 93-209	NO. OF RECORDABLE INDICATIONS: 0	TOTAL DOSE
EXAMINATION RESULTS: <input checked="" type="checkbox"/> ACCEPTABLE	<input type="checkbox"/> UNACCEPTABLE	NO. OF REPORTABLE INDICATIONS: 0	050 MAN REM
10-2444	II	3-30-95	3-30-95
SUMMARY BY	LEVEL	DATE	UTILITY LEVEL IN REVIEW
GE REVIEWED BY	LEVEL	DATE	DATE
	III	3/30/95	3-31-95
			ANII REVIEW



GE Nuclear Energy

WALL THICKNESS PROFILE SHEET

SITE: DUANE ARNOLD UNIT: 1

REPORT NO.: 195039

PROJECT: 1DX36 TASK: IFJPV

SYSTEM: RHR

COMPONENT ID NO.: RHB-J002



POSITION	0°	90°	180°	270°
1	1.04"	N/A	N/A	N/A
2	1.04"	N/A	N/A	N/A
3	N/A	N/A	N/A	N/A
4	.96"	N/A	N/A	N/A
5	.96"	N/A	N/A	N/A

CROWN HEIGHT: FLUSH

CROWN WIDTH: .70"

NOM DIAMETER: 4.0"

WELD LENGTH: 19.50"

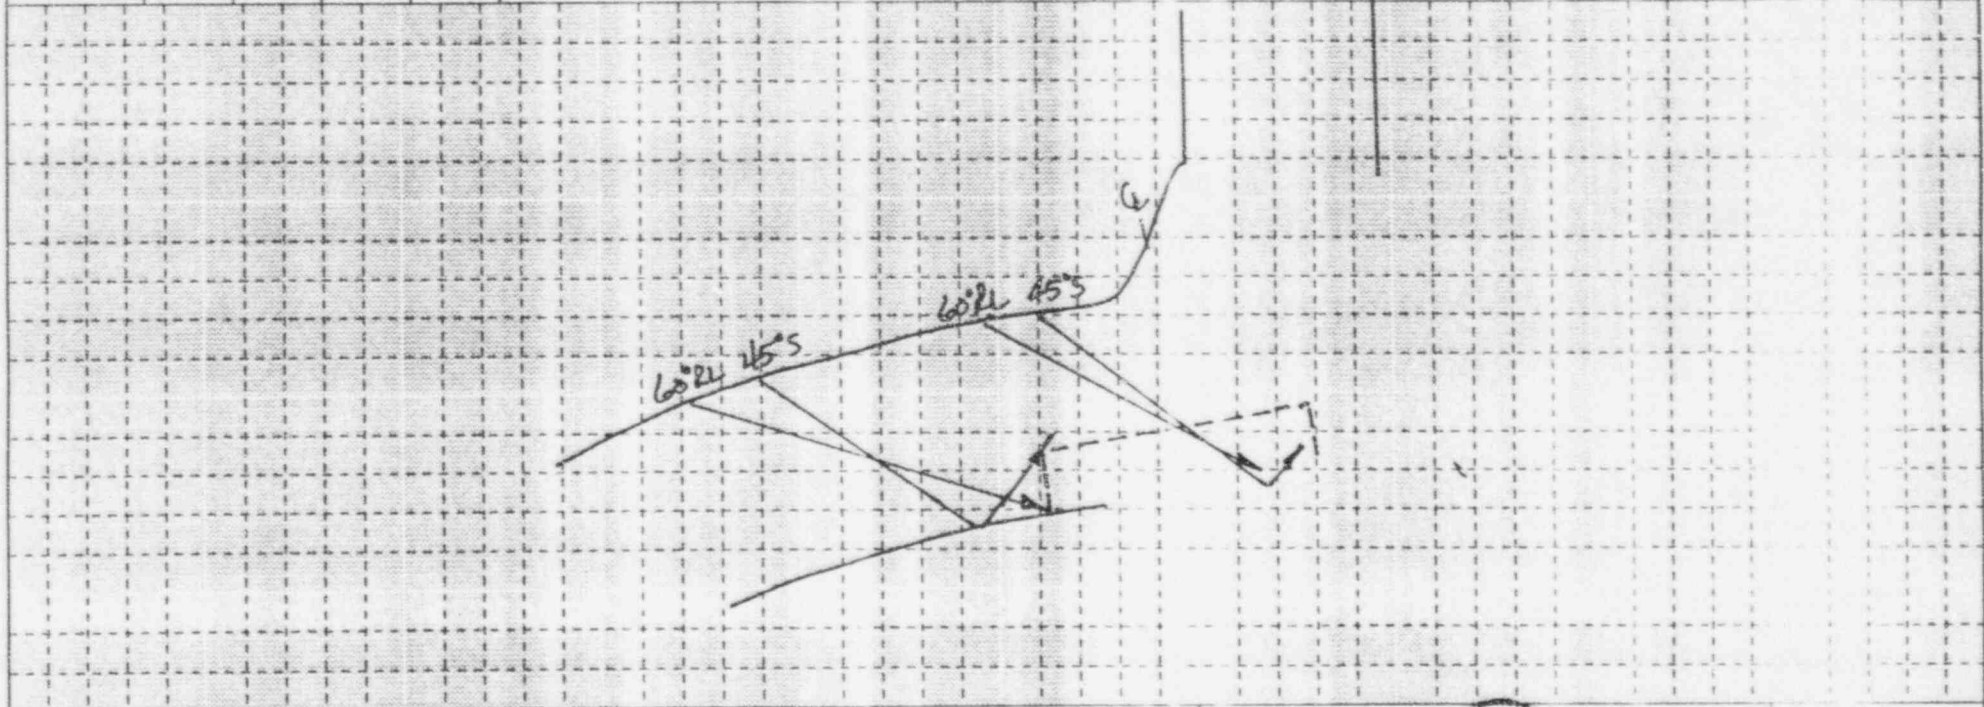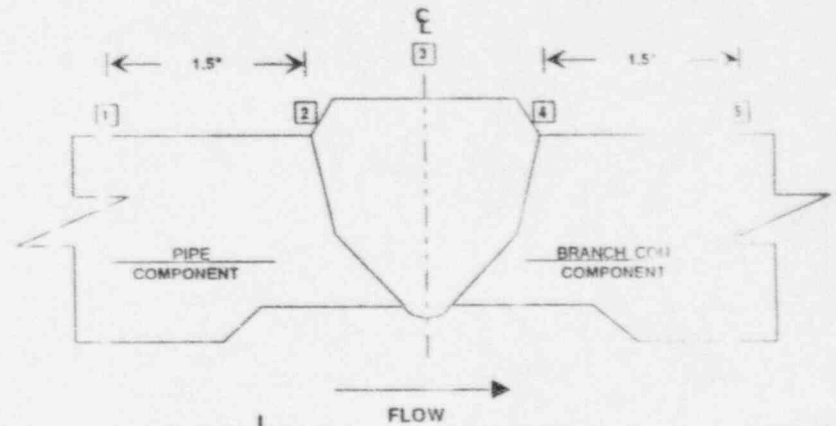

D-2/HM
DRAWN BY
Ed Bonnell
GE REVIEWED BY

II 3-25-95
LEVEL DATE
III 3/30/95
LEVEL DATE

Frank DeLeon 3-30-95
UTILITY LEVEL III REVIEW DATE

William M. ... 3-31-95
ANII REVIEW DATE

PAGE: 2 OF: 8

Attachment to NG-95-2236 Page 28 of 52



GE Nuclear Energy


EXAM PLAN

SITE: DUANE ARNOLD UNIT: 1

REPORT NO.:

PROJECT: 1DX36 TASK: 1FJPV

1950 19

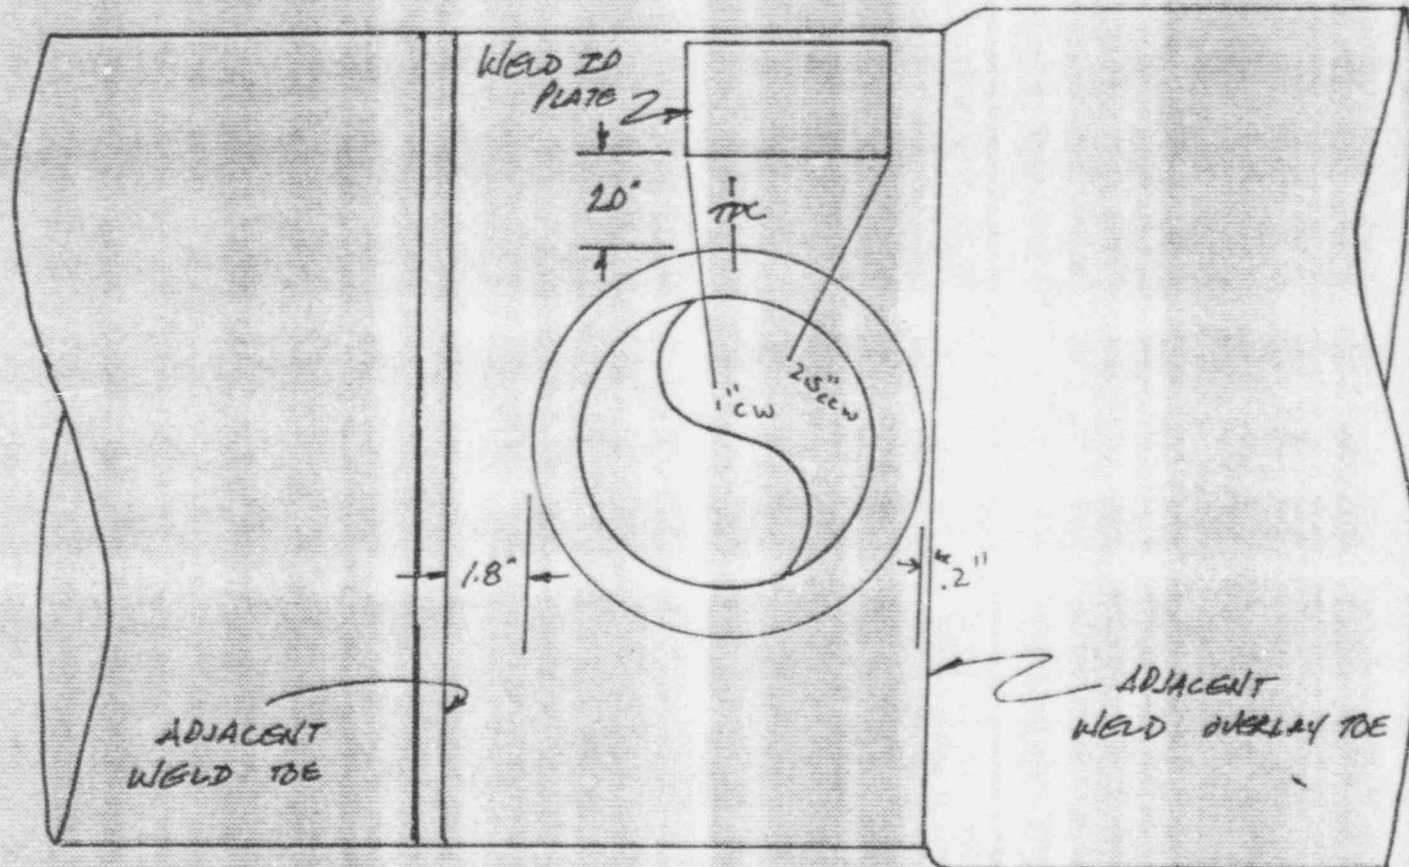

TAKEN FROM PREVIOUS DATA

P-244
 DRAWN BY
Bob Maxwell
 GE REVIEWED BY

II 3-25-95
 LEVEL DATE
III 3/30/95
 LEVEL DATE

Paul Dolan
 UTILITY LEVEL III REVIEW
 3-30-95
 DATE

William M. [Signature]
 ANI REVIEW
 3-31-95
 DATE

PAGE OF 8

Attachment to NG-95-2236 Page 29 of 52



GE Nuclear Energy

**ULTRASONIC EXAMINATION DATA SHEET
 (MANUAL PIPING)**

SITE: DUANE ARNOLD UNIT: 1 REPORT NO.: 195039
 PROJECT NO.: 1DX36 TASK:1FJPV CALIBRATION SHEET NO.: CM-074
 DATA SHEET NO.: DM-073


PROCEDURE NO.: UT-DAC-102V0 REVISION: 0 FRR: N/A

SYSTEM: RHR EXAM SURFACE TEMP: 74 °F COUPLANT: HUMEX EXAM START: 10:50
 WELD ID: RHB-J002 THERMOMETER S/N: 145795 BATCH NO.: 94165 EXAM END: 11:03

SEARCH UNIT: 45° / SHR EXAMINATION SURFACE: ID OD MATERIAL TYPE: CS SS OTHER: N/A
 Lo REFERENCE: TOP DEAD CENTER AXIAL SCAN SENSITIVITY (dB) 56.0
 Wo REFERENCE: WELD CENTERLINE CIRC SCAN SENSITIVITY (dB) 63.0

- AXIAL: { 1 WITH FLOW
 2 AGAINST FLOW
 CIRC CW: { 3 UPSTREAM
 4 DOWNSTREAM
 CIRC CCW: { 5 UPSTREAM
 6 DOWNSTREAM
 7 L-WAVE BASE METAL
 8 OTHER N/A

PERFORMED		INDICATIONS	
YES	NO	YES	NO
X			X
	X		
X			X
	X		
X			X
	X		
	X		
	X		

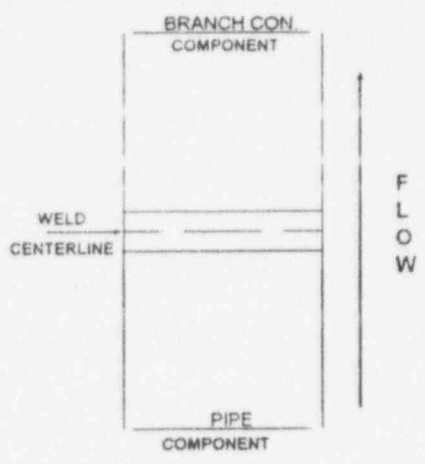

INDICATION NO.	L (in) FROM REF			W (in) FROM REF			SWEEP READING			MAX AMP % DAC	EXAMINATION (1-8)
	L-1	L-MAX	L-2	W-1	W-MAX	W-2	SW-1	SW-MAX	SW-2		
NRI											
N/A											

REMARKS:
 Scans performed at gain level below required scanning sensitivity in order to maintain a 10-30% average ID noise level.
 No examination was performed downstream due to the branch configuration.
 The upstream examination was limited to "L" = 2.4" to 7.2" due to adjacent circumferential weld, overlay, and weld ID plate. (Refer to Exam plan.)

D-ZAH II 3-25-95 Paul D. ... 3-30-95
 EXAMINER LEVEL DATE UTILITY LEVEL III REVIEW DATE
Bill ... III 3-20-95 William ... 3-31-95
 GE REVIEWED BY LEVEL DATE ANII REVIEW DATE
 PAGE: 4 OF 8
 FORM UT-95 REV 3



GE Nuclear Energy

ULTRASONIC EXAMINATION DATA SHEET (MANUAL PIPING)

SITE: DUANE ARNOLD UNIT: 1 REPORT NO.: 195039
 PROJECT NO.: 1DX36 TASK:1FJPV CALIBRATION SHEET NO.: CM-075
 DATA SHEET NO.: DM-074

PROCEDURE NO.: UT-DAC-102V0 REVISION: 0 FRR: N/A

SYSTEM: RHR EXAM SURFACE TEMP: 74 °F COUPLANT: HUMEX EXAM START: 11:05
 WELD ID: RHB-J002 THERMOMETER S/N: 145795 BATCH NO.: 94165 EXAM END: 11:10

SEARCH UNIT: 60° / RL EXAMINATION SURFACE: ID OD MATERIAL TYPE: CS SS OTHER: N/A
 Lo REFERENCE: TOP DEAD CENTER AXIAL SCAN SENSITIVITY (dB) 77.4
 Wo REFERENCE: WELD CENTERLINE CIRC SCAN SENSITIVITY (dB) N/A

	PERFORMED		INDICATIONS	
	YES	NO	YES	NO
AXIAL: {	1 WITH FLOW	X		X
	2 AGAINST FLOW		X	
CIRC CW: {	3 UPSTREAM		X	
	4 DOWNSTREAM		X	
CIRC CCW: {	5 UPSTREAM		X	
	6 DOWNSTREAM		X	
	7 L-WAVE BASE METAL		X	
	8 OTHER <u>N/A</u>		X	

INDICATION NO.	L (in) FROM REF			W (in) FROM REF			SWEEP READING			MAX AMP % DAC	EXAMINATION (1-8)
	L-1	L-MAX	L-2	W-1	W-MAX	W-2	SW-1	SW-MAX	SW-2		
NRI											
N/A											

REMARKS:

Scans performed at gain level below required scanning sensitivity in order to maintain a 10-30% average ID noise level.
 No examination was performed downstream due to the branch configuration.
 The upstream examination was limited to "L" = 2.4" to 7.2" due to adjacent circumferential weld, overlay, and weld ID plate. (Refer to Exam plan.)

<u>19-2444</u>	<u>II</u>	<u>3-25-95</u>	<u>Frank Doherty</u>	<u>3-30-95</u>	
EXAMINER	LEVEL	DATE	UTILITY LEVEL III REVIEW	DATE	
<u>[Signature]</u>	<u>III</u>	<u>3-30-95</u>	<u>William [Signature]</u>	<u>3-31-95</u>	
GE REVIEWED BY	LEVEL	DATE	ANII REVIEW	DATE	


**RECORD OF NONDESTRUCTIVE EXAMINATION
 LIQUID PENETRANT PT-1**

CMAR NO N/A MIF STEP N/A DCP/PMP NO N/A TRAVELER NO N/A INDEX ITEM N/A
 GIR NO N/A ISI NO I95039 AR NO N/A Temp. 70 ° F
 COMPONENT OR SYSTEM RHB-1002 DWG. OR ISO NO 1.2-14
 THICKNESS .960" PROCEDURE NO 2162.1 REV 2 ACCEPT STD 6.7.4.7 ^{Feb 4/21/95}
 LIGHT METER ID/DUE DATE N/A BLACK LIGHT INTENSITY ($\mu\text{W}/\text{cm}^2$) N/A

ITEM	INITIAL INSPECTION		DEFECT CODE*	INITIAL INSPECTION REMARKS (SIZE/LOCATION)	REINSPECTION		DEFECT CODE*	REINSPECTION REMARKS (SIZE/LOCATION)
	ACC	REJ			ACC	REJ		
RHB 1002	<input checked="" type="checkbox"/>	<input type="checkbox"/>		No RECORABLE INDICATIONS	<input type="checkbox"/>	<input type="checkbox"/>		
				N	A			

*DEFECT CODE

P - POROSITY, R - ROUNDED, LI - LINEAR INDICATION, LA - LAMINATION, O - OTHER (IDENTIFY)

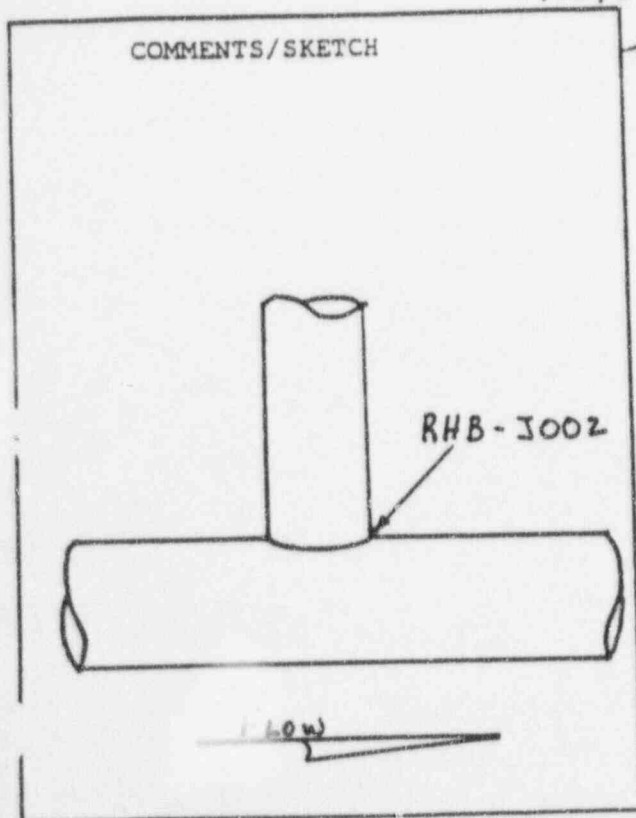

100% 99% BB 3/2/95
 100% Weld Examined

Previous Inspection Data Reviewed Yes No NA AK Init.

PENETRANT MATERIALS: Magnaflux

MATERIAL	TYPE	BATCH
CLEANER	<u>SKC-S</u>	<u>94L07K</u>
PENETRANT	<u>SKL-HF/S</u>	<u>88L003</u>
DEVELOPER	<u>SKD-NF</u>	<u>90F07P</u>

EXAMINER: Harvey Kompelin / II / 3-24-95
 SIGNATURE/LEVEL/DATE
 REVIEWED BY: Frank [Signature] 3-30-95
 LEVEL III SIGNATURE/DATE
 REVIEWED BY: William [Signature] 3-31-95 ^{W.O.M.}
 ANII SIGNATURE/DATE ⁴⁻²⁷⁻⁹⁵



GE Nuclear Energy

ULTRASONIC CALIBRATION DATA SHEET
(MANUAL EXAMINATION)


SITE: DUANE ARNOLD UNIT: 1 CALIBRATION SHEET NO.: CM-074

PROJECT NO.: 1DX36 TASK: 1FJPV LINEARITY SHEET NO.: L-015

PROCEDURE NO.: UT-DAC-102V0 REVISION: 0 FRR: N/A

Instrument STAVELEY SONIC 136 7661
Manufacturer Model No. Serial No.
 Search Unit KBA K10900 50" 1.50 MHz 45° / SHR 40"
Manufacturer Serial No. Size Freq. Angle/Mode incident to wedge front
 Cable RG-174 6' 2
Type Length No. of Connectors
 Calibration Standard IE-54 SS 960" 70 °F
Serial No. Material Thickness Temp.
 Couplant HUMEX 94165 Thermometer 145795
Type Batch No. Serial No.

DAC

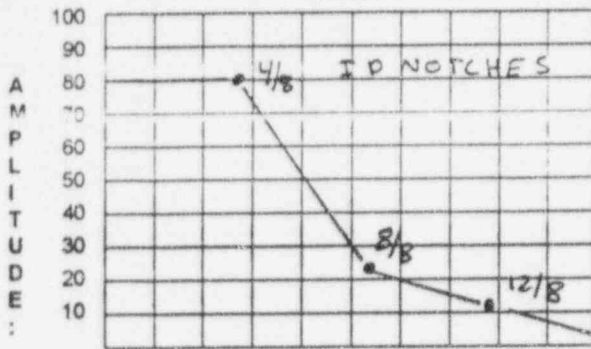

SWEEP: 0 - 10 = 50"

DEPTH METAL PATH

INSTRUMENT SETTINGS

<u>DAC Construction</u>	<u>Sensitivity</u>
Gain - Axial Scan <u>49.0</u>	Gain - Axial Scan <u>49.0</u>
Gain - Circ. Scan <u>56.2</u>	Gain - Circ. Scan <u>56.2</u>
Pulse <u>222 ns</u>	Range <u>5.00"</u>
Damping <u>500 ohms</u>	Delay <u>400"</u>
Rep Rate <u>4.0 KHz</u>	Velocity <u>128 in/us</u>
Filter <u>2</u>	Sweep <u>N/A</u>
Frequency <u>2.25 MHz</u>	Resolution <u>N/A</u>
Reject <u>OFF</u>	Jack <input type="checkbox"/> R <input checked="" type="checkbox"/> T

Field Simulator: ROMPUS S/N: CAL-RHQM-021

CALIBRATION VERIFICATION

REFLECTOR:	NEAR SDH	FAR SDH	INITIAL CALIBRATION TIME	08:38	VERIFICATION TIMES
MAX AMPLITUDE:	58%	50%			
SWEEP:	1.45"	1.10"	FINAL VERIFICATION TIME	13:01	N/A N/A
GAIN:	49.0	49.0			N/A N/A

WELDS EXAMINED REPORT NO. COMMENTS:

WELDS EXAMINED	REPORT NO.	COMMENTS:
RHB-J002	195039	N/A

D-2444 II 3-25-95
EXAMINER LEVEL DATE
Ed Aminelli III 3/30/95
GE REVIEWED BY LEVEL DATE

Frank Deiner 3-30-95
UTILITY LEVEL III REVIEW DATE
William T. ... 3-31-95
ANII REVIEW DATE



GE Nuclear Energy

ULTRASONIC CALIBRATION DATA SHEET

(MANUAL EXAMINATION)

SITE: DUANE ARNOLD UNIT: 1 CALIBRATION SHEET NO.: CM-075

PROJECT NO.: 1DX36 TASK: 1FJPV LINEARITY SHEET NO.: L-015

PROCEDURE NO.: UT-DAC-102V0 REVISION: 0 FRR: N/A

Instrument STAVELEY SONIC 136 7661
Manufacturer Model No. Serial No.


Search Unit HARISONIC H4029 2(.25x.50)in 3.50 MHz 60°/RI 60°
Manufacturer Serial No. Size Freq. Angle/Mode Incident to wedge front

Cable 2(RG-174) 2(6') 4
Type Length No. of Connectors

Calibration Standard IE-54 SS 960" 70 °F
Serial No. Material Thickness Temp.

Couplant HUMEX 94165 Thermometer 145795
Type Batch No. Serial No.

DAC

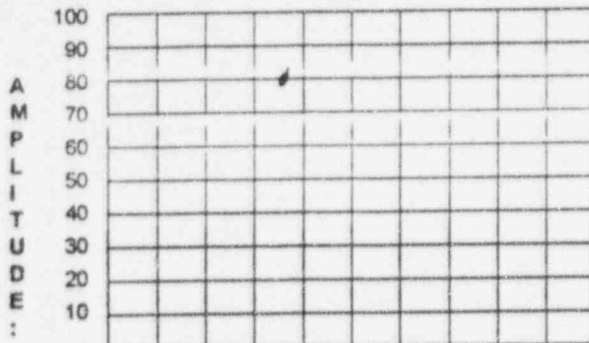

SWEEP: 0 - 10 = 5.0"

DEPTH METAL PATH

INSTRUMENT SETTINGS

DAC Construction Sensitivity

Gain - Axial Scan 77.4 Gain - Axial Scan 77.4

Gain - Circ. Scan N/A Gain - Circ. Scan N/A

Pulse 100 ns Range 5.00"

Damping 500 ohms Delay 602"

Rep Rate 2.0 KHz Velocity 232 in/us

Filter 1 Sweep N/A

Frequency 5.00 MHz Resolution N/A

Reject OFF Jack R T

Field Simulator: ROMPUS S/N: CAL-RHOM-021

CALIBRATION VERIFICATION

REFLECTOR:	N/A	FAR SDH	INITIAL CALIBRATION TIME	09:15	VERIFICATION TIMES	
MAX AMPLITUDE:	N/A	80%	FINAL VERIFICATION TIME	13:03	11:04	N/A
SWEEP:	N/A	1.5"			N/A	N/A
GAIN:	N/A	77.4				

WELDS EXAMINED REPORT NO. COMMENTS:

RHB-J002 195039 N/A

D-2 HHH II 3-25-95 Frank D... 3-30-95
EXAMINER LEVEL DATE UTILITY LEVEL III REVIEW DATE

Bob Amicelli III 3/30/95 Willie... 3-31-95
GE REVIEWED BY LEVEL DATE ANII REVIEW DATE

DUANE ARNOLD ENERGY CENTER
2ND 10-YEAR INTERVAL
REQUEST FOR RELIEF NO. NDE-017

I SYSTEM/COMPONENT(S) FOR WHICH RELIEF IS REQUESTED

RBB-J006 Recirculation Bypass Weld

EXAMINATION CATEGORY B-J, ITEM(S) B9.11

II CODE REQUIREMENT

Section XI (1980 W81 ADD), Table IWB-2500-1 Category B-J, Item B9.11 requires a volumetric and surface examination which includes essentially 100% of weld length once during the ten year interval.

III CODE REQUIREMENT FROM WHICH RELIEF IS REQUESTED

Relief is requested from performing volumetric examination of essentially 100% of the weld length for Recirculation Bypass Weld RBB-J006.

IV BASIS FOR RELIEF

This weld is a pipe-to-tee configuration which limits the volumetric (UT) coverage to a one-sided exam. This results in approximately 84% coverage of the weld length. Performing a radiograph of the weld would require the Recirculation System to be drained, which would increase exposure to personnel by a factor of 1.7 due simply to the pipe being empty (170 mr/hr vs 100 mr/hr) for a total of 140 mr for the additional 16% coverage. This is the additional exposure for the examination, inspection and removal of insulation and shielding; it does not include any additional exposure resulting from the time spent performing valve line-ups or system draining. Examining the additional 16% of weld length has only a small potential for increasing plant safety margins and a very disproportionate impact on expenditures of plant manpower and radiation exposure.

V ALTERNATE EXAMINATIONS

IES Utilities Inc. proposes to perform volumetric examination of the 84% weld length. The alternative examination coverage allowed by Code Case N-460 will also be used.

VI JUSTIFICATION FOR THE GRANTING OF RELIEF

To perform an examination of the additional 16% of weld length, the Recirculation System would be required to be drained, thus increasing exposure to personnel. Examining the additional 25% of weld length has only a small potential for increasing plant safety margins and a very disproportionate impact on expenditures of plant manpower and radiation exposure to perform the radiography.

VII IMPLEMENTATION SCHEDULE

This relief request will be implemented during the 2nd Ten Year Interval. This weld was included in the Refueling Outage (RFO) 13 Summary Report.



GE Nuclear Energy

EXAMINATION SUMMARY SHEET

REPORT NO.:
195043

PROJECT: <u>DUANE ARNOLD</u> <u>1DX36 Task: 1EJPV</u>	PROCEDURE: <u>UT-DAC-102V0</u> REV: <u>0</u> FRR: <u>N/A</u> <u>N/A</u> <u>N/A</u>
SYSTEM: <u>RECIRCULATION</u>	<u>2162.1</u> REV: <u>2</u> FRR: <u>N/A</u> <u>N/A</u> <u>N/A</u>
WELD NO.: <u>RBB-J006</u>	<u>N/A</u> REV: <u>N/A</u> FRR: <u>N/A</u> <u>N/A</u> <u>N/A</u>
CONFIGURATION: <u>PIPE TO TEE</u>	
EXAMINER: <u>D. HEBERT</u> LEVEL: <u>II</u>	<input type="checkbox"/> MT <input checked="" type="checkbox"/> PT <input checked="" type="checkbox"/> UT <input type="checkbox"/> VT
EXAMINER: <u>J. SHEA</u> LEVEL: <u>II</u>	<input checked="" type="checkbox"/> CIRCUMFERENTIAL
EXAMINER: <u>N/A</u> LEVEL: <u>N/A</u>	WELD TYPE: <input type="checkbox"/> LONGITUDINAL <input type="checkbox"/> OTHER <u>N/A</u>
DATA SHEET NO.(S): <u>DM-051</u> <u>DM-052</u> <u>PT-006</u>	CAL SHEET NO.(S): <u>CM-052</u> <u>CM-053</u>

During the manual ultrasonic examination of RBB-J006, no recordable indications as per ASME Section XI and NUREG 0313 were detected utilizing a 45° shear wave search unit.

No examination was performed downstream due to the Tee configuration

A supplemental 60° PL examination was performed, to increase required Code examination coverage, and resulted in no recordable indications

A liquid penetrant examination was performed prior to the ultrasonic examination resulting in no recordable indications.

~~Examined 63% of the Code required volume.~~ *BB 4/1/95*

Examined 84% of the Code required volume. Refer to Attachment 1, EPRI Raytrace Coverage Plot.

<input checked="" type="checkbox"/> EXAM COMPLETE	<input type="checkbox"/> PARTIALLY EXAMINED (EXPLAIN IN COMMENTS)	<input type="checkbox"/> EXAM COMPLETE IN COMBINATION WITH DATA SHEETS BELOW	RWP NO.: <u>40213</u>
ADDITIONAL DATA SHEETS: <u>N/A</u>		NO. OF RECORDABLE INDICATIONS: <u>0</u>	TOTAL DOSE
COMPARED TO: <input type="checkbox"/> PSI <input checked="" type="checkbox"/> ISI REPORT NO.(S): <u>91-238</u> <input checked="" type="checkbox"/> NO CHANGE		NO. OF REPORTABLE INDICATIONS: <u>0</u>	<u>026</u> MAN REM
EXAMINATION RESULTS: <input checked="" type="checkbox"/> ACCEPTABLE <input type="checkbox"/> UNACCEPTABLE			
<u>D-244</u> <u>II</u> <u>3-27-95</u> SUMMARY BY LEVEL DATE	<u>Frank E. [Signature]</u> <u>4-3-95</u> UTILITY LEVEL III REVIEW DATE		
<u>[Signature]</u> <u>III</u> <u>3/28/95</u> GE REVIEWED BY LEVEL DATE	<u>William [Signature]</u> <u>4-4-95</u> ANII REVIEW DATE	PAGE: <u>1</u> OF: <u>7</u>	

REPORT NO.: _____
 SITE: DUANE ARNOLD UNIT: 1
 PROJECT: 1DX36 TASK: IFJPV

**WALL THICKNESS
 PROFILE SHEET**


COMPONENT ID NO.: RBB-1006

CROWN HEIGHT: .05"

CROWN WIDTH: .60"


NOM DIAMETER: 4.00"

WELD LENGTH: 14.50"

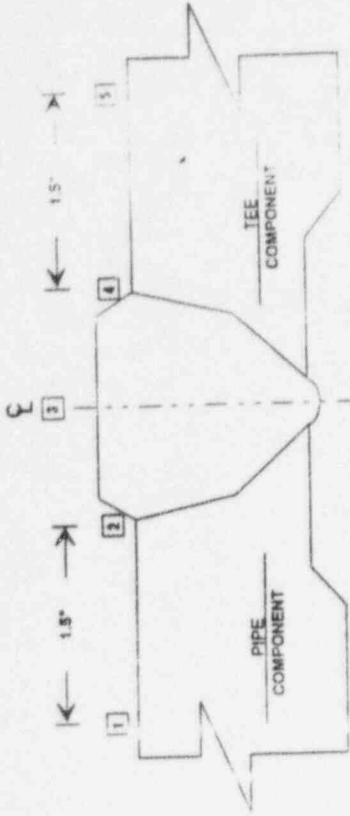

SYSTEM: RECIRCULATION

POSITION	0°	90°	180°	270°
1	N/A	N/A	.35"	N/A
2	N/A	N/A	.36"	N/A
3	N/A	N/A	.48"	N/A
4	N/A	N/A	.40"	N/A
5	N/A	N/A	.49"	N/A

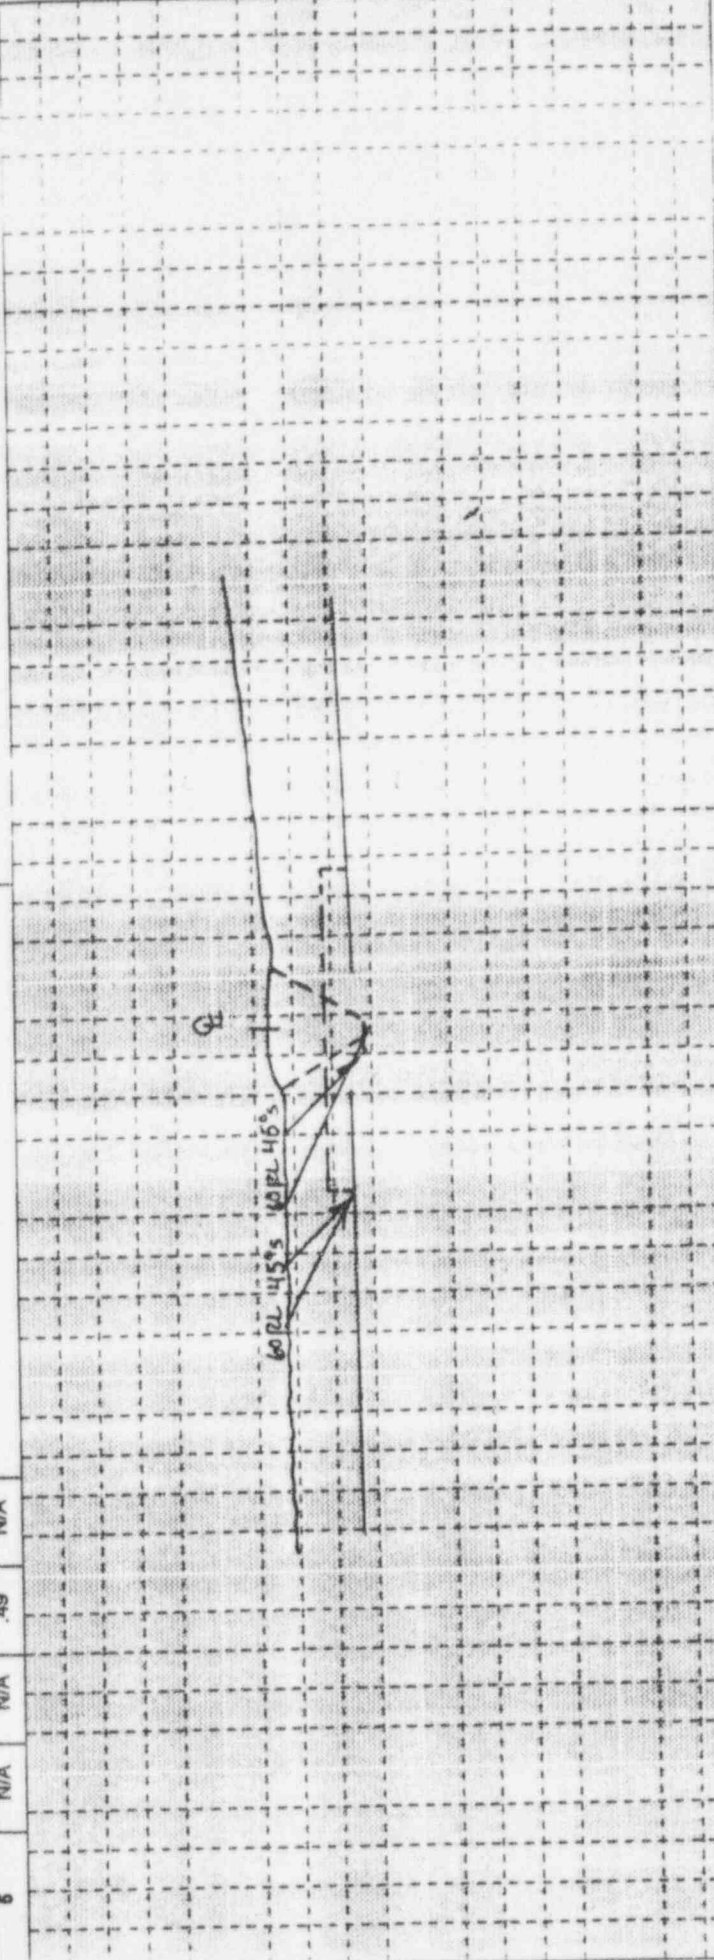

DRAWN BY: *[Signature]* DATE: 3-20-95
 REVIEWED BY: *[Signature]* DATE: 3-28-95
 UTILITY LEVEL III REVIEW: *[Signature]* DATE: 4-3-95
 ANI REVIEW: *[Signature]* DATE: 4-4-95
 PAGE 2 OF 7





GE Nuclear Energy

ULTRASONIC EXAMINATION DATA SHEET
 (MANUAL PIPING)

SITE: DUANE ARNOLD UNIT: 1 REPORT NO.: I95043
 PROJECT NO.: 1DX36 TASK: 1FJPV CALIBRATION SHEET NO.: CM-052
 DATA SHEET NO.: DM-051

PROCEDURE NO.: UT-DAC-102V0 REVISION: 0 FRR: N/A

SYSTEM: RECIRCULATION EXAM SURFACE TEMP: 72 °F COUPLANT: HUMEX EXAM START: 16:26
 WELD ID: RDB-J006 THERMOMETER S/N: 145795 BATCH NO.: 94165 EXAM END: 16:30

SEARCH UNIT: 45° / SHR EXAMINATION SURFACE: ID OD MATERIAL TYPE: CS SS OTHER: N/A
 Lo REFERENCE: TOP DEAD CENTER AXIAL SCAN SENSITIVITY (dB) 47.0
 Wo REFERENCE: WELD CENTERLINE CIRC SCAN SENSITIVITY (dB) 57.0

	PERFORMED		INDICATIONS	
	YES	NO	YES	NO
AXIAL:	1 WITH FLOW	X		X
	2 AGAINST FLOW		X	
CIRC CW:	3 UPSTREAM	X		X
	4 DOWNSTREAM		X	
CIRC CCW:	5 UPSTREAM	X		X
	6 DOWNSTREAM		X	
	7 L-WAVE BASE METAL		X	
	8 OTHER N/A		X	

INDICATION NO.	L (in) FROM REF			W (in) FROM REF			SWEEP READING			MAX AMP % DAC	EXAMINATION (1-8)
	L-1	L-MAX	L-2	W-1	W-MAX	W-2	SW-1	SW-MAX	SW-2		
NRI											
N/A											

REMARKS:
 No examination was performed downstream due to the Tee configuration.
 Scans performed at gain level below required scanning sensitivity in order to maintain a 10-30% average ID noise level.

<u>D-2HW</u> EXAMINER	<u>II</u> LEVEL	<u>3-20-95</u> DATE	<u>Frank E. Johnson</u> UTILITY LEVEL III REVIEW	<u>4-3-95</u> DATE
<u>William A. Dill</u> GE REVIEWED BY	<u>III</u> LEVEL	<u>3/23/95</u> DATE	<u>William A. Dill</u> ANII REVIEW	<u>4-4-95</u> DATE

PAGE: 3 OF: 7



GE Nuclear Energy

ULTRASONIC EXAMINATION DATA SHEET
 (MANUAL PIPING)

SITE: DUANE ARNOLD UNIT: 1 REPORT NO.: 195043
 PROJECT NO.: 1DX36 TASK: 1FJPV CALIBRATION SHEET NO.: CM-053
 DATA SHEET NO.: DM-052


PROCEDURE NO.: UT-DAC-102V0 REVISION: 0 FRR: N/A

SYSTEM: RECIRCULATION EXAM SURFACE TEMP: 72 °F COUPLANT: HUMEX EXAM START: 16:46
 WELD ID: RBB-J005 THERMOMETER S/N: 145795 BATCH NO.: 94165 EXAM END: 16:50

SEARCH UNIT: 60° / RL EXAMINATION SURFACE: ID OD MATERIAL TYPE: CS SS OTHER: N/A
 L₀ REFERENCE: TOP DEAD CENTER AXIAL SCAN SENSITIVITY (dB) 78.8
 W₀ REFERENCE: WELD CENTERLINE CIRC SCAN SENSITIVITY (dB) N/A

- AXIAL: { 1 WITH FLOW
 2 AGAINST FLOW
 CIRC CW: { 3 UPSTREAM
 4 DOWNSTREAM
 CIRC CCW: { 5 UPSTREAM
 6 DOWNSTREAM
 7 L-WAVE BASE METAL
 8 OTHER N/A

PERFORMED		INDICATIONS	
YES	NO	YES	NO
X			X
	X		
	X		
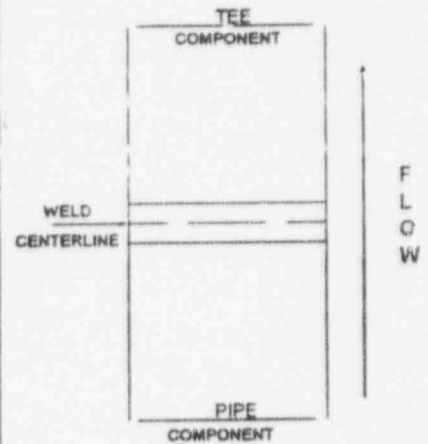

INDICATION NO.	L (in) FROM REF			W (in) FROM REF			SWEEP READING			MAX AMP % DAC	EXAMINATION (1-8)
	L-1	L-MAX	L-2	W-1	W-MAX	W-2	SW-1	SW-MAX	SW-2		
NRI											
N/A											

REMARKS:
 Supplemental 60° RL examination was performed to increase examination coverage.
 No examination was performed downstream due to the Tee configuration.

D-2HH EXAMINER
Blanchard GE REVIEWED BY
 II 3/20/95 LEVEL DATE
 III 3/28/95 LEVEL DATE
Frank E. [Signature] UTILITY LEVEL III REVIEW
William [Signature] ANII REVIEW
 4-3-95 DATE
 4-4-95 DATE

RECORD OF NONDESTRUCTIVE EXAMINATION
 LIQUID PENETRANT PT-1


CMAR NO NIA MIF STEP NIA DCP/PMP NO NIA TRAVELER NO NIA INDEX ITEM NIA
 GIR NO NIA ISI NO 195043 AR NO NIA Temp. 62 ° F
 COMPONENT OR SYSTEM RBB-J006 DWG. OR ISC NO 1.2-21A
 THICKNESS .337 PROCEDURE NO 2162.1 REV 2 ACCEPT STD 6.7.67 ^{ASME 4/27/95}
 LIGHT METER ID/DUE DATE NIA FLACK LIGHT INTENSITY, (µW/cm²) NIA

ITEM	INITIAL INSPECTION		DEFECT CODE*	INITIAL INSPECTION REMARKS (SIZE/LOCATION)	REINSPECTION		DEFECT CODE*	REINSPECTION REMARKS (SIZE/LOCATION)
	ACC	REJ			ACC	REJ		
RBB J006	X	N/A	N/A	NO RECORDABLE INDICATIONS	N/A	N/A	N/A	N/A
				N/A				

DEFECT CODE

P - POROSITY, R - ROUNDED, LI - LINEAR INDICATION, LA - LAMINATION, O - OTHER (IDENTIFY)

COMMENTS/SKETCH

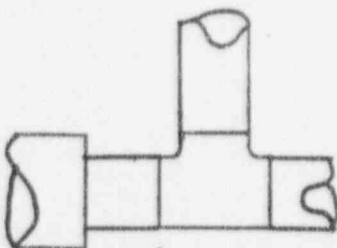

RBB-J006

100 % Weld Examined

Previous Inspection Data Reviewed Yes No N/A ^{ASME}
 Init.

PENETRANT MATERIALS: Magnaflux

MATERIAL	TYPE	BATCH
CLEANER	SKC-NF	93K01K
PENETRANT	SKL-HF/S	88L003
DEVELOPER	SKD-NF	90E07P

EXAMINER:

John Shea LI II 3-19-95
 SIGNATURE/LEVEL/DATE

REVIEWED BY:

Frank E. Johnson 4/3/95
 LEVEL III SIGNATURE/DATE

REVIEWED BY:

William Miller 4-4-95
 ANTI SIGNATURE/DATE

W.O.M.
 4-30-95

5
 Page 4 of 7



GE Nuclear Energy

ULTRASONIC CALIBRATION DATA SHEET

(MANUAL EXAMINATION)


SITE: DUANE ARNOLD UNIT: 1 CALIBRATION SHEET NO.: CM-052

PROJECT NO.: 1DX36 TASK: 1FJPV LINEARITY SHEET NO.: L-015

PROCEDURE NO.: UT-DAC-102V0 REVISION: 0 FRR: N/A

Instrument STAVELEY Manufacturer SONIC 136 Model No. 7661 Serial No.
 Search Unit KBA Manufacturer D19642 Serial No. 25" Size 2.25 MHz Freq. 45° / SHR Angle/Mode 25" incident to wedge front
 Cable RG-174 Type 6' Length 2 No. of Connectors
 Calibration Standard IE-57 Serial No. SS Material .337" Thickness 66 °F Temp
 Couplant HUMEX Type 94165 Batch No. Thermometer 145795 Serial No.

DAC

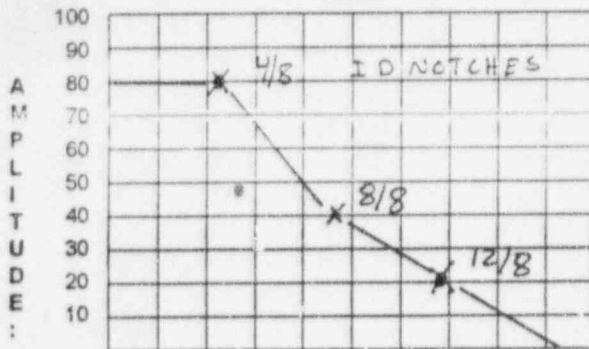

SWEEP: 0 - 10 = 20"
 DEPTH METAL PATH

INSTRUMENT SETTINGS

DAC Construction _____ Sensitivity _____
 Gain - Axial Scan 40.6 Gain - Axial Scan 40.6
 Gain - Circ. Scan 50.0 Gain - Circ. Scan 50.0
 Pulse 222 ns Range 2.00"
 Damping 500 ohms Delay .227"
 Rep Rate 4.0 KHz Velocity .124 in/us
 Filter 2 Sweep N/A
 Frequency 2.25 MHz Resolution N/A
 Reject OFF Jack R T

Field Simulator: ROMPUS S/N: CAL-RHOM-021

CALIBRATION VERIFICATION

REFLECTOR:	NEAR SDH	FAR SDH	INITIAL CALIBRATION TIME	08:55	VERIFICATION TIMES
MAX AMPLITUDE:	24%	10%	FINAL VERIFICATION TIME	18:25	15:47 N/A
SWEEP:	48"	1.08"			N/A N/A
GAIN:	40.6	40.6			

WELDS EXAMINED REPORT NO. COMMENTS:

WELDS EXAMINED	REPORT NO.	COMMENTS:
RBB-J006	I95043	N/A

D-2HH EXAMINER II LEVEL 3-20-95 DATE
Ed Conwell GE REVIEWED BY III LEVEL 3/29/95 DATE
Frank [Signature] UTILITY LEVEL III REVIEW 4-3-95 DATE
William [Signature] ANII REVIEW 4-4-95 DATE



GE Nuclear Energy

ULTRASONIC CALIBRATION DATA SHEET

(MANUAL EXAMINATION)

SITE: DUANE ARNOLD UNIT: 1

CALIBRATION SHEET NO.: CM-053


PROJECT NO.: 1DX36 TASK: 1FJPV

LINEARITY SHEET NO.: L-015

PROCEDURE NO.: UT-DAC-102V0 REVISION: 0 FRR: N/A

Instrument STAVELEY SONIC 136 7661
Manufacturer Model No. Serial No.
 Search Unit HARISONIC H4029 2(25x.50)in 3.50 60° / RL 60"
Manufacturer Serial No. Size Freq Angle/Mode Incident to wedge front
 Cable 2(RG-174) 2(6') 4
Type Length No. of Connectors
 Calibration Standard IE-57 SS .337" 68 °F
Serial No. Material Thickness Temp.
 Couplant HUMEX 94165 Thermometer 145795
Type Batch No. Serial No.

DAC

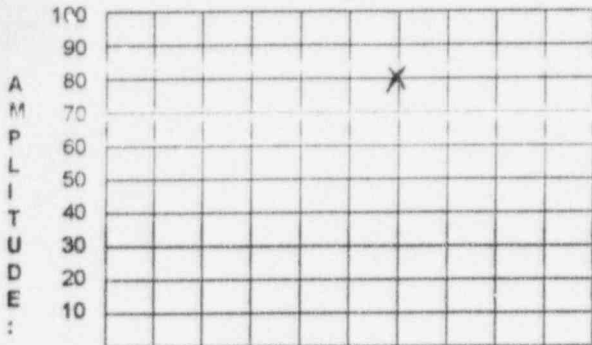

SWEEP: 0 - 10 = 1.0"

DEPTH METAL PATH

INSTRUMENT SETTINGS

DAC Construction Sensitivity
 Gain - Axial Scan 78.8 Gain - Axial Scan 78.8
 Gain - Circ. Scan N/A Gain - Circ. Scan N/A
 Pulse 100 ns Range 1.00"
 Damping 500 ohms Delay .728"
 Rep Rate 2.0 KHz Velocity .232 in/us
 Filter 1 Sweep N/A
 Frequency 5.00 MHz Resolution N/A
 Reject OFF Jack R T

Field Simulator: ROMPUS S/N: CAL-RHQM-021

CALIBRATION VERIFICATION

REFLECTOR:	NEAR SDH	N/A	INITIAL CALIBRATION TIME	09:22	VERIFICATION TIMES	
MAX AMPLITUDE:	80%	N/A			16:45	N/A
SWEEP:	.60"	N/A	FINAL VERIFICATION TIME	18:20	N/A	N/A
GAIN:	64.4	N/A				

WELDS EXAMINED REPORT NO. COMMENTS:


RBB-J006	195043	N/A

D-2HM II 3/20/95 4-3-95
EXAMINER LEVEL DATE UTILITY LEVEL II REVIEW DATE
W. M. Smith II 3/28/95 4-4-95
GE REVIEWED BY LEVEL DATE ANII REVIEW DATE

PIPE

FLOW →

TEE

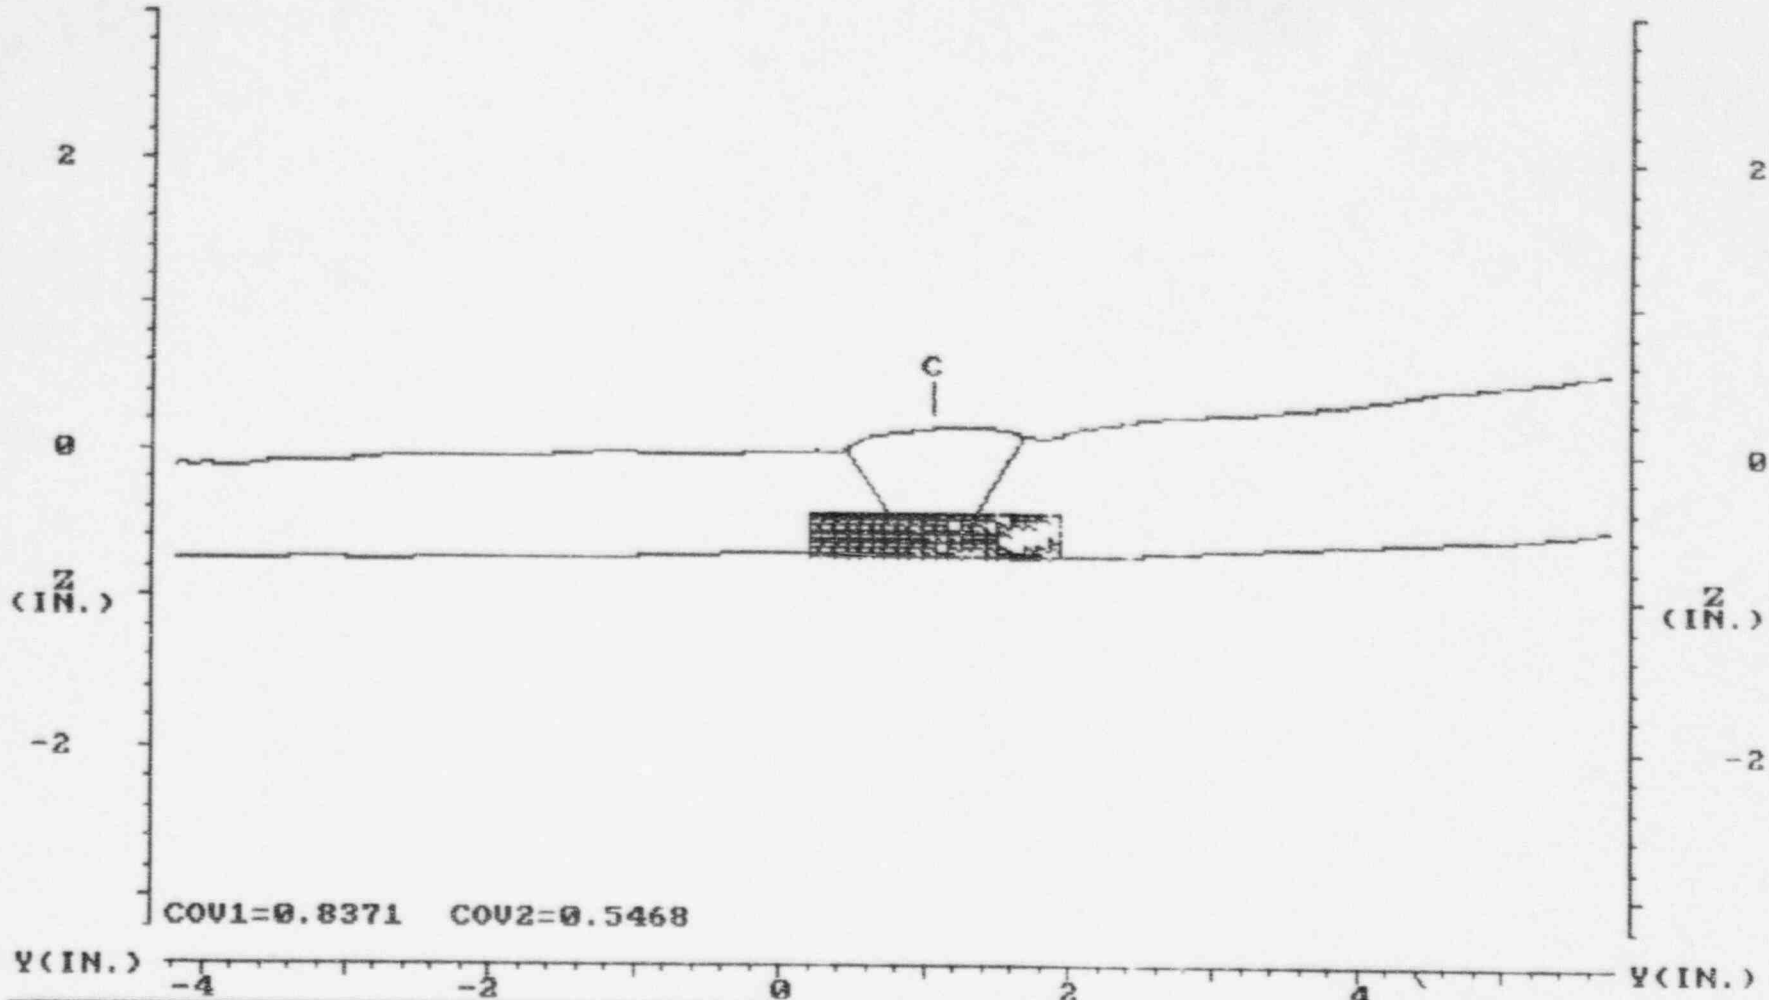

ATTACHMENT 1 - EPRI RAYTRACE

SET							SET
DEP							DEP
MP							MP
TOF							TOF
FAN							FAN
GATE							GATE
STEP							STEP
EXIT	MAKERAY	UTILITY	LEFT	RIGHT	TOP	PRINT	EXIT
PLANT: DAEC		4/1/95		GIRC. POS:			
SYSTEM: RECIRCULATION		14:43		ANALYST:			
COMPONENT: RBB-J006				CAL. SHEET:			

DUANE ARNOLD ENERGY CENTER
2ND 10-YEAR INTERVAL
REQUEST FOR RELIEF NO. NDE-018

I SYSTEM/COMPONENT(S) FOR WHICH RELIEF IS REQUESTED

HEA-CB-2 Residual Heat Removal (RHR) Heat Exchanger Nozzle Weld

EXAMINATION CATEGORY C-B, ITEM(S) C2.21

II CODE REQUIREMENT

Section XI (1980 W81 ADD), Table IWC-2500-1 Category C-B, Item C2.21 requires a volumetric and surface examination which includes essentially 100% of weld length once during the ten year interval.

III CODE REQUIREMENT FROM WHICH RELIEF IS REQUESTED

Relief is requested from performing volumetric and surface examination of essentially 100% of the weld length for RHR heat exchanger weld HEA-CB-2.

IV BASIS FOR RELIEF

This weld is a nozzle-to-shell configuration which limits the volumetric (UT) coverage to a one-sided exam. The nozzle is located next to the tube sheet flange which further limits the volumetric examination coverage, resulting in approximately 71 % UT coverage of the weld length. Performing a radiograph of the weld requires draining the RHR System and removing the pipe or opening the tube sheet to provide access to the inside diameter. (Removal of the tube sheet is not an option because several tubes would be required to be removed along with the tube sheet.) Draining the pipe increases the dose rates in the area by a factor of 1.7 (20 mr/hr vs 12 mr/hr). This results in additional personnel exposure of 50 mr to obtain the radiograph, including the installation and removal of insulation and shielding. In addition, removing the pipe from the nozzle would require the pipe to be cut in two places and then rewelded which would take about 102 hours. Additional examinations would then be needed for the welds that reattach the pipe to the system. The total dose for the project would be approximately 2 R. The additional 29 % coverage would provide only a small potential for increasing plant safety while greatly increasing expenditures of plant manpower and radiation exposure.

V ALTERNATE EXAMINATIONS


IES Utilities Inc. proposes to perform volumetric examination of the 71% weld length. The alternative examination coverage allowed by Code Case N-460 will also be used.

VI JUSTIFICATION FOR THE GRANTING OF RELIEF

Examining the additional 29% of weld length would require draining the RHR System and removing the pipe. This would greatly increase personnel radiation exposure while providing only a small potential for increasing plant safety.

VII IMPLEMENTATION SCHEDULE

This relief request will be implemented during the 2nd Ten Year Interval. This weld was included in the Refueling Outage (RFO) 13 Summary Report.

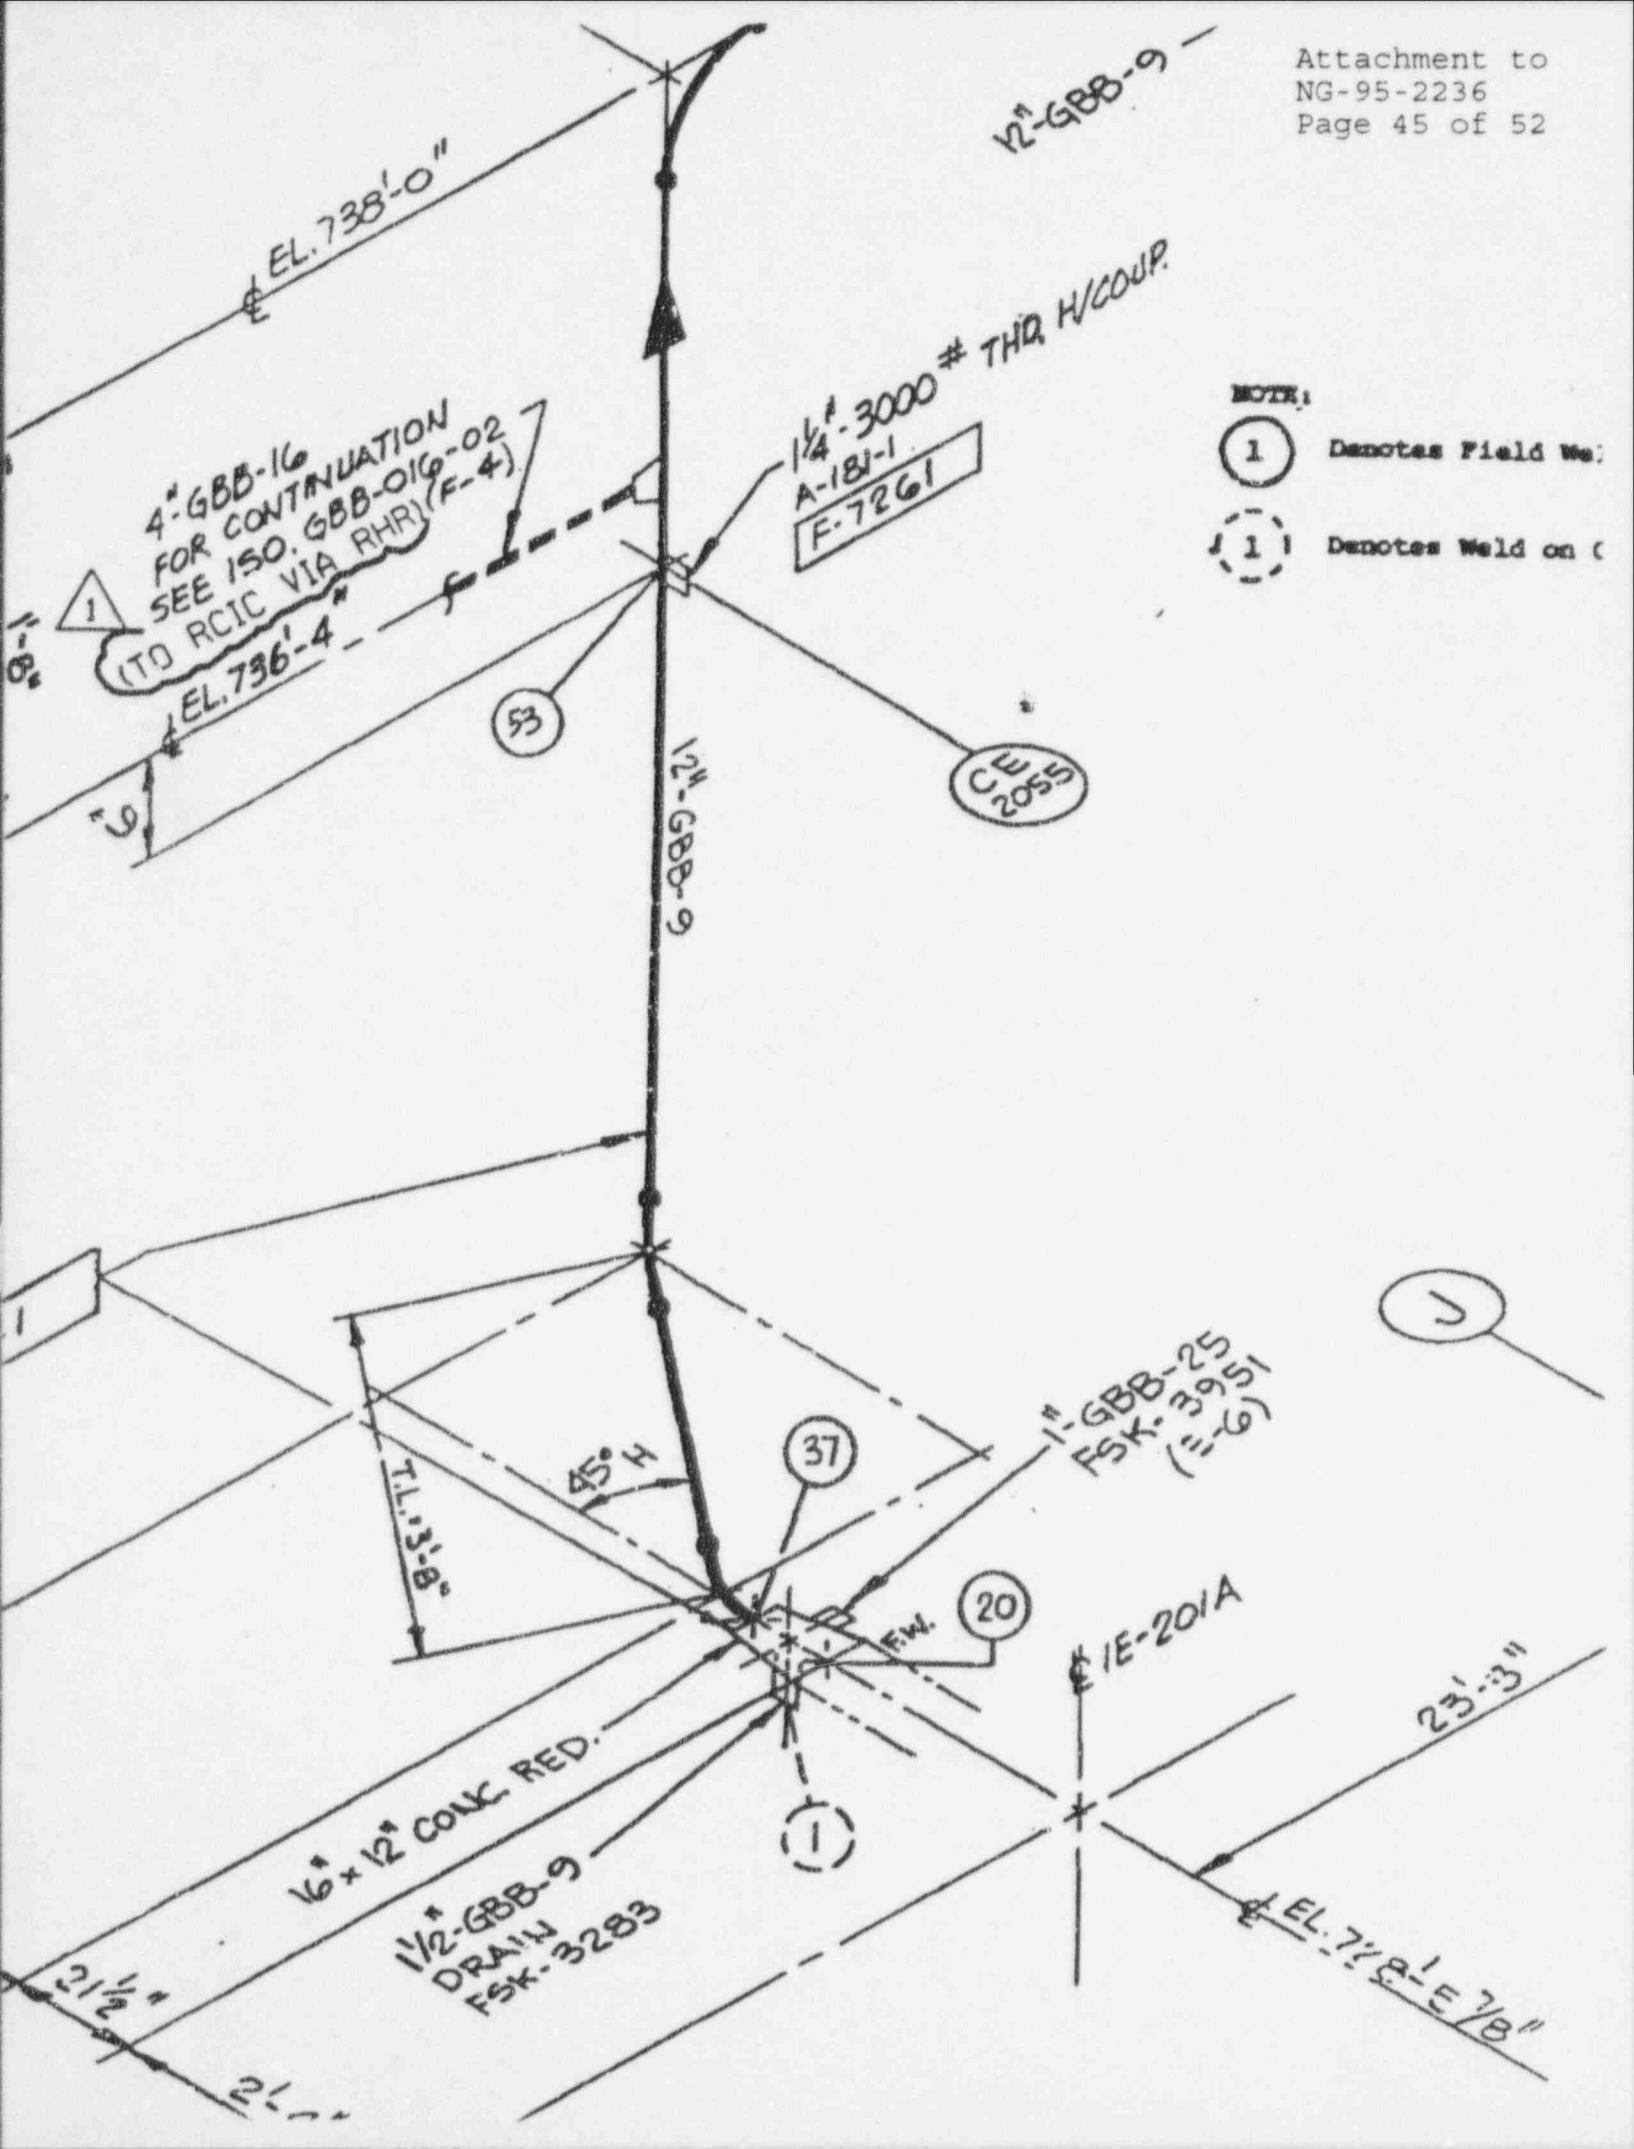

NOTE:
 (1) Denotes Field Weld
 (1) Denotes Weld on (

4" GBB-16
 FOR CONTINUATION
 SEE ISO. GBB-016-02
 (TO RCIC VIA RHR) (F-4)

1/4" - 3000 # THQ H/COUR.
 A-181-1
 F-7261

1" GBB-25
 FSK-3951
 (F-6)

1 1/2" GBB-9
 DRAIN
 FSK-3283

16" x 12" COLC. RED.

E/E-201A

EL. 7 7/8" - E 7/8"

EL. 738'-0"

EL. 736'-4"

1 1/2" GBB-9

1 1/2" GBB-9

(53)

(W 15
 2055)

(37)

(20)

(1)

(J)


45° H

T.L. 3'-8"

23'-3"

2 1/2"

2'-0"

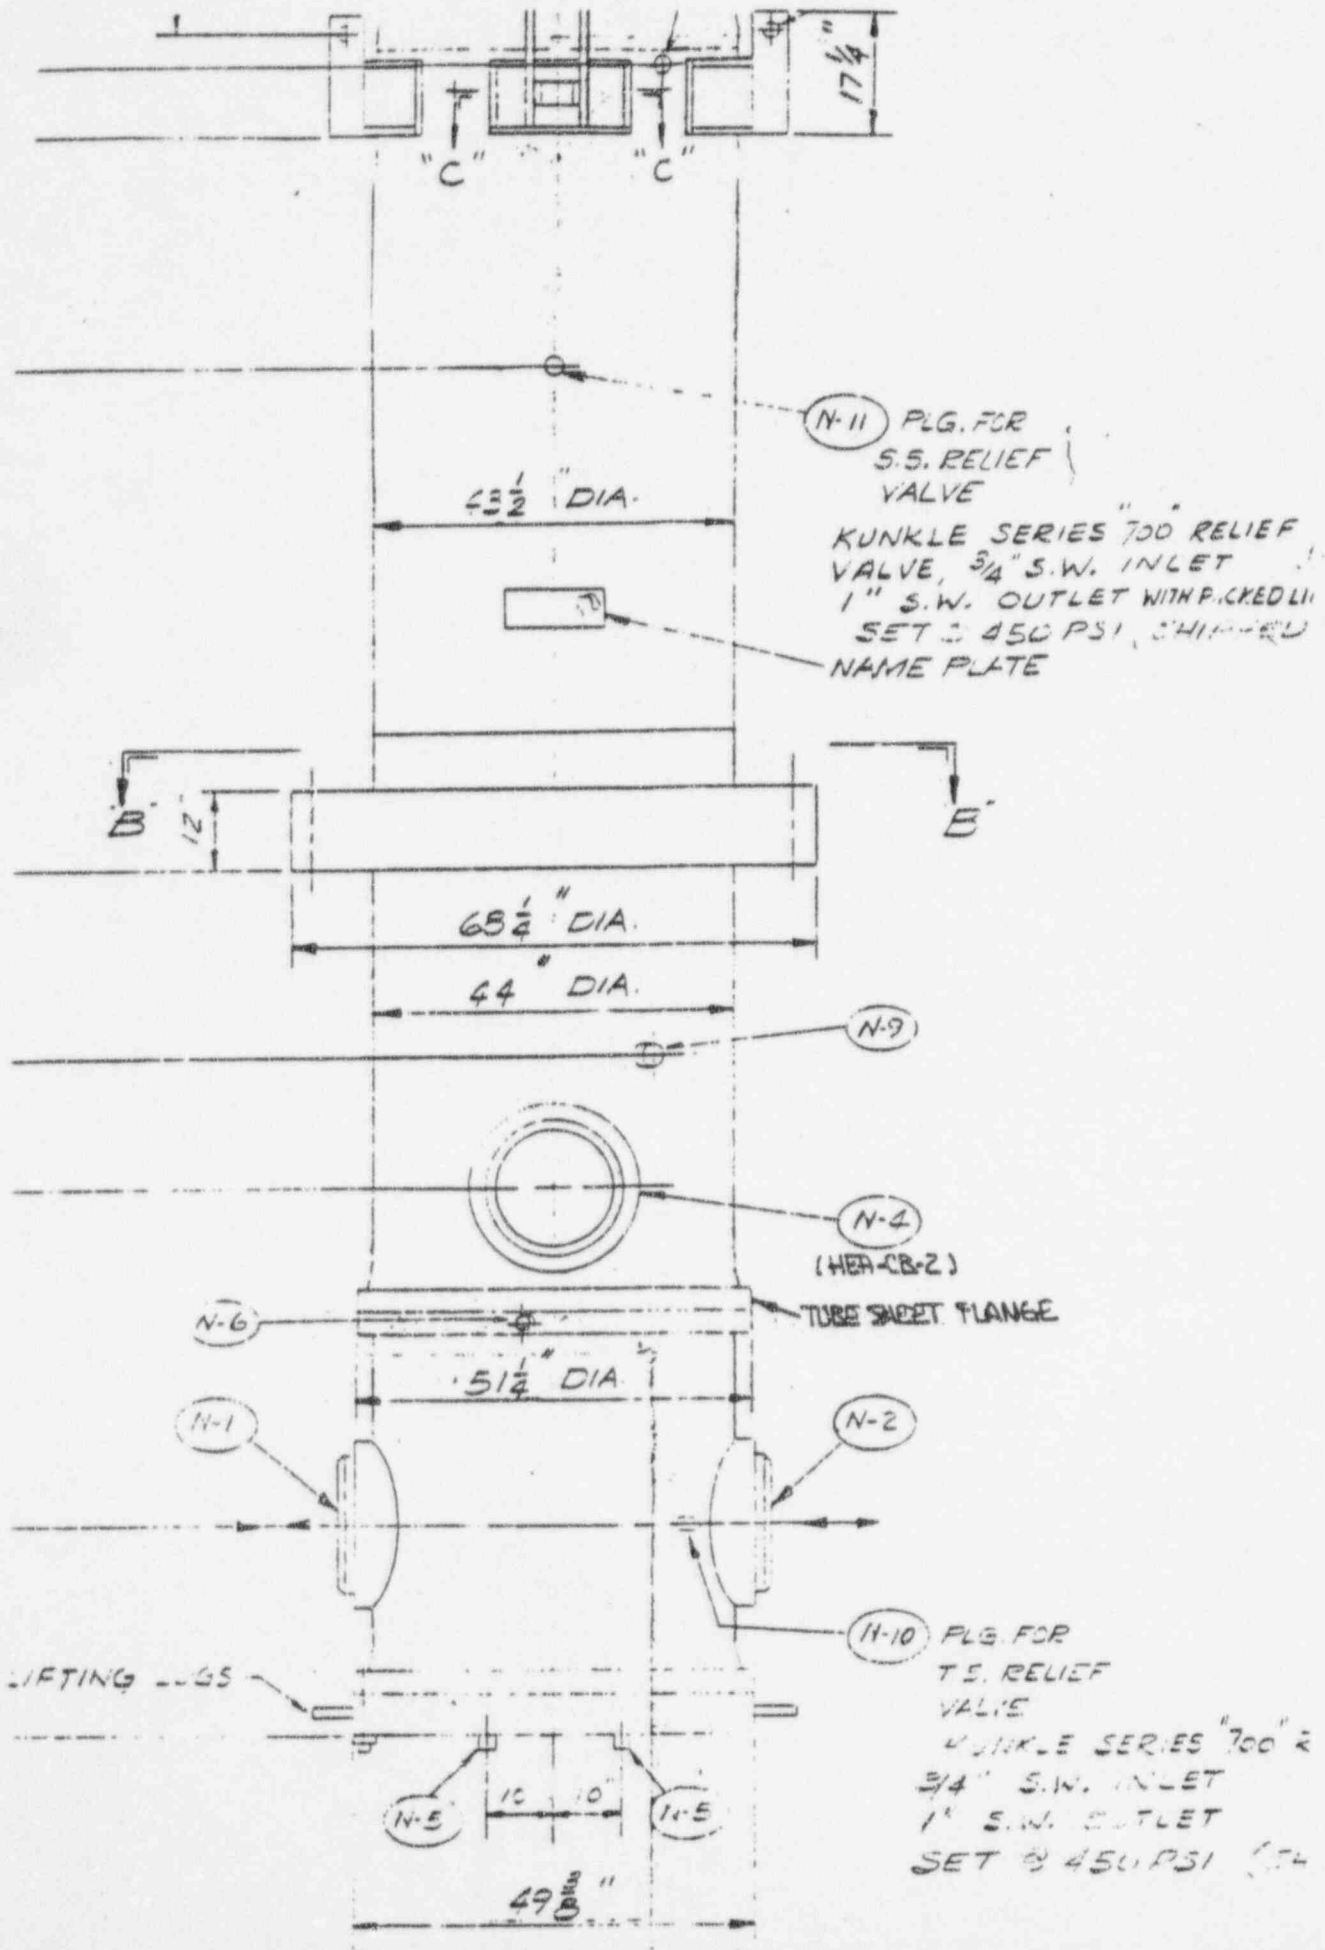



GE Nuclear Energy

EXAMINATION SUMMARY SHEET

REPORT NO.:
 195094

PROJECT: <u>DUANE ARNOLD</u> <u>1DX36</u>	PROCEDURE: <u>UT-DAC-301V0</u> REV: <u>0</u> FRR: <u>N/A</u> <u>N/A</u> <u>N/A</u>
SYSTEM: <u>HEAT EXCHANGER A</u>	<u>2162.4</u> REV: <u>1</u> FRR: <u>N/A</u> <u>N/A</u> <u>N/A</u>
WELD NO.: <u>HEA-CB-2</u>	<u>N/A</u> REV: <u>N/A</u> FRR: <u>N/A</u> <u>N/A</u> <u>N/A</u>
CONFIGURATION: <u>NOZZLE - SHELL</u>	
EXAMINER: <u>E. MAZYCK</u> LEVEL: <u>II</u>	<input checked="" type="checkbox"/> MT <input type="checkbox"/> PT <input checked="" type="checkbox"/> UT <input type="checkbox"/> VT
EXAMINER: <u>P. MICHELSON</u> LEVEL: <u>II</u>	<input type="checkbox"/> CIRCUMFERENTIAL
EXAMINER: <u>N/A</u> LEVEL: <u>N/A</u>	<input type="checkbox"/> LONGITUDINAL <input checked="" type="checkbox"/> OTHER <u>NOZZLE-SHELL</u>
DATA SHEET NO.(S): <u>DM-003</u> <u>MT-002</u>	CAL SHEET NO.(S): <u>CM-003</u>


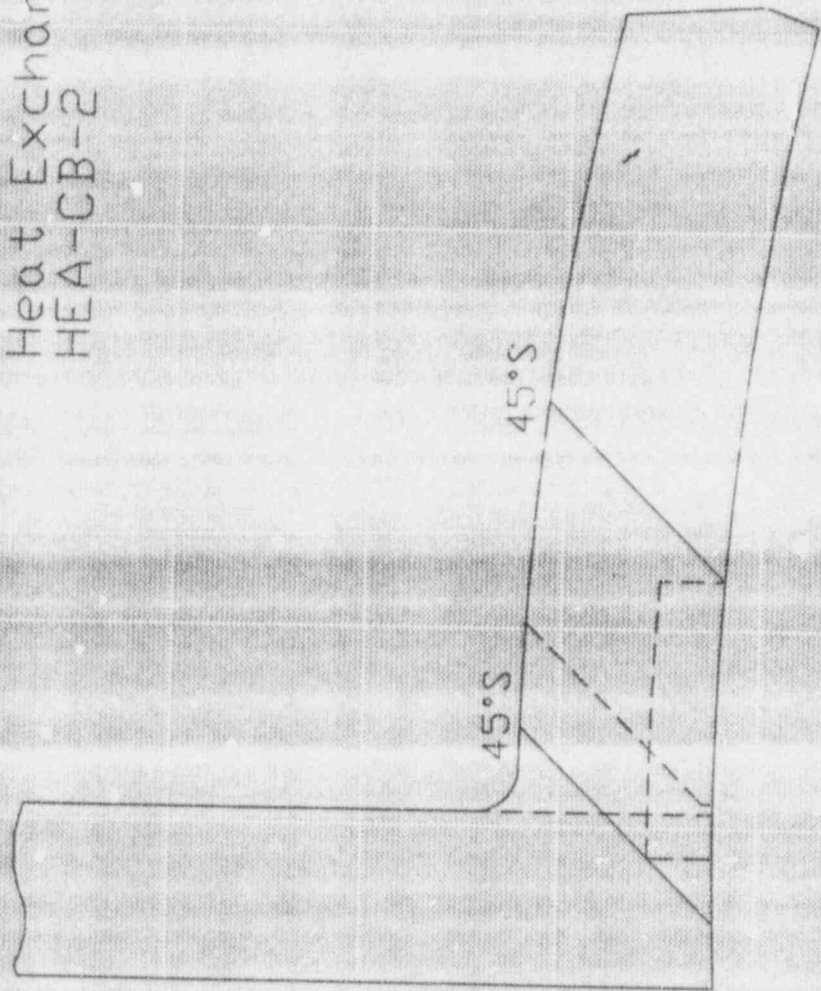
During the manual ultrasonic examination of HEA-CB-2, no reportable indications as per ASME Section XI were detected utilizing a 45° shear wave search unit.

This examination was performed from the shell side of the weld only due to the nozzle to shell configuration. The ultrasonic examination was restricted in the proximity of the adjacent flange weld.

A magnetic particle examination was performed resulting in no reportable indications. The magnetic particle examination was restricted to .30" from the weld toe from L = 24.0" to L = 29.3" due to the proximity of the flange weld.

Composite ultrasonic examination coverage of HEA-CB-2 is 71% of the Code required volume.

<input type="checkbox"/> EXAM COMPLETE	<input checked="" type="checkbox"/> PARTIALLY EXAMINED (EXPLAIN IN COMMENTS)	<input type="checkbox"/> EXAM COMPLETE IN COMBINATION WITH DATA SHEETS BELOW	RWP NO.: <u>1021204</u>
ADDITIONAL DATA SHEETS: <u>N/A</u>		NO. OF RECORDABLE INDICATIONS: <u>0</u>	TOTAL DOSE <u>010</u> MAN REM
COMPARED TO: <input type="checkbox"/> PSI <input checked="" type="checkbox"/> ISI REPORT NO.(S): <u>82-049,054</u> <input checked="" type="checkbox"/> NO CHANGE		NO. OF REPORTABLE INDICATIONS: <u>0</u>	
EXAMINATION RESULTS: <input checked="" type="checkbox"/> ACCEPTABLE <input type="checkbox"/> UNACCEPTABLE			
<u>Paul W. Nicholson</u> II <u>3-4-95</u>	<u>Paul E. [Signature]</u> <u>3-17-95</u>		
SUMMARY BY LEVEL DATE	UTILITY LEVEL III REVIEW DATE		
<u>[Signature]</u> III <u>3-17-95</u>	<u>William [Signature]</u> <u>3-18-95</u>		
GE REVIEWED BY LEVEL DATE	ANII REVIEW DATE		
		PAGE: <u>1</u> OF: <u>6</u>	

 <p>GE Nuclear Energy</p>	<p>INDICATION PLOT SHEET</p>		<p>SITE: <u>DUANE ARNOLD</u> UNIT: <u>1</u> REPORT NO.: <u>195094</u></p>
<p>SYSTEM: <u>HEATEXCHANGER A</u></p>	<p>COMPONENT ID NO.: <u>HEA-CB-2</u></p>	<p>PROJECT: <u>1DX36</u> CONFIGURATION: <u>NOZZLE</u> SHELL</p>	<p style="text-align: center;">Heat Exchanger "A" HEA-CB-2</p> 
<p>DRAWN BY: <u>Paul M. Nicholson</u> LEVEL: <u>II</u> DATE: <u>3-4-95</u></p> <p>GE REVIEWED BY: <u>[Signature]</u> LEVEL: <u>AT</u> DATE: <u>3-12-95</u></p>	<p>UTILITY LEVEL III REVIEW: <u>[Signature]</u> DATE: <u>3-17-95</u></p>	<p>ANN REVIEW: <u>[Signature]</u> DATE: <u>3-18-95</u></p> <p style="text-align: right;">PAGE 2 OF 6</p>	



GE Nuclear Energy

INDICATION PLOT SHEET

SITE: DUANE ARNOLD UNIT: 1

REPORT NO.:


PROJECT: 1DX36

195014

SYSTEM: HEAT EXCHANGER A

COMPONENT ID NO.: HEA-CB-2

CONFIGURATION: NOZZLE FLOW → SHELL

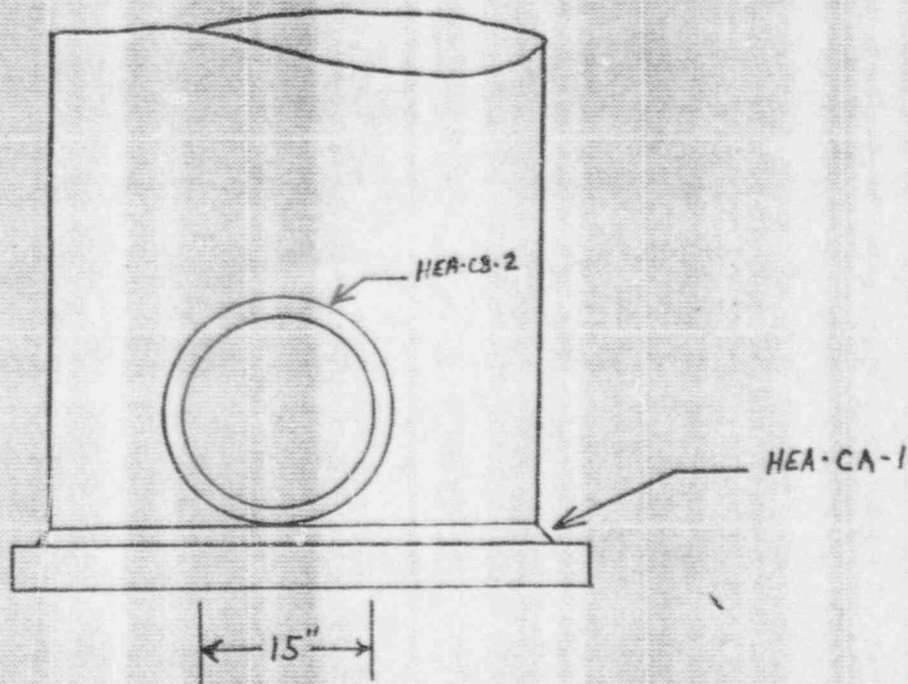

<i>Paul W. Nicholson</i>	<u>II</u>	<u>3-4-95</u>
DRAWN BY	LEVEL	DATE
<i>B. Bonnell</i>	<u>III</u>	<u>2-17-95</u>
GE REVIEWED BY	LEVEL	DATE

<i>Hank E. ...</i>	<u>3-17-95</u>
UTILITY LEVEL III REVIEW	DATE

<i>William ...</i>	<u>3-18-95</u>
ANII REVIEW	DATE

PAGE 5 OF 8

Attachment to
NG-95-2236
Page 49 of 52



GE Nuclear Energy

ULTRASONIC EXAMINATION DATA SHEET



(MANUAL RPV VESSEL WELDS)

SITE: DUANE ARNOLD PROCEDURE NO.: UT-DAC-301V0 REPORT NO.: 195094
 UNIT: 1 REVISION NO.: 0 DATA SHEET NO.: DM-003
 PROJECT NO.: 1DX36 FRR NO.: N/A CALIBRATION SHEET NO.: 0° N/A
45° CM-003 60° N/A

SYSTEM: HEAT EXCHANGER A EXAM SURFACE TEMP: 79 °F COUPLANT: HUMEX EXAM START: 12:10
 WELD ID: HEA-CB-2 THERMOMETER S/N: 145989 BATCH NO.: 93765 EXAM END: 12:30

BEAM ANGLE: 0° 45° 60° OTHER N/A SURFACE CONDITION: SMOOTH GROUND OTHER N/A
 MATERIAL TYPE: CS S5 OTHER N/A EXAM SURFACE: ID OD

L₀ REFERENCE: TOP DEAD CENTER OF NOZZLE 0° SCAN SENSITIVITY N/A dB
 W₀ REFERENCE: WELD CENTERLINE 45° SCAN SENSITIVITY 52.0 dB
 60° SCAN SENSITIVITY N/A dB

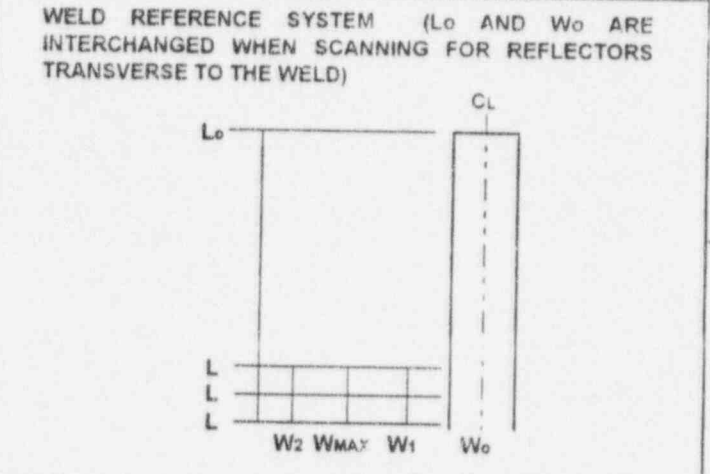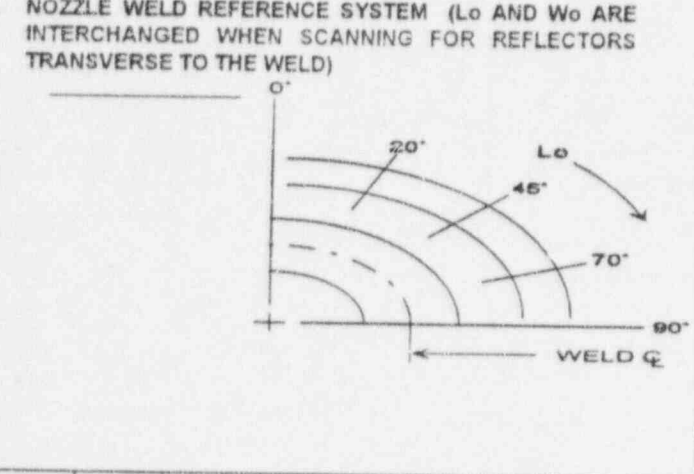

L/R	% DAC (MAX)	W ₁ 20% DAC	W _{F1} 50% DAC	W _M MAX DAC	W _{F2} 50% DAC	W ₂ 20% DAC	MP ₁ 20% DAC	MP _{F1} 50% DAC	MP MAX DAC	MP _{F2} 50% DAC	MP ₂ 20% DAC	CONTINUOUS (C) OR SPOT (S) TRANSVERSE (T) OR PARALLEL (P)	CW/CCW TOP OR BOTTOM
NRI													

REMARKS: One sided exam performed from the shell side due to the nozzle to shell configuration. The examination was limited from 19.0" to 24.0" and from 29.0" to 34.0" to a "W" dimension of less than 2.0" due to the proximity of HEA-CA-1. No examination was performed from 24.0" to 29.0" due to the proximity of HEA-CA-1 weld.

Paul W. Michelson II 3-4-95 Frank T. DeLima 3-17-95
 EXAMINED BY LEVEL DATE UTILITY LEVEL III REVIEW DATE
 Ed Brumwell # 3-17-95 William M. M... 3-18-95
 GE REVIEWED BY LEVEL DATE ANII REVIEW DATE
 PAGE: 4 OF: 6

RECORD OF NONDESTRUCTIVE EXAMINATION
 MAGNETIC PARTICLE- (DRY OR WET METHOD) MT-1

CHAR NO. N/A MIF STEP N/A DCP/PHP NO. N/A TRAVELER NO. N/A INDEX ITEM N/A
 GIR NO. N/A ISI NO. I95094 AR NO. N/A
 COMPONENT OR SYSTEM HEAT EXCHANGER A DWG. OR ISO NO. 2.1-01
 THICKNESS .875" PROCEDURE NO. 2162.4 REV 1 ACCEPT STD. 6.10.6
 EQUIPMENT NO. ID 90015A CAL. DUE DATE 5-10-95 (AC) DC
 D.C. CURRENT GUN N/A CAL. DUE DATE N/A
 YOKE/PROD SPACING 4"-5" AMP N/A DRY POWDER: RED N/A BLACK N/A
 MX-MCP BATCH NO. 89F02K 9 CM RED BATCH NO. 89L05K 7 C-F BLACK BATCH NO. N/A

ITEM	INITIAL INSPECTION		DEFECT CODE*	INITIAL INSPECTION REMARKS (SIZE/LOCATION)	REINSPECTION		DEFECT CODE*	REINSPECTION REMARKS (SIZE/LOCATION)
	ACC	REJ			ACC	REJ		
HEA-CB-2	X		N/A	NRI				
				N/A				

#DEFECT CODE

PREVIOUS INSPECTION DATA REVIEWED

P - POROSITY, R - ROUNDED, LI - LINEAR INDICATION, LA - LAMINATION, O - OTHER
 (IDENTIFY)

COMMENTS/SKETCH

HEA-CB-2

HEA-CB-2

1" LINE

2" LINE

EXAM RESTRICTED TO .3" FROM WELD TOE AT 24" TO 29.3" DUE TO CONFIGURATION OF NOZZLE. EXAMINED 95% OF THE CODE REQ'D AREA.

Examiner: Paul F. Johnson 3-4-95 Reviewed By: William M. ... 3/15/95
 Signature/Level/Date Level III Signature/Date ANII Signature/Date



GE Nuclear Energy


ULTRASONIC CALIBRATION DATA SHEET (VESSEL CALIBRATION)

SITE: DUANE ARNOLD UNIT: 1 CALIBRATION SHEET NO.: CM-003

PROJECT NO.: IDX36 LINEARITY SHEET NO.: L-002

PROCEDURE NO.: UT-DAC-301V0 REVISION: 0 FRR: N/A

Instrument STAVELEY SONIC 136 707H
 Manufacturer Model No. Serial No.
 Search Unit KBA C28420 50" 2.25 MHz 45° / SHR 40"
 Manufacturer Serial No. Size Freq. Angle/Mode Incident to wedge front
 Cable RG-174 6' 2
 Type Length No. of Connectors
 Calibration Standard IE-12 CS 1.50" 68 °F
 Serial No. Material Thickness Temp.
 Couplant HUMEX 94165 Thermometer 145989
 Type Batch No. Serial No.

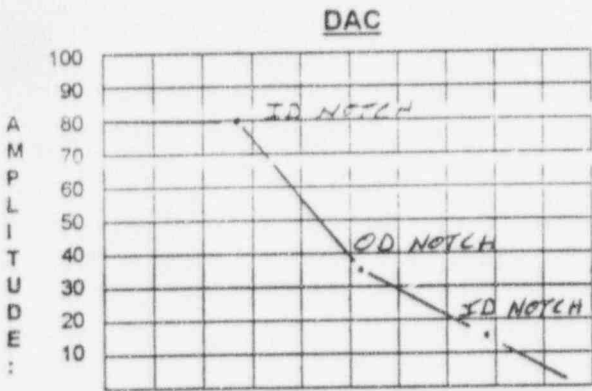

SWEEP: 0 - 10 = 8.0"

DEPTH METAL PATH

INSTRUMENT SETTINGS

DAC Construction		Sensitivity	
Gain - Axial Scan	<u>38.0</u>	Gain - Axial Scan	<u>38.0</u>
Gain - Circ. Scan	<u>38.0</u>	Gain - Circ. Scan	<u>38.0</u>
Pulse	<u>222 ns</u>	Range	<u>8.0"</u>
Damping	<u>500 ohms</u>	Delay	<u>299"</u>
Rep Rate	<u>2 KHz</u>	Velocity	<u>129 in/μ</u>
Filter	<u>1</u>	Sweep	<u>N/A</u>
Frequency	<u>2.25 MHz</u>	Resolution	<u>N/A</u>
Reject	<u>OFF</u>	Jack	<input type="checkbox"/> R <input checked="" type="checkbox"/> T

NOTE: N/A dB DIFFERENCE BETWEEN 3/8 VEE AND 5/8 VEE

HOLE DEPTH "T"	INCHES	GAIN @ 1X	MAX. AMP.	"W" INCHES	"MP" INCHES	SDH OR FBH
1/4	N/A	1X	N/A	N/A	N/A	N/A
1/2	N/A	1X	N/A	N/A	N/A	N/A
3/4	N/A	1X	N/A	N/A	N/A	N/A
NOTCH	1.50"	1X	80%	1.80"	2.24"	N/A

Field Simulator:	<u>N/A</u>	S/N:	<u>N/A</u>
REFLECTOR:	<u>N/A</u>	<u>N/A</u>	<u>N/A</u>
MAX AMPLITUDE:	<u>N/A</u>	<u>N/A</u>	<u>N/A</u>
SWEEP:	<u>N/A</u>	<u>N/A</u>	<u>N/A</u>
GAIN:	<u>N/A</u>	<u>N/A</u>	<u>N/A</u>

WELDS EXAMINED	REPORT NO.
<u>HEA-CB-2</u>	<u>195094</u>
<u>N/A</u>	

CALIBRATION VERIFICATION			
INITIAL CALIBRATION TIME	<u>11:30</u>	VERIFICATION TIMES	
FINAL VERIFICATION TIME	<u>13:40</u>	<u>N/A</u>	<u>N/A</u>
		<u>N/A</u>	<u>N/A</u>

BEAM SPREAD									
TRAILING RAY				MAXIMUM AMP.		LEADING RAY			
20% DAC		50% DAC		100% DAC		50% DAC		20% DAC	
W	MP	W	MP	W	MP	W	MP	W	MP
N/A	N/A	N/A	N/A	N/A	N/A	N/A	N/A	N/A	N/A
N/A	N/A	N/A	N/A	N/A	N/A	N/A	N/A	N/A	N/A
N/A	N/A	N/A	N/A	N/A	N/A	N/A	N/A	N/A	N/A

<u>Paul W. Mickelson</u> EXAMINER	<u>II</u> LEVEL	<u>3-4-95</u> DATE	<u>Frank E. ...</u> UTILITY LEVEL III REVIEW	<u>3-17-95</u> DATE
<u>Ed ...</u> GE REVIEWED BY	<u>III</u> LEVEL	<u>3/17/95</u> DATE	<u>William ...</u> ANII REVIEW	<u>3-18-95</u> DATE