

**DUKE POWER COMPANY**  
P.O. BOX 33189  
CHARLOTTE, N.C. 28242

HAL B. TUCKER  
VICE PRESIDENT  
NUCLEAR PRODUCTION

TELEPHONE  
(704) 373-4531

July 9, 1984

Mr. Harold R. Denton, Director  
Office of Nuclear Reactor Regulation  
U. S. Nuclear Regulatory Commission  
Washington, D. C. 20555

Attention: Ms. E. G. Adensam, Chief  
Licensing Branch No. 4

Re: Catawba Nuclear Station  
Docket Nos. 50-413 and 50-414

Dear Mr. Denton:

In regards to my July 6, 1984 letter concerning compliance with GDC 51 "Fracture Prevention of Containment Pressure Boundary," please find attached the information which we committed to provide.

Very truly yours,

*Hal B. Tucker*  
Hal B. Tucker

RWO/ssb

Attachment

cc: Mr. James P. O'Reilly, Regional Administrator  
U. S. Nuclear Regulatory Commission  
Region II  
101 Marietta Street, NW, Suite 2900  
Atlanta, Georgia 30323

NRC Resident Inspector  
Catawba Nuclear Station

Mr. Jesse L. Riley  
Carolina Environmental  
Study Group  
854 Henley Place  
Charlotte, North Carolina  
28207

Mr. Robert Guild, Esq.  
Attorney-at-law  
P. O. Box 12097  
Charleston, South Carolina 29412

Palmetto Alliance  
2135½ Devine Street  
Columbia, South Carolina 29205

8407170189 840709  
PDR ADOCK 05000413  
A PDR

B60  
111

Catawba Nuclear Station  
Power Piping and Mechanical Penetrations  
Compliance with GDC 51

**I. POWER PIPING AND MECHANICAL PENETRATION MATERIALS**

Section 3.1, page 32 of the Catawba Final Safety Analysis Report addresses General Design Criterion 51 of Appendix A of 10CFR Part 50. This section states that the reactor containment boundary shall be designed with sufficient margin to assure that under operating, maintenance, testing, and postulated accident conditions (1) its ferritic materials behave in a nonbrittle manner and (2) the probability of rapidly propagating fracture is minimized. This section also states that the design shall reflect consideration of service temperatures and other conditions of the containment boundary material during operation, maintenance, testing and postulated accident conditions, and the uncertainties in determining (1) material properties, (2) residual, steady-state, and transient stress, and (3) size of flaws.

Duke Power Company has complied with these commitments for mechanical penetrations through selection of materials used in design of the mechanical penetrations. These materials have proven reliable and not subject to brittle fracture in Duke Power's operating plants and in general industry service.

Mechanical penetrations for Catawba meet all code requirements. The effective code for mechanical penetrations is the 1974 edition of the ASME Boiler and Pressure Vessel Code, Section III, Subsection NC including summer 1974 addenda.

In addition to complying with the FSAR commitments and code requirements, the mechanical penetrations comply with guidelines for GDC 51 compliance of Standard Review Plan NUREG 0800 for power operation including power transient conditions. In accordance with NUREG 0800, an assessment of material fracture toughness is made using fracture toughness data presented by NUREG-0577 and ASME Section III, Summer 1977 Addenda, Subsection NC. Using this method a Permissible Lowest Service Metal Temperature (PLSMT) is established for pressure boundary materials. An analysis of the power piping and mechanical penetration materials is discussed below:

**A. Penetration Assemblies**

- 1) Main Steam and Feedwater Penetration Flued Heads - SA 105; annealed, 2" design axial thickness (see Attachment 1 - June 23, 1983 letter by D. L. Caldwell). NUREG-0577, Table 4.4 assigns a (NDT + 1.3 $\sigma$ ) NDT of 67°F/77°F to this material. Given the 5 1/2" design axial thickness, the Summer 1977 Addenda Class 2 rules would assign a PLSMT of 125°F/135°F to the material. However, Duke's analysis states the flued heads are part of a floating penetration assembly, which would require a  $\leq$  2" axial thickness under the limiting condition. Given a 2" axial thickness, the Summer 1977 addenda Class 2 rules would assign a PLSMT of 107°F. The design LSMT of this material is 115°F (which will be experienced during hydrotest) and therefore meets the requirements of GDC 51.

- 2) Main Steam Penetration Process Pipe - SA 106 Gr. C; 1.5" min. wall. NUREG-0577, Table 4.4 assigns a  $(NDT + 1.3^{\circ}C)$  NDT of  $77^{\circ}F$ . Summer Addenda Class 2 rules assign a PLSMT of  $107^{\circ}F$ . The design LSMT of this material is  $115^{\circ}F$  (which will be experienced during hydrotest) and therefore meets the requirements of GDC 51.
- 3) Main Feedwater Penetration Process Pipe - SA 106 Gr. B; 0.937 min. wall. NUREG-0577, Table 4.4 assigns a  $(NDT + 1.3^{\circ}C)$  NDT of  $77^{\circ}F$ . Summer 1977 Addenda Class 2 rules assign a PLSMT of  $107^{\circ}F$ . The design LSMT of this material is  $115^{\circ}F$  (which will be experienced during hydrotest) and therefore meets the requirements of GDC 51.

#### B. Piping Subassemblies

- 1) Main Steam Process Pipe - SA 106 Grade C; 31.438" ID x 1.75" min. wall and 31.438" ID x 1.375" min. wall. NUREG-0577, Table 4.4 would assign a  $(NDT + 1.3^{\circ}C)$  NDT of  $67^{\circ}F/77^{\circ}F$  to this material. Summer 1977 Addenda Class 2 rules would assign a PLSMT of  $97^{\circ}F/107^{\circ}F$  to the material. The design LSMT of this material is  $115^{\circ}F$  (which will be experienced during hydrotest) and therefore meets the requirements of GDC 51.
- 2) Main Steam Process Pipe Fittings - SA 234 WPC (SA 106 Gr. C) 31.5" ID x 2.37" nom. wall manifold. NUREG-0577, Table 4.4 would assign a  $(NDT + 1.3^{\circ}C)$  NDT of  $67^{\circ}F/77^{\circ}F$  to this material. Summer 1977 Addenda Class 2 rules would assign a PLSMT of  $97^{\circ}F/107^{\circ}F$  to this material. The design LSMT of this material is  $115^{\circ}F$  (which will be experienced during hydrotest) and therefore meets the requirements of GDC 51.

SA 234 WPC (SA 106 Gr. C); 31.625" x 1.375" min. wall ell; 31.625" x 1.750" min. wall (see above analysis).

SA 105, normalized, 1" x 3000#, 2" x 3000" weld boss; est. thickness  $\leq 2 \frac{1}{2}"$ . NUREG -0577, Table 4.4 would assign a  $(NDT + 1.3^{\circ}C)$  NDT of  $-5^{\circ}F$  to this material. Summer 1977 Addenda Class 2 rules would assign a PLSMT of  $25^{\circ}F$ . The design LSMT of this material is  $115^{\circ}F$  (which will be experienced during hydrotest) and therefore meets the requirements of GDC 51).

SA 105, normalized, 34" (1.375" min. wall) x 6" (0.432" min. wall) sweepolet (see above 2" x 3000# weld boss analysis).

SA 105; 10" x 6" OD transition piece, 10" x 8.75" OD transition piece. CMTR identified the materials as having been normalized. Grinnell Traveler CT-SM-7D calls out 10" x 1 1/2" nom. wall manifold outlets. NUREG-0577, Table 4.4 assigns a  $(NDT + 1.3^{\circ}C)$  NDT of  $-5^{\circ}F$  to this material. Summer 1977 Addenda Class 2 rules assign a PLSMT of  $25^{\circ}F$ . The design LSMT of this material is  $115^{\circ}F$  (which will be experienced during hydrotest) and therefore meets the requirements of GDC 51.

- 3) Main Feedwater Process Pipe - SA 106 Gr. B, 18" x S80 (0.937"), assumed to be normalized. NUREG-0577 Fig. B7 and Table 4.4 would assign the material a  $(NDT + 1.3^{\circ}C)$  NDT in that population below  $40^{\circ}F$ . Based on an assigned NDT of  $40^{\circ}F$ , Summer 1977 Addenda Class 2 rules would assign a PLSMT of  $70^{\circ}F$ . The design LSMT of this material is  $115^{\circ}F$  (which will be experienced during hydrotest) and therefore

meets the requirements of GDC 51.

- 4) Main Feedwater Process Pipe Fittings - SA 234 WPB (SA 106 Gr. B) 18" x S80 (0.937") ell. Based on the analysis for the feedwater piping, a PLSMT of 70°F is assigned to this material. The design LSMT is 115°F (which will be experienced during hydrotest) and therefore meets the requirements of GDC 51.

SA105 weld boss; normalized; 3/4" and 2". Based on the analysis for the main steam bosses above, a PLSMT of 25°F is assigned to this material. The design LSMT is 115°F (during hydrotest) and therefore meets the requirements of GDC 51.

### C. Isolation Valves

- 1) Main Steam Isolation Valve Body - SA 216 Grade WCB; normalized; 2 3/16" min. design thickness. NUREG-0577, Table 4.4 assigns a  $(\overline{NDT} + 1.3\sigma)$  NDT of 57°F to 2 1/2" to 5" thick materials. Summer 1977 Addenda Class 2 rules would assign a PLSMT of 87°F. The design LSMT of this material is 115°F (which will be experienced during hydrotest) and therefore meets the requirements of GDC 51.
- 2) Main Steam Isolation Valve Cover - SA 105; quenched and tempered; 5.56" min. design thickness. NUREG-0577, Table 4.4 would assign a  $(\overline{NDT} + 1.3\sigma)$  NDT at or below -28°F given that the material was quenched and tempered. Summer 1977 Addenda Class 2 rules would assign a PLSMT of 30°F to the material. The design LSMT is 115°F (during hydrotest) and therefore meets the requirements of GDC 51.
- 3) Main Steam Isolation Valve Poppet - SA 105; quenched and tempered; 6 7/8; r.i.n. design thickness. Given the analysis for the valve cover above, Summer 1977 Addenda Class 2 rules would assign a PLSMT of 39°F to the material. The design LSMT is 115°F (during hydrotest) and therefore meets the requirements of GDC 51.
- 4) Main Steam Isolation Valve Pilot Poppet - SA 182 F6 (410 SS); 2" min. design thickness, oil quenched and tempered. From forging prolongation, the estimated  $(\overline{NDT} + 1.3\sigma)$  NDT is assumed as 60°F. Summer 1977 Class 2 rules would assign a PLSMT of 90°F. The design LSMT of this material is 115°F (during hydrotest) and therefore meets the requirements of GDC 51.
- 5) Main Feedwater Isolation Valve Body - SA 105; normalized; 1.8" min. design thickness. NUREG-0577, Table 4.4 assigns a  $(\overline{NDT} + 1.3\sigma)$  NDT of -5°F. Summer 1977 Addenda Class 2 rules assign a PLSMT of 25°F. The design LSMT of this material is 115°F (during hydrotest) and therefore meets the requirements of GDC 51.
- 6) Main Feedwater Isolation Valve Bonnet - SA 105; normalized; 3 1/4" min. design thickness. NUREG-0577, Table 4.4 assigns a  $(\overline{NDT} + 1.3\sigma)$  NDT of 5°F. Summer 1977 Addenda Class 2 rules assign a PLSMT of 38°F. The design LSMT of this material is 115°F (during hydrotest) and therefore meets the requirements of GDC 51.
- 7) Main Feedwater Isolation Valve Neck - SA 105; normalized; 1.8" min. design thickness. Assuming a  $(\overline{NDT} + 1.3\sigma)$  NDT of -5°F, the Summer 1977 Addenda Class rules assign a PLSMT of 25°F. The design LSMT of this material is 115°F (during hydrotest) and therefore

meets the requirements of GDC 51.

- 8) Main Feedwater Isolation Valve Retainer - SA 105; normalized; quenched and tempered; 2.9" min. design thickness. Assuming a  $(NDT + 1.3\sigma)$  NDT of  $-5^{\circ}\text{F}$ , the Summer 1977 Addenda Class 2 rules assign a PLSMT of  $35^{\circ}\text{F}$ . The design LSMT of this material is  $115^{\circ}\text{F}$  (during hydrotest) and therefore meets the requirements of GDC 51.

## II. MATERIAL FORMS

In order to provide an additional basis for support, attached are the appropriate code data report forms for the penetration assemblies, the main steam system shop fabricated piping, and the main steam and feedwater isolation valves.

CN-SA-83-438

June 23, 1983

C. C. Rolfe

Attention: T. A. Ford


Re: Catawba Unit 1  
Main Steam and Feedwater Penetrations  
GDC-51  
File: CN-1206.02-58

This letter is in response to questions raised by the NRC concerning the design thickness of the Main Steam and Feedwater Systems Flued Heads.

These flued heads are a part of floating penetration assemblies. The penetrations are not anchored to the Reactor Building shell wall but "float" on bellows assemblies on both sides of the wall. Because of this arrangement, the only significant loads on the flued head will be due to pressure in the event of a pipebreak.

The longitudinal thickness of the Main Steam Flued Head is 5 $\frac{1}{2}$ ". The longitudinal thickness of the Feedwater Flued Head is 4". The required thickness of the Main Steam Flued Head and the Feedwater Flued Head is less than 2' thick.

Please call J. D. Duncan at 6246 if you have questions.

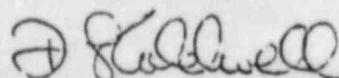

D. L. Caldwell  
Supervising Design Engineer

JDD/eam

cc: R. W. Bonsall  
S. S. Lefler  
W. R. Selden

Catawba Nuclear Station  
Containment Structures  
Compliance with GDC 51

1. LOWEST SERVICE METAL TEMPERATURE (LSMT)

The lowest service metal temperature is identified as the limiting temperature which will be experienced by the limiting materials of the containment pressure boundary during the performance of the containment function under operating, maintenance, testing and postulated accident conditions. Calculations based upon conservative assessment of the ambient atmospheric conditions, the insulation and enclosure provided, and the specified minimum containment atmosphere temperature show the LSMT to be 49°F for the steel containment vessel, personnel locks, penetration sleeves and penetration insert plates. The exterior face of the equipment hatch is exposed to ambient outdoor air conditions, and therefore it will experience a lower LSMT than the remainder of the steel containment. The LSMT for the equipment hatch is calculated to be 35°F.

## 2. CONTAINMENT PRESSURE BOUNDARY MATERIALS (FERRITIC)

Containment pressure boundary materials have been reviewed within the context of General Design Criterion 51. The materials of the following components were characterized with respect to fracture toughness:

### A. STEEL CONTAINMENT VESSEL, PERSONNEL LOCKS, EQUIPMENT HATCH, AND PENETRATION SLEEVES

#### 1) General

As stated in Section 3.8.2 of the Catawba FSAR, the steel containment is designed, fabricated and erected in accordance with Subsection NE of the ASME Code, 1971 Edition, including addenda through Summer 1972. This Code edition provides for material fracture toughness by requiring drop-weight tests or Charpy V-notch tests at 30°F or more below the lowest service metal temperature. This temperature was identified in the procurement specifications as 10°F for the steel containment vessel, equipment hatch and penetration sleeves, and as 48°F for the personnel lock. These temperatures are below the calculated LSMT for each component. Consistent and acceptable Charpy V-notch test results have been obtained at test temperatures at least 30°F below the specified lowest service metal temperature, insuring that the material is acceptable for its intended service.

To further demonstrate the suitability of these materials, the discussion below establishes that the service conditions for the material are well removed from the nil-ductility region. Generic nil-ductility transition temperatures for each type of material are used when data is available.

## 2. CONTAINMENT PRESSURE BOUNDARY MATERIALS (FERRITIC) (cont'd)

### A. STEEL CONTAINMENT VESSEL, PERSONNEL LOCKS, EQUIPMENT HATCH, AND PENETRATION SLEEVES, (cont'd.)

#### 2) Steel Containment Vessel

SA-516 Gr 60, normalized, 1", 3/4", and 11/16" thick are identified as having been applied. Typical certified mill test reports for 1" plate show Charpy V-notch test data which does not support the use of the Charpy test temperature as the LSMT within the context of the ASME Summer 1977 Addenda Class 2 rules. However, these ASME rules, NUREG/CR-3009, and CBI in-house data will support assigning a nil-ductility transition temperature of 0°F and a permissible lowest service metal temperature (PLSMT) of 30°F for these materials.

#### 3) Penetration Insert Plates

Thickened insert plates are installed in the containment vessel at some penetrations. SA-516 Gr. 60, normalized, 3/4", 1 1/4", and 1 3/8" thick are identified as having been applied. Certified mill test reports for typical 1 3/8" plate were submitted for review. As was the case for the steel containment vessel itself, ASME Summer 1977 Addenda Class 2 rules, NUREG/CR-3009, and CBI in-house data will support assigning a nil-ductility transition temperature of 0°F and a PLSMT of 30°F for these materials.

#### 4) Penetration Sleeves

SA-333 Gr 6, 24" Schedule 100, 1.531" thick, normalized, is identified as a limiting material. Certified mill test report indicates that the material was Charpy V-notch tested at -30°F to criteria consistent with the ASME Summer 1977 Addenda Class 2 rules and is acceptable for service at 49°F.

Formed, welded, and stress relieved sleeves applying normalized SA-516 Gr 60 in 3/4", 1 1/4", and 1 3/8" thicknesses are identified as limiting materials. Subsection NE rules required qualification of the forming process, including tests to determine that required impact properties are met after straining. Procedure qualification was required to be conducted using material of the same specification, grade or class, and heat treatment. Certified mill test report data for 1 3/8" thick normalized material indicate that the material, before and after fabrication, met Subsection NE Charpy V-notch requirements. While the Charpy results at -30°F do not meet ASME Summer 1977 Addenda Class 2 rules to support the test temperature as the LSMT, they do support a PLSMT of 49°F or lower. Based on NUREG/CR-3009 and ASME Summer 1977 Addenda Class 2 Rules, a PLSMT of 30°F would be developed. A similar analysis is applied to 3/4" and 1 1/4" thick materials.

2. CONTAINMENT PRESSURE BOUNDARY MATERIALS (FERRITIC) (cont'd.)

A. STEEL CONTAINMENT VESSEL, PERSONNEL LOCKS, EQUIPMENT HATCH, AND PENETRATION SLEEVES (cont'd.)

5) Personnel Air Lock

SA-516 Gr 70, normalized, 2 1/2" thick is identified as a limiting material. Charpy V-notch mils lateral expansion data at -30°F do not meet ASME Summer 1977 Addenda Class 2 rules to support the test temperature as the LSMT. However, these rules would assign a nil-ductility transition temperature of 0°F and a PLSMT of 30°F to the material.

SA-333 Gr 6, 6" Schedule 80, 0.432" thick, and 3" Schedule 40, 0.216" thick, identified as containment pressure boundary materials, would be exempted from Charpy V-notch testing by the ASME Summer 1977 Addenda Class 2 rules. Certified mill test reports, however, indicate that the materials were Charpy tested at -50°F, to Charpy V-notch mils lateral expansion supporting a service temperature of 49°F.

SA-350 Gr LF2 fitting, Scrd. coupling 1"-3000#, is identified as a containment pressure boundary material. Based upon dimensioning of commercial forged steel fittings, ASME Summer 1977 Addenda Class 2 rules would exempt the material from testing. However, certified mill test reports indicate that the material was Charpy V-notch tested to energy criteria consistent with the ASME Summer 1977 Addenda Class 2 rules supporting a service temperature of 49°F for the material.

6) Equipment Hatch

SA-516 Gr 70, normalized, 3" thick, used in the hatch barrel, is identified as a limiting material. NUREG/CR-3009 Table 4.4 assigns a 90% confidence nil-ductility transition temperature of -5°F to the material. CBI in-house data shows typical nil-ductility transition temperatures for such material of -10°F and below. ASME Summer 1977 Addenda Class 2 rules can therefore assign a PLSMT of 35°F to the material.

SA-516 Gr 70, normalized, 1 1/8" thick is applied for the dished hatch cover. Consistent with the analysis for the barrel above, ASME Summer 1977 Addenda Class 2 rules would assign a PLSMT of 25°F to the material.

3. QUALITY ASSURANCE DOCUMENTATION FOR LIMITING MATERIALS

- A. CMTR NNI File #46 (1" plate SA-516 Gr 60) (Steel Containment Vessel)
- B. CMTR NNI File #50 ( 1 3/8" plate SA-516 Gr 60) (penetration insert plates and fabricated penetration sleeves)
- C. CMTR NNI File #i87 (24" diameter Sch 100 SA-333 Gr 6) (penetration sleeves)
- D. CMTR Lakeside Bridge and Steel, Heat #T68952 (3" plate SA-516 Gr 70) (Equipment hatch barrel)
- E. CMTR Lamco Industries Heat #67302 (2 1/2" plate SA-516 Gr 70) (Personnel air lock)
- F. CMTR US Steel Heat #A01359 (6" diameter Sch 80 SA-333 Gr 6) (Personnel air lock)
- G. CMTR US Steel Heat #N14522 (3" diameter Sch 40 SA-333 Gr 6) (Personnel air lock)
- H. CMTR Metalloy Heat #8865304 (1" blind flange, SA-350 Gr LF2)
- I. NNI Quality Assurance package for containment plate assembly 1-3-13  
(Shows forming process for thickest fabricated sleeves and stress relief of entire assembly following penetration installation.)
- J. NNI Quality Assurance package for containment insert plate assembly 113-1  
(Shows thickest penetration insert plate, sleeve fabrication and stress relief of assembly after sleeve installation.)

3A

W-2181

PHOENIX STEEL CORPORATION  
CLAYMONT, DELAWARESPECIFICATION ASME SA 516 GR 60 PWI-SMA. LUGG'L V-NOTCH IMPACT Q-30 DEG F. CLAYMONT, DEL.  
TJ NE-2350 (SLC III 1973 & AUS/EN/SA)  
CHEMICAL AND PHYSICAL TESTS OF Silicon Quality Steel

May 19, 1975

CUSTOMER'S ORDER NO. 5024-A-7

CHARGED TO - Newport News Industrial Corp.  
Sub. of Newport News Shipbuilding  
SHIPPED TO - Newport News, Va. 23606

MILL ORDER NO. 23624-05

CAR NO. PG 523342

OK

Homogeneity Test

MELT No.	SLAB No.	SERIAL No.	CHEMICAL ANALYSIS							TEST PRICE		Yield Point Per. Ag. In.	Tensile Strength Lbs. Per sq. In.	Elong. in. %	SIZE
			Cmn	Mn	Prec	Ni	Cr	Mn	Thickness	Sec. Area					
Vee-notch Charpy Impact Testing Q-30 DEG F.															
66333-26	49732	75 HNS 232	.10	.96	.017	.018	.15	Lw 60-16-12	.92	45300	65300	33.5	1-in 40.8/5x111x336		
	49733	75 HNS 232						Lw 12-50-63	.974	45200	65300	29.7	1-in "		
	49734	75 HNS 232						Lw 5-10-103	.973	45200	67600	34.0	1-in "		
66504-26	49734	75 HNS 232	.10	1.20	.014	.030	.29	Lw 4-152-44	.990	51700	71100	30.2	1-in "		
96915-26	49735	75 HNS 232	.09	1.13	.011	.018	.16	Lw 130-124-128	.995	46600	64710	32.5	1-in "		
86767-67	4343	75 HNS 232	.09	1.14	.003	.024	.23	Lw 9-100-108	.976	47100	70500	26.5	1-in "		
43346	16	HNS 235						Lw 10-112-93	.992	45600	65700	31.7	1-in "		1.0
43347	16	HNS 235						Lw 102-100-96	.992	50400	65300	33.2	1-in "		
43348	16	HNS 235						Lw 2-22-22	.995	51300	76300	23.5	1-in "		
43349	16	HNS 235						QC ACCEPTED 1 of 2	.987	50400	65300	33.2	1-in "		
96375-67	4320	75 HNS 235	.11	1.13	.013	.030	.23	Lw 70-74-62	.959	45400	61600	30.0	1-in "		

PLATES AND TEST PLS. UNHEATED AT 1600-1500 deg F., HOLD FOR 15 MIN. OF THICKNESS AND AIR COOLED.  
SLENDER AND SHORT TO BEFORE 12"

SLENDER AND SHORT TO BEFORE 12"

N. N. I. C.  
RECORD CENTER  
FILE COPY 461. These figures are correct as  
printed in the records of the Corporation.

W-2181

PHOENIX STEEL CORPORATION  
CLAYMONT, DELAWARESPECIFICATION ASME SA 516 CR 60 PWI-SMA. LUGG'L V-NOTCH IMPACT Q-30 DEG F. CLAYMONT, DEL.  
TJ NE-2350 (SLC III 1973 & AUS/EN/SA)  
CHEMICAL AND PHYSICAL TESTS OF Silicon Quality Steel

May 19, 1975

CUSTOMER'S ORDER NO. 5024-A-7

CHARGED TO - Newport News Industrial Corp.  
Sub. of Newport News Shipbuilding  
SHIPPED TO - Newport News, Va. 23606

MILL ORDER NO. 23624-05

CAR NO. PG 523342

OK

Homogeneity Test

MELT No.	SLAB No.	SERIAL No.	CHEMICAL ANALYSIS							TEST PRICE		Yield Point Per. Ag. In.	Tensile Strength Lbs. Per sq. In.	Elong. in. %	SIZE
			Cmn	Mn	Prec	Ni	Cr	Mn	Thickness	Sec. Area					
N. N. I. C. RECORD CENTER FILE COPY 46															
66333-26	49732	Lw Exp. .074-.073-.069													
		& Check 233440.430%													
	49733	Lw Exp. .074-.045-.090													
		% Check 433440.452%													
	49734	Lw Exp. .074-.073-.077													
		& Check 533440.462%													
86767-67	4320	Lw Exp. .073-.070-.137													
		% Check 20.470-20%													
96215-26	49735	Lw Exp. .074-.064-.070													
		% Check 100.472-40%													
96721-67	4320	Lw Exp. .070-.059-.068													
		& Check 22.470-40%													
85767-67	4320	Lw Exp. .074-.073-.062													
		& Check 50.470-40%													
43346	16	Lw Exp. .071...0...0.076													
		& Check 60.470-40%													
43347	16	Lw Exp. .072-.070-.079													
		& Check 52.470-40%													
43348	16	Lw Exp. .071...0...0.024													
		& Check 50.470-40%													
43349	16	Lw Exp. .072...0...0.021													
		& Check 50.470-40%													

SLENDER AND SHORT TO BEFORE 12"

1. These figures are correct as  
printed in the records of the Corporation.Tracy  
Tracy A. MalleyJ. W. K. B.  
John W. K. B.

3B

W-662-1-R1

PHOENIX STEEL CORPORATION  
CLAYMONT, DELAWARE

SPECIFICATION ASME SA 516 GR 60 Normalized, Long V-Notch Impacts at Minus 30 Deg F to 1E-2350 (Sec III-1973 & Addenda) to Meet 15 Ft. Lb.  
 CHEMICAL AND PHYSICAL TESTS OF Silicon Quality Steel  
 CHARGED TO: Newport News Industrial Corp., Subsidiary of Newport News Shipbuilding  
 SHIPPED TO: Newport News, Va. 23606

May 20, 1975  
 CLAYMONT, DEL.  
 CUSTOMER'S ORDER NO. 5024-A-7  
 MILL ORDER NO. 23624-05  
 CAR NO. MILW 60163

MELT No.	SLAB No.	SERIAL No.	CHEMICAL ANALYSIS						TEST PIECE			Yield Point in Psi. Per Sq. In.	Tensile Strength Lbs. Per Sq. In.	Elong. in %	Red. Test OK	Dimensions Test
			CARB	MANG	PHOS	NIQUE	SI	CR	Mn	Thickness	Var. Area					
86205-25	65789	75HNL253	.10	1.20	.016	.010	.22	L=20-21-22		.736	45700	70200	29.5	1 - 30.6" x 114" x 336"		
	65790	75HNL253						L=30-31-28		.722	52000	71100	23.5	1 - 4 " "		
	65791	75HNL253						L=13-130-130		.733	52000	71900	29.2	1 - 17 " "		
	65793	75HNL253						L=130-121-130		.737	51600	70300	30.5	1 - 6 " "		
	65794	75HNL253						L=106-105-110		.726	49300	71600	30.7	1 - 5 " "		
	65795	75HNL253						L=112-112-108		.700	49300	71000	31.2	1 - 20 " "		
	86793-26	49085	75HNL254	.10	1.01	.020	.030	.19	L=110-109-114		.724	45700	69500	31.5	2 - 22 " "	
	86793-26	49083	75HNL254	.11	.95	.009	.021	.23	L=76-72-76		.735	51300	71000	31.0	1 - 23 " "	
	86793-26	49086	75HNL255	.11	.95	.009	.020	.23	L=50-40-36		.718	49600	70500	27.5	1 - 24 " "	
	86796-26	65677	75HNL255	.10	1.10	.016	.023	.20	L=60-66-59		.729	49300	69500	26.0	1 - 2 30.6" x 114" x 336"	Item #15
	96875-26	65422	75HNL256	.13	1.13	.013	.030	.23	L=106-100-100		1.367	47700	68000	33.2	1 - 156.1" x 112" x 222"	Item #30
	86423	75HNL256						L=30-33-36		1.375	49500	69200	29.7	1 - 2 " "		

PLATES AND TEST -CS NORMALIZED AT 1600-1650 DEG F., HELD FOR ONE HOUR PER INCH OF THICKNESS AND AIR COOLED.

SUBSCRIBED AND SWEORN TO BEFORE ME

<i>James A. Malony</i> James A. Malony New York	<b>N. N. I. C.</b> <b>RECORD CENTER</b> <b>FILE COPY 50</b>
---	---

I certify the above figures are correct as recorded in the records of the Corporation.

*J. W. K.*  
 J. W. K. - President, N. N. I. C.

W-662-1-R1

PHOENIX STEEL CORPORATION  
CLAYMONT, DELAWARE

SPECIFICATION ASME SA 516 GR 60 NORMALIZED LONG'SL V NOTCH IMPACT @-30 DEG F. 1E-2350 (SEC III-1973 & ADDENDA)  
 CHEMICAL AND PHYSICAL TESTS OF Silicon Quality Steel  
 CHARGED TO: Newport News Industrial Corp., Subsidiary of Newport News Shipbuilding  
 SHIPPED TO: Newport News, Va. 23606

May 20, 1975  
 CLAYMONT, DEL.  
 CUSTOMER'S ORDER NO. 5024-A-7  
 MILL ORDER NO. 23624-05  
 CAR NO. MILW 60163

MELT No.	SLAB No.	SERIAL No.	CHEMICAL ANALYSIS						TEST PIECE			Yield Point in Psi. Per Sq. In.	Tensile Strength Lbs. Per Sq. In.	Elong. in %	Red. Test OK	Dimensions Test
			CARB	MANG	PHOS	NIQUE	SI	CR	Mn	Thickness	Var. Area					
86506-26	65709	L. Exp.	.016-.013-.020						96875-26	65422	L. Exp.	.077-.080-.079				
	65709	% Shear	10%-10%-10%							65423	% Shear	53%-50%-50%				
	65709	L. Exp.	.051-.074-.068							65423	L. Exp.	.071-.076-.079				
	65709	% shear	30%-40%-40%								% Shear	40%-45%-40%				
	65709	L. Exp.	.090-.097-.095													
	65709	% Shear	70%-70%-60%													
	65709	L. Exp.	.105-.095-.095													
	65709	% shear	100%-60%-100%													
	65709	L. Exp.	.079-.071-.070													
	65709	% Shear	30%-30%-40%													
	65709	L. Exp.	.072-.071-.076													
	65709	% Shear	70%-60%-60%													
	86799-26	49035	L. Exp.	.071-.072-.085												
	86799-26	% Shear	50%-40%-50%													
	86813-26	49433	L. Exp.	.057-.051-.059												
	86813-26	% Shear	50%-50%-50%													
	49436	L. Exp.	.021-.023-.023													
	49436	% Shear	10%-20%-10%													
	86796-26	45677	L. Exp.	.057-.051-.051												
	86796-26	% Shear	30%-20%-30%													

SUBSCRIBED AND SWEORN TO BEFORE ME




*James A. Malony*  
 James A. Malony  
 New York

<b>N. N. I. C.</b> <b>RECORD CENTER</b> <b>FILE COPY 50</b>
---

I certify the above figures are correct as recorded in the records of the Corporation.



*J. W. K.*  
 J. W. K. - President, N. N. I. C.

IMAGE EVALUATION  
TEST TARGET (MT-3)

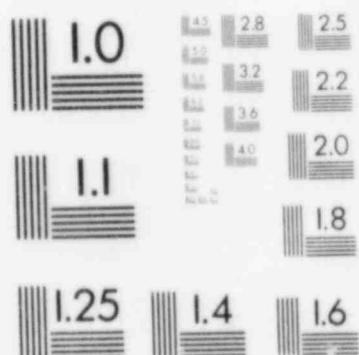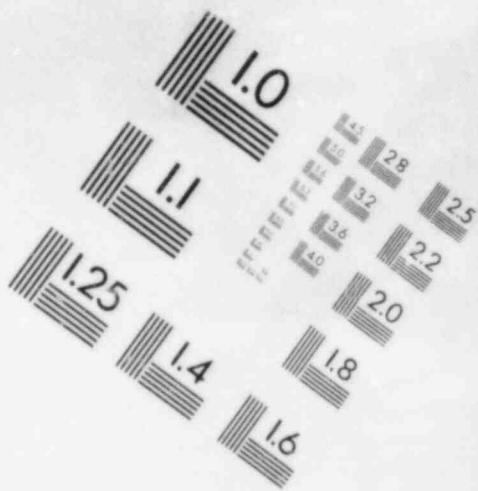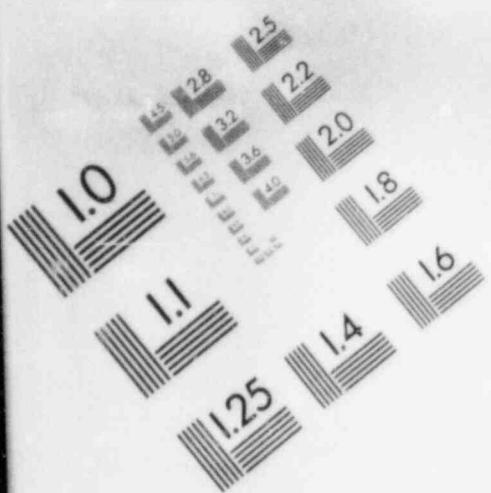

150mm

67

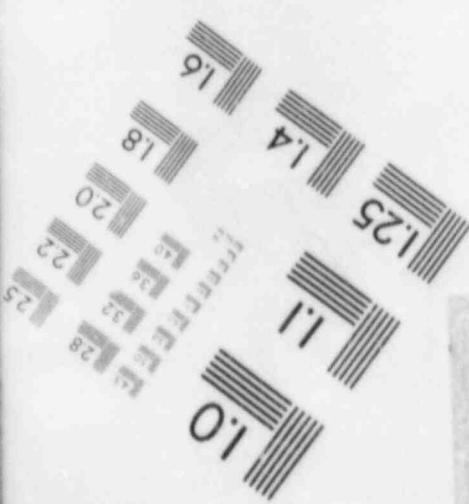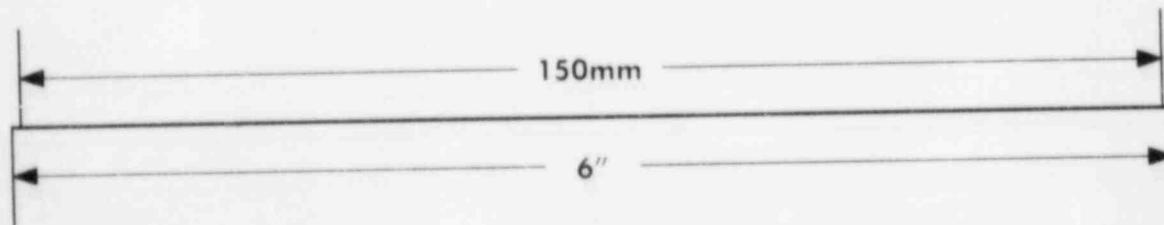

Newport News Industrial Corporation Subsidiary of Newport News Shipbuilding A Tenneco Company			MATERIAL INVESTIGATION REQUEST				
Material Condition <b>CARBON STEEL/AS-FORMED</b>		Date Rec'd by LAB SEP 23 1975	Date Reported SEP 23 1975	File Code M11100/52075/-	Lab No. 5249-1C		
		Heat No. N/A	Batch TS NNI 256	QA Control No. TS NNI 256	Witness N/A		
Name of Article	No. Pos	Group/Sheet/Line	Item	Drawing/Pattern No.	J.O.	Control Level	Specification
Penetration Test Plate	1	SG ASI-7/1/13	17	288108	5024-A	ASME NUC.	SA-S1G6R1C
PLEASE IMPACT TEST PER SA-370 AS SPECIFIED IN INSTRUCTION 451-NC-TCC1.							
<b>TEST RESULTS</b>							
Distribution T.C. BOND, NNI ENGINEERING/DESIGN Form 1-455 JIM STAFFORD, NNI CA							
MISCELLANEOUS TEST CHARPY NN 2201-4 IMPACT TEST NNS & CO. CO.			DATE REC'D.	DATE REPORTED	LAB NO.		
Sample No.	Temp Ft/Lbs	Sample No. ft/lbs No.	Sample Temp Ft/Lbs No. °F	Sample Temp Ft/Lbs No. °F	5249-2		
17.1	-50	46					
17.2	1	42	QC NO 15 NNI - 256				
17.3	1	26					
PERFORMED BY Brynum 9-23-75				CHECKED BY W.W. Jones			

TENNECO				Newport News Industrial Corporation Subsidiary of Newport News Shipbuilding A Tenneco Company			MATERIAL INVESTIGATION REQUEST		
Material/Condition		Date Rec'd by LAB	Test/Inspection Date	File Code	MANUFACTURE / 520701 / Lab No.				
CARBON STEEL/AS-FORMED		Test No.	N/A	Batch	QA Control No.	Weldness			
Name of Article	No. Pcs	Group/Subs/Line		Item	Drawing/Pattern No.	J.O.	Contract Spec Level		
PERFORATION TEST PLATE	1	SG-451-7/1/12		16	288108	5021-A	ASME NC ISA		
PLEASE IMPACT TEST PER				SA-310 AS SPECIFIED IN					
				INSTRUCTION 451-NC-T001.					
TEST RESULTS									
Distribution T.E. BOND, NNI ENGINEERING/DESIGN									
Form 1-485 JIM STAFFIERA, NNI GA									

N. N. I. C.  
RECORD CENTER  
FILE COPY 150

OK TO  
SPEC  
Jindallite

75 NNI 256 (ONLY)  
4 OF 4

N. N. I. C.  
RECORD CENTER  
FILE COPY 50

75 NNT 25% (only)  
3 of 4

L A T E: DEC. 02, 1975 CERTIFICATE NO. YYD1542  
SUPPLIER: 009 235 3751 C. ITON AND CO., LTD.  
CUSTOMER: NEWPORT NEWS INDUSTRIAL CORP.  
ARTICLE: SEAMLESS CARBON STEEL PIPE (HOT FINI



**MILL CERTIFICATE**

MASTER CODE

10 SUMITOMO METAL INDUSTRIES, LTD.  
STEEL TUBE WORKS

#### 1. MISUNDERSTANDING OF THE TERM "CULTURE"

STANDARD ASME 34333 CB-6 and ASME Sect. III NF-3222

SPECIFICATION: CAF REPRODUCED 4-19-67

J. CONTRACT NO.

P. O. DATE PURCHASE ORDER NO.

2C9210-11 11/27/78

SHIPPER'S NO.

MILL ORDER NO.

P. VOICE NO.

H00547 3 27 79

NB60360

154-15846

VEHICLE IDENTITY EJE 35142

GARY WORKS  
GARY, INDIANA 46402LAKESIDE BRIDGE & STEEL CO  
5300 NO 33RD ST  
MILWAUKEE WISC 53209LAKESIDE BRIDGE & STEEL CO  
5300 NO 33RD ST  
MILWAUKEE WISCONSIN

PLATES CARBON ASME SA516-76/1977/SUMMER 1977  
 ADDENDA GRADE 70 PRESSURE VESSEL QUALITY NORMALIZE  
 PLATE AND SUB-SECTION NE OF SECTION III OF ASME  
 1977 EDITION WITH SUMMER 1977 ADDENDA SUB-  
 : MILL THE APPLICABLE PROVISIONS OF 10CFR PART 21 APPLY

\*\*SEE BELOW

BEING DULY SWEORN ACCORDING  
 TO LAW, DEPOSES AND SAYS  
 THAT THE CHEMICAL ANALYSES  
 AND/OR TEST RESULTS SHOWN  
 IN THIS REPORT ARE CORRECT  
 AS CONTAINED IN THE RECORDS  
 OF THE COMPANY.

BY: *Lukichson*  
 A. BELKIN  
 MGR QUALITY ASSURANCE

DATE

STATE OF INDIANA

COUNTY OF LAKE

SUBSCRIBED AND SWEORN TO BEFORE ME  
 THIS 4 DAY OF APRIL 1979NOTARY PUBLIC  
*Walter L. Dierck*  
 MY COMMISSION EXPIRES

MARCH 14, 1982

THICKNESS OR SECTION	MATERIAL DESCRIPTION			QUAN- TITY	WEIGHT	HEAT NO.	TEST OR PIECE IDENTITY	YIELD PT. PSI	TENSILE STA PSI	ELONGATION %		% RED. OF AREA	BEN
	WIDTH	DIA.	OR FL. WT.							IN B"	IN 2"		
3.0000"	60.000			1	9189	T68952	01 W2	+ 54000 + * 46400	82500 83000	29.0 29.0			
FULL SIZE CHARPY IMPACTS	FT LBS -	57-54-53											
FULL SIZE CHARPY IMPACTS	FT LBS -	31-31-39											
PLATES AND TEST SPECIMENS	NORMALIZED 1660 F												
LONGITUDINAL	V-NOTCH CHARPY IMPACTS AT MINUS	30 F											
+NORMALIZED													
*NORMALIZED AND STRESS RELIEVED													
**PARAGRAPHS NE-2100 NE-2200 NE-2300 NE-2400 NE-2500 NE-2600 NE-2700 THOSE PARAGRAPHS APPLICABLE TO PLATE PRODUCT FURNISH NORMALIZED TEST SPECIMENS PLUS NORMALIZED AND STRESS RELIEVED TEST SPECIMENS FOR 8 HOURS FURNISH ONE TENSILE TEST IN NORMALIZED CONDITION ONLY IMPACTS IN BOTH CONDITIONS QUALITY ASSURANCE CERT REQ TO MEET CHARPY V-NOTCH LONGITUDINAL IMPACT TESTS EA PLATE AS HEAT TREATED AT 20 FT/LBS AT MINUS 30 DEG F HEATING AND COOLING RATES PER NE-4623 SPECIAL SPEC REQ B THE APPLICABLE PROVISIONS OF 10 CFR PART 21 APPLICABLY													
SYSEUL J 0050 EXT.													

LT NO.	TYPE	C	MN	P	S	SI	CU	Ni	CR	MO	SN	AL	N	V	B	TI	CB	CO	Avg Gr. Siz.	Date
8952	HEAT	23	1D8	019	015	23													1.07	APR 11 1979

TEST SPECIMENS STRESS RELIEVED AT 1150 PLUS OR MINUS 25F WITH CONTROLLED HEATING AND COOLING. FCE  
 DID NOT EXCEED 800F AT CHARGE RATE OF HEATING ABOVE 800 DID NOT EXCEED 133F PER HOUR HELD AT TEMP  
 8 HR. COOLED TO 800F. RATE OF COOLING TO 800 DID NOT EXCEED 133F PER HOUR  
 QUALITY ASSURANCE CERT NO. N1618 EXPIRES JANUARY 21, 1980

## CERTIFICATE OF TESTS

ARMCO

Armco Steel Corporation

P.O. Box 96120, Houston, Texas 77015

CUST. ORDER NO.	CUST. ORDER NO.	SHIPPED VIA	CAT. INITIAL AND NO.	DATE SHIPPED	SHIPPING LIST (RECAP) NO.	DATE MTR.
TNS 6222	015383-6817	RAIL	TP 821989	8-31-76	7001293	9-29-76

DESCRIPTION	BAR OR PLATE NO.	No. PCS.	YIELD PSI	TENSILE PSI	% ELONG.	% REDUCT.	BEND TEST	HOMO TEST	BNH	IMPACT: TYPE	A NOTCH	V SIZE	FULL
-------------	------------------	----------	-----------	-------------	----------	-----------	-----------	-----------	-----	--------------	---------	--------	------

STEEL PLT CARBON ASME SA516 GR 70 FOR PV NORM +S3 SWHT @ 1100°F  
FOR 2-1/2 HRS HT UP & COOL DOWN 160°F/HR MAX +S5 CVNL EA PLT 20,  
15 FT LBS @ -30°F NUCLEAR MAT'L TO MEET ASME B&PV CODE 1971 EDITION

WINTER '73 ADDENDA SEC III DIV 1  
CL MC

HEAT: 67302 2-1/2 x 120 x 130"

"

"

**United States Steel Corporation**

**STANDARD CERTIFIED TEST REPORT**  
**TUBULAR PRODUCTS**

Sink Progressive Pupil

DEPARTURE 1615 OF AIR LINED FRENCH TIME 45.0 MIN.

NAME  
C U S T O M E R  
CAPITAL PIPE & STEEL PRODUCTS INC - ATTN: SELMA BERMAN  
ADDRESS

ADDRESS  
P.O. Box #71

CITY AND STATE

~~CITY AND STATE~~ No. 69 Cynwyd F. 4. 1:004

1-3-16

DATA

GRADE 6 Y AJ7111 A333

ASHE SA333✓

CUSTOMER'S ORDER NO.

75-4559-00

**U.S. STEEL ORDER NO.**

KC 11055

INVOICE NO.

Lamco Industries  
P.O.# 11396-5817  
S.O.# LN0902-A  
Ch# P-34729  
Item# 1

AUG 14 1978

FATTENING TEST OK

P/N 32297-01

We hereby certify that the above figures are correct,  
as contained in the records of the company.

CHECKED TO SEC III MC  
AND CL2 MAILED THRU WINT'73

STANDARD SWEATED TEST REPORT  
TUBULAR PRODUCTS

Seamless Pressure Pipe

Normalized 1600° for 6.2 Min. Quenched  
Cryotrol Pipe + Steel Products Inc.

5-12-75 DATE  
GRADE 6 ASME SA333

CUSTOMER'S ORDER NO. 67332-30

U.S. STEEL ORDER NO. AH 02315

356-02415

Longitudinal tensile test

CAGE NO. LOT NO.	SIZE IN. MM.	SAE GRADE	HEAT NO. / WT. IN. LBS.	TEST NO. WT. IN. LBS.	MECHANICAL PROPERTIES		CHEMICAL ANALYSIS (%)					
					YIELD STRENGTH L.B.S.	TENSILE STRENGTH L.B.S.	C	Mn	P	S	Si	Mo
842 6.625-432			A01359 2800 50600	71280 45.0 17	✓	✓	✓	✓	✓	✓	✓	✓
			A01359 2800 50790	69800 44.0 17	✓	✓	✓	✓	✓	✓	✓	✓
					17	106.0 10	013.16	17	108.0 009	017.16	17	108.0 009

Flattening tests satisfactory

Full size longitudinal CVN's specimens at minus -50°F


FT.LBS. % SHEAR LAT. EXP.

A01359	95	66	.018	✓
	78	79	.064	✓
	82	53	.068	✓

Full size longitudinal CVN's specimens at minus -50°F stress relieved at 100°C

FT.LBS. % SHEAR LAT. EXP.

A01359	67	51	.054	✓
	52	73	.047	✓
	35	37	.035	✓

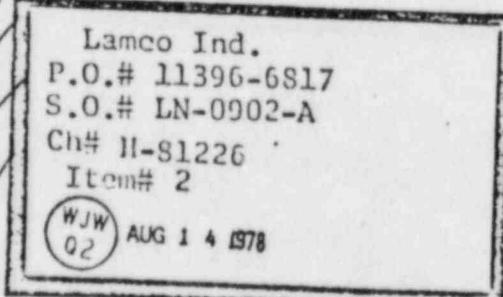

J. J. Sawin

I BEING DULY SWEATED ACCORDING TO  
LAW, DEPOSE AND SAY THAT THE FIGURES SET FORTH ABOVE ARE COR-  
RECT AS CONTAINED IN THE RECORDS OF THE COMPANY.

DEPOSED AND SWEATED TO BEFORE ME THIS

12th DAY OF August, 1975.  
Elmer J. Sawin

NOTARY PUBLIC

MY COMMISSION EXPIRES

MT. A01359

P/N 32301-06  
011 32302-06

John J. Sawin  
RNS  
Date 11/5/78

United States Steel Corporation, National Tube Division  
CHECKED TO SEC III,  
Mr. [unclear] 1978

Chief Metallurgist  
9



DECISION MANUFACTURERS FOR THE PETR CHEMICAL POWER NUCLEAR INDUSTRY

(713) 675-4341

7809 MARKET STREET ROAD

HOUSTON, TEXAS 77029

Customer McJunkin Corp.

Date Shipped

Customer Order No.

31-57776

Date 2-8-77

Our Order No.

30015

3H

ITEM	DESCRIPTION							SPECIFICATIONS						
5.	1/2" 3000# Scrd Cplg ✓							ASME SA350 LF2 ✓						
6.	1" Ditto							Ditto ✓						
ITEM	HEAT NO.	CARBON	MANG.	PHOS.	SUL.	SIL.	CHROME	NICKEL	MOLY	CU.	CO.	OTHER	OTH	MA
5.	Requirements	.30 <sub>MAX</sub>	1.35 <sub>MAX</sub>	.035	.040	.15-								
	83R302	.24 ✓	1.28 ✓	.019 ✓	.027 ✓	.23 ✓		Charpy	-50°F	40-20-30				
6.	Requirements	.30 <sub>MAX</sub>	1.35 <sub>MAX</sub>	.033	.040	.15-	.30 <sub>MAX</sub>							
	83S5304	.265 ✓	.88 ✓	.013 ✓	.024 ✓	.19 ✓		Charpy	-50°F	70-84-63				
	Requirements	MAX	MAX			MAX								
	Requirements	MAX	MAX			MAX								
ITEM	YIELD PSI			TENSILE			ELONGATION		REDUCTION			HARDNESS		
5.	Requirements	36,000 ✓	MIN	70,000-95,000	MIN	MIN	22%	MIN	30%	MIN				MA
	Actual	60,100 ✓		88,800 ✓			31% ✓		64.1% ✓					
6.	Requirements	36,000 ✓	MIN	70,000-95,000	MIN		21%	MIN	30%	MIN				MA
	Actual	57,500 ✓		82,000 ✓			30% ✓		67% ✓					
	Requirements		MIN		MIN			MIN						MA
	Actual													
	Requirements		MIN		MIN			MIN						MA
	Actual													
ITEM	SPECIAL TESTING													
	We certify that the above material complies with ASME SA350. Heat treating in accordance with ASME SA350 LF2.													
	Above fittings are capable of withstanding a hydrostatic test pressure as prescribed by ASME Specs.													
	The above fittings complies with ASME Section III Class MC-1971 Edition with Addenda thru Winter 1974.													
	FUS													
	WE CERTIFY THAT THE CHEMICAL ANALYSIS AND PHYSICAL TEST RESULTS APPLYING ON THE ABOVE ORDER NUMBER ARE CORRECT AND TRUE TO THE BEST OF OUR KNOWLEDGE AND BELIEF.													
	SEC III CL MC 1971 ED. WIN 73 ADD													
	ITEM 5 PN 32301-19. ITEM 6 PN 32292-26													
	ITEM 6 PN 32295-23													
	Eleanor Graham HARRIS													
	P.O. D15529													
	(WJW) AUG 14 1978 3/15/77 02													

Sworn and subscribed to before me 8-8-77

Eleanor Graham HARRIS

METALLOY INC.  
ITEM 6 PN 32295-23  
3H  
Lance Finch(WJW) AUG 14 1978 3/15/77  
02





Newport News Industrial Corporation

Subsidiary of Newport News Shipbuilding

A Tenneco Company

WELD  
HISTORY RECORD

JOB ORDER NO.	DWG. NO.	REV.	WELD NO.	1-3-13-3A 1-3-13-3B (2)								
LOCATION #	JOINT TYPE	MII NO.	<input type="checkbox"/> CUT NO. <input checked="" type="checkbox"/> REPAIR NO.									
45000	1/2" FILLET	451-NC-300-23	<input checked="" type="checkbox"/> SHOP INST.									
BASE MATERIAL	ITEM 1902 TO ITEM 1903	□ PIPE <input checked="" type="checkbox"/> PLATE	ORIGINAL									
MATERIAL TYPE	SA-516-ER-60	SA-516-ER-60	WELDING SUPERVISOR	DATE								
QC CONTROL NO.	25ANIC10	25NOV218	L.H. Smith	7-28-76								
ACTUAL THK.	9"	3/4"	INSPECTOR	DATE								
WELDER	ELEC/FILLER/INSERT	TYPE	REPAIR NO.	INT. PASS	PLATE	PIPE	FIT-UP	APPLICATION REQUIRING NDE	NOE ACCOMPLISHED			
EVERHART	TACK WELD SAT	N/A			1901	*		REVE 7/14/76 Weld	FINAL	TYPE	INSPECTOR/ LEVEL	DATE
0777	75MMI307	N/A			1902	*		A-3106	mt	Bapt II	8-28	
0777	75MMI307	N/A			"	"	"	A-3106	mt	Bapt II	8-30	
EVERHART	75MMI183	FINAL	148	SAT	1904	*		A-3106	mt	Bapt II	8-28	
		N/A			"	"	"	A-3106	mt	Bapt II	8-30	
					1901	*		A-3106	mt	Bapt II	8-28	
					"	"	"	A-3106	mt	Bapt II	8-30	
					1904	*		A-3106	mt	Bapt II	8-28	
					"	"	"	A-3106	mt	Bapt II	8-30	
					1901	*		A-3106	mt	Bapt II	8-28	
					"	"	"	A-3106	mt	Bapt II	8-30	
					1904	*		A-3106	mt	Bapt II	8-28	
					"	"	"	A-3106	mt	Bapt II	8-30	
					1901	*		A-3106	mt	Bapt II	8-28	
					"	"	"	A-3106	mt	Bapt II	8-30	
					1904							





Newport News Industrial Corporation

**Business Day** of London News Publishing  
1, London Wall, London EC2Y 5AU

WELD  
HISTORY RECORD





Newport News Industrial Corporation

Subsidy of Nonconventional Shipbuilding

HISTORICAL  
WELD

Weld Qualifier	Location	Weld No.	Rev.	Weld No.	Rev.
52-2414	510 540 P	288-02	8	1-10-4	8
	Base Material	Joint Type	Weld No.	Shop Inst	
		Double Bevel	52-2414-X10-9		
		Item /0 To Item /0	Plates	Cut No.	Date
MATL TYPE	SA572-GR-60	5A-56-GR-60	Welding Supervisor		
QC CONTROL NO.	75801106P	758011068	Mr. Miller	10-7-25	Date
ACTUAL THK.	1.232	1.233	Weld Up D. J. only	9-26-75	Date
WELDER	Elec. Filler/Insert	Layer No Thk	Int. Pass	Inspected	Note
	Type Size QC Control No.	Repair No.	Pre. Ht.	Date	Inspector
2108	SAE/TH	208 1/8	208W 347	SOT	Weld supervisor
			Post & Hyper		Back Ground
			A-Side	SOT	Surface
			B-Side	SOT	
			1/2" Pass	208-1-10	
			B-SIDE	208-1-10	
			FIBER	208-1-10	
			57-208W 348	SOT	
			Post	208-1-10	
			208W 345	SOT	
			Post	208-1-10	
			208W 345	SOT	

A rectangular stamp with a grid background containing the text "N. N. I. C.", "RECORD CENTER", and "FILE COPY 160".

COMPLETE & IN ACCORDANCE WITH DRUG & PROCEDURES  
Dr. Long - 10-17-75



**Newport News Industries Corporation**  
Subsidiary of Newport News Shipbuilding  
A Tenneco Company

JOB ORDER NO.	DSG. NO.	REV.	MU NO.
<u>58244</u>	<u>297133</u>	<u>F1</u>	<u>457-AC-X10-23</u>
JOB ORDER LOCATION	INSPECTOR	DATE	
<u>58244</u>	<u>Alt 6</u>	<u>8-10-76</u>	

JOINT NO. A-554 1-3-13	BASE MATERIAL ITEM TO ITEM	PLATE	PIPE	FIT-UP	APPLICATION REQUIRING NDE	TYPE	NDE ACCOMPLISHED	
							INSPECTOR/ LEVEL	DATE
507	1908	1901	X		PIPE TIG WELD WELDED	MT	Takaty II	8-30-76
"	"	"	X		"	MT	Barnes D	8-17-76
"	"	"	X		"	MT	Barnes D	8-17-76
"	"	"	X		"	MT	Barnes D	8-17-76
507	1908	1901	X		FINAL A-310C FINAL B-310C	UT	Buddean P	8-27-76
"	"	"	X		"	UT	Buddean P	8-27-76
508	1909	1901	X		PIPE TIG WELD WELDED	MT	Takaty II	8-28-76
"	"	"	X		"	MT	Barnes D	8-17-76
"	"	"	X		"	MT	Barnes D	8-17-76
"	"	"	X		"	MT	Takaty II	8-28-76
508	1909	1901	X		FINAL A-310C FINAL B-310C	UT	MURRAY E	8-27-76
"	"	"	X		"	UT	MURRAY E	8-27-76

\* INDICATE ACTUAL WALL THICKNESS FOR PIPE JOINTS THAT REQUIRE B

REMARKS: Jo<sup>o</sup>" 5<sup>o</sup>7 50am + J-2a-1  
Jo<sup>o</sup>" 5<sup>o</sup>8 50am + J-12-1

COMPLETE AND IN ACCORDANCE WITH DRAWING AND PROCEDURES.

WELDING SUPERVISOR

B6. N. V. Thiem 2-11-76

新嘉坡和吉隆坡，都是世界著名的花园城市。

Q.A. Goldin 9/13/76

002353

RADIOPHGRAPHIC TECHNIQUE		DATE 10-16-75	
Rev 22A-FM REV. 31		HHS & DO CO. Remarks on back	
50284A - ER		EXPIRATION NO.	
WELD I.D. 10-10		STRUCTURE QN + F	
1-10-4 AFB 288-108B		Fracture test	
STATUS O	SOURCE TYPE IRd	IMAGE SIZE 1/4 x 1/4	WELD I.D. L52
	SHUTTER STATUS PS	SHUTTER SIZE —	WELD I.D. L341-441
TIME 24 min	TM 1/4	TM 1/2	WELD I.D. 30ASTM
SOURCE POSITION I/3	SOURCE ANGLE 90°	EF.D. 24"	FILM SIZE AA
EXPOSED BY Vogelwedde	EXPOSURE NO. 200	INCHES TO REC. INTENP. 1/4	
ACCEPTED <input checked="" type="checkbox"/>	MT <input type="checkbox"/>	GR/RT <input type="checkbox"/>	RET <input type="checkbox"/>
REASON	DEFECT LENGTH		REP <input type="checkbox"/> VIR ENCL <input type="checkbox"/>
LINE NO. LOT NO.	Lev 2 P.C. M. 10/17/75		

RADIOPHGRAPHIC TECHNIQUE		Remote's on back		DATE
MM 142 REV. B 50-244 FR		NNS & CO CO		10-15-75
		ORIENTATION NO.		STRUCTURE PENETRATION
WELD I.D. <b>UNIT 1</b>		10-10-1-10-5 A+B		20B 10E,
STATUS <b>S</b>	SOURCE TYPE <b>IR-8192</b>	SOURCE SIZE <b>1/4" x 1/4"</b>	SOURCE I.D. <b>I-48</b>	CURIES <b>7.2</b>
SHOT <b>R.S.</b>	SHOTS	SHOOTAT	STD SETUP <b>N341-44141</b>	MATERIAL <b>M.S.</b>
TIME <b>4 1/2 MIN</b>	TM <b>1 1/4</b>	TS <b>1 1/2</b>	PEVENT <b>30</b>	SHIM <b>1/4</b>
SOURCE POSITION <b>I S</b>	SOURCE ANGLE <b>70</b>	SLANT <b>24"</b>	FILM <b>A A</b>	<b>7" x 17</b>
EXPOSURE BY <b>Prelgett</b>	FILM HOLDER NO. <b>144</b>		INCHES TO BE INTERP. <b>44" 14"</b>	
ACCEPTED <input checked="" type="checkbox"/>	MT <input type="checkbox"/>	GR/RT <input type="checkbox"/>	RET <input type="checkbox"/>	REP <input type="checkbox"/> VIB ENCL. <input type="checkbox"/>
REASON	DEFECT LENGTH			
LINE NO.	LOT NO.		<b>1307/441</b>	
			DATE <b>OCT 15 1975</b>	

N N I C

U. S. RECORD CENTER

## ULTRASONIC TEST DATA

REV A FORM 1211 REV. 11

WALL THICKNESS	PROCEDURE	TEST SURFACE	FREQUENCY	STRUCTURE NO.	THICKNESS	TEST DATE	INSTRUMENT		LOCATION	REMARKS
							TYPE	FREQ.		
1/8"	X-03-7-2d1	A/B	177.5	502-AFB	1-3-73	5/27/66	70-2	2.5	16 1/2 x 5	0-1
							72.1	2.5	81 3/4 x 11	1-2
									60 0	2-3
									3-0	3-0
										C.O.R.K

## RADIOGRAPHIC TEST DATA

REV A FORM 1211 REV. 11

WALL THICKNESS	PROCEDURE	TEST SURFACE	FREQUENCY	STRUCTURE NO.	THICKNESS	TEST DATE	INSTRUMENT		LOCATION	REMARKS
							TYPE	FREQ.		
1/8"	X-03-7-2d1	A/B	177.5	502-AFB	1-3-73	5/27/66	70-2	2.5	16 1/2 x 5	0-1
							72.1	2.5	81 3/4 x 11	1-2
									60 0	2-3
									3-0	3-0
										C.O.R.K

## ULTRASONIC TEST DATA

REV A FORM 1211 REV. 11

WALL THICKNESS	PROCEDURE	TEST SURFACE	FREQUENCY	STRUCTURE NO.	THICKNESS	TEST DATE	INSTRUMENT		LOCATION	REMARKS
							TYPE	FREQ.		
1/8"	X-03-7-2d1	A/B	177.5	502-AFB	1-3-73	5/27/66	70-2	2.5	16 1/2 x 5	0-1
							72.1	2.5	81 3/4 x 11	1-2
									60 0	2-3
									3-0	3-0
										C.O.R.K

## RADIOGRAPHIC TEST DATA

REV A FORM 1211 REV. 11

WALL THICKNESS	PROCEDURE	TEST SURFACE	FREQUENCY	STRUCTURE NO.	THICKNESS	TEST DATE	INSTRUMENT		LOCATION	REMARKS
							TYPE	FREQ.		
1/8"	X-03-7-2d1	A/B	177.5	502-AFB	1-3-73	5/27/66	70-2	2.5	16 1/2 x 5	0-1
							72.1	2.5	81 3/4 x 11	1-2
									60 0	2-3
									3-0	3-0
										C.O.R.K

## RADIOGRAPHIC TEST DATA

REV A FORM 1211 REV. 11

WALL THICKNESS	PROCEDURE	TEST SURFACE	FREQUENCY	STRUCTURE NO.	THICKNESS	TEST DATE	INSTRUMENT		LOCATION	REMARKS
							TYPE	FREQ.		
1/8"	X-03-7-2d1	A/B	177.5	502-AFB	1-3-73	5/27/66	70-2	2.5	16 1/2 x 5	0-1
							72.1	2.5	81 3/4 x 11	1-2
									60 0	2-3
									3-0	3-0
										C.O.R.K

N. N. I. C.  
RECORD CENTER  
FILE COPY 35



**Newport News Industrial Corporation**  
 Subsidiary of Newport News Shipbuilding  
 A Tennessee Company

© Francesco Cicali

WELD HISTORY RECORD

卷之三

N. N. I. C.  
RECORD CENTER  
FILE COPY 129

N.N.I.C. 294  
RECORD CENTER  
FILE COPY

COMPLETE & IN ACCORDANCE WITH Dwg. & PROCEDURES  
D. J. Day  
10-17-75

**Newport News Industrial Corporation**  
Subsidiary of Newport News Shipbuilding  
A Textron Company

卷之三

COMPLETE & IN ACCORDANCE WITH FIG. 3 PROCEDURES  
D.J. dony / Jim Steffens 3-30-74

卷之三

Form 1-451

COMPLETE & IN ACCORDANCE WITH Dwg. & PROCEDURES  
D. J. Day  
10-17-75

**TIFFED**  
**Newport News Indust. Corporation**  
 Subsidiary of Newport News Shipbuilding  
 A Tenneco Company

### NDE RECORD

OPT. 270, 283, 286, 289, 303 / 5, 20

JOB ORDER NO.	DWG. NO.	REV.	M-NO.
502414	288133	F1	451-PC-X10-23
JOB ORDER LOCATION	INSPECTOR		DATE
SUB SHOP	D.J. Song	9-11-76	7-22-76

JOINT NO. ASSY 1-3-13	BASE MATERIAL ITEM TO ITEM	PLATE	PIPE	FIT-UP	APPLICATION REQUIRING NDE	NDE ACCOMPLISHED		
						TYPE	INSPECTOR/ LEVEL	DATE
509	1907	1901	X	Diff E	FINAL A-3100	MT	Feberty II	8-28-76
"	"	"	X	"	A-3100 Root	MT	Feberty II	8-19-76
"	"	"	X	"	1SE PASS B-3100	MT	Feberty II	8-20-76
"	"	"	X	"	FINAL B-3100	MT	Feberty II	8-28-76
509	1907	1901	X	Diff E	FINAL A-3100	UT	Bucknow	8-27-76
"	"	"	X	"	FINAL B-3100	UT	Bucknow	8-27-76
510	1907	1901	X	Diff E	FINAL A-3100	MT	Feberty II	8-28-76
"	"	"	X	"	A-3100 Root	MT	Feberty II	8-17-76
"	"	"	X	"	1SE PASS B-3100	MT	Feberty II	8-20-76
"	"	"	X	"	FINAL B-3100	MT	Feberty II	8-28-76
510	1907	1901	X	Diff E	FINAL A-3100	UT	Bucknow	8-27-76
"	"	"	X	"	FINAL B-3100	UT	Bucknow	8-27-76

\* INDICATE ACTUAL WALL THICKNESS FOR PIPE JOINTS THAT REQUIRE RT

REMARKS: J0*509 Seam = 1-16-3 J0*510 Seam = 1-16-4	COMPLETE AND IN ACCORDANCE WITH DRAWING AND PROCEDURES
WELDING SUPERVISOR	
<i>R.W. Williams</i> 9-11-76	
INSPECTION SUPERVISOR	
<i>O.J. Bld</i> 9/3/76	

002354

RADIOGRAPHIC TECHNIQUE		DATE 10-16-75			
NN 1258 (REV. 3) NMS & CO CO.		Remarks on back			
WELD # 51244 —		ORIENTATION NO. 1-2			
TIME 22-12-1 1-12-1 A4B 248-168 B		STRUCTURE/GR. I			
STATE	TYPE	SOURCE SIZE			
RS	FRD	18X1/8			
TIME	SHOOT	SOURCE I.D.			
22-12-1 1-12-1	1 1/8	52			
SOURCE POSITION	SHOOT	CURVES			
1/8	1 1/8	73			
SOURCE ANGLE	SHOOT	WALL			
70°	1 1/8	10.5MM			
EXPOSED BY	S.F.O.	SHIN			
Vogelvode	20	1/4			
	FILM	SIZE			
	ROLLER NO.	7X17			
ACCEPTED <input checked="" type="checkbox"/>	MT <input type="checkbox"/>	GR/RT <input type="checkbox"/>	RET <input type="checkbox"/>	REP <input type="checkbox"/>	VIR ENCL <input type="checkbox"/>
REASON	DEFECT LENGTH				
LINE NO.	LOT NO.	DATE 10-16-75			
Loc 2 ECW		ECW			

PENETRATION SEAM  
JOINT # 1-12-1

N.N.I.C.  
RECORD CENTER  
FILE COPY 21



## Newport News Industrial Corporation

Subsidiary of Newport News Shipbuilding  
A Textron Company

A Tennessee Company

**WELD  
HISTORY RECORD**

N. N. I. C.  
RECORD CENTER  
FILE COPY 192

COMPLETE & IN ACCORDANCE WITH DWG. & PROCEDURES

D.J. doby 10-15-75

ULTRASONIC TEST DATA INN FORM 2321 (REV. 11)								DATE 8/27/72	
NAME	PN	TEST SURFACE	ORIENTATION NO.	STRUCTURE	1255 Y 1-3-13 UNJ #1				
NIL 5024-A	~	A/B	300 Rebar/rod Penet. in Cyl. P/T	MATERIAL	THICKNESS	STATUS			
PROCEDURE	X03-7-241			M.S.	3/4"				
LOCATION	LENGTH	DEPTH	ZONE	DIRECTION	INDICATED DEFECT TYPE	DISPOSITION	(INSTRUMENT)	TRANSDUCER NO. 644792	CALIB. BLOCK
				1P/1a		B	TYPE 702-A NO. 72104	TYPE G FREQ. 2.25 SIZE $\frac{1}{4}$ " ANGLE 60°	NO. —
							25" LOC'S	REMARKS	LOC. OF STENCIL IN
							0-1		FWD
							1-2		AFT
							2-3		TOP
							3-0		BOTTOM
							CO-OK	5-08	INBD
									OUTBD
									PORT
									\$TBD
NODE USED					DISPOSITION	BEAM DIRECTION			
1ST HALF ✓ 2ND HALF ✓ 1ST HALF ✓ 2ND HALF					0 = SATISFACTORY (+) = REJECTABLE # = REJECTABLE PENDING REP. OF R	F = FWD PORTION A = AFT, STRG, OUT, DOWN L = LONGITUDINAL WELD T = TRANSVERSE WELD C = COMPRESSIONAL			
1ST NODE 1ST NODE 2ND NODE 2ND NODE					LENGTH = 16" OR LESS				
DEFECT TYPE					PERFORMED BY	PART OF LAB. REPORT			
W - WELD REINFORCEMENT		H - INCLUSION							
D - DELAMS - LAMINAR		C - POROSITY							
S - STRUCTURE		G - CRACK							
L - LACK OF FUSION									

ULTRASONIC TEST DATA NY FORM 2221 (REV. 11)							510-A&B		8-2276		
HULL	FM	ORIENTATION NO.		STRUCTURE A55Y 1-3-13		UNITED					
NN 5024-A	-	SEE REMARKS		PCHT IN CFM PLT							
PROCEDURE	TEST SURFACE	MATERIAL		THICKNESS	STATUS						
A03-7-241	N/A	M.S.		3/4"	O						
LOCATION	LENGTH	DEPTH	BEAM LOCATION	BLK. SIZE	BEAM DIRECTION	INDICATED EFFECT TYPE	DISPOSITION	INSTRUMENTS	TRANSDUCER NO. 264945	CALIB. BLOCK	
T-2 11"	7/8	7/16	2-3	40	TF		O	TYPE 702-A NO. 721204	TYPE C FREQ. 2.25 SIZE 1/16" ANGLE 5°	NO. —	
								25° LOCS	REMARKS	LOC. OF STENCILING	
										FWD	
										AFT	
										TOP	
										BOTTOM	
										(INBD)	
										OUTBD	
										PORT	
										STBD	
NODE USED							DISPOSITION		BEAM DIRECTION		
1ST HALF ✓ 2ND HALF ✓		1ST HALF		2ND HALF		O - SATISFACTORY E - 1/4 REJECTABLE PENDING REP. OF R		F - FWD, PORT			
1ST NODE ✓ 1ST NODE		2ND NODE		2ND NODE		R - REJECTABLE		A - AFT, STBD, OUT, DOWN			
DEFECT TYPE							LENGTH + + UN" OR LESS		L - TRANSITUDINAL WELD T - TRANSVERSE WELD C - COMPRESSIONAL		
W - WELD REINFORCEMENT D - DELAYS - LAMINAR S - STRUCTURE							PERFORMED BY		PART OF LAB. REPORT		
N - INCLUSION C - POROSITY C - CRACK							<i>D.J. Buchanan</i>				

RADIOGRAPHIC TECHNIQUE			
No. 118 Rev. D	No. 118 Rev. D	No. 118 Rev. D	Date 10-15-75
5024A	PN	Reinforced on back	
STL'D.	16.0	Source size	
STL'D.	16.0	Source size	
SIDES	1/2	STRUCTURE NO.	
R.S.		STRUCTURE NO.	
TIME	7 1/2 min.	ANGLE	288-108 R
EXPOSURE	1/2 sec.	SIZE	
ACCEPTED	<input checked="" type="checkbox"/>	GRANT	
REASON	DEFECT LENGTH		
LINE NO.	LOT NO.	DATE	10-16-75
Line 2 Emissified Cut 1 J 12			

RADIOGRAPHIC TECHNIQUE			
No. 118 Rev. D	No. 118 Rev. D	No. 118 Rev. D	Date 10-15-75
5024A	PN	Reinforced on back	
STL'D.	16.0	Source size	
STL'D.	16.0	Source size	
SIDES	1/2	STRUCTURE NO.	
R.S.		STRUCTURE NO.	
TIME	7 1/2 min.	ANGLE	288-108 R
EXPOSURE	1/2 sec.	SIZE	
ACCEPTED	<input checked="" type="checkbox"/>	GRANT	
REASON	DEFECT LENGTH		
LINE NO.	LOT NO.	DATE	10-16-75
Line 2 Emissified Cut 1 J 12			

FILE COPY 26			
RECORD CENTER			
N. N. I. C.			
FILE COPY 193			

RADIOGRAPHIC TECHNIQUE			
No. 118 Rev. D	No. 118 Rev. D	No. 118 Rev. D	Date 10-16-75
5024A	PN	Reinforced on back	
STL'D.	16.0	Orientation No.	
STL'D.	16.0	Orientation No.	
SIDES	1/2	STRUCTURE NO.	
R.S.		STRUCTURE NO.	
TIME	7 1/2 min.	ANGLE	288-108 R
EXPOSURE	1/2 sec.	SIZE	
ACCEPTED	<input checked="" type="checkbox"/>	GRANT	
REASON	DEFECT LENGTH		
LINE NO.	LOT NO.	DATE	10-16-75
Line 2 Emissified Cut 1 J 12			

N. N. I. C.			
RECORD CENTER			
FILE COPY 193			

REMARKS

FILE COPY 26  
RECORD CENTER  
N. N. I. C.  
FILE COPY 193

COMPLETE & IN ACCORDANCE WITH SPECIFICATIONS  
D. J. Donahue 10-17-75

Form 1-61

**Newport News Industries Corporation**  
Subsidiary of Newport News Shipbuilding  
A Tenneco Company

NDE RECORD


REMARKS: **✓** 0500 MORTAL REPORT OF DAY  
RECORDED ON THIS FORM WHICH IS FOR FIVE MONTHS FOR PINE JUN 13 THAT REQUIRE HT  
COMPL.

REMARKS: E. C. 1000' UPLAND WALL, THICKENED FROM PIPE JOIN 12 THAT REQUIRES NO  
# Close metal repair jacket  
COMPLETE AND IN ACCORDANCE WITH DRAWING AND  
PROCEDURES

WELDING SUPERVISOR  
J. T. Cleary Temp. Attachment  
CCU. #1020 process

INSPECTION SUPERVISOR  
J. Bell 9/2/74

000639

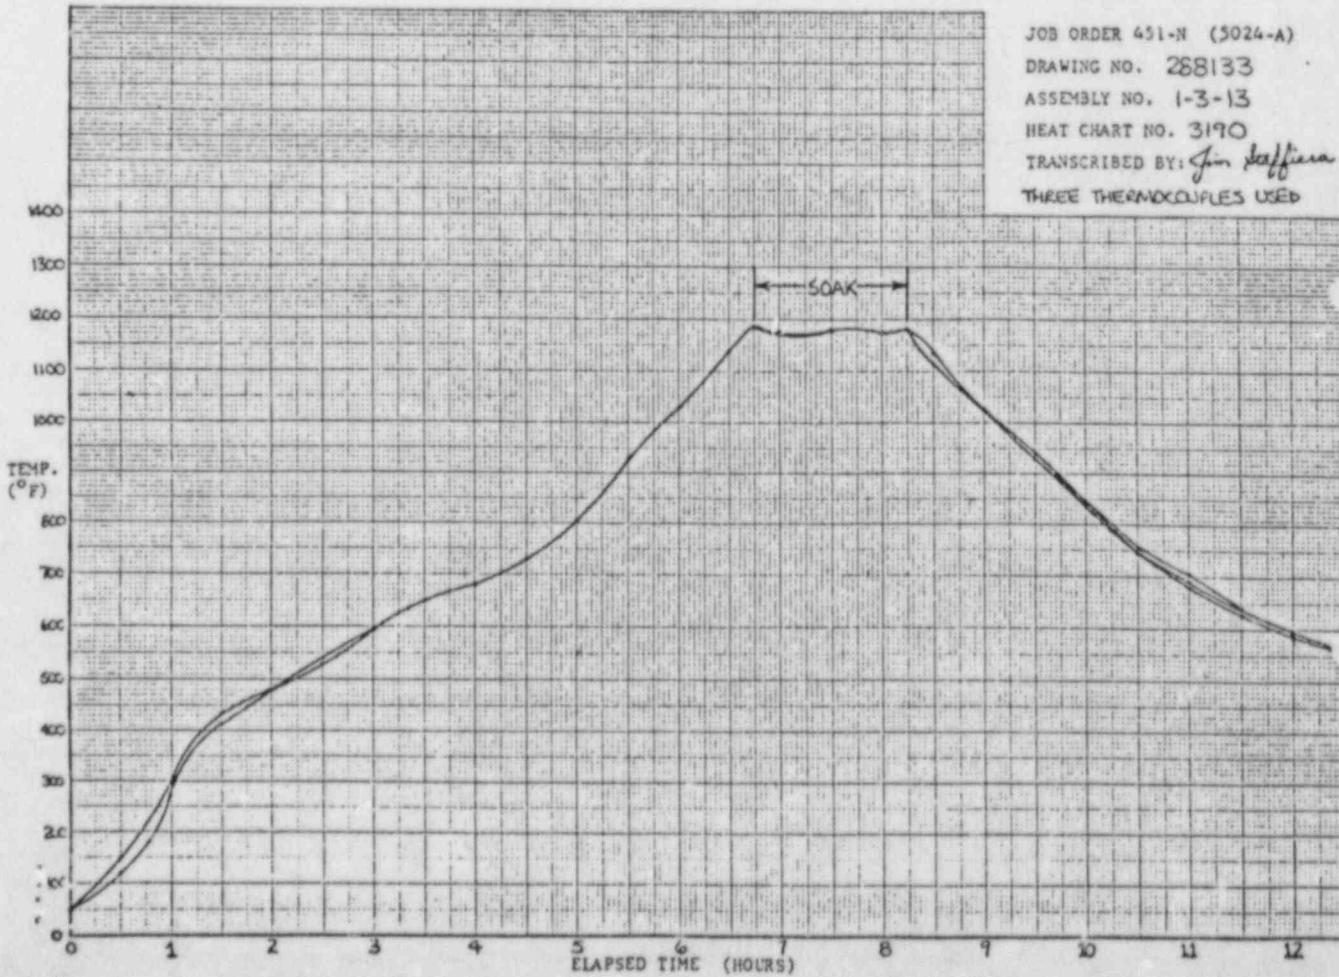

NEWPORT NEWS SHIPBUILDING AND DRY DOCK COMPANY  
NEWPORT NEWS, VIRGINIA

SHIPPING NOTICE FOR: NEWPORT NEWS INDUSTRIAL CORPN.  
(A TENNECO CO.)

DATE FEBRUARY 28, 1977

CUSTOMER'S ORDER  
**A-98512** ORDER  
NEWPORT NEWS, VIRGINIA 23607

CUSTOMER'S RECON.  
N.H. CHARGE  
**5024-A (451-N)**

DUKE POWER CO.  
CHARLOTTE, NORTH CAROLINA

DUKE POWER CO.  
C/O D.G. BEAM  
CATAWBA NUCLEAR STATION  
SOUTH CAROLINA HIGHWAY 274  
NEWPORT, SOUTH CAROLINA

MARCS  
NNI / CORPN. - JOB ORDER 451-N (NNS JO 5024-A)

2/28/77	ROSS TRUCKING CO.	CHARGE PREPAID
TRAILER P-59	NUMBER PACKAGES 14 -PCS.	NET WT. 15,980 #

- |          |   |
|----------|---|
| PACKAGES | CONTENTS  |
|          | <ul style="list-style-type: none"> <li>6 - DOME INSERT WELDMENT ASSEMBLIES 111-1 THRU 111-6<br/>DWG. 288113 - "B"</li> <li>6 - DOME INSERT WELDMENT ASSEMBLIES 111-7 THRU 111-12<br/>DWG. 288113 - "B"</li> <li>1 - SHELL INSERT WELDMENT ASSEMBLY 113-1 - DWG. 288229</li> <li>1 - SHELL INSERT WELDMENT ASSEMBLY 113-2 - DWG. 288229</li> </ul> |

AS PER LIST ATTACHED.

LESS DUNNAGE	16,140
NET	16,140

ORDER NOT COMPLETE

COPY TO:-

2-CC. CATAWBA NUCLEAR STATION, P.O.BOX 223, CLOVER, SOUTH CAROLINA 29770

ATTEN: D.S. BEAM

1-CC. FRANK H BEARD, JR., NNI, BLDG. 86

2-CC. J.C. NEFF, ACCOUNTS PAYABLE, NNI, BLDG. 520, 4TH FLOOR

1-CC. R. MACLAUCHLIN W/COPY B/L - NNI, BLDG. 520, 4 TH FLOOR

1-CC. JIM MITCHELL, X10, BLDG. 211

1-CC. 073 ACCOUNTS RECEIVABLE

 Newport News Industrial Corporation  
Subsidiary of Newport News Shipbuilding

A Tenneco Company

SHIP-OUT  
INSPECTION  
REPORT

FINAL INSPECTION OF MATERIAL LISTED HAS BEEN COMPLETED AND IS RELEASED FOR SHIPMENT			
DRG. NO.	DRG. ITEM	P.O. ITCW	QTY
DESCRIPTION			
<input checked="" type="checkbox"/> COMPANY FURN. MATER.			
<input type="checkbox"/> CUSTOMER FURN. MATER.			
<input type="checkbox"/> OTHER			

J.D.	FILE NO.
5024-A	X12-313
INSPECTION DATE	DATE
2-15-77	2-16-77

288229 A  
5024-A (451-N)  
SHELL INSERT WELDMENT CONSISTING  
OF THE FOLLOWING ITEMS.

11301	1	INSERT PLT.	75NNI 256
11302	1	Penetration	75NNI 036

APPROVED BY QA  
J.W. Loring 3-11-77  
APPROVED BY ST DATE

THIS COMPLETES /PARTIALLY COMPLETES: THIS CLEARS /PARTIALLY CLEARS IN NR:	N/A	REV. _____
APPLICABLE INSPECTIONS	APPLICABLE DATA	
EACH CHECKED INSPECTION HAS BEEN PERFORMED ON EACH ITEM LISTED ABOVE	NHI CHARGE/P.O./I.D. NO.	NHI SHIPMENT NO.
<input checked="" type="checkbox"/> MARKING	451-N	172 (5024-A-175)
<input checked="" type="checkbox"/> SURFACE	SHIPPED TO	
<input checked="" type="checkbox"/> CLEANLINESS	DUKE POWER COMPANY ATTN: D.G. BEAM	
<input type="checkbox"/> GRADE	CATAWBA NUCLEAR STATION	
<input checked="" type="checkbox"/> AS REC'D FOR SHIPOUT	NEWPORT, SOUTH CAROLINA	
<input type="checkbox"/> PRIM. CLEAN TAG	ENGINEERING INSTRUCTION	
<input type="checkbox"/> PLUG WARNING TAG	451-N-3001	
<input type="checkbox"/> DIMENSIONAL INSP.	QA INSPECTOR	
<input type="checkbox"/> WELD PREP	James E. Staffina 2-17-77	
<input type="checkbox"/> OVERALL	CUSTOMS INSPECTOR	
OTHER (SPECIFY) _____		
DISTRIBUTION		
2-NNI RECORDS CENTER		
1-DUKE POWER COMPANY (DOCUMENTATION PACKAGE)		
1-NNI QA, BLDG 86, 3 <sup>rd</sup> FLOOR		

SHIP ID	QA	SD	CEXX	R&S	SHIPMENT NUMBER
5024-A-175	5024-A	SD	CEXX	R&S	5024-A-175



DUKE POWER COMPANY  
QUALITY ASSURANCE DEPARTMENT  
SUPPLIER QUALITY ASSURANCE CERTIFICATION

Name of Supplier Newport News Industrial Corporation Date FEBRUARY 23, 1977

Address of Supplier Plant 230 41st Street Mill Power Order No. A-98512  
Newport News, Virginia 23607 Duke Item or Proj. No. 1144.09-1  
Spec. No. CNS-1144.09-1 Rev. 4

Supplier ID Nos. As noted per attached Shipout Inspection Reports X12-310-311-313 & -314

Description of Component(s) or Material(s) DOME INSERT ASSEMBLIES III-1 THROUGH III-12  
SHELL INSERT ASSEMBLIES II-3-1 & II-3-2

Attached Documentation covers all Components/Materials on Mill Power Order.  
 Attached Documentation covers partial shipment of Components/Materials on Mill Power Order.

The following listed tests, inspections and reports have been completed as required by the specification:

<input checked="" type="checkbox"/> Physical & Chemical Analysis	<input checked="" type="checkbox"/> Major Repair Records & Charts
Hydro (Test Pressure = PSIG <u>_____</u> )	Personnel Qualifications on Record
<input checked="" type="checkbox"/> Design Report	<input checked="" type="checkbox"/> Stress Report
<input checked="" type="checkbox"/> Radiographic Test	<input checked="" type="checkbox"/> Ultrasonic Test
<input checked="" type="checkbox"/> Penetrant Test	<input checked="" type="checkbox"/> Repair NDE
<input checked="" type="checkbox"/> Operating Test	<input checked="" type="checkbox"/> Performance Curve
<input checked="" type="checkbox"/> Dimensional Check	<input checked="" type="checkbox"/> Deviation Record # <u>SEE 1) BELOW</u>
<u>1) NONCONFORMITY REPORTS 451-N-X12-7,-35 &amp; MS3-4</u>	

2) \_\_\_\_\_

3) \_\_\_\_\_  
This certifies that the listed Component(s) or Material(s) conform to the requirements of the above referenced Duke Power drawing 20, including all codes, standards, test requirements and Quality Assurance requirements.

QA RECORDS APPROVED

C. E. Steffens  
QA REPRESENTATIVE  
DATE 3-8-77

James E. Steffens for L.H. Harrison  
Supplier Representative Authorized Signature

Title QA Manager Date 2-23-77

(See Instructions)

PACKAGING AND SHIPPING REQUIREMENTS

Specification No. CNS-1144.09-1

Date FEBRUARY 23, 1977

1. ITEM CLASSIFICATION (ANSI N45.2.2 - 1972)

Level	A	B	C	D	Special
Special					

2. PACKAGING (ANSI N45.2.2 - 1972, Section 3 and Appendix A3)

Level	A	B	C	D	Special
Special Instructions					

3. SHIPPING (ANSI N45.2.2 - 1972, Section 4.2)

Carrier	Open	Closed	Special
Special Instructions			

Shipment via Train Truck Plane Barge Ship Other

Description of other means \_\_\_\_\_

4. LOADING & TRANSIT (ANSI N45.2.2 - 1973, Section 4.3)

Special instructions for loading, rigging, handling, preservative coatings, seals, stacking and vandalism precautions

Newport News Industrial Corporation Instruction 451-NC-5001

5. IDENTIFICATION AND MARKING (ANSI N45.2.2 - 1972, Appendix A3.9)

Item Markings Newport News Industrial Corporation drawing and item/assembly numbers and Quality Control numbers

Container Markings Uniform freight classification rules

CP-12-5

**Newport News Industries Corporation**  
Subsidiary of Newport News Shipbuilding  


Newspaper of Record / Newsweek

*Suburbia of Shantou Street, Shippensburg*

Report of the  
Subcommittee of Parsons

1

INDE RECOR

JOU ORDER NO.	DRUG NO.	DRUG NO.	RE. NO.	REC'D.
JOU ORDER LOCATION	INSPECTOR	INSPECTOR	DATE	DATE
50-244	288-229	—	457-240-X10-465	10-8-76
JOU ORDER LOCATION	INSPECTOR	INSPECTOR	DATE	DATE
500 J100	D.J. Long	2-11-77		
JOINT NO.	BASE MATERIAL	ITEM TO ITEM	PLATE	PIPE
500				
113				
113-1	11302	K	118-76	F1N9C
K	K	K	K	A-3-600
K	K	K	K	R007
K	K	K	K	136 P053
K	K	K	K	B-5-600
K	K	K	K	F1N9C
K	K	K	K	A-3-600
113-1	11302	K	118-76	F1N9C
K	K	K	K	A-3-600
K	K	K	K	P1A02
K	K	K	K	C-2-600
113-1	11302	K	118-76	F1N9C
K	K	K	K	A-3-600
K	K	K	K	P1A02
K	K	K	K	C-2-600
X	11301	—	X	BASE MEDIUM
X	11302	—	X	Extrusion
K	—	—	X	Final
X	11301	—	X	Kelly H
X	11302	—	X	Kelly H
K	—	—	X	Kelly H

\* INDICATE ACTUAL WALL THICKNESS FOR PIPE JOINTS THAT REQUIRE IT

PROSECUTOR'S OFFICE

1

JOB ORDER 451-N (5024-A)  
DRAWING NO. 788229


ASSEMBLY NO. 113-1

HEAT CHART NO. 327

TRANSCRIBED BY: *John S.*

TWO THERMOCOUPLES USED

— 1 —

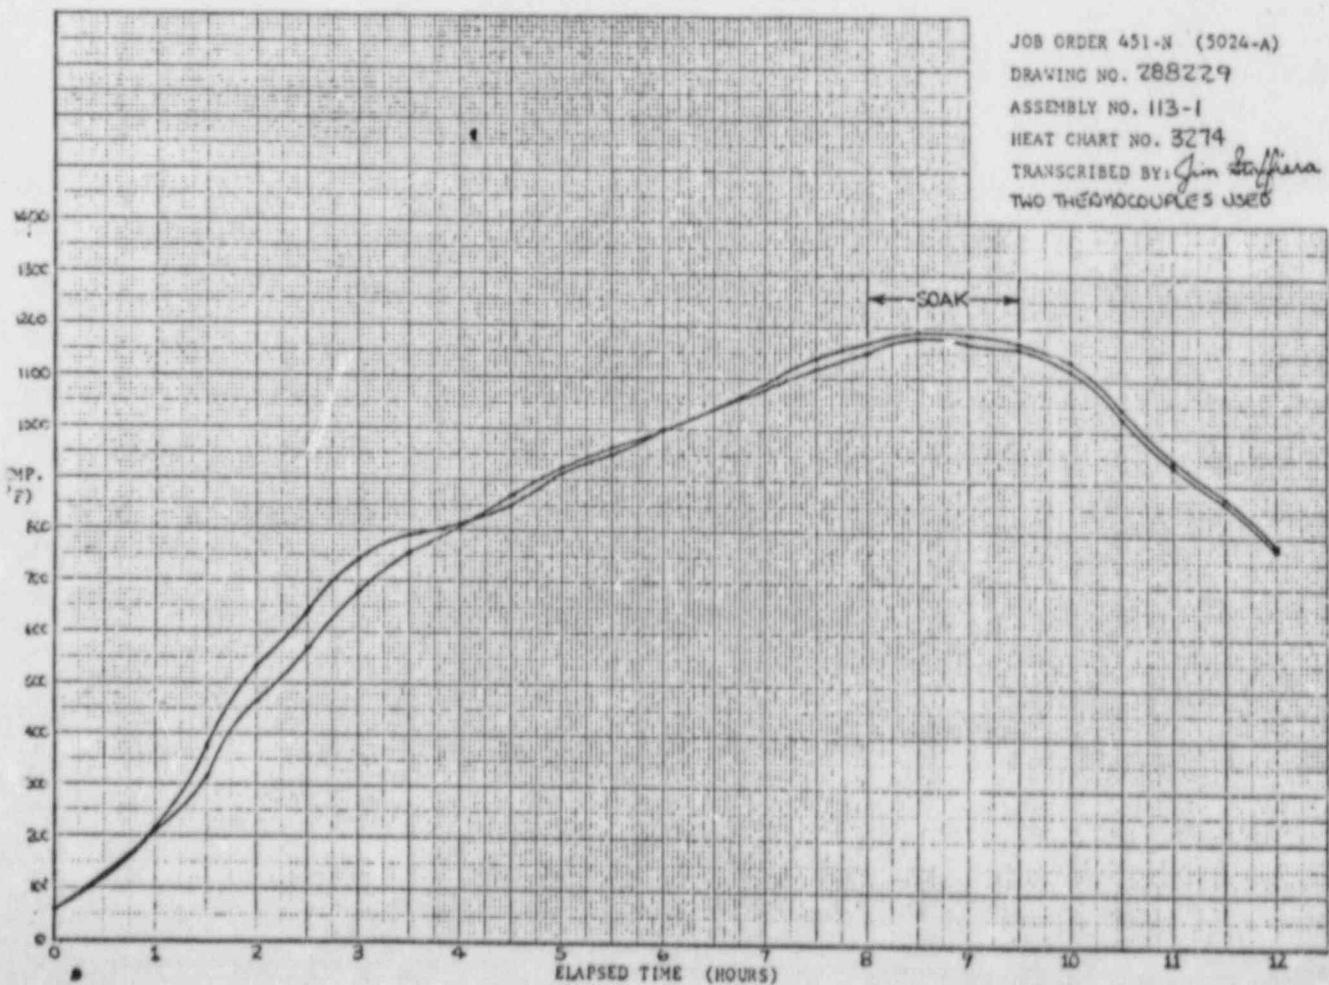



Newport News Industrial Corporation

**Subsidy of Imported Haven Shipbuilding**  
A Technical Survey

WELD HISTORY RECORD

卷之三

COMPLETE & IN ACCORDANCE WITH THE SPECIFICATIONS  
D. J. Orling Jan 27-1972

卷之三

FILE COPY #2  
RECORD CENTER  
N.N.I.C.

SCIENCE 2001

RADIOGRAPHIC TECHNIQUE		DATE 10-22-75	
5024A		Exposure on back	
1/3-13		Projectrical	
1/3-13	1/3-14	88-1635	
1/3-13	1/3-14	7-30	
1/3-13	1/3-14	134/441	165/56
1/3-13	1/3-14	30	
1/3-13	1/3-14	1/2	1/2
1/3-13	1/3-14	547	547
EXPOSED BY	Helson	REPT	VIN ENCL.
ACCEPTED	<input checked="" type="checkbox"/>	GROUT	<input type="checkbox"/>
REASON	RE-SETTLEMENT		
CONT.	Lia 2 22M 144		
CONT.	521 100 375		

## FORM N-2 MANUFACTURERS DATA REPORT FOR NUCLEAR PART AND APPURTENANCES\*

As required by the Provisions of the ASME Code Rules

T-5191

## ASSOCIATED PIPING &amp; ENGINEERING CORPORATION

1. (a) Manufactured by Temp Flex Div., 1707 W. Compton Blvd., Compton, CA 90224  
(Name and address of Manufacturer of part)(b) Manufactured for Duke Power Company, P.O. Box 2178, Charlotte, N.C. 28242  
(Name and address of Manufacturer of completed nuclear component)

2. Identification-Manufacturer's Serial No. of Part H-6854 Nat'l Bd. No. ---


(a) Constructed According to Drawing No. D-23502 Drawing Prepared by Temp Flex Division

(b) Description of Part Inspected Type I-Main Steam Penetration Assembly, Mark No.: 1-M113 Summer

(c) Applicable ASME Code: Section III, Edition 1974, Addenda date 1974, Case No. --- Class 2

3. Remarks: 1) Assembly as a part used in Containment Vessel Penetration. 2) Bellows  
(Brief description of service for which component was designed)  
Expansion Joint design complies with Paragraph NC 3649.4 (e) (1) of the Code.  
3) Material description on attached Sheet 2 of 2.

We certify that the statements made in this report are correct and this vessel part or appurtenance as defined in the Code conforms to the rules of construction of the ASME Code Section III.  
 (The applicable Design Specification and Stress Report are not the responsibility of the part Manufacturer. An appurtenance Manufacturer is responsible for furnishing a separate Design Specification and Stress Report if the appurtenance is not included in the component Design Specification and Stress Report.)

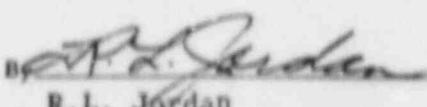Date 11/15 1977 Signed Temp Flex Division By   
(Manufacturer) R. L. Jordan  
Certificate of Authorization Expires January 5, 1979 Certificate of Authorization No. 1298

## CERTIFICATION OF DESIGN FOR APPURTENANCE (when applicable)

Design information on file at \_\_\_\_\_

Stress analysis report on file at \_\_\_\_\_

Design specifications certified by \_\_\_\_\_ Prof. Eng. State \_\_\_\_\_ Reg. No. \_\_\_\_\_

Stress analysis report certified by \_\_\_\_\_ Prof. Eng. State \_\_\_\_\_ Reg. No. \_\_\_\_\_


## CERTIFICATE OF SHOP INSPECTION

I, the undersigned, holding a valid commission issued by the National Board of Boiler and Pressure Vessel Inspectors and/or the State or Province of California and employed by H.S.B.I.P.I.C.O. of Hartford, Conn., have inspected the part of a pressure vessel described in this

Manufacturer's Partial Data Report on 11/15 1977, and state that to the best of my knowledge and belief, the Manufacturer has constructed this part in accordance with the ASME Code Section III.

By signing this certificate, neither the Inspector nor his employer makes any warranty, expressed or implied, concerning the part described in this Manufacturer's Partial Data Report. Furthermore, neither the Inspector nor his employer shall be liable in any manner for any personal injury or property damage or a loss of any kind arising from or connected with this inspection.

Date 11/15 1977

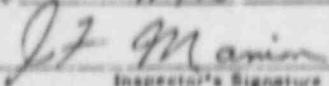  
 Inspector's Signature J.F. Manion Commissions 1107 California Comm. No.  
 National Board, State, Province and No.

\*Supplemental sheets in form of lists, sketches or drawings may be used provided (1) size is 8½" x 11", (2) information in items 1-3 on this data report is included on each sheet, and (3) each sheet is numbered and number of sheets is recorded in item 3, "Remarks".

## FORM N-2 MANUFACTURERS DATA REPORT FOR NUCLEAR PART AND APPURTENANCES\*

As required by the Provisions of the ASME Code Rules

T-5191

ASSOCIATED PIPING &amp; ENGINEERING CORPORATION

1. (a) Manufactured by Temp Flex Div., 1707 W. Compton Blvd., Compton, CA 90224  
(Name and address of Manufacturer of part)(b) Manufactured for Duke Power Company, P.O. Box 2178, Charlotte, N.C. 28242  
(Name and address of Manufacturer of completed nuclear component)2. Identification-Manufacturer's Serial No. of Part H-6854 Nat'l Bd. No. ---(a) Constructed According to Drawing No. D-23502 Drawing Prepared by Temp Flex Division(b) Description of Part Inspected Type I-Main Steam Penetration Assembly. Mark No.: 1-M113  
Summer(c) Applicable ASME Code: Section III, Edition 1974, Addenda date 1974, Case No. --- Class 2

## 3. REMARKS: (continued)

Materials as follows:

Process Pipe Sub-Assembly:

Flued Head - 54" x 40" x 34" N.P.S., SA-105.

Process Pipe - 31.250" I.D. x 1.510" Min. Wt., SA-106 Grade C.

Guard Pipe - 36.750" I.D. x 1.625" Min. Wt., SA-106 Grade C.

Bellows Sub-Assembly:

Bellows: 2 Ply .036" Thk., SA-240 Type 321.

Inner Center Sleeve, Outer Center Sleeve, and Outer End Sleeves:  
54" O.D. x .50" Wt., SA-515 Grade 70.Inner End Sleeve: 54.25" O.D. x 1.75" Wt. (before machining),  
SA-516 Grade 70.

Attachment Sleeve: 54.5" O.D. x .75" Wt., SA-516 Grade 70.

Ring Details:

Split Seal Ring: .500" Thk., SA-515 Grade 70.

## FORM N-2 MANUFACTURERS DATA REPORT FOR NUCLEAR PART AND APPURTENANCES\*

As required by the Provisions of the ASME Code Rules

T-5191

## ASSOCIATED PIPING &amp; ENGINEERING CORPORATION

1. (a) Manufactured by Temp Flex Div., 1707 W. Compton Blvd., Compton, CA 90224  
(Name and address of Manufacturer of part)(b) Manufactured for Duke Power Company, P.O. Box 2178, Charlotte, N.C. 28242  
(Name and address of Manufacturer of completed nuclear component)2. Identification-Manufacturer's Serial No. of Part H-6859 Nat'l Bd. No. ---(a) Constructed According to Drawing No. D-23762 Drawing Prepared by Temp Flex Division(b) Description of Part Inspected Type I-Main Steam Penetration Assembly. Mark No.: 2-M261  
Summer(c) Applicable ASME Code: Section III, Edition 1974, Addenda date 1974, Case No. --- Class 23. Remarks: 1) Assembly as a part used in Containment Vessel Penetration. 2) Bellows  
(Brief description of service for which component was designed)Expansion Joint design complies with Paragraph NC 3649.4 (e) (1) of the Code.3) Material description on attached Sheet 2 of 2.\* Added .4 to Paragraph NC 3649.

We certify that the statements made in this report are correct and this vessel part or appurtenance as defined in the Code conforms to the rules of construction of the ASME Code Section III.  
 (The applicable Design Specification and Stress Report are not the responsibility of the part Manufacturer. An appurtenance Manufacturer is responsible for furnishing a separate Design Specification and Stress Report if the appurtenance is not included in the component Design Specification and Stress Report.)

Date 12-1-77 19 77 Signed Temp Flex Division By R.L. Jordan  
 (Manufacturer) R.L. Jordan  
 Certificate of Authorization Expires January 5, 1979 Certificate of Authorization No. 1298

## CERTIFICATION OF DESIGN FOR APPURTENANCE (when applicable)

Design information on file at \_\_\_\_\_

Stress analysis report on file at \_\_\_\_\_

Design specifications certified by \_\_\_\_\_ Prof. Eng. State \_\_\_\_\_ Reg. No. \_\_\_\_\_

Stress analysis report certified by \_\_\_\_\_ Prof. Eng. State \_\_\_\_\_ Reg. No. \_\_\_\_\_

## CERTIFICATE OF SHOP INSPECTION

I, the undersigned, holding a valid commission issued by the National Board of Boiler and Pressure Vessel Inspectors and/or the State or Province of California and employed by H.S.B.I.&I.Co. of Hartford, Conn. have inspected the part of a pressure vessel described in this

Manufacturer's Partial Data Report on 11/11 1977, and state that to the best of my knowledge and belief, the Manufacturer has constructed this part in accordance with the ASME Code Section III.

By signing this certificate, neither the Inspector nor his employer makes any warranty, expressed or implied, concerning the part described in this Manufacturer's Partial Data Report. Furthermore, neither the Inspector nor his employer shall be liable in any manner for any personal injury or property damage or a loss of any kind arising from or connected with this inspection.

Date 12-1- 19 77J.F. Manion  
Inspector's Signature

J.F. Manion

Commissions 1107 California Comm. No.  
National Board, State, Province and No.

## FORM N-2 MANUFACTURERS DATA REPORT FOR NUCLEAR PART AND APPURTENANCES\*

As required by the Provisions of the ASME Code Rules

T-5191

ASSOCIATED PIPING & ENGINEERING CORPORATION1. (a) Manufactured by Temp Flex Div., 1707 W. Compton Blvd., Compton, CA 90224  
(Name and address of Manufacturer of part)(b) Manufactured for Duke Power Company, P.O. Box 2178, Charlotte, N.C. 28242  
(Name and address of Manufacturer of completed nuclear component)2. Identification-Manufacturer's Serial No. of Part H-6859 Nat'l Bd. No. ---(a) Constructed According to Drawing No. D-23762 Drawing Prepared by Temp Flex Division(b) Description of Part Inspected Type I-Main Steam Penetration Assembly. Mark No.: 2-M261  
Summer(c) Applicable ASME Code: Section III, Edition 1974, Addenda date 1974, Case No. --- Class 2

## 3. REMARKS: (continued)

Materials as follows:

Process Pipe Sub-Assembly:

Flued Head - 54" x 40" x 34" N.P.S., SA-105.

Process Pipe - 31.250" I.D. x 1.510" Min. Wt., SA-106 Grade C.

Guard Pipe - 36.750" I.D. x 1.625" Min. Wt., SA-106 Grade C.

Bellows Sub-Assembly:

Bellows: 2 Ply .036" Thk., SA-240 Type 321.

Inner Center Sleeve, Outer Center Sleeve, and Outer End Sleeve:

54" O.D. x .50" Wt., SA-515 Grade 70.

Inner End Sleeve: 54.25" O.D. x 1.75" Wt. (before machining),  
SA-516 Grade 70.

Attachment Sleeve: 54.5" O.D. x .75" Wt., SA-516 Grade 70.

Ring Details:

Split Seal Ring: .500" Thk., SA-515 Grade 70.

## FORM N-2 MANUFACTURERS DATA REPORT FOR NUCLEAR PART AND APPURTENANCES\*

As required by the Provisions of the ASME Code Rules

T-5191

## ASSOCIATED PIPING &amp; ENGINEERING CORPORATION

1. (a) Manufactured by Temp Flex Div., 1707 W. Compton Blvd., Compton, CA 90224  
(Name and address of Manufacturer of part)(b) Manufactured for Duke Power Company, P.O. Box 2178, Charlotte, N.C. 28242  
(Name and address of Manufacturer of completed nuclear component)2. Identification-Manufacturer's Serial No. of Part H-6858 Nat'l Bd. No. ---(a) Constructed According to Drawing No. D-23754 Drawing Prepared by Temp Flex Division(b) Description of Part Inspected Type I-Main Steam Penetration Assembly. Mark No.: 2-M113  
Summer(c) Applicable ASME Code: Section III, Edition 1974, Addenda date 1974, Case No. --- Class 23. Remarks: 1) Assembly as a part used in Containment Vessel Penetration. 2) Bellows  
(Brief description of service for which component was designed)

Expansion Joint design complies with Paragraph NC 3649.4 (e) (1) of the Code.

3) Material description on attached Sheet 2 of 2.

We certify that the statements made in this report are correct and this vessel part or appurtenance as defined in the Code conforms to the rules of construction of the ASME Code Section III.

(The applicable Design Specification and Stress Report are not the responsibility of the part Manufacturer. An appurtenance Manufacturer is responsible for furnishing a separate Design Specification and Stress Report if the appurtenance is not included in the component Design Specification and Stress Report.)

Date 11/16 1977 Signed Temp Flex Division By R.L. Jordan  
(Manufacturer) R.L. JordanCertificate of Authorization Expires January 5, 1979 Certificate of Authorization No. 1298

## CERTIFICATION OF DESIGN FOR APPURTEANCE (when applicable)

Design information on file at \_\_\_\_\_

Stress analysis report on file at \_\_\_\_\_

Design specifications certified by \_\_\_\_\_ Prof. Eng. State \_\_\_\_\_ Reg. No. \_\_\_\_\_

Stress analysis report certified by \_\_\_\_\_ Prof. Eng. State \_\_\_\_\_ Reg. No. \_\_\_\_\_

## CERTIFICATE OF SHOP INSPECTION

I, the undersigned, holding a valid commission issued by the National Board of Boiler and Pressure Vessel Inspectors and/or the State or Province of California and employed by H.S.B.I.& I.C.O. of Hartford, Conn. have inspected the part of a pressure vessel described in thisManufacturer's Partial Data Report on 11/16 1977, and state that to the best of my knowledge and belief, the Manufacturer has constructed this part in accordance with the ASME Code Section III.

By signing this certificate, neither the Inspector nor his employer makes any warranty, expressed or implied, concerning the part described in this Manufacturer's Partial Data Report. Furthermore, neither the Inspector nor his employer shall be liable in any manner for any personal injury or property damage or a loss of any kind arising from or connected with this inspection.

Date 11/16 1977J.F. Manion  
Inspector's Signature

J.F. Manion

Commissions

1107 California Comm. No.

National Board, State, Province and No.

\*Supplemental sheets in form of lists, sketches or drawings may be used provided (1) size is 8½" x 11", (2) information in items 1-2 on this data report is included on each sheet, and (3) each sheet is numbered and number of sheets is recorded in item 3, "Remarks".

## FORM N-2 MANUFACTURERS DATA REPORT FOR NUCLEAR PART AND APPURTENANCES\*

As required by the Provisions of the ASME Code Rules

T-5191

## ASSOCIATED PIPING &amp; ENGINEERING CORPORATION

1. (a) Manufactured by Temp Flex Div., 1707 W. Compton Blvd., Compton, CA 90224  
(Name and address of Manufacturer of part)(b) Manufactured for Duke Power Company, P.O. Box 2178, Charlotte, N.C. 28242  
(Name and address of Manufacturer of completed nuclear component)2. Identification-Manufacturer's Serial No. of Part H-6858 Nat'l Bd. No. ---(a) Constructed According to Drawing No. D-23754 Drawing Prepared by Temp Flex Division(b) Description of Part Inspected Type I-Main Steam Penetration Assembly. Mark No.: 2-M113  
Summer(c) Applicable ASME Code: Section III, Edition 1974, Addenda date 1974, Case No.    Class 2

## 3. REMARKS: (continued)

Materials as follows:

Process Pipe Sub-Assembly:

Flued Head - 54" x 40" x 34" N.P.S., SA-105.

Process Pipe - 31.250" I.D. x 1.510" Min. Wt., SA-106 Grade C.

Guard Pipe - 36.750" I.D. x 1.625" Min. Wt., SA-106 Grade C.

Bellows Sub-Assembly:

Bellows: 2 Ply .036" Thk., SA-240 Type 321.

Inner Center Sleeve, Outer Center Sleeve, and Outer End Sleeve:

54" O.D. x .50" Wt., SA-515 Grade 70.

Inner End Sleeve: 54.25" O.D. x 1.75" Wt. (before machining),  
SA-516 Grade 70.

Attachment Sleeve: 54.5" O.D. x .75" Wt., SA-516 Grade 70.

Ring Details:

Split Seal Ring: .500" Thk., SA-515 Grade 70.

## FORM N-2 MANUFACTURERS DATA REPORT FOR NUCLEAR PART AND APPURTENANCES\*

As required by the Provisions of the ASME Code Rules

T-5191

ASSOCIATED PIPING &amp; ENGINEERING CORPORATION

1. (a) Manufactured by Temp Flex Div., 1707 W. Compton Blvd., Compton, CA 90224  
(Name and address of Manufacturer of part)(b) Manufactured for Duke Power Company, P.O. Box 2178, Charlotte, N.C. 28242  
(Name and address of Manufacturer of completed nuclear component)

2. Identification-Manufacturer's Serial No. of Part H-6855 Nat'l Bd. No. ----

(a) Constructed According to Drawing No. D-23510 Drawing Prepared by Temp Flex Division

(b) Description of Part Inspected Type I-Main Steam Penetration Assembly. Mark No.: 1-M261  
Summer


(c) Applicable ASME Code: Section III, Edition 1974, Addenda date 1974, Case No. \_\_\_\_\_ Class 2

3. Remarks: 1) Assembly as a part used in Containment Vessel Penetration. 2) Bellows  
(Brief description of service for which component was designed)

Expansion Joint design complies with Paragraph NC 3649.4 (e) (1) of the Code.

3) Material description on attached Sheet No. 2 of 2.

We certify that the statements made in this report are correct and this vessel part or appurtenance as defined in the Code conforms to the rules of construction of the ASME Code Section III.  
 (The applicable Design Specification and Stress Report are not the responsibility of the part Manufacturer. An appurtenance Manufacturer is responsible for furnishing a separate Design Specification and Stress Report if the appurtenance is not included in the component Design Specification and Stress Report.)

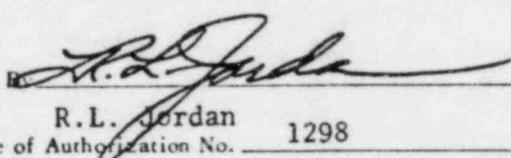Date 11/14 1977 Signed Temp Flex Division  
(Manufacturer)

Certificate of Authorization Expires January 5, 1979 Certificate of Authorization No. 1298

## CERTIFICATION OF DESIGN FOR APPURTENANCE (when applicable)

Design information on file at \_\_\_\_\_

Stress analysis report on file at \_\_\_\_\_

Design specifications certified by \_\_\_\_\_ Prof. Eng. State \_\_\_\_\_ Reg. No. \_\_\_\_\_

Stress analysis report certified by \_\_\_\_\_ Prof. Eng. State \_\_\_\_\_ Reg. No. \_\_\_\_\_


## CERTIFICATE OF SHOP INSPECTION

I, the undersigned, holding a valid commission issued by the National Board of Boiler and Pressure Vessel Inspectors and/or the State or Province of California and employed by H.S.B.I. & I.C.O. of Hartford, Conn. have inspected the part of a pressure vessel described in this

Manufacturer's Partial Data Report on 11/14 1977, and state that to the best of my knowledge and belief, the Manufacturer has constructed this part in accordance with the ASME Code Section III.

By signing this certificate, neither the Inspector nor his employer makes any warranty, expressed or implied, concerning the part described in this Manufacturer's Partial Data Report. Furthermore, neither the inspector nor his employer shall be liable in any manner for any personal injury or property damage or a loss of any kind arising from or connected with this inspection.

Date 11/14 1977

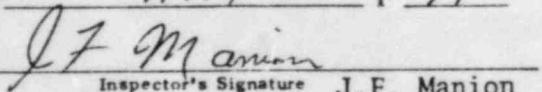
 Inspector's Signature J.F. Manion Commissions 1107 California Comm. No.  
 National Board, State, Province and No.

\*Supplemental sheets in form of lists, sketches or drawings may be used provided (1) size is 8½" x 11", (2) information in items 1-2 on this data report is included on each sheet, and (3) each sheet is numbered and number of sheets is recorded in item 3, "Remarks".

## FORM N-2 MANUFACTURERS DATA REPORT FOR NUCLEAR PART AND APPURTENANCES\*

As required by the Provisions of the ASME Code Rules

T-5191

## ASSOCIATED PIPING &amp; ENGINEERING CORPORATION

1. (a) Manufactured by Temp Flex Div., 1707 W. Compton Blvd., Compton, CA 90224  
(Name and address of Manufacturer of part)(b) Manufactured for Duke Power Company, P.O. Box 2178, Charlotte, N.C. 28242  
(Name and address of Manufacturer of completed nuclear component)2. Identification-Manufacturer's Serial No. of Part H-6855 Nat'l Bd. No. ----(a) Constructed According to Drawing No. D-23510 Drawing Prepared by Temp Flex Division(b) Description of Part Inspected Type I-Main Steam Penetration Assembly. Mark No.: 1-M261  
Summer(c) Applicable ASME Code: Section III, Edition 1974, Addenda date 1974, Case No. ----- Class 2

## 3. REMARKS: (continued)

Materials as follows:

Process Pipe Sub-Assembly:

- Flued Head - 54" x 40" x 34" N.P.S., SA-105.
- Process Pipe - 31.250" I.D. x 1.510" Min. Wt., SA-106 Grade C.
- Guard Pipe - 36.750" I.D. x 1.625" Min. Wt., SA-106 Grade C.

Bellows Sub-Assembly:

Bellows - 2 Ply .036" Thk., SA-240 Type 321.  
 Inner Center Sleeve, Outer Center Sleeve, and Outer End Sleeve -  
 54" O.D. x .50" Wt., SA-515 Grade 70.  
 Inner End Sleeve - 54.25" O.D. x 1.75" Wt. (before machining),  
 SA-516 Grade 70.  
 Attachment Sleeve - 54.5" O.D. x .75" Wt., SA516 Grade 70.

Ring Details:

Split Seal Ring - .500" Thk., SA-515 Grade 70.

## FORM N-2 MANUFACTURERS DATA REPORT FOR NUCLEAR PART AND APPURTENANCES\*

As required by the Provisions of the ASME Code Rules

T-5191

## ASSOCIATED PIPING &amp; ENGINEERING CORPORATION

1. (a) Manufactured by Temp Flex Div., 1707 W. Compton Blvd., Compton, CA 90224  
(Name and address of Manufacturer of part)(b) Manufactured for Duke Power Company, P.O. Box 2178, Charlotte, N.C. 28242  
(Name and address of Manufacturer of completed nuclear component)2. Identification-Manufacturer's Serial No. of Part H-6860 Nat'l Bd. No. ---(a) Constructed According to Drawing No. D-23770 Drawing Prepared by Temp Flex Division(b) Description of Part Inspected Type I-Main Steam Penetration Assembly. Mark No.: 2-M393  
Summer(c) Applicable ASME Code: Section III, Edition 1974, Addenda date 1974, Case No. --- Class 23. Remarks: 1) Assembly as a part used in Containment Vessel Penetration. 2) Bellows  
(Brief description of service for which component was designed)Expansion Joint design complies with Paragraph NC 3649.4 (e) (1) of the Code.3) Material description on attached Sheet 2 of 2.\* Added .4 to Paragraph NC 3649.

We certify that the statements made in this report are correct and this vessel part or appurtenance as defined in the Code conforms to the rules of construction of the ASME Code Section III.

(The applicable Design Specification and Stress Report are not the responsibility of the part Manufacturer. An appurtenance Manufacturer is responsible for furnishing a separate Design Specification and Stress Report if the appurtenance is not included in the component Design Specification and Stress Report.)

Date 12-1-77 1977 Signed Temp Flex Division  
(Manufacturer)By R.L. Jordan  
R. L. JordanCertificate of Authorization Expires January 5, 1979 Certificate of Authorization No. 1298

## CERTIFICATION OF DESIGN FOR APPURTENANCE (when applicable)

Design information on file at \_\_\_\_\_

Stress analysis report on file at \_\_\_\_\_

Design specifications certified by \_\_\_\_\_ Prof. Eng. State \_\_\_\_\_ Reg. No. \_\_\_\_\_

Stress analysis report certified by \_\_\_\_\_ Prof. Eng. State \_\_\_\_\_ Reg. No. \_\_\_\_\_

## CERTIFICATE OF SHOP INSPECTION

I, the undersigned, holding a valid commission issued by the National Board of Boiler and Pressure Vessel Inspectors and/or the State or Province of California and employed by H.S.B.I.& I.Co. of Hartford, Conn. have inspected the part of a pressure vessel described in thisManufacturer's Partial Data Report on 11/8 1977, and state that to the best of my knowledge and belief, the Manufacturer has constructed this part in accordance with the ASME Code Section III.

By signing this certificate, neither the Inspector nor his employer makes any warranty, expressed or implied, concerning the part described in this Manufacturer's Partial Data Report. Furthermore, neither the Inspector nor his employer shall be liable in any manner for any personal injury or property damage or a loss of any kind arising from or connected with this inspection.

Date 12-1 1977J.F. Manion  
Inspector's Signature

J.F. Manion

Commissions

1107 California Comm. No.

National Board, State, Province and No.

## FORM N-2 MANUFACTURERS DATA REPORT FOR NUCLEAR PART AND APPURTENANCES\*

As required by the Provisions of the ASME Code Rules

T-5191

ASSOCIATED PIPING & ENGINEERING CORPORATION1. (a) Manufactured by Temp Flex Div., 1707 W. Compton Blvd., Compton, CA 90224  
(Name and address of Manufacturer of part)(b) Manufactured for Duke Power Company, P.O. Box 2178, Charlotte, N.C. 28242  
(Name and address of Manufacturer of completed nuclear component)2. Identification-Manufacturer's Serial No. of Part H-6860 Nat'l Bd. No. ---(a) Constructed According to Drawing No. D-23770 Drawing Prepared by Temp Flex Division(b) Description of Part Inspected Type I-Main Steam Penetration Assembly. Mark No.: 2-M393  
Summer(c) Applicable ASME Code: Section III, Edition 1974, Addenda date 1974, Case No.        Class 2

## 3. REMARKS: (continued)

Materials as follows:

Process Pipe Sub-Assembly:

Flued Head - 54" x 40" x 34" N.P.S., SA-105.

Process Pipe - 31.250" I.D. x 1.510" Min. Wt., SA-106 Grade C.

Guard Pipe - 36.750" I.D. x 1.625" Min. Wt., SA-106 Grade C.

Bellows Sub-Assembly:

Bellows: 2 Ply .036" Thk., SA-240 Type 321.

Inner Center Sleeve, Outer Center Sleeve, and Outer End Sleeve:

54" O.D. x .50" Wt., SA-515 Grade 70.

Inner End Sleeve: 54.25" O.D. x 1.75" Wt. (before machining),  
SA-516 Grade 70.

Attachment Sleeve: 54.5" O.D. x .75" Wt., SA-516 Grade 70.

Ring Details:

Split Seal Ring: .500" Thk., SA-515 Grade 70.

## FORM N-2 MANUFACTURERS DATA REPORT FOR NUCLEAR PART AND APPURTENANCES\*

As required by the Provisions of the ASME Code Rules

T-5191

ASSOCIATED PIPING & ENGINEERING CORPORATION1. (a) Manufactured by Temp Flex Div., 1707 W. Compton Blvd., Compton, CA 90224  
(Name and address of Manufacturer of part)(b) Manufactured for Duke Power Company, P.O. Box 2178, Charlotte, N.C. 28242  
(Name and address of Manufacturer of completed nuclear component)2. Identification-Manufacturer's Serial No. of Part H-6856 Nat'l Bd. No. ----(a) Constructed According to Drawing No. D-23518 Drawing Prepared by Temp Flex Division(b) Description of Part Inspected Type I-Main Steam Penetration Assembly. Mark No.: 1-M393  
Summer(c) Applicable ASME Code: Section III, Edition 1974, Addenda date 1974, Case No. ----- Class 23. Remarks: 1) Assembly as a part used in Containment Vessel Penetration. 2) Bellows

(Brief description of service for which component was designed)

Expansion Joint design complies with Paragraph NC 3649 (e) (1) of the Code. 3)Material description on attached Sheet No. 2 of 2.

We certify that the statements made in this report are correct and this vessel part or appurtenance as defined in the Code conforms to the rules of construction of the ASME Code Section III.

(The applicable Design Specification and Stress Report are not the responsibility of the part Manufacturer. An appurtenance Manufacturer is responsible for furnishing a separate Design Specification and Stress Report if the appurtenance is not included in the component Design Specification and Stress Report.)

Date 11/11 1977 Signed Temp Flex Division By R. L. Jordan  
(Manufacturer) R. L. Jordan 1298  
Certificate of Authorization Expires January 5, 1979 Certificate of Authorization No. -----

## CERTIFICATION OF DESIGN FOR APPURTENANCE (when applicable)

Design information on file at \_\_\_\_\_

Stress analysis report on file at \_\_\_\_\_

Design specifications certified by \_\_\_\_\_ Prof. Eng. State \_\_\_\_\_ Reg. No. \_\_\_\_\_

Stress analysis report certified by \_\_\_\_\_ Prof. Eng. State \_\_\_\_\_ Reg. No. \_\_\_\_\_

## CERTIFICATE OF SHOP INSPECTION

I, the undersigned, holding a valid commission issued by the National Board of Boiler and Pressure Vessel Inspectors and/or the State or Province of California and employed by H.S.B.I. & I.Co. of Hartford, Conn. have inspected the part of a pressure vessel described in this

Manufacturer's Partial Data Report on 11/11 1977, and state that to the best of my knowledge and belief, the Manufacturer has constructed this part in accordance with the ASME Code Section III.

By signing this certificate, neither the Inspector nor his employer makes any warranty, expressed or implied, concerning the part described in this Manufacturer's Partial Data Report. Furthermore, neither the Inspector nor his employer shall be liable in any manner for any personal injury or property damage or a loss of any kind arising from or connected with this inspection.

Date 11/11 1977J.F. ManionInspector's Signature J.F. MANIONCommissions 1107 California Comm. No.

National Board, State, Province and No.

\*Supplemental sheets in form of lists, sketches or drawings may be used provided (1) size is 8½" x 11", (2) information in items 1-2 on this data report is included on each sheet, and (3) each sheet is numbered and number of sheets is recorded in item 3, "Remarks".

## FORM N-2 MANUFACTURERS DATA REPORT FOR NUCLEAR PART AND APPURTENANCES\*

As required by the Provisions of the ASME Code Rules

T-5191

ASSOCIATED PIPING & ENGINEERING CORPORATIONI. (a) Manufactured by Temp Flex Div., 1707 W. Compton Blvd., Compton, CA 90224  
(Name and address of Manufacturer of part)(b) Manufactured for Duke Power Company, P.O. Box 2178, Charlotte, N.C. 28242  
(Name and address of Manufacturer of completed nuclear component)2. Identification-Manufacturer's Serial No. of Part H-6856 Nat'l Bd. No. -----(a) Constructed According to Drawing No. D-23518 Drawing Prepared by Temp Flex Division(b) Description of Part Inspected Type I-Main Steam Penetration Assembly. Mark No.: 1-M393  
Summer(c) Applicable ASME Code: Section III, Edition 1974, Addenda date 1974, Case No. ----- Class 2

## 3. REMARKS: (continued)

Materials as follows:

Process Pipe Sub-Assembly:

Flued Head - 54" x 40" x 34" N.P.S., SA-105.

Process Pipe - 31.250" I.D. x 1.510" Min. Wt., SA-106 Grade C.

Guard Pipe - 36.750" I.D. x 1.625" Min. Wt., SA-106 Grade C.

Bellows Sub-Assembly:

Bellows - 2 Ply .036" Thk., SA-240 Type 321.

Inner Center Sleeve, Outer Center Sleeve, and Outer End Sleeve -  
54" O.D. x .50" Wt., SA-515 Grade 70.Inner End Sleeve - 54.25" O.D. x 1.75" Wt. (before machining),  
SA-516 Grade 70.

Attachment Sleeve - 54.5" O.D. x .75" Wt., SA-516 Grade 70.

Ring Details:

Split Seal Ring - .500" Thk., SA-515 Grade 70.

## FORY MANUFACTURERS DATA REPORT FOR NUCLEAR PART AND APPURTENANCES\*

As required by the Provisions of the ASME Code Rules

T-5191

## ASSOCIATED PIPING &amp; ENGINEERING CORPORATION

1. (a) Manufactured for Temp Flex Div., 1707 W. Compton Blvd., Compton, CA 90224  
(Name and address of Manufacturer of part)(b) Manufactured for Duke Power Company, P.O. Box 2178, Charlotte, N.C. 28242  
(Name and address of Manufacturer of completed nuclear component)

2. Identification-Manufacturer's Serial No. of Part H-6857 Nat'l Bd. No. ---

(a) Constructed According to Drawing No. D-23526 Drawing Prepared by Temp Flex Division

(b) Description of Part inspected Type I-Main Steam Penetration Assembly. Mark No.: 1-M423  
Summer

(c) Applicable ASME Code: Section III, Edition 1974, Addenda date 1974, Case No. --- Class 2

3. Remarks: 1) Assembly as a part used in Containment Vessel Penetration. 2) Bellows  
(Brief description of service for which component was designed)

Expansion Joint design complies with Paragraph NC 3649.4 (e) (1) of the Code.

3) Material description on attached Sheet 2 of 2.

We certify that the statements made in this report are correct and this vessel part or appurtenance as defined in the Code conforms to the rules of construction of the ASME Code Section III.  
 (The applicable Design Specification and Stress Report are not the responsibility of the part Manufacturer. An appurtenance Manufacturer is responsible for furnishing a separate Design Specification and Stress Report if the appurtenance is not included in the component Design Specification and Stress Report.)

Date 11/16 1977 Signed Temp Flex Division By *R.L. Jordan*  
(Manufacturer) R.L. Jordan  
Certificate of Authorization Expires January 5, 1979 Certificate of Authorization No. 1298

## CERTIFICATION OF DESIGN FOR APPURTEANCE (when applicable)

Design information on file at \_\_\_\_\_

Stress analysis report on file at \_\_\_\_\_

Design specifications certified by \_\_\_\_\_ Prof. Eng. State \_\_\_\_\_ Reg. No. \_\_\_\_\_

Stress analysis report certified by \_\_\_\_\_ Prof. Eng. State \_\_\_\_\_ Reg. No. \_\_\_\_\_

## CERTIFICATE OF SHOP INSPECTION

I, the undersigned, holding a valid commission issued by the National Board of Boiler and Pressure Vessel Inspectors and/or the State or Province of California and employed by H.S.B.I. & I.Co. of Hartford, Conn.

have inspected the part of a pressure vessel described in this Manufacturer's Partial Data Report on 11/16 1977, and state that to the best of my knowledge and belief, the Manufacturer has constructed this part in accordance with the ASME Code Section III.

By signing this certificate, neither the Inspector nor his employer makes any warranty, expressed or implied, concerning the part described in this Manufacturer's Partial Data Report. Furthermore, neither the Inspector nor his employer shall be liable in any manner for any personal injury or property damage or a loss of any kind arising from or connected with this inspection.

Date 11/16 1977

*J.F. Manion*  
Inspector's Signature

J.F. Manion

Commissions 1107 California Comm. No.  
National Board, State, Province and No.

\*Supplemental sheets in form of lists, sketches or drawings may be used provided (1) size is 8½" x 11", (2) information in items 1-2 on this data report is included on each sheet, and (3) each sheet is numbered and number of sheets is recorded in item 3, "Remarks".

## FORM N-2 MANUFACTURERS DATA REPORT FOR NUCLEAR PART AND APPURTENANCES\*

As required by the Provisions of the ASME Code Rules

T-5191

ASSOCIATED PIPING & ENGINEERING CORPORATION1. (a) Manufactured by Temp Flex Div., 1707 W. Compton Blvd., Compton, CA 90224  
(Name and address of Manufacturer of part)(b) Manufactured for Duke Power Company, P.O. Box 2178, Charlotte, N.C. 28242  
(Name and address of Manufacturer of completed nuclear component)2. Identification-Manufacturer's Serial No. of Part H-6857 Nat'l Bd. No. ---(a) Constructed According to Drawing No. D-23526 Drawing Prepared by Temp Flex Division(b) Description of Part Inspected Type I-Main Steam Penetration Assembly. Mark No.: 1-M423  
Summer(c) Applicable ASME Code: Section III, Edition 1974, Addenda date 1974, Case No.   Class 2

## 3. REMARKS: (continued)

Materials as follows:

Process Pipe Sub-Assembly:

Flued Head - 54" x 40" x 34" N.P.S., SA-105.

Process Pipe - 31.250" I.D. x 1.510" Min. Wt., SA-106 Grade C.

Guard Pipe - 36.750" I.D. x 1.625" Min. Wt., SA-106 Grade C.

Bellows Sub-Assembly:

Bellows: 2 Ply .036" Thk., SA-240 Type 321.

Inner Center Sleeve, Outer Center Sleeve, and Outer End Sleeve:

54" O.D. x .50" Wt., SA-515 Grade 70.

Inner End Sleeve: 54.25" O.D. x 1.75" Wt. (before machining),  
SA-516 Grade 70.

Attachment Sleeve: 54.5" O.D. x .75" Wt., SA-516 Grade 70.

Ring Details:

Split Seal Ring: .500" Thk., SA-515 Grade 70.

## FORM N-2 MANUFACTURERS DATA REPORT FOR NUCLEAR PART AND APPURTENANCES\*

As required by the Provisions of the ASME Code Rules

T-5191

## ASSOCIATED PIPING &amp; ENGINEERING CORPORATION

1. (a) Manufactured by Temp Flex Div., 1707 W. Compton Blvd., Compton, CA 90224  
(Name and address of Manufacturer of part)(b) Manufactured for Duke Power Company, P.O. Box 2178, Charlotte, N.C. 28242  
(Name and address of Manufacturer of completed nuclear component)2. Identification-Manufacturer's Serial No. of Part H-6861 Nat'l Bd. No. ---(a) Constructed According to Drawing No. D-23778 Drawing Prepared by Temp Flex Division(b) Description of Part Inspected Type I-Main Steam Penetration Assembly. Mark No.: 2-M423 Summer(c) Applicable ASME Code: Section III, Edition 1974, Addenda date 1974, Case No. ----- Class 23. Remarks: 1) Assembly as a part used in Containment Vessel Penetration. 2) Bellows  
(Brief description of service for which component was designed)

Expansion Joint design complies with Paragraph NC 3649.4 (e) (1) of the Code.

3) Material description on attached Sheet 2 of 2.

We certify that the statements made in this report are correct and this vessel part or appurtenance as defined in the Code conforms to the rules of construction of the ASME Code Section III.

(The applicable Design Specification and Stress Report are not the responsibility of the part Manufacturer. An appurtenance Manufacturer is responsible for furnishing a separate Design Specification and Stress Report if the appurtenance is not included in the component Design Specification and Stress Report.)

Date 11/15 1977 Signed Temp Flex Division By R.L. Jordan  
(Manufacturer) R.L. Jordan  
Certificate of Authorization Expires January 5, 1979 Certificate of Authorization No. 1298

## CERTIFICATION OF DESIGN FOR APPURTENANCE (when applicable)

Design information on file at \_\_\_\_\_

Stress analysis report on file at \_\_\_\_\_

Design specifications certified by \_\_\_\_\_ Prof. Eng. State \_\_\_\_\_ Reg. No. \_\_\_\_\_

Stress analysis report certified by \_\_\_\_\_ Prof. Eng. State \_\_\_\_\_ Reg. No. \_\_\_\_\_

## CERTIFICATE OF SHOP INSPECTION

I, the undersigned, holding a valid commission issued by the National Board of Boiler and Pressure Vessel Inspectors and/or the State or Province of California and employed by H.S.B.I.&I.Co. of Hartford, Conn. have inspected the part of a pressure vessel described in this

Manufacturer's Partial Data Report on 11/15 1977, and state that to the best of my knowledge and belief, the Manufacturer has constructed this part in accordance with the ASME Code Section III.

By signing this certificate, neither the Inspector nor his employer makes any warranty, expressed or implied, concerning the part described in this Manufacturer's Partial Data Report. Furthermore, neither the Inspector nor his employer shall be liable in any manner for any personal injury or property damage or a loss of any kind arising from or connected with this inspection.

Date 11/15 1977J.F. Manion  
Inspector's Signature

J.F. Manion

Commissions

1107 California Comm. No.

National Board, State, Province and No.

## FORM N-2 MANUFACTURERS DATA REPORT FOR NUCLEAR PART AND APPURTENANCES\*

As required by the Provisions of the ASME Code Rules

T-5191

ASSOCIATED PIPING & ENGINEERING CORPORATION1. (a) Manufactured by Temp Flex Div., 1707 W. Compton Blvd., Compton, CA 90224  
(Name and address of Manufacturer of part)1. (b) Manufactured for Duke Power Company, P.O. Box 2178, Charlotte, N.C. 28242  
(Name and address of Manufacturer of completed nuclear component)2. Identification-Manufacturer's Serial No. of Part H-6861 Nat'l Bd. No. ---(a) Constructed According to Drawing No. D-23778 Drawing Prepared by Temp Flex Division(b) Description of Part Inspected Type I-Main Steam Penetration Assembly. Mark No.: 2-M423  
Summer(c) Applicable ASME Code: Section III, Edition 1974, Addenda date 1974, Case No. ----- Class 2

## 3. REMARKS: (continued)

Materials as follows:

Process Pipe Sub-Assembly:

Flued Head - 54" x 40" x 34" N.P.S., SA-105.

Process Pipe - 31.250" I.D. x 1.510" Min. Wt., SA-106 Grade C.

Guard Pipe - 36.750" I.D. x 1.625" Min. Wt., SA-106 Grade C.

Bellows Sub-Assembly:

Bellows: 2 Ply .036" Thk., SA-240 Type 321.

Inner Center Sleeve, Outer Center Sleeve, and Outer End Sleeve:

54" O.D. x .50" Wt., SA-515 Grade 70.

Inner End Sleeve: 54.25" O.D. x 1.75" Wt. (before machining),  
SA-516 Grade 70.

Attachment Sleeve: 54.5" O.D. x .75" Wt., SA-516 Grade 70.

Ring Details:

Split Seal Ring: .500" Thk., SA-515 Grade 70.

ZSM7

**FORM NPV-1 MANUFACTURERS' DATA REPORT FOR NUCLEAR PUMPS OR VALVES\***  
**(As Required by the Provisions of the ASME Code, Section III, Div. 1)**

1. Manufactured by	Atwood & Morrill Co., Inc., Salem, Mass. (Name and Address of Manufacturer)					
2. Manufactured for	Mecklenburg Power Supply Co., Charlotte, No. Carolina (Name and Address of Purchaser or Owner)					
3. Location of Installation	Catawba Nuclear Station, Newport, So. Carolina (Name and Address)					
4. Pump or Valve	Valve	Nominal Inlet Size	34"	Outlet Size	34"	(inch)
(a) Model No., Series No. or Type	(b) Manufacturers' Serial No.	(c) Canadian Registration No.	(d) Drawing No.	(e) Class	(f) Nat'l. Bd. No.	(g) Year Built
(1) 34" Main Steam Isolation Valve	2-13000	N/A	13000-01-H Rev. 10	2	N/A	1977
(3)						
(4)						
(5)						
(6)						
(7)						
(8)						
(9)						
(10)						

## 5. For service in Main Steam Piping System

(Brief description of service for which equipment was designed)

6. Design Conditions 1185  
(Pressure) psi 600  
(Temperature) °F or Valve Pressure Class \_\_\_\_\_ (1)

7. Cold Working Pressure 1500 psi at 100°F.

8. Pressure Retaining Pieces

Mark No.	Material Spec. No.	Manufacturer	Remarks
<b>(a) Castings</b>			
Body	SA216, Gr. WCB	Atwood & Morrill Ltd.	S/N 2-13000
RT#J1357			
Ht. #121			
<b>(b) forgings</b>			
Cover	SA105	Cann & Saul	S/N 5-13000
Ht. #216077			
Poppet	SA105	Cann & Saul	S/N 3-13000
Ht. #216077			
Pilot Poppet	SAT82, Gr. F6	Cann & Saul	S/N 2-13000
Ht. #72613			

(1) For manually operated valves only.

\* Supplemental sheets in form of lists, sketches or drawings may be used provided (1) size is 8-1/2" x 11", (2) information in items 1, 2 and 5 on this data report is included on each sheet, and (3) each sheet is numbered and number of sheets is recorded at top of this form.

FORM NPV-1 (Back)

9. Hydrostatic test shell 2250 psi.  
disc 1500

**CERTIFICATE OF COMPLIANCE**

We certify that the statements made in this report are correct and that this pump, or valve, conforms to the rules of construction of the ASME Code for Nuclear Power Plant Components. Section III, Div. I, Edition 1971.  
Addenda Winter 72, Code Case No. N/A, Date N/A  
(Date)  
Signed Atwood & Morrill Co., Inc. by Walter Emerson 22 Nov 77  
(Manufacturer) Quality Control Manager  
Our ASME Certificate of Authorization No. N1766 to use the N symbol expires 5-20-80  
(IN) (INFEV) (Date)

## CERTIFICATION OF DESIGN

Design information on file at Mill Power Supply Co., Charlotte, No. Carolina  
Stress analysis report (Class 1 only) on file at N/A

Design specifications certified by (1) Thomas F. Wyke

PE State No. Carolina Reg. No. 4870

Stress analysis certified by (1) N/A

PE State N/A Reg. No. N/A

(1) Signature not required. List name only.

**CERTIFICATE OF SHOP INSPECTION**

I, the undersigned, holding a valid commission issued by the National Board of Boiler and Pressure Vessel Inspectors and the State or Province of Massachusetts and employed by H.S.B.I. & I. Co. of Hartford, Conn. have inspected the pump, or valve, described in this Data Report on NOV. 25 1977, and state that to the best of my knowledge and belief, the Manufacturer has constructed this pump, or valve, in accordance with the ASME Code, Section III.

By signing this certificate, neither the Inspector nor his employer makes any warranty, expressed or implied, concerning the equipment described in this Data Report. Furthermore, neither the Inspector nor his employer shall be liable in any manner for any personal injury or property damage or a loss of any kind arising from or connected with this inspection.

Date Nov. 28, 1977  
Gene A. Horcian  
(Inspector)

**FORM NPV-1 MANUFACTURERS' DATA REPORT FOR NUCLEAR PUMPS OR VALVES\***  
**(As Required by the Provisions of the ASME Code, Section III, Div. 1)**

15m 7

- |   |  |                                     |                    |           |                       |                   |
|---|--|-------------------------------------|--------------------|-----------|-----------------------|-------------------|
| 1. Manufactured by                      | Atwood & Morrill Co., Inc., Salem, Mass.<br>(Name and Address of Manufacturer)             |                                     |                    |           |                       |                   |
| 2. Manufactured for                     | Mill Power Supply Co., Charlotte, No. Carolina<br>(Name and Address of Purchaser or Owner) |                                     |                    |           |                       |                   |
| 3. Location of Installation             | Catawba Nuclear Station, Newport, So. Carolina<br>(Name and Address)                       |                                     |                    |           |                       |                   |
| 4. Pump or Valve                        | Valve  | Nominal Inlet Size                  | 34"                | (inch)    | Outlet Size           | 34"               |
| (a) Model No.,<br>Series No.<br>or Type | (b) Manufacturers'<br>Serial<br>No.  | (c) Canadian<br>Registration<br>No. | (d) Drawing<br>No. | (e) Class | (f) Nat'l.<br>Bd. No. | (g) Year<br>Built |
| (1) 34" Main Steam                      | 4-13000  | N/A                                 | 13000-01-H         | 2         | N/A                   | 1977              |
| (3) Isolation Valve                     |  |                                     | Rev. 10            |           |                       |                   |
| (4)                                     |  |                                     |                    |           |                       |                   |
| (5)                                     |  |                                     |                    |           |                       |                   |
| (6)                                     |  |                                     |                    |           |                       |                   |
| (7)                                     |  |                                     |                    |           |                       |                   |
| (8)                                     |  |                                     |                    |           |                       |                   |
| (9)                                     |  |                                     |                    |           |                       |                   |
| (10)                                    |  |                                     |                    |           |                       |                   |

5.  For Service in Main Steam Piping System

(Brief description of service for which equipment was designed)

6. Design Conditions 1185 (Pressure) psi 600 (Temperature) °F or Valve Pressure Class \_\_\_\_\_ (1)  
7. Cold Working Pressure 1500 psi at 100°F.  
8. Pressure Retaining Pieces.

(1) For manually operated valves only.

- \* Supplemental sheets in form of lists, sketches or drawings may be used provided (1) size is 8-1/2" x 11", (2) information in items 1, 2 and 5 on this data report is included on each sheet, and (3) each sheet is numbered and number of sheets is recorded at top of this form.

**FORM NPV-1 (Back)**

9. Hydrostatic test Shell 2250 psi.  
Disc 1500

**CERTIFICATE OF COMPLIANCE**

We certify that the statements made in this report are correct and that this pump, or valve, conforms to the rules of construction of the ASME Code for Nuclear Power Plant Components. Section III, Div. I., Edition 1971, Addenda Winter 1972, Code Case No. N/A. Date N/A  
(Date)  
Signed Atwood & Merrill Co., Inc. by Walter F. Emerson QC Mgr. 28 Oct 77  
(Manufacturer)  
Our ASME Certificate of Authorization No. N1766 to use the N symbol expires 5-20-80  
(IN) (INFEV) (Date)

**CERTIFICATION OF DESIGN**

Design information on file at Mill Power Supply Co., Charlotte, No. Carolina  
Stress analysis report (Class 1 only) on file at N/A

Design specifications certified by (1) R.E. Miller  
PE State So. Carolina Reg No. 4237

Stress analysis certified by (1) N/A

(1) Signature not required. List name only.

**CERTIFICATE OF SHOP INSPECTION**

I, the undersigned, holding a valid commission issued by the National Board of Boiler and Pressure Vessel Inspectors and the State or Province of Massachusetts and employed by H.S.B. I. & I. Co. of Hartford, Conn. have inspected the pump, or valve, described in this Data Report on Dec. 28<sup>th</sup> 1977 and state that to the best of my knowledge and belief, the Manufacturer has constructed this pump, or valve, in accordance with the ASME Code, Section III.

**By signing this certificate, neither the Inspector nor his employer makes any warranty, expressed or implied, concerning the equipment described in this Data Report. Furthermore, neither the Inspector nor his employer shall be liable in any manner for any personal injury or property damage or a loss of any kind arising from or connected with this inspection.**

Date Dec. 26<sup>th</sup> 1977  
4:00 p.m.

Commissions Mass. 1196  
(Nat'l Bd., State, Prov. and No.)

## As Required by the Provisions of the ASME Code, Section III, Div. 1

25M5

1. Manufactured by	<u>Atwood &amp; Morrill Co., Inc.</u>		<u>Salem, MA</u>			
(Name and Address of N Certificate Holder)						
2. Manufactured for	<u>Mill Power Supply Co.</u>		<u>Charlotte, No. Carolina</u>			
(Name and Address of Purchaser or Owner)						
3. Location of Installation	<u>Catawba Nuclear Station, Newport, So. Carolina</u>					
(Name and Address)						
4. Pump or Valve	<u>Valve</u>	Nominal Inlet Size	<u>34"</u>			
		(inch)	Outlet Size	<u>34"</u>		
			(inch)			
(a) Model No., (b) N Certificate Holder's Series No. or Type	(b) Serial No.	(c) Canadian Registration No.	(d) Drawing No.	(e) Class	(f) Nat'l. Bd. No.	(g) Year Built
(1) <u>34" Main Steam 8-13000</u>	<u>N/A</u>	<u>13000-01-H</u>	<u>2</u>	<u>N/A</u>	<u>1978</u>	
(2) <u>Isolation Valve</u>			<u>Rev. 11</u>			
(3)						
(4)						
(5)						
(6)						
(7)						
(8)						
(9)						
(10)						

5. For Service in Main Steam Piping System  
(Brief description of service for which equipment was designed)

6. Design Conditions 1185 (Pressure) psi 600 (Temperature) °F or Valve Pressure Class \_\_\_\_\_ (1)

7. Cold Working Pressure 1500 psi at 100°F.

8. Pressure Retaining Pieces

Mark No.	Material Spec. No.	Manufacturer	Remarks
<b>(a) Castings</b>			
<u>Body</u>	<u>SA 216, Gr. WCB</u>	<u>Atwood &amp; Morrill Ltd.</u>	<u>S/N 8-13000</u>
<u>Ht. # 114</u>			
<u>Rt. # K7</u>			
<b>(b) forgings</b>			
<u>Cover</u>	<u>SA 105</u>	<u>Cann &amp; Saul</u>	<u>S/N 3-13000</u>
<u>Ht. # 216077</u>			
<u>Poppet</u>	<u>SA 105</u>	<u>Cann &amp; Saul</u>	<u>S/N 8-13000</u>
<u>Ht. # 216077</u>			
<u>Pilot Poppet</u>	<u>SA 182, Gr. F6</u>	<u>Cann &amp; Saul</u>	<u>S/N 8-13000</u>
<u>Ht. # 8-14649</u>			

(1) For manually operated valves only.

\* Supplemental sheets in form of lists, sketches or drawings may be used provided (1) size is 8-1/2" x 11", (2) information in items 1, 2 and 5 on this Data Report is included on each sheet, and (3) each sheet is numbered and number of sheets is recorded at top of this form.

## FORM NPV-1 (Black)

Mark No.	Material Spec. No.	Manufacturer	Remarks
(c) Bolting			
Studs	SA 193, Gr. B7	Jos. Dyson & Sons	Ht. #8088146 Code C99B
Nuts	SA 194, Gr. 2H	Jos. Dyson & Sons	Ht. #L04394 Code A94
(d) Other Parts			
* Pipe (2" sch-160)	SA 106, Gr. B	Braman Dow (U.S. Steel)	Ht. # L20864
* Pipe (½" sch-160)	SA 106, Gr. B	Braman Dow (Leland Tube)	Ht. # M91512
* 45° Elbow	SA 105	Braman Dow (Vogt Mach.)	Ht. # L00281
* Note: These parts comply with the Code for material construction and workmanship, but are not included in design.			

9. Hydrostatic test 2250 psi. Disk Differential test pressure 1500 psi.

## CERTIFICATE OF COMPLIANCE

We certify that the statements made in this report are correct and that this pump, or valve, conforms to the rules of construction of the ASME Code for Nuclear Power Plant Components. Section III, Div. I, Edition 1971.  
 Addenda Winter 1972, Code Case No. N/A Date N/A  
 (Date)  
 Signed Atwood & Morrill Co., Inc. by Walter F. Emerson 27 Jun 78  
 (In Certificate Holder) Quality Control Manager  
 Our ASME Certificate of Authorization No. N1766 to use the N symbol expires 5-20-80  
 (N) (Date)

## CERTIFICATION OF DESIGN

Design information on file at Mill Power Supply Co., Charlotte, No. Carolina  
 Stress analysis report (Class 1 only) on file at N/A

Design specifications certified by (1) R.E. Miller  
 PE State So. Carolina Reg. No. 4237  
 Stress analysis certified by (1) N/A  
 PE State N/A Reg. No. N/A

(1) Signature not required. List name only.

## CERTIFICATE OF SHOP INSPECTION

I, the undersigned, holding a valid commission issued by the National Board of Boiler and Pressure Vessel Inspectors and the State or Province of Massachusetts and employed by H.S.B.I. & T. Co. of Hartford, Conn. have inspected the pump, or valve, described in this Data Report on JUNE 27 1978, and state that to the best of my knowledge and belief, the N Certificate Holder has constructed this pump, or valve, in accordance with the ASME Code, Section III.

By signing this certificate, neither the Inspector nor his employer makes any warranty, expressed or implied, concerning the equipment described in this Data Report. Furthermore, neither the Inspector nor his employer shall be liable in any manner for any personal injury or property damage or a loss of any kind arising from or connected with this inspection.

Date JUNE 27 1978

Walter F. Emerson  
 (Inspector)

Commissions MA1222

(Nat'l Bd., State, Prov. and No.)

15m<sup>5</sup>

**FORM NPV-1 MANUFACTURERS' DATA REPORT FOR NUCLEAR PUMPS OR VALVES\***  
**(As Required by the Provisions of the ASME Code, Section III, Div. 1)**

- |  |                                   |  |     |                                     |        |                    |           |                       |                   |
|--|-----------------------------------|--|-----|-------------------------------------|--------|--------------------|-----------|-----------------------|-------------------|
| 1. Manufactured by                       |                                   | Atwood & Morrill Co., Inc. Salem, Mass.        |     |                                     |        |                    |           |                       |                   |
| (Name and Address of Manufacturer)       |                                   |  |     |                                     |        |                    |           |                       |                   |
| 2. Manufactured for                      |                                   | Mill Power Supply Co., Charlotte, No. Carolina |     |                                     |        |                    |           |                       |                   |
| (Name and Address of Purchaser or Owner) |                                   |  |     |                                     |        |                    |           |                       |                   |
| 3. Location of Installation              |                                   | Catawba Nuclear Station, Newport, So. Carolina |     |                                     |        |                    |           |                       |                   |
| (Name and Address)                       |                                   |  |     |                                     |        |                    |           |                       |                   |
| 4. Pump or Valve                         |                                   | Nominal Inlet Size                             |     |                                     | 34"    | Outlet Size        |           |                       |                   |
|  |                                   |  |     |                                     | (inch) | 34"                |           |                       |                   |
| (a) Model No.,<br>Series No.<br>or Type  |                                   | (b) Manufacturers'<br>Serial<br>No.            |     | (c) Canadian<br>Registration<br>No. |        | (d) Drawing<br>No. | (e) Class | (f) Nat'l.<br>Bd. No. | (g) Year<br>Built |
| (1)                                      | 34" Main Steam<br>Isolation Valve | 3-13000  | N/A | 13000-01-H                          | 2      | N/A                | 1978      |                       |                   |
| (3)                                      |                                   |  |     | Rev. 10                             |        |                    |           |                       |                   |
| (4)                                      |                                   |  |     |                                     |        |                    |           |                       |                   |
| (5)                                      |                                   |  |     |                                     |        |                    |           |                       |                   |
| (6)                                      |                                   |  |     |                                     |        |                    |           |                       |                   |
| (7)                                      |                                   |  |     |                                     |        |                    |           |                       |                   |
| (8)                                      |                                   |  |     |                                     |        |                    |           |                       |                   |
| (9)                                      |                                   |  |     |                                     |        |                    |           |                       |                   |
| (10)                                     |                                   |  |     |                                     |        |                    |           |                       |                   |

5. For Service in Main Steam Piping System  
 (Brief description of service for which equipment was designed)

---

6. Design Conditions 1185 (Pressure) psi 600 (Temperature) °F or Valve Pressure Class \_\_\_\_\_ (1)

7. Cold Working Pressure 1500 psi at 100°F.

8. Pressure Retaining Pieces

(1) For manually operated valves only.

\* Supplemental sheets in form of lists, sketches or drawings may be used provided (1) size is 8-1/2" x 11", (2) information in items 1, 2 and 5 on this data report is included on each sheet, and (3) each sheet is numbered and number of sheets is recorded at top of this form.

## FORM NPV-1 (Back)

Mark No.	Material Spec. No.	Manufacturer	Remarks
<b>(c) Bolting</b>			
Studs	SA193, Gr. B7	Jos. Dyson & Sons	Ht. #8088146 Code C99B
Nuts	SA194, Gr. 2H	Jos. Dyson & Sons	Ht. #L04394 Code A94
<b>(d) Other Parts</b>			
*	Pipes (2" Sch. 150) SA106, Gr. B	Braman Dow (U.S.Steel)	Ht. #L20864
*	Pipe (1/2" Sch. 150) SA106, Gr. B	Braman Dow (Leland Tube)	Ht. #M91512
*	45° Elbow SA105	Braman Dow (Vogt Mach.)	Ht. #L00281
* Note: These parts comply with the Code for material construction and workmanship, but are not included in design.			

9. Hydrostatic test Shell 2250 psi.

Disc 1500

## CERTIFICATE OF COMPLIANCE

We certify that the statements made in this report are correct and that this pump, or valve, conforms to the rules of construction of the ASME Code for Nuclear Power Plant Components. Section III, Div. I, Edition 1971, Addenda Winter 1972, Code Case No. N/A, Date N/A

Signed Atwood & Morrill Co., Inc.  
(Manufacturer)

by Walter F. Omera (QC Mgr. 18) Jan 78

Our ASME Certificate of Authorization No. N1766 to use the N symbol expires 5-20-80  
(N) (NFV) (Date)

## CERTIFICATION OF DESIGN

Design information on file at Mill Power Supply Co. Charlotte, No. Carolina

Stress analysis report (Class 1 only) on file at N/A

Design specifications certified by (1) R.E. Miller,

PE State So. Carolina Reg. No. 4237

Stress analysis certified by (1) N/A

PE State N/A Reg. No. N/A

(1) Signature not required. List name only.

## CERTIFICATE OF SHOP INSPECTION

I, the undersigned, holding a valid commission issued by the National Board of Boiler and Pressure Vessel Inspectors and the State or Province of Massachusetts and employed by H.S.B. I. & I. Co. of Hartford, Conn. have inspected the pump, or valve, described in this Data Report on Jan. 18<sup>th</sup> 1978, and state that to the best of my knowledge and belief, the Manufacturer has constructed this pump, or valve, in accordance with the ASME Code, Section III.

By signing this certificate, neither the Inspector nor his employer makes any warranty, expressed or implied, concerning the equipment described in this Data Report. Furthermore, neither the Inspector nor his employer shall be liable in any manner for any personal injury or property damage or a loss of any kind arising from or connected with this inspection.

Date Jan. 18<sup>th</sup> 19 78

J. Price  
(Inspector)

Commissions Mass. 1196  
(Nat'l Bd., State, Prov. and No.)

2SM3

**FORM NPV-1 MANUFACTURERS' DATA REPORT FOR NUCLEAR PUMPS OR VALVES\***  
**(As Required by the Provisions of the ASME Code, Section III, Div. 1)**

1. Manufactured by	Atwood & Morril Co., Inc. Salem, MA (Name and Address of Manufacturer)						
2. Manufactured for	Mill Power Supply Co., Charlotte, No. Carolina (Name and Address of Purchaser or Owner)						
3. Location of Installation	CATAWBA Nuclear Station, Newport, So. Carolina (Name and Address)						
4. Pump or Valve	Valve	Nominal Inlet Size	34"	Outlet Size	34"	(inch)	
(a) Model No., Series No. or Type	(b) Manufacturers' Serial No.	(c) Canadian Registration No.	(d) Drawing No.	(e) Class	(f) Nat'l. Bd. No.	(g) Year Built	
(1) 34" Main Steam Isolation Valve	5-13000	N/A	13000-01-H	2	N/A	1978	
(3)			Rev. 10				
(4)							
(5)							
(6)							
(7)							
(8)							
(9)							
(10)							

## 5. For service in Main Steam Piping System

(Brief description of service for which equipment was designed)

6. Design Conditions 1185 psi 600 °F or Valve Pressure Class (1)  
 (Pressure) (Temperature)
7. Cold Working Pressure 1500 psi at 100°F.
8. Pressure Retaining Pieces

Mark No.	Material Spec. No.	Manufacturer	Remarks
<b>(a) Castings</b>			
Body	SA216, GR. WCB	Atwood & Morril LTD	S/N 5-13000
HT# 125			
RT# J1413			
<b>(b) forgings</b>			
Cover	SA 105	Cann & Saul	S/N 1-13000
HT# 216077			
Poppet	SA 105	Cann & Saul	S/N 5-13000
HT# 216077			
Pilot Poppet	SA 182, GR. F6	Cann & Saul	S/N 5-13000
HT# 834649			

(1) For manually operated valves only.

\* Supplemental sheets in form of lists, sketches or drawings may be used provided (1) size is 8-1/2" x 11", (2) information in items 1, 2 and 5 on this data report is included on each sheet, and (3) each sheet is numbered and number of sheets is recorded at top of this form.

Mark No.	Material Spec. No.	Manufacturer	Remarks
(c) Bolting			
Studs	SA 193, GR. B7	Jos. Dyson & Sons	HT # 8088146 Code C99B
Nuts	SA 194, GR. 2H	Jos. Dyson & Sons	HT # L04394 Code A94
(d) Other Parts			
*Pipes (2"sch-160)	SA 106, GR. B	Braman Dow (U.S. Steel)	HT # 120864
*Pipe (3"sch-160)	SA 106, GR. B	Braman Dow (Leland Tube)	HT # M91512
*45° Elbow	SA 105	Braman Dow (Vogt Mach.)	HT # L00281
<b>*NOTE:</b> These parts comply with the Code for Material Construction and Workmanship, but are not included in design.			

9. Hydrostatic test shell 2250 psi.  
disc. 1500

#### CERTIFICATE OF COMPLIANCE

We certify that the statements made in this report are correct and that this pump, or valve, conforms to the rules of construction of the ASME Code for Nuclear Power Plant Components. Section III, Div. I, Edition 1971, Addenda Winter 1972, Code Case No. N/A. Date N/A  
 Signed Atwood & Morrill Co., Inc. by Walter F. Eman QC Mgr 3/2/78  
 (Date)  
 (Manufacturer)  
 Our ASME Certificate of Authorization No. N1766 to use the N symbol expires 5-20-80  
 (N) (NFV) (Date)

#### CERTIFICATION OF DESIGN

Design information on file at Mill Power Supply Co., Charlotte, No. Carolina  
 Stress analysis report (Class 1 only) on file at N/A

Design specifications certified by (1) R.E. Miller  
 PE State So. Carolina Reg. No. 4237

Stress analysis certified by (1) N/A  
 PE State N/A Reg. No. N/A

(1) Signature not required. List name only.

#### CERTIFICATE OF SHOP INSPECTION

I, the undersigned, holding a valid commission issued by the National Board of Boiler and Pressure Vessel Inspectors and the State or Province of Massachusetts and employed by H.S.B.I. & I. Co. of Hartford, Conn. have inspected the pump, or valve, described in this Data Report on Feb. 3<sup>rd</sup> 1978, and state that to the best of my knowledge and belief, the Manufacturer has constructed this pump, or valve, in accordance with the ASME Code, Section III.

By signing this certificate, neither the Inspector nor his employer makes any warranty, expressed or implied, concerning the equipment described in this Data Report. Furthermore, neither the Inspector nor his employer shall be liable in any manner for any personal injury or property damage or a loss of any kind arising from or connected with this inspection.

Date Feb 3<sup>rd</sup> 1978  
 J. Cone  
 (Inspector)

Commissions Mass. 1196  
 (Nat'l Bd., State, Prov. and No.)

ZSM 3

FORM NPV-1 MANUFACTURERS' DATA REPORT FOR NUCLEAR PUMPS OR VALVES\*  
(As Required by the Provisions of the ASME Code, Section III, Div. 1)

1. Manufactured by	Atwood & Morrill Co., Inc., Salem, MA (Name and Address of Manufacturer)					
2. Manufactured for	Mill Power Supply Co., Charlotte, No. Carolina (Name and Address of Purchaser or Owner)					
3. Location of Installation	CATAWBA Nuclear Station, Newport, So. Carolina (Name and Address)					
4. Pump or Valve	Valve	Nominal Inlet Size	34"	Outlet Size	34"	(inch)
(a) Model No., Series No. or Type	(b) Manufacturers' Serial No.	(c) Canadian Registration No.	(d) Drawing No.	(e) Class	(f) Nat'l. Bd. No.	(g) Year Built
(1) 34" Main Steam	6-13000	N/A	13000-01-H	2	N/A	1978
(3) Isolation Valve			Rev. 10			
(4)						
(5)						
(6)						
(7)						
(8)						
(9)						
(10)						

5. For service in Main Steam Piping System

(Brief description of service for which equipment was designed)

6. Design Conditions 1185 psi 600 °F or Valve Pressure Class (1)  
(Pressure) (Temperature)

7. Cold Working Pressure 1500 psi at 100°F.

8. Pressure Retaining Pieces

Mark No.	Material Spec. No.	Manufacturer	Remarks
<b>(a) Castings</b>			
Body	SA 216, GR. WCB	Atwood & Morrill LTD. S/N 6-13000	
HT # 132			
RT # J1414			
<b>(b) forgings</b>			
Cover	SA 105	Cann & Saul	S/N 8-13000
HT # 215759			
Poppet	SA 105	Cann & Saul	S/N 4-13000
HT # 216077			
Pilot Poppet	SA 182, GR. F6	Cann & Saul	S/N 6-13000
HT # 834649			

(1) For manually operated valves only.

\* Supplemental sheets in form of lists, sketches or drawings may be used provided (1) size is 8-1/2" x 11", (2) information in items 1, 2 and 5 on this data report is included on each sheet, and (3) each sheet is numbered and number of sheets is recorded at top of this form.

## FORM NPV-1 (Back)

Mark No.	Material Spec. No.	Manufacturer	Remarks
(c) Bolting			
Studs	SA 193, GR. B7	Jos. Dyson & Sons	HT # 8088146 Code C99B
Nuts	SA 194, GR. 2H	Jos. Dyson & Sons	HT # L04394 Code A94
(d) Other Parts			
*Pipes (2" sch-160)	SA 106, GR. B	Braman Dow (U.S. Steel)	HT # L20864
*Pipe (1" sch-160)	SA 106, GR. B	Braman Dow (Leland Tube)	HT # M91512
*45° Elbow	SA 105	Braman Dow (Vogt Mach.)	HT # L00281
<b>* NOTE: These parts comply with the Code for Material Construction and Workmanship, but are not included in design.</b>			

9. Hydrostatic test shell 2250 psi.  
Disc. 1500

## CERTIFICATE OF COMPLIANCE

We certify that the statements made in this report are correct and that this pump, or valve, conforms to the rules of construction of the ASME Code for Nuclear Power Plant Components. Section III, Div. I, Edition 1971,  
Addenda Winter, 1972, Code Case No. N/A. Date N/A  
(Date)  
Signed Atwood & Morrill Co., Inc. by Walter F. Emerson (C.C. Mgr. 25Jan78)  
(Manufacturer)  
Our ASME Certificate of Authorization No. N1766 to use the N symbol expires 5-20-80  
(N) (NFV) (Date)

## CERTIFICATION OF DESIGN

Design information on file at Mill Power Supply Co., Charlotte, No. Carolina  
Stress analysis report (Class 1 only) on file at N/A

Design specifications certified by (1) R.E. Miller

PE State No. Carolina Reg. No. 4237

Stress analysis certified by (1) N/A

PE State N/A Reg. No. N/A

(1) Signature not required. List name only.

## CERTIFICATE OF SHOP INSPECTION

I, the undersigned, holding a valid commission issued by the National Board of Boiler and Pressure Vessel Inspectors and the State or Province of Massachusetts and employed by H.S.B.I. & I. Co. of Hartford, Conn. have inspected the pump, or valve, described in this Data Report on Jan. 26, 1978, and state that to the best of my knowledge and belief, the Manufacturer has constructed this pump, or valve, in accordance with the ASME Code, Section III.

By signing this certificate, neither the Inspector nor his employer makes any warranty, expressed or implied, concerning the equipment described in this Data Report. Furthermore, neither the Inspector nor his employer shall be liable in any manner for any personal injury or property damage or a loss of any kind arising from or connected with this inspection.

Date Jan. 26, 1978

Jay Dore  
(Inspector)

Commissions Mass. 1196  
(Nat'l Bd., State, Prov. and No.)

**FORM NPV-1 MANUFACTURERS' DATA REPORT FOR NUCLEAR PUMPS OR VALVES\***  
**(As Required by the Provisions of the ASME Code, Section III, Div. 1)**

1. Manufactured by	Atwood & Merrill Co., Inc., Salem, Mass. (Name and Address of Manufacturer)					
2. Manufactured for	Mill Power Supply Co., Charlotte, No. Carolina (Name and Address of Purchaser or Owner)					
3. Location of Installation	Catawba Nuclear Station, Newport, So. Carolina (Name and Address)					
4. Pump or Valve	Valve	Nominal Inlet Size	34"	Outlet Size	34"	(inch)
(a) Model No.	(b) Manufacturers'	(c) Canadian				
Series No.	Serial No.	Registration No.	(d) Drawing No.	(e) Class:	(f) Nat'l. Bd. No.	(g) Year Built
(1) 34" Main Steam Isolation Valve	1-13000	N/A	13000-01-H	2	N/A	1977
(3)			Rev. 10			
(4)						
(5)						
(6)						
(7)						
(8)						
(9)						
(10)						

## 5. For Service in Main Steam Piping System

(Brief description of service for which equipment was designed)

6. Design Conditions 1185 psi 600 °F or Valve Pressure Class (1)  
(Pressure) (Temperature)

7. Cold Working Pressure 1500 psi at 100°F.

## 8. Pressure Retaining Pieces

Mark No.	Material Spec. No.	Manufacturer	Remarks
<b>(a) Castings</b>			
Body	SA216, Gr. WCB	Atwood & Merrill Ltd. S/N 1-13000	
Ht. #103			
RT #16674C-001			
RT #J1718			
<b>(b) forgings</b>			
Cover	SA105	Cann & Saul	S/N 7-13000
Ht. #216077			
Poppet	SA105	Cann & Saul	S/N 2-13000
Ht. #216077			
Pilot Poppet	SA182, Gr. F6	Cann & Saul	S/N 4-13000
Ht. #72613			

(1) For manually operated valves only.

\* Supplemental sheets in form of lists, sketches or drawings may be used provided (1) size is 8-1/2" x 11", (2) information in Items 1, 2 and 5 on this data report is included on each sheet, and (3) each sheet is numbered and number of sheets is recorded at top of this form.

## FORM NPV-1 (Back)

Mark No.	Material Spec. No.	Manufacturer	Remarks
<b>(c) Bolting</b>			
Studs	SA193, Gr. B7	Jos. Dyson & Sons	Ht. #8088146 Code C99B
Nuts	SA194, Gr. 2H	Jos. Dyson & Sons	Ht. #L04394 Code A94
<b>(d) Other Parts</b>			
*	Pipes (2" Sch. 160) SA106, Gr. B	Braman Dow (U.S. Steel)	Ht. #L20864
*	Pipe (4" Sch. 160) SA106, Gr. B	Braman Dow (Leland Tube)	Ht. #M91512
*	45° Elbow SA105	Braman Dow (Vogt Mach.)	Ht. #L00281
* Note: These parts comply with the Code for material construction and workmanship, but are not included in design.			

9. Hydrostatic test Shell 2250 psi.  
Disc 1500

## CERTIFICATE OF COMPLIANCE

We certify that the statements made in this report are correct and that this pump, or valve, conforms to the rules of construction of the ASME Code for Nuclear Power Plant Components. Section III, Div. I., Edition 1971, Addenda Winter 1972, Code Case No. N/A, Date N/A  
 (Date)  
 Signed Atwood & Morrill Co., Inc. by Walter F. Emerson QC Mgr. 19 Dec 77  
 (Manufacturer)  
 Our ASME Certificate of Authorization No. N1766 to use the N symbol expires 5-20-80  
 (N) (NFV) (Date)

## CERTIFICATION OF DESIGN

Design information on file at Mill Power Supply Co., Charlotte, No. Carolina  
 Stress analysis report (Class 1 only) on file at N/A

Design specifications certified by (1) Thomas F. Wyke  
 PE State No. Carolina Reg. No. 4870  
 Stress analysis certified by (1) N/A  
 PE State N/A Reg. No. N/A

(1) Signature not required. List name only.

## CERTIFICATE OF SHOP INSPECTION

I, the undersigned, holding a valid commission issued by the National Board of Boiler and Pressure Vessel Inspectors and the State or Province of Massachusetts and employed by H. S. B. I. & I. Co. of Hartford, Conn. have inspected the pump, or valve, described in this Data Report on Dec. 20<sup>th</sup> 19 77, and state that to the best of my knowledge and belief, the Manufacturer has constructed this pump, or valve, in accordance with the ASME Code, Section III.

By signing this certificate, neither the Inspector nor his employer makes any warranty, expressed or implied, concerning the equipment described in this Data Report. Furthermore, neither the Inspector nor his employer shall be liable in any manner for any personal injury or property damage or a loss of any kind arising from or connected with this inspection.

Date Dec 20<sup>th</sup> 19 77

*M. L. Lewis*  
(Inspector)

Commissions Mass 1196  
(Nat'l Bd., State, Prov. and No.)

**FORM NPV-1 MANUFACTURER'S DATA REPORT FOR NUCLEAR PUMPS OR VALVES\***  
**(As Required by the Provisions of the ASME Code, Section III, Div. 1)**

1. Manufactured by Atwood & Morril Co., Inc., Salem, MA  
 (Name and Address of Manufacturer)

2. Manufactured for Hill Power Supply Co., Charlotte, No. Carolina  
 (Name and Address of Purchaser or Owner)

3. Location of Installation Catawba Nuclear Station, Newport, So. Carolina  
 (Name and Address)

4. Pump or Valve Valve Nominal Inlet Size 34" Outlet Size 34"  
 (inch)

(a) Model No. Series No. or Type	(b) Manufacturers' Serial No.	(c) Canadian Registration No.	(d) Drawing No.	(e) Class	(f) Nat'l. Bd. No.	(g) Year Built
(1) 34" Main Steam	7-13001	N/A	13000-01-H	2	N/A	1978
(3) Isolation valve			Rev. 11			
(4)						
(5)						
(6)						
(7)						
(8)						
(9)						
(10)						

5. For service in Main Steam Piping System

(Brief description of service for which equipment was designed)

6. Design Conditions 1185 psi 600 °F or Valve Pressure Class \_\_\_\_\_ (1)  
 (Pressure) (Temperature)

7. Cold Working Pressure 1500 psi at 100°F.

8. Pressure Retaining Pieces

Mark No.	Material Spec. No.	Manufacturer	Remarks
(a) Castings			
Body	SA216, GR. WCB	Atwood & Morril Ltd	S/N7-13000
HT # 127			
AT # J1435			
(b) Forgings			
Cover	SA105	Cann & Saul	S/N4-13000
HT # 216077			
Poppet	SA105	Cann & Saul	S/N7-13000
HT # 216077			
Pilot Poppet	SA182, GR. F6	Cann & Saul	S/N7-13000
HT # 834549			

(1) For manually operated valves only.

\* Supplemental sheets in form of lists, sketches or drawings may be used provided (1) size is 8-1/2" x 11", (2) information in items 1, 2 and 5 on this data report is included on each sheet, and (3) each sheet is numbered and number of sheets is recorded at top of this form.

Mark No.	Material Spec. No.	Manufacturer	Remarks
(c) Bolting			
Studs	SA193, GR. B7	Jos. Dyson & Sons	HT#8088146 Code C99B
Nuts	SA194, GR. 2H	Jos. Dyson & Sons	HT#L04394 Code A94
(d) Other Parts			
* Pipes (2" sch-160)	SA106, GR. B	Braman Dow (U.S. Steel)	HT #L20864
* Pipe (1" sch-160)	SA106, GR. B	Braman Dow (Leland Tube)	HT #M91512
* 45° Elbow	SA105	Braman Dow (Vogt Mach)	HT #L00281
* NOTE: These parts comply with the code for material construction and workmanship, but are not included in design.			

9. Hydrostatic test shell 2250 psi.  
disc 1500

#### CERTIFICATE OF COMPLIANCE

We certify that the statements made in this report are correct and that this pump, or valve, conforms to the rules of construction of the ASME Code for Nuclear Power Plant Components. Section III, Div. I, Edition 1971, Addenda Winter 1972, Code Case No. N/A. Date N/A  
 (Date)  
 Signed Atwood & Morril Co., Inc. by Walter F. Emerson QC Mgr 28 Feb 78  
 (Manufacturer)  
 Our ASME Certificate of Authorization No. N1766 to use the N symbol expires 5/20/80.  
 (N) (NFV) (Date)

#### CERTIFICATION OF DESIGN

Design information on file at Mill Power Supply Co., Charlotte, No. Carolina  
 Stress analysis report (Class 1 only) on file at N/A

Design specifications certified by (1) R.E. Miller

PE State So. Carolina Reg. No. 4237

Stress analysis certified by (1) N/A

PE State N/A Reg. No. N/A

(1) Signature not required. List name only.

#### CERTIFICATE OF SHOP INSPECTION

I, the undersigned, holding a valid commission issued by the National Board of Boiler and Pressure Vessel Inspectors and the State or Province of Massachusetts and employed by H.S.B.I. & I. Co. of Hartford, Conn. have inspected the pump, or valve, described in this Data Report on Feb. 28<sup>th</sup> 1978 and state that to the best of my knowledge and belief, the Manufacturer has constructed this pump, or valve, in accordance with the ASME Code, Section III.

By signing this certificate, neither the Inspector nor his employer makes any warranty, expressed or implied, concerning the equipment described in this Data Report. Furthermore, neither the Inspector nor his employer shall be liable in any manner for any personal injury or property damage or a loss of any kind arising from or connected with this inspection.

Date Feb. 28<sup>th</sup> 1978

Y. Price  
(Inspector)

Commissions Mass. 1196  
(Nat'l Bd., State, Prov. and No.)

## FORM NPV-1 MANUFACTURERS' DATA REPORT FOR NUCLEAR PUMPS OR VALVES\*

As Required by the Provisions of the ASME Code Rules

## Nuclear Valve Division

1. Manufactured by of Borg Warner, 7500 Tyrone Ave., Van Nuys, CA Order No. 46763  
(Name & Address of Manufacturer)

## Mill Power Supply/Duke Power Company

2. Manufactured for P.O. Box 1339, Charlotte, North Carolina Order No. C 23593  
(Name and Address)3. Owner Catawba Nuclear Station4. Location of Plant Newport, South Carolina 287105. Pump or Valve Identification NVD P/N 74040, 18 Inch Feedwater Isolation Valve, CS, 900#Serial Number 31311 (1 Valve)

(Brief description of service for which equipment was designed)

(a) Drawing No. 74040 Prepared by Nuclear Valve Division of Borg Warner(b) National Board No. 10656. Design Conditions 1385 psi 600 °F  
(Pressure) (Temperature)7. The material, design, construction, and workmanship complies with ASME Code Section III, Class 2Edition 1974, Addenda Date Winter '74, Case No. N/A

Mark No.	Material Spec. No.	Manufacturer	Remarks
<b>(a) Castings</b>			
<u>Gate-Code 2P83</u>	<u>SA351 CF8M</u>	<u>Pacific Metals</u>	
<b>(b) forgings</b>			
<u>Body-Code 1Q22</u>	<u>SA105</u>	<u>Gulf Forge</u>	
<u>Bonnet-Code 1Q20</u>	<u>SA105</u>	<u>Compton Forge</u>	
<u>Neck-Code 1R36</u>	<u>SA105</u>	<u>Compton Forge</u>	
<u>Retsainer-Code 1R44</u>	<u>SA105</u>	<u>Gulf Forge</u>	

\*Supplemental sheets in form of lists, sketches or drawings may be used provided (1) size is 8½" x 11", (2) information in items 1, 2, 5a and 5b on this data report is included on each sheet, and (3) each sheet is numbered and number of sheets is recorded at top of this form.

FORM NPY-1 (back)

8. Hydrostatic test 3250 psi.

**CERTIFICATION OF DESIGN**

Design information as filed at NVD of Borg Warner, 7500 Tyrone Ave., Van Nuys, CA 91409

Design information on file at \_\_\_\_\_  
Source analysis report on file at \_\_\_\_\_ N/A

Stress analysis report on file at  
Thomas F. Wyke (1) Prof. Eng. State N. C. Reg. No. 4870

Design specifications certified by \_\_\_\_\_ N/A (1) Prof. Eng. State \_\_\_\_\_ Reg. No. \_\_\_\_\_

(1) Signatures are required. List name only.

(1) Signature not required. List name only.

We certify that the statements made in this report are correct.  
Nucleonics, Inc.

## Nuclear Valve Division

Date August 17 19 78 Signed of Borg Warner By J. F. Johnson

Certificate of Authorization No. N-1254 expires October 27, 1978

**CERTIFICATE OF SHOP INSPECTION**

I, the undersigned, holding a valid commission issued by the National Board of Boiler and Pressure Vessel Inspectors and/or the State of Province of California and employed by Lumbermen's Mutual Casualty Company, have inspected the equipment described in this Data Sheet.

of Long Grove, Ill. have inspected the equipment described in this Data Report on August 17 1978, and state that to the best of my knowledge and belief, the Manufacturer

By signing this certificate, neither the Inspector nor his employer makes any warranty, expressed or implied, concerning the equipment described in this Data Report. Furthermore, neither the Inspector nor his employer shall be liable in any manner for any personal injury or property damage or a loss of any kind arising from or connected with this inspection.

Date August 17 1978

R. D. Johnson  
(Inspector)

Commissions CA 1406 ND 8026  
(National Board, State, Province and No.)

ZCF60

**FORM NPV-1 MANUFACTURERS' DATA REPORT FOR NUCLEAR PUMPS OR VALVES\***  
**(As Required by the Provisions of the ASME Code, Section III, Div. 1)**

- |                                      |  |                    |                  |                 |           |                    |
|--------------------------------------|--|--------------------|------------------|-----------------|-----------|--------------------|
| 1. Manufactured by                   | Nuclear Valve Div. of Borg Warner, 7500 Tyrone Ave., Van Nuys, Ca.<br>(Name and Address of Manufacturer)     |                    |                  |                 |           |                    |
| 2. Manufactured for                  | Mill Power Supply/Duke Power Co., P.O. Box 1339, Charlotte, N.C.<br>(Name and Address of Purchaser or Owner) |                    |                  |                 |           |                    |
| 3. Location of Installation          | Catowbe Nuclear Station, Newport, South Carolina 28710<br>(Name and Address)                                 |                    |                  |                 |           |                    |
| 4. Pump or Valve FeedWater Isolation | Nominal Inlet Size   | 18                 |                  | Outlet Size     | 18        |                    |
|                                      | (a) Model No..   | (b) Manufacturers' | (c) Canadian     |                 |           |                    |
|                                      | Series No.   | Serial No.         | Registration No. | (d) Drawing No. | (e) Class | (f) Nat'l. Bd. No. |
|                                      | or Type  | No.                | No.              |                 |           | (g) Year Built     |
| (1)                                  | 900#   | 31315              | N/A              | 74040           | 2         | 1131 1978          |
| (3)                                  | Motor On.  |                    |                  |                 |           |                    |
| (4)                                  |  |                    |                  |                 |           |                    |
| (5)                                  |  |                    |                  |                 |           |                    |
| (6)                                  |  |                    |                  |                 |           |                    |
| (7)                                  |  |                    |                  |                 |           |                    |
| (8)                                  |  |                    |                  |                 |           |                    |
| (9)                                  |  |                    |                  |                 |           |                    |
| (10)                                 |  |                    |                  |                 |           |                    |

5. The valves are designed to handle a fluid media which includes steam, water condensate, borated water, etc., associated with a PWR and BWR. The temperature pressure rating of the media is stated below.

6. Design Conditions 1385 (Pressure) psi 600 (Temperature) °F or Valve Pressure Class N/A (1)  
7. Cold Working Pressure N/A psi at 100°F.  
8. Pressure Retaining Pieces

(1) For manually operated valves only.

- \* Supplemental sheets in form of lists, sketches or drawings may be used provided (1) size is 8-1/2" x 11", (2) information in items 1, 2 and 5 on this data report is included on each sheet, and (3) each sheet is numbered and number of sheets is recorded at top of this form.

FORM NPY-1 (Back)

Mark No.	Material Spec. No.	Manufacturer	Remarks
(c) Bolting	N/A		
(d) Other Parts	N/A		

8. Hydrostatic test 3250 psi.

**CERTIFICATE OF COMPLIANCE**

We certify that the statements made in this report are correct and that this pump, or valve, conforms to the rules of construction of the ASME Code for Nuclear Power Plant Components. Section III, Div. I., Edition 1974.  
Addenda Winter '74, Code Case No. N/A, Date N/A  
(Date)  
Signed Nuclear Valve Div. of Borg-Warner by Josephine Stinson  
(Manufacturer)  
Our ASME Certificate of Authorization No. N1254 to use the N symbol expires 10/27/78  
(IN) (INVF)  
(Date)

## CERTIFICATION OF DESIGN

Design information on file at Nuclear Valve Div. of Borg-Warner, 7500 Tyrone Av., V.N. Ca.  
Stress analysis report (Class 1 only) on file at N/A

Thomas F. Wyke

Design specifications certified by (1) \_\_\_\_\_  
REG. NO. N.C. Reg. No. 4870

Stress analysis certified by (1) \_\_\_\_\_ N/A

PE State \_\_\_\_\_ Reg. No. \_\_\_\_\_

(1) Signature not required. List name only.

**CERTIFICATE OF SHOP INSPECTION**

I, the undersigned, holding a valid commission issued by the National Board of Boiler and Pressure Vessel Inspectors and the State or Province of California and employed by Lumbermen's Mutual Casualty of Long Grove, Ill., have inspected the pump, or valve, described in this Data Report on September 7 1978, and state that to the best of my knowledge and belief, the Manufacturer has constructed this pump, or valve, in accordance with the ASME Code, Section III.

By signing this certificate, neither the Inspector nor his employer makes any warranty, expressed or implied, concerning the equipment described in this Data Report. Furthermore, neither the Inspector nor his employer shall be liable in any manner for any personal injury or property damage or a loss of any kind arising from or connected with this inspection.

Date September 7

100

Commissions NSEE 26 CA 1406  
(Nat'l Bd., State, Prov. and No.)

|CF5|

**FORM NPV-1 MANUFACTURERS' DATA REPORT FOR NUCLEAR PUMPS OR VALVES\***

As Required by the Provisions of the ASME Code Rules

### Nuclear Valve Division

1. Manufactured by Borg Warner, 7500 Tyrone Ave., Van Nuys, CA Order No. 46763  
(Name & Address of Manufacturer)

Mill Power Supply/Duke Power Company

2. Manufactured for P.O. Box 1339, Charlotte, North Carolina Order No. C23593  
(Name and Address)

3. Owner: Catawba Nuclear Station

4. Location of Plant Newport, South Carolina 28710

5. Pump or Valve Identification NVD P/N 74040, 18 Inch Feedwater Isolation Valve, CS. 900#

Serial Number 31310 (1 Valve)

(Brief description of service for which equipment was designed)

- (a) Drawing No. 74040 Executed by Nuclear Valve Division of Borg-Warner

- (b) National Board No. 1060

6. Design Conditions 1385 psi 600 °F  
(Pressure) (Temperature)

7. The material, design, construction, and workmanship complies with ASME Code Section III, Class 1

- Edition 1971 Addenda Date Summer '73 Case No. N/A

**\*Supplemental sheets in form of lists, sketches or drawings may be used provided (1) size is 8½" x 11", (2) information in items 1, 2, 5a and 5b on this data report is included on each sheet, and (3) each sheet is numbered and number of sheets is recorded at top of this form.**

## FORM NPV-1 (back)

Mark No.	Material Spec. No.	Manufacturer	Remarks
(c) Bolting N/A			
(d) Other Parts N/A			

8. Hydrostatic test 3250 psi.

## CERTIFICATION OF DESIGN

Design information on file at NVD of Borg Warner, 7500 Tyrone Ave., Van Nuys, CA 91409

Stress analysis report on file at N/A


Design specifications certified by Thomas F. Wyke (1) Prof. Eng. State N.C. Reg. No. 4870

Stress analysis report certified by N/A (1) Prof. Eng. State \_\_\_\_\_ Reg. No. \_\_\_\_\_

(1) Signature not required. List name only.

We certify that the statements made in this report are correct.

Nuclear Valve Division

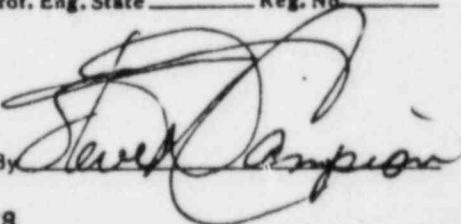Date August 9 19 78 Signed of Borg Warner By 

Certificate of Authorization No. N-1254 expires October 27, 1978.


## CERTIFICATE OF SHOP INSPECTION

I, the undersigned, holding a valid commission issued by the National Board of Boiler and Pressure Vessel Inspectors and/or the State of Province of California and employed by Lumbermen's Mutual Casualty of Long Grove, Ill., have inspected the equipment described in this Data Report on

Report on August 9 19 78, and state that to the best of my knowledge and belief, the Manufacturer has constructed this equipment in accordance with the applicable Subsections of ASME Code, Section III.

By signing this certificate, neither the Inspector nor his employer makes any warranty, expressed or implied, concerning the equipment described in this Data Report. Furthermore, neither the Inspector nor his employer shall be liable in any manner for any personal injury or property damage or a loss of any kind arising from or connected with this inspection.

Date August 9 19 78

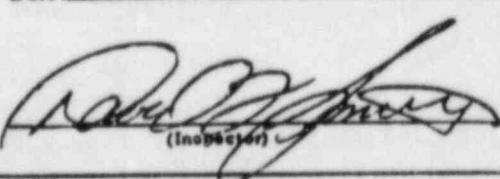  
(Inspector)Commission # 468026 041406  
(National Board, State, Province and No.)

**FORM NPV-1 MANUFACTURERS' DATA REPORT FOR NUCLEAR PUMPS OR VALVES\***

As Required by the Provisions of the ASME Code Rules

## Nuclear Valve Division

1. Manufactured by Borg Warner, 7500 Tyrone Ave., Von Nuys, Ca. Order No. 46763  
(Name & Address of Manufacturer)2. Manufactured for Mill Power Supply/Duke Power Company  
P.O. Box 1339, Charlotte, North Carolina Order No. C23593  
(Name and Address)3. Owner Catawba Nuclear Station4. Location of Plant Newport, South Carolina 287105. Pump or Valve Identification NVD P/N 14040, 18 Inch Feedwater Isolation Valve, CS, 900#Serial Number 31310 (1 Valve)(Brief description of service for which equipment was designed)(a) Drawing No. 74040 Prepared by Nuclear Valve Division of Borg Warner(b) National Board No. 10606. Design Conditions 1385 (Pressure) psi 600 (Temperature) °F7. The material, design, construction, and workmanship complies with ASME Code Section III, Class 2Edition 1974, Addenda Date Winter '74, Case No. N/A

\*7. Original NPV-1 Dated and Signed August 9, 1978 listed  
the incorrect Addenda Date.

The items described in #5 were designed and manufactured  
to the correct Addenda Date listed on this Attachment #1.

## FORM NPV-1 (back)

Mark No.	Material Spec. No.	Manufacturer	Remarks
(c) Bolting N/A			
(d) Other Parts N/A			

8. Hydrostatic test 3250 psi.

## CERTIFICATION OF DESIGN

Design information on file at NVD of Borg Warner, 7500 Tyrone Ave., Van Nuys, Ca. 91409

Stress analysis report on file at N/A

Design specifications certified by Thomas F. Wyke (1) Prof. Eng. State N.C Reg. No. 4870

Stress analysis report certified by N/A (1) Prof. Eng. State \_\_\_\_\_ Reg. No. \_\_\_\_\_

(1) Signature not required. List name only.

We certify that the statements made in this report are correct.  
Nuclear Valve DivisionDate August 25 19 78 Signed of Borg Warner By   
(Manufacturer)

Certificate of Authorization No. N-1254 expires October 27, 1978


## CERTIFICATE OF SHOP INSPECTION

I, the undersigned, holding a valid commission issued by the National Board of Boiler and Pressure Vessel Inspectors and/or the State or Province of California and employed by Lumbermen's Mutual Casualty of Long Grove, Ill., have inspected the equipment described in this Data Report on August 25 19 78

Report on August 25 19 78, and state that to the best of my knowledge and belief, the Manufacturer has constructed this equipment in accordance with the applicable Subsections of ASME Code, Section III.

By signing this certificate, neither the Inspector nor his employer makes any warranty, expressed or implied, concerning the equipment described in this Data Report. Furthermore, neither the Inspector nor his employer shall be liable in any manner for any personal injury or property damage or a loss of any kind arising from or connected with this inspection.

Date August 25 19 78

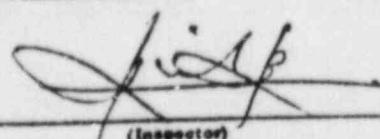Commissions D75 CA . 7669 NB  
(National Board, State, Province and No.)

2CF51

**FORM NPV-1 MANUFACTURERS' DATA REPORT FOR NUCLEAR PUMPS OR VALVES\***  
**(As Required by the Provisions of the ASME Code, Section III, Div. 1)**

1. Manufactured by Nuclear Valve Div. of Borg Warner, 7500 Tyrone Ave., Van Nuys, Ca.  
(Name and Address of Manufacturer)
2. Manufactured for Mill Power Supply/Duke Power Co., P.O. Box 1339, Charlotte, N.C.  
(Name and Address of Purchaser or Owner)
3. Location of Installation Catawba Nuclear Station, Newport, South Carolina 28710  
(Name and Address)
4. Pump or Valve FeedWater Isolation Nominal Inlet Size 18  
(inch) Outlet Size 18

(a) Model No.	(b) Manufacturers'	(c) Canadian	(d) Drawing	(f) Nat'l.	(g) Year
Series No.	Serial No.	Registration No.	No.	Class	Bd. No.
or Type					Built

(1) 900# Motor Op.	31314	N/A	74040	2	1130	1978
(3)						
(4)						
(5)						
(6)						
(7)						
(8)						
(9)						
(10)						

5. The valves are designed to handle a fluid media which includes steam, water condensate, borated water, etc., associated with a PWR and BWR. The temperature pressure rating of the media is stated below.  
(Brief description of service for which equipment was designed)

6. Design Conditions 1385 psi 600 °F or Valve Pressure Class N/A (1)  
(Pressure) (Temperature)

7. Cold Working Pressure N/A psi at 100°F.

8. Pressure Retaining Pieces

Mark No.	Material Spec. No.	Manufacturer	Remarks
<b>(a) Castings</b>			
Gate-Code 2P85	SA 351 CF8M	Pacific Metals	
<b>(b) forgings</b>			
Body-Code 1Q22	SA 105	Gulf Forge	
Bonnet-Code 1Q20	SA 105	Compton Forge	
Neck-Code 1R36	SA 105	Compton Forge	
Retainer-Code 2W93A	SA 105	Jorgensen Steel	

(1) For manually operated valves only.

\* Supplemental sheets in form of lists, sketches or drawings may be used provided (1) size is 8-1/2" x 11", (2) information in items 1, 2 and 5 on this data report is included on each sheet, and (3) each sheet is numbered and number of sheets is recorded at top of this form.

Mark No.	Material Spec. No.	Manufacturer	Remarks
(c) Bolting N/A			
(d) Other Parts N/A			

9. Hydrostatic test 3250 psi.

**CERTIFICATE OF COMPLIANCE**

We certify that the statements made in this report are correct and that this pump, or valve, conforms to the rules of construction of the ASME Code for Nuclear Power Plant Components. Section III, Div. I., Edition 1974,  
Addenda Winter '74, Code Case No. N/A, Data N/A.

Addenda Winter 74, Code Case No. N/A, Date 10/27/78  
(Date)  
Signed Nuclear Valve Div. of Borg-Warner by James Stinson  
(Manufacturer)  
Our ASME Certificate of Authorization No. N1254 to use the N symbol expires 10/27/78  
(IN) (INEV) (Date)

**CERTIFICATION OF DESIGN**

Design information on file at Nuclear Valve Div. of Borg-Warner, 7500 Tyrone Av., V.N. Ca  
Storage and use report (Class 1 only) on file at N/A

Reviewers' Services and Test by (1) Thomas F. Wyke

Design specifications certified by (1) \_\_\_\_\_  
PC-Sign N.C. Reg. No. 4870

PE State \_\_\_\_\_ Reg. No. \_\_\_\_\_  
Power mechanism certified by (1) \_\_\_\_\_ N/A

Stress analysis certified by (1) \_\_\_\_\_  
PC Name \_\_\_\_\_ Reg. No. \_\_\_\_\_

REVIEWED

(1) Signature not required. List name only.

**CERTIFICATE OF SHOP INSPECTION**

I, the undersigned, holding a valid commission issued by the National Board of Boiler and Pressure Vessel Inspectors and the State or Province of California and employed by Lumbermen's Mutual Casualty of Long Grove, Ill., have inspected the pump, or valve, described in this Data Report on September 6 1978, and state that to the best of my knowledge and belief, the Manufacturer has constructed this pump, or valve, in accordance with the ASME Code, Section III.

By signing this certificate, neither the Inspector nor his employer makes any warranty, expressed or implied, concerning the equipment described in this Data Report. Furthermore, neither the Inspector nor his employer shall be liable in any manner for any personal injury or property damage or a loss of any kind arising from or connected with this inspection.

Date September 6 1978  
Arrell J. Price  
(Inspector)

Commissioner #S 8026 CA1406  
(Nat'l Bd., State, Prov. and No.)

ZCF42

**FORM NPV-1 MANUFACTURERS' DATA REPORT FOR NUCLEAR PUMPS OR VALVES\***  
**(As Required by the Provisions of the ASME Code, Section III, Div. 1)**

1. Manufactured by Nuclear Valve Div. of Borg Warner, 7500 Tyrone Ave., Van Nuys, Ca.  
(Name and Address of Manufacturer)  
2. Manufactured for Mill Power Supply/Duke Power Co., P.O. Box 1339, Charlotte, N.C.  
(Name and Address of Purchaser or Owner)  
3. Location of Installation Catawba Nuclear Station, Newport, South Carolina 28710  
(Name and Address)

4. Pump or Valve FeedWater Isolation Nominal Inlet Size 18  
(inch) Outlet Size 18

(a) Model No..	(b) Manufacturers' Series No.	(c) Canadian Registration No.	(d) Drawing No.	(e) Class	(f) Nat'l. Bd. No.	(g) Year Built
(1) 900#	31313	N/A	74040	2	1129	1978
(3) Motor Op.						
(4)						
(5)						
(6)						
(7)						
(8)						
(9)						
(10)						

5. The valves are designed to handle a fluid media which includes steam, water condensate, borated water, etc., associated with a PWR and BWR. The temperature pressure rating of the media is stated below.

6. Design Conditions 1385 (Pressure) psi 600 (Temperature) °F or Valve Pressure Class N/A (1)

7. Cold Working Pressure N/A psi at 100°F.

### **8. Pressure Retaining Pieces**

(1) For manually operated valves only.

\* Supplemental sheets in form of lists, sketches or drawings may be used provided (1) size is 8-1/2" x 11", (2) information in items 1, 2 and 5 on this data report is included on each sheet, and (3) each sheet is numbered and number of sheets is recorded at top of this form.

## FORM NPV-1 (Back)

Mark No.	Material Spec. No.	Manufacturer	Remarks
(c) Bolting N/A			
(d) Other Parts N/A			

8. Hydrostatic test 3250 psi.

## CERTIFICATE OF COMPLIANCE

We certify that the statements made in this report are correct and that this pump, or valve, conforms to the rules of construction of the ASME Code for Nuclear Power Plant Components. Section III, Div. I, Edition 1974, Addenda Winter '74, Code Case No. N/A, Date N/A  
 Signed Nuclear Valve Div. of Borg-Warner by *James Stawicki*  
 (Manufacturer) Our ASME Certificate of Authorization No. N1254 to use the N symbol expires 10/27/78  
 (IN) (NFS) (Date)

## CERTIFICATION OF DESIGN

Design Information on file at Nuclear Valve Div. of Borg-Warner, 7500 Tyrone Av., V.N., Ca.  
 Stress analysis report (Class 1 only) on file at N/A

Design specifications certified by (1) Thomas F. Wyke

PE State N.C. Reg. No. 4870

Stress analysis certified by (1) N/A

PE State \_\_\_\_\_ Reg. No. \_\_\_\_\_

(1) Signature not required. List name only.

## CERTIFICATE OF SHOP INSPECTION

I, the undersigned, holding a valid commission issued by the National Board of Boiler and Pressure Vessel Inspectors and the State or Province of California and employed by Lumbermen's Mutual Casualty of Long Grove, Ill., have inspected the pump, or valve, described in this Data Report on September 7 19 78, and state that to the best of my knowledge and belief, the Manufacturer has constructed this pump, or valve, in accordance with the ASME Code, Section III.

By signing this certificate, neither the Inspector nor his employer makes any warranty, expressed or implied, concerning the equipment described in this Data Report. Furthermore, neither the Inspector nor his employer shall be liable in any manner for any personal injury or property damage or a loss of any kind arising from or connected with this inspection.

Date September 7 19 78

*John J. Jones*  
 Inspector

Commissions N.B. No. 26 C.A.Y.O.C. (Nat'l Bd., State, Prov. and No.)

(CF42

FORM NPV-1 MANUFACTURERS' DATA REPORT FOR NUCLEAR PUMPS OR VALVES\*

As Required by the Provisions of the ASME Code Rules

Nuclear Valve Division

1. Manufactured by Borg Warner, 7500 Tyrone Ave., Van Nuys, CA Order No. 46763  
(Name & Address of Manufacturer)

Mill Power Supply/Duke Power Company  
2. Manufactured for P.O. Box 1339, Charlotte, North Carolina Order No. C-23593  
(Name and Address)

3. Owner Catawba Nuclear Station

4. Location of Plant Newport, South Carolina 28710

5. Pump or Valve Identification NVD P/N 74040, 18 Inch FeedWater Isolation Valve, 900#, CS, MO

Serial Number 31309 (1 Valve)

(Brief description of service for which equipment was designed)

#

(a) Drawing No. 74040 Prepared by Nuclear Valve Division of Borg Warner

(b) National Board No. 1048

6. Design Conditions 1885 psi 600 °F  
(Pressure) (Temperature)

7. The material, design, construction, and workmanship complies with ASME Code Section III, Class 2

Edition 1974, Addenda Date Winter '74, Case No. N/A

Mark No.	Material Spec. No.	Manufacturer	Remarks
(a) Castings			
Gate - Code 2P91	SA 351 CF8M	Chiang & Assoc.	
(b) Forgings			
Body - Code 1Q22	SA 105	Gulf Forge	
Bonnet - Code 1Q20	SA 105	Compton Forge	
Neck - Code 1R36	SA 105	Compton Forge	
Retainer - Code 1R44	SA 105	Gulf Forge	

\*Supplemental sheets in form of lists, sketches or drawings may be used provided (1) size is 8W" x 11", (2) information in items 1, 2, 3a and 3b on this data report is included on each sheet, and (3) each sheet is numbered and number of sheets is recorded at top of this form.

**FORM NIV-1 (back)**

8. Hydrostatic test 3250 psi.

**CERTIFICATION OF DESIGN**

Facsimile information on file w/ NVD of Borg Warner, 7500 Tyrone Ave., Van Nuys, CA 91409

Success analysis report on file at \_\_\_\_\_ N/A

Design specifications certified by Thomas F. Wyke (1) Prof. Eng. State N. C. Reg. No. 4820

Screws analysis report certified by \_\_\_\_\_ N/A \_\_\_\_\_ (I) Prof. Eng. Saste \_\_\_\_\_ Reg. No. \_\_\_\_\_

(1) Signature not required. List name only.

(b) *Suppose that  $\mu$  is a probability measure on  $\mathbb{R}$  such that  $\int_{\mathbb{R}} x \mu(dx) = 0$ . Then  $\mu$  is a symmetric measure.*

We certify that the statements made in this report are correct.

## Nuclear Valve Division

Date August 2 1978 Signed of Borg Warner

Certificate of Authorization No. M-1254 Expires October 27, 1978

**CERTIFICATE OF SHOP INSPECTION**

I, the undersigned, holding a valid commission issued by the National Board of Boiler and Pressure Vessel Inspectors and/or the State or Province of California and employed by Lumbermen's Mutual Casualty of Long Grove, Ill. have inspected the equipment described in this Data

Report as August 2 1978, and state that to the best of my knowledge and belief, the Manufacturer has constructed this equipment in accordance with the applicable Subsections of ASME Code, Section III.

By signing this certificate, neither the Inspector nor his employer makes any warranty, expressed or implied, concerning the equipment described in this Data Report. Furthermore, neither the Inspector nor his employer shall be liable in any manner for any personal injury or property damage or a loss of any kind arising from or connected with this inspection.

Date August 2 1978

**Manuel B. Diaz**

Commissions CA 1275 NB 7669  
(National Board, State, Province and No.)

2CF33

**FORM NPV-1 MANUFACTURERS' DATA REPORT FOR NUCLEAR PUMPS OR VALVES\***

### **As Required by the Provisions of the ASME Code Rules**

## Nuclear Valve Division

- I. Manufactured by Borg Warner, 7500 Tyrone Ave., Van Nuys, CA Order No. 46763  
(Name & Address of Manufacturer)

Mill Power Supply/Duke Power Company

2. Manufactured for P.O. Box 1339, Charlotte, North Carolina Order No. C23593  
(Name and Address)

3. Owner: Catawba Nuclear Station

4. Location of Plant: Newport, South Carolina

5. Pump or Valve Identification NVD P/N 74040, 18 Inch Feedwater Isolation Valve, CS 900#

Serial Number 31312

(Brief description of service for which equipment was designed)

(a) Drawing No. 74040 Prepared by Nuclear Valve Division of Borg Warner

(b) National Board No. 1064



7. The material, design, construction, and workmanship complies with ASME Code Section III, Class 2

Edition 1974, Addenda Date Winter '74, Case No. N/A

\*Supplemental sheets in form of lists, sketches or drawings may be used provided (1) size is 8½" x 11", (2) information in items, 1, 2, 5a and 5b on this data report is included on each sheet, and (3) each sheet is numbered and number of sheets is recorded at top of this form.

## FORM NPV-1 (back)

	Mark No.	Material Spec. No.	Manufacturer	Remarks
(c) Bolting	N/A			
(d) Other Parts	N/A			

8. Hydrostatic test 3250 psi.

## CERTIFICATION OF DESIGN

Design information on file at NVD of Borg Warner, 7500 Tyrone Ave., Van Nuys, CA 91409  
 Stress analysis report on file at N/A

Design specifications certified by Thomas F. Wyke (I) Prof. Eng. State N.C. Reg. No. 4870  
 Stress analysis report certified by N/A (I) Prof. Eng. State \_\_\_\_\_ Reg. No. \_\_\_\_\_

(I) Signature not required. List name only.

We certify that the statements made in this report are correct.

Date August 17 19 78 Signed of Borg Warner By *John Stevens*  
 (Manufacturer)

Certificate of Authorization No. N-1254 expires October 27, 1978

## CERTIFICATE OF SHOP INSPECTION

I, the undersigned, holding a valid commission issued by the National Board of Boiler and Pressure Vessel Inspectors and/or the State or Province of California and employed by Lumbermen's Mutual Casualty of Long Grove, Ill.

Report on August 17 19 78 have inspected the equipment described in this Data Report on August 17 19 78, and state that to the best of my knowledge and belief, the Manufacturer has constructed this equipment in accordance with the applicable Subsections of ASME Code, Section III.

By signing this certificate, neither the Inspector nor his employer makes any warranty, expressed or implied, concerning the equipment described in this Data Report. Furthermore, neither the Inspector nor his employer shall be liable in any manner for any personal injury or property damage or a loss of any kind arising from or connected with this inspection.

Date August 17 19 78

*Robert C. Johnson*  
 (Inspector)

Commission No. 468026 CP 1406  
 (National Board, State, Province and No.)

1cf33

**FORM NPV-1 MANUFACTURERS' DATA REPORT FOR NUCLEAR PUMPS OR VALVES\***

**As Required by the Provisions of the ASME Code Rules**

### Nuclear Valve Division

1. Manufactured by Borg Warner, 7500 Tyrone Ave., Van Nuys, CA Order No. 46763  
(Name & Address of Manufacturer)

Mill Power Supply/Duke Power Company

2. Manufactured for P.O. Box 1339, Charlotte, North Carolina Order No. C-23593  
(Name and Address)

3. Owner Gatwaba Nuclear Station

4. Location of Plant Newport, South Carolina 28710

5. Pump or Valve Identification NVD P/N 74040, 18 Inch FeedWater Isolation Valve, 900#, CS. MO

Serial Number 31308 (1 Valve)

(Brief description of service for which equipment was designed)

- (a) Drawing No. 74040 Prepared by Nuclear Valve Division of Borg Warner  
(b) National Board No. 1047  
6. Design Conditions 1385 psi 600 °F  
(Pressure) (Temperature)  
7. The material, design, construction, and workmanship complies with ASME Code Section III, Class 2  
Edition 1974, Addenda Date Winter '74, Case No. N/A

**\*Supplemental sheets in form of notes, sketches or drawings may be used provided (1) size is 8½" x 11", (2) information in Items 1, 2, 5a and 5b on this data report is included on each sheet, and (3) each sheet is numbered and number of sheets is recorded at top of this form.**

**FORM NIV-I (back)**

8. Hydrostatic test 3250 psi.

## CERTIFICATION OF DESIGN

Design information on file at NVD of Borg Warner, 7500 Tyrone Ave., Van Nuys, CA 91409

Syntax analysis report on file at \_\_\_\_\_ N/A

Design specifications certified by Thomas F. Wyke (1) Prof. Eng. State N.C. Reg. No. 4870

**Stress analysis report certified by** \_\_\_\_\_ **N/A** **(1) Prof. Eng. Sastre** \_\_\_\_\_ **Reg. No.** \_\_\_\_\_

(1) Signature not required. List name only.

We certify that the statements made in this report are correct.

## Nuclear Valve Division

Date August 2 1978 Signed of Borg Warner  
(Manufacturer) By Yvonne Stevens

Certificate of Authorization No. H-1254 expires October 27, 1978

**CERTIFICATE OF SHOP INSPECTION**

I, the undersigned, holding a valid commission issued by the National Board of Boiler and Pressure Vessel Inspectors and/or the State or Province of California and employed by Lumbermen's Mutual Casualty of Long Grove, Ill. have inspected the equipment described in this Data

Report on August 2 19 78, and same due to the best of my knowledge and belief, the Manufacturer has constructed this equipment in accordance with the applicable Subsections of ASME Code, Section III.

By signing this certificate, neither the Inspector nor his employer makes any warranty, expressed or implied, concerning the equipment described in this Data Report. Furthermore, neither the Inspector nor his employer shall be liable in any manner for any personal injury or property damage or a loss of any kind arising from or connected with this inspection.

Date August 2 1978

#### **Commissioners**

CA 1275 NB 7669

(National) Board, State, Province and M.-)

Printed in U.S.A. (8/72)

This form (E-37) is obtainable from the AMER, 345 E. 47th St., New York, N.Y. 10017.

**FORM NPP-1 DATA REPORT FOR FABRICATED NUCLEAR PIPELINE SUBASSEMBLIES\***  
**(As Required by the Provisions of the ASME Code Rules)**

SHEET 1 OF 4

1. Fabricated by ITT Grinnell Ind. Piping, Inc. Kernersville Order No. 7127 4-3-28  
(Name and Address of Fabricator)  
2. Fabricated for Duke Power Company, Charlotte, NC Order No. C-12517  
(Name and Address)  
3. Owner Duke Power Company 4. Location of Plant Newport, SC

8. Piping System Identification MAIN STEAM  
(Brief description of intended use, main coolant etc.)

(a) Drawing No. CT-01-34X Prepared by ITT Grinnell Industrial Piping, Inc.  
(b) National Board No. N/A

6. The material, design, construction, and workmanship complies with ASME Code Section III, Class N-2  
Edition 1974 - Admire Date Winter 1974 Case No. N/A

**Remarks:** Manufacturers' Data Reports properly identified and signed by Commissioned Inspectors have been furnished for the following items of this report \_\_\_\_\_ **N/A** (Name of Part - Item number, Manufacturer's name, and Identifying stamp)

7. Shop Hydrostatic Test Field

8. Description of piping inspected Piece Mark Number CT-SM-4D  
(include - mark no. - material spec. - nom. pipe size - schedule or thickness - length  
- fittings - flanges, etc.)  
See Attached Sheets

We certify that the statements made in this report are correct and that the fabrication of the described piping conforms with the requirements of SECTION III of the ASME BOILER AND PRESSURE VESSEL CODE.

Date 9-12-78 Signed Ind. Piping, Inc. By Thomas A. Smith  
(Fabricator)

Certificate of Authorization Expires 7-16-79 Certificate of Authorization No. N-1456

**CERTIFICATE OF SHOP INSPECTION**

I, the undersigned, holding a valid commission issued by the National Board of Boiler and Pressure Vessel Inspectors and/or the State or Province of N.C. \* and employed by Hartford, CT. have inspected the piping described in this Data Report on 9-15 1978, and state that to the best of my knowledge and belief, the Manufacturer has constructed this piping in accordance with the applicable Subsections of ASME Code, Section III.\* The Hartford Steam Boiler Inspection and Insurance Co. By signing this certificate, neither the Inspector nor his employer make any warranty, expressed or implied, concerning the piping in this Data Report. Furthermore, neither the Inspector nor his employer shall be liable in any manner for any personal injury or property damage or a loss of any kind arising from or connected with this inspection.

Date 9-15 2028  
Barry K. Silvo  
(Inspector)

Commissions N.C. - No. 878  
National Board, State, Province and No.

\*Supplemental sheets in form of lists, sketches or drawings may be used provided (1) size is 8½" x 11", (2) information in Items 1, 2 and 5 on this data report is included on each sheet, and (3) each sheet is numbered and number of sheets is recorded in Item 7, "Remarks".  
Printed in U.S.A. (2/73)

# ITT Grinnell Industrial Piping Inc.

KERNERSVILLE, N.C.

FORM E1010 REV 1/20  
QAL FORM 2020-1C  
Sheet 2 of 4

CONT. NO. 7127

NAME DUKE POWER COMPANY  
LOCATION CATAWBA UNIT #1  
Charlotte, N.C.  
P.O. - C-12517

△ S-780 2-1705 → REDRWN: 4-10-28-77

REV. ① SM, 11-11-77

REV. ② SM, 12-14-77

REV. ③ SM, 5-23-78

REV. ④ SM, 10-20-78

CHK'D PG

CHK'D PG


CHK'D PG

CHK'D PG

SPECIAL MATERIAL  
CHECK ALLOCATION SHEETS  
BEFORE CUTTING

LENGTH OF ACCESS HOLE PLUG SHALL  
BE  $\pm 1/16"$  OF ACTUAL WALL THK.  
SHOP SHALL GRIND TO FIT—IF REQUIRED.

{ USE 3'-10 $\frac{5}{16}$ " FROM BAR #18, LOT # 4121,  
HT. # FL 3117, USE BALANCE FOR ITEM #2.

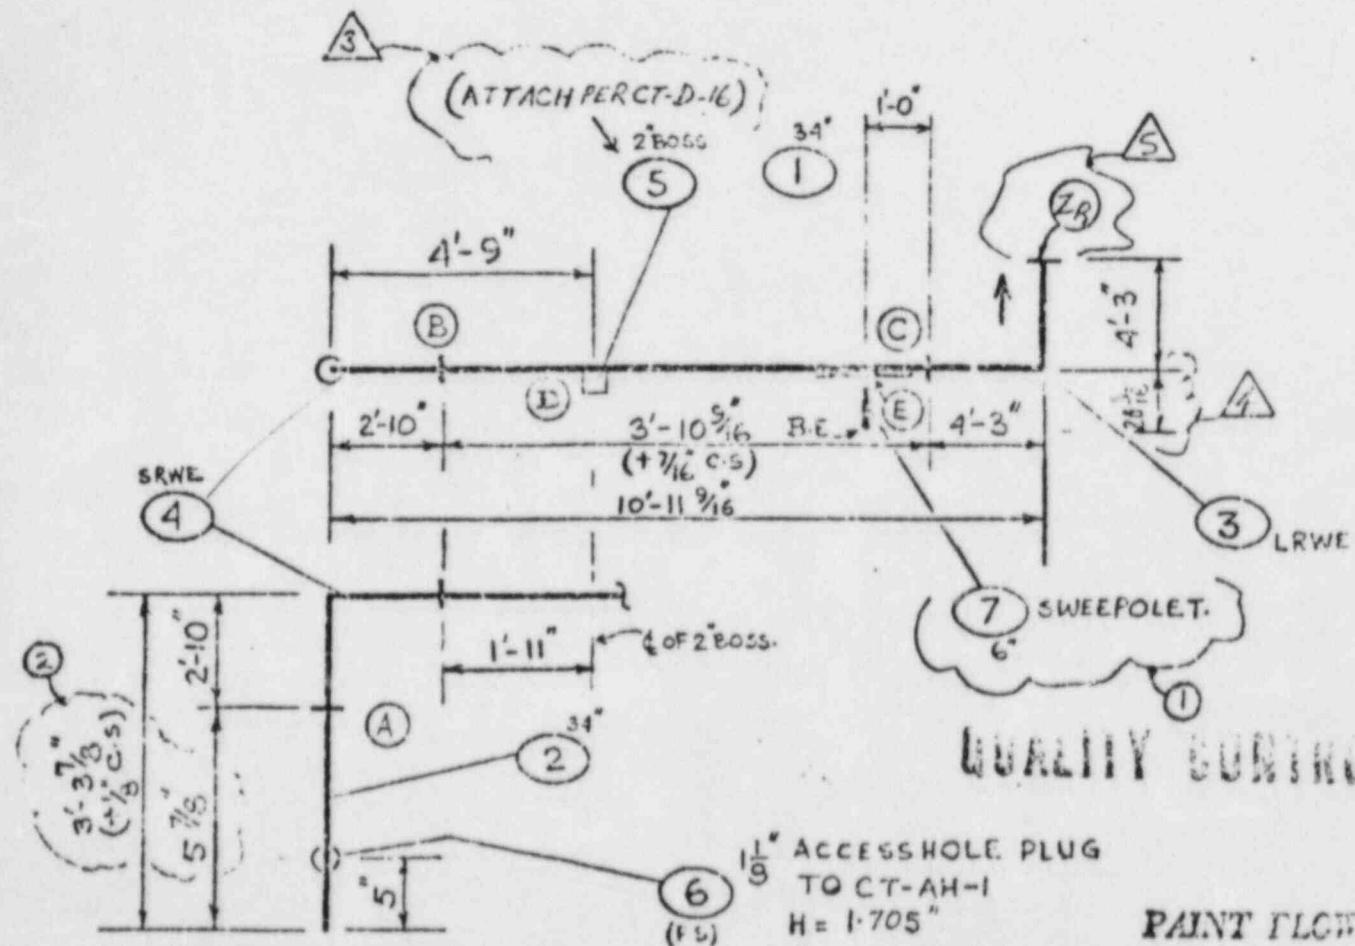

## QUALITY CONTROL

PAINT FLOW ARROWS

## MACHINE ENDS

PER SKETCH CT-D-2, EXCEPT AS NOTED.

## Nuclear Safety Related

CLASS	DUKE B	LINE SPEC. PS 1500-5(01)	APP. CODE A 2a Sec. III CL 2	NO. REQ'D.
radiography (RT)	✓	Special Marking	Preheat	✓
Mag. Particle (MP)	✓	Special Cleaning	Heat Treat	Mill Test Report
Paint (PT)		Painting	Code Stamp	Data Report

SYSTEM MAIN STEAM (SM)

EF. DRWG NO. CN-1500-514004(PM2)

FAB. SPEC'S. JS 118

PRESS. 1185 PSI TEMP. 600° F. WT. 272.8 LBS.

SPEC MARK C.T. SM-4D

④

REGISTER C.T.-01-74X

Register No. CT-01-34X

MATERIALS RECORD  
PRODUCTION PLANNER

Sheet 3 of 24

Revision No. 5M

Revision Date 5/22/77

Piece Mark CT-5M-AD

Job Name CATAWBA UNIT #1  
Charlotte, N.C.

Contract No. 7127

Location

DUKE POWER COMPANY

CATAWBA UNIT #1  
Charlotte, N.C.

P.O. C-12517

DESCRIPTION

QUAN  
OR  
LENGQUALITY CONTROL  
HEAT  
NUMBER DOCUMENT IN PROCESS

STATUS

U/M

UNIT PRICE

P.O.

D.S.

VENDOR

NET

PART NUMBER SYS- MAIN STEAM	DESCRIPTION	QUAN OR LENG	HEAT NUMBER	DOCUMENT IN PROCESS	STATUS	U/M	UNIT PRICE	P.O.	D.S.	VENDOR	NET
F.S.C.T.C.D-3.4	31-438 I.D X 375" MW. SML'S									F	
CT-01-11-1	CS, PIPE TO ASME, SA-106										
	GR-C.										
	(2)										
F.S.C.T.C.D-3.4	— DITTO —		0-5							F	
CT-01-11-1											
L.B.A.T.C.*-3.4	31-438" I.D X 375" MW, 90° RWE	1								E	
CT-01-117-1	TO SA-234 WPB-W, MADE										
	FROM SA-515 GR. 70 PLATE,										
	(70,000 PSI TENSILE), OR SA-234										
	WPC SEAMLESS, ENDS PER										
	DETAIL CT-D-2										
L.B.A.T.C.*-3.4	— DITTO — EXCEPT SRWE,	1								E	
CT-01-16-1											
	ITT GRUNNELL MFG. PIPING										
Y.X.A.A.C.E.-2	2" 3000# CS, SP WELD BOSS	1	KERNERSVILLE, N.C.							E	
CT-3522-3	TO SA-105, PER DETISK.										
	CT-WB-1 (ATTACH TO CT-D-16)										

Code ASME Sec III, CL 2

Class DUKE B



Nuclear Safety Related

Job Supplement JS 11B

MFG. Code

Register No. CT-21-34X

MATERIALS RECORD  
PRODUCTION PLANNER

Sheet 24 of 24

Revision No. 2 SM

Revision Date 1/1/77

Piece Mark CT-SM-4D

Job Name

DUKE POWER COMPANY

CATAWBA UNIT #1  
CHARLOTTE, N.C.

Contract No. 7127

Location

PART NUMBER	DESCRIPTION	QUAN OR LENGTH	QUALITY CONTROL			ACCOUNTING/MATERIAL		
			HEAT NUMBER	DOCUMENT IN PROCESS	STATUS	U/M	UNIT PRICE P.O.	D.S. VENDOR
X X X X X CT-4012-2	1 1/2" ACCESS HOLE PLUG PER SK. CT-AH-1, TO ASME SA-105, H=1705	1					E	
3A	SP. END PROT. PER CT-EP-1	2					E	
3A	SPIDER BEARING PER.	2					E	
CT-ES-1								
3 1/2" (1375 NW) X 6" (S-EO)	3 1/2" (1375 NW) X 6" (S-EO)	1					E	
GT-2168-1	SWEEEPOL ET TO SA-105, WITH 37 1/2 RE.							SEE ATTACHED SHEET
6	END PROT.	1					E	
12	END PROT.	1	AT GRINNELL IND. PIPING				E	
			HERNERSVILLE, N. C.					

Code Am. Sec. III, Cl. 2

Class DUKE 'B'

Nuclear Safety Related

Job Supplement

JS118

MFG. Code

**FORM NPP-I DATA REPORT FOR FABRICATED NUCLEAR PIPELINE SUBASSEMBLIES\***  
**(As Required by the Provisions of the ASME Code Rules)**

**SHEET 1 OF 4**

1. Fabricated by ITT Grinnell Inc. Piping, Inc. Kernersville Order No. 7128  
(Name and Address of Fabricator)

2. Fabricated for Duke Power Company, Charlotte, NC Order No. C-12517  
(Name and Address)

3. Owner Duke Power Company 4. Location of Plant Newport, SC

5. Piping System Identification MAIN STEAM  
(Brief description of intended use, main coolant etc.)

(a) Drawing No. CT-01-25X Prepared by ITT Grinnell Industrial Piping, Inc.  
(b) National Board No. N/A

6. The material, design, construction, and workmanship complies with ASME Code Section III, Class N-2  
Edition 1974, Addenda Date Winter 1974, Case No. N/A

Remarks: Manufacturers' Data Reports properly identified and signed by Commissioned Inspectors have been furnished for  
the following items of this report N/A  
(Name of Part - Item number, Manufacturer's name, and identifying stamp)

Supplemental Sheets 2 --- Drawings  
3,4 --- Bill (s) of Material

7. Shop Hydrostatic Test Field psi.

8. Description of piping inspected Piece Mark Number CT-SM-4C  
(Include - mark no. - material spec. - nom. pipe size - schedule or thickness - length  
- fittings - flanges, etc.)  
See Attached Sheets

We certify that the statements made in this report are correct and that the fabrication of the described piping conforms  
with the requirements of SECTION III of the ASME BOILER AND PRESSURE VESSEL CODE.

Date 8-10-78 Signed Ind. Piping, Inc. by Thomas A. Smith  
(Fabricator)

Certificate of Authorization Expires 7-16-79 Certificate of Authorization No. N-1456

**CERTIFICATE OF SHOP INSPECTION**

I, the undersigned, holding a valid commission issued by the National Board of Boiler and Pressure Vessel Inspectors  
and/or the State or Province of N.C. and employed by \* of Hartford, CT.  
have inspected the piping described in this Data Report on 8-14-78, and state that to the best of my knowledge  
and belief, the Manufacturer has constructed this piping in accordance with the applicable Subsections of ASME Code,  
Section III.\*The Hartford Steam Boiler Inspection and Insurance Co.  
By signing this certificate, neither the Inspector nor his employer make any warranty, expressed or implied, concerning  
the piping in this Data Report. Furthermore, neither the Inspector nor his employer shall be liable in any manner  
for any personal injury or property damage or a loss of any kind arising from or connected with this inspection.

Date 8-14-78  
Benny R. Pollio  
(Inspector)

Commission N.C. - No. 878  
National Board, State, Province and No.

## ITT Grinnell Industrial Piping Inc.

KERNERSVILLE, N.C.

CONT. NO. 7127

NAME DUKE POWER COMPANY  
LOCATION CATAWBA UNIT #1  
*Charlotte, N.C.*  
P.O. C-12517→ RE DRW'N ~~101-101~~ R-2B-77

CHK'D PG

CHK'D PG

CHK'D PG

CHK'D PG


CHK'D PG

REV. ① 5-11-77

REV. ② 5-11-77

REV. ③ 5-23-78

REV. ④ 7-5-78

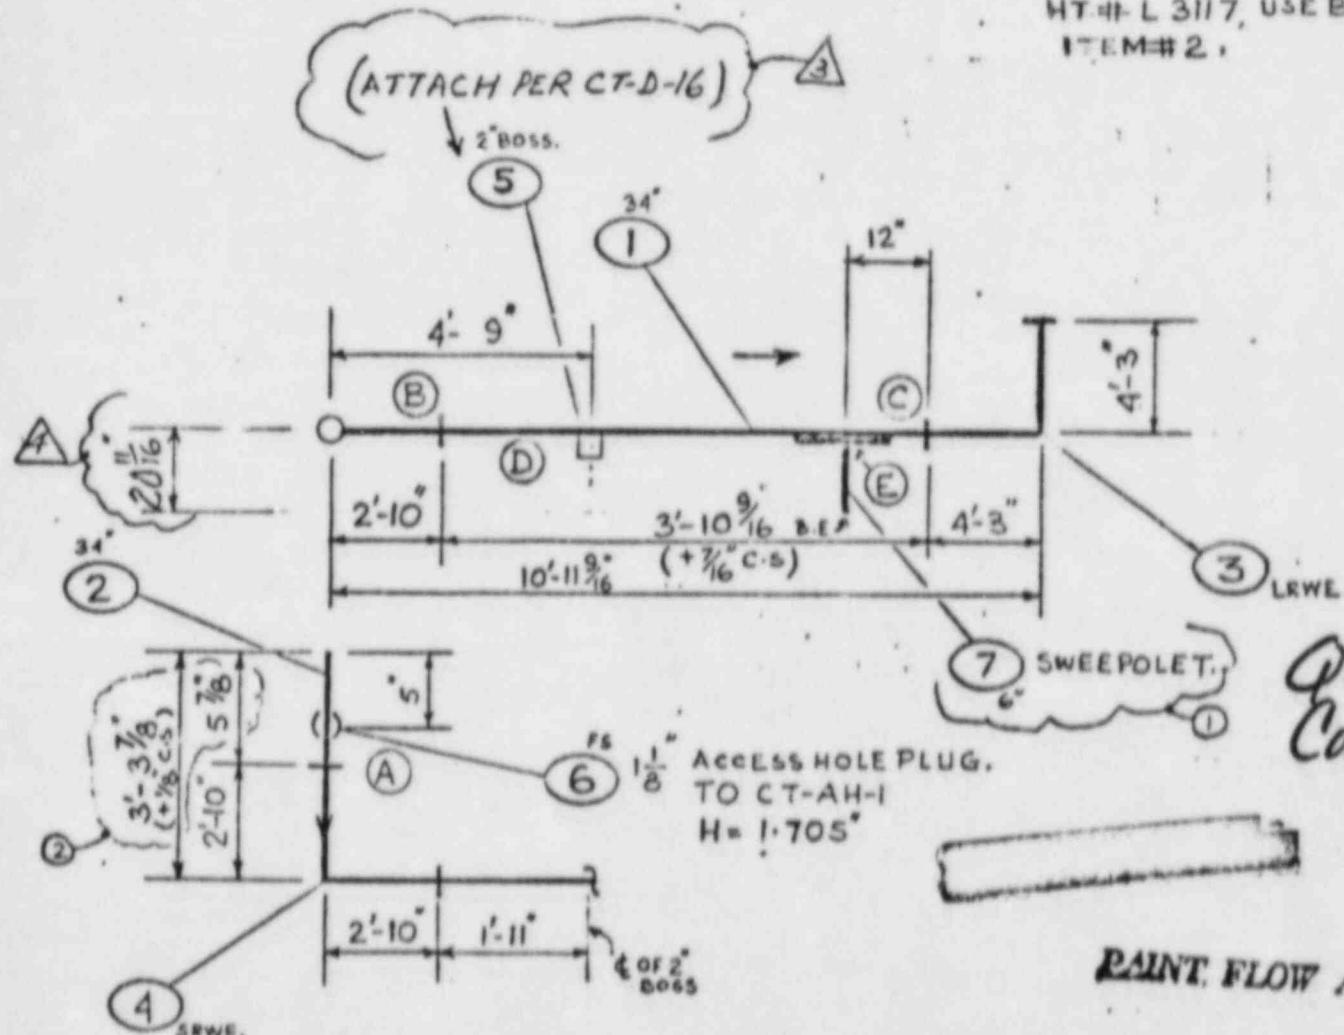LENGTH OF ACCESS HOLE PLUG SHALL  
BE  $\pm 1/16"$  OF ACTUAL WALL THK.  
SHOP SHALL GRIND TO FIT—IF REQUIRED.SPECIAL MATERIAL  
CHECK ALLOCATION SHEETS  
BEFORE CUTTINGUSE 3'-10  $\frac{9}{16}$ " FROM BAR#17 LOT#4121  
HT#L 3117, USE BALANCE FOR  
ITEM#2.MACHINE ENDS  
PER SKETCH CT-D-2, EXCEPT AS NOTED.

## Nuclear Safety Related

CLASS DUKE B LINE SPEC. PS 1500-5 (01) APP. CODE ~~Amc. Sec. III, Cl. 2~~ NO. REQ'D

Radiography (RT)	✓	Special Marking		Preheat	✓	Cert. of Compliance
Mag. Particle (MT)	✓	Special Cleaning	✓	Heat Treat		Mill Test Reports
Liq. Penetrant (PT)		Painting	✓	Code Stamp	✓	Data Reports

SYSTEM MAIN STEAM (SM)

FAB. SPECS. JS 11.9

REF. DRW'G NO. CN-1491-SMO01(EEV2)

PRESS. 1185 PSI TEMP. 600 °F WT. 7728 LBS.

PIECE MARK CT - SM-4C

①

REGISTER CT-01-25X

Register No. CT-01-25X

## MATERIALS RECORD PRODUCTION PLANNER

Sheet 3 Of 24  
Revision No A SM Revision Date 5-22-75

Piece Mark C.T.-SM-4C

**Job Name**

DUKE POWER COMPANY

**CATAWBA UNIT #1**

Contract No. 7127

### Location

Revision Date 5-2-75

Code Name Sec. III, Cl. 2

Class DEKE B

Job Supplement TS 11B

MFG. Code.

## Nuclear Safety Related

Register No. CT-01-25X

MATERIALS RECORD  
PRODUCTION PLANNERSheet 24 Of 24  
Revision No. A SIM Revision Date 7/3-78

Piece Mark CT-SM-4C

Job Name DUKE POWER COMPANY

CATAWBA UNIT #1

Charlotte, N.C.

Contract No. 7127

Location

ITEM	PART NUMBER	DESCRIPTION	QUAN OR LENG	QUALITY CONTROL			ACCOUNTING/MATERIAL			
				HEAT NUMBER	DOCUMENT IN PROCESS	STATUS	U/M	UNIT PRICE P.O.	DIS. VENDOR	NET
	1112-1	1 1/8" ACCESS HOLE PLUG	1					E		
	CT-4012-2	PER SK. CT-AH-1, TO	1							
		ASME, SA-105, H=1-705								
	34-1	SP. END PROT. PER CT-EP-1	2					E		
	34-1	SPIDER BRACING PER	2					E		
		CT-ES-1								
	34-1	34*(1.375 MW) X 6"(S-80)	1					E		
	CT-2166-1	SWEET POLET, TO SA-105,								
		WITH 37 1/2° BE								
	16-1	END PROT.	1					E		
	16-1									
	16-1									
	16-1									
	12-1	END PROT.	1					E		
		WT GRINNELL IND. IRVING								
		KERNERSVILLE, NC								

Code Ame. Sec. III, Cl. 2Class DUKE 'B'

Nuclear Safety Related

Job Supplement TS118

MFG. Code \_\_\_\_\_

**FORM NPP-1 DATA REPORT FOR FABRICATED NUCLEAR PIPELINE SUBASSEMBLIES\***  
 (As Required by the Provisions of the ASME Code Rules)

*SHEET 1 of 3*

1. Fabricated by ITT Grinnell Ind. Piping, Inc., Kernersville Order No. 7127  
 (Name and Address of Fabricator)

2. Fabricated for Duke Power Company, Charlotte, NC Order No. C-12517  
 (Name and Address)

3. Owner Duke Power Company 4. Location of Plant Newport, SC

5. Piping System Identification MAIN STEAM  
 (Brief description of intended use, main coolant etc.)

(a) Drawing No. CT-01-15X Prepared by ITT Grinnell Industrial Piping, Inc.  
 (b) National Board No. N/A

6. The material, design, construction, and workmanship complies with ASME Code Section III, Class N-2  
 Edition 1974, Addenda Date Winter 1974, Case No. N/A

Remarks: Manufacturers' Data Reports properly identified and signed by Commissioned Inspectors have been furnished for  
 the following items of this report N/A  
 (Name of Part - Item number, Manufacturer's name, and identifying stamp)

Supplemental Sheets	2 ---- Drawings
	3 ---- Bill (s) of Material

7. Shop Hydrostatic Test Field psi.

8. Description of piping inspected Piece Mark Number CT-5M-4B  
 (include - mark no. - material spec. - nom. pipe size - schedule or thickness - length  
 See Attached Sheets  
 - fittings - flanges, etc.)

We certify that the statements made in this report are correct and that the fabrication of the described piping conforms  
 with the requirements of SECTION III of the ASME BOILER AND PRESSURE VESSEL CODE.

Date 5-26-78 Signed ITT Grinnell Ind. Piping, Inc. By Thomas A. Smith  
 (Fabricator)

Certificate of Authorization Expires 7-16-79 Certificate of Authorization No. N-1456

**CERTIFICATE OF SHOP INSPECTION**

I, the undersigned, holding a valid commission issued by the National Board of Boiler and Pressure Vessel Inspectors and/or the State or Province of N.C. and employed by \* of Hartford, CT. have inspected the piping described in this Data Report on 5-29-78, and state that to the best of my knowledge and belief, the Manufacturer has constructed this piping in accordance with the applicable Subsections of ASME Code, Section III.\*The Hartford Steam Boiler Inspection and Insurance Co. By signing this certificate, neither the Inspector nor his employer make any warranty, expressed or implied, concerning the piping in this Data Report. Furthermore, neither the Inspector nor his employer shall be liable in any manner for any personal injury or property damage or a loss of any kind arising from or connected with this inspection.

Date 5-29-78 Barry K. Bollo Commissons N.C. No. 878  
 (Inspector) National Board, State, Province and No.

\*Supplemental sheets in form of lists, sketches or drawings may be used provided (1) size is 8½" x 11", (2) information in items 1, 2 and 5 on this data report is included on each sheet, and (3) each sheet is numbered and number of sheets is recorded in item 7, "Remarks".  
 Printed in U.S.A. (7/73)

**ITT Grinnell Industrial Piping Inc.**  
KERNERSVILLE, N. C.

sheet 2 of 3  
FORMEN-101 REV 1/77  
Q.A. FORM N2.1C

CONT. NO. 7127

NAME DUKE POWER COMPANY  
LOCATION CATAWBA UNIT #1  
Charlotte, N.C.  
C-12517

→REDRW'N NO. 10-28-77

CHK'D PG

REV. ① SM 12-14-77

CHK'D PG


REV. ② FA 3-10-78

CHK'D PG

REV. ③ SM 5-1-78

CHK'D PG

LENGTH OF ACCESS HOLE PLUG SHALL  
BE  $\pm 1/16$ " OF ACTUAL WALL THK.  
SHOP SHALL GRIND TO FIT—IF REQUIRED.

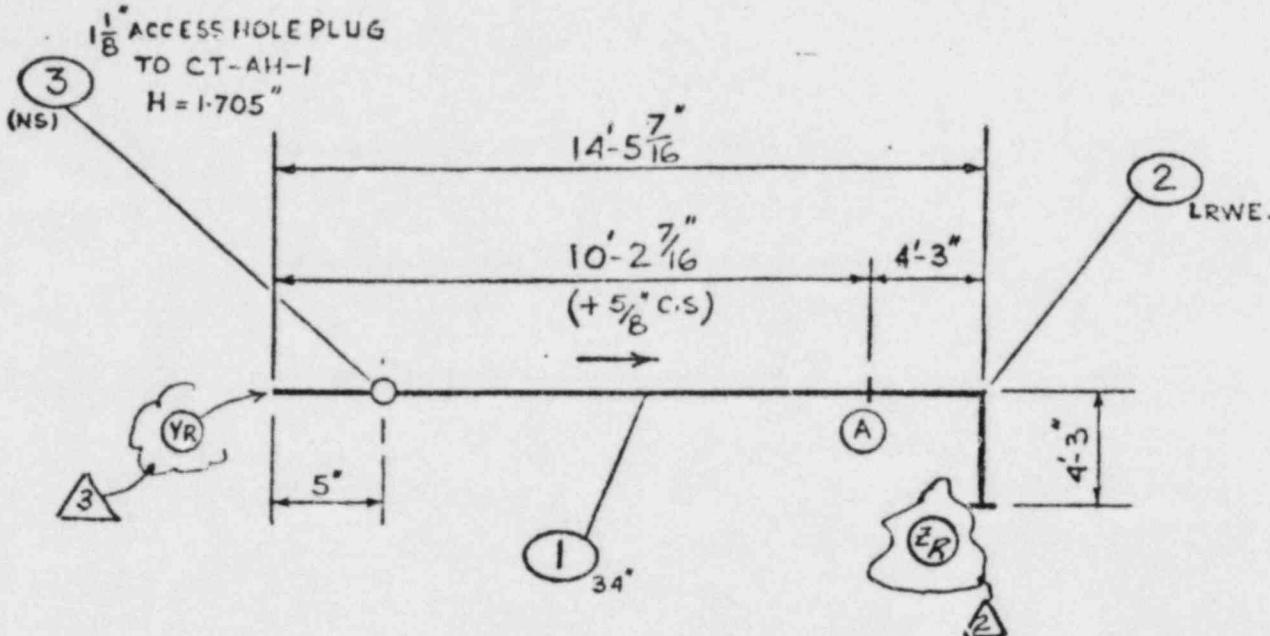

PIPE: 31-4381-DX1-375MW.  
SA-106C.

FLG:

B. W. FITG: SA-234WPB-W OR

SA-234WPC.

F. S. FITG: SA-105

## QUALITY CONTROL

PAINT FLOW ARROWS

MACHINE ENDS  
PER SKETCH CT-D-2

Nuclear Safety Related

CLASS DUKE B LINE SPEC. PS 1500-5 (01) APP. CODE ~~Ame. Sec. III, CL 2~~ NO. REQ'D 1

Radiography (RT)	✓	Special Marking		Preheat	✓	Cert. of Compliance	
Mag. Particle (MT)	✓	Special Cleaning	✓	Heat Treat		Mill Test Reports	✓
Liq. Penetrant (PT)		Painting	✓	Code Stamp	✓	Data Reports	✓

SYSTEM MAIN STEAM (SM)

FAB. SPECS. JS115

REF. DRWG NO. CN-1491-SM002 (REV.?)

PRESS. 1135 PSI. TEMP. 500 °F. WT. 8546 LBS.

PIECE MARK CT-SM-4B

①

REGISTER CT-01-15X



**FORM NPP-1 DATA REPORT FOR FABRICATED NUCLEAR PIPING SUBASSEMBLIES\***  
**(As Required by the Provisions of the ASME Code Rules)**

1. Fabricated by ITT Crinnell Ind. Piping, Inc., Kernersville Order No. 7127  
 (Name and Address of Fabricator) NC

2. Fabricated for Duke Power Company, Charlotte, NC Order No. C 12517  
 (Name and Address)

3. Owner Duke Power Company 4. Location of Plant Newport, SC

5. Piping System Identification MAIN STEAM  
 (Brief description of intended use, main coolant etc.)

(a) Drawing No. CT-01-5X Prepared by ITT GRINNELL Industrial Piping Inc.  
 (b) National Board No. N/A

6. The material, design, construction, and workmanship complies with ASME Code Section III, Class N-2  
 Edition 1974, Addenda Date Winter 1974, Case No. N/A

Remarks: Manufacturers' Data Reports properly identified and signed by Commissioned Inspectors have been furnished for  
 the following items of this report N/A  
 (Name of Part - Item number, Manufacturer's name, and Identifying stamp)

Supplemental Sheets	<u>2</u>	---Drawings
	<u>3</u>	---Bill (s) of Material

7. Shop Hydrostatic Test Field psi.

8. Description of piping inspected Piece Mark Number CT-Sm-4A  
 (include - mark no. - material spec. - nom. pipe size - schedule or thickness - length  
- fittings - flanges, etc.)  
 See Attached Sheets

We certify that the statements made in this report are correct and that the fabrication of the described piping conforms  
 with the requirements of SECTION III of the ASME BOILER AND PRESSURE VESSEL CODE.

Date 3-28-78 Signed ITT Grinnell Ind. Piping, Inc. By Thomas A. Smith  
 (Fabricator)

Certificate of Authorization Expires 7-16-79 Certificate of Authorization No. N-1456

**CERTIFICATE OF SHOP INSPECTION**

I, the undersigned, holding a valid commission issued by the National Board of Boiler and Pressure Vessel Inspectors  
 and/or the State or Province of N.C. and employed by \* of HARTFORD CT.  
 have inspected the piping described in this Data Report on 3-29-78, and state that to the best of my knowledge  
 and belief, the Manufacturer has constructed this piping in accordance with the applicable Subsections of ASME Code,  
 Section III. THE HARTFORD STEAM BOILER INSPECTION AND INSURANCE CO.  
 By signing this certificate, neither the Inspector nor his employer make any warranty, expressed or implied, concerning  
 the piping in this Data Report. Furthermore, neither the Inspector nor his employer shall be liable in any manner  
 for any personal injury or property damage or a loss of any kind arising from or connected with this inspection.

Date 3-29-78 Commiss. N. C. - No. 878  
 (Inspector) Barry K. Bobo Commission No. National Board, State, Province and No.

\* Supplemental sheets in form of lists, sketches or drawings may be used provided (1) size is 8½" x 11", (2) information in items 1, 2 and 5 on this data report is included on each sheet, and (3) each sheet is numbered and number of sheets is recorded in Item 7, "Remarks".

Grinnell Industrial Piping Inc.  
KERNERSVILLE, N.C.

QA FORM NO. 1C  
20F3


CONT. NO. 7127

NAME - DUKE POWER COMPANY  
LOCATION CATAWBA UNIT #1  
CHARLOTTE NC.  
P.O. C12517

→ REDRAWN ON 10-28-77  
REV. 12/14/77  
REV. 1/22/78  
REV. \_\_\_\_\_

CHEK'D PG  
CHEK'D PG  
CHEK'D PG - 3-2-7  
CHEK'D \_\_\_\_\_

LENGTH OF ACCESS HOLE PLUG SHALL  
BE  $\pm 1/16$ " OF ACTUAL WALL THK.  
SHOP SHALL GRIND TO FIT—IF REQUIRED.

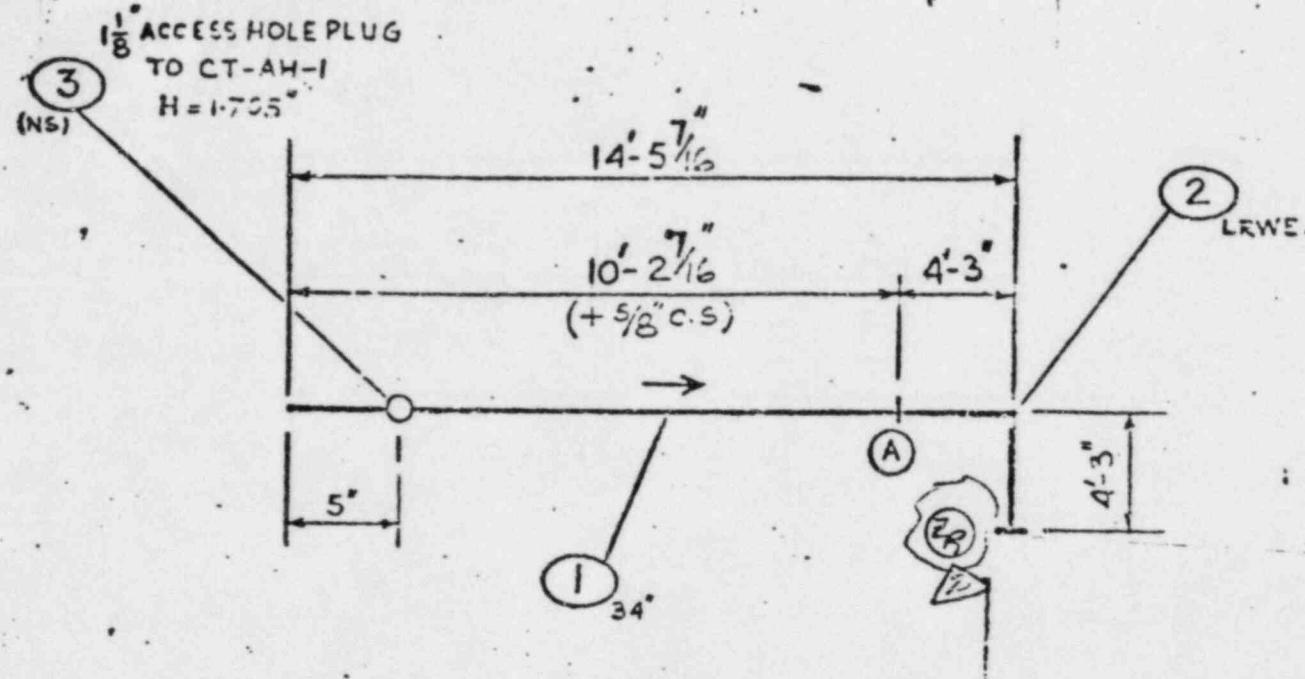

PIPE: 31-4361-DX-37EMW,  
SA-106C.

FLG:

B. W. FTTG: SA-224WPB-W OR

F. S. FTTG: SA-224WPC.

SA-105.

REVISION

PAINT FLOW ARROWS

MACHINE ENDS  
PER SKETCH CT-D-2

Nuclear Safety Related

CLASS DUKE B

LINE SPEC. PS 1500-5 (O1)

APP. CODE: ASME Sec. III, CL 2 NO. REQ'D. 1

Radiography (RT)	<input checked="" type="checkbox"/>	Special Marking		Preheat	<input checked="" type="checkbox"/>	Cert. of Compliance
Mag. Particle (MP)	<input checked="" type="checkbox"/>	Special Cleaning	<input checked="" type="checkbox"/>	Heat Treat		Mill Test Reports
Liq. Penetrant (LP)		Painting	<input checked="" type="checkbox"/>	Code Stamp	<input checked="" type="checkbox"/>	Data Reports

SYSTEM: MAIN STEAM (S-1)  
CT. DRAWING NO. CH-1491-SM003 (REV2)

FAB. SPEC'S J5116  
PRESS: 1135 psi TEMP: 600 °F. w/ 8546 lbf

RECEIPT MARK: CT-SM-4A

①

REGISTER: CT-01-5X

**GRINNELL INDUSTRIAL PIPING, INC.**

KERNERSVILLE N.C

FORM EN-102 REV 7/78  
O.A. FORM N2-1F

H-1

Register No. C.T.-01-5X

**MATERIALS RECORD**  
**PRODUCTION PLANNER**

Sheet 3 of 3

Revision No. \_\_\_\_\_ Revision Date \_\_\_\_\_

Piece Mark C.T- SM-4A

Job Name CATAWBA UNIT #1  
CHARLOTTE NC

Contract No. 7127

Location

Coda Xxxx Sec. III, Cl. 2

Class

DUKE B

## Job Supplement

TS 118

MFG. Code

## Nuclear Safety Related

**FORM NPP-I DATA REPORT FOR FABRICATED NUCLEAR PIPELINE SUBASSEMBLIES\***  
**(As Required by the Provisions of the ASME Code Rules)**

10F4

1. Fabricated by ITT Grinnell Ind. Piping, Inc., Kernevelville Order No. 7127  
 (Name and Address of Fabricator)

2. Fabricated for Duke Power Company, Charlotte, NC Order No. C-12517  
 (Name and Address)

3. Owner Duke Power Company 4. Location of Plant Newport, SC

5. Piping System Identification MAIN STEAM  
 (Brief description of intended use, main coolant etc.)

(a) Drawing No. CT-01-6X Prepared by ITT Grinnell Industrial Piping, Inc.  
 (b) National Board No. N/A

6. The material, design, construction, and workmanship complies with ASME Code Section III, Class N-2  
 Edition 1974, Addenda Date Winter 1974, Case No. N/A

Remarks: Manufacturers' Data Reports properly identified and signed by Commissioned Inspectors have been furnished for  
 the following items of this report N/A  
 (Name of Part - Item number, Manufacturer's name, and identifying stamp)

Supplemental Sheets 2 Drawings  
344 Bill (s) of Material

7. Shop Hydrostatic Test Field psi.

8. Description of piping inspected Piece Mark Number CT-SM-5A  
 (include - mark no. - material spec. - nom. pipe size - schedule or thickness - length  
 See Attached Sheets  
 - fittings - flanges, etc.)

We certify that the statements made in this report are correct and that the fabrication of the described piping conforms  
 with the requirements of SECTION III of the ASME BOILER AND PRESSURE VESSEL CODE.

Date 6-26-78 Signed ITT GRINNELL Ind. Piping, Inc. By Thomas A. Smith  
 (Fabricator)

Certificate of Authorization Expires 7-16-79 Certificate of Authorization No. N-1456

**CERTIFICATE OF SHOP INSPECTION**

I, the undersigned, holding a valid commission issued by the National Board of Boiler and Pressure Vessel Inspectors and/or the State or Province of N.C. and employed by \* of Hartford, CT. have inspected the piping described in this Data Report on 6-27-1978, and state that to the best of my knowledge and belief, the Manufacturer has constructed this piping in accordance with the applicable Subsections of ASME Code, Section III. \*The Hartford Steam Boiler Inspection and Insurance Co. By signing this certificate, neither the Inspector nor his employer make any warranty, expressed or implied, concerning the piping in this Data Report. Furthermore, neither the Inspector nor his employer shall be liable in any manner for any personal injury or property damage or a loss of any kind arising from or connected with this inspection.

Date 6-27-1978  
 Barry R. Bolte  
 (Inspector)

Commission N.C.-No. 878  
 National Board, State, Province and No.

\*Supplemental sheets in form of lists, sketches or drawings may be used provided (1) size is 8½" x 11", (2) information in Items 1, 2 and 5 on this data report is included on each sheet, and (3) each sheet is numbered and number of sheets is recorded in Item 7, "Remarks".  
 Printed in U.S.A. (2/73)

This form (E62) is obtainable from the ASME, 345 E. 47th St., New York, N.Y. 10017

CT-SM-5A

**T. T. Grinnell Industrial Piping Inc.**  
KERNERSVILLE, N. C.

CONT. NO. 7127

NAME DUKE POWER COMPANY  
LOCATION CATAWBA UNIT #1

Charlotte N.C.  
P.O. 12517


LENGTH OF ACCESS HOLE PLUG SHALL  
BE  $\pm$  1/16" OF ACTUAL WALL THK.  
SHOP SHALL GRIND TO FIT—IF REQUIRED.

-> RE DRAWN 10-26-77

REV. ① M-11-77  
REV. ② M-12-14-77  
REV. A M 5-23-78  
REV. A M 5-23-78  
REV. A M 5-23-78

✓ PG  
✓ SL

284

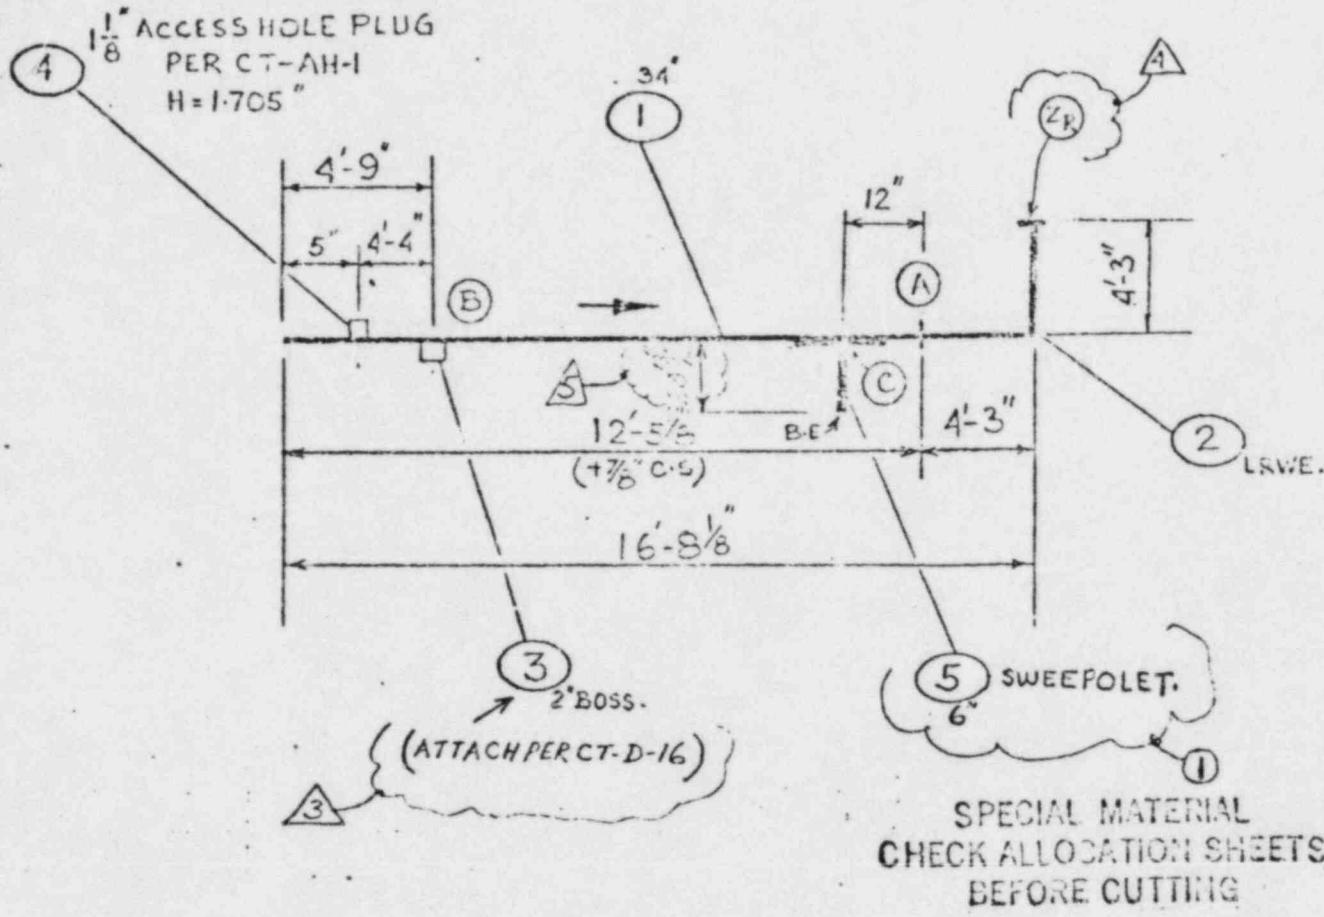

### PAINT FLOW ARROWS

1920 1921 1922 1923 1924  
1925 1926 1927 1928 1929  
1930 1931 1932 1933 1934

## MACHINE ENDS

PER SKETCH CT-D-2,  
EXCEPT AS NOTED.

## Nuclear Safety Related

CLASS DUKE B LINE SPEC. PS 1500-5 (01) APP. CODE Time, Sec. III, CL 2 NO. REQ'D 1

Radiography (RT)	<input checked="" type="checkbox"/>	Special Marking		Preheat	<input checked="" type="checkbox"/>	Cert. of Compliance	
Mag. Particle (MT)	<input checked="" type="checkbox"/>	Special Cleaning	<input checked="" type="checkbox"/>	Heat Treat		Mill Test Reports	<input checked="" type="checkbox"/>
Liq. Penetrant (PT)		Painting	<input checked="" type="checkbox"/>	Crade Stamp	<input checked="" type="checkbox"/>	Data Reports	<input checked="" type="checkbox"/>

**SYSTEM - MAIN STEAM. (SM)**

FAB. SPECIES J.S. 112

REF. DRWG NO. C.N-1491-SM.003 (REV.2) PRESS. 1185 PSI. TEMP. 600 °F. WT. 10,779 LBS.

PIECE NAME C.T.=SM=SA

①

REGISTER CT-91-6X

## GRINNELL INDUSTRIAL PIPING, INC.

KERNERSVILLE, NC

FORM EN-102 REV 7/78  
G.A. FORM N2.17

Register No. CT-01-6X

REVISION

MATERIALS RECORD  
PRODUCTION PLANNER

Sheet 3 of 71

Revision No. ASM

Revision Date 5-22-78

Piece Mark CT-SM-5A

Job Name CATAWBA UNIT #1  
Charlottesville

Contract No. 7127

Location

## DUKE POWER COMPANY

CATAWBA UNIT #1

PART NUMBER	P.O.C.12517 DESCRIPTION System Main Steam	QTY/N OR LENG	QUALITY CONTROL			ACCOUNTING/MATERIAL			
			HEAT NUMBER	DOCUMENT IN PROCESS	STATUS	U/M	UNIT PRICE P.O.	DIS. VENDOR	NET
2BC1CD12 3/4	31.438" I.D.X1.375" MW. SML'S 12.5A	1					F		
CT-01-11-1	CS PIPE TO ASME SA-106								
	GR.C.								
	USE BAR #13, LOT # 4121, HT # L3122 (13-1/2")								
LAA1TC12 3/4	31.438" I.D.X1.375" MW. 90° LRWE.	1					E		
CT-01-11-1	TO SA-234WPB-W, MADE								
	FROM SA-515 GR.70 PLATE,								
	(70,000 PSI TENSILE), OR								
	SA-234WPC SEAMLESS,								
	ENDS PER DETAIL CT-D-2								
YAA1CE12	2" 3000# CS. SP. WELD	1					E		
CT-3522-3	BOSS TO SA-105 PER DET.								
	SK# CT-WB-1								
	(ATTACHMENT CT-D-16). □								
YAA1CE12	1 1/2" ACCESS HOLE PLUG PER	1					E		
CT-3512-2	CT-AH-1, SA-105 "H"=1705								

Code Area Sec III, CL 2

Class

DUKE P

Job Supplement

JS 118

MFG. Code

Nuclear Safety Related

GRINNELL INDUSTRIAL PIPING, INC.

KPNEKSVILLE NC

H. P.

Register No. C T-01-6X

## MATERIALS RECORD PRODUCTION PLANNER

Sheet 21 Of 24

DUKE POWER COMPANY  
CATAWBA UNIT #1

Revision No. ① S.M. Revision Date 11-11-77

Piece Mark C T-SM-5A

Job Name 7/1/2024

Contract No. 7127

Location

**Code** Am. Soc. III, Cl. 2

Class

DUKE '3

## Nuclear Safety Related

Job Supplement JS 118

MFG. Code

**FORM SPE-1 DATA BEFORE FOR FABRICATOR SUB-ASSEMBLY SUB-ASSEMBLY TEST**

(As Required by the Provisions of the ASME Code Rules)

SHEET 1 OF 4

1. Fabricated by ITT Grinnell Ind. Piping, Inc. Kernersville Order No. 7127

(Name and Address of Fabricator) \_\_\_\_\_

**Owner:** Duke Power Company      **Location of Plant:** Newport, SC

5. Piping System Identification MAIN STEAM

(a) Drawing No. CT-DI-16X Prepared by ITT Grinnell Industrial Piping, Inc.  
(b) National Board No. N/A

6. The material, design, construction, and workmanship complies with ASME Code Section III, Class N-2  
Date 1974      Winter 1974      N/A

**Remarks:** Manufacturers' Data Reports properly identified and signed by Commissioned Inspectors have been furnished for the following items of this report \_\_\_\_\_ *N/A* (Name of Part - Item number, Manufacturer's name, and Identification stamp)

Supplemental Sheets . . . . . 2 ----Drawings  
3,4 ----Bill (s) of Material

7. Shop Hydrostatic Test Field psi.

8. Description of piping inspected - Piece Mark Number CT-5M-5B  
(Include - mark no. - material spec. - nom. pipe size - schedule or thickness - length  
- fittings - flanges, etc.) See Attached Sheets

We certify that the statements made in this report are correct and that the fabrication of the described piping conforms with the requirements of SECTION III of the ASME BOILER AND PRESSURE VESSEL CODE.

Date 8-31-78 Signed Ind. Piping, Inc. By Thomas A. Smith  
(Fabricator)

**Certificate of Authorization Expires** 7-16-79      **Certificate of Authorization No.** A-1456

**CERTIFICATE OF SHOP INSPECTION**

I, the undersigned, holding a valid commission issued by the National Board of Boiler and Pressure Vessel Inspectors and/or the State or Province of MD and employed by \* of Hartford, CT. have inspected the piping described in this Data Report on 11 1978, and state that to the best of my knowledge and belief, the Manufacturer has constructed this piping in accordance with the applicable Subsections of ASME Code, Section III.\*The Hartford Steam Boiler Inspection and Insurance Co. By signing this certificate, neither the Inspector nor his employer make any warranty, expressed or implied, concerning the piping in this Data Report. Furthermore, neither the Inspector nor his employer shall be liable in any manner for any personal injury or property damage or a loss of any kind arising from or connected with this inspection.

Date 9/11/18 . 19 18 Home Donated Commissions 40128

\* Supplemental sheets in form of lists, sketches or drawings may be used provided (1) size is 8½" x 11", (2) information in Items 1, 2 and 5 on this data report is included on each sheet, and (3) each sheet is numbered and number of sheets is recorded in Item 7, "Remarks".

## ITT Grinnell Industrial Piping Inc.

KERNERSVILLE, N. C.


CONT. NO. 7127

NAME DUKE POWER COMPANY

LOCATION CATAWBA UNIT #1

CHARLOTTE, N.C.  
C-12517LENGTH OF ACCESS HOLE PLUG SHALL  
BE  $\pm 1/16$ " OF ACTUAL WALL THK.  
SHOP SHALL GRIND TO FIT—IF REQUIRED.

→ RE DRW'G NO. 101-108-77 CHKD FG  
 REV ① 1-11-77 CHKD FG  
 REV ② 5-12-14-77 CHKD FG  
 REV ③ 5M5-23-78 CHKD FG  
 REV ④ 5M5-24-78 CHKD FG  
 REV ⑤ 7-1-2-78 ← SL

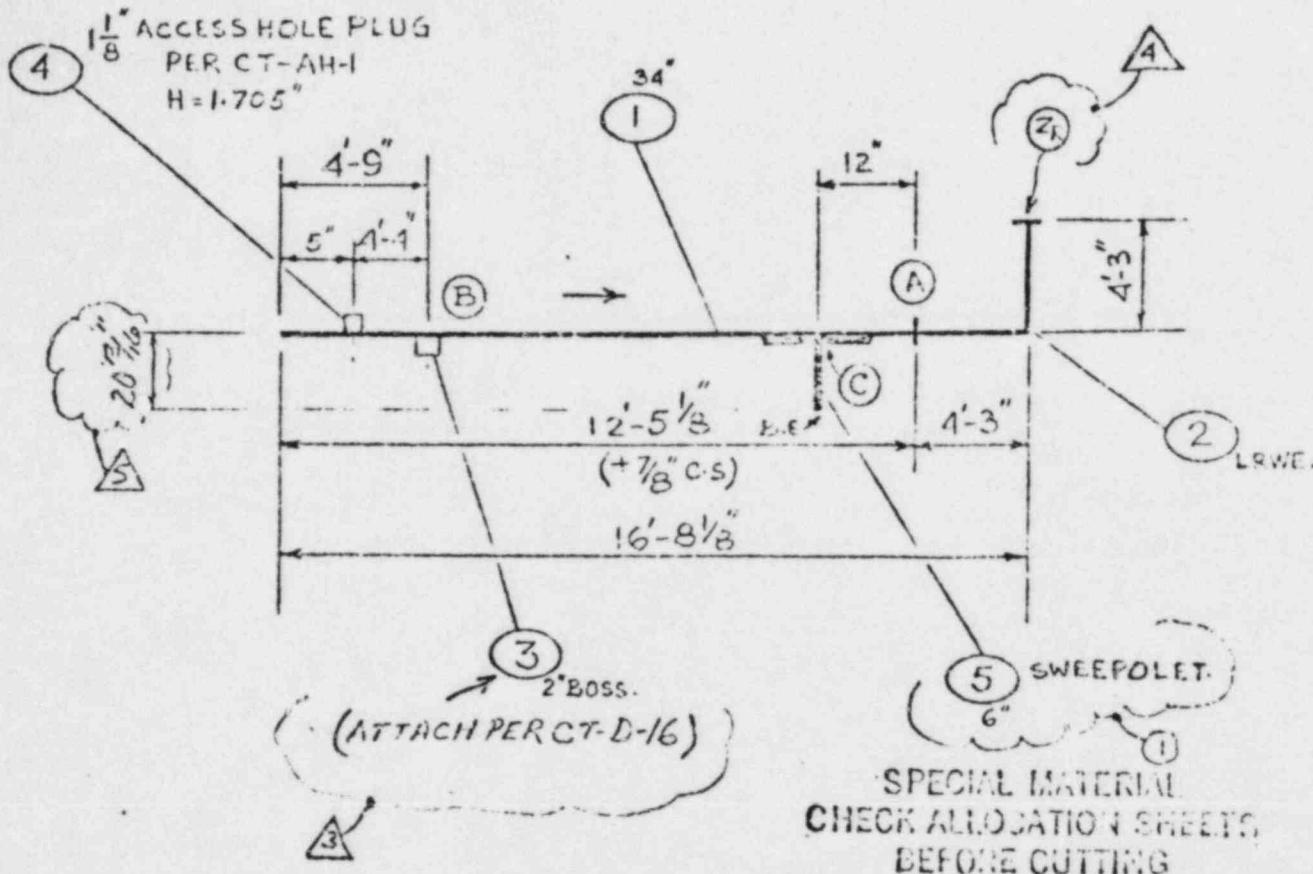

## QUALITY CONTROL

EATIN FLOW ARROWS

USE BAR 4115, LOT # 4121,  
 HT. # L 3123, (13'-0 $\frac{3}{8}$ ")

MACHINE ENDS

PER SKETCH CT-D-2  
EXCEPT AS NOTED.

## Nuclear Safety Related

CLASS DUKE B LINE SPEC. PS 1500-5(OI) APP. CODE T-2, Sec. III, CL 2 NO. REQ'D

Radiography (RT)	✓	Special Marking		Preheat	✓	Cert. of Compliance	
Mag. Particle (MT)	✓	Special Cleaning	✓	Heat Treat		Mill Test Reports	✓
Liq. Penetrant (PT)		Painting	✓	Cod. Stamp	✓	Data Reports	✓

SYSTEM MAIN STEAM (SM)

FAB. SPEC'S. 15119

REF. DRW'G NO. 2-N-1411-SM-CG2(PD) PRESS. 1185. PSL TEMP. 550° F. WT. 1247.2 LBS.

PIPE MARK C.T.-SM-5B

OF

REGISTER C.T.-O1-16X

KERNERSVILLE, N. C.

Register No. CT-01-16X

MATERIALS RECORD  
PRODUCTION PLANNER

Sheet 3 Of 24

Revision No. A SM

Revision Date 5-23-78

Piece Mark CT-01-5B

DUKE POWER COMPANY  
CATAWBA UNIT #1  
CHARLOTTE, N.C.

Contract No. 7127 Location

PART NUMBER	DESCRIPTION	QUAN OR LENGTH	QUALITY CONTROL			ACCOUNTING/MATERIAL			
			HEAT NUMBER	DOCUMENT IN PROCESS	STATUS	U/M	UNIT PRICE P.O.	DIS. VENDOR	NET
CT-D-2	P.O.-C-12517 SYSTEM- MAIN STEAM	31.425' I.DX1-375" MW. SML'S	12'5 <sup>1</sup> / <sub>2</sub> "					F	
CT-01-11-1	CS, PIPE TO ASME SA-106								
	GR.C								
	USE BAR #15, LOT #4121 HT. #L3123 (13-052)								
L.A.A. 3	31.425" I.DX1-375" MW, 90LRWE	1							
CT-01-17-1	TO SA-234WPP-W, MADE							F	
	FROM SA-515 GR.70 PLATE,								
	(70,000 PSI TENSILE), OR								
	SA-234VIPC SFAMLESS,								
	ENDS PER DETAIL CT-D-2.								
Y.X.A. 1	3000 ft CS. SP. WELDBOSS	1							
CT-2002-3	TO SA-105, PER DET. SK#							E	
	CT-WB-1								
	(ATTACH PER CT-D-16)								
X.Y.Z. 1	1 1/2" ACCESS HOLE. PLUG	1							
CT-4012-2	PER CT-AH-1, H=1-705"							E	
	MAT. TO SA-105								

SEE ATTACHED  
SHEETS

Code Area Sec. III, CL 2

Class

DUKE B

Nuclear Safety Related

Job Supplement

JS 118

MFG. Code

KERNERSVILLE, N. C.

Register No. CT-01-16X

## MATERIALS RECORD PRODUCTION PLANNER

Sheet 24 Of 24

Revision No. 1

RevisionDate 5-22-21

2000 MHz.  $\int T = 5M = 5B$

Job Name CANNERY UNIT # 1  
CHEROTTE, N.C.

CIAWCA UNIT #1

~~Charlotte, N.C.~~

Contract No. 7127

## Location

SEE ATTACHED  
SHEETS

Code E&E Sec. III, Cl. 2

Class DUKE P

### Nuclear Safety Related

Job Supplement J S 119

MFG. Code

Register No. CT-01-16X

MATERIALS RECORD  
PRODUCTION PLANNER

Sheet 1 Of 2

Revision No. 1 SM

Revision Date 11-11-77

DUKE POWER COMPANY

Piece Mark CT-SM-5B

Job Name CATAWBA UNIT #1

Contract No. 7127

Location \_\_\_\_\_

ITEM	PART NUMBER	DESCRIPTION	QUAN OR LENG	QUALITY CONTROL				ACCOUNTING/MATERIAL			
				HEAT NUMBER	DOLL 5-22-73	IN PROCESS	STATUS	U/M	UNIT PRICE P.O.	DIS. VENDOR	NET
1	PAD*	34.1*1*1*1	31.438" I.D.X1-375" MW-SML'S	12.50	L3123	100%	100%	F	5-18-78		
	CT-01-11-1	1*1*1*1*1	CS, PIPE TO ASME SA-106	(SN-24622)	100%	100%	100%	F			
		1*1*1*1*1	GR.C								
		1*1*1*1*1	USE BAR#15, LOT#4121 HT:FL3123 (13.0%)								
2	LAA*	34.1*1*1*1	31.438" I.D.X1-375" MW, 90LRWE	1 (ARBT)	300F.1G	100%	100%	F			
	CT-01-17-1	1*1*1*1*1	TO SA-234WPB-W, MADE								
		1*1*1*1*1	FROM SA-515GR.70 PLATE,								
		1*1*1*1*1	(70,000 PSI TENSILE), OR								
		1*1*1*1*1	SA-234WPC SEAMLESS,								
		1*1*1*1*1	ENDS PER DETAIL CT-D-2.								
3	Y*AA	12.1*1*1	3000#CS, SP.WELDBOSS	1 (AA)	SWF.4	100%	100%	E			
	CT-3002-3	1*1*1*1*1	TO SA-105, PER DET. SK#1								
		1*1*1*1*1	CT-WB-1								
4	XIX**	1.12.1*1	1 1/2" ACCESS HOLE PLUG	1 ABP	RP 4	100%	100%	E	Rec. 5/10 7/12		
	CT-4012-2	1*1*1*1*1	PER CT-AH-1, H=1.705"								
		1*1*1*1*1	MAT. TO SA-105								
			SUPERCEDED								

Code Amz. Sec. III, Cl. 2

Class DUKE B

Nuclear Safety Related

Job Supplement JS118

MFG. Code

**FORM NPP-1 DATA REPORT FOR FABRICATED NUCLEAR PIPING SUBASSEMBLIES\***  
**(As Required by the Provisions of the ASME Code Rules)**

SHEET 1 OF 3

1. Fabricated by ITT Grinnell Industrial Piping, Inc. Order No. 7127  
(Name and Address of Fabricator) Kernersville, N. C.

2. Fabricated for Duke Power Company Charlotte, N. C. Order No. C-12517  
(Name and Address)

3. Owner Duke Power Company 4. Location of Plant Newport, S. C.

**5. Piping System Identification . . .** **MAIN STEAM**  
(Brief description of intended use, main coolant etc.)

MAIN STEAM

(Brief description of intended use, main coolant etc.)

(a) Drawing No. CT-01-26X Prepared by IFT Grinnell Industrial Piping, Inc.  
(b) National Board No. N/A

(b) National Board No. N/A

6. The material, design, construction, and workmanship complies with ASME Code Section III, Class Nuc. 2  
Edition 1974, Addenda Date Winter 1974, Case No. N/A

**Remarks:** Manufacturers' Data Reports properly identified and signed by Commissioned Inspectors have been furnished for the following items of this report. N/A (Name of Report, Item number, Manufacturer's name, and Identification stamp)

7. Shop Hydrostatic Test Field psi.

- ## #2 - - Drawings

- #3 ---Bill(s) of Material

8. Description of piping inspected Piece Mark Number CT-SM-5C  
(include - mark no. - material spec. - nom. pipe size - schedule or thickness - length)

See Attached Sheets

$\equiv \text{ALL}[\text{pos} = (\text{BFS}[\text{stc}], \text{stc})]$

We certify that the statements made in this report are correct and that the fabrication of the described piping conforms with the requirements of SECTION III of the ASME BOILER AND PRESSURE VESSEL CODE.

Date 9-13-77 Signed Ind By Chesman A. Smith

Certificate of Authorization Expires 7-16-79 Certificate of Authorization No. N-1456

**CERTIFICATE OF SHIP INSPECTION**

I, the undersigned, holding a valid commission issued by the National Board of Boiler and Pressure Vessel Inspectors and/or the State or Province of Maryland and employed by \*  
X of Hartford, CT.  
have inspected the piping described in this Data Report on 9-15-77, and state that to the best of my knowledge and belief, the Manufacturer has constructed this piping in accordance with the applicable Subsections of ASME Code, Section III. \*The Hartford Steam Boiler Inspection and Insurance Company  
By signing this certificate, neither the Inspector nor his employer make any warranty, expressed or implied, concerning the piping in this Data Report. Furthermore, neither the Inspector nor his employer shall be liable in any manner for any personal injury or property damage or a loss of any kind arising from or connected with this inspection..

Date 9-15-1, 1973  
C. L. Moore  
(Signature)

### **Cessions**

3d. 77

### National Board, State, Province and City.

# ITT Grinnell Industrial Piping Inc.

(R)

KERNERSVILLE, N.C.

FORM EN-101 REV 1/76  
QA FORM N2.1C

Sheet 2 of 3

CONT. NO. 7127

NAME DUKE POWER COMPANY  
LOCATION CATAWBA UNIT #1

DRW'N NO. 1-1-76

CHK'D PG 11-1-76

REV. 1 SM-4-21-77

CHK'D PG

REV. 2 SM-4-21-77

CHK'D PG

REV. 3 SM-7-25-77


CHK'D PG

CHK'D PG

NOTE:- LENGTH OF A-H PLUG SHALL  
BE  $\pm \frac{1}{16}$ " OF ACTUAL WALL THK.  
SHOP SHALL GRIND TO FIT, IF REQ'D.

2

DUKE POWER COMPANY  
CHARLOTTE, N.C.  
C-12517

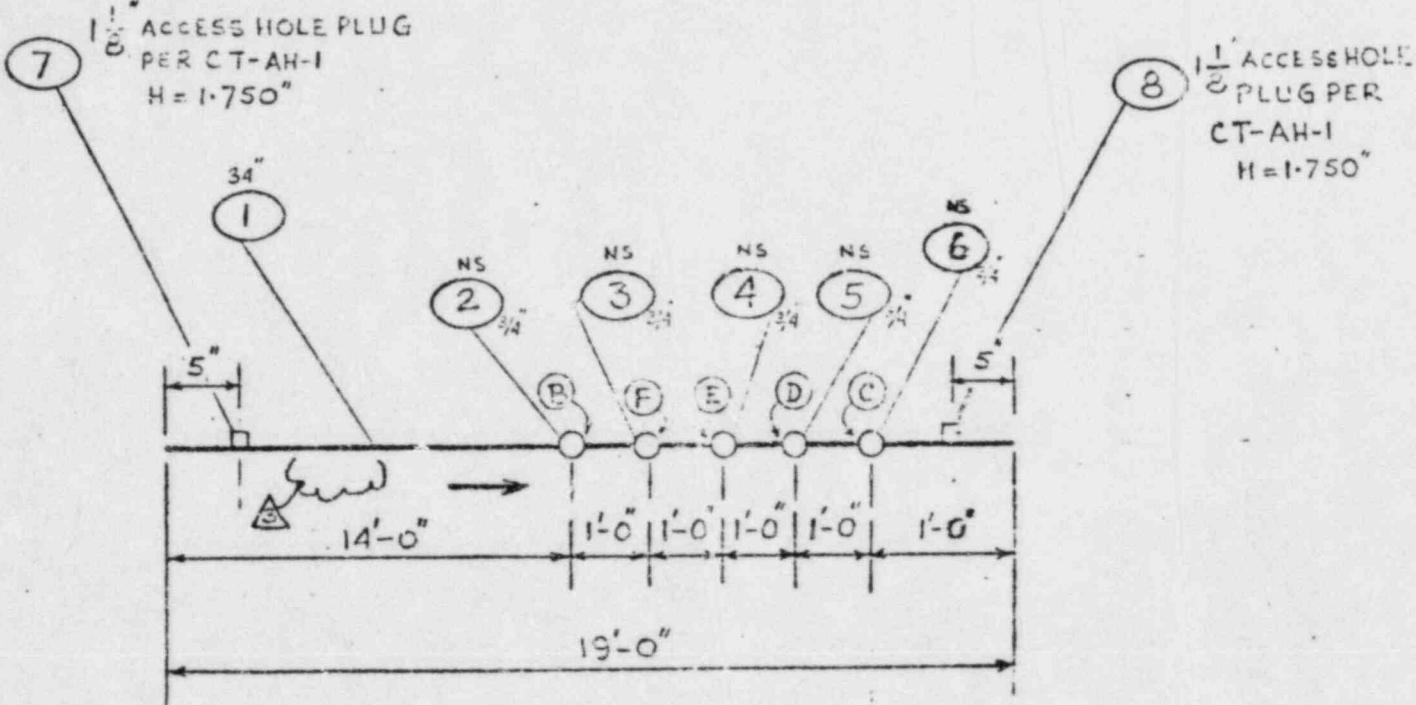

MACHINE ENDS  
PER SKETCH CT-D-2

Nuclear Safety Related

CLASS DUKE B LINE SPEC. PS-1500-5(01) APP. CODES Sec. III, CL 2 NO. REQ'D

Radiography (RT)	<input checked="" type="checkbox"/>	Special Marking		Preheat	<input checked="" type="checkbox"/>	Cert. of Compliance	
Mag. Particle (MP)	<input checked="" type="checkbox"/>	Special Cleaning	<input checked="" type="checkbox"/>	Heat Treat	<input checked="" type="checkbox"/>	Mill Test Report	<input checked="" type="checkbox"/>
Liq. Penetrant (PT)		Panting	<input checked="" type="checkbox"/>	Code Stamp	<input checked="" type="checkbox"/>	Data Reports	<input checked="" type="checkbox"/>

SYSTEM MAIN STEAM (SM)

REF. DRWG NO. CL-141-SM-01

FAB. SPECS. J5-11

PRESS. 1322 psi TEMP. 632 °F. WT. 11374 LBS.

PIECE MARK CL-141-SM-SC

REGISTER CL-141-26X



**FORM NPP-1 DATA REPORT FOR FABRICATED NUCLEAR PIPING SUBASSEMBLIES\***  
 (As Required by the Revisions of the ASME Code Rules)

Sheet 1 OF 3

1. Fabricated by ITT Grinnell Industrial Piping, Inc. Order No. 7127  
 (Name and Address of Fabricator) Kernersville, N. C.

2. Fabricated for Duke Power Company Charlotte, N. C. Order No. C-12517  
 (Name and Address)

3. Owner Duke Power Company 4. Location of Plant Newport, S. C.

5. Piping System Identification MAIN STEAM  
 (Brief description of intended use, main coolant etc.)

(a) Drawing No. CT-01-35X Prepared by ITT Grinnell Industrial Piping, Inc.  
 (b) National Board No. N/A

6. The material, design, construction, and workmanship complies with ASME Code-Section III, Class N-2  
 Edition 1974, Addenda Date Winter 1974, Case No. N/A

Remarks: Manufacturers' Data Reports properly identified and signed by Commissioned Inspectors have been furnished for  
 the following items of this report N/A  
 (Name or Part - Item number, Manufacturer's name, and Identifying stamp)

Supplemental Sheets 2 ---Drawings  
3 ---Bill(s) of Material

7. Shop Hydrostatic Test Field psi.

8. Description of piping inspected Piece Mark Number CT-SM-5D  
 (include - mark no. - material spec. - nom. pipe size - schedule or thickness - length  
 - fittings - flanges, etc.)

See Attached Sheets

We certify that the statements made in this report are correct and that the fabrication of the described piping conforms  
 with the requirements of SECTION I<sup>1</sup> of the ASME BOILER AND PRESSURE VESSEL CODE.

Date 8-31-77 Signed ITT Grinnell Industrial Piping, Inc. By Thomas A. Smith  
 (Fabricator)

Certificate of Authorization Expires 7-16-79 Certificate of Authorization No. N 1456

**CERTIFICATE OF SHOP INSPECTION**

I, the undersigned, holding a valid commission issued by the National Board of Boiler and Pressure Vessel Inspectors  
 and/or the State or Province of N.C. and employed by \* of Hartford, CT.  
 have inspected the piping described in this Data Report on 9-7 1977, and state that to the best of my knowledge  
 and belief, the Manufacturer has constructed this piping in accordance with the applicable Subsections of ASME Code,  
 Section III. \*The Hartford Steam Boiler Inspection and Insurance Company  
 By signing this certificate, neither the Inspector nor his employer make any warranty, expressed or implied, concerning  
 the piping in this Data Report. Furthermore, neither the Inspector nor his employer shall be liable in any manner  
 for any personal injury or property damage or losses arising from or connected with this inspection.

Date 9-7 1977  
Barney K. Bolte  
 (Inspector)

Comments: N.C. - No. 878  
 National Board, State, Province and No.

**ITI Grinnell Industrial Piping Inc.**

KERNERSVILLE, N.C.

FORM NO. 101 REV 1/78  
Q.A. FORM NO. 1C

2063

ONT. NO. 7127

NAME DUKE POWER COMPANY, CHARLOTTE, N.C.  
LOCATION CATAWBA UNIT #1 P.O. C-12517

DRWNSHIPS 10-21-76

CHKD PG 11-1-76

REV. 1△SM 4-2-77

CHKD PG

REV. 2△SM 6-19-77

CHKD PG

REV. 3△SM 7-26-77

CHKD PG

CHKD PG

NOTE:- LENGTH OF AH-PLUG SHALL  
BE  $\pm \frac{1}{16}$ " OF ACTUAL WALL THK.  
SHOP SHALL GRIND TO FIT, IF REQD.

REV. 3△SM 7-26-77

CHKD PG

REV. 3△SM 7-26-77</

QA FORM N2.1P

29. 2. 1977

THE GRINNELL INDUSTRIAL PIPING, INC., KERNERSVILLE, N.C.

Duke Power Co., Charlotte, N.C.

Sample No. C.T. = 01-35X P.O. C12517

**MATERIALS RECORD  
PRODUCTION PLANNER**

Sheet 3 for 3

water: Miss Steam

DUKE POWER COMPANY

Revision No. 1

RevisionDate: 1-21-77

ECR Mark CT-SM-5D

Job Name

CATAWBA UNIT #

Contract No. 7127

Location

Code Ann. Sec. III, Cl. 2

Class DUKE B

## Nuclear Safety Related

Job Supplement J S 118

MFG. Cod

## FORM SPP-1 DATA REPORT FOR FABRICATED NUCLEAR PIPELINE SUBASSEMBLIES\*

(As Required by the Provisions of the ASME Code Rules)

SHEET 1 OF 31. Fabricated by ITT Grinnell Industrial Piping, Inc. Order No. 7127  
(Name and Address of Fabricator) Kernersville, N. C.2. Fabricated for Duke Power Company Charlotte, N. C. Order No. C-12517  
(Name and Address)3. Owner Duke Power Company 4. Location of Plant Newport, S. C.5. Piping System Identification MAIN STEAM  
TEW 8-18-77  
(Brief description of intended use, main coolant etc.)(a) Drawing No. CT-01-7X Prepared by ITT Grinnell Industrial Piping, Inc.  
(b) National Board No. N/A6. The material, design, construction, and workmanship complies with ASME Code Section III, Class NUC.2  
Boston 1974, Addenda Date Winter 1974, Case No. N/ARemarks: Manufacturers' Data Reports properly identified and signed by Commissioned Inspectors have been furnished for  
the following items of this report N/A  
(Name of Part - Item number, Manufacturer's name and Identifying stamp)Supplemental Sheets #2 ---Drawings  
#3 ---Bill(s) of Material7. Shop Hydrostatic Test Field psi.8. Description of piping inspected Piece Mark Number CT-SM-6A  
(include - mark no. - material spec. - nom. pipe size - schedule or thickness - length  
- fittings - flanges, etc.)  
See Attached SheetsWe certify that the statements made in this report are correct and that the fabrication of the described piping conforms  
with the requirements of SECTION III of the ASME BOILER AND PRESSURE VESSEL CODE.Date 8-18-77 Signed ITT Grinnell Industrial Piping, Inc. By Thomas A. Smith  
(Fabricator)Certificate of Authorization Expires 7-16-79 Certificate of Authorization No. 11-1456

## CERTIFICATE OF INSPECTION

I, the undersigned, holding a valid commission issued by the National Board of Boiler and Pressure Vessel Inspectors and/or the State or Province of Maryland and employed by \* of Hartford, CT.  
have inspected the piping described in this Data Report on 8/23/1977, and state that to the best of my knowledge and belief, the Manufacturer has constructed this piping in accordance with the applicable Subsections of ASME Code, Section III. \*The Hartford Steam Boiler Inspection and Insurance Company  
By signing this certificate, neither the Inspector nor his employer make any warranty, expressed or implied, concerning the piping in this Data Report. Furthermore, neither the Inspector nor his employer shall be liable in any manner for any personal injury or property damage or a loss of any kind arising from or connected with this inspection.

Date 8/23/77  
\_\_\_\_\_  
Richard L. Stockley  
(Inspector)Commission Maryland - 94  
National Board State, Province and No.

**GIFT** Grinnell Industrial Piping Inc.  
FERNDALE, N.C.

ONT. NO. 7127

NAME DUKE POWER COMPANY  
LOCATION CATAWBA UNIT #1

REVISION

PENN IN ENCL REV 1/28  
G.A. FORM 21C

Sheet 2 of 3


DRWNS-CH-AJ-21-76  
REV.  $\Delta$  SM-421-72  
REV.  $\Delta$  SMG-29-77  
REV.  $\Delta$  SM-7-20-77

CHK'D PG. B-1-76  
CHK'D PG  
CHK'D PG  
CHK'D PG

NOTE:- LENGTH OF ACCESS HOLE PLUG  
SHALL BE  $\pm \frac{1}{16}$ " OF ACTUAL WALL  
THK. SHOP SHALL GRIND TO FIT,  
IF REQ'D.

QUALITY CONTROL

DUKE POWER COMPANY  
CHARLOTTE, N.C.  
C-12517

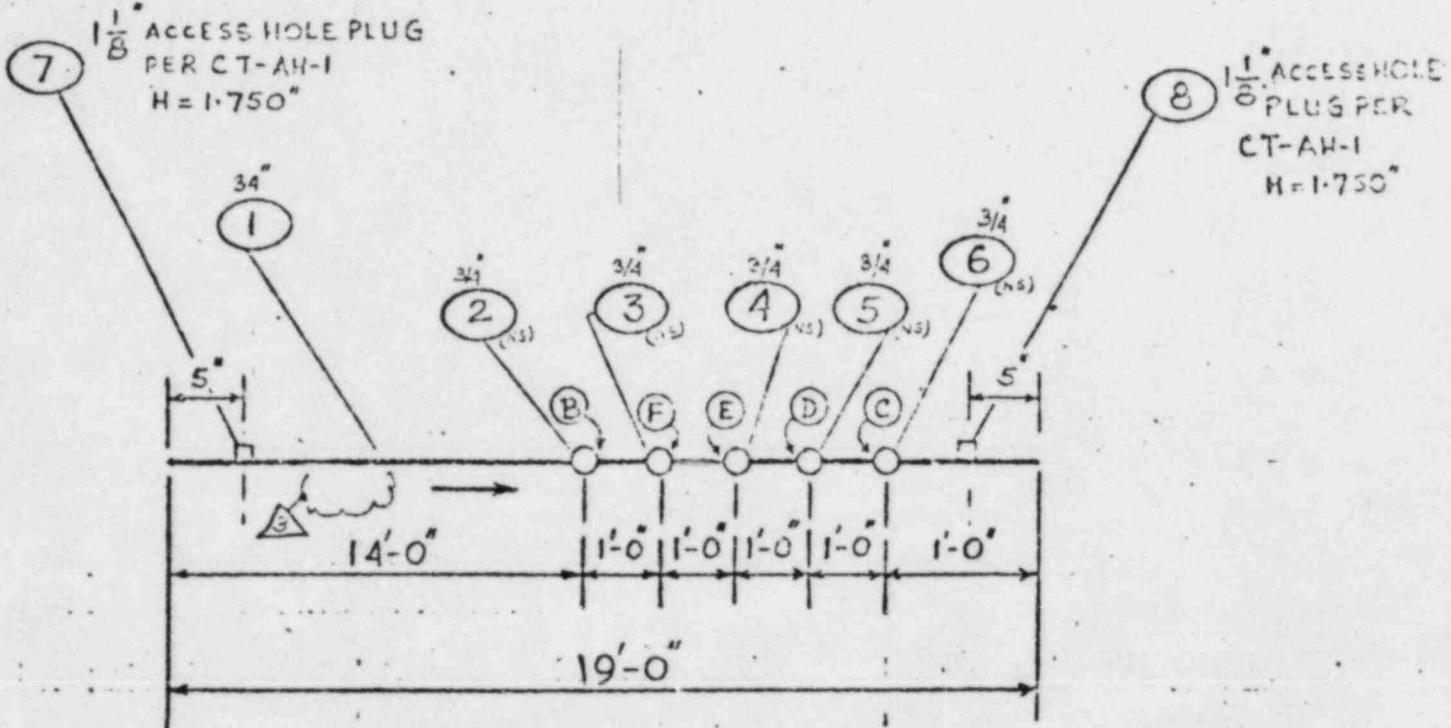

MACHINE ENDS  
PER SKETCH CT-D-2

Nuclear Safety Related

ASS	DUKE B	LINE SPEC PS 1500-5 (01)	APP. CODE A723, S3, III, CL 2	NO. REQ'D
radiography (RT)	<input checked="" type="checkbox"/>	Special Marking	<input checked="" type="checkbox"/>	Cert. of Compliance
ag. Particle (MT)	<input checked="" type="checkbox"/>	Special Cleaning	<input checked="" type="checkbox"/>	Mill Test Reports
g. Penetrant (PT)		Painting	<input checked="" type="checkbox"/>	Data Reports
YSTEM	MAIN STEAM (SM)		FAB. SPECS	J.S.IIS
F. DRWG NO.	CH-149L-SM-003		PRESS.	1230 PSI TEMP. 600°F WT. 1254 LBS
REMARK	CT-SM-6A		REGISTER	CT-01-7X

GRINNELL INDUSTRIAL PIPING, INC.

DUKE POWER COMPANY  
CHARLOTTE, N.C.  
C-12517

Q.A. FORM N2 "F"

Register No. 6 T= 91 = 7X

## MATERIALS RECORD PRODUCTION PLANNER

Sheet 1 Of 2

Revision No. 1 SN

RevisionDate 7-1-2022

Bisco Mark C T = S M = S A

Job Name

DUKE POWER COMPANY  
CATAWBA UNIT #1

Contract No. 7127

#### Location

Code Am. Sec. III, Cl. 2

Class DUKE B

Job Supplement J S 118

MFG. Code

## Nuclear Safety Related MAIN STEAM

## FORM NPP-1 DATA REPORT FOR FABRICATED NUCLEAR PIPING SUBASSEMBLIES

(As Required by the Provisions of the ASME Code Rules)

SHEET 1 OF 3

1. Fabricated by ITT Grinnell Industrial Piping, Inc. Order No. 7127  
(Name and Address of Fabricator) Kernersville, N. C.2. Fabricated for Duke Power Company Charlotte, N. C. Order No. C-12517  
(Name and Address)3. Owner Duke Power Company 4. Location of Plant Newport, S. C.5. Piping System Identification MAIN STEM  
(Brief description of intended use, main coolant etc.)(a) Drawing No. CT-01-17X Prepared by ITT Grinnell Industrial Piping, Inc.  
(b) National Board No. N/A6. The material, design, construction, and workmanship complies with ASME Code Section III, Class NUC.2Edition 1974, Addenda Date Winter 1974, Case No. N/ARemarks: Manufacturers' Data Reports properly identified and signed by Commissioned Inspectors have been furnished for  
the following items of this report N/A  
(Name of Part - Item number, Manufacturer's name, and Identifying stamp)Supplemental Sheets #2 --- Drawings  
#3 --- Bill(s) of Material7. Shop Hydrostatic Test Field psi.8. Description of piping inspected Piece Mark Number CT-SM-68  
(include - mark no. - material spec. - nom. pipe size - schedule or thickness - length  
- fittings - flanges, etc.)

See Attached Sheets

We certify that the statements made in this report are correct and that the fabrication of the described piping confor-  
with the requirements of SECTION III of the ASME BOILER AND PRESSURE VESSEL CODE.Date 9-15-77 Signed ITT Grinnell Ind. Piping, Inc. By Thomas A. Smith  
(Fabricator)Certificate of Authorization Expires 7-16-79 Certificate of Authorization No. A-1756

## CERTIFICATE OF SHOP INSPECTION

I, the undersigned, holding a valid commission issued by the National Board of Boiler and Pressure Vessel Inspectors and/or the State or Province of Maryland and employed by \* \_\_\_\_\_ of Hartford, CT. have inspected the piping described in this Data Report on 9-15-77, and state as to the best of my knowledge and belief, the Manufacturer has constructed this piping in accordance with the applicable Subsections of ASME Code, Section III. The Hartford Steam Boiler Inspection and Insurance Company. By signing this certificate, neither the Inspector nor his employer make any warranty, expressed or implied, concerning the piping in this Data Report. Furthermore, neither the Inspector nor his employer shall be liable in any manner for any personal injury or property damage, or a loss of any kind arising from or connected with this inspection.

Date 9-15-77 C. D. Brown Commissioned 09/77  
(Inspector) National Board, State, Province and No.

\* Supplemental sheets in form of lists, schedules or drawings may be used provided (1) size is  $8\frac{1}{2} \times 11\frac{1}{2}$ , (2) information in Items 1, 2 and 5 on this Data Report is included on each sheet, and (3) each sheet contains a list of parts or subassemblies present in the piping system.

**ITT Grinnell Industrial Piping Inc.**  
KERNERSVILLE, N.C.

FORM EN-101 REV 1/78  
Q.A. FORM H2.1C

Sheet 2 of 3

INT. NO 7127

NAME DUKE POWER COMPANY  
LOCATION CATAWBA UNIT #1

DRWNS-N-42-30-2-76 CHK'D PG 11-1-76  
REV. A 4-21-77 CHKD PG  
REV. A 5-15-77 CHKD FG  
REV. \_\_\_\_\_ CHKD \_\_\_\_\_


NOTE:- LENGTH OF A-H PLUG SHALL  
BE  $\pm \frac{1}{16}$ " OF ACTUAL WALL THK.  
SHOP SHALL GRIND TO FIT, IF REQD.

2

DUKE POWER COMPANY  
CHARLOTTE, N.C.

C-12517

7 1  $\frac{1}{8}$ " ACCESS HOLE PLUG  
PER CT-AH-1  
H = 1-750"

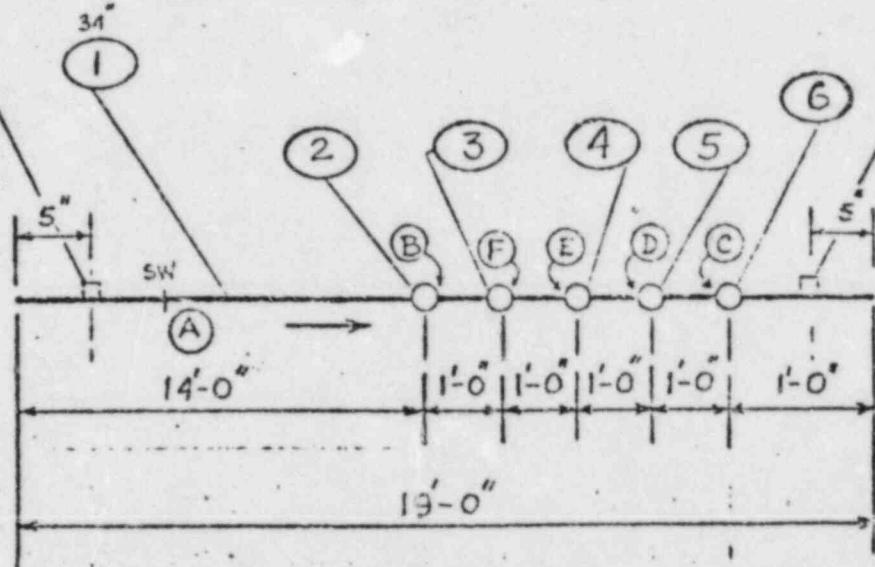

8 1  $\frac{1}{8}$ " ACCESS HOLE  
PLUG PER  
CT-AH-1  
H = 1-750"

MACHINE END  
PER SKETCH CT-D-2

Nuclear Safety Related

ASS DUKE B

LINE SPEC. PS-1500-5 (OH)

APP. CODE III, CL 2 NO. REQ'D

radiography (RT)	<input checked="" type="checkbox"/>	Special Marking	<input checked="" type="checkbox"/>	Preheat	<input checked="" type="checkbox"/>	Cert. of Compliance	
Ion Particle (IP)	<input checked="" type="checkbox"/>	Special Cleaning	<input checked="" type="checkbox"/>	Heat Treat	<input checked="" type="checkbox"/>	Mill Test Reports	<input checked="" type="checkbox"/>
Penetrant (PT)	<input checked="" type="checkbox"/>	Painting	<input checked="" type="checkbox"/>	Code Stamp	<input checked="" type="checkbox"/>	Data Reports	<input checked="" type="checkbox"/>

SYSTEM MAIN STEAM (SM)

FAB. SPECS. J.S.18

DE. DRWG NO. CT-1491-SM-002

PRESS. 1230 PSI TEMP. 600°F. WT 4024 LBS.

DE MARK CT-SM-6B

REGISTER CT-01-17X

D

Duke Power Company/Catawba, NC / C-12517

Project No. C-12517-X

P/NM STEAM

DUKE POWER COMPANY

Plant Name C-12517-B

MATERIALS RECORD  
PRODUCTION PLANNING

Revision No. A.M. Revision Date

Contract No. 7127 Location

PART NUMBER	DESCRIPTION	QTY ON	QUALITY CONTROL	NUMBER DOCUMENTATION PROCESSED	STAGE	UNIT PRICE	D.Q.	ACCOUNTING STATE	VARIANCE	NET
C-12517-X-01	31.430" I.DX15750 MV, SMLS C.S., PIPE TO ASME SA-106 C	19.0	5.4003	24547	17	E	-2	P-7	TRG	P-7
C-12517-X-02	3/4" 300CIT CS, SPECIAL WELD BOSS TO SA-105, PER DET. K.D.P. C.T.-WEB-1	1	AUA	100	1	E				
C-12517-X-03	DITTO	1	AUA	100	1	E				
C-12517-X-04	DITTO	1	AUA	100	1	E				
C-12517-X-05	DITTO	1	AUA	100	1	E				
C-12517-X-06	DITTO	1	AUA	100	1	E				
C-12517-X-07	DITTO	1	AUA	100	1	E				
C-12517-X-08	DITTO	1	AUA	100	1	E				
C-12517-X-09	DITTO	1	AUA	100	1	E				
C-12517-X-10	1 1/8" ACCESSORIAL PLUG PFR C.T.-A111-SA-105, H-1750	1	ABE	100	1	E				
C-12517-X-11	DITTO	1	ABE	100	1	E				

Code: NEMA Gen. lit. Cl. 2 Class: Duke 'B'

Nuclear Safety Policy

J.3 Supplement T.S.H.O.

MFG. Code

7/11

10F3

**FORM NPP-1 DATA REPORT FOR FABRICATED NUCLEAR PIPING SUBASSEMBLIES\***  
 (As Required by the Provisions of the ASME Code Rules)

1. Fabricated by ITT Grinnell Ind. Piping, Inc., Kernersville Order No. 7127  
 (Name and Address of Fabricator) NC

2. Fabricated for Duke Power Company, Charlotte, NC Order No. C12517  
 (Name and Address)

3. Owner Duke Power Company 4. Location of Plant Newport, SC

5. Piping System Identification MAIN STEAM  
 (Brief description of intended use, main coolant etc.)

(a) Drawing No. CT-01-27X Prepared by ITT GRINNELL INDUSTRIAL PIPING CO. INC.  
 (b) National Board No. N/A

6. The material, design, construction, and workmanship complies with ASME Code Section III, Class N-2  
 Edition 1974, Addenda Date Winter 1974, Case No. N/A

Remarks: Manufacturer's Data Reports properly identified and signed by Commissioned Inspectors have been furnished for  
 the following items of this report N/A  
 (Name of Part - Item number, Manufacturer's name, and Identifying stamp)

Supplemental Sheets	<u>2</u>	---Drawings
	<u>3</u>	---Bill (s) of Material

7. Shop Hydrostatic Test Field psi.

8. Description of piping inspected Piece Mark Number CT-5M-6C  
 (include - mark no. - material spec. - nom. pipe size - schedule or thickness - length  
 - fittings - flanges, etc.)  
See Attached Sheets

We certify that the statements made in this report are correct and that the fabrication of the described piping conforms  
 with the requirements of SECTION III of the ASME BOILER AND PRESSURE VESSEL CODE.

Date 3-23-78 Signed ITT Grinnell Ind. Piping, Inc. By Thomas A. Smith  
 (Fabricator)

Certificate of Authorization Expires 7-16-79 Certificate of Authorization No. N 1456

**CERTIFICATE OF SHOP INSPECTION**

I, the undersigned, holding a valid commission issued by the National Board of Boiler and Pressure Vessel Inspectors  
 and/or the State or Province of MD and employed by \* of Hartford, CT.  
 have inspected the piping described in this Data Report on 3/24/1978, and state that to the best of my knowledge  
 and belief, the Manufacturer has constructed this piping in accordance with the applicable Subsections of ASME Code,  
 Section III. The Hartford Steam Boiler Inspection and Insurance Co.  
 By signing this certificate, neither the Inspector nor his employer make any warranty, expressed or implied, concerning  
 the piping in this Data Report. Furthermore, neither the Inspector nor his employer shall be liable in any manner  
 for any personal injury or property damage or a loss of any kind arising from or connected with this inspection.

Date 3/24/78 Commission MD 128  
 (Inspector) John Donaldson National Board, State, Province and No.

\* Supplemental sheets in form of lists, sketches or drawings may be used provided (1) size is 8½" x 11", (2) information in Items 1, 2 and 5  
 on this data report is included on each sheet, and (3) each sheet is numbered and number of sheets is recorded in Item 7, "Remarks".  
 Printed in U.S.A. (2/73)

**ITT Grinnell Industrial Piping Inc.**  
KERNERSVILLE, N. C.

FORMEN-101 REV 7/7  
QA FORM N21C

20F3

CONT. NO: 7127

NAME DUKE POWER COMPANY  
LOCATION CATAWBA UNIT #1

Charlotte NC

Po C 12517

→ REDRWN 10-23-77

REV. PG 2-29-78

REV. \_\_\_\_\_

REV. \_\_\_\_\_


CHK'D PG

CHK'D 10-23-78

CHK'D \_\_\_\_\_

CHK'D \_\_\_\_\_

CHK'D \_\_\_\_\_

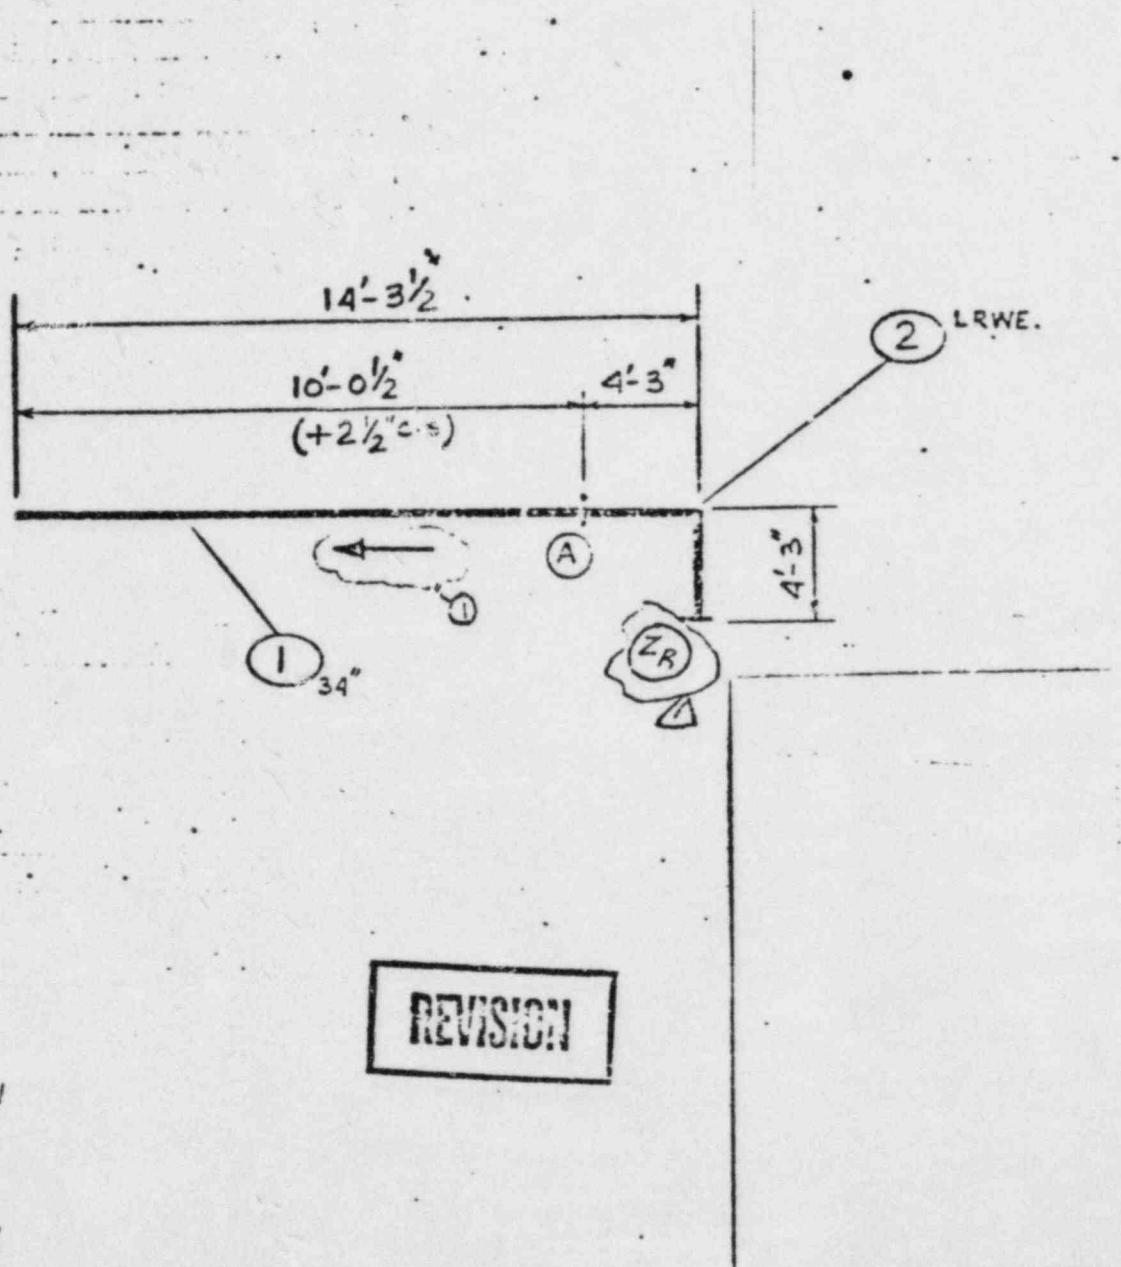

PIPE: 31-4381DX-750MW.  
SA-106C

FLG:

D. W. FITG: SA-234WFB-W

F. S. FITG: OR SA-234WFC

PAINT FLOW ARROWS

MACHINE ENDS  
PER SKETCH CT-D-2

Nuclear Safety Related

CLASS DUKE B

LINE SPEC. PS 1500-5(9)

APP. CODES ASME III CL 2

NO. REQ'D 1

Radiography (RT)	✓	Special Marking		Preheat	✓	✓	Cert. of Compliance
Mag. Particle (MP)	✓	Special Cleaning		Heat Treat	✓	✓	Mill Test Reports
Liq. Penetrant (PT)		Painting		Code Stamp	✓	✓	Data Reports

SYSTEM MAIN STEAM (SM)

FAB. SPEC'S JS 118

REF. DRWG NO. SN-1491-5M1001 REV 2

PRESS. 1185 PSI TEMP. 600 °F. WI 120E1 LBS.

PIECE MARK CT-SM-6C

①

REGISTER CT cl-27 X

## GRINNELL INDUSTRIAL PIPING, INC.

KERNERSVILLE N.C.

FORM EN-102 REV 7/78  
Q.A. FORM N2.1F

H-P

Register No. CT-01-27X

MATERIALS RECORD  
PRODUCTION PLANNER

Sheet 3 Of 3

Revision No. Revision Date

Piece Mark CT-SM-6C

Job Name CATAWBA UNIT #1

DUKE POWER COMPANY

CHARLOTTE NC

Contract No. 7127

Location

ITEM	PART NUMBER	DESCRIPTION	QUAN OR LENG	QUALITY CONTROL			ACCOUNTING/MATERIAL		
				HEAT NUMBER	DOCUMENTATION PROCESS	STATUS	U/M	UNIT PRICE P.O.	DIS. VENDOR
1	P.B.C.T.C.P. 3.4" CT-01-15-1	31.438" I.D X 1.750" MW SMLS CS PIPE TO ASME SA-106C	1	L3274 P76 SN 26914Y	O.C. 1PI 150	7/6 2-20-78	F		
2	L.A.A.T.C.Y. 3.4" CT-01-18-1	31.438" I.D X 1.750" MW 90° L.P.W.C TO SA-234WPC-W MADE FROM SA-515 GR-70 PLATE (70,000 PSI TENSILE), OR TO SA-234WPC SMLS ENDS PER DET. CT-D-2	1	ARAR Buf-19 51m	O.C. 1PI 150	7/7 2-20-78	E		Head
	3.4	SP. END PROT. PER CT-EP-1	2				E		RECEIVED
	3.4	SPIDER BRACING PER CT-ES-1	2				E		MB 2077
				SHOP COPY LAYOUT					
									12/19 BCM

Code Ame. Soc. HIC CL 2

Class DUKE B

Nuclear Safety Related

Job Supplement

J.S.118

MFG. Code

**FORM NPP-1 DATA REPORT FOR FABRICATED NUCLEAR PIPING SUBASSEMBLIES\***  
 (As Required by the Provisions of the ASME Code Rules)

10F3

1. Fabricated by ITT Grinnell Ind. Piping, Inc., Kernersville Order No. 7127  
 (Name and Address of Fabricator)

2. Fabricated for Duke Power Company, Charlotte, NC Order No. C-12517  
 (Name and Address)

3. Owner Duke Power Company 4. Location of Plant Newport, SC

5. Piping System Identification MAIN STEAM  
 (Brief description of intended use, main coolant etc.)

(a) Drawing No. CT-01-36X Prepared by ITT Grinnell Industrial Piping, Inc.  
 (b) National Board No. N/A

6. The material, design, construction, and workmanship complies with ASME Code Section III, Class N-2  
 Edition 1974, Addenda Date Winter 1974, Case No. N/A

Remarks: Manufacturers' Data Reports properly identified and signed by Commissioned Inspectors have been furnished for  
 the following items of this report N/A  
 (Name of Part - Item number, Manufacturer's name, and identifying stamp)

Supplemental Sheets 8 ----Drawings  
3 ----Bill (s) of Material

7. Shop Hydrostatic Test Field psi.

8. Description of piping inspected Piece Mark Number CT-SM-6D  
 (Include - mark no. - material spec. - nom. pipe size - schedule or thickness - length  
 See Attached Sheets  
 - fittings - flanges, etc.)

We certify that the statements made in this report are correct and that the fabrication of the described piping conforms  
 with the requirements of SECTION III of the ASME BOILER AND PRESSURE VESSEL CODE.

Date 5-23-78 Signed ITT GRINNELL By Thomas A. Smith  
 Ind. Piping, Inc. (Fabricator)

Certificate of Authorization Expires 7-16-79 Certificate of Authorization No. N1456

**CERTIFICATE OF SHOP INSPECTION**

I, the undersigned, holding a valid commission issued by the National Board of Boiler and Pressure Vessel Inspectors and/or the State or Province of Maryland and employed by \* of Hartford, CT. have inspected the piping described in this Data Report on 5/31/1978, and state that to the best of my knowledge and belief, the Manufacturer has constructed this piping in accordance with the applicable Subsections of ASME Code, Section III.\*The Hartford Steam Boiler Inspection and Insurance Co. By signing this certificate, neither the Inspector nor his employer make any warranty, expressed or implied, concerning the piping in this Data Report. Furthermore, neither the Inspector nor his employer shall be liable in any manner for any personal injury or property damage or a loss of any kind arising from or connected with this inspection.

Date 5/31/1978 Commission On Island - 94  
 Inspector Richard L. Shorley Nations' Board, State, Province and No.

\*Supplemental sheets in form of lists, sketches or drawings may be used provided (1) size is 8½" x 11", (2) information in Items 1, 2 and 3 on this data report is included on each sheet, and (3) each sheet is numbered and number of sheets is recorded in Item 7, "Remarks".

# ITT Grinnell Industrial Piping Inc.


KERNERSVILLE, N. C.

FORM 115  
Q.A. FORM N2.1C  
2183

CONT. NO. 7127

NAME DUKE POWER COMPANY  
LOCATION CATAWBA UNIT #1  
Charlotte NC.  
P.O. C12517

REF DRW'N A 153-17-78 CHK'D 153-17-78  
REV. \_\_\_\_\_ CHK'D \_\_\_\_\_  
REV. \_\_\_\_\_ CHK'D \_\_\_\_\_  
REV. \_\_\_\_\_ CHK'D \_\_\_\_\_

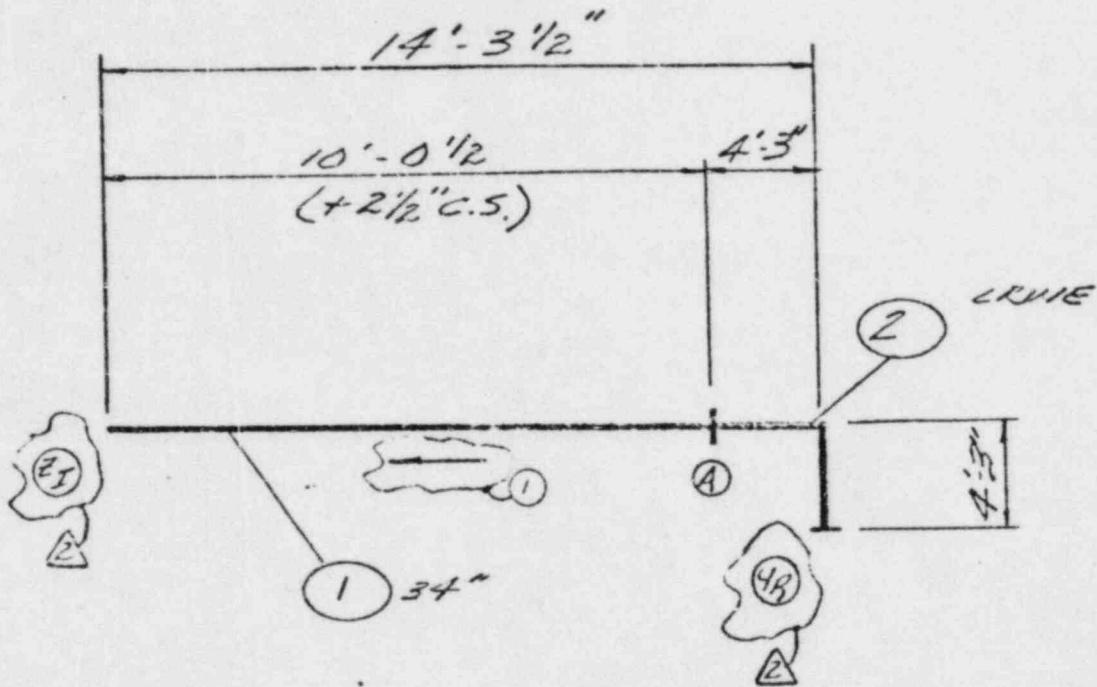

PIPE: 3A-438 "ID X 1.750" min.  
SA-106-C  
FLG:  
B. W. FITG: SA - 234 WPC - VI  
F. S. FITG: OK SA - 234 WPC.

## PAINT FLOW ARROWS

OUTLINE DRAWING

MACHINE ENDS  
PER SKETCH CT-D-2

Nuclear Safety Related

CLASS DUKE "B" LINE SPEC. PS 1500.5(01) APP. CODE Sec. III, CL 2 NO. REQ'D /

Radiography (RT)	<input checked="" type="checkbox"/>	Special Marking		Preheat	<input checked="" type="checkbox"/>	Cert. of Compliance	
Mag. Particle (MT)	<input checked="" type="checkbox"/>	Special Cleaning	<input checked="" type="checkbox"/>	Heat Treat	<input checked="" type="checkbox"/>	Mill Test Reports	<input checked="" type="checkbox"/>
Liq. Penetrant (PT)		Painting	<input checked="" type="checkbox"/>	Code Stamp	<input checked="" type="checkbox"/>	Data Reports	<input checked="" type="checkbox"/>

SYSTEM 153-17-78 (501) FAB. SPECS. JS-113  
REF. DRW'G NO. C11-1411-5000-112 PRESS. 1125 PSI. TEM. 200 °F. WT 1200 LBS.

PIECE MARK CT-500-6D

REGISTER | LD LV LD LV

**GRINNELL INDUSTRIAL PIPING, INC.**

KERNERSVILLE N.C.

FORM EN-102 REV 7/15  
Q.A. FORM N2.1F

U.P.

Register No. CT-01-36X

**MATERIALS RECORD  
PRODUCTION PLANNER**

Sheet 3 of 3

Piece Mark CT-SM-6D

Job Name CATAWBA UNIT #

Contract No. 7127

Location

Code Name, Sec. III, Cl. 2

Class DUKE B

## Nuclear Safety Related

Job Supplement JS 118

MFG. Code

## FORM NPP-1 DATA REPORT FOR FABRICATED NUCLEAR PIPELINE SUBASSEMBLIES\*

(As Required by the Provisions of the ASME Code Rules)

*Sister for 3*1. Fabricated by ITT Grinnell Piping, Inc., Kernersville Order No. 7128  
(Name and Address of Fabricator)2. Fabricated for Duke Power Company, Charlotte, NC Order No. C-12517  
(Name and Address)3. Owner Duke Power Company 4. Location of Plant Newport, SC5. Piping System Identification MAIN STEAM  
(Brief description of intended use, main coolant etc.)(a) Drawing No. CT-01-Ex Prepared by ITT Grinnell Industrial Piping, Inc.  
(b) National Board No. N/A6. The material, design, construction, and workmanship complies with ASME Code Section III, Class A-2  
Edition 1974, Addenda Date Winter 1974, Case No. N/ARemarks: Manufacturers' Data Reports properly identified and signed by Commissioned Inspectors have been furnished for  
the following items of this report N/A  
(Name of Part - Item number, Manufacturer's name, and identifying stamp)Supplemental Sheets 2 --- Drawings  
3 --- Bill (s) of Material7. Shop Hydrostatic Test Field psi.8. Description of piping inspected Piece Mark Number CT-SM-7A  
(include - mark no. - material spec. - nom. pipe size - schedule or thickness - length  
- fittings - flanges, etc.)  
See Attached SheetsWe certify that the statements made in this report are correct and that the fabrication of the described piping conforms  
with the requirements of SECTION III of the ASME BOILER AND PRESSURE VESSEL CODE.Date 10-27-78 Signed Ind. Piping, Inc. By Jasper D. L.  
(Fabricator)Certificate of Authorization Expires 7-16-79 Certificate of Authorization No. N-1456

## CERTIFICATE OF SHOP INSPECTION

I, the undersigned, holding a valid commission issued by the National Board of Boiler and Pressure Vessel Inspectors and/or the State or Province of N.C. \* and employed by Hartford, CT. have inspected the piping described in this Data Report on 10-30-1978, and state that to the best of my knowledge and belief, the Manufacturer has constructed this piping in accordance with the applicable Subsections of ASME Code, Section III.\*The Hartford Steam Boiler Inspection and Insurance Co. By signing this certificate, neither the Inspector nor his employer make any warranty, expressed or implied, concerning the piping in this Data Report. Furthermore, neither the Inspector nor his employer shall be liable in any manner for any personal injury or property damage or a loss of any kind arising from or connected with this inspection.

Date 10-30-1978  
\_\_\_\_\_  
(Inspector)Commission No. N.C. - NO. 878  
National Board, State, Province and No.


\* Supplemental sheets in form of lists, sketches or drawings may be used provided (1) size is 8½" x 11", (2) information in Items 1, 2 and 5 on this data report is included on each sheet, and (3) each sheet is numbered and number of sheets is recorded in Item 7, "Remarks".

**ITT Grinnell Industrial Piping Inc.**  
Raleigh, North Carolina

Sheet 2/2

PROJ. NO. 7127  
NAME DUKE POWER COMPANY  
LOCATION CATAWBA UNIT 21  
Charlotte, N.C.  
No. C-1A517

→ P/D/RWNS-0442-23277... CHKD PG.  
REV. 0 Rev. 12-04-77 CHKD L1  
REV. 1 Rev. 12-04-78 CHKD L1  
REV. 2 Rev. 12-04-78 CHKD L1

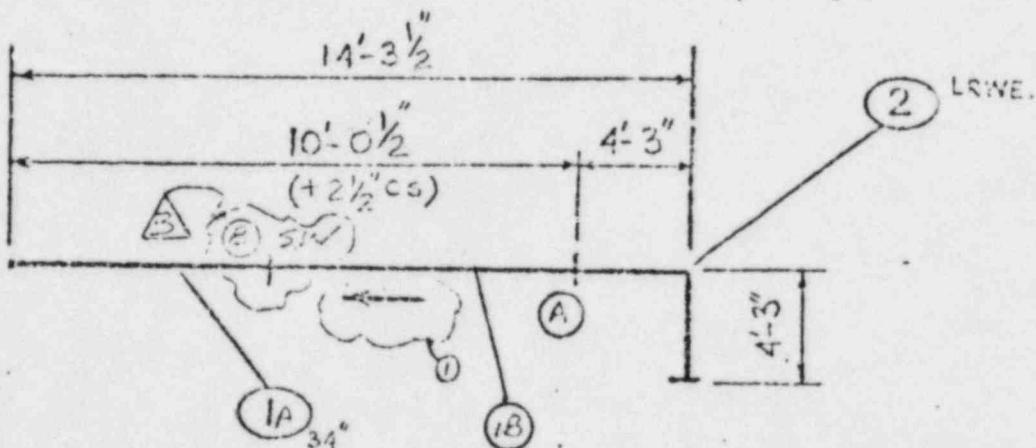

PIPE: 3H-438 X 1-750MW  
SA-106C.

FLG:

D. W. FITG; SA-234WPB-W, OR  
SA-234WPC.

F. S. FITG:

PAINT FLOW ARROWS

## QUALITY CONTROL

MACHINE ENDS  
PER SKETCH CT-D-2

## Nuclear Safety Related

ASS	DARKLE R.	LINE SPEC. P.S. 1500-5(01)	APP. CODE & SEC. SEE III, CL 2	NO. REQ'D.	A
Graphy (RT)	<input checked="" type="checkbox"/>	Serial Marking	Preheat	<input checked="" type="checkbox"/>	Cert. of Compliance
Particles (PT)	<input checked="" type="checkbox"/>	Steel Cleaning	Heat Treat	<input checked="" type="checkbox"/>	Melt Test Reports
Painted (PT)	<input checked="" type="checkbox"/>	Painting	Code Stamp	<input checked="" type="checkbox"/>	Data Reports
STEM MAINT TEAM (SM)			FOR SIGNATURE	J.S.J.8	
DRIVING C.H.1791-SM002(ZEEZ)			PRESSURE	113.5 psi	TIME, 500 °F. w/ 100% LES
REMARKS	C.T.-SM-7A				REGISTER C.T.-OH-BX



**FORM NPP-1 DATA REPORT FOR FABRICATED NUCLEAR PIPE SUBASSEMBLIES\***  
**(As Required by the Provisions of the ASME Code Rules)**

**SHEET 1 OF 3**

1. Fabricated by ITT Grinnell Ind. Piping, Inc., Kernersville Order No. 7127  
(Name and Address of Fabricator)

2. Fabricated for Duke Power Company, Charlotte, NC Order No. C-12517  
(Name and Address)

3. Owner Duke Power Company 4. Location of Plant Newport, SC

5. Piping System Identification MAIN STEAM  
(Brief description of intended use, main coolant etc.)

(a) Drawing No. CT-01-18X Prepared by ITT Grinnell Industrial Piping, Inc.  
(b) National Board No. N/A

6. The material, design, construction, and workmanship complies with ASME Code Section III, Class N-2  
Edition 1974, Adherence Date Winter 1974, Case No. N/A

Remarks: Manufacturers' Data Reports properly identified and signed by Commissioned Inspectors have been furnished for  
the following items of this report N/A  
(Name of Part - Item number, Manufacturer's name, and Identifying stamp)

Supplemental Sheets 2 ---- Drawings  
3 ---- Bill (s) of Material

7. Shop Hydrostatic Test Field psig

8. Description of piping inspected Piece Mark Number CT-SM-7B  
(include - mark no. - material spec. - nom. pipe size - schedule or thickness - length  
See Attached Sheets  
- fittings - flanges, etc.)

We certify that the statements made in this report are correct and that the fabrication of the described piping conforms  
with the requirements of SECTION III of the ASME BOILER AND PRESSURE VESSEL CODE.

Date 5-17-78 Signed ITT GRINNELL By Thomas A. Smith  
(Fabricator)

Certificate of Authorization Expires 7-16-79 Certificate of Authorization No. N-1456

**CERTIFICATE OF SHOP INSPECTION**

I, the undersigned, holding a valid commission issued by the National Board of Boiler and Pressure Vessel Inspectors  
and/or the State or Province of Maryland and employed by \* of Hartford, CT.  
have inspected the piping described in this Data Report on 5/18 1978, and state that to the best of my knowledge  
and belief, the Manufacturer has constructed this piping in accordance with the applicable Subsections of ASME Code,  
Section III.\*The Hartford Steam Boiler Inspection and Insurance Co.  
By signing this certificate, neither the Inspector nor his employer make any warranty, expressed or implied, concerning  
the piping in this Data Report. Furthermore, neither the Inspector nor his employer shall be liable in any manner  
for any personal injury or property damage or a loss of any kind arising from or connected with this inspection.

Date 5/18 1978 Inspector Richard L. Shortley Commission Maryland - 44  
(Inspector) (National Board, State, Province and No.)

\* Supplemental sheets in form of lists, sketches or drawings may be used provided (1) size is 8½" x 11", (2) information in items 1, 2 and 5  
on this data report is included on each sheet, and (3) each sheet is numbered and number of sheets is recorded in item 7, "Remarks".  
Printed in U.S.A. (2/73)

**ITT Grinnell Industrial Piping Inc.**  
KERNERSVILLE, N.C.

FORM EN-101 REV 1/76  
Q.A. FORM 92-1C

sheet 2 of 3

CONT. NO. 7127

NAME DUKE POWER COMPANY  
LOCATION C-TAWA UNIT #1  
Charlotte, N.C.  
C-12517

→ REDRWN'S M 12-28-77

REV. ① SM 12-14-77

REV. ② PG 2-21-79


REV. \_\_\_\_\_

CHK'D PG

CHK'D PG

CHK'D E&E 3-2-79

CHK'D \_\_\_\_\_

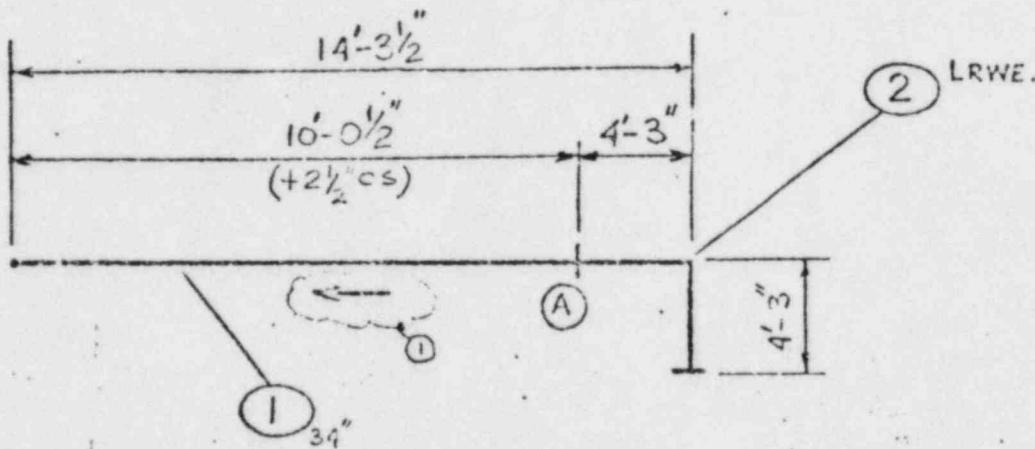

PIPE: 31-435 I-DYI-7EDMW  
SA-1060

FLG:

B. W. FITG: SA-234WPG-W  
CREA-234WPC

F. S. FITG:

**QUALITY CONTROL**

PAINT FLOW ARROWS

**REVISION**

MACHINE THIS  
PER SKETCH CT-D-2

Nuclear Safety Related

CLASS DUKE B LINE SPEC. PS 1500-5 (Q1) APP. CODE ASME Sec. III, CL 2 NO REQD 1

Radiography (RT)	✓	Special Marking		Preheat	↗	✓	Cert. of Compliance
Mag. Particle (MT)	✓	Special Cleaning	✓	Heat Treat	✓	✓	Mill Test Reports
Liq. Penetron (LP)		Painting	✓	Code Stamp	✓	✓	Data Reports

SYSTEM MAIN STEAM (SMI)

FAB. SPEC. JS 48

REF. DRWG NO. CN-1491-SM002 (REV. 3)

PRESS. 1135 psi. TEMP. 600 °F. WT 12,651 lbs.

PIECE MARK C.T.-S.M. 7B

REGISTER CT-CI-1SX



**FORM NPP-1 DATA REPORT FOR FABRICATED NUCLEAR PIPELINE SUBASSEMBLIES\***  
**(As Required by the Provisions of the ASME Code Rules)**

*Start 1 of 5*

1. Fabricated by ITT Grinnell Ind. Piping, Inc., Kernersville Order No. 7127  
     (Name and Address of Fabricator)

2. Fabricated for Duke Power Company, Charlotte, NC Order No. C-12517  
     (Name and Address)

3. Owner Duke Power Company 4. Location of Plant Newport, SC

5. Piping System Identification MAIN STREAM  
     (Brief description of intended use, main coolant etc.)

(a) Drawing No. CT-01-37X Prepared by ITT Grinnell Industrial Piping, Inc.  
     (b) National Board No. N/A

6. The material, design, construction, and workmanship complies with ASME Code Section III, Class N-2  
     Edition 1974, Adenda Date Winter 1974, Case No. N/A

Remarks: Manufacturers' Data Reports properly identified and signed by Commissioned Inspectors have been furnished for  
     the following items of this report NA  
     (Name of Part - Item number, Manufacturer's name, and identifying stamp)

Supplemental Sheets 2 Drawings  
     3,4,5 Bill (s) of Material

7. Shop Hydrostatic Test Field psi.

8. Description of piping inspected Piece Mark Number CT-SM-7D  
     (include - mark no. - material spec. - nom. pipe size - schedule or thickness - length  
     See Attached Sheets  
     - fittings - flanges, etc.)

We certify that the statements made in this report are correct and that the fabrication of the described piping conforms  
     with the requirements of SECTION III of the ASME BOILER AND PRESSURE VESSEL CODE.  
     Date 1-26-79 Signed ITT GRINNELL by Kenall H. [Signature]  
     Signed Ind. Piping, Inc. by [Signature]  
     (Fabricator)

Certificate of Authorization Expires 7-16-79 Certificate of Authorization No. N-1456

**CERTIFICATE OF SHOP INSPECTION**

I, the undersigned, holding a valid commission issued by the National Board of Boiler and Pressure Vessel Inspectors  
     and/or the State or Province of N.C. and employed by \* of Hartford, CT.  
     have inspected the piping described in this Data Report on 1-26-79, and state that to the best of my knowledge  
     and belief, the Manufacturer has constructed this piping in accordance with the applicable Subsections of ASME Code,  
     Section III.\*The Hartford Steam Boiler Inspection and Insurance Co.  
     By signing this certificate, neither the Inspector nor his employer make any warranty, expressed or implied, concerning  
     the piping in this Data Report. Furthermore, neither the inspector nor his employer shall be liable in any manner  
     for any personal injury or property damage or a loss of any kind arising from or connected with this inspection.

Date 1-26-79 Inspector Barry R. Bobo Commissions N.C. - No. 878  
     National Board, State, Province and No.

\* Supplemental sheets in form of lists, sketches or drawings may be used provided (1) size is 8½" x 11", (2) information in items 1, 2 and 5  
     on this data report is included on each sheet, and (3) each sheet is numbered and number of sheets is recorded in item 7, "Remarks".

CT-SM-7D



**GRINNELL INDUSTRIAL PIPING, INC.**

Register No. CT-01-37X

Sister. Mrs. Smit

Piece Mark C T-SM-7D

Job Name

DUKE POWER COMPANY, CHARLOTTE, N.C.  
CATAWBA UNIT #1 Contract No.

CATAWBA UNIT #1


CLIPPER 6-12517

Sheet 3 of 35

CA FORM N3-1E

G.A. FORM N2.1F

H-P

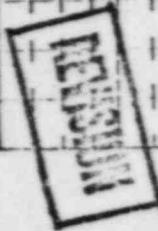

Am. Soc. III, Cl. 2

Class DUKE 'B'

### Nuclear Safety Related

**Job Supplement** to **Table I**

MFG. Code

# GRINNELL INDUSTRIAL PIPING, INC.

Kennesaw, Ga., U.S.A.

Register No. CT-01-37X

System: Man System

Piece Mark CT-SM-7D

MATERIALS RECORD

PRODUCTION PLANNER

DUKE POWER COMPANY CHARLOTTE, NC

CATAWBA UNIT #1

Job Name C-Duct #C-725/2

MATERIALS RECORD SHEET

Revision No. A

Revision Date 6/6/78

Location

Contract No. 7127

ACCOUNTING/MATERIAL

PART NUMBER	DESCRIPTION	QUALITY CONTROL			DIS. P.O.	UNIT PRICE	DIS. VENDOR	NET.
		HEAT NUMBER	DOCUMENT	PROCESS				
4 CT-2095-2	10" X 8" O.D. FORGED C.S. TRANSITION PC; MATERIAL TO ASME (SA-105 HT.) Z (L = LENGTH = 6") (PER DET. CT-SM-3)				E			
5 CT-2095-2	DITTO				E			
6 CT-2095-2	DITTO				E			
7 CT-2095-2	DITTO				E			
8 CT-2095-2	DITTO				E			
9 CT-3002-2	1" <sup>A</sup> SCS SP.WELD BOSS TO SA-105 PER DET. SK.CT-WB-1				E			
10 CT-3002-2	DITTO				E			
11 CT-3002-2	DITTO				E			
12 CT-3002-2	DITTO				E			

Nuclear Safety Related

Code

Class DUKE B

Job Supplement JS 118

MFG. Code

**GRINNELL INDUSTRIAL PIPING, INC.**

Kansas City, Mo.

Register No. C T-01-37X

System: Major System

Piece Mark CT-SM-7D

Job Name

DUKE POWER COMPANY CHARLOTTE, N.C.  
CATAWBA UNIT #1 Contract No. <sup>Re</sup>

## CATAWBA UNIT #1

## MATERIALS RECORD PRODUCTION PLANNER

Sheet

35 or 35

Revision No. 10

RevisionDate 5-10-78

Am. Sec. III, Cl. 2

Class DUKE B.

John S. Summer JS 118

MFG. Code

## Nuclear Safety Related

## FORM NPP-I DATA REPORT FOR FABRICATED NUCLEAR PIPELINE ASSEMBLIES\*

(As Required by the Provisions of the ASME Code Rules)

ICFS

1. Fabricated by ITT Grinnell Ind. Piping, Inc. Kernersville Order No. 7128  
(Name and Address of Fabricator)2. Fabricated for Duke Power Company, Charlotte, NC Order No. C-12517  
(Name and Address)3. Owner Duke Power Company 4. Location of Plt. Newport, SC5. Piping System Identification MAIN - Steam  
(Brief description of intended use, main coolant etc.)(a) Drawing No. CT-11-26X Prepared by ITT Grinnell Industrial Piping, Inc.  
(b) National Board No. N/A6. The material, design, construction, and workmanship complies with ASME Code Section III, Class N-2  
Edition 1974, Addenda Date Winter 1974, Case No. N/ARemarks: Manufacturers' Data Reports properly identified and signed by Commissioned Inspectors have been furnished for  
the following items of this report N/A  
(Name of Part - Item number, Manufacturer's name, and identifying stamp)Supplemental Sheets 2 ----Drawings  
3,4,5 ----Bill (s) of Material7. Shop Hydrostatic Test Field psig8. Description of piping inspected Piece Mark Number CT-SM-7C  
(include - mark no. - material spec. - nom. pipe size - schedule or thickness - length  
- fittings - flanges, etc.)  
See Attached SheetsWe certify that the statements made in this report are correct and that the fabrication of the described piping conforms  
with the requirements of SECTION III of the ASME BOILER AND PRESSURE VESSEL CODE.Date 10-30-78 Signed ITT GRINNELL Ind. Piping, Inc. by James G. Hendon  
(Fabricator)Certificate of Authorization Expires 7-16-79 Certificate of Authorization No. N-1456

## CERTIFICATE OF SHOP INSPECTION

I, the undersigned, holding a valid commission issued by the National Board of Boiler and Pressure Vessel Inspectors and/or the State or Province of Connecticut and employed by Hartford, CT of Hartford, CT, have inspected the piping described in this Data Report on 11-1-78, and state that to the best of my knowledge and belief, the Manufacturer has constructed this piping in accordance with the applicable Subsections of ASME Code, Section III.\*The Hartford Steam Boiler Inspection and Insurance Co. By signing this certificate, neither the Inspector nor his employer make any warranty, expressed or implied, concerning the piping in this Data Report. Furthermore, neither the Inspector nor his employer shall be liable in any manner for any personal injury or property damage or a loss of any kind arising from or connected with this inspection.

Date 11-1-78 + 1978 Commissions 11-1-91  
(Inspector) John J. Hendon National Board, State, Province and No.

\* Supplemental sheets in form of lists, sketches or drawings may be used provided (1) size is 8½" x 11", (2) information in Items 1, 2 and 5 on this data report is included on each sheet, and (3) each sheet is numbered and number of sheets is recorded in Item 7, "Remarks".  
Printed in U.S.A. (2/73)

**ITT** Grinnell Industrial Piping Inc.  
KERNERSVILLE, N.C.


PO: 300-1001-5  
Q.A. FG. WH-21C

CONT. NO. 7127

NAME DUKE POWER COMPANY  
LOCATION CARMELA UNIT #1

**Charlotte, N.C.** C-12517

REDRWN	12-25-77	CHK'D
REV	12-14-77	CHK'D
	12-14-77	CHK'D

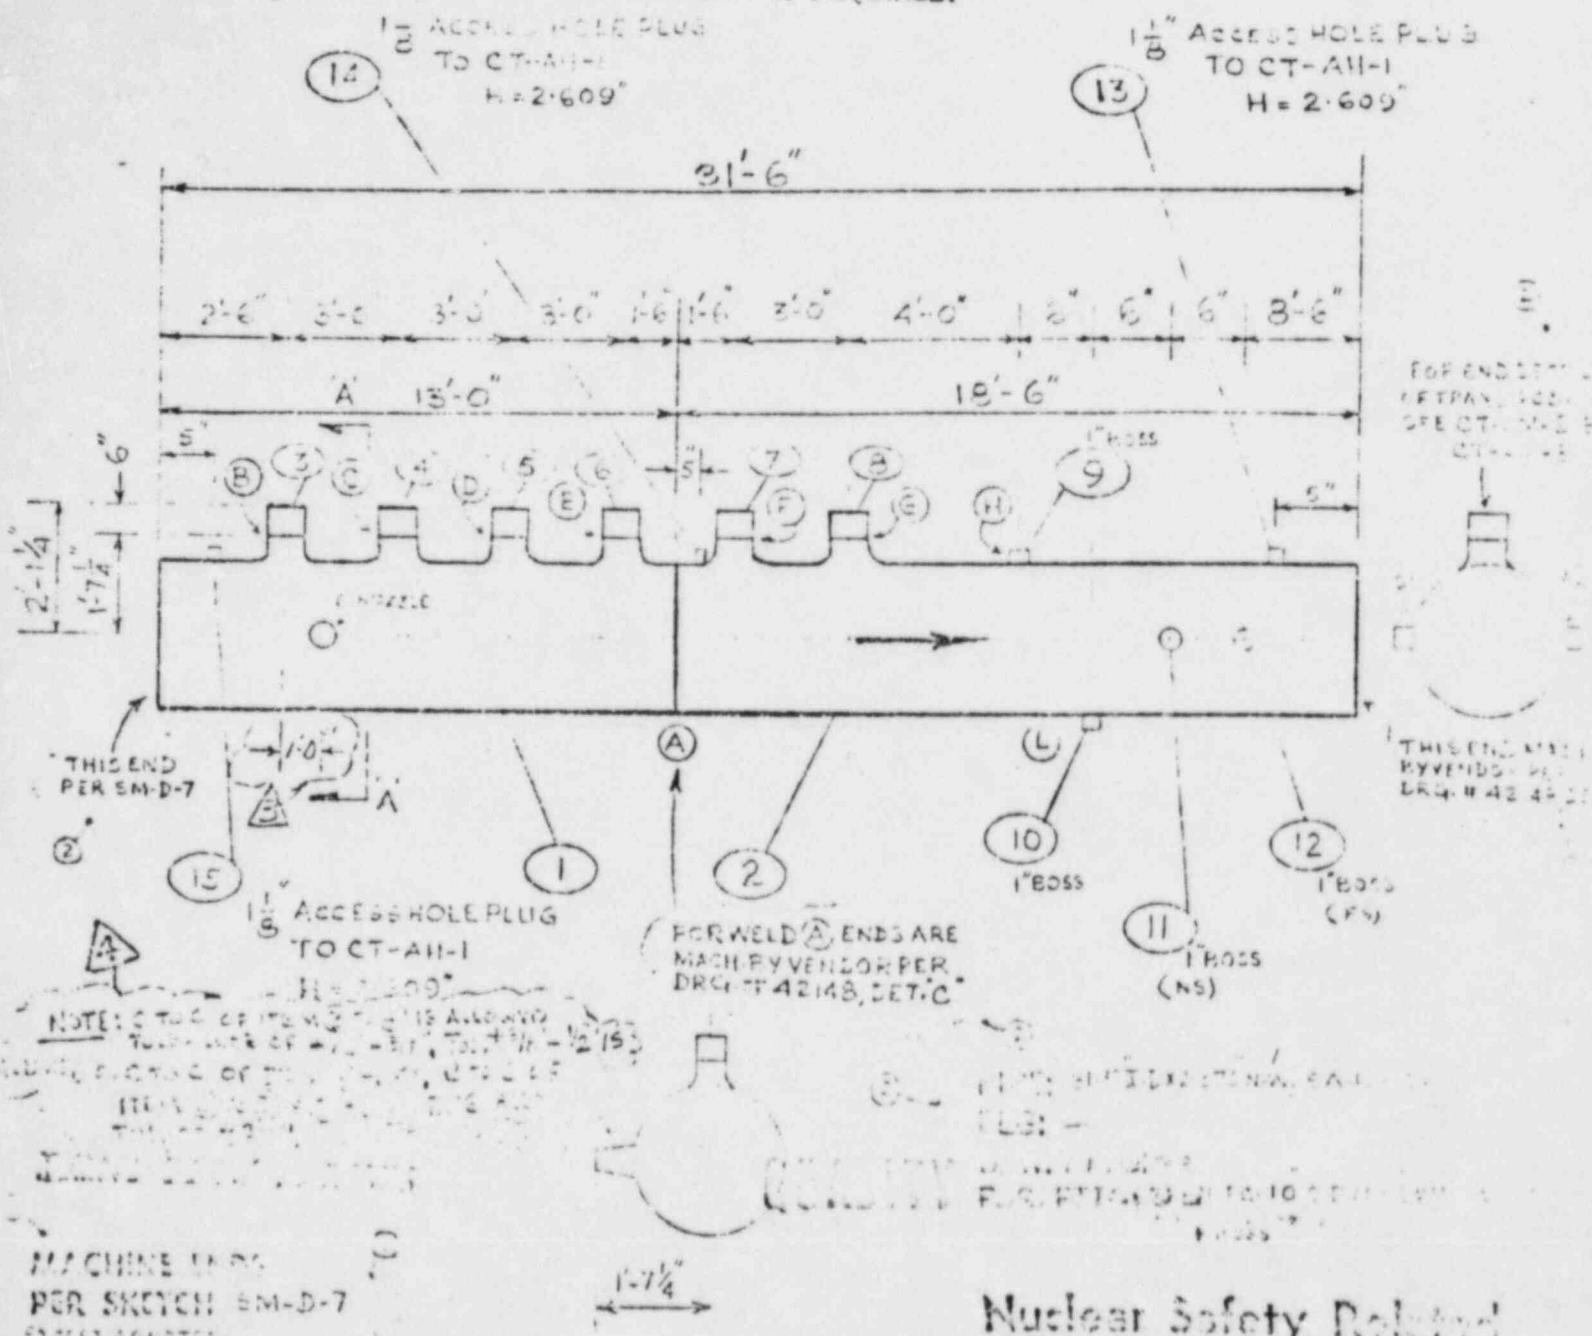

MACHINE DRAWING  
PER SKETCH SM-D-7  
ELECTRICAL

## Nuclear Safety Policy

CLASS	FILE #	LINE SPEC.	P.S. 120-5(6)	APP. CODE	125, Sec. III, Cl. 2	NO. REQ'D
<input checked="" type="checkbox"/> Radiography (RT)	<input checked="" type="checkbox"/>	Special Marking		Preheat	<input checked="" type="checkbox"/>	Cert. of Compliance
<input checked="" type="checkbox"/> Mag. Particle (MT)	<input checked="" type="checkbox"/>	Special Cleaning	<input checked="" type="checkbox"/>	Heat Treat	<input checked="" type="checkbox"/>	MIL Test Reports
<input checked="" type="checkbox"/> Liqu. Penetrant (PI)	<input checked="" type="checkbox"/>	Painting	<input checked="" type="checkbox"/>	Code Stamp	<input checked="" type="checkbox"/>	Data Reports
SYSTEM			FAB. SPECS.			
REF. DRWG NO. C7-112-511221(072)			PRESS. 112.5 PSI. TEMP. 122°F. WT. 138.			
PIECE MARK C7-511-7C			①	REGISTER C7-01-24A		

GRINNELL INDUSTRIAL PIPING, INC., 111 GRINNELL RD., PINE,

KERNERSVILLE, N. C.

Register No. C T - Q1-28X

**MATERIALS RECORD  
PRODUCTION PLANNER**

Sheet

www.english-test.net

Piece Mark C7-5M-7C

Job Name: CHARLOTTE, N.C.

### Review I.

### Review Date

Contract No. 717

### Location

Code Natl. Soc. H.L. Cl. 2

Class: MUIKE P.

Job Supplement

JSL 118

MFG. Code

## Nuclear Safety Related



## GRIFFELL INDUSTRIAL BUILDING, INC. MFG. MATERIA L RECORD

REFERENCE NO.		Sheet No.	5	OF	5
PROJECT NO.		Revision No.			
PRODUCTION PLANNER		Revised Date			
DUKE INDUSTRIAL COMPANY		Contract No.	7127	Location	
PART NUMBER	DESCRIPTION	QTY OR UNIT	QUANTITY CONTROL	ACCOUNTS RECEIVABLE	
27-41092-2	1/2" ACCESS HOLE PLUG F.R.	1	E		
	S.S. CT-AH-1 TO ASME				
	SA-105, H = 2.609"				
	DITTO	1	E		
	DITTO	1	E		
	DITTO	1	E		
	35" O.D SPEND PROT. P.R.	2	E		
	SK-#T CT-EP-1				
	375 O.D. BRIGHT END PROT.	5	E		
	6" PIPE SIZE B.E. PROT.	1	E		
	25" SPIDER BEARING PER	2	E		
	CT-ES-1				

Mechanic Society Record

Duke 'B'

Name Sec. III, Cl. 2

Code

Job Supplement T.S. HS

MFG. Code