

October 23, 1995

Docket No. 50-336  
B15403

Re: 10CFR50.90

U.S. Nuclear Regulatory Commission  
Attention: Document Control Desk  
Washington, DC 20555

Millstone Nuclear Power Station, Unit No. 2  
Additional Information Regarding  
Proposed Revision to Technical Specifications  
Cycle-Specific A.C. Sources Allowed Outage Time Extension

On October 6, 1995, Northeast Nuclear Energy Company (NNECO) proposed to amend the Millstone Nuclear Power Station, Unit No. 2 Technical Specifications by extending the Allowed Outage Time (AOT) when an offsite circuit is inoperable from the current 72 hours to seven days for the remainder of Cycle 13.<sup>(1)</sup> This change would avert a Millstone Unit No. 2 shutdown should offsite power obtained from the Millstone Unit No. 1 cross-tie become unavailable for more than 72 hours.

In a telephone conversation on October 12, 1995, the NRC Staff identified the need for the following additional information regarding the proposed revision to the Technical Specifications:

- Description of the scope of work to be performed on the Millstone Unit No. 1 electrical cross-tie equipment, including drawings, an estimate of man-hours for each task, the potential for exceeding the current 72 hour AOT, and the potential for the work to cause an inadvertent loss of normal power to Millstone Unit No. 2;
- Description of any compensatory actions that would enhance the reliability of the other sources of A.C. power to Millstone Unit No. 2 when the Millstone Unit No. 1 cross-tie is unavailable, including restricting work on the 345 kV lines into the Millstone Unit No. 2 switchyard, the Millstone Unit

---

(1) J. F. Opeka letter to U.S. Nuclear Regulatory Commission, "Millstone Nuclear Power Station, Unit No. 2, Proposed Revision to Technical Specifications Cycle-Specific A.C. Sources Allowed Outage Time Extension," dated October 6, 1995.

ADD 1/1

No. 2 reserve station service transformer, and the Millstone Unit No. 2 diesel generators, which can be otherwise postponed;

- Details regarding the dominant sequences affecting overall Millstone Unit No. 2 plant risk when the Millstone Unit No. 1 cross-tie is unavailable.

Attachment 1 to this letter transmits the requested additional information regarding the proposed license amendment as listed above.

Also, NNECO had previously requested that the NRC Staff process and issue the proposed amendment prior to November 5, 1995, when the work on the relevant electrical cross-tie equipment was scheduled to start. Presently, work on the cross-tie equipment has been rescheduled and is not expected to begin prior to November 29, 1995. Accordingly, NRC action on the proposed amendment by November 22, 1995, will provide ample time to avert a potential Millstone Unit No. 2 shutdown should the Millstone Unit No. 1 cross-tie become unavailable for more than 72 hours.

Additionally, NNECO requested that the original proposed change be applicable for the remainder of Millstone Unit No. 2 Cycle 13 (which is currently scheduled to end in May 1997). The NRC staff, however, considers that if the proposed AOT extension to 7 days is approved it should be limited to the immediate need (i.e., the upcoming Millstone Unit No. 1 outage). Accordingly, NNECO agrees to further revise the proposed Technical Specifications change to Section 3.8.1.1 by replacing the words "Except that for Cycle 13 only" with "During the Millstone Unit No. 1 Refueling Outage 15."

In view of the above limitation on the applicability of the proposed AOT extension, NNECO has also revised the proposed change to the Technical Specification BASES section as a footnote to page B 3/4 8-1 which reads as follows:

"A probabilistic safety assessment has examined the affect of extending the allowed outage time to seven (7) days for the electrical cross-tie from Unit 1 to Unit 2 during the Unit 1 Refueling Outage 15. The results show that the increase in risk is acceptable provided that two diesel generators are available."

Attachment 2 to this letter is a copy of the revised marked-up version of the appropriate sections of the current Technical Specifications. Attachment 3 is the retyped Technical Specifications sections.

U.S. Nuclear Regulatory Commission  
B15403/Page 3  
October 23, 1995

It should be emphasized that the additional information provided by this letter and the revised Technical Specifications changes do not alter the content or conclusion of the safety assessment, the environmental consideration or the determination of no significant hazards consideration previously provided in our letter to the Staff of October 6, 1995. Specifically, NNECO has determined that the proposed change does not involve any significant affect on public health and safety.

The following is an amplification to NNECO's commitment B15380.1 Other statements within this letter are provided for information only.


B15403.1 NNECO will limit work on the other sources of A.C. power to Millstone Unit No. 2 when the electrical cross-tie to Millstone Unit No. 1 is unavailable during the upcoming Millstone Unit No. 1 Refueling Outage 15. This includes work on the 345 kV lines, the switchyard, the Millstone Unit No. 2 RSST, and the Millstone Unit No. 2 diesel generators. This restriction will be enforced as part of our on-line maintenance risk reduction program.

If there are any additional questions regarding this submittal, please contact Mr. Mario Robles at (203) 440-2073.

Very truly yours,

NORTHEAST NUCLEAR ENERGY COMPANY

FOR: J. F. Opeka  
Executive Vice President

BY:   
E. A. DeBarba  
Vice President

cc: T. T. Martin, Region I Administrator  
G. S. Vissing, NRC Project Manager, Millstone Unit No. 2  
P. D. Swetland, Senior Resident Inspector, Millstone Unit  
Nos. 1, 2, and 3

U.S. Nuclear Regulatory Commission  
B15403/Page 4  
October 23, 1995

Subscribed and sworn to before me

this 23<sup>rd</sup> day of October, 1995

Sherry Esherman

Date Commission Expires: 8/31/98



Docket No. 50-336  
B15403

Attachment 1

Millstone Nuclear Power Station, Unit No. 2

Additional Information Regarding  
Proposed Revision to Technical Specifications  
Cycle-Specific A.C. Sources Allowed Outage Time Extension

October 1995

**Additional Information Regarding  
Proposed Revision to Technical Specifications  
Cycle-Specific A.C. Sources Allowed Outage Time Extension**

**WORK TO BE PERFORMED ON UNIT 1 ELECTRICAL CROSS-TIE EQUIPMENT**

Bus 4160-14H is scheduled to be de-energized for 48 hours, beginning November 29, 1995, and ending November 30, 1995. The workscope includes inspecting, cleaning, and testing the buswork and cubicle. Power-Vac circuit breakers from this bus will also be inspected, serviced (i.e., preventative maintenance) and tested. Specific manhours for each task are not relevant.

The likelihood for exceeding the 72 hour Allowed Outage Time (AOT) in the Unit 2 Technical Specifications for this bus is considered small. Unit 1 personnel believe that the scheduled works fits within the outage window. In the unlikely event that unanticipated problems arise, personnel from General Electric's Apparatus Service Center will be on-site to help expedite the resolution of these problems.

A review of the work to be performed on bus 14H indicates that there is no potential for causing a Unit 2 loss of normal power (LNP) since no Unit 2 LNP circuitry is located in this area. Drawings showing the 14H bus are also provided herein.

**ACTIONS TO ENHANCE RELIABILITY OF A.C. POWER TO UNIT 2**


In order to monitor and control the risk of varying plant configurations, Unit 2 has instituted an on-line risk monitoring program. This program quantifies the risk attributed to maintenance and surveillance activities using the Unit 2 probabilistic risk assessment model on a forward-looking weekly basis. On a daily basis, changes to the work schedule are evaluated to account for any changes that may occur during the course of the week. As such, this program will consider maintenance activities on the Unit 1 to Unit 2 cross-tie and will ensure planned maintenance and surveillance activities are carefully managed to minimize plant risk.

When the electrical cross-tie to Millstone Unit No. 1 is unavailable during the upcoming Unit 1 refueling outage 15, NNECO will limit work on the other sources of A.C. power to Unit 2. This includes work on the 345 kV lines, the switchyard, the Unit 2 reserve station service transformer, and the Unit 2 diesel generators. This restriction will be enforced as part of the on-line maintenance risk monitoring program described above.

**DOMINANT SEQUENCES AFFECTING PLANT RISK WHEN CROSS-TIE UNAVAILABLE**

Also provided herein are the dominant sequences associated with requantifying the Unit 2 LNP event tree with A.C. power recovery scenarios modified to reflect the configuration when the Unit 1 cross-tie is unavailable. The increase in the frequency of Core Melt Frequency (CMF) due to an LNP is approximately 10 percent. In other words, with the MP1 cross-tie unavailable, the contribution that an LNP initiating event has to CMF increases from approximately 25 percent of the baseline CMF ( $3.41E-05$  event/year) to 35 percent of the baseline CMF. As shown, the emergency diesel generators and auxiliary fcedwater system are important to these sequences.

9510260286-G1

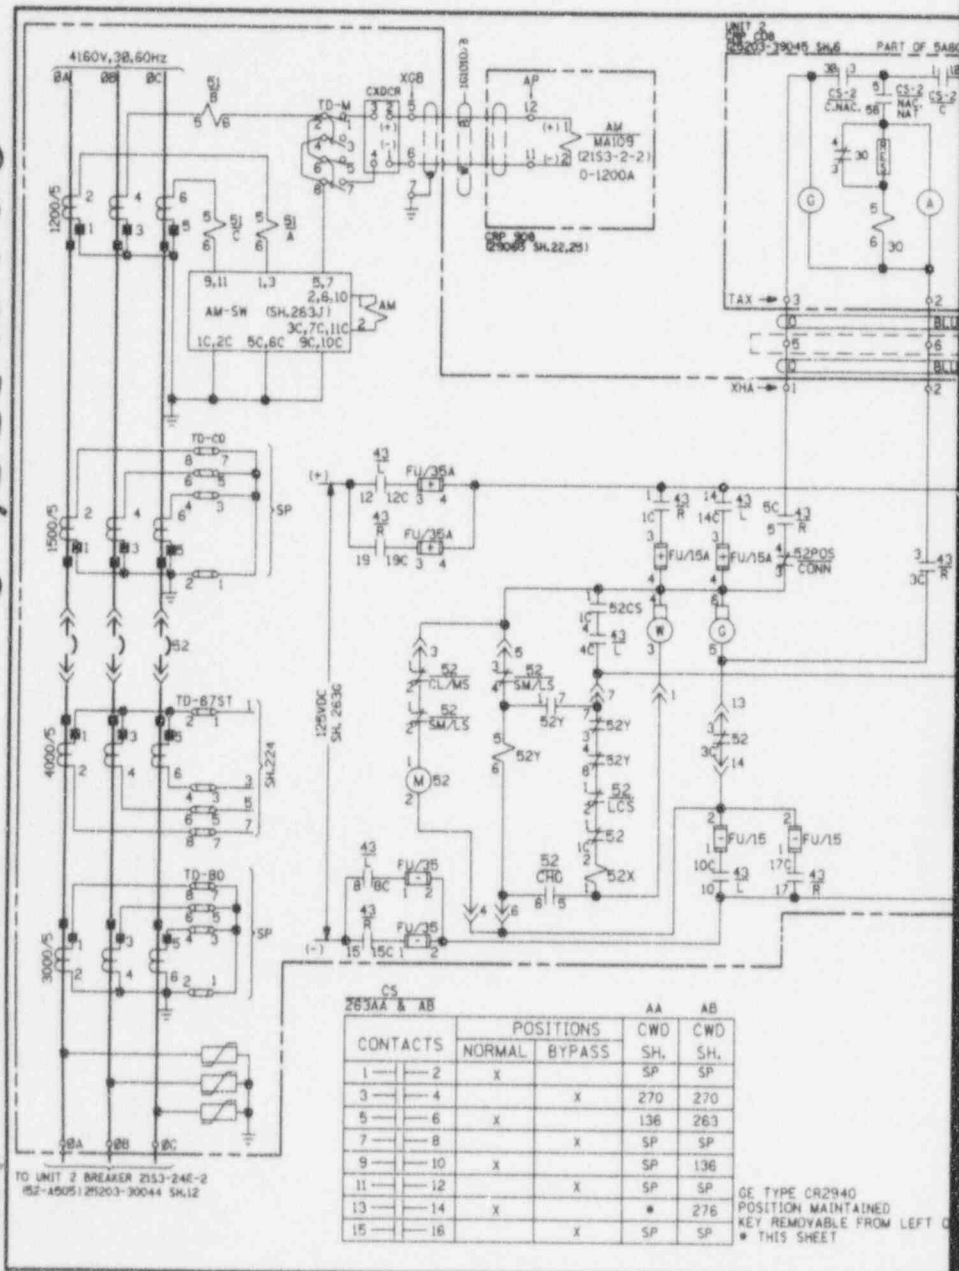










Also Available on  
Aperture Card

**ANSTEC  
APERTURE  
CARD**

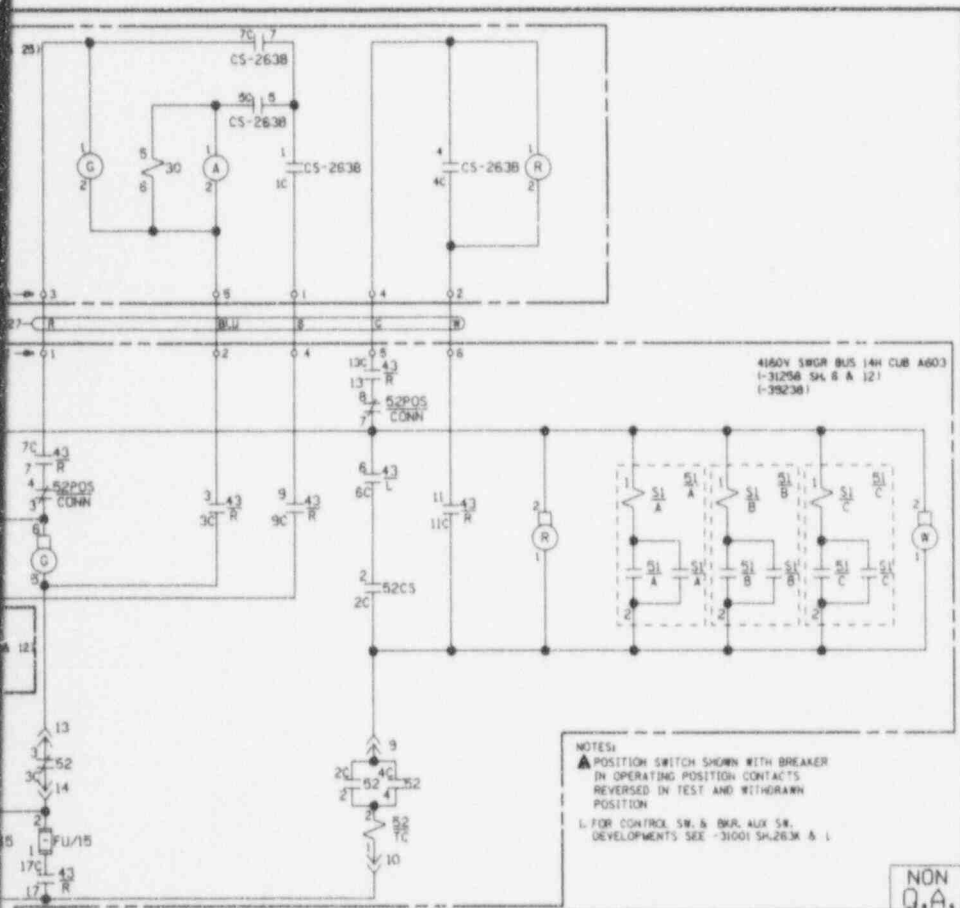

CAD

NOTE:  
MANUAL REVISIONS TO THIS DOCUMENT  
WHEN AS-BUILT ARE PROHIBITED.

REVISIONS DURING CONSTRUCTION P.A.\*

**Northeast Utilities System**

FOR NORTHEAST NUCLEAR ENERGY CO.

TITLE  
WILLSTONE UNIT 1  
4160V SWGR BUS 14H CUB A603  
RST FEED TO 14H  
WATERFORD, CONN.

BY DLM CHKD. JKY APP. GJF APP. RJH  
DATE 2-3-88 DATE 8-23-89 DATE 8-24-89 DATE 8-24-89

SCALE NONE DWG. NO 25202-31001 SH.2638  
P.A.\* 83-156

NO.	DATE	REVISIONS	BY	CHK	APP	
N/A	2	9-28-95 95	INCORP. DM1-S-962-95 PER DCR-MI-S-221-95	DJH	DJH	WJK
83-156	1		AS BUILT PER DSR-MI-S-1062-88	GT	GJF	RH


MF P.A.\* NO. DATE REVISIONS BY CHK APP





Also Available on  
Aperture Card

**ANSTEC  
APERTURE  
CARD**

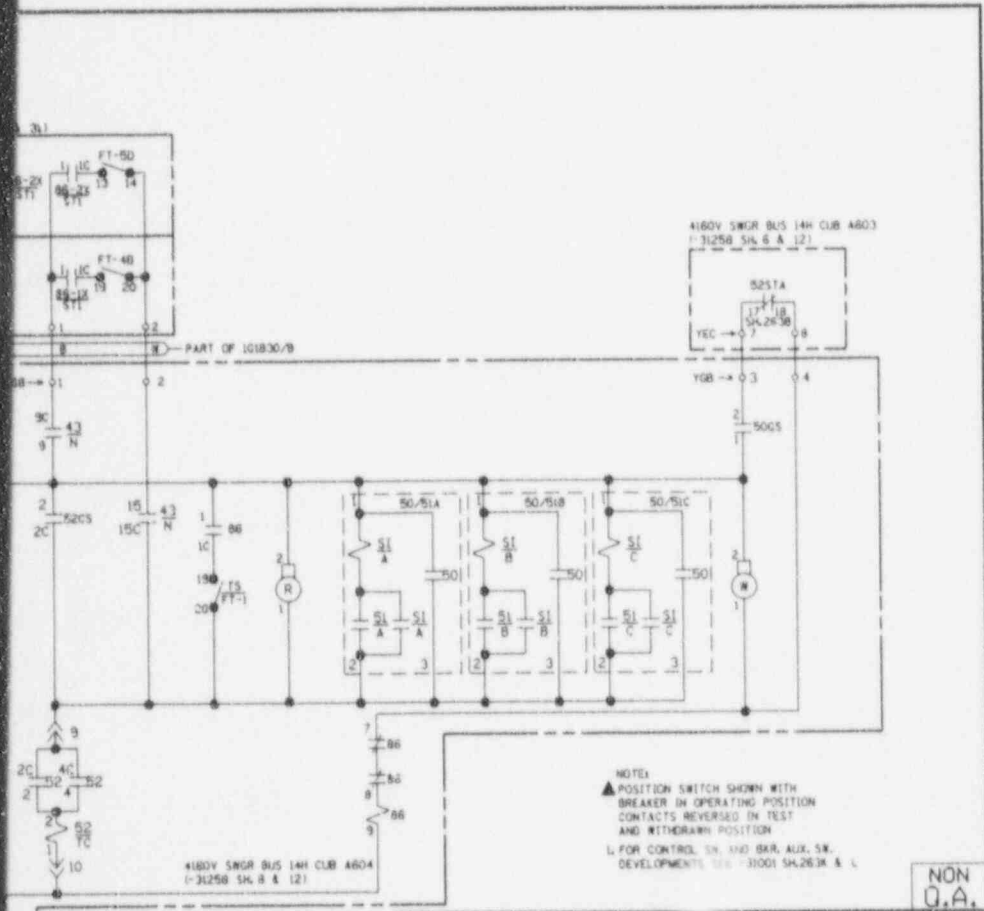

NON  
Q.A.

CAD

NOTE:  
MANUAL REVISIONS TO THIS DOCUMENT  
WHEN AS-BUILT ARE PROHIBITED.

REVISIONS DURING CONSTRUCTION	P.A.*

**Northeast Utilities System**  
FOR NORTHEAST NUCLEAR ENERGY CO.  
WILLSTONE UNIT 1  
TITLE: 4160V SWGR BUS 14H CUB A604  
300KVA SHUTDOWN XFMR (14H1-1X)  
WATERFORD, CONN.

BY	DLM	CHKD	JKY	APP	GJF	APP	RJH
DATE	3-14-88	DATE	8-23-89	DATE	8-24-89	DATE	8-24-89
SCALE	NONE	DWG. NO.	25202-31001 SH.263C				
P.A.*	B3-156						


N/A	2	9-22-95	INCORP. DMI-5-562-95 PER OCR-MI-5-221-95	DJH	CPH	WV	WV
B3-156	1		AS BUILT PER DSR-MI-5-1062-88	GT	W	GJF	RH
MF	P.A.*	NO.	DATE	REVISIONS	BY	CHK	APP





Also Available on  
Aperture Card

**ANSTEC  
APERTURE  
CARD**

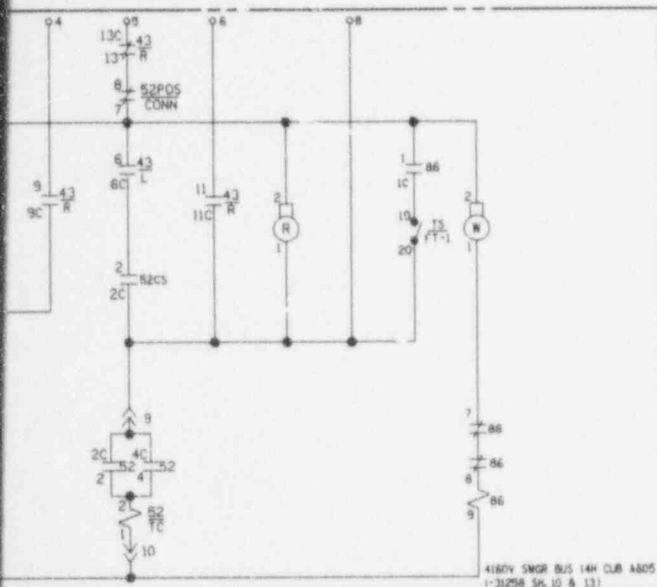

NOTE:  
▲ POSITION SWITCH SHOWN WITH  
BREAKER IN OPERATING POSITION  
CONTACTS REVERSED IN TEST  
AND WITHDRAWN POSITION  
1. FOR CONTROL SW. AND BKA. AUX. SW.  
DEVELOPMENTS SEE -31001 SH.2630 & 1

NON  
O.A.

CAD

NOTE:  
MANUAL REVISIONS TO THIS DOCUMENT  
WHEN AS-BUILT ARE PROHIBITED.

REVISIONS DURING CONSTRUCTION P.A.\*

**Northeast Utilities System**

FOR NORTHEAST NUCLEAR ENERGY CO.

TITLE  
WILLSTONE UNIT 1  
4160V SWGR BUS 14H CUB A605  
SPARE  
WATERFORD, CONN.


NO	DATE	REVISIONS	BY	CHK	APP	DATE	CHKD	JKY	APP	CJF	APP.	R. TH		
N/A	2	9 22 45	INCORP. DM1-S-562-95 PER DCR-M1-S-221-95	DJH	WJH		BY	DLM	CHKD	JKY	APP	CJF	APP.	R. TH
83-156	1		AS BUILT PER DSR-M1-S-1062-88	GT	CJF	RH	DATE	3-8-88	DATE	8-23-89	DATE	8-24-89	DATE	8-24-89
MF	P.A.*	NO DATE	REVISIONS	BY	CHK	APP	SCALE	NONE	DWG NO.	25202-31001 SH.2630				
							P.A.*	83-156						








9510260286-06

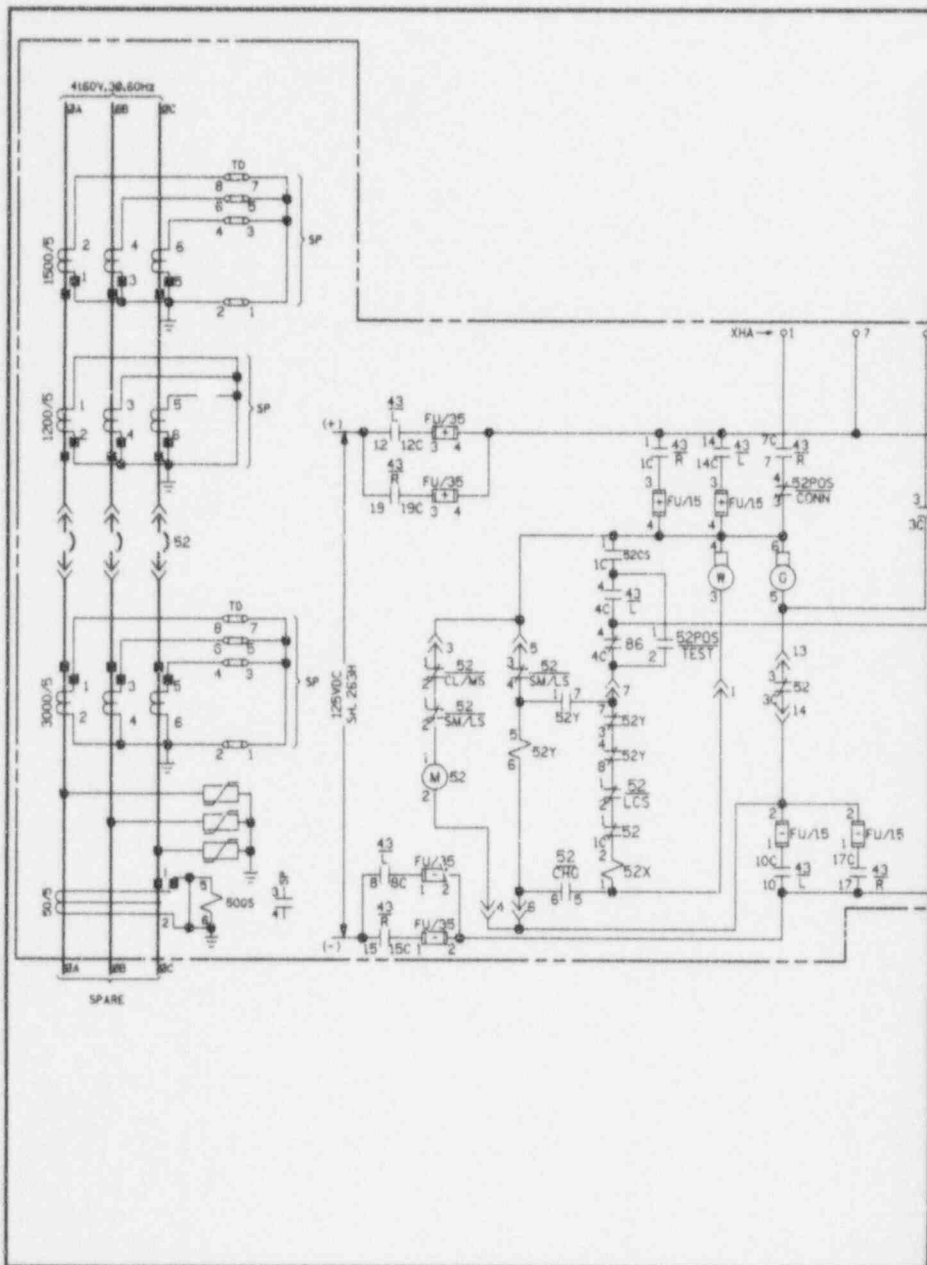

Also Available on  
Aperture Card

ANSTEC  
APERTURE  
CARD

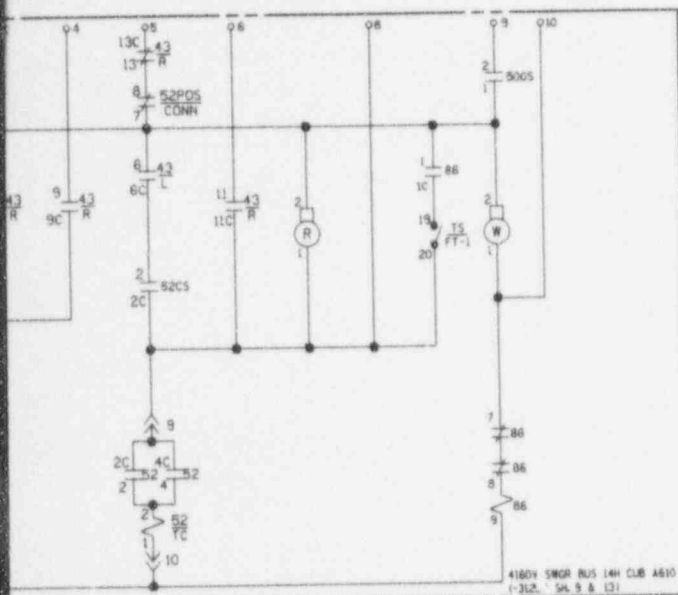

NOTE:  
▲ POSITION SWITCH SHOWN WITH  
BREAKER IN OPERATING POSITION  
CONTACTS REVERSED IN TEST  
AND WITHDRAWN POSITION  
1. FOR CONTROL SW. AND BAR. AUX. SW.  
DEVELOPMENTS SEE -31001 SH.263X & L

NON  
Q.A.


CAD

NOTE:  
MANUAL REVISIONS TO THIS DOCUMENT  
WHEN AS-BUILT ARE PROHIBITED.

REVISIONS DURING CONSTRUCTION	P.A.*




9510267286-07

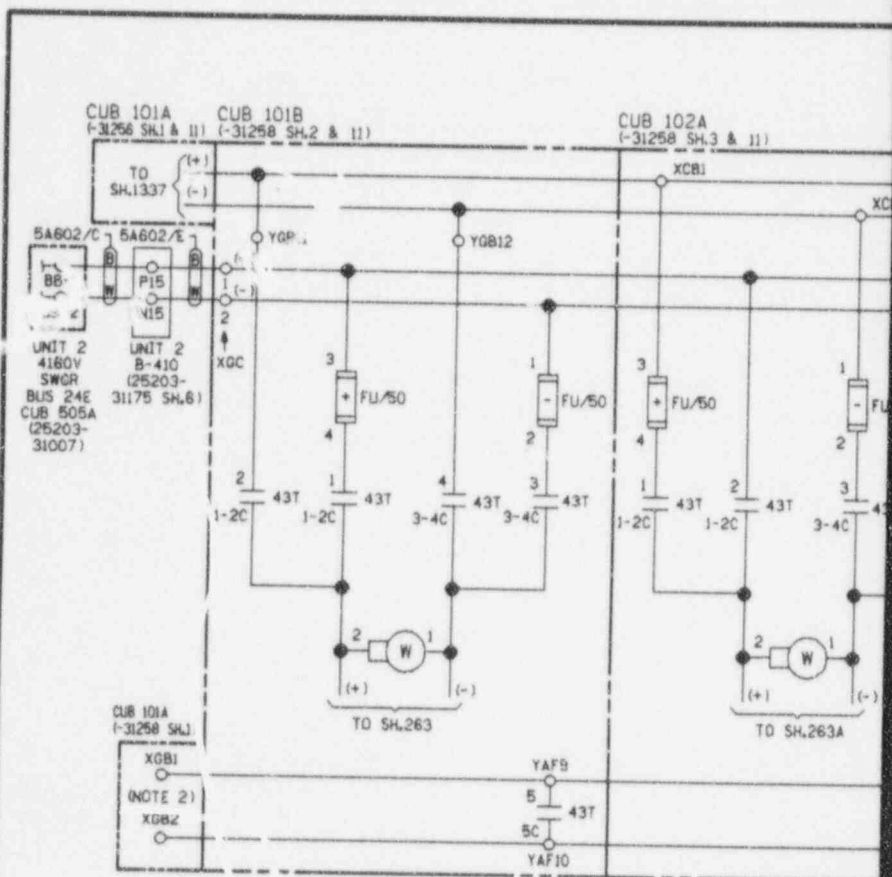


NOTES:

1. FOR SW DEVELOPMENTS SEE -3.001 SH.263K & L
2. ALARM CONTACTS NOT USE.

ANSTEC  
APERTURE  
CARD

Also Available on  
Aperture Card

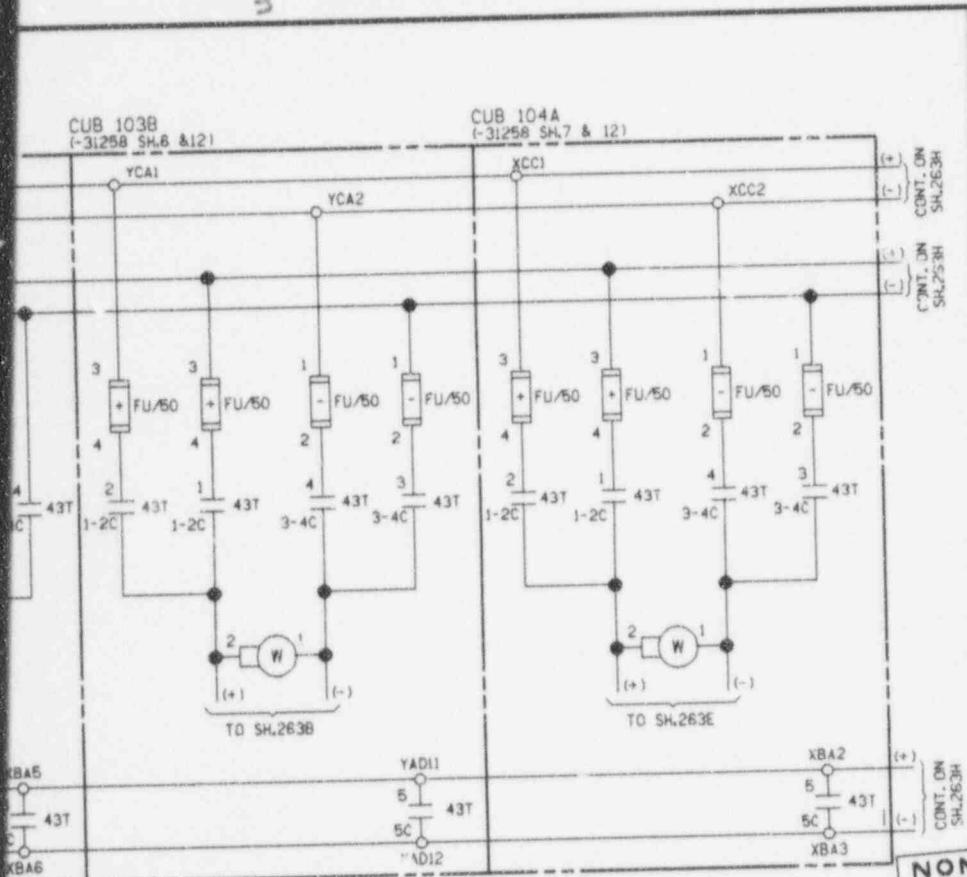

**C.A.D.**

NOTE:  
MANUAL REVISIONS TO THIS AS-BUILT  
DOCUMENT ARE PROHIBITED. REFER TO  
GED 3.01 FOR REVISION DURING  
CONSTRUCTION MANUAL REVISIONS.

REVISIONS DURING CONSTRUCTION P.A.\*



NORTHEAST UTILITIES SERVICE CO.

FOR NORTHEAST NUCLEAR ENERGY CO.


TITLE  
MILLSTONE UNIT 1  
4160V SWGR. BUS 14H 125VDC CONTROL  
POWER FOR CUBS 101B, 102A, 103B & 104A  
WATERFORD, CT.

BY DLW CHKD. JY APP. MGT APP. STJ  
DATE 9-15-87 DATE B-23-81 DATE 10/15/87 DATE 8/2/88  
SCALE NONE DWG. NO. 25202-31001 SH.263G  
P.A.\* 83-158

NO.	DATE	REVISIONS	BY	CHK	APP	APP
83-158	1	AS BUILT PER DSR-M1-S-1062-88	GT			

MR

9510260286-08

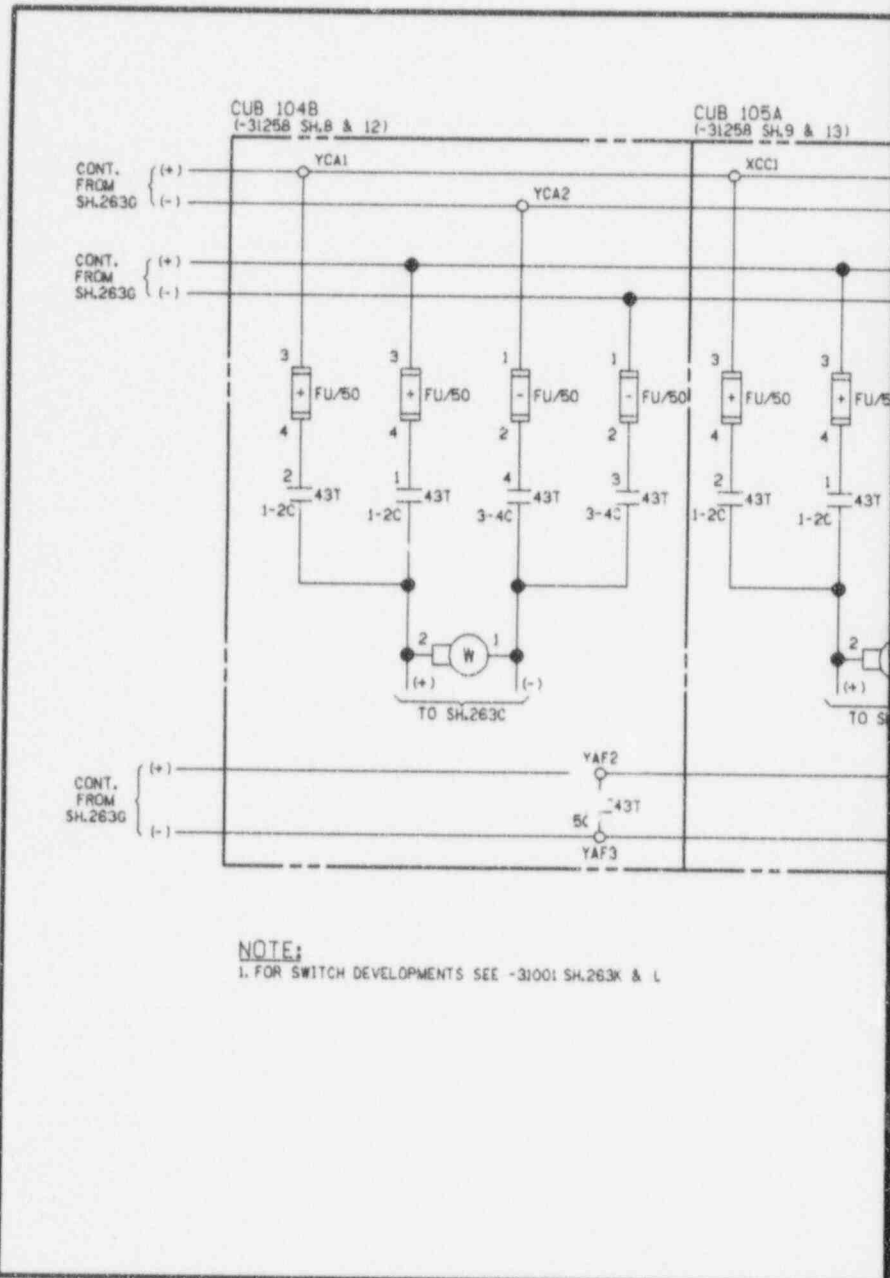

**NOTE:**


1. FOR SWITCH DEVELOPMENTS SEE -31001 SH.263K & L



ANSTEC  
APERTURE  
CARD

Also Available on  
Aperture Card

CUB 105B  
(-31258 SH.10 & 13)

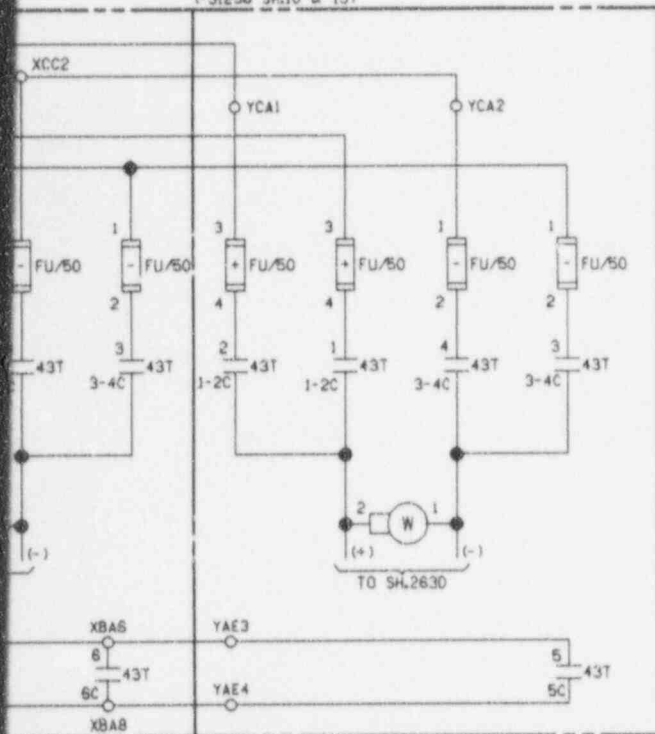

NON  
Q.A.

C.A.D.

NOTE:  
MANUAL REVISIONS TO THIS AS-BUILT  
DOCUMENT ARE PROHIBITED. REFER TO  
GED 3.01 FOR REVISION DURING  
CONSTRUCTION MANUAL REVISIONS.

REVISIONS DURING CONSTRUCTION

P.A.#



NORTHEAST UTILITIES SERVICE CO.

FOR NORTHEAST NUCLEAR ENERGY CO.

TITLE  
MILLSTONE UNIT 1  
4160V SWGR. BUS 14H 125VDC  
CONTROL POWER FOR CUB'S 104B, 105A & 105B  
WATERFORD, CT.

BY DLM CHR.D. JY APP. JH 4 DATE 9-15-87  
DATE 2-23-88 DATE 4/15/88 DATE 7/1/88

SCALE NONE DWG. NO. 25202-31001 SH.263H

P.A.# 83-156

B3-156	1	AS BUILT PER DSP-MI-S-1062-88	GT	4/15/88
MF	P.A.#	NO. DATE	REVISIONS	BY CHK APP APP


MR  
□





Also Available on  
Aperture Card

ANSTEC  
APEPTURE  
CARD

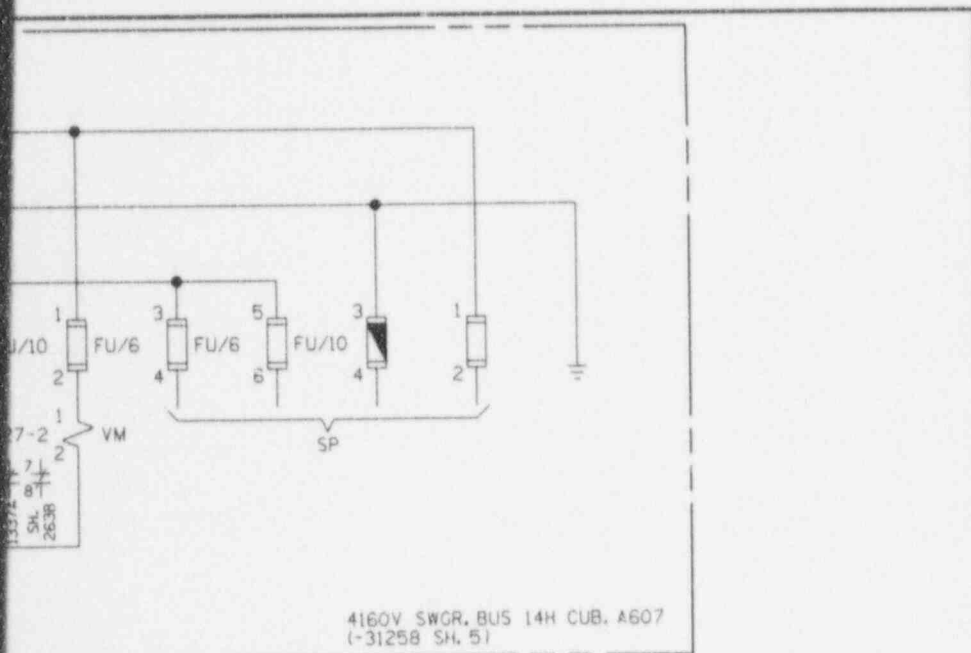

		NON Q.A.		CAD MANUAL REVISIONS TO THIS DOCUMENT WHEN AS-BUILT ARE PROHIBITED		Northeast Utilities System	
						FOR NORTHEAST NUCLEAR ENERGY CO.	
TITLE		MILLSTONE UNIT 1		BY G.TARDIE	CHKD. JKY	APP. GJF	APP. RH
4160V SWGR, BUS 14H CUBS A607, A608		AUXILIARY COMPARTMENT		DATE 8-9-89	DATE 2-23-89	DATE 2-24-89	DATE 2-24-89
POT. AND GRND XEMPS, UV RELAYS		WATERFORD, CT		SCALE N/A	DWG NO.	25202-31001 SH.263J	
P.A.P.P.P.				P.A. 83-156			

9510260286-10

52STA

CONTACTS		POSITION		CUB. 101B	CUB. 102A	CUB. 103B	CUB. 104A	CUB. 104B	CUB. 105A	CUB. 105B
CRANK END	NO.	BKR. OPEN	BKR. CLOSED	CWO SH	CWO SH	CWO SH	CWO SH	CWO SH	CWO SH	CWO SH
6-1-8	8-1-8	1-2	X	298	SP	298	SP	SP	SP	SP
8-1-8	8-1-8	3-4	X	Δ	Δ	SP	SP	SP	SP	SP
8-1-8	8-1-8	5-6	X	SP	SP	243	SP	SP	SP	SP
8-1-8	8-1-8	7-8	X	SP	SP	SP	SP	SP	SP	SP
8-1-8	8-1-8	9-10	X	299	SP	299	SP	SP	SP	SP
8-1-8	8-1-8	11-12	X	SP	SP	SP	SP	SP	SP	SP
8-1-8	8-1-8	13-14	X	SP	SP	263	SP	SP	SP	SP
8-1-8	8-1-8	15-16	X	SP	SP	SP	SP	SP	SP	SP
8-1-8	8-1-8	17-18	X	SP	SP	253C	SP	SP	SP	SP
8-1-8	8-1-8	19-20	X	SP	SP	SP	SP	SP	SP	SP
8-1-8	8-1-8	21-22	X	SP	SP	263E	SP	SP	SP	SP
8-1-8	8-1-8	23-24	X	SP	SP	SP	SP	SP	SP	SP

S812-0226A92870010

43T

CONTACTS		POSITION		CUB. 101B	CUB. 102A	CUB. 103B	CUB. 104A	CUB. 104B	CUB. 105A	CUB. 105B
HANDLE END	NO.	UNIT 2	UNIT 1	CWO SH	CWO SH	CWO SH	CWO SH	CWO SH	CWO SH	CWO SH
6-1-8	1-2C	1	X	263C	263C	263C	263C	263H	263H	263H
8-1-8	3-4C	1	X	263C	263C	263C	263C	263H	263H	263H
8-1-8	5-6C	1	X	263C	263C	263C	263C	263H	263H	263H
8-1-8	7-8C	1	X	263C	263C	263C	263C	263H	263H	263H
8-1-8	9-10C	1	X	263C	263C	263C	263C	263H	263H	263H
8-1-8	11-12C	1	X	SP	SP	SP	SP	SP	SP	SP

S81-C021355M2V

52POS

CONTACTS		POSITION		CUB. 101B	CUB. 102A	CUB. 103B	CUB. 104A	CUB. 104B	CUB. 105A	CUB. 105B
CRANK END	NO.	BKR. IN	BKR. OUT	CWO SH	CWO SH	CWO SH	CWO SH	CWO SH	CWO SH	CWO SH
6-1-8	8-1-8	1-2	X	SP	SP	253B	253E	253C	253C	253C
8-1-8	8-1-8	3-4	X	263	263A	263B	SP	SP	263F	263C
8-1-8	8-1-8	5-6	X	SP	SP	SP	SP	SP	SP	SP
8-1-8	8-1-8	7-8	X	263	263A	263B	SP	SP	263F	263C
8-1-8	8-1-8	9-10	X	SP	SP	SP	SP	SP	SP	SP
8-1-8	8-1-8	11-12	X	SP	SP	SP	SP	SP	SP	SP

S812-0226A92870010

NOTES:

1. Δ - 25203-31212 SH.119

83-156	1	8/2	AS BUILT PER	
		8/1	DSR-M1-S-1062-88	
MF P.A.*	NO.	DATE	REVISIONS	

REVISIONS DURING CONSTRUCTION P.A.\*

Also Available on  
Aperture Card

KINSTEK  
APERTURE  
CARD

CS

CONTACTS	HANDLE END	NO.	POSITION		CUB. 101B	CUB. 102A	CUB. 103B	CUB. 104A	CUB. 104B	CUB. 105A	CUB. 105B
			TRIP	NORMAL	CWO SP	CWO SP	CWO SP	CWO SP	CWO SP	CWO SP	CWO SP
	IC	1		X	263	263A	263B	263C	263D	263E	263F
	OC	2	X		265	265A	265B	265C	265D	265E	265F

LAB303  
RING RETURN TO NORMAL

2 BKR. AUX. SWITCHES

CONTACTS	CRANK END	NO.	POSITION		CUB. 101B	CUB. 102A	CUB. 103B	CUB. 104A	CUB. 104B	CUB. 105A	CUB. 105B
			BKR. OPEN	BKR. CLOSED	CWO SP	CWO SP	CWO SP	CWO SP	CWO SP	CWO SP	CWO SP
	1C	1	X		263	263A	263B	263C	263D	263E	263F
	2C	2		X	263	263A	263B	263C	263D	263E	263F
	3C	3	X		263	263A	263B	263C	263D	263E	263F
	4C	4		X	263	263A	263B	263C	263D	263E	263F
	5C	5	X		SP	SP	SP	SP	SP	SP	SP
	6C	6		X	SP	SP	SP	SP	SP	SP	SP
	7C	7	X		SP	SP	SP	SP	SP	SP	SP
	8C	8		X	SP	SP	SP	SP	SP	SP	SP

NON  
Q.A.

C.A.D.  
MANUAL REVISIONS TO  
AS-BUILTS ARE  
PROHIBITED. SEE GED 3.01



NORTHEAST UTILITIES SERVICE CO.  
FOR NORTHEAST NUCLEAR ENERGY CO.

TITLE	MILLSTONE UNIT 1 4160V SWGR. BUS 14H CONTROL SW. & TEST SW. DEVELOPMENTS SH.1 WATERFORD, CT	BY G. TARDIE	CHKD. JY	APP. JY	APP. JY
DATE	8-11-89	DATE	8-23-89	DATE	8-15-89
SCALE	N/A	DWG. NO.	25202-31001 SH.263K		
P.A.#	B3-156				

MR  
□



9510260286-11

86/868

HAND RESET SHOWN IN RESET POSITION	NO.	CUB. 101B	CUB. 104A	CUB. 104B	CUB. 105A	CUB. 105B
		CWO 3A	CWO 3A	CWO 3A	CWO 3A	CWO 3A
	1	263	263E	263C	263F	263D
	2	270	SP	SP	SP	SP
	3	275	SP	SP	SP	SP
	4	283	263E	263C	263V	263D
	5	270	SP	SP	SP	SP
	6	275	SP	SP	SP	SP
	7	283	263E	263C	263V	263D
	8	263	263E	263C	263F	263D
	9	263	263E	263C	263F	263D

HEA81A223K2

AM

CONTACT	
HANDLE END	
10	
30	
50	
70	
90	
110	

185B1CA15

43

CONTACTS	NO.	POSITION		CUB. 101B	CUB. 104A	CUB. 104B	CUB. 104A	CUB. 104B	CUB. 105A	CUB. 105B
		REMOTE (NORMAL)	LOCAL (ISOLATE)	CWO 3A	CWO 3A	CWO 3A	CWO 3A	CWO 3A	CWO 3A	CWO 3A
	1	X	X	263	263A	263B	263E	263C	263F	263D
	2	X	X	263	263A	263B	263E	263C	263F	263D
	3	X	X	263	263A	263B	263E	263C	263F	263D
16SR1MR2A00L

REVISIONS DURING CONSTRUCTION P.A.\*

NO.	DATE	REVISIONS
83-156	1 8-2-64	AS BUILT PER DSR-MI-S-1062-88

POSITION										CUB. 101B	CUB. 102A	CUB. 103B	CUB. 104A	CUB. 104B	CUB. 105A	CUB. 105B
B	W	OFF	W	2	W	OFF	W	I		CWO SH	CWO SH	CWO SH	CWO SH	CWO SH	CWO SH	CWO SH
X	X	X	X	X	X	X	X	X		263	263A	263B	263C	263D	263E	263F
								X	X	263	263A	263B	263C	263D	263E	263F
								X	X	263	263A	263B	263C	263D	263E	263F
										263	263A	263B	263C	263D	263E	263F
X	X	X	X		X	X	X	X	X	263	263A	263B	263C	263D	263E	263F
					X	X	X			263	263A	263B	263C	263D	263E	263F
					X	X	X			263	263A	263B	263C	263D	263E	263F
										263	263A	263B	263C	263D	263E	263F
X	X	X	X	X	X	X	X	X	X	263	263A	263B	263C	263D	263E	263F
X	X									263	263A	263B	263C	263D	263E	263F
X	X									263	263A	263B	263C	263D	263E	263F
										263	263A	263B	263C	263D	263E	263F
										263	263A	263B	263C	263D	263E	263F

ANSTEC  
APERTURE  
CARD


Also Available on  
Aperture Card

NON Q.A.		C.A.D. MANUAL REVISIONS TO AS-BUILTS ARE PROHIBITED. SEE REF 3.01		NORTHEAST UTILITIES SERVICE CO. FOR NORTHEAST NUCLEAR ENERGY CO.			
TITLE		BY G. TARDIE	CHKD. JY	APP. JG	APP. PTH		
MILLSTONE UNIT 1		DATE 8-11-89	DATE 8-23-89	DATE 9-1-89	DATE 9-1-89		
4160V SWGR. BUS 14H		SCALE N/A	DWG. NO.		25202-31001 SH.263L		
CONTROL SW. & TEST SW. DEVELOPMENTS SH.2		P.A.* 83-156					
WATERFORD, CT							

MR  
0





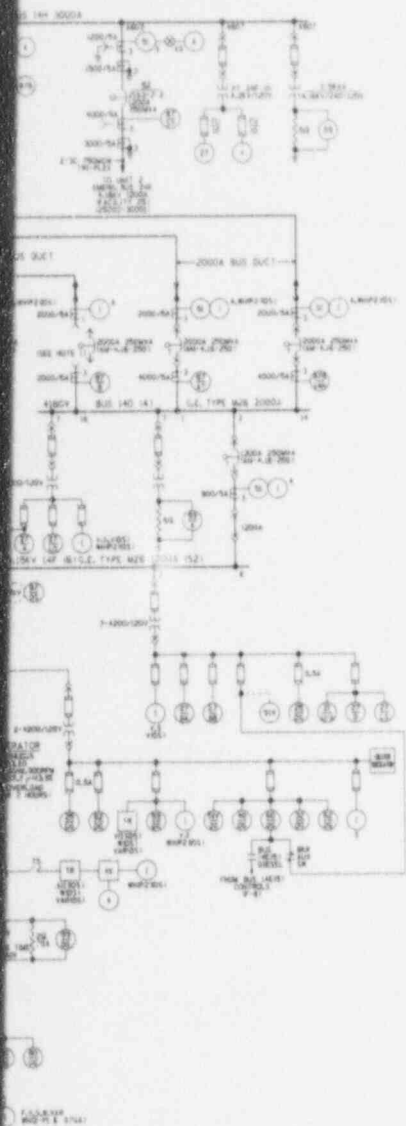

RELAY	DESCRIPTION
2000A-1	OVERCURRENT RELAY
2000A-2	OVERCURRENT RELAY
2000A-3	OVERCURRENT RELAY
2000A-100	OVERCURRENT RELAY

- SYMBOLS**
- 7 - INDICATES TRIP ON LOSS OF NORMAL POWER
  - 7A - INDICATES TRIP ON LOSS OF NORMAL POWER & REQUIRED FOR LINE DIRECTION
  - 7B - INDICATES TRIP ON LOSS OF NORMAL POWER & REQUIRED FOR LINE DIRECTION
- REFERENCE DRAWINGS**
- 2500-3000-301-1 PRINCIPAL DIAGRAM
  - 2500-3000-301-2 BUSH & BUSH ONE LINE DIAGRAM
  - 2500-3000-301-3 BUSH & BUSH ONE LINE DIAGRAM
  - 2500-3000-301-4 BUSH & BUSH ONE LINE DIAGRAM
  - 2500-3000-301-5 BUSH & BUSH ONE LINE DIAGRAM
  - 2500-3000-301-6 BUSH & BUSH ONE LINE DIAGRAM

- NOTES**
1. REFER TO BE LIMITED AND EXISTING MECHANISM TO BE PROVIDED TO PREVENT ...
  2. ...
  3. ...
  4. ...
  5. ...
  6. ...

Also Available on  
Aperture Card

**ANSTEC  
APERTURE  
CARD**

OPERATIONS CRITICAL

Q.A.

CAD		REVISION	
DATE: 10/1/78		BY: J. J. ...	
<p style="text-align: center;"><b>Northeast Utilities System</b></p> <p style="text-align: center;">NORTHEAST NUCLEAR ENERGY CO.</p> <p style="text-align: center;">WILMINGTON, DEL.</p> <p style="text-align: center;">MAIN ONE LINE WIRING DIAGRAM</p>			
NO.	REV.	DESCRIPTION	DATE
1	1	ISSUED FOR CONSTRUCTION	10/1/78
2	1	ISSUED FOR CONSTRUCTION	10/1/78
3	1	ISSUED FOR CONSTRUCTION	10/1/78
4	1	ISSUED FOR CONSTRUCTION	10/1/78
5	1	ISSUED FOR CONSTRUCTION	10/1/78
6	1	ISSUED FOR CONSTRUCTION	10/1/78
7	1	ISSUED FOR CONSTRUCTION	10/1/78
8	1	ISSUED FOR CONSTRUCTION	10/1/78
9	1	ISSUED FOR CONSTRUCTION	10/1/78
10	1	ISSUED FOR CONSTRUCTION	10/1/78







Initiator	Core Melt	Any Rel.	Sig. Rel.	Econ Risk	Risk 5	Risk 6
T8	1.21E-05	0.00E+00	0.00E+00	0.00E+00	0.00E+00	0.00E+00
Total Freq:	1.21E-05	0.00E+00	0.00E+00	0.00E+00	0.00E+00	0.00E+00

Sequence Name	Plant Damage Class	Freq. Measure	Percent (%)	Accident Sequence Events
TEH1	TEH	5.91E-07	4.9	T8 LOSS OF NORMAL POWER INITIATING EVENT AMODDGBFLTJKI <module> D/G 15G-13U FAULTS FMODMDADELCA <MODULE> MD PUMP TRAIN A FAILS TO DELIVER FMODSDPDELD <MODULE> SD PUMP FAILS TO DEL APW TO HEADERS
TEH1	TEH	5.91E-07	4.9	T8 LOSS OF NORMAL POWER INITIATING EVENT AMODDGAFLTJJI <module> D/G 15G-12U FAULTS FMODMDDELCEB <MODULE>MD PUMP 9B FAILS TO DELIVER FMODSDPDELD <MODULE> SD PUMP FAILS TO DEL APW TO HEADERS
TLGL1	TLGL	5.57E-07	4.6	T8 LOSS OF NORMAL POWER INITIATING EVENT ACREC13 RECOVERY OF AC POWER IN 13 HOURS (MEAN COPING TIME) AMODCCFLNPKAB <module> COMMON CAUSE FAILURE OF AC POWER GIVEN AN LNP
TLGL1	TLGL	4.22E-07	3.5	T8 LOSS OF NORMAL POWER INITIATING EVENT ACREC13 RECOVERY OF AC POWER IN 13 HOURS (MEAN COPING TIME) AMODDGAFLTJJI <module> D/G 15G-12U FAULTS AMODDGBFLTJKI <module> D/G 15G-13U FAULTS
TEH1	TEH	4.20E-07	3.5	T8 LOSS OF NORMAL POWER INITIATING EVENT AMODDGBFLTJKI <module> D/G 15G-13U FAULTS FMODMDADELCA <MODULE> MD PUMP TRAIN A FAILS TO DELIVER FQ1PKCP4 COGNITIVE ERROR FOR OPS. FAILING TO INIT. SD PUMP.
TEH1	TEH	4.20E-07	3.5	T8 LOSS OF NORMAL POWER INITIATING EVENT AMODDGAFLTJJI <module> D/G 15G-12U FAULTS FMODMDDELCEB <MODULE>MD PUMP 9B FAILS TO DELIVER FQ1PKCP4 COGNITIVE ERROR FOR OPS. FAILING TO INIT. SD PUMP.
TEH1	TEH	3.61E-07	3.1	T8 LOSS OF NORMAL POWER INITIATING EVENT AMODDGBFLTJKI <module> D/G 15G-13U FAULTS FMODMDADELCA <MODULE> MD PUMP TRAIN A FAILS TO DELIVER FQ1QXOP4 SD APW PUMP P4 IS O.O.S. FOR MAINT.
TEH1	TEH	3.61E-07	3.1	T8 LOSS OF NORMAL POWER INITIATING EVENT AMODDGAFLTJJI <module> D/G 15G-12U FAULTS FMODMDDELCEB <MODULE>MD PUMP 9B FAILS TO DELIVER FQ1QXOP4 SD APW PUMP P4 IS O.O.S. FOR MAINT.
TEH1	TEH	3.34E-07	2.8	T8 LOSS OF NORMAL POWER INITIATING EVENT AMODDGAFLTJJI <module> D/G 15G-12U FAULTS FMODSDPDELD <MODULE> SD PUMP FAILS TO DEL APW TO HEADERS FP9QXO9B APW MD PUMP 9B IS O.O.S. DUE TO MAINT.
TEH1	TEH	3.34E-07	2.8	T8 LOSS OF NORMAL POWER INITIATING EVENT AMODDGBFLTJKI <module> D/G 15G-13U FAULTS FMODSDPDELD <MODULE> SD PUMP FAILS TO DEL APW TO HEADERS FP9QXO9A APW MD PUMP 9A IS O.O.S. DUE TO MAINT.
TEH1	TEH	2.73E-07	2.3	T8 LOSS OF NORMAL POWER INITIATING EVENT FMODCCFHDBG <MODULE> CCFs OF THE COMMON INJECTION HEADER VALVES GABAFLN COGNITIVE ERROR TO INITIATE BLEED AND FEED/LNP INITIATOR
TEGH1	TEGH	2.62E-07	2.2	T8 LOSS OF NORMAL POWER INITIATING EVENT ACRECS4 RECOVERY OF AC POWER IN 54 MINUTES AMODCCFLNPKAB <module> COMMON CAUSE FAILURE OF AC POWER GIVEN AN LNP FMODSDPDELD <MODULE> SD PUMP FAILS TO DEL APW TO HEADERS
TEH1	TEH	2.37E-07	2.0	T8 LOSS OF NORMAL POWER INITIATING EVENT AMODDGAFLTJJI <module> D/G 15G-12U FAULTS FP9QXO9B APW MD PUMP 9B IS O.O.S. DUE TO MAINT. FQ1PKCP4 COGNITIVE ERROR FOR OPS. FAILING TO INIT. SD PUMP.
TEH1	TEH	2.37E-07	2.0	T8 LOSS OF NORMAL POWER INITIATING EVENT AMODDGBFLTJKI <module> D/G 15G-13U FAULTS FP9QXO9A APW MD PUMP 9A IS O.O.S. DUE TO MAINT. FQ1PKCP4 COGNITIVE ERROR FOR OPS. FAILING TO INIT. SD PUMP.



TEGH1	TEGH	1.99E-07	1.6	T8	LOSS OF NORMAL POWER INITIATING EVENT
				ACREC54	RECOVERY OF AC POWER IN 54 MINUTES
				AMODDGAPLTJI	<module> D/G 15G-12U FAULTS
				AMODDGBFLTKI	<module> D/G 15G-13U FAULTS
				FMODSDPDELD	<MODULE> SD PUMP FAILS TO DEL AFW TO HEADERS
TEGH1	TEGH	1.86E-07	1.5	T8	LOSS OF NORMAL POWER INITIATING EVENT
				ACREC54	RECOVERY OF AC POWER IN 54 MINUTES
				AMODCCPLWPKAB	<module> COMMON CAUSE FAILURE OF AC POWER GIVEN AN LNP
				FQIPKCP4	COGNITIVE ERROR FOR OPS. FAILING TO INIT. SD PUMP.
TEH1	TEH	1.75E-07	1.4	T8	LOSS OF NORMAL POWER INITIATING EVENT
				AMODDGBFLTKI	<module> D/G 15G-13U FAULTS
				FMODMDADELCA	<MODULE> MD PUMP TRAIN A FAILS TO DELIVER
				FQIPKOP4	OP FAILS TO PLACE THE SD PUMP TRAIN IN SERVICE-PROC. ERRORS.
TEH1	TEH	1.75E-07	1.4	T8	LOSS OF NORMAL POWER INITIATING EVENT
				AMODDGAPLTJI	<module> D/G 15G-12U FAULTS
				FMODMBDELCEB	<MODULE>MD PUMP 9B FAILS TO DELIVER
				FQIPKOP4	OP FAILS TO PLACE THE SD PUMP TRAIN IN SERVICE-PROC. ERRORS.
TEGH1	TEGH	1.69E-07	1.4	T8	LOSS OF NORMAL POWER INITIATING EVENT
				ACREC54	RECOVERY OF AC POWER IN 54 MINUTES
				AMODCCPLWPKAB	<module> COMMON CAUSE FAILURE OF AC POWER GIVEN AN LNP
				FQIQKOP4	SD AFW PUMP P4 IS O.O.S. FOR MAINT.
TEH1	TEH	1.43E-07	1.2	T8	LOSS OF NORMAL POWER INITIATING EVENT
				AMODDGAPLTJI	<module> D/G 15G-12U FAULTS
				FMODCCFHDRG	<MODULE> CCFs OF THE COMMON INJECTION HEADER VALVES
TEH1	TEH	1.43E-07	1.2	T8	LOSS OF NORMAL POWER INITIATING EVENT
				AMODDGBFLTKI	<module> D/G 15G-13U FAULTS
				FMODCCFHDRG	<MODULE> CCFs OF THE COMMON INJECTION HEADER VALVES
TEGH1	TEGH	1.41E-07	1.2	T8	LOSS OF NORMAL POWER INITIATING EVENT
				ACREC54	RECOVERY OF AC POWER IN 54 MINUTES
				AMODDGAPLTJI	<module> D/G 15G-12U FAULTS
				AMODDGBFLTKI	<module> D/G 15G-13U FAULTS
				FQIPKCP4	COGNITIVE ERROR FOR OPS. FAILING TO INIT. SD PUMP.
TEGH1	TEGH	1.28E-07	1.1	T8	LOSS OF NORMAL POWER INITIATING EVENT
				ACREC54	RECOVERY OF AC POWER IN 54 MINUTES
				AMODDGAPLTJI	<module> D/G 15G-12U FAULTS
				AMODDGBFLTKI	<module> D/G 15G-13U FAULTS
				FQIQKOP4	SD AFW PUMP P4 IS O.O.S. FOR MAINT.
TEH1	TEH	1.20E-07	1.0	T8	LOSS OF NORMAL POWER INITIATING EVENT
				ADGQX13U	DIESEL GENERATOR 15G-13U OUT OF SERVICE DUE TO MAINTENANCE
				FMODMDADELCA	<MODULE> MD PUMP TRAIN A FAILS TO DELIVER
				FMODSDPDELD	<MODULE> SD PUMP FAILS TO DEL AFW TO HEADERS
TEH1	TEH	1.20E-07	1.0	T8	LOSS OF NORMAL POWER INITIATING EVENT
				ADGQX12U	DIESEL GENERATOR 15G-12U OUT OF SERVICE DUE TO MAINTENANCE
				FMODMBDELCEB	<MODULE>MD PUMP 9B FAILS TO DELIVER
				FMODSDPDELD	<MODULE> SD PUMP FAILS TO DEL AFW TO HEADERS
TEH1	TEH	9.92E-08	.8	T8	LOSS OF NORMAL POWER INITIATING EVENT
				AMODDGAPLTJI	<module> D/G 15G-12U FAULTS
				FP9QK09B	AFW MD PUMP 9B IS O.O.S. DUE TO MAINT.
				FQIPKOP4	OP FAILS TO PLACE THE SD PUMP TRAIN IN SERVICE-PROC. ERRORS.
TEH1	TEH	9.92E-08	.8	T8	LOSS OF NORMAL POWER INITIATING EVENT
				AMODDGBFLTKI	<module> D/G 15G-13U FAULTS
				FP9QK09A	AFW MD PUMP 9A IS O.O.S. DUE TO MAINT.
				FQIPKOP4	OP FAILS TO PLACE THE SD PUMP TRAIN IN SERVICE-PROC. ERRORS.
TLGL1	TLGL	8.54E-08	.7	T8	LOSS OF NORMAL POWER INITIATING EVENT
				ACREC13	RECOVERY OF AC POWER IN 13 HOURS (MEAN COPING TIME)
				ADGQX12U	DIESEL GENERATOR 15G-12U OUT OF SERVICE DUE TO MAINTENANCE
				AMODDGBFLTKI	<module> D/G 15G-13U FAULTS
TLGL1	TLGL	8.54E-08	.7	T8	LOSS OF NORMAL POWER INITIATING EVENT

TEH1	TEH	8.49E-08	ACRRC13 ADGQX130 AMODGCAFLTJI	RECOVERY OF AC POWER IN 13 HOURS (MEAN COPIING TIME) DIESEL GENERATOR 15G-130 OUT OF SERVICE DUE TO MAINTENANCE <module> D/G 15G-120 FAULTS
TEH1	TEH	8.49E-08	ADGQX130 FMODDADELCA FQ1PXP4	LOSS OF NORMAL POWER INITIATING EVENT DIESEL GENERATOR 15G-130 OUT OF SERVICE DUE TO MAINTENANCE <module> MD PUMP TRAIN A FAILS TO DELIVER COGNITIVE ERROR FOR OPS. FAILING TO INIT. SD PUMP.
TGHI	TEGH	7.78E-08	ADGQX120 FMODMDELCH FQ1PXP4	LOSS OF NORMAL POWER INITIATING EVENT DIESEL GENERATOR 15G-120 OUT OF SERVICE DUE TO MAINTENANCE <module> MD PUMP 9B FAILS TO DELIVER COGNITIVE ERROR FOR OPS. FAILING TO INIT. SD PUMP.
TEH1	TEH	7.71E-08	ACRRC54 AMODCFLNPKAB FQ1PXP4	RECOVERY OF AC POWER IN 54 MINUTES <module> COMMON CAUSE FAILURE OF AC POWER GIVEN AN LMP OF FAILS TO PLACE THE SD PUMP TRAIN IN SERVICE-PROC. ERRORS.
TEH1	TEH	6.76E-08	ADGQX120 FMODMDELCH FQ1ORP4	LOSS OF NORMAL POWER INITIATING EVENT DIESEL GENERATOR 15G-120 OUT OF SERVICE DUE TO MAINTENANCE <module> MD PUMP 9B FAILS TO DELIVER SD AFW PUMP P4 IS O.O.S. FOR MAINT.
TEH1	TEH	6.12E-08	ADGQX120 FMODSDFEILD FF9QX9B	LOSS OF NORMAL POWER INITIATING EVENT DIESEL GENERATOR 15G-120 OUT OF SERVICE DUE TO MAINTENANCE <module> SD PUMP FAILS TO DEL AFW TO HEADERS AFW MD PUMP 9B IS O.O.S. DUE TO MAINT.
TEGH1	TEGH	5.90E-08	AMOD24CLNFI FMODMDELCH FMODSDFEILD	FAILURE OF BUS 24C LMP LOGIC <module> MD PUMP 9B FAILS TO DELIVER <module> SD PUMP FAILS TO DEL AFW TO HEADERS RECOVERY OF AC POWER IN 54 MINUTES
TEH1	TEH	5.39E-08	AMODGCAFLTJI AMODGCAFLTKI FQ1PXP4	B/C 15G-120 FAULTS <module> D/G 15G-130 FAULTS OF FAILS TO PLACE THE SD PUMP TRAIN IN SERVICE-PROC. ERRORS.
TEH1	TEH	5.39E-08	AB2CXDT2 FMODDADELCA FMODSDFEILD	TIE BREAKER 24D-IT-2 FAILS TO OPEN <module> MD PUMP TRAIN A FAILS TO DELIVER <module> SD PUMP FAILS TO DEL AFW TO HEADERS LOSS OF NORMAL POWER INITIATING EVENT
TEH1	TEH	5.23E-08	AB2CXCY2 FMODMDELCH FMODSDFEILD	TIE BREAKER 24C-IT-2 FAILS TO OPEN <module> MD PUMP 9B FAILS TO DELIVER <module> SD PUMP FAILS TO DEL AFW TO HEADERS LOSS OF NORMAL POWER INITIATING EVENT
TEH1	TEH	5.15E-08	AMOD24LHPEKI FMODDADELCA FMODSDFEILD	FAILURE OF BUS 24D LMP LOGIC <module> MD PUMP TRAIN A FAILS TO DELIVER <module> SD PUMP FAILS TO DEL AFW TO HEADERS LOSS OF NORMAL POWER INITIATING EVENT
TEH1	TEH	5.15E-08	FEDCCFHDRG MAVC190B	CCF's OF THE COMMON INJECTION HEADER VALVES RANDOM MECHANICAL FAILURE OF ADV MS-190B LOSS OF NORMAL POWER INITIATING EVENT
TEH1	TEH	4.80E-08	MAVC190A ADGQX120 FF9QX9B	CCF's OF THE COMMON INJECTION HEADER VALVES RANDOM MECHANICAL FAILURE OF ADV MS-190A DIESEL GENERATOR 15G-120 OUT OF SERVICE DUE TO MAINTENANCE AFW MD PUMP 9B IS O.O.S. DUE TO MAINT.
TEH1	TEH	4.68E-08	FQ1PXP4 FMODMDELCH FMODSDFEILD AMODSAPTSAIN	COGNITIVE ERROR FOR OPS. FAILING TO INIT. SD PUMP. LOSS OF NORMAL POWER INITIATING EVENT <module> MD PUMP 9B FAILS TO DELIVER <module> SD PUMP FAILS TO DEL AFW TO HEADERS <module> SD PUMP 5A FAILS TO START OR ESPRS EQUIPMENT FAILS

TEH1	TEH	4.68E-08	.4	T8	LOSS OF NORMAL POWER INITIATING EVENT
				FNCDDADELCA	<module> NO PUMP TRAIN A FAILS TO DELIVER
				FNCDDDPDELD	<module> SD PUMP FAILS TO DEL AFW TO HEADERS
				WNCDDP5CFTSHW	<module> SW PUMP 5C FAILS TO START OR ESPAS EQUIPMENT FAILS
TLGL1	TLGL	4.38E-08	.4	T8	LOSS OF NORMAL POWER INITIATING EVENT
				ACREC13	RECOVERY OF AC POWER IN 13 HOURS (MEAN COPING TIME)
				AMOD24CLNPI	<module> FAILURE OF BUS 24C LNP LOGIC
				AMODDGBFLTKI	<module> D/G 15G-13U FAULTS
TEH1	TEH	4.35E-08	.4	T8	LOSS OF NORMAL POWER INITIATING EVENT
				AMOD24CLNPI	<module> FAILURE OF BUS 24C LNP LOGIC
				FNCDDDBDELCA	<module> NO PUMP 9B FAILS TO DELIVER
				FQIPXCP4	COGNITIVE ERROR FOR OPS. FAILING TO INIT. SD PUMP.
TEGH1	TEGH	4.03E-08	.3	T8	LOSS OF NORMAL POWER INITIATING EVENT
				ACREC54	RECOVERY OF AC POWER IN 54 MINUTES
				ADGQK12U	DIESEL GENERATOR 15G-12U OUT OF SERVICE DUE TO MAINTENANCE
				AMODDGBFLTKI	<module> D/G 15G-13U FAULTS
				FNCDDDPDELD	<module> SD PUMP FAILS TO DEL AFW TO HEADERS
TEGH1	TEGH	4.03E-08	.3	T8	LOSS OF NORMAL POWER INITIATING EVENT
				ACREC54	RECOVERY OF AC POWER IN 54 MINUTES
				ADGQK13U	DIESEL GENERATOR 15G-13U OUT OF SERVICE DUE TO MAINTENANCE
				AMODDGBFLTKI	<module> D/G 15G-12U FAULTS
				FNCDDDPDELD	<module> SD PUMP FAILS TO DEL AFW TO HEADERS
TEH1	TEH	3.95E-08	.3	T8	LOSS OF NORMAL POWER INITIATING EVENT
				AMOD24CLNPI	<module> FAILURE OF BUS 24C LNP LOGIC
				FNCDDDBDELCA	<module> NO PUMP 9B FAILS TO DELIVER
				FQIQXCP4	SD AFW PUMP P4 IS O.O.S. FOR MAINT.
TLGL1	TLGL	3.85E-08	.3	T8	LOSS OF NORMAL POWER INITIATING EVENT
				AB2GKCT2	TIE BREAKER 24C-IT-2 FAILS TO OPEN
				ACREC13	RECOVERY OF AC POWER IN 13 HOURS (MEAN COPING TIME)
				AMODDGBFLTKI	<module> D/G 15G-13U FAULTS

---

TOTAL: 8.67E-06 71.68% of CN Total Frequency 1.21E-05