

SAFETY RELATED YES NO

**SAFETY RELATED CALCULATIONS
FOR NON-SAFETY RELATED SYSTEM**

FORMAL
PIPING STRESS ANALYSIS
COMMONWEALTH EDISON COMPANY
LASALLE - UNIT 2
MAIN STEAM SYSTEM
2MS-56

Rev.: 00 Date: 8-11-82

ACCESSION NO. EMD- 037954

Information on the following
page(s) 14-18, 22

is adequate for the purpose of EMD RECORD CENTER
use.

Approved by S. D. Gillian NOV 24 1982
RECEIVED

Page 1 of 22



ENGINEERING MECHANICS DIVISION

SARGENT & LUNDY
ENGINEERS
CHICAGO

PROJECT NO.: 4267-00
ACC. NO.: EMD-037954
CALC. NO.: 2MS-56
REV.: 00 DATE: 8-11-82
PAGE 2 OF 22

SIGNATURE PAGE

PREPARED BY: James Thompson DATE: 8-11-82
J. Thompson

REVIEWED BY: S. Sharma DATE: 8-11-82
S. Sharma

ANALYSIS RESULTS
APPROVED BY: S. Killian DATE: 8-11-82
S. Killian

STRESS REPORT
APPROVED BY: S. Killian DATE: 10/29/82
S. Killian

FIRST ISSUE

THIS ANALYSIS SUPERSEDES:

REV.:

DATE:

ACC. NO.: EMD-

PROJECT NO.: 4267-00
ACC. NO.: EMD-037954
CALC. NO.: 2MS-56
REV.: 00 DATE: 8-11-82
PAGE 3 OF 22

TABLE OF CONTENTS

<u>Part I - To Be Filmed</u>	Page
1. Title Page.....	1
2. Signature Page.....	2
3. Table Of Contents.....	3
4. Subsystem Documentation.....	4
5. Analyses Performed.....	5
6. Checklist.....	6-11
7. General Notes.....	12
8. Subsystem Plot.....	13
9. Analytical Drawing.....	14-18
10. Equipment Nozzle Reactions and Allowables.....	-
11. Miscellaneous.....	-
12. Calculations.....	19-22

<u>Part II - Do Not Film</u>	Check
1. Combined Reactions	
a. Input.....	<input checked="" type="checkbox"/>
b. Max. Combined Anchor/Valve-End Reactions.....	<input checked="" type="checkbox"/>
c. Max. Rigid Restraint Loads.....	<input checked="" type="checkbox"/>
d. Thermal Mvt. At The Nodes.....	<input checked="" type="checkbox"/>
e. Spring Hanger Data.....	<input checked="" type="checkbox"/>
f. Hydraulic Snubber Data.....	<input checked="" type="checkbox"/>
2. Miscellaneous	
a. Restraint Change Requests	
b. Condenser Allowables	
c. Valve Accelerations	
d. Restraint drawings	

Part III

Computer Output Microfiche (COM)

Includes "Analyses Performed" as listed in Part I/Page 5
Number of COM cards 04.

PROJECT NO.: 4267-00
ACC. NO.: EMD-03795A
CALC. NO.: 2MS-56
REV.: 00 DATE: 8-11-82
PAGE 4 OF 22

SUBSYSTEM DOCUMENTATION

System: Main Steam Subsystem: 2MS-56

Piping Classification Group: D Seismic Yes No

Initial Formal Certified Analysis

REFERENCES

1. Certified System Design Spec.: No.: _____ Rev.: _____ Date: _____
2. Anal. Drawing: No.: M-2000-56 Rev.: A Date: 9-29-82
3. P&ID Drawings: No.: _____ Rev.: _____ Date: _____
4. Equip. Spec.: No.: _____ Rev.: _____ Date: _____

5. Seismic Information:

LASALLE2*SPECTRA-REV1

6. Other:

PROJECT NO.: 4267-00
ACC. NO.: EMD-037954
CALC. NO.: 2MS-56
REV.: 00 DATE: 8-11-82
PAGE 5 OF 22

ANALYSES PERFORMED

Loadings	Date	Comments	Check-list Item No.	Sec.
BASIC DATA	8-11-82	BASIC DATA INPUT	1.0	C
WEIGHT	8-11-82	REGULAR WEIGHT ANALYSIS	3.0	E
THERMAL	8-11-82	MODE 1 - NORMAL OPER. TEMP.	2.0	D
	8-11-82	MODE 2 - STARTUP OPERATION	2.0	D
DYNAMIC	8-11-82	OBE HALF PERCENT	5.0	F
HYDRO	8-11-82	INCLUDED, BUT UNNECESSARY		

ROW ID: ST19

VALIDATED PROGRAMS USED:

PIPSYS NOHEAT SRVA

PROJECT NO.: 4267-00
 ACC. NO.: EMD-037954
 CALC. NO.: ZMS-56
 REV.: 00 DATE: 8-11-82
 PAGE 6 OF 23

DESCRIPTION	CHECKED*	COMMENTS
1.0 <u>Basic Design Data</u> (Output Section C)		
1.1 Have all branch lines met the criteria $I_R/I_B \leq 7.0$?	✓	N.A
1.2 Are all material types coded correctly?	✓	
1.3 Are all pipe/fitting thicknesses and uniform weights coded correctly?	✓	
1.4 Are all motor or pneumatic-operated valves modeled using lumped masses and cg's?	✓	
1.5 Is the system modeled correctly (length ratios, etc.)?	✓	
1.6 Are all hangers/restraints modeled correctly?	✓	
1.7 Are there any special modeling techniques used in the analyses (equipment flexibility, special restraint configurations, etc.)?	X	
1.8 Are all node types coded correctly?	✓	
1.9 Is the internal pressure (max. op. pressure) coded in psig?	✓	

* In this column on this Form, a check mark (✓) indicates an affirmative answer (yes).

SAFETY-RELATED
MECHANICAL DEPARTMENT STANDARD
 CHECKLIST FOR
 PIPING SYSTEM STRESS ANALYSIS

FOR OFFICE USE ONLY - NOT TO BE SENT OUTSIDE OF SARGENT & LUNDY



Form MAC-EMD-2.2 Approved by M. J. DeGeroni
 Dept. Mgr.
 Rev. Orig. (7-31-80)

CALC. NO.:	REV.:	DATE:	PROJECT NO.: 4267-00
PROJECT NUMBER:		EMD FILE N	ACC. NO.: EMD-037954
DESCRIPTION			CALC. NO.: 2MS-56
			REV.: 00 DATE: 8-11-82
			PAGE 7 OF 22

2.0 Thermal Analysis (Output Section D)

- 2.1 Are all specified thermal modes analyzed correctly? ✓
- 2.2 Is the anchor movements input correct? ✓
- 2.3 Are all the deflections reasonable? (If over 1.5" specify) ✓

3.0 Weight Analysis (Output Section E)

- 3.1 Is the overall support system balanced? ✓
- 3.2 Are all pipe deflections within 0.2 inches? ✓

4.0 Equivalent Static Load Analyses (Output Section D)

The following analyses are performed using the PIPSYS static analysis routine:

- a-
- b-
- c-
- d-
- e-
- f-
- g-
- h-

- 4.1 Are all design parameters in agreement with the stress analysis?
- 4.2 Are the forces input correctly in the PIPSYS with respect to magnitude, direction and point of action?
- 4.3 Has the effect of seismic differential anchor movements been considered and have the data sources been documented?

a	b	c	d	e	f	g	h

N.A.

↓

Form MAS-EMD-2.2 Rev. Orig. (7-31-80)

DESCRIPTION	a	b	c	d	e	f	g	h
5.0 <u>Dynamic Analyses</u> (Output Section F)								
5.1 The following analyses are performed using response spectra method (Seismic in PIPSYS Output):								
a-Seismic <i>OBEHALFPERCENT</i>	✓							
b-								
c-								
d-								
e-								
f-								
g-								
h-								
5.1.1 Are the latest revisions of response spectra used for the analysis?	✓							
5.1.2 Are the length ratios acceptable?	✓							
5.1.3 Does cutoff frequency cover the peak acceleration value?	✓							
5.1.4 Is the square root of the double sum method used to combine the modal responses?	✓							
5.1.5 Are all the deflections reasonable? (If over 1.0" OBE, specify)	✓							
5.1.6 Has the effect of seismic differential anchor movements been considered?	X							
5.2 The following analyses are performed using the forcing function method (Transient in PIPSYS Output):								
a-								
b-								
c-								
d-								
e-								
f-								
g-								
h-								

N.A.

↓

Form MAS-EMD-2.2
Rev. Orig. (7-31-80)

DESCRIPTION	a	b	c	d	e	f	g	h
5.2.1 Is the force calculation design basis listed or referenced?								
5.2.2 If force calculations are not attached to this analysis, are they referenced?								
5.2.3 Are all necessary design parameters specified in this analysis (opening/closing times, flow rates, etc.)?								
5.2.4 If a safety/relief valve analysis is performed:								
a. Does the steam stagnation pressure and density reflect the S/RV set point?								
b. Are the pipe ID and segment lengths input correctly in the SRVA program?								
c. Is the pipe submerged length correctly calculated and input?								
d. Is the correct density used in the calculation?								
5.2.5 Are the forces input correctly in the PIPSYS with respect to magnitude, direction and point of action?								
5.2.6 Are the equipment reactions included with the correct load set?								
6.0 <u>Thermal Transient Analysis</u> (ASME Class 1 Piping Only)								
6.1 Are the results of transient analysis attached to this report?								

N.A.



Form MAS-EMD-2.2
Rev. Orig. (7-31-80)

DESCRIPTION	GN	
6.2 Are all transient stresses identified and are the NOHEAT RUNS properly documented?		N.A. ↓
6.3 Are thermal transient conditions and cycles correct?		
6.4 Are all discontinuities considered?		
6.5 Are the film coefficients, densities and material thermal conductivity correct?		
6.6 Are correct time steps used in performing the transient analysis?		
<u>7.0 Hand Calculations</u>		
7.1 If hand calculations are not attached to this analysis, are they properly referenced?		
7.2 Are the calculations reviewed in accordance with GQ-3.08?		
<input type="checkbox"/> A detailed review of original calculation.		
<input type="checkbox"/> A review by an alternate, simplified or approximate method of calculation.		
<input type="checkbox"/> A review of a representative sample of repetitive calculations.		
<input type="checkbox"/> A review of the calculation against a similar calculation previously performed.		
<u>8.0 Combined Stresses (Output Section A)</u>		
8.1 Are the stresses within the allowables?	✓	
8.2 Are the allowable stresses for the materials used in the analysis in agreement with the Code?	✓	
8.3 Is the design pressure correct?	✓	

Form MAS-EMD-2.2
Rev. Orig. (7-31-80)

CALC. NO.:	REV.:	DATE:	PROJECT NO.: 4267-00
PROJECT NUMBER:		EMD FILE NO.:	ACC. NO.: EMD-037954
			CALC. NO.: 2MS-56
			REV.: 00 DATE: 8-11-82
			PAGE 11 OF 22

DESCRIPTION	C.	
8.4 Are all thermal load combinations specified in accordance with the design specification?	✓	
8.5 Are all mechanical loads listed, per the design specification, as service level B, C or D?	✓	
8.6 Are the number of earthquake cycles calculated per the design specification or per SRP-3.7.3?	N.A.	
8.7 Are all high-stress/usage factor (over 0.1) points run with the detailed output?	N.A.	
9.0 <u>Combined Reactions</u> (Output Section B)		
9.1 Are all applicable forces and moments considered for both service levels B and C?	✓	
9.2 Are all the equipment nozzles identified correctly?	✓	
9.3 Are equipment loads and valve accelerations acceptable? Have they been forwarded to the EMD/CAS?	✓	
9.4 Are the vendor supplied component supports able to carry the imposed loads?	✓	
9.5 Are all Type 3 restraints reviewed to determine if they can be replaced by rigid restraints?	✓	
9.6 Method used to combine the loads:	✓	
<input type="checkbox"/> Absolute Sum <input checked="" type="checkbox"/> SRSS		


Form MAS-EMD-2.2
Rev. Orig. (7-31-80)

GENERAL NOTES

I. The analysis is based on the following Code and S&L Programs:

- ASME Code, Sec. III - Class 3 of 1977 issue.
- ANSI B31.1 of issue.
- "PIPSYS" (Prog. No. 09.5.065- 5.3) of June 1, 1982 issue.
- "SRVA" (Prog. No.) of issue.
- "NOHEAT" (Prog. No. 09.5.075.) of issue.

II. Coordinate Systems:

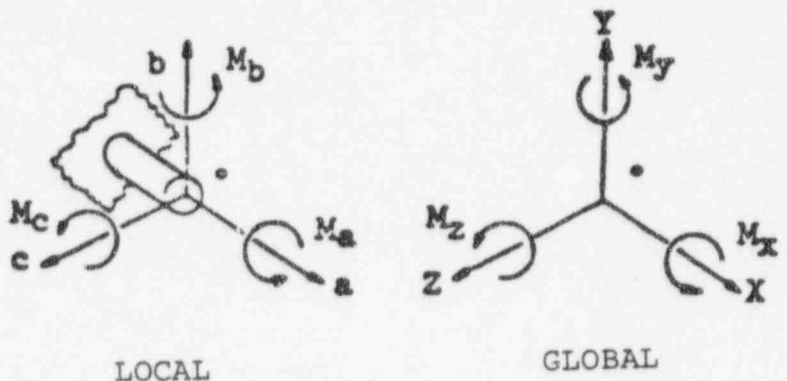


III. Conclusions & Design Requirement.

1. Maximum stresses are within the code allowables if the recommended restraint changes are made.
2. All valve accelerations, forces and moments are within the manufacturer's allowables, and similarly for the main condenser.
3. Analysis is based on as-built isometric received from EMD field dated 7-14-82


S21JJT 08/13/00

PLT-FILE-095


SCALE: 1 INCH = 0.11 FEET

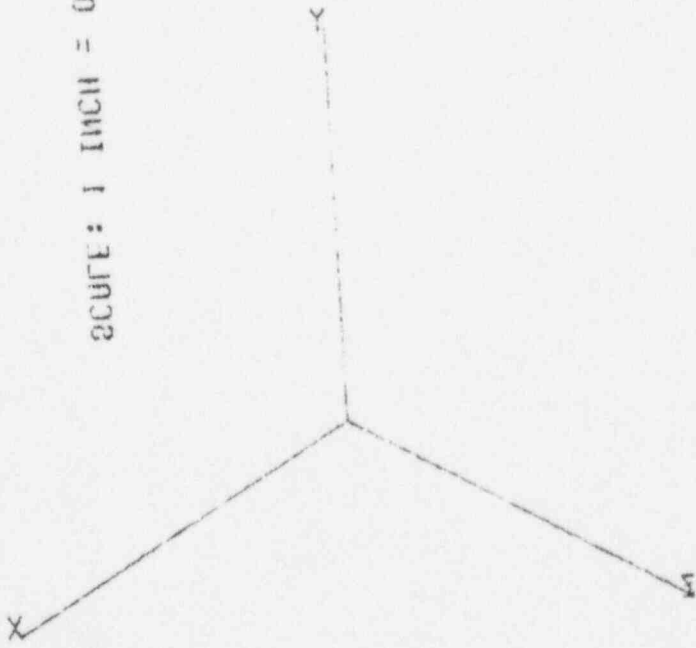

PROJECT NO.: 4267-00
ACC. NO.: EMD-037954
CALC. NO.: 2MS-56
REV.: 00 DATE: 8-11-82
PAGE 13 OF 22

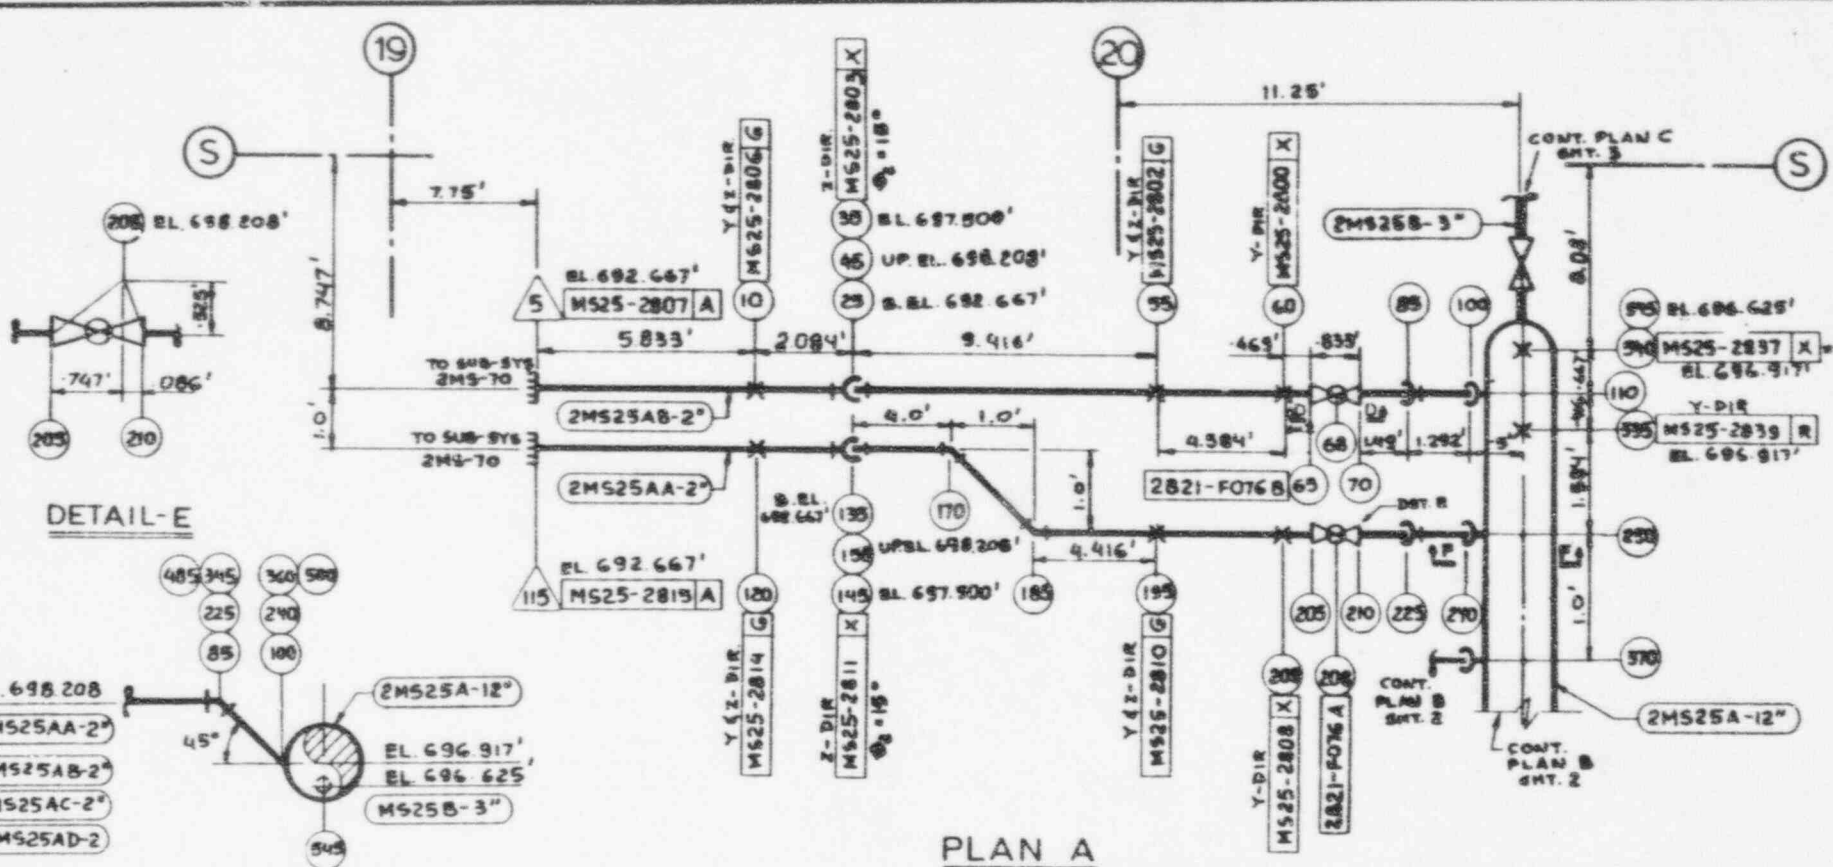


DETAIL-E

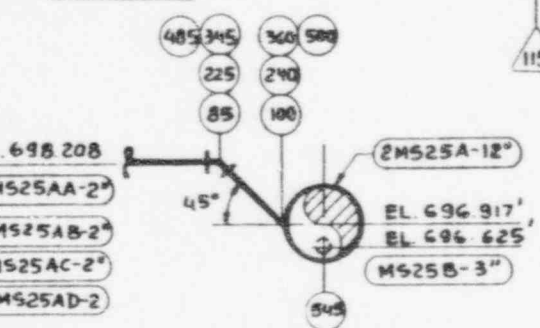

SECTION F-F

PLAN A

PROJECT NO.: 4267-00
 ACC. NO.: EMD-037954
 CALC. NO.: 2MS-56
 REV.: 00 DATE: 8-11-82
 PAGE 14 OF 22

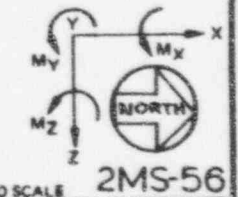

TURBINE BUILDING

REFERENCE DRAWINGS	DWG. NO.	REV.	DWG. NO.	REV.	DWG. NO.	REV.	DWG. NO.	REV.	DWG. NO.	REV.
	M-900-22		M-116-2	H						
	M-966-43									

RELEASE RECORD

REV.	DATE	PREPARED	REVIEWED	APPROVED	PURPOSE	FILM
A	9-29-82	RK in	<i>[Signature]</i>	<i>[Signature]</i>	RELEASED PER EMD #037394	

PIPING ANALYTICAL & PHYSICAL DATA	
FOR	MAIN STEAM PIPING SYSTEM
PROJECT	LA SALLE COUNTY-2
CLIENT	COMMONWEALTH EDISON CO.
PROJECT NO.	4267-00

NO SCALE 2MS-56


SARGENT & LUNDY
CHICAGO

SUB SYSTEM NO.	REV.
M-2000-56	A

SHEET 1 OF 5

Approved by *[Signature]*
 Rev. A (10-14-77)
 Dept. Mgr.

George T. ...
 Form MS-6.4.1 Approved by
 Rev. A (10-14-77)
 Dept. Nat.

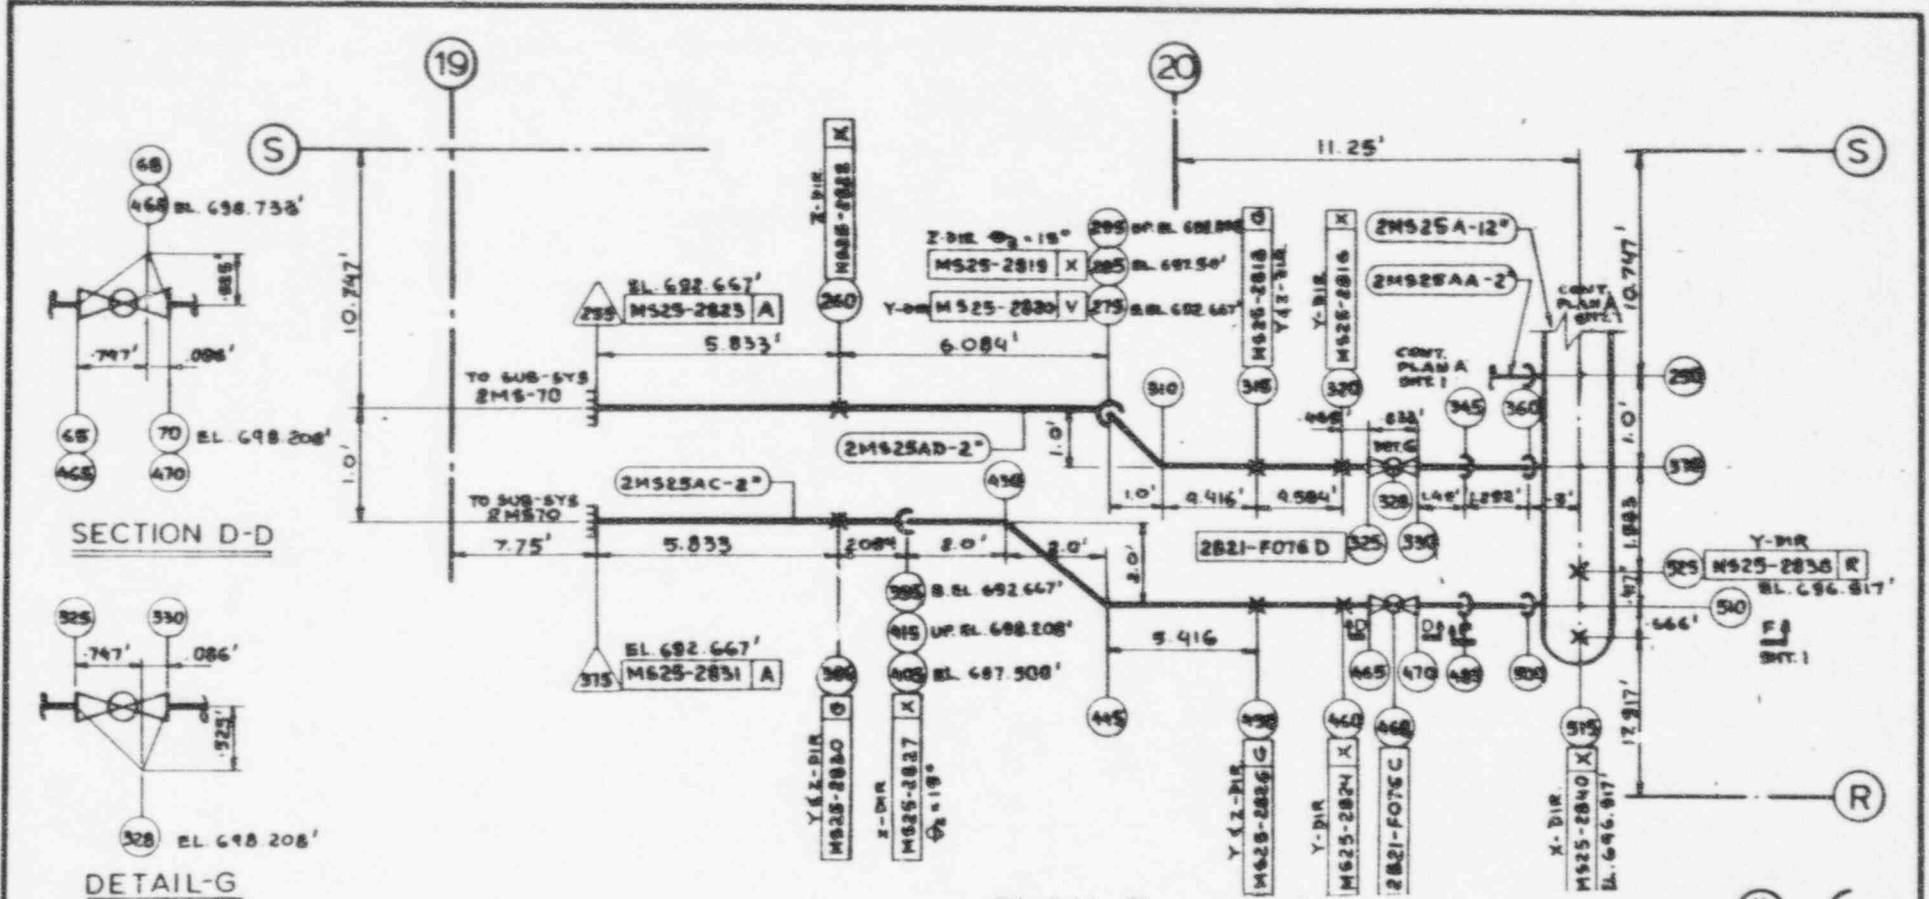

TURBINE BUILDING

REFERENCE DRAWINGS	DWG NO	REV	DWG NO	REV	DWG NO	REV	DWG NO	REV	DWG NO	REV
	M-900-22		M-116-7	H						
	M-966-43									

RELEASE RECORD						
REV	DATE	PREPARED	REVIEWED	APPROVED	PURPOSE	FILM
A	9-28-82	RKin	<i>[Signature]</i>	<i>[Signature]</i>	RELEASED PER EMD P57954	

PLAN B

PROJECT NO.: 4267-00
 ACC. NO.: EMD-037954
 CALC. NO.: 2MS-56
 REV.: 00 DATE: 8-11-82
 PAGE 15 OF 22




NO SCALE 2MS-56

PIPING ANALYTICAL & PHYSICAL DATA
 FOR MAIN STEAM PIPING SYSTEM
 PROJECT LA SALLE COUNTY-2
 CLIENT COMMONWEALTH EDISON CO.
 PROJECT NO. 4267-00

SARGENT & LUNDY CHICAGO	
SUB SYSTEM NO.	REV.
M-2000-56	A
SHEET 2 OF 5	

0 57L

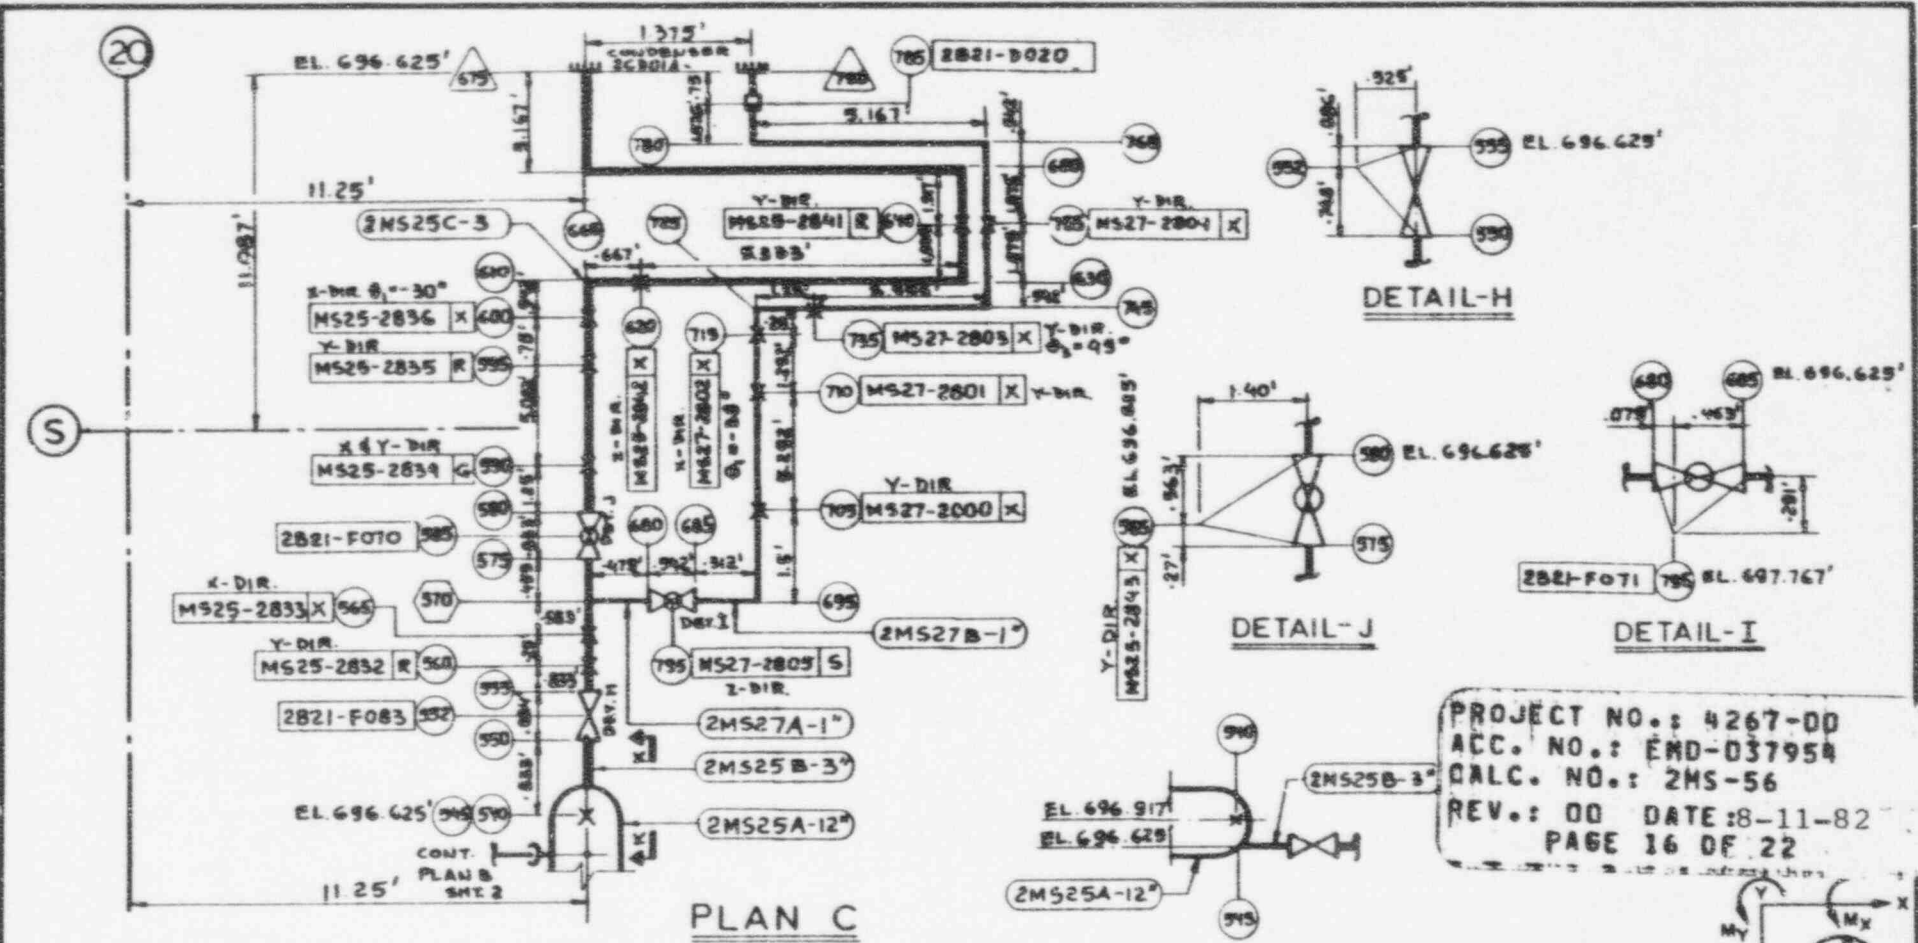

PROJECT NO.: 4267-00
 ACC. NO.: EMD-037954
 CALC. NO.: 2MS-56
 REV.: 00 DATE: 8-11-82
 PAGE 16 OF 22



NO SCALE 2MS-56

TURBINE BUILDING

REFERENCE DRAWINGS	DWG NO.	REV	DWG NO.	REV	DWG NO.	REV	DWG NO.	REV	DWG NO.	REV
	M-900-22		M-116-2	H						
	M-966-43									

RELEASE RECORD						
REV	DATE	PREPARED	REVIEWED	APPROVED	PURPOSE	FILM
A	9-29-82	RCin	[Signature]	[Signature]	RELEASED PER EMD037954	

PIPING ANALYTICAL & PHYSICAL DATA
 FOR MAIN STEAM PIPING SYSTEM
 PROJECT LA SALLE COUNTY - 2
 CLIENT COMMONWEALTH EDISON CO.
 PROJECT NO. 4267-00

SARGENT & LUNDY
 CHICAGO

SUB SYSTEM NO.	REV.
M-2000-56	A

SHEET 3 OF 5

Approved by [Signature]
 Dept. Mgr.
 Rev. A (10-14-77)

PIPE DATA

REV	NODE POINTS		LINE NUMBER	CLASS	PIPING DESIGN TABLE	MATERIAL		DESIGN PRESS.	MAX OPER.		O.D.	SCHED.	WALL THICK.	INSUL THICK.	WEIGHTS - LBS./LINEAL FT.						
	FROM	TO				SPEC.	GR.		PRESS.	TEMP.					1 PIPE	2 OPER FLUID	3 INSUL.	OPER TOTAL	1+2+3	4 WATER	HYDRO 1+4
						ASTM A-335	PS														
	5	100	2MS25AB-2"	D B	+930LS			1250	1025	550°	2.375	80	.218	2.5	5.02	0.020	3.65	8.69	1.28	6.30	
	115	240	2MS25AA-2"	D B	+930LS						2.375		.218	2.5	5.02	0.020	3.65	8.69	1.28	6.30	
	255	300	2MS25AD-2"	D B	+930LS						2.375		.218	2.5	5.02	0.020	3.65	8.69	1.28	6.30	
	375	500	2MS25AC-2"	D B	+930LS						2.375		.218	2.5	5.02	0.020	3.65	8.69	1.28	6.30	
	515	545	2MS25A-12"	D B	+930LS						12.75		.687	3.0	88.50	1.673	13.10	103.27	44.0	132.5	
	545	580	2MS25B-3"	D B	+930LS						3.50		.300	2.5	10.25	0.050	4.45	14.75	2.86	18.11	
	580	675	2MS25C-3"	D N	930LS						3.50		.300	2.5	10.25	0.050	4.45	14.75	2.86	18.11	
	570	685	2MS27A-1"	D B	+930LS						1.315		.179	2.0	2.17	0.012	2.10	4.28	0.31	2.48	
	685	790	2MS27B-1"	D N	930LS						1.315		.179	2.0	2.17	0.012	2.10	4.28	0.31	2.48	

VALVE & SPECIAL FITTINGS DATA

REV	NODE POINTS		TYPE	PRESSURE RATING	VAL STROKING TIME (SEC.)		VAL/FIT WT LBS.		OPERATOR WT LBS.		FLEXIBILITY INFO		VENDOR	DRAWING NO.	REV	REMARKS
	FROM	TO			OPEN	CLOSE	PRELIM	ACTUAL	PRELIM	ACTUAL	O.D.	THICK				
	65	70			2" VV GLOBE VA	900#			85							
209	210		900#			85				2.375	.654		03-6400-510		2821-F076A	
329	330		900#			85				2.375	.654		03-6400-510		2821-F076D	
465	470		900#			85				2.375	.654		03-6400-510		2821-F076C	
550	555	2" VV GLOBE VA	900#			85				3.50	.900		04-4010-510		2821-F083	
575	580	3" VA AS	900#			95	115	115		3.50	.900		03-6497-550		2821-F070	
680	685	1" VA AS	900#			20		142		1.313	.537		03-6498-300		2821-F071	
	785		ORIFICE					.875				DRAGON VALVE INC.	12250 J-2956		2821-D020	

PROJECT NO.: 4267-00
 ACC. NO.: EMD-037954
 CALC. NO.: 2MS-56
 REV.: 00 DATE: 8-11-82
 PAGE 17 OF 22

2MS-56

RELEASE RECORD

REV	DATE	PREPARED	REVIEWED	APPROVED	PURPOSE	FILM
A	9-29-82	RKC	<i>[Signature]</i>	<i>[Signature]</i>	RELEASED PER EMD-037954	

PIPING ANALYTICAL & PHYSICAL DATA

FOR MAIN STEAM PIPING SYSTEM
 PROJECT LA SALLE COUNTY-2
 CLIENT COMMONWEALTH EDISON CO
 PROJECT NO. 4267-00



SUB SYSTEM NO. M-2000-56
 REV. A
 SHEET 4 OF 5

706 10-14-77

DEPT. MGR. REV. FOR 10-14-77



George Tolson

SCHMATIC OF MODES TO BE ANALYZED

TOTAL NO. OF MODES REQUIRED _____

MODE NO. 1 MODE DESCRIPTION: NORMAL OPERATION CONDITION

MODE NO. 2 MODE DESCRIPTION: START-UP/SHUTDOWN OPERATION CONDITION

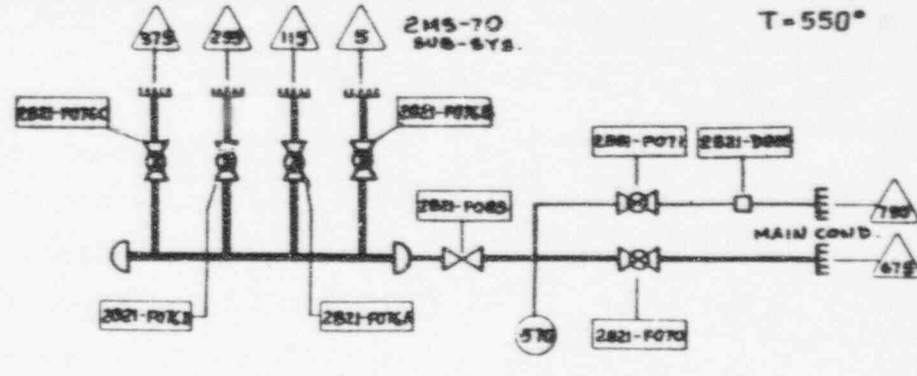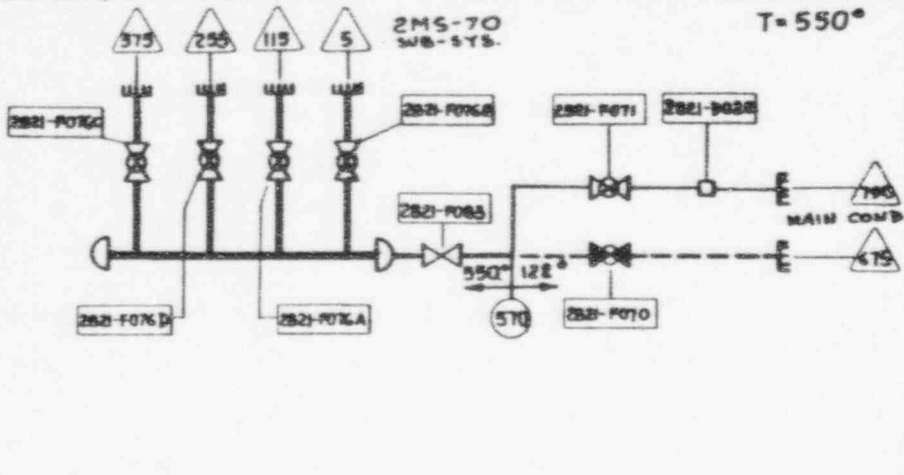

NOTE: ——— DELINEATES FLOW PATH

PROJECT NO.: 4267-00
 ACC. NO.: EMD-037954
 CALC. NO.: 2MS-56
 REV.: 00 DATE: 8-11-82
 PAGE 18 OF 22

REV	MODE NO. <u>1</u>										EQUIPMENT INFORMATION										MODE NO. <u>2</u>									
	NODE POINT	TEMP	TERMINAL MOVEMENTS			CALC BY		EQUIPMENT NUMBER	EQUIPMENT TITLE	VENDOR	DRAWING NO.	REV.	REMARKS	REV.	NODE POINT	TEMP	TERMINAL MOVEMENTS			CALC BY										
			ΔX	ΔY	ΔZ	VDR	SBL										ΔX	ΔY	ΔZ	VDR	SBL									
	5	550°	0	0	0			ANCHOR		M525-2807A				5	550°	0	0	0												
	115		0	0	0					M525-2815A				115		0	0	0												
	255		0	0	0					M525-2823A				255		0	0	0												
	375		0	0	0					M525-2821A				375		0	0	0												
	675	122°	1703	0456	2293		2CDO1A	CONDENSER	WECO	J-2819 731J321				675		1703	0456	2293												
	790	550°	1608	0456	2293									790		1608	0456	2293												

RELEASE RECORD						
REV	DATE	PREPARED	CHECKED	ENG'R APPL.	REV DESCRIPTION	FILM
A	9-29-82	RK:u	<i>[Signature]</i>	<i>[Signature]</i>	RELEASED PER EMD#037954	

PIPING ANALYTICAL & PHYSICAL DATA
 FOR MAIN STEAM PIPING SYSTEM
 PROJECT LA SALLE COUNTY CO
 CLIENT COMMONWEALTH EDISON CO
 PROJECT NO. 4267-00

SARGENT & LUNDY




SUB SYSTEM NO. M-2000-56
 REV. A
 SHEET 5 OF 5

5. Shen 11.88
 Approved by *[Signature]*
 Form MS-6.4.3 Approved by *[Signature]*
 Rev. A (10-14-77)

Client	CECO	
Project	LASALLE	
Proj. No.	4267	Equip. No.

Prepared by	Jim Thompson	Date	8-6-82
Reviewed by		Date	
Approved by		Date	

FOR NODES 110, 250, 370, 510

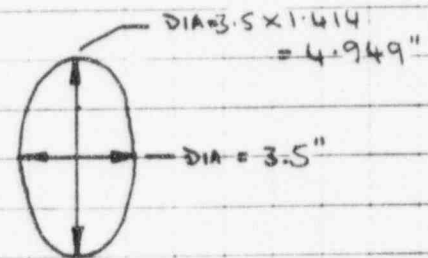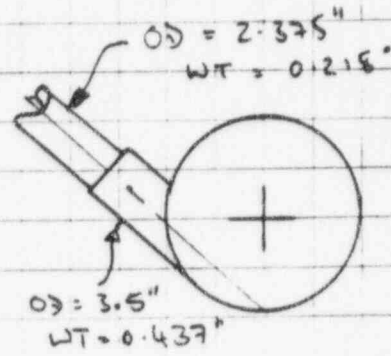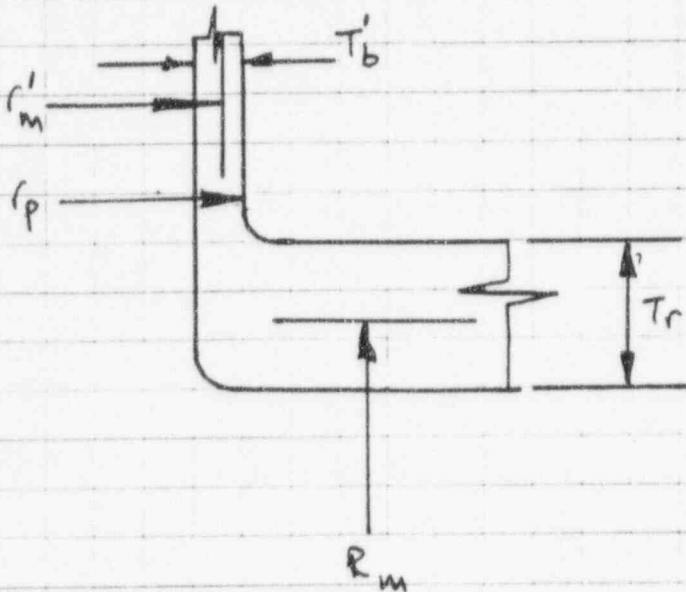

ASSUMPTION: FOR CALL USE LARGER DIA OF ELLIPSE AS SHOWN

REFERENCE:

FROM PIPSYS PAGE 12-2-10

STRESS INTENSIFICATION FACTOR, I, FOR BRANCH:

$$I = 1.5 \left(\frac{R_m}{T_r} \right)^{2/3} \left(\frac{r'_m}{R_m} \right)^{1/2} \left(\frac{T'_b}{T_c} \right) \left(\frac{r'_m}{r_p} \right)$$

where

$$R_m = \text{mean radius of run pipe} = \frac{12.75 - 0.687}{2} = 6.032''$$

$$T_r = \text{nominal thickness of run pipe} = 0.687''$$

$$r'_m = \text{mean radius of branch pipe} = \frac{4.949 - 0.618}{2} = 2.166''$$

$$T_c = T'_b = \text{nominal thickness of branch pipe} = 0.437 \times 1.414 = 0.618''$$

$$r_p = \text{outside radius of branch pipe} = \frac{3.5 \times 1.414}{2} = 2.475''$$



Calcs. For 2MS-56
 User coded stress intensification
 Safety-Related Non-Safety-Related

PROJECT NO.: 4267-00
 ACC. NO.: EMD-037954
 CALC. NO.: 2MS-56
 REV.: 00 DATE: 8-11-82
 PAGE 20 OF 22

Client CECO
 Project LASALLE
 Proj. No. 4267 Equip. No.

Prepared by Jim Thompson Date 6.6.82
 Reviewed by Date
 Approved by Date

$$\begin{aligned} \therefore I_1 &= 1.5 \left(\frac{6.032}{0.687} \right)^{2/3} \left(\frac{2.166}{6.032} \right)^{1/2} \left(\frac{0.618}{0.618} \right) \left(\frac{2.166}{2.475} \right) \\ &= 1.5 (4.256) (0.599) (1.000) (0.875) \\ &= 3.346 \end{aligned}$$

for inclination, use factor of 2

$$I'_1 = 2I_1 = 2(3.346) = \underline{\underline{6.692}}$$

for NODE 545

$$\begin{aligned} R_m &= 6.032'' \\ T_r &= 0.687'' \\ r'_m &= \frac{3.5 - 0.3}{2} = 1.60'' \\ T'_b &= 0.30'' = T_t \\ r_p &= 3.50'' \end{aligned}$$


$$\begin{aligned} I_2 &= 1.5 \left(\frac{R_m}{T_r} \right)^{2/3} \left(\frac{r'_m}{R_m} \right)^{1/2} \left(\frac{T'_b}{T_t} \right) \left(\frac{r'_m}{r_p} \right) \\ &= 1.5 (4.256) (0.515) (1.000) (0.457) \\ &= 1.50 \end{aligned}$$

Safety-Related

Non-Safety-Related


Client	CECO	Prepared by	Jim Thompson	Date	6.82
Project	LASALLE	Reviewed by		Date	
Proj. No.	4267	Approved by		Date	
Equip. No.					

Use $I_2' = \underline{2.10}$ to be conservative

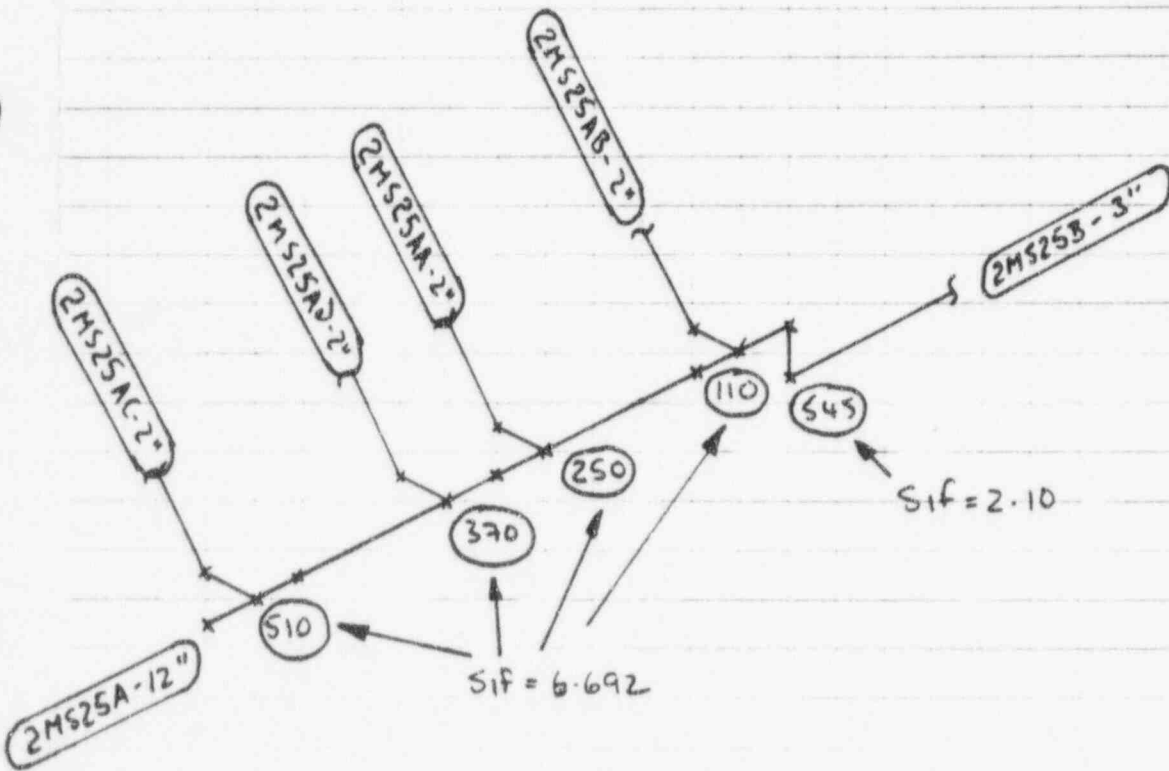

Client _____
 Project _____
 Proj. No. _____ Equip. No. _____

Prepared by *AMC*
 Reviewed by _____ Date _____
 Approved by _____ Date _____

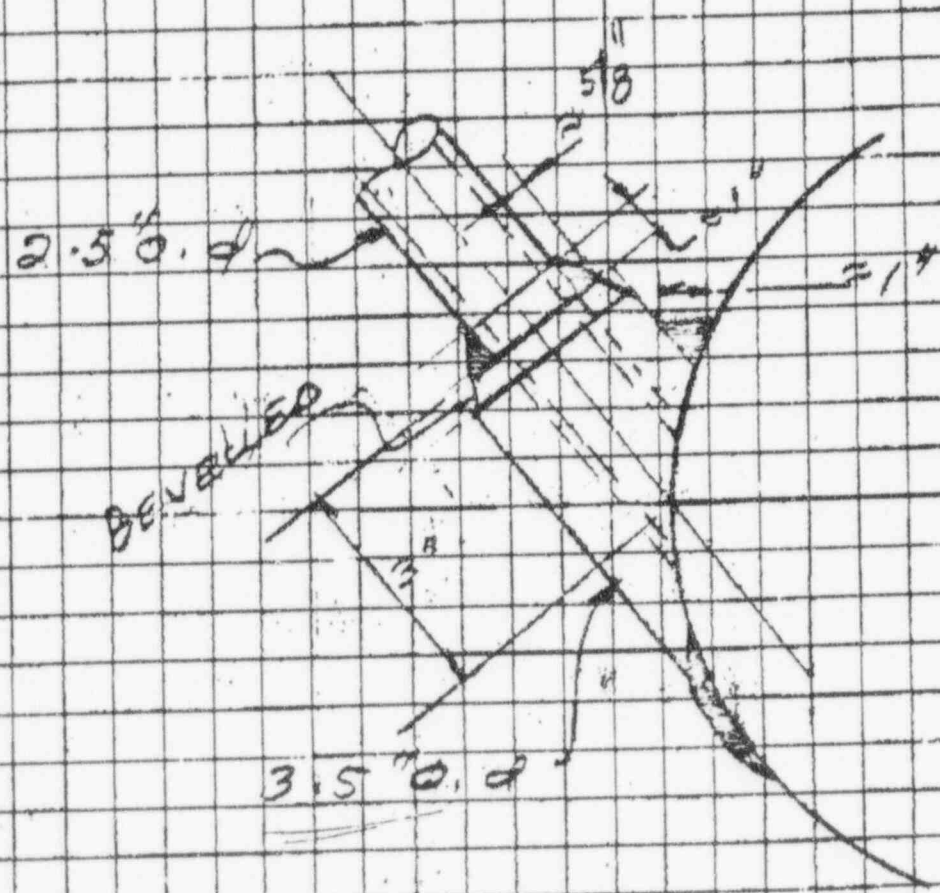

Rf. MS-56 & 57
A. M. CHAUDHARY
21 F 13

DO
NOT
FILM

SARGENT & LUNDY

INTER-OFFICE MEMORANDUM

From Jim Thompson Date 12 AUGUST, 1982
 Project No. 4267-00
 Dept./Div. Mechanical/EMD Spec. No. _____
 File No. _____
 Page No. 1 of 2

Client CECO Stn. LaSalle Unit 2
 Subject Request to Change or Add Restraints

To: J. C. Szydlik - 21
 CC: G. H. DeBoo - 21
 S. D. Killian - 21
 J. M. Nosko - 21
 B. R. Parduhn - 21
 W. Thiel - Field

FEASIBILITY OF CHANGES DISCUSSED
 AND AGREED TO BETWEEN A. CHAUDHARY
 AND S. MURTHY / D.S. DHILLON (EMD) IN
 FIELD

The following restraint request information for Subsystem _____ is to be examined by MDD and SDD. Required support location and angularity are given on the attached sketches.



Node Point	Support Design Basis Loads				Required Structure Support Must Attach To	Required Action
	SLA	SLB	SLC	SLD		
260 MS25-28224	38 9	192 -145	-	327 -279		RESTRAINT IS BUILT AS GUIDE TO RESTRAIN Y AND Z (GLOBAL) MOVEMENT. <u>RELEASE Y RESTRAINT</u> SEE DRAWING ATTACHED (CHANGE RESTRAINT ID TO MS25-28224)

EMD's scope of work for this subsystem will be on hold awaiting your approval.

FEASIBILITY OF CHANGES

Client **LECO**
Project **LASALLE**
Proj. No. **4267** Equip. No. _____

Prepared by **Jim Thompson** Date **8.12.82**
Reviewed by _____ Date _____
Approved by _____ Date _____

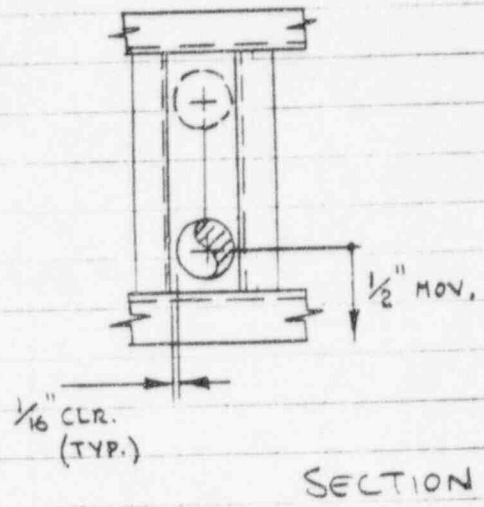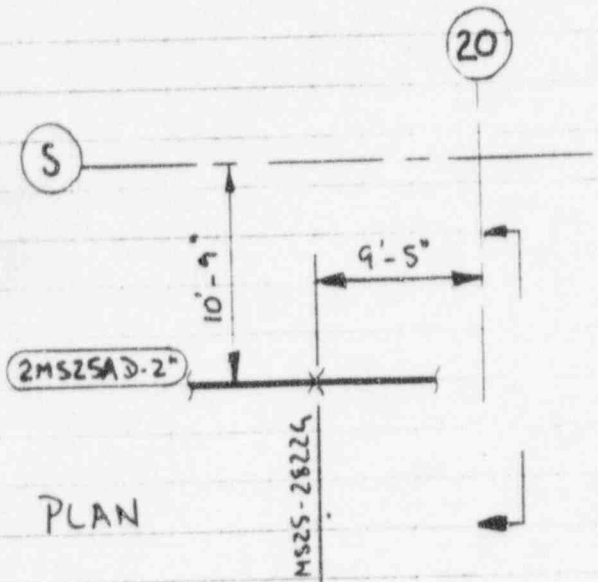

- NOTE:
1. THE SUPPORTS ON THE 3 ADJACENT LINES, MS25-28064, MS25-28144, AND MS25-28304 ARE UNAFFECTED AND REMAIN 1 AND 2 GLOBAL RESTRAINTS
 2. THE MODIFIED SUPPORT, MS25-28224, MUST ACCOMMODATE A MOVEMENT OF AT LEAST 0.38" IN THE NEGATIVE 1 DIRECTION TO ALLOW FOR THERMAL EXPANSION

SARGENT & LUNDY

INTER-OFFICE MEMORANDUM

From Jim Thompson Date 6 AUGUST, 1982
 Dept./Div. Mechanical/EMD Project No. 4267-00
 Spec No. _____
 File No. _____
 Page No. 1 of 2
 Client CECO Stn. LaSalle Unit 2
 Subject Request to Change of Add Restraints

To: J. C. Szydlik - 21
 CC: G. H. DeBoo - 21
 S. D. Killian - 21
 J. M. Nosko - 21
 B. R. Parduhn - 21
 W. Thiel - Field

The following restraint request information for Subsystem 2MS-56 is to be examined by MDD and SDD. Required support location and angularity are given on the attached sketches.

Node Point	RESTRAINT I.D.	Required Structure Support Must Attach To	Required Action
15	MS25-28055	SEE FIG. 1	ALL (11) TO BE DELETED ↓
20	MS25-28044	" "	
75	MS25-28015	" "	
125	MS25-28124	SEE FIG. 2	
130	MS25-28135	" "	
215	MS25-28095	" "	
265	MS25-28215	SEE FIG. 3	
* 335	MS25-28175	" "	
385	MS25-28284	SEE FIG. 4	
390	MS25-28295	" "	
425	MS25-28255	" "	

EMD's scope of work for this subsystem will be on hold awaiting your approval.

* NOTE: VARIABLE HANGER, MS25-28204, AT NODE 275 IS NOT AFFECTED BY THIS CHANGE AND MUST REMAIN AS BUILT.

Client	<u>LEO</u>
Project	<u>LASALLE</u>
Proj. No.	<u>4267</u>
Equip. No.	

Prepared by	<u>Jim Thompson</u>	Date	<u>8.9.82</u>
Reviewed by		Date	
Approved by		Date	

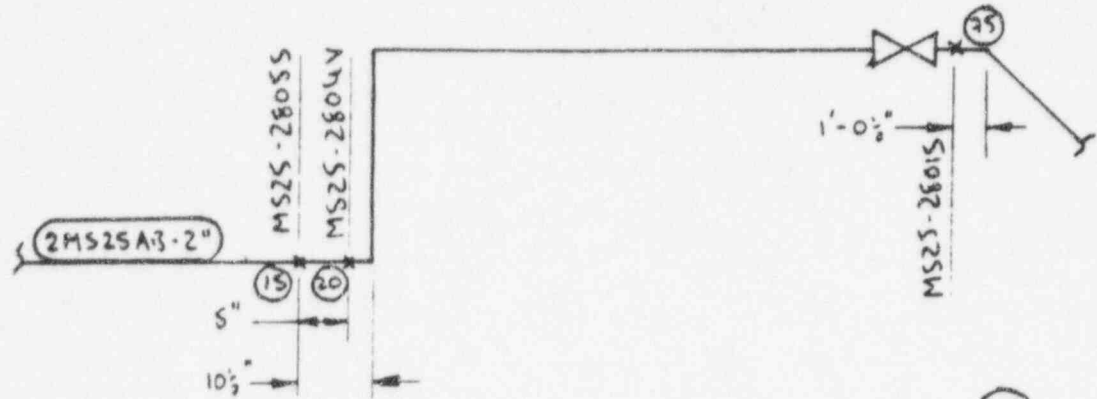


FIG. 1
1. MS25-28015
2. MS25-2804V
3. MS25-28055

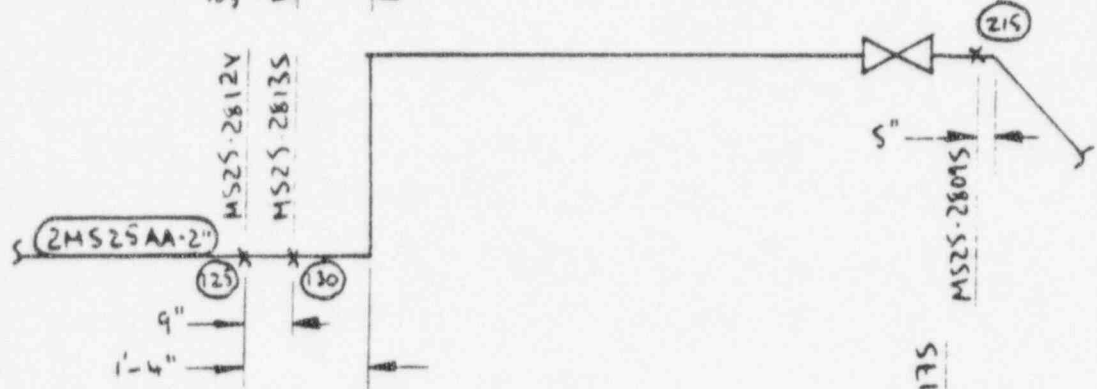


FIG. 2
1. MS25-2809S
2. MS25-2813S
3. MS25-2812V

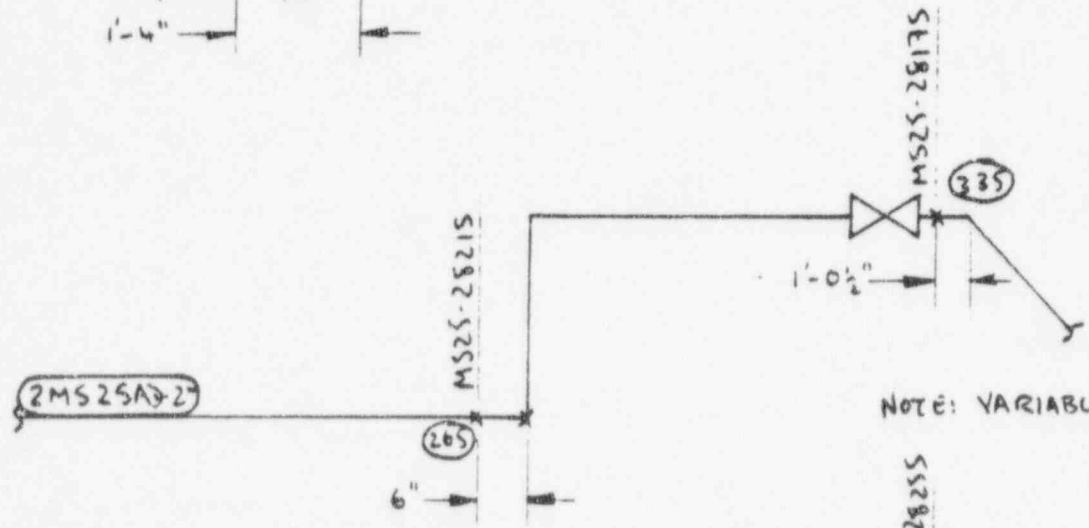


FIG. 3
1. MS25-2817S
2. MS25-282
NOTE: VARIABLE HANGER IS NOT AFFECTED

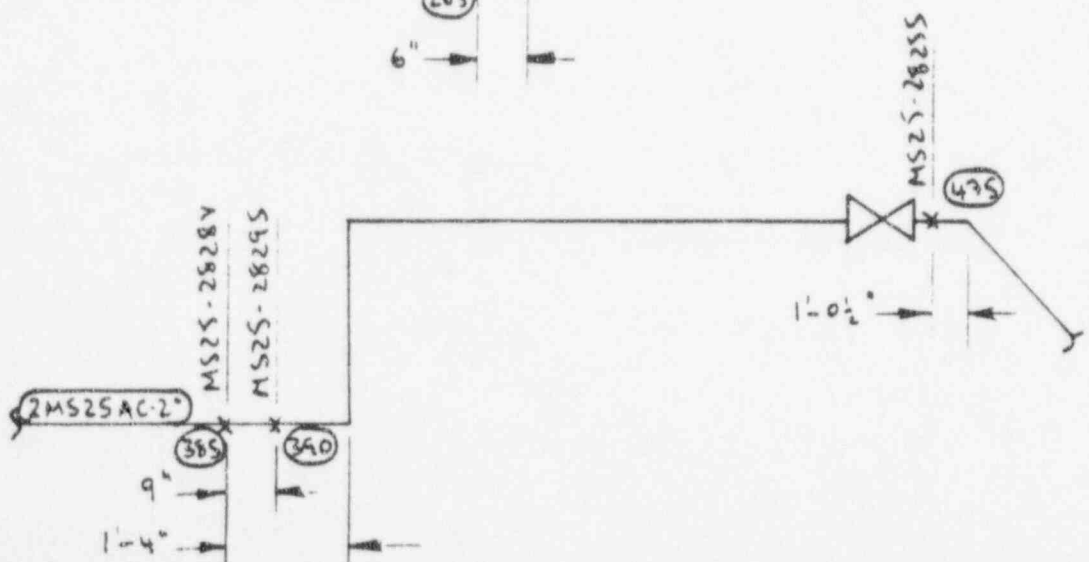


FIG. 4
1. MS25-2825S
2. MS25-2829S
3. MS25-2828V

SARGENT & LUNDY

INTER-OFFICE MEMORANDUM

From W. K. Lee - 30 X6156 Date August 24, 1982
Dept./Div. Mechanical/Component Qualification Project No. 4267-00
Spec. No. 2515
File No. COD-003523
Page No. 1 of 1
Client CECO Stn. LaSalle County Unit 2
Subject Nozzle Loads on 2CD01A from Subsystem 2MS-56

(Non-Safety-Related)

To: A. M. Chaudhary - 21

CC: B. R. Parduhn - 21
D. C. Haan - 21
G. DeBoo - 21
E. Panzica - 21
M. M. Hassaballa - 30
B. Gojineni - 30
J. Wu - 30
AEM/APD/LKL - 30
CQD File - 30

Reference: 1) Memo from A. M. Chaudhary, dated 9-13-82 and
Attached Nozzle Loads

Per your request, CQD reviewed the reference loads of nozzle lines 2MS25C and 2MS27B on the wall of condenser 2CD01A from the analysis of subsystem 2MS-56 and found them acceptable.

Please call if you have any questions.

LKL/eg

Cy Kamle
PKZ

SARGENT & LUNDY
ENGINEERS
25 EAST MONROE STREET
CHICAGO, ILLINOIS 60603
TELEPHONE 312-269-2000

ATBUE/PSI
30
2MS-56

February 2, 1981
Project Nos. 4266/67-10

Commonwealth Edison Company
LaSalle County Station - Units 1&2

Sargent and Lundy Specification J-2952

Mr. A. Morshedi
Project Manager
Nuclear Services Corporation
1700 Dell Avenue
Campbell, California 95008

References: Nuclear Services Corporation letter NSC-PM-SAR-6-016

Dear Mr. Morshedi:

The referenced letter requested allowable loading information for Subsystem 2MS-56.

Condenser (2CD01A)

3" line - $F_r = 940$ lbs. as per Westinghouse Drawing 731J390
1" line - loadings should be kept as low as possible.

<u>Valve No.</u>	<u>F_r</u>	<u>M_r</u>	<u>Acceleration</u> <u>($H_1=H_2=Y$)</u>
2B21-F076A-D	1802	891	4
2B21-F083	3308	2412	4
2B21-F071	1028	282	5
2B21-F070	3308	2412	5
2B21-F302A-D	1028	282	5
2B21-F303A-D	1028	282	5

Forces in lbs., Moments in ft-lbs.,
Accelerations in "g"s.

Yours very truly,

Philip J. Peterson
Philip J. Peterson


PJP:RGE
Copies:
D. C. Haan
R. H. Pollock
bcc:
M. M. Hassaballa
J. Sinnappan
EBB/AFM/PJP

J-2952
J-2515

COPY

Client	Prepared by	Date
Project	Reviewed by	Date
Proj. No.	Approved by	Date
Equip. No.		


Client	Prepared by	Date
Project	Reviewed by	Date
Proj. No.	Approved by	Date
Equip. No.		

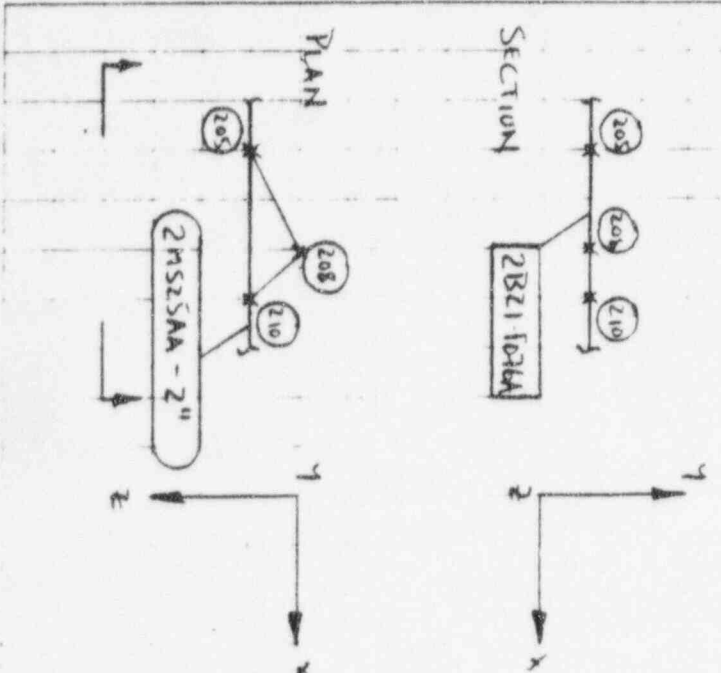

ALLOWABLE:
 $f_r = 1802 \text{ lb}$
 $M_1 = 891 \text{ k-ft-lb}$

NODE	UPSET			EMERGENCY		
	X	Y	Z	X	Y	Z
205	0.284	0.193	0.400	0.533	0.362	0.750
208	0.349	0.344	0.372	0.548	0.734	0.648
210	0.283	0.468	0.294	0.531	0.878	0.551

Fig. 2

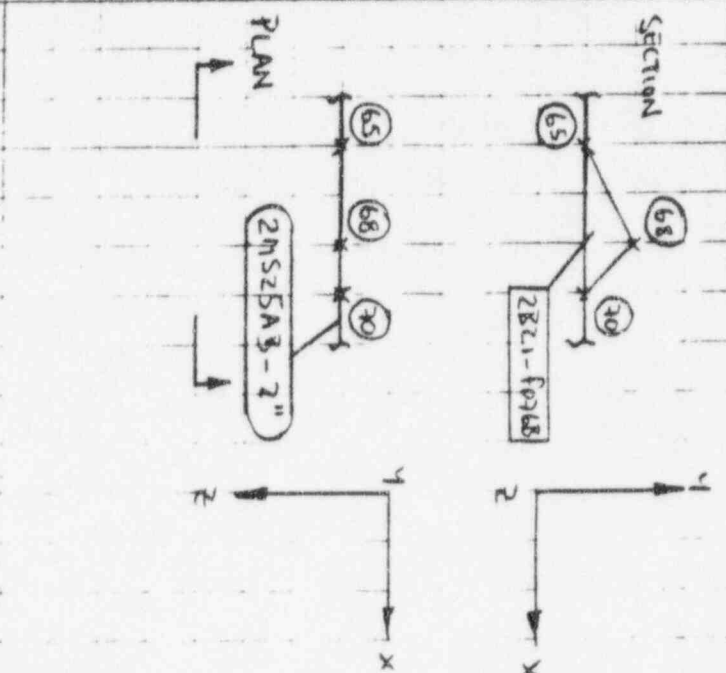

$f_r = 1802 \text{ lb}$
 $M_1 = 891 \text{ k-ft-lb}$ } ALLOWABLE

Fig. 1

NODE	UPSET			EMERGENCY		
	X	Y	Z	X	Y	Z
65	0.202	0.168	0.296	0.379	0.515	0.555
68	0.173	0.275	0.359	0.324	0.512	0.673
70	0.202	0.266	0.255	0.379	0.536	0.478

Client	Prepared by	Date
Project	Reviewed by	Date
Proj. No.	Approved by	Date
Equip. No.		

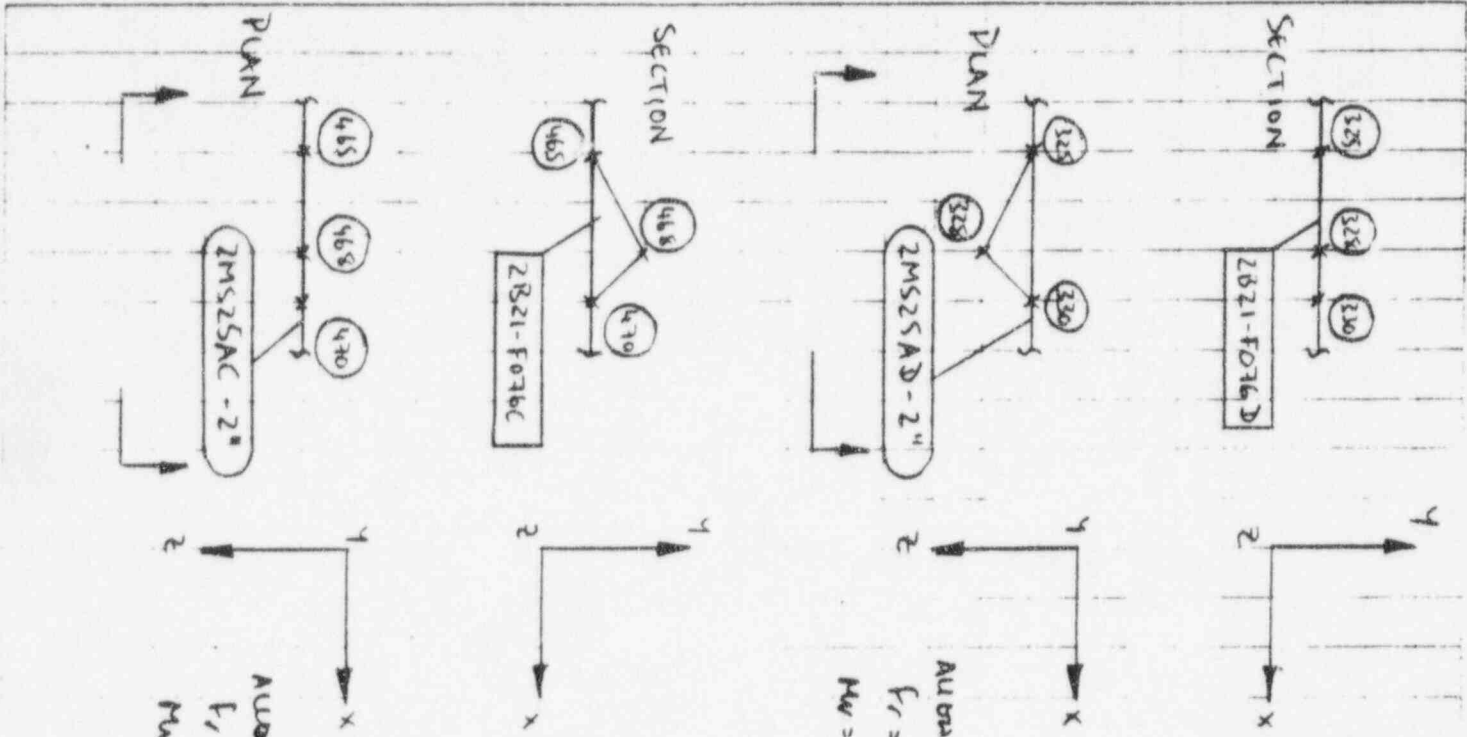


FIG 3

NODE	UPSET			EMERGENCY		
	X	Y	Z	X	Y	Z
325	0.279	0.156	0.331	0.523	0.349	0.621
328	0.307	0.359	0.604	0.576	0.329	0.570
330	0.274	0.223	0.302	0.523	0.606	0.566

AUXILIARY:
 $F_r = 15021b$
 $M_w = 8914.1b$



FIG 4

NODE	UPSET			EMERGENCY		
	X	Y	Z	X	Y	Z
465	0.222	0.172	0.446	0.416	0.323	0.930
468	0.187	0.279	0.619	0.351	0.573	1.161
470	0.222	0.292	0.450	0.416	0.548	0.844

AUXILIARY:
 $F_r = 15021b$
 $M_w = 8914.1b$

Client _____
Project _____
Proj. No. _____ Equip. No. _____

Prepared by _____ Date _____
Reviewed by _____ Date _____
Approved by _____ Date _____

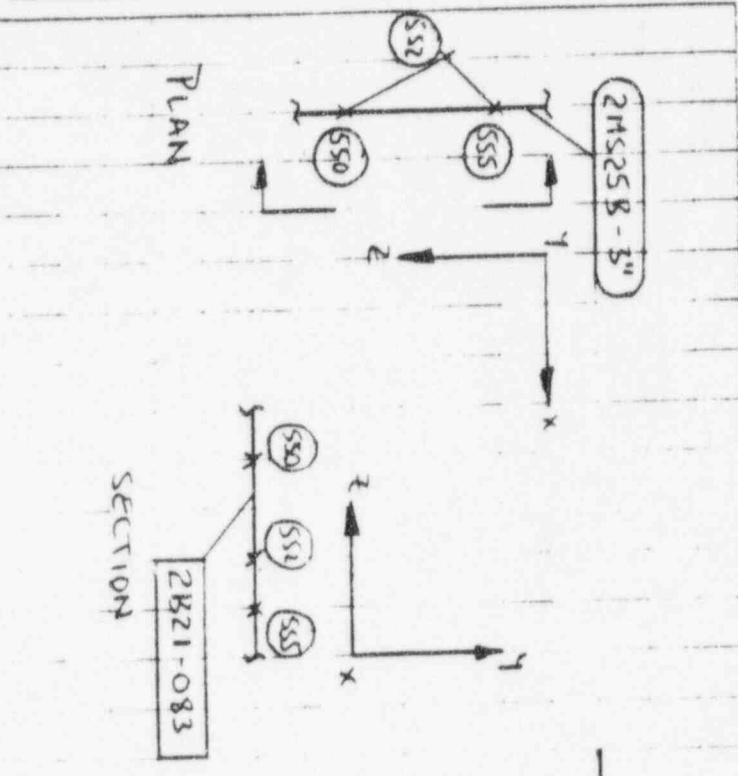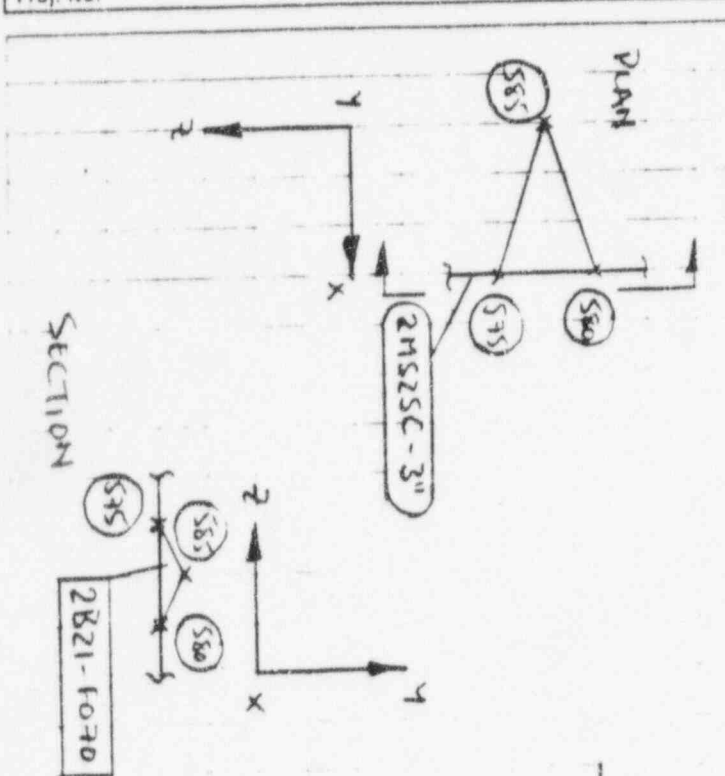

NODE	UPSET			EMERGENCY		
	X	Y	Z	X	Y	Z
S75	0.178	0.182	0.128	0.334	0.249	0.240
S80	0.182	0.153	0.128	0.341	0.249	0.240
S85	0.178	0.125	0.123	0.334	0.234	0.230

fig. 6
ALLOWABLE:
 $F_r = 3308 \text{ lb}$
 $M_r = 2412 \text{ ft. lb}$

NODE	UPSET			EMERGENCY		
	X	Y	Z	X	Y	Z
S50	0.221	0.126	0.126	0.414	0.236	0.236
S52	0.204	0.175	0.128	0.383	0.328	0.240
S55	0.202	0.126	0.126	0.379	0.236	0.236

fig. 5
 $F_r = 3308 \text{ lb}$
 $M_r = 2412 \text{ ft. lb}$
ALLOWABLE

Client

Prepared by

Date

Project

Reviewed by

Date

Proj. No.

Equip. No.

Approved by

Date

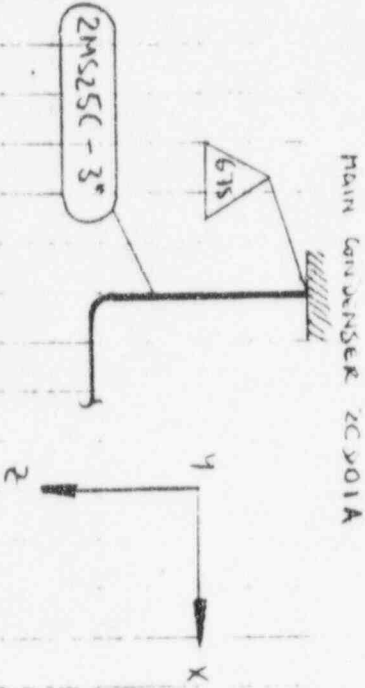


Fig. 8

Allowable:
 $F_r = 94015s$

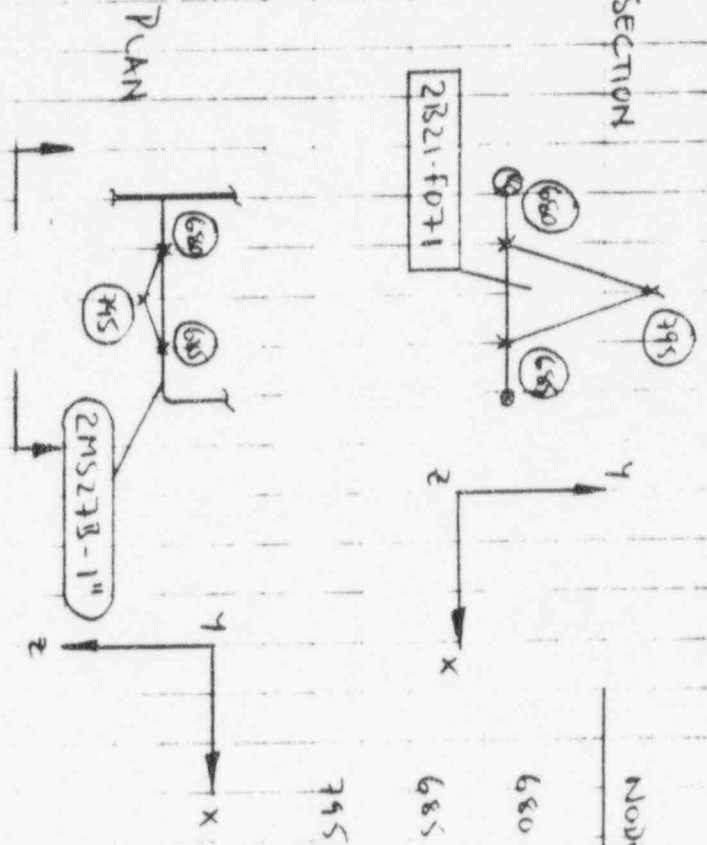


Fig. 7

Allowable:
 $F_r = 102816$
 $M_w = 2824.16$


NODE	UFSR			EMORLFCY		
	X	Y	Z	X	Y	Z
680	0.178	0.160	0.156	0.334	0.358	0.292
685	0.178	0.356	0.277	0.354	0.630	0.523
795	0.304	0.205	0.160	0.570	0.584	0.328

Calcs. For	
Safety-Related	Non-Safety-Related

Calc. No.	
Rev.	Date
Page	of

Client	
Project	
Proj. No.	Equip. No.

Prepared by	Date
Reviewed by	Date
Approved by	Date

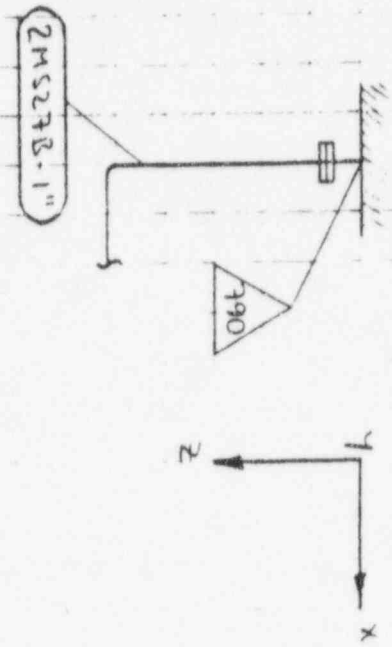

Allowable:
loadings should be kept as low
as possible


Fig. 9

WEIGHT (LBS)

ITEM	QTY	FIG NO OR PART NO	DESCRIPTION	WEIGHT (LBS)
1	1		COMPONENT SUPPORT ASSEMBLY CONSISTING OF	3.3
2	1		4 1/2 x 1/2 x 1/4 x 1-5" LG	2.0
3	1		1/2" x 4" x 4" LUBRITATE PLATE	3.2
4	1		ALLOY 237 W/AZ-7 LUBRICANT	5.1
5	1		1/4" x 1/2" x 1/2" x 8 1/4" LG (CUT TO SUIT)	.0.2
6	1		1/2" x 6" x 6" C S PLATE	6.4



20.2
 Revised as noted / f

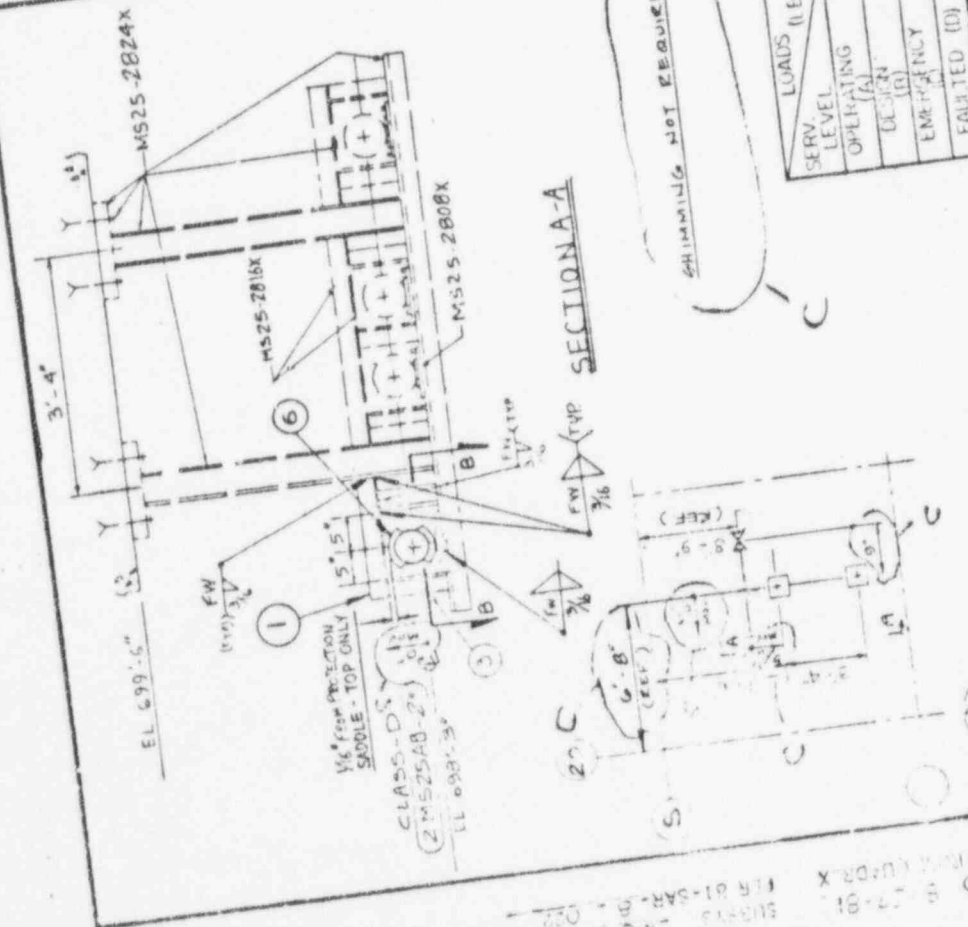

DESIGN	OPERATING	EMERGENCY	FAULTED
SEE LOAD TABLE	SEE LOAD TABLE	SEE LOAD TABLE	SEE LOAD TABLE

LOADS (LBS)	WELD NO	EXAMINATION PROCEDURE
OPERATING (A)		
DESIGN (B)		
EMERGENCY (C)		
FAULTED (D)		

REV	DATE	BY	DESCRIPTION
1	10-15-82	NS	PREPARED
2	11-15-82	NS	REVIEWED
3	12-15-82	NS	APPROVED

LA SALLE COUNTY STATION
 UNIT-2
 COMMONWEALTH EDISON COMPANY
 CHICAGO, ILLINOIS

MAIN STEAM PIPING SYSTEM

DRAWING NO. MS25-2808X
 SHEET 799A

SARGENT & LUNDY ENGINEERS

VICTORY PENACERRADA
 REGISTERED PROFESSIONAL ENGINEER
 ILLINOIS

PROJECT NO. 427-00
 DRAWING NO. M09
 REV. MS25-2800X

FOR RECORD & FILE
 REQUIRE PER REGANALYSIS DATED 8-11-81 (REV C)

FOR RECORD & FILE
 REQUIRE PER REGANALYSIS DATED 8-11-81 (REV C)



FOR RECORD & FILE
 REQUIRE PER REGANALYSIS DATED 8-11-81 (REV C)

FOR RECORD & FILE
 REQUIRE PER REGANALYSIS DATED 8-11-81 (REV C)

AS RECEIVED FROM QUADRA
 PER 81-SAR-1-56
 SUBSIS 281-56
 DATED 10-15-82
 PER 81-SAR-1-56

CLASS D

LOADS (LBS)	F_y	F_z
NORMAL	79	0
OPERATING	-151	-99
TEST	-126	25
EMERGENCY	-190	-34
FAULTED (B)	167	47
	-240	-102

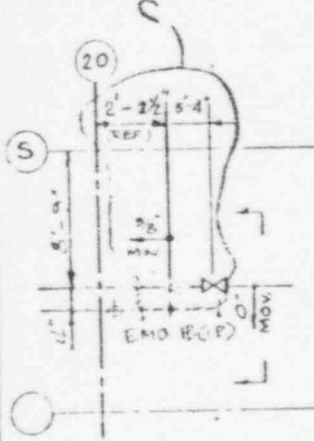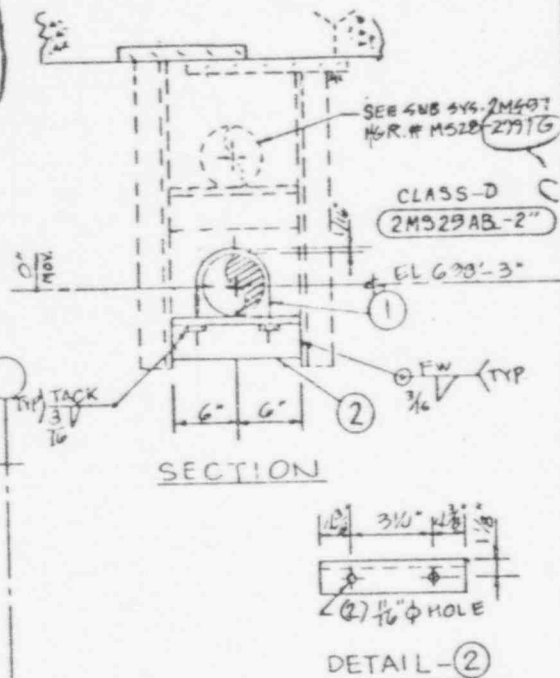

BILL OF MATERIAL

ITEM	QUAN	FIG. NO. OR PART NO.	DESCRIPTION
ONE			COMPONENT SUPPORT ASSY CONSISTING OF
1			5/8" x 2" U-BOLT, P=5 1/16" PL=1-4 3/8" W/NUTS (HEAVY DUTY)
2			L2" x 2" x 3/8", 1'-0" LG. (SEE DETAIL 2)
			BUNDLE & TAG FC-49

COMPONENT WEIGHT (LBS)	REMARKS
1.5	
4.7	



REV	DATE REL'D	PREPARED	REVIEWED	APPROVED
A	3-25-81	J. Geyer / Gibbetian	H.N. Banerjee / M. Chappas	P. Penacerrada
B	8-27-81	J. Geyer / Gibbetian	H.N. Banerjee / M. Chappas	P. Penacerrada
C	9-15-82	20/1/83	N.S. Carlier P.C.	H. M. Tooko

REFERENCE DRAWINGS
M-906-43
M-589

REV DWG NO. REV DWG NO. REV DWG NO.
B M-1410-2 E 1E-2-3335 B

DRAWING RELEASE RECORD EMD-057954 8-11-82

PURPOSE FOR RECORD & FILE. REVISED FOR REANALYSIS DATED 8-11-82 (REV C.)

CED-6026 FOR D SPEC (1-2990)

DESIGN	OPERATING	HYDRO TEST	EMERGENCY	FAULTED
	SEE LOAD TABLE			





LA SALLE COUNTY
UNIT-2
COMMONWEALTH EDISON CO.
CHICAGO, ILLINOIS

MAIN STEAM PIPING SYSTEM

NO SCALE PROJECT NO. 4267-00	DRAWING NO. REV MO-MS 25-2802G C
SARGENT & LUNDY ENGINEERS CHICAGO	SHEET 1 OF 1
801A	

AS RECEIVED FROM QUANTITY CONTROL

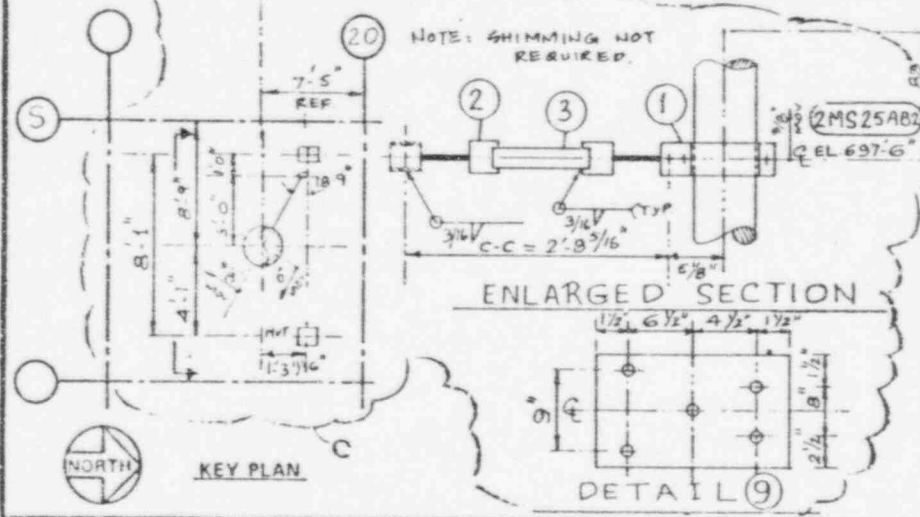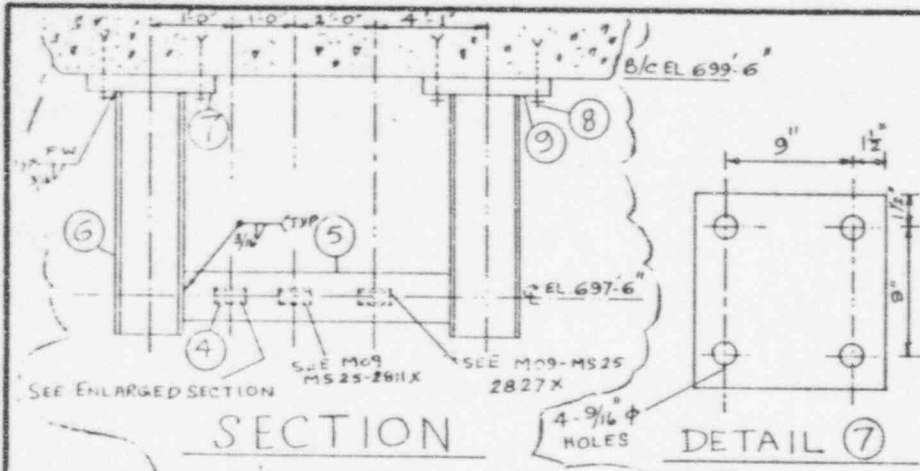

REFERENCE DRAWINGS	DWG. NO.	REV.	DWG. NO.	REV.	DWG. NO.	REV.	DWG. NO.	REV.
	M-966 SH 43	E	M-1418 SH 2	E	IE-2-335	B		
	M-584	C	S 940	M				

DRAWING RELEASE RECORD		CUTPUT: 8-11-82	
PEV	DATE REL'D	PREPARED	REVIEWED
C	9-15-82	A GORBY	Cybatung & C/82


PURPOSE: REVISED PER SP-T1307-01, REV. C
 REDRAWN
 FOR 'D' SPECS (J. 2530) & PER REVISION 1914. DATED: 8-11-82

BILL OF MATERIAL			P&S	JSS	PRM	SEC	AISC	COMPONENT WEIGHT (LB)
ITEM	QUAN.	FIG. NO. OR PART NO.						
1			COMPONENT SUPPORT ASSEMBLY					
			CONSISTING OF					
1	1	CH 1015	2" φ PIPE CLAMP					2.6
2	2	180131201	FORWARD ADAPTER PSA- 1/4 *					1.7
3	1	-	3/4" φ SCH KXS EXT PIPE X 2'-4" LG					5.7
4	1	180155801	REAR BRACKET PSA 1/4 *					0.4
5	1	-	M 4 X 13 (7'-11" LG) - C					102.9 - C
6	2	-	M 4 X 13 (2'-3" LG) - C					63
7	1	YC	1/2" X 12" X 12" C S PL (PER DETAIL 2)					10.2 C
8	8		1/2" φ X (7") HILTI-KWIK BOLTS					3.2
9	1		5/8" X 12" X 1-1/2" LG. C S PLATE (SEE DETAIL 3)					29.75
* SUPPLIED BY BULK ORDER								
1			BUNDLE & TAG EC-49					
								254.2
								TOTAL WEIGHT

LOADS (LBS.)				
DESIGN	OPERATING	HYDRO TEST	EMERGENCY	FAULTED
21-33-C	3-15-C			87-491-C

EMD REVIEW		LA SALLE COUNTY STATION UNIT-2 COMMONWEALTH EDISON COMPANY CHICAGO, ILLINOIS	
		MAIN STEAM PIPING SYSTEM	
		NO SCALE PROJECT NO 4267 00	SUPPORT NO. REV M09- MS 25-2803 X C
PIPE CLASS D	PE SEAL	802 A	SHEET 1 OF 1

DEPT. MGR. REV. 1-78-81
 MGR. 12-1-82 (BY) APPROVED

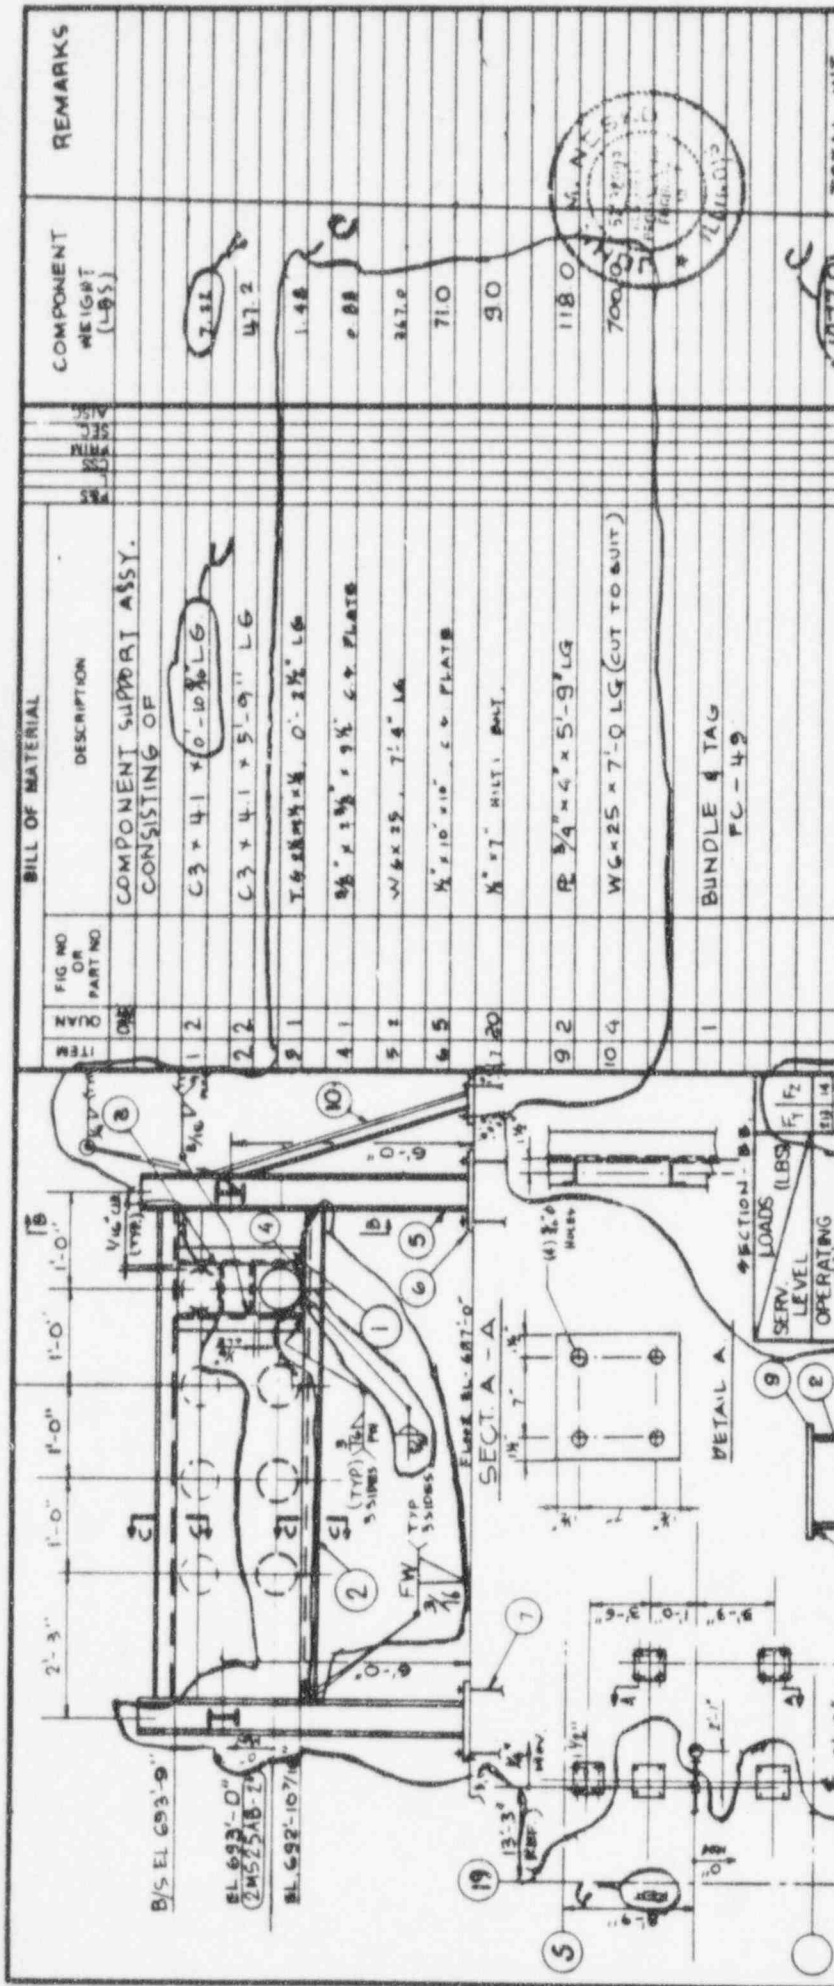

REV	DATE	BY	CHKD	DWG NO	REV	DWG NO	REV	DWG NO	REV	DWG NO	REV	DWG NO	REV	DWG NO
A	3-25-81	E	M-1418	M-1418	E	152-5285	B							
B	3-27-81	C	S-219	M										
C	10-8-82													

FIG. NO. OF PART NO.	DESCRIPTION	QUANTITY	REMARKS
1	COMPONENT SUPPORT ASSY. CONSISTING OF	1	
2	C3 x 41 x 0-10 1/16 LG	1	
3	C3 x 41 x 5-9 1/2 LG	1	
4	T. 4. 2. 8. 8. 4. 4. 0. 2 1/2 LG	1	
5	3/8" x 3 1/2" x 9 1/2" C.P. PLATE	1	
6	W 6 x 25, 7'-4" LG	1	
7	1/2" x 10" x 10" C.P. PLATE	1	
8	8" x 7" MULT. BOLT	1	
9	R 3/4" x 4" x 5'-9" LG	1	
10	WG x 25 x 7'-0 LG (CUT TO SUIT)	1	
11	BUNDLE & TAG PC-49	1	

WELD NO.	WELD PROCEDURE	EXAMINATION PROCEDURE	LOADS (LBS)
			OPERATING
			HYDRO TEST
			EMERGENCY
			FAULTED

SEE CSD 6086 FOR P&ID. SPEC (J-2530)

PURPOSE: RE-PIPE PIPING SYSTEM (REV. C)

REVISED AS NOTED/REV. B

LA SALLE COUNTY STATION UNIT - 2
COMMONWEALTH EDISON COMPANY
CHICAGO, ILLINOIS

NO. 18 1 2 10 71 FROM APPROVED


REV. B DATED 8-27-81
AS RECEIVED FROM QUADREX
SUBSYS. RMS-56
PER 81-SAR-B-022



NO. SCALE	PROJECT NO.	DRAWING NO.	REV
	4267-00	M09-	
		MSS-28066	C
		SHEET 1 OF 1	

SARGENT & LURDY
CHICAGO
805A

MAIN STEAM PIPING SYSTEM

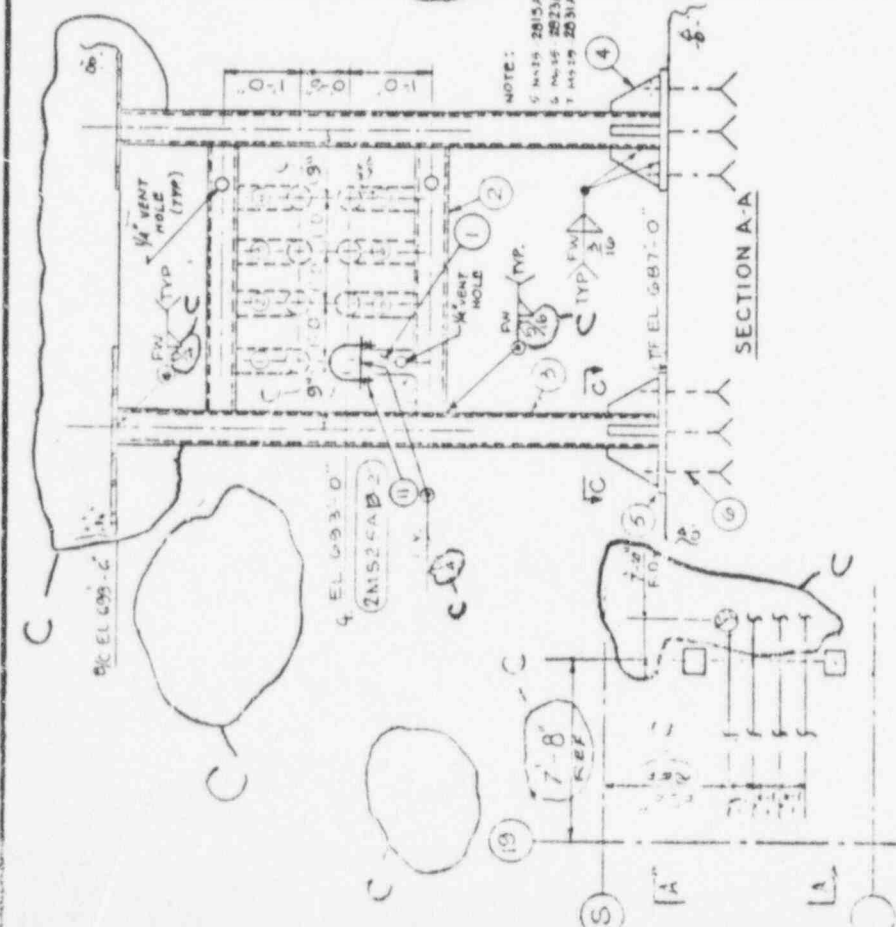

REV	DATE	BY	CHKD	DWG NO	REV	DWG NO	REV	DWG NO	REV	DWG NO	REV	DWG NO	REV
1	3-25-82	W. J.	S-1010	M	S-975	M	1E-2-3395	F	1E-2-3395	F	1E-2-3395	F
2	8-27-82
3	9-15-82

DRAWING RELEASE RECORD OUTPUT EMP-057954, 8-11-82
 APPROVED: *[Signature]*
 REVIEWED: *[Signature]*
 PREPARED: *[Signature]*
 4-3-82
 8-27-82
 9-15-82

FUTURE USE REVISED PER SP-T-1328, 7-15-89
 PER REANALYSIS, DATED, 8-11-82.
 FOR P SPEC (CU-2530) (REV C)

ITEM	QUAN	FIG NO OR PART NO	DESCRIPTION	COMPONENT SUPPORT ASSEMBLY CONSISTING OF	COMPONENT WEIGHT (LB)	REMARKS
1	1					
1	1			4" SCH. 40 STANCHION PIPE	18.36	
2	2			0"-8" LG	178.96	
3	2			TS 5 X 5 X 3/8 4'-0" LG	877.33	
4	8			6 X 6 X 1/2 12'-5 7/8 LG	13.4	
5	2			3/8" PLATE PER DETAIL A	156.0	
6	16			3/4" X 10" HULTI KWIK BOLT (PER DETAIL-5)	21.6	
7				DELETED		
8				DELETED		
9				DELETED		
10				DELETED		
11				ANCHOR TYPE-B, SEE DETAIL	18.7	
				M-1100 SH. 33		
				BUNDLE & TAG		
				FC-49		
					1284.35	

EXAMINATION PROCEDURE: *[Blank]*
 WELD NO: *[Blank]*
 WELD PROCEDURE: *[Blank]*
 LOADS (LCS):
 DESIGN: *[Blank]* OPERATING: *[Blank]* HYDRO TEST: *[Blank]* EMERGENCY: *[Blank]* FAULTED: *[Blank]*
 SEE: *[Blank]* LOAD: *[Blank]* TABLE (SH.2): *[Blank]*

LA SALLE COUNTY STATION
 UNIT-2
 COMMONWEALTH EDISON COMPANY
 CHICAGO, ILLINOIS


VICTORY PENACERRADA
 REGISTERED PROFESSIONAL ENGINEER
 ILLINOIS

DRAWING NO. MS25-2807A
 SHEET 1 OF 2

PROJECT NO. 4267-00
 NO. SALE: *[Blank]*



REV B DATED 8-27-81 AS RECEIVED FROM SUESSYS 2MS-56 PER 81-SAR-B-022

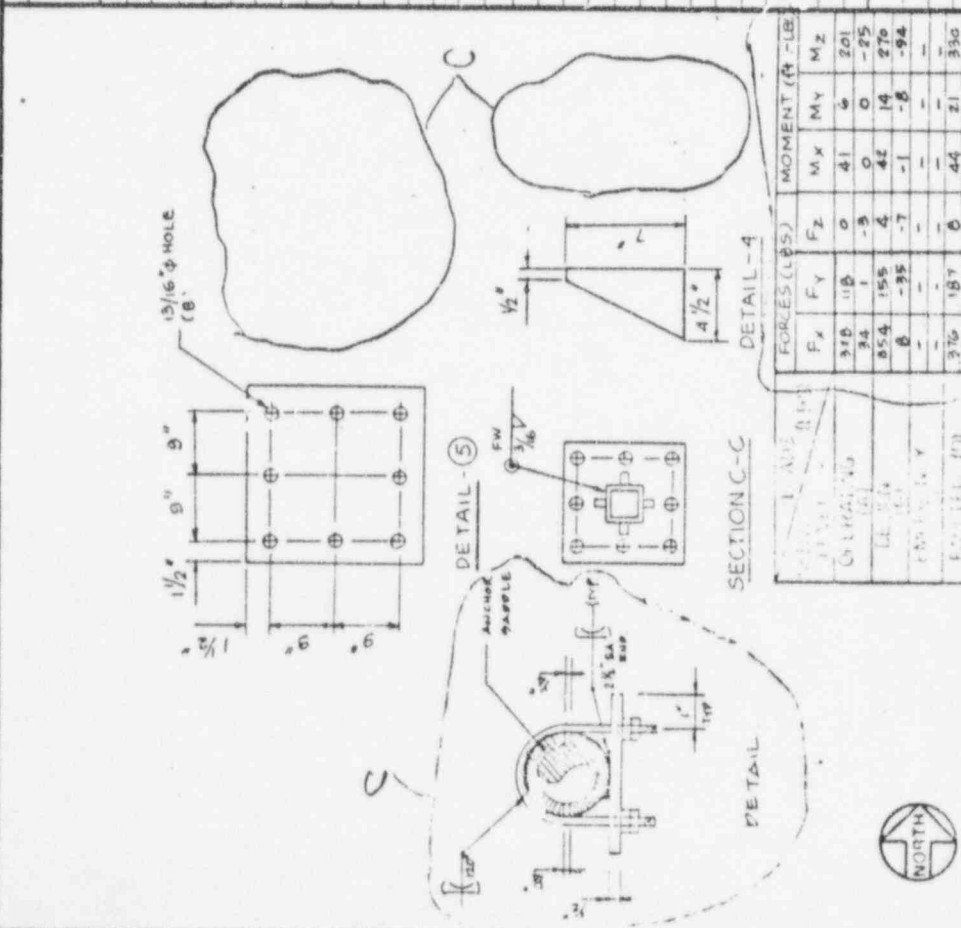

REV	DATE	RELD	PREPARED	REVIEWED	APPROVED	FILM
A	3-25-81		William J. Penacerrada		Penacerrada	
B	8-27-81		William J. Penacerrada		Penacerrada	
	9-15-82		William J. Penacerrada		Penacerrada	

DRAWING RELEASE RECORD: 8-11-81

PURPOSE: REVISED PER 81-T-1329, 11959 & PER 81-SAR-B-022, 8-11-81

FOR 81-SAR-B-022 (REV. C)

ITEM	QUAN.	FIG. NO. OR PART NO.	DESCRIPTION	COMPONENT WEIGHT (LB)
1			COMPONENT SUPPORT ASSEMBLY CONSISTING OF BILL OF MATERIAL SEE SH. 1	

LA SALLE COUNTY STATION
UNIT-2
COMMONWEALTH EDISON COMPANY
CHICAGO ILLINOIS

MAIN STEAM PIPING SYSTEM

NO SCALE PROJECT NO. 4267 00
DRAWING NO. M09
MS25-2807A
SHEET 1 OF 1

VICTOR G. PENACERRADA
REGISTERED PROFESSIONAL ENGINEER
ILLINOIS

EMD REVIEW
Vijesh Gupta

DESIGN OPERATING HYDRO TEST EMERGENCY FAULTED
SEE LOAD TABLE

WELD NO. WELD PROCEDURE EXAMINATION PROCEDURE

TOTAL WEIGHT
REVISED AS NOTED / REV C



ITEM	FIG NO OR PART NO	DESCRIPTION	COMPONENT WEIGHT (LB)
1	1	COMPONENT SUPPORT ASSEMBLY CONSISTING OF	
1	1	1/2" x 4" x 4" LUBRITE PLATE (20-375)	2.0
2	1	L 1 1/2" x 1/2" x 1/4" x 8 1/4" L.G.	1.6
3	1	1/2" x 6 x 6" C S PLATE	5.1
4	4	1/4" x 1/4" x 3" C S LUG	.2
5	2	2" PROTECTION SADDLE	6.4




WELD NO. 12.3
 EXAMINATION PROCEDURE
 REVISED AS NOTED / REV. B

WELD NO.	WELD PROCEDURE	EXAMINATION PROCEDURE
1	BUNDLE TAG FC-49	

LA SALLE COUNTY STATION
 UNIT - 2
 COMMONWEALTH EDISON COMPANY
 CHICAGO, ILLINOIS

DRAWING NO. P
 MOD.
 MS 25-2808X C
 SHEET 1 OF 1

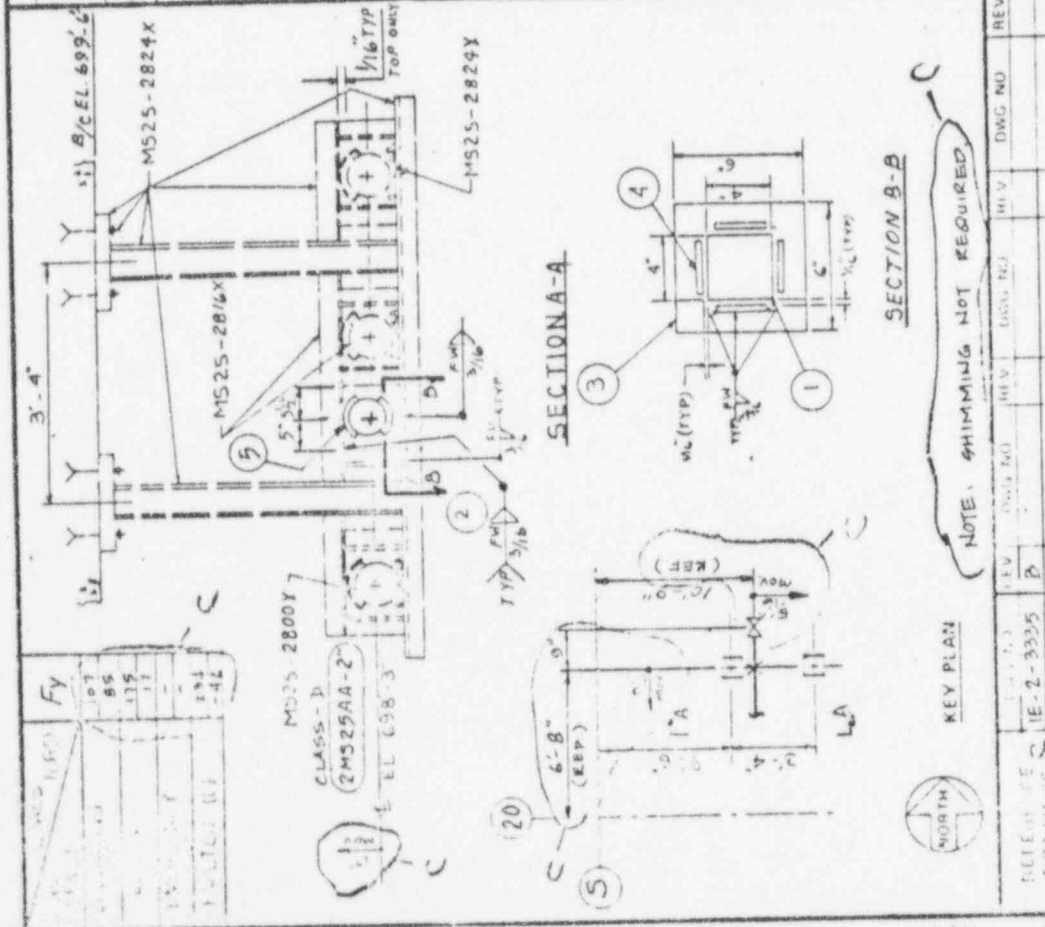

DESIGN	OPERATING	HYDRO TEST	EMERGENCY	FAULTED
		SEE LOAD TABLE		

EMD REVIEW
Rajesh Gupta



CLASS - D (2MS25AA-2)
 E.L. 698-3
 MS25 2800Y
 Fy
 107
 85
 175
 11
 191
 42

NOTE: DIMMING NOT REQUIRED

KEY PLAN

REFERENCE DRAWINGS: IE-2-3325 D, M-916-43 E

DATE REL'D: 2MS-56 NR (200) (Y)

PREPARED BY: J. G. ...


REVIEWED BY: M. CHAS. ...

APPROVED BY: ...


DRAWING RELEASE RECORD OUTPUT: EMD-001954, B-11-02

PURPOSE FOR RECORD & FILE
 REQUIRED FOR REANALYSIS DATED: B-11-02 (REV. 9)


LED 6026 FOR D SPECS (J-2530)

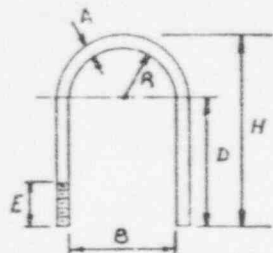

DETAIL-1

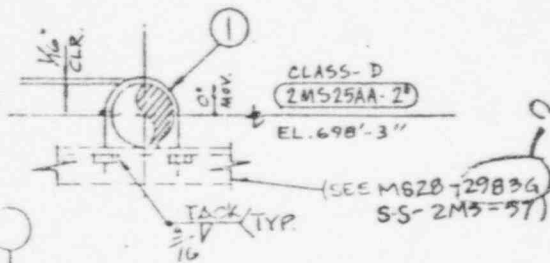


SECTION

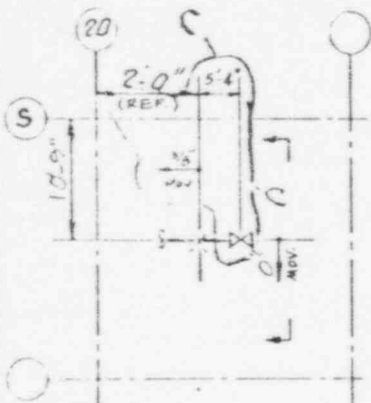

KEY PLAN

SERV. LEVEL	LOADS (LBS)	
	F _y	F _z
OPERATING (A)	86	-5
DESIGN (B)	-137	-116
EMERGENCY (C)	147	26
FAULTED (D)	-198	-147
	202	53
	-251	-176

ITEM QUAN.		FIG NO. OR PART NO.	DESCRIPTION	COMB. PARTS	SEC.	ALYS.	COMPONENT WEIGHT (LBS.)
COMPONENT SUPPORT ASST. CONSISTING OF:							
1	1	-	5/8" x 2" U-BOLT A = 5/8", B = 1 3/16", D = 4 1/2" E = 3 1/2", H = 6 5/16", R = 1 3/16" DL = 12 3/4" WITH 2 HEX NUTS PER DETAIL (1)				1.4
1			BUNDLE K TAG FC-49				
WELD NO. WELD PROCEDURE EXAMINATION PROCEDURE							
DESIGN OPERATING HYDRO TEST EMERGENCY FAULTED							
SEE LOAD TABLE							

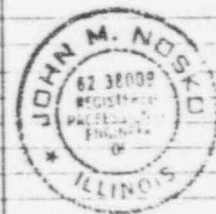

1.4 TOTAL WEIGHT

REV. B. DATED 8-25-81. SUBS. PER E1-CAR-8-022. AS RECEIVED FROM A, U.S.D.

REFERENCE DRAWINGS	REV.	DWG NO.	REV.	DWG NO.	REV.	DWG NO.	REV.
M-9	E	M-1415-2	E	IE-23335	B		
M-584	C	S-940	M				

PREPARED	REVIEWED	APPROVED	FILED
J. Geiger / P. Beltrami	N.M. Adams / M. Chang	V. Penacerrada	
J. Geiger / P. Beltrami	N.S. Carlow / P.C.	V. Penacerrada	
		H.M. Gabe	

EMD REVIEW

VICTORY G. PENACERRADA
062 001132
REGISTERED PROFESSIONAL ENGINEER
ILLINOIS

SUPPORT CLASS D

LA SALLE COUNTY
UNIT-2
COMMONWEALTH EDISON CO.
CHICAGO, ILLINOIS


MAIN STEAM PIPING SYSTEM.

DRAWING NO. MS25-2810G
SHEET 1 OF 1


SAINT LUNDY ENGINEERS CHICAGO
809A

PURPOSE FOR RECORD & FILE
REVISED PER REAMALTS#16. DATED 8-11-82. (REV.)
CED-6026 FOR D SPEC (J-2930)

REV B, C, D, E, F, G, H, I, J, K, L, M, N, O, P, Q, R, S, T, U, V, W, X, Y, Z, AA, AB, AC, AD, AE, AF, AG, AH, AI, AJ, AK, AL, AM, AN, AO, AP, AQ, AR, AS, AT, AU, AV, AW, AX, AY, AZ, BA, BB, BC, BD, BE, BF, BG, BH, BI, BJ, BK, BL, BM, BN, BO, BP, BQ, BR, BS, BT, BU, BV, BW, BX, BY, BZ, CA, CB, CC, CD, CE, CF, CG, CH, CI, CJ, CK, CL, CM, CN, CO, CP, CQ, CR, CS, CT, CU, CV, CW, CX, CY, CZ, DA, DB, DC, DD, DE, DF, DG, DH, DI, DJ, DK, DL, DM, DN, DO, DP, DQ, DR, DS, DT, DU, DV, DW, DX, DY, DZ, EA, EB, EC, ED, EE, EF, EG, EH, EI, EJ, EK, EL, EM, EN, EO, EP, EQ, ER, ES, ET, EU, EV, EW, EX, EY, EZ, FA, FB, FC, FD, FE, FF, FG, FH, FI, FJ, FK, FL, FM, FN, FO, FP, FQ, FR, FS, FT, FU, FV, FW, FX, FY, FZ, GA, GB, GC, GD, GE, GF, GG, GH, GI, GJ, GK, GL, GM, GN, GO, GP, GQ, GR, GS, GT, GU, GV, GW, GX, GY, GZ, HA, HB, HC, HD, HE, HF, HG, HH, HI, HJ, HK, HL, HM, HN, HO, HP, HQ, HR, HS, HT, HU, HV, HW, HX, HY, HZ, IA, IB, IC, ID, IE, IF, IG, IH, II, IJ, IK, IL, IM, IN, IO, IP, IQ, IR, IS, IT, IU, IV, IW, IX, IY, IZ, JA, JB, JC, JD, JE, JF, JG, JH, JI, JJ, JK, JL, JM, JN, JO, JP, JQ, JR, JS, JT, JU, JV, JW, JX, JY, JZ, KA, KB, KC, KD, KE, KF, KG, KH, KI, KJ, KK, KL, KM, KN, KO, KP, KQ, KR, KS, KT, KU, KV, KW, KX, KY, KZ, LA, LB, LC, LD, LE, LF, LG, LH, LI, LJ, LK, LL, LM, LN, LO, LP, LQ, LR, LS, LT, LU, LV, LW, LX, LY, LZ, MA, MB, MC, MD, ME, MF, MG, MH, MI, MJ, MK, ML, MM, MN, MO, MP, MQ, MR, MS, MT, MU, MV, MW, MX, MY, MZ, NA, NB, NC, ND, NE, NF, NG, NH, NI, NJ, NK, NL, NM, NN, NO, NP, NQ, NR, NS, NT, NU, NV, NW, NX, NY, NZ, OA, OB, OC, OD, OE, OF, OG, OH, OI, OJ, OK, OL, OM, ON, OO, OP, OQ, OR, OS, OT, OU, OV, OW, OX, OY, OZ, PA, PB, PC, PD, PE, PF, PG, PH, PI, PJ, PK, PL, PM, PN, PO, PP, PQ, PR, PS, PT, PU, PV, PW, PX, PY, PZ, QA, QB, QC, QD, QE, QF, QG, QH, QI, QJ, QK, QL, QM, QN, QO, QP, QQ, QR, QS, QT, QU, QV, QW, QX, QY, QZ, RA, RB, RC, RD, RE, RF, RG, RH, RI, RJ, RK, RL, RM, RN, RO, RP, RQ, RR, RS, RT, RU, RV, RW, RX, RY, RZ, SA, SB, SC, SD, SE, SF, SG, SH, SI, SJ, SK, SL, SM, SN, SO, SP, SQ, SR, SS, ST, SU, SV, SW, SX, SY, SZ, TA, TB, TC, TD, TE, TF, TG, TH, TI, TJ, TK, TL, TM, TN, TO, TP, TQ, TR, TS, TT, TU, TV, TW, TX, TY, TZ, UA, UB, UC, UD, UE, UF, UG, UH, UI, UJ, UK, UL, UM, UN, UO, UP, UQ, UR, US, UT, UY, UZ, VA, VB, VC, VD, VE, VF, VG, VH, VI, VJ, VK, VL, VM, VN, VO, VP, VQ, VR, VS, VT, VU, VV, VW, VX, VY, VZ, WA, WB, WC, WD, WE, WF, WG, WH, WI, WJ, WK, WL, WM, WN, WO, WP, WQ, WR, WS, WT, WU, WV, WW, WX, WY, WZ, XA, XB, XC, XD, XE, XF, XG, XH, XI, XJ, XK, XL, XM, XN, XO, XP, XQ, XR, XS, XT, XU, XV, XW, XX, XY, XZ, YA, YB, YC, YD, YE, YF, YG, YH, YI, YJ, YK, YL, YM, YN, YO, YP, YQ, YR, YS, YT, YU, YV, YW, YX, YY, YZ, ZA, ZB, ZC, ZD, ZE, ZF, ZG, ZH, ZI, ZJ, ZK, ZL, ZM, ZN, ZO, ZP, ZQ, ZR, ZS, ZT, ZU, ZV, ZW, ZX, ZY, ZZ

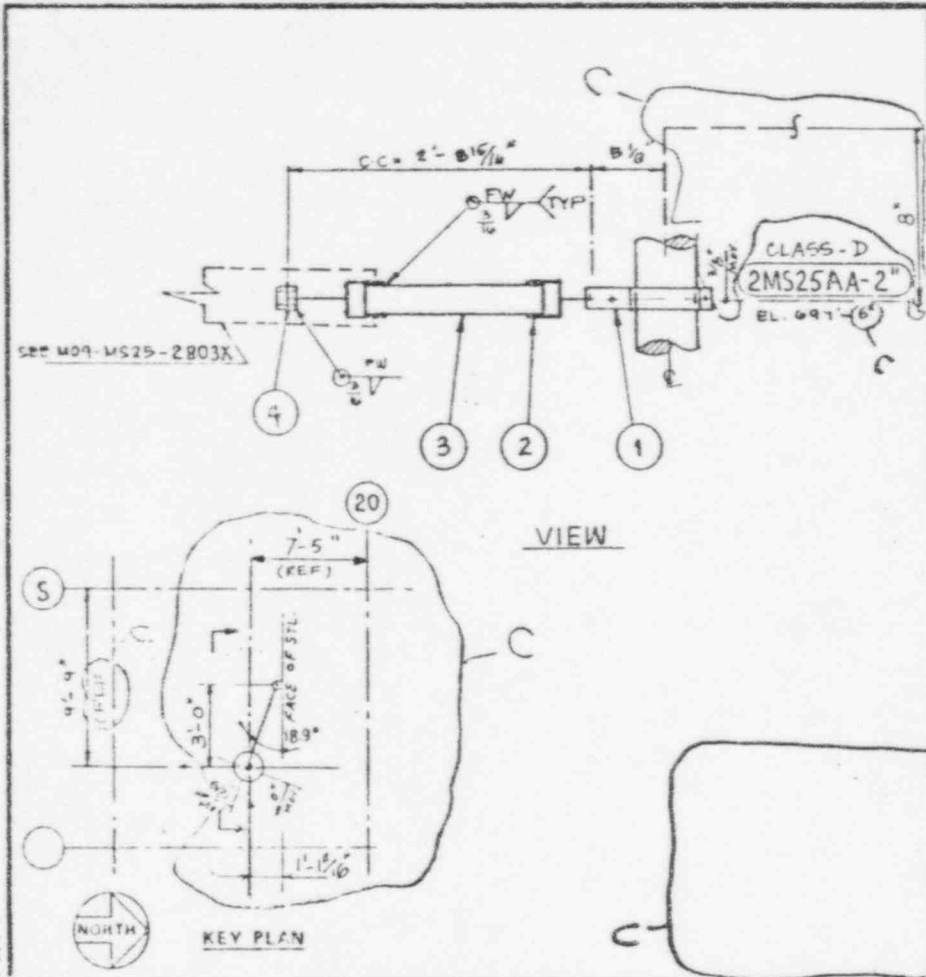

BILL OF MATERIAL				REV	PRIM	SEC	ALIAS	COMPONENT WEIGHT (LBS)	REMARKS									
ITEM	QUAN	FIG NO. OR PART NO.	DESCRIPTION															
COMPONENT SUPPORT ASSY. CONSISTING OF:																		
1	1	CH1016	2" PIPE CLAMP				2.6											
2	2	1001512-01	ADAPTER ASSY PER PSA-1/4				17											
3	1		3/4" SCH XXS EXT. PIPE, 2'-4" LG				57											
4	1	1001508-01	REAR BRACKET PER PSA-1/4				0.4											
* SUPPLIED BY BULK ORDER																		
1			BUNDLE & TAG FC-49															
WELD NO.				WELD PROCEDURE				EXAMINATION PROCEDURE										
ESTIMATED LOADS (LBS)				DESIGN			OPERATING			HYDRO. TEST			EMERGENCY			FAULTED		
				55/-13			36/6						72/-30					

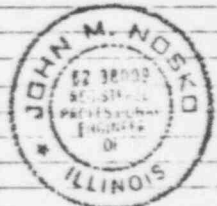

REV	DATE	REL'D	PREPARED	REVIEWED	APPROVED	FILM	EMD REVIEW
A	3-25-81		G. Louch / J. P. ...	M. CHANG / J. R. ...	Penacerrada		
B	8-27-81		V. H. ...	M. ...	Penacerrada		
C	9-15-82		G. J. S. ...	H. ...	J. M. ...		R. ...

PURPOSE: REVISED PER SP T1307 (REV. C)
 SEE CVD-6026 FOR "D" SPEC. (J-2530) PER REANALYSIS DATED: 8-11-82

VICTORY G. PENACERRADA
 62 001432
 REGISTERED PROFESSIONAL ENGINEER OF ILLINOIS

LA SALLE COUNTY STATION
 UNIT-2
 COMMONWEALTH EDISON COMPANY
 CHICAGO, ILLINOIS


MAIN STEAM PIPING SYS.

NO SCALE
 PROJECT NO. 4267-00

DRAWING NO. MS 25-2811X
 SHEET 1 OF 1

REVISED AS NOTED/REV. B	TOTAL WEIGHT 10.4
-------------------------	-------------------

ITEM	QUAN	FIG. NO. OR PART NO.	DESCRIPTION	COMPONENT WEIGHT (LB)
1	1		COMPONENT SUPPORT ASSEMBLY CONSISTING OF:	
1	2		C 3 X 4-1 (K 0-10 1/8" LG.)	7.11
2	1		1 1/2" x 1/4" x 1/4" x 1/4" O. 2 1/2" LG.	1.40
3	1		3/8" x 2 1/2" x 9 1/2" C.S. PLATE.	0.88

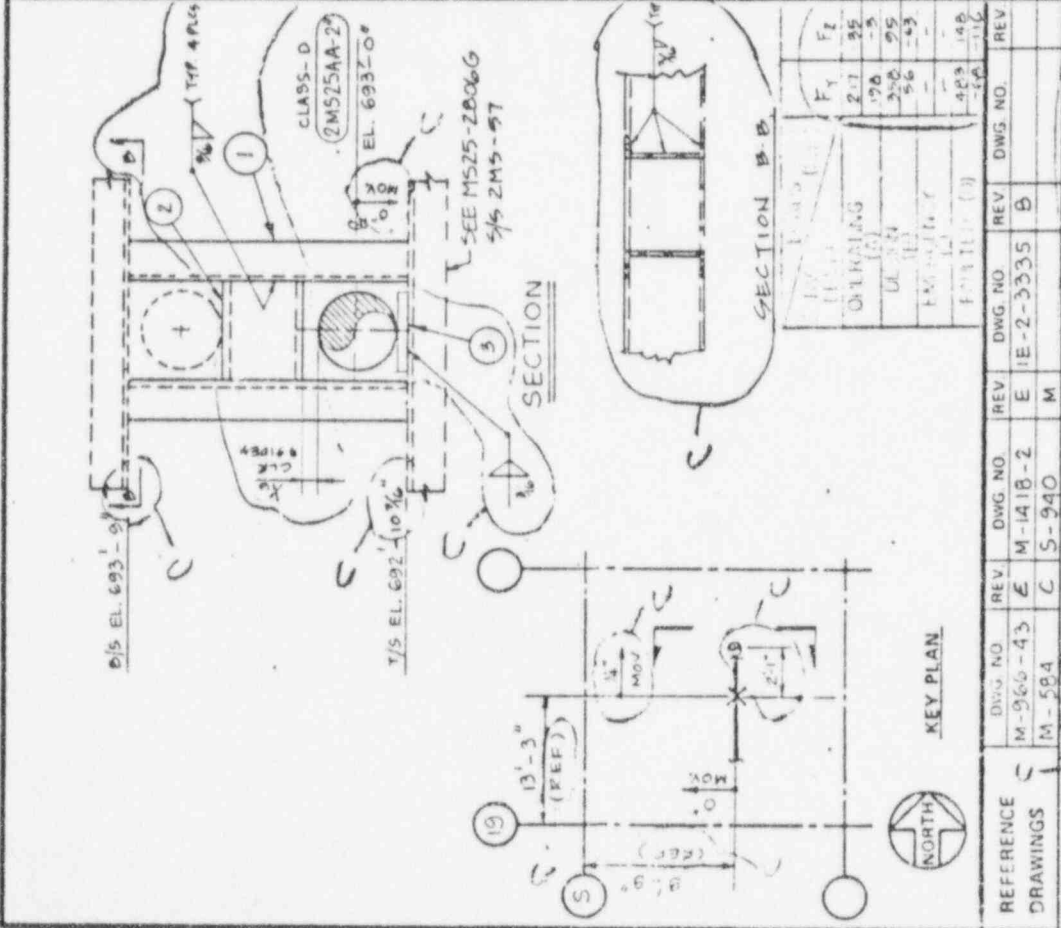

DESIGN	OPERATING	HYDRO. TEST	EMERGENCY	FAULTED

WELD NO. _____ WELD PROCEDURE _____ EXAMINATION PROCEDURE _____

TOTAL WEIGHT: 9.58

REVISED AS NOTED/REV. B

REV	DATE	REL'D	PREPARED	REVIEWED	APPROVED	FILM
A	3-25-81		Althony / Rebeckall			
B	8-7-81		A. N. Kelly / V. S. J. Williams			
C	9-15-82		V. S. J. Williams			

DRAWING RELEASE RECORD EMP 087954 OUTPUT: 5-11-81

EMD REVIEW: Refresh Copy

LA SALLE COUNTY STATION
 UNIT - 2
 COMMONWEALTH EDISON COMPANY
 CHICAGO, ILLINOIS

SARGENT & LUNDY
 ENGINEERS
 CHICAGO, ILLINOIS

VICTORY & PENACERRADA
 REGISTERED PROFESSIONAL ENGINEER
 OF ILLINOIS

DRAWING NO. M09
 PROJECT NO. 4267 00
 NO SCALE

PIPE CLASS D


PER SEAL

MS25-2814G
 SHEET 1 OF 1

ITEM	QUAN	FIG NO OR PART NO	DESCRIPTION	COMPONENT WEIGHT (LB)
1	1		COMPONENT SUPPORT ASSEMBLY CONSISTING OF	
1	1		4" SCH XXS, 0'-8" LG STANCHION PIPE	18.36
2	1		ANCHOR TYPE "B" SEE DETAIL M-1100 SH. 23	10.6
			BUNDLE & TAG FC-49	56.96



REVISED AS NOTED/REV. D

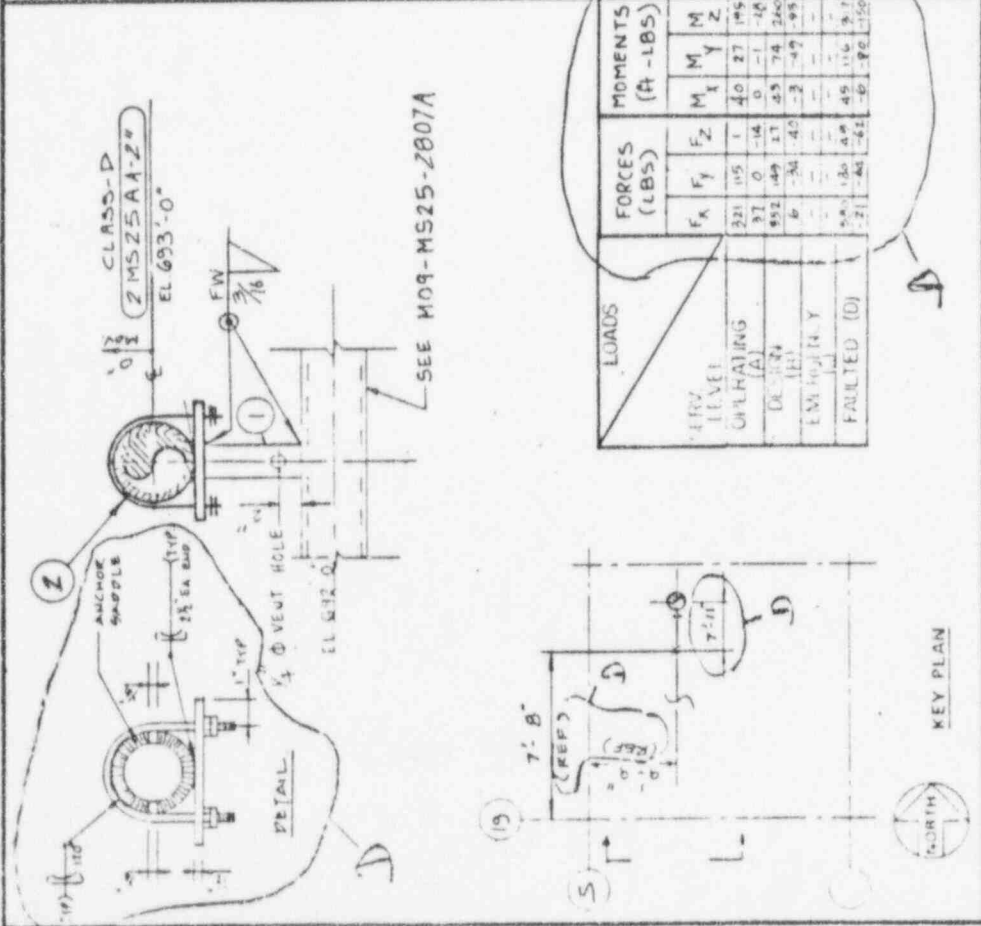

DESIGN	OPERATING	HYDRO TEST	EMERGENCY
SEE	SEE	LOAD	TABLE

WELD NO. WELD PROCEDURE EXAMINATION PROCEDURE


LA SALLE COUNTY STATION UNIT-2
COMMONWEALTH EDISON COMPANY
CHICAGO, ILLINOIS

VICTOR G. PENACERRADA
REGISTERED PROFESSIONAL ENGINEER
OF ILLINOIS

NO SCALE PROJECT NO 4267 30

DRAWING NO. MS 25-2815A D SHEET 1 OF 1

SARGEANT-LURCY ENGINEERS 814A

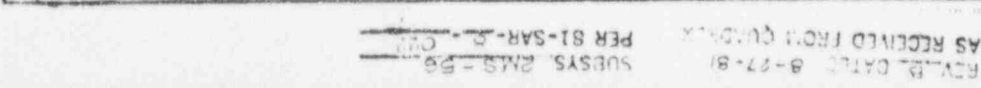

REV	DWG NO	REV	DWG NO	REV	DWG NO	REV	DWG NO
1	9-6-5443	E	5-9-69	Y	M	1E-2-3335	F
2	MS 56 NP (11E)						

DRAWING RELEASE RECORD OUTPUT (EMP 03/1994, 8-11-82)

APPROVED: *[Signature]*


REVIEWED: *[Signatures]*

PURPOSE REVISED PER 4P-T1958 AND PER RBANALY414 (REV C).


FOR "D" SPECS (J-2530)

AS RECEIVED DATE 8-27-81
SUBSYS RMS-PS
PER 81-SAR-P-1-81

REV. 12 DATED 8-27-81 SUBSYS 2113-50
 AS RECEIVED FROM QUADRY PER 81-SAR-5-022

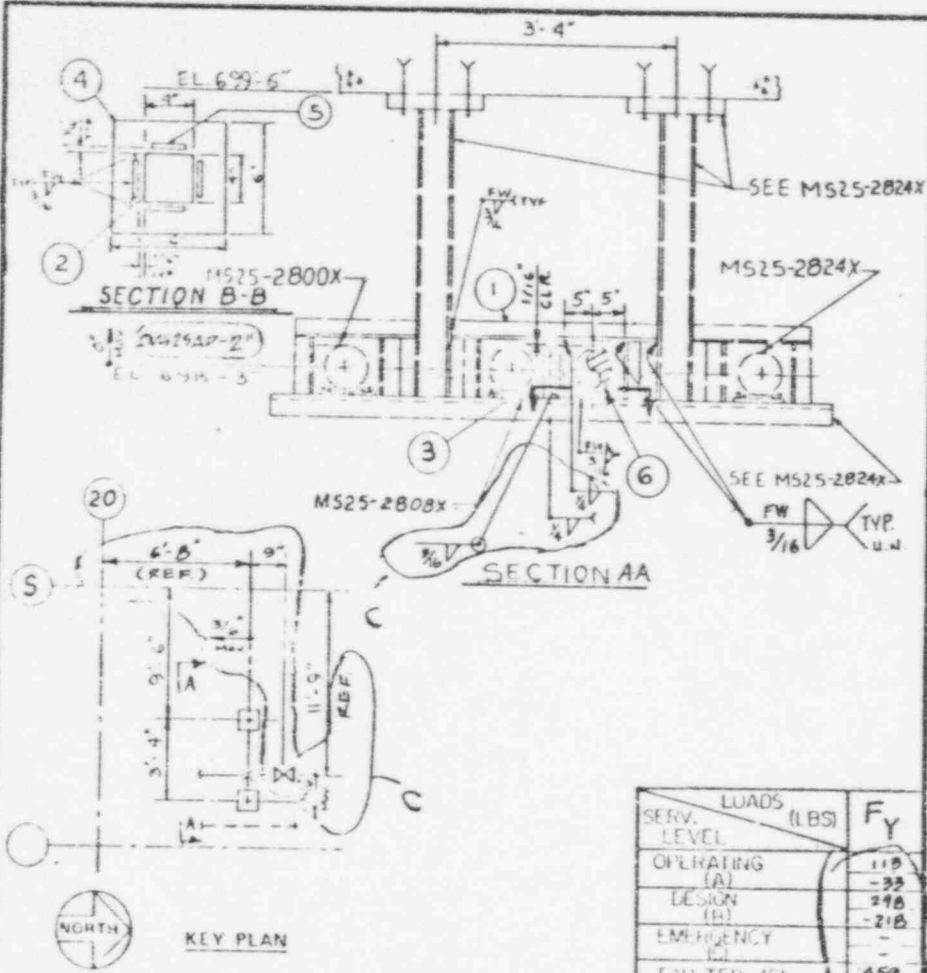

BILL OF MATERIAL				COMPONENT WEIGHT (LB)	
ITEM	QUAN	FIG NO OR PART NO	DESCRIPTION		
COMPONENT SUPPORT ASSEMBLY CONSISTING OF					
1	1		$\angle 1\frac{1}{2} \times 1\frac{1}{2} \times \frac{1}{4} \times 3'-1\"$ LG	7.2	
2	1		$\frac{1}{2} \times 4 \times 4$ LUBRITE PLATE ALLOY 237 W/AE-7 LUBRICANT.	2.0	
3	2		$\angle 1\frac{1}{2} \times 1\frac{1}{2} \times \frac{1}{4} \times 8\frac{1}{4}\"$ LG (CUT TO SUIT)	3.3	
4	1		$\frac{1}{2} \times 6 \times 6$ CS PLATE	5.1	
5	4		$\frac{1}{4} \times \frac{1}{4} \times 3$ CS LUG	0.2	
6	2	162	2" PROTECTION SADDLE	6.4	
1			BUNDLE & TAG FC-49	24.2	
WELD NO.				WELD PROCEDURE	EXAMINATION PROCEDURE

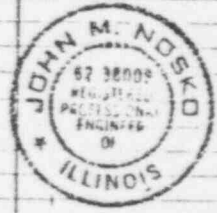

LOADS (LBS)	F _y
SERV. LEVEL	
OPERATING (A)	110
DESIGN (B)	-33
EMERGENCY (C)	210
FAULTED (D)	-210
	450
	-280

REFERENCE DRAWINGS	REV	DWG NO	REV	DWG NO	REV	DWG NO	REV
M966-43	E	MI418-2	E	IE-2-3335	B		
M525	C	S-940	M				

REV	DATE	REL'G	PREPARED	REVIEWED	APPROVED	FILM
A	3-25-81		G. S. ...	M. CHANG	T. ...	
B	8-27-81		A. ...	M. ...	A. ...	
C	9-15-82		E. ...	N.S. ...	H. ...	

LOADS (LBS.)				
DESIGN	OPERATING	HYDRO TEST	EMERGENCY	FAULTED
				SEE LOAD TABLE

PURPOSE FOR RECORD & FILE PER REANALYSIS.
 FOR - D, SPEC. J-2530.
 CTD 6026

EMD REVIEW

SUPPORT CLASS D

LA SALLE COUNTY STATION
 UNIT-2
 COMMONWEALTH EDISON COMPANY
 CHICAGO, ILLINOIS


MAIN STEAM PIPING SYSTEM.

NO SCALE PROJECT NO. 4267 03


SARGENT & LUNDY
 ENGINEERS
 CHICAGO
 WISA

DRAWING NO. M09
 MS25-2816 X C
 SHEET 1 OF 1


AS RECEIVED FROM QUANT

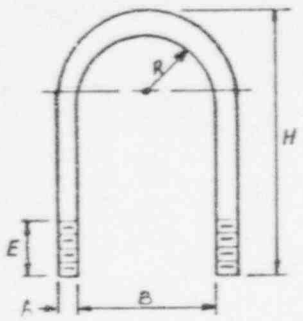

DETAIL 1

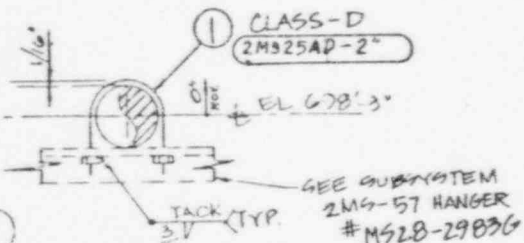


SECTION

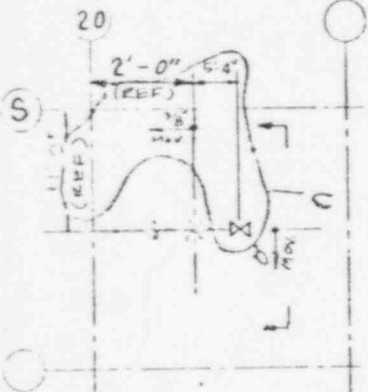

KEY PLAN

SEV. LEVEL	LOADS (LBS)	F _y	F _z
OPERATING (A)	70	15	15
DESIGN (B)	140	30	30
EMERGENCY (C)	210	45	45
FAULTED (D)	280	60	60

BILL OF MATERIAL				ITEM QUAN	FIG NO OR PART NO	DESCRIPTION	P.S.	C.S.	P.A.T.A.	S.E.C.	O.A.S.	COMPONENT HEIGHT (LBS)	REMARKS
TOTAL WEIGHT		TOTAL WEIGHT											
COMPONENT SUPPORT ASSY CONSISTING OF:													
1	1	-	3/8" x 1" U-BOLT			A=5 1/8", B=3 1/8", D=4 1/2", E=3 1/2", H=6 3/4", R=1 1/16", DL=1'-2 1/16" W/2 HEXNUTS, PER DETAIL 1						1.4	
BUNDLE & TAG FC-49													
												1.4	TOTAL WEIGHT

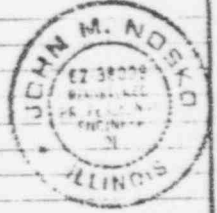

WELD NO.	WELD PROCEDURE	EXAMINATION PROCEDURE
C		

DESIGN	OPERATING	HYDRO TEST	EMERGENCY	FAULTED
	SEE LOAD TABLE			

REV	DATE	BY	CHKD	REV	DATE	BY	CHKD
A	3-25-81	J. Geiger	W. Peterson				
B	8-22-81	J. Geiger	W. Peterson				
C	9-15-82	See 315					



LA SALLE COUNTY
UNIT-2
COMMONWEALTH EDISON CO.
CHICAGO, ILLINOIS

MAIN STEAM PIPING SYSTEM

NO SCALE	DRAWING NO.	REV
PROJECT NO. 4267-00	M09	
	M525-28/8G	C


SARGENT & LUNDY
ENGINEERS
CHICAGO

8/7A

SHEET 1 OF 1


CED-6026 PURPOSE FOR RECORD & FILE FOR REANALYSIS (REV. C.) FOR D SPECS (J-2530)

REV. B DATED 8-27-81
 AS RECEIVED FROM CURD...
 SUBS. 2MS-56
 PEN 81-SAR-B-022

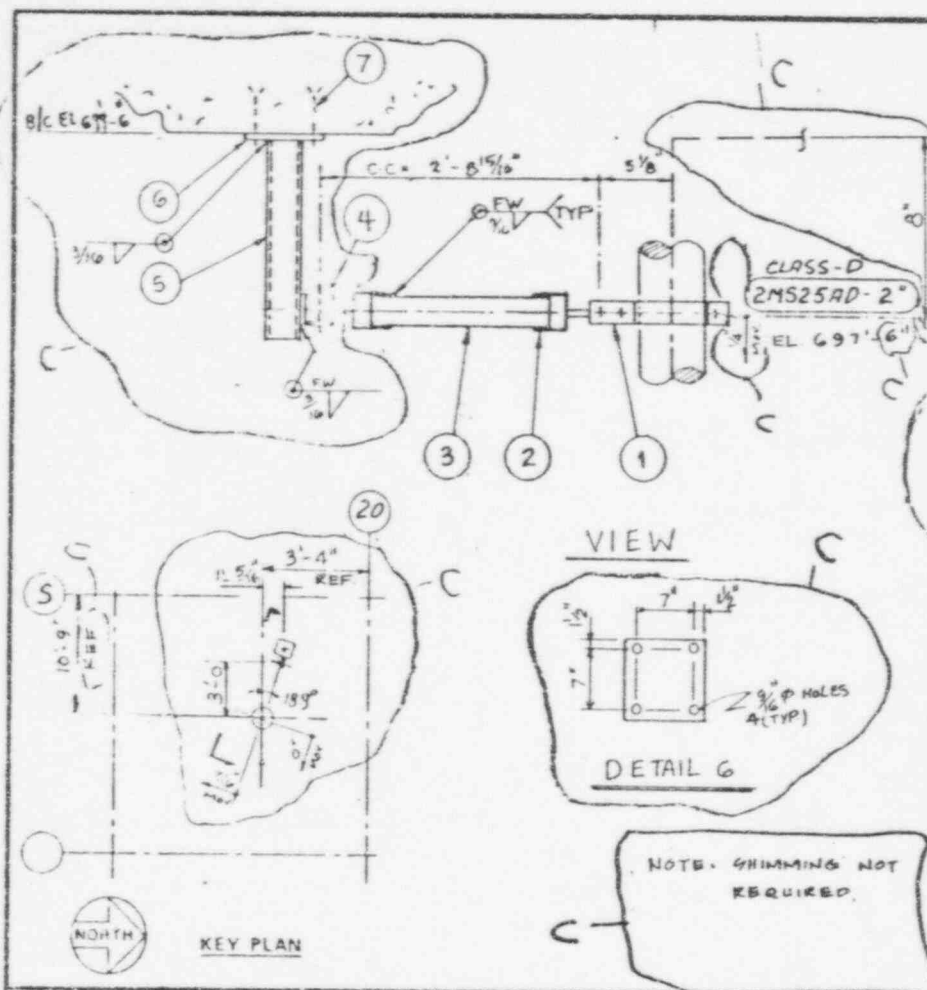

ITEM		QTY	FIG NO. OR PART NO	DESCRIPTION	P&S	CLASS	PRIM	SEC	ALIC
BILL OF MATERIAL									
COMPONENT SUPPORT ASSY									
CONSISTING OF:									
1	1	CH 1015	2 3/8	OD PIPE CLAMP					
2	2	1801312-01		ADAPTER ASSY PER PSA-1/4					
3	1			3/4" SCH XXS EXT PIPE 2'-4" LG					
4	1	1801598-01		REAR BRACKET PSA 1/4					
5	1			1 5/8 X 4 X 1/4" 2'-3" LG					
6	1			1/2" X 10" CS FB 0'-10" LG (PER DETAIL 6)					
7	4			1/2" X 7" LG HILT KWIK BOLTS (SEE DETAIL 6)					
* SUPPLIED BY BULK ORDER									
BUNDLE & TAG FC-49									

COMPONENT WEIGHT (LBS)	REMARKS
2.6	
1.7	
5.7	
0.4	
27.5	
14.2	
1.76	
TOTAL WEIGHT	
53.86	

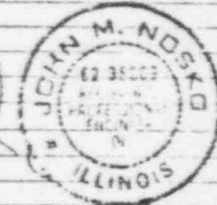

NOTE: GRIMMING NOT REQUIRED.

REV	DATE	BY	CHKD	APP'D	REASON
A	3-25-81	G. C. ...			
B	8-27-81	A. ...			
C	9-15-82	G. ...			

PURPOSE REVISED PER SP-T1307-(REV.C) PER REANALYSIS

SFE CED-6026 FOR D SPECS(U-2530)

WELD NO.	WELD PROCEDURE	EXAMINATION PROCEDURE

DESIGN	OPERATING	HYDRO TEST	EMERGENCY	FAULTED
85/-19	74/-7			95/-29



LA SALLE COUNTY STATION
 UNIT - 2
 COMMONWEALTH EDISON COMPANY
 CHICAGO, ILLINOIS

MAIN STEAM PIPING SYSTEM


DRAWING NO. 1109
 MS25-2819X
 SHEET 1 OF 1

NO SCALE PROJECT NO. 4267-00


ENGINEER: SERGEANT LUNDY
 CHICAGO

818A

REV. B, DATED 8-27-81
 AS RECEIVED FROM QUADRA
 SUESYS, EMS-56
 PER 81-SAR-5-012

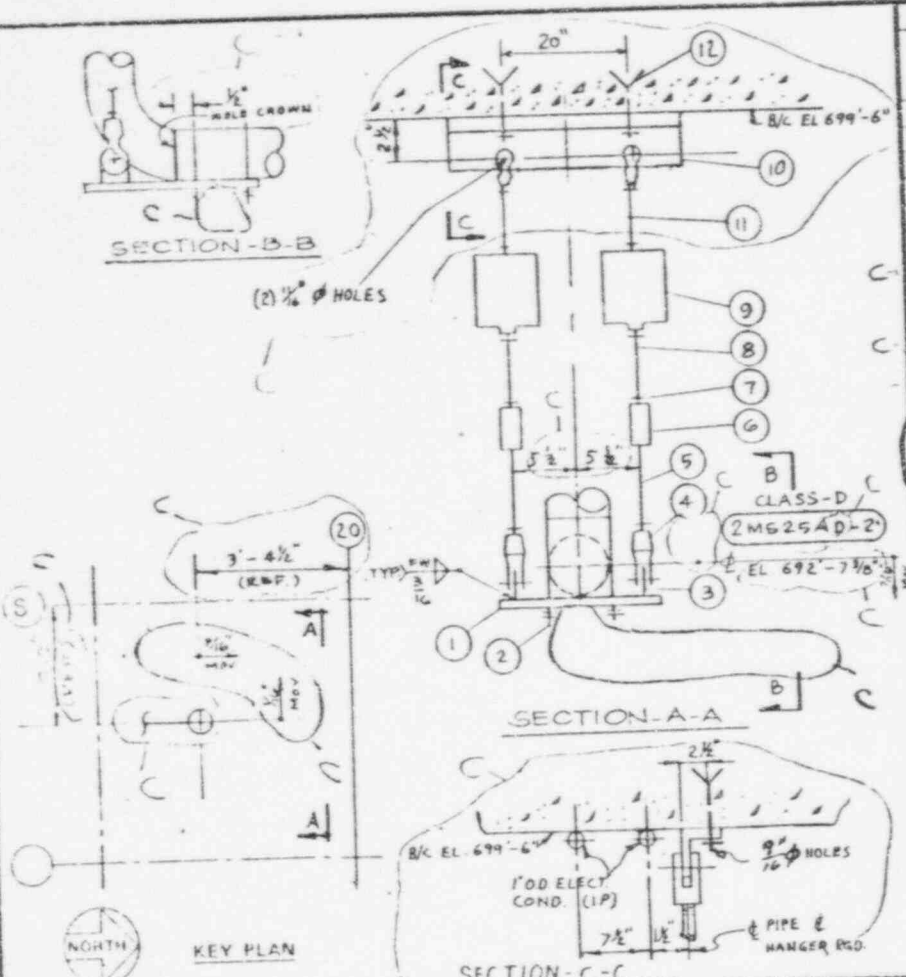

BILL OF MATERIAL				RES	PR	TRIM	SEC	AUG	COMPONENT WEIGHT (LB.)
ITEM	QUAN	FIG NO OR PART NO	DESCRIPTION						
1			COMPONENT SUPPORT ASSEMBLY CONSISTING OF:						
1	1	-	1/2" x 12" x 12" C B PLATE PER DETAIL - 1						20.4
2	2	137	3/8" x 2" U-BOLT D=3/4" W/HEX NUTS						0.7
3	2	55	WELDING LUG (SHORT) 1/2" ROD						1.0
4	4	299	1/2" CLAVIS W/PIN & COTTER						7.64
5	2	253	1/2" Ø ROD x 1'-6" LG W/6" TBE						1.59
6	2	230	1/2" TURNBUCKLE						
7	10	-	1/2" HEX NUT						.45
8	2	140	1/2" (O-B) W/TPL						0.70
9	2	B-208	Ø TYPE-A HL=80 #C.L=81 # 1/2" (O-B)						14.0
10	1	-	L 4" x 4" x 1/2" x 2'-0" LG						25.60
11	2	140	1/2" Ø ROD x 3'-1 1/2" LG W/6" TBE						1.72
12	2	-	1/2" Ø x 7" LG HILTI KWIK BOLT						0.88
1			BUNDLE K TAG FC-49						
									176.10 TOTAL WEIGHT
WELD NO.			WELD PROCEDURE			EXAMINATION PROCEDURE			
DESIGN			OPERATING			HYDRO TEST			EMERGENCY
			SEE LOAD TABLE						(SH.2)
									FAULTED
LOADS (LBS)									

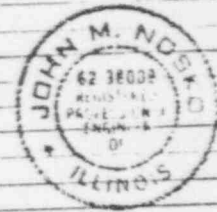

REFERENCE DRAWINGS	DWG NO	REV	DWG NO	REV	DWG NO	REV	DWG NO	REV
	M-866-43	C	M-143-2	E	IE-2-3335	B		
	M-584	C	S-940	M				

REV	DATE	FIELD	PREPARED	REVIEWED	APPROVED	FILED
A	3-25-81		<i>William J. ...</i>	<i>N. ...</i>	<i>V. ...</i>	
B	8-21-81		<i>N. ...</i>	<i>N. ...</i>	<i>V. ...</i>	
C	9-15-82		<i>J. Sigel</i>	<i>N. ...</i>	<i>J. M. ...</i>	<i>R. ...</i>

PURPOSE REVISED PER SP #R-05826 T-1378
 #PER REVISION 1 (REV. C)
 FOR D SPEC(SJ-2930)

LA SALLE COUNTY STATION
 UNIT - 2
 COMMONWEALTH EDISON COMPANY
 CHICAGO, ILLINOIS

MAIN STEAM PIPING SYS.

DRAWING NO. 1 REV
 MOB.
 MS25-2820V C
 SHEET 1 OF 2


NO SCALE
 PROJECT NO
 4267-00

SARGENT LUNDY
 ENGINEERS
 CHICAGO
 819A

VICTORY G. PENACERRA
 REGISTERED PROFESSIONAL ENGINEER
 OF ILLINOIS

SUPPORT CLASS D

REVISED DATED 8-27-81
 AS RECEIVED FROM...
 SUCSYS 2MS-056
 PER 81-SAR-B-022

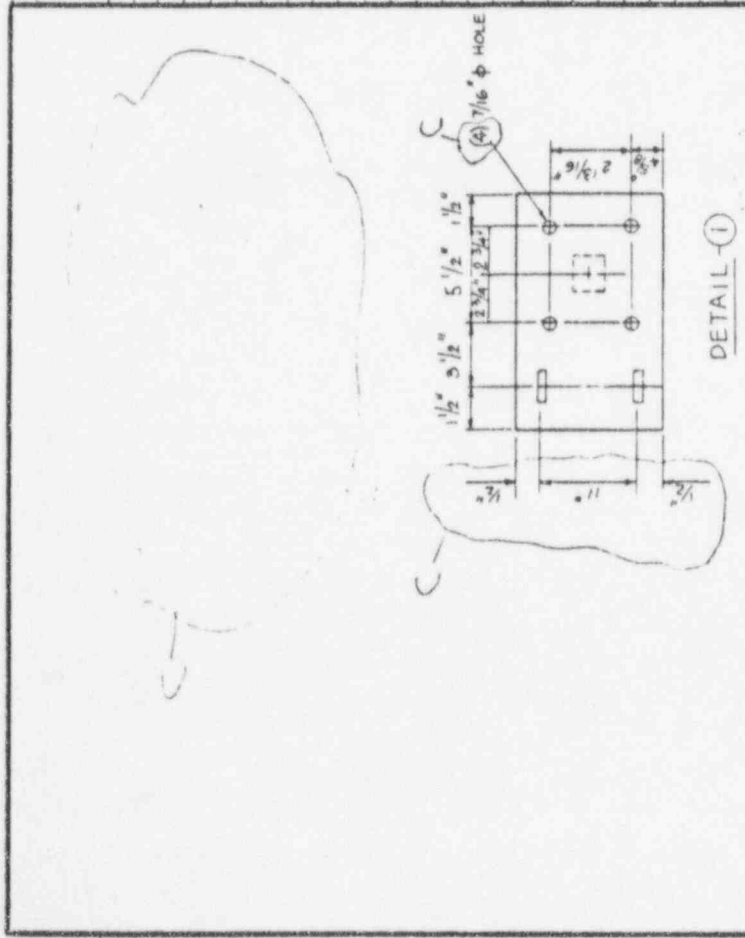

SEMI-LOADS (LBS.)	147
OPERATING	147
EMERGENCY	147
FAULTED	147

REV	DATE	REV	DWG. NO.	REV	DWG. NO.	REV	DWG. NO.	REV	DWG. NO.	REV	DWG. NO.	REV	DWG. NO.
A	3-25-81	C	M-1418-2	E	1E-2-3335	B							
B	8-27-81	C	S-540	M									
C	9-15-82												

2MS-56 NP 1275 (V)
 DRAWING RELEASE RECORD EMD-897954 OUTPUT: B-II-BE

PURPOSE REVISED PER SP8 R-0582 T-1378
 PER 81-SAR-B-022 (REV: C)

FOR D SPECS (J-2530)

ITEM	QUAN.	FIG. NO. OR PART NO.	DESCRIPTION	COMPONENT WEIGHT (LBS.)
1			COMPONENT SUPPORT ASSEMBLY CONSISTING OF	
			BILL OF MATERIAL SEE SH. 1	

LA SALLE COUNTY STATION
 UNIT - 2
 COMMONWEALTH EDISON COMPANY
 CHICAGO, ILLINOIS

MAIN STEAM PIPING SYSTEM

NO SCALE
 PROJECT NO. 437 00

EMD REVIEW
 [Signature]

PIPE CLASS D


PE SEAL

SARGENT & LUNDY
 CHICAGO, ILLINOIS

DRAWING NO. M09
 MS25-2820A
 SHEET 2 OF 2



ITEM	QTY	FIG NO OR PART NO	DESCRIPTION	COMPONENT SUPPORT ASS CONSISTING OF	COMPONENT WEIGHT (LBS)
1	2			3" x 4" x 0.10% LG	711
				BUNDLE & TAG FC-49	712

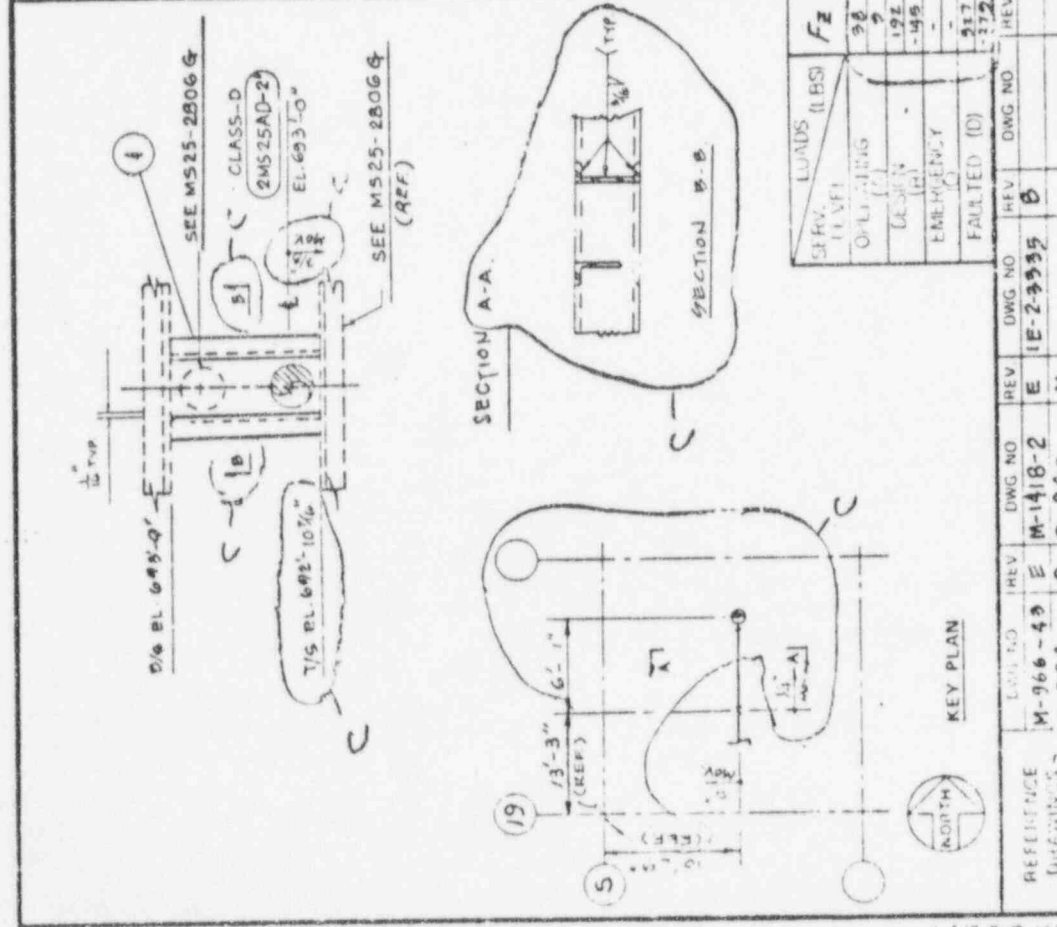

BILL OF MATERIAL		LA SALLE COUNTY STATION UNIT-2	
DESCRIPTION		COMPASS HEALTH EDISON COMPANY CHICAGO, ILLINOIS	
COMPONENT SUPPORT ASS CONSISTING OF		MAIN STEAM PIPING SYSTEM	
WELD PROCEDURE		NO SCALE	
EXAMINATION PROCEDURE		PROJECT NO 4267-00	
LOADS (LBS)		DRAWING NO. 10-2	
DESIGN		REVISIONS	
OPERATING		NO. 1	
HYDRO TEST		M525-2806G	
EMERGENCY		SHEET 1 OF 1	
FAULTED		82/A	




EMD REVIEW		VICTOR G. PENACERRADA REGISTERED PROFESSIONAL ENGINEER OF ILLINOIS	
DESIGN		LA SALLE COUNTY STATION UNIT-2	
OPERATING		COMPASS HEALTH EDISON COMPANY CHICAGO, ILLINOIS	
HYDRO TEST		MAIN STEAM PIPING SYSTEM	
EMERGENCY		NO SCALE	
FAULTED		PROJECT NO 4267-00	
LOADS (LBS)		DRAWING NO. 10-2	
DESIGN		REVISIONS	
OPERATING		NO. 1	
HYDRO TEST		M525-2806G	
EMERGENCY		SHEET 1 OF 1	
FAULTED		82/A	

REV	DATE	BY	CHKD	APP'D	PURPOSE
1	10-2-82	V. G. Penacerrada			FOR RECORD & FILE - REVISED PER RE-ANALYSIS (R50)
2	10-2-82	V. G. Penacerrada			
3	10-2-82	V. G. Penacerrada			
4	10-2-82	V. G. Penacerrada			
5	10-2-82	V. G. Penacerrada			

REV	DATE	BY	CHKD	APP'D	PURPOSE
1	10-2-82	V. G. Penacerrada			FOR RECORD & FILE - REVISED PER RE-ANALYSIS (R50)
2	10-2-82	V. G. Penacerrada			
3	10-2-82	V. G. Penacerrada			
4	10-2-82	V. G. Penacerrada			
5	10-2-82	V. G. Penacerrada			



AS RECEIVED PER I.C. DRAWING PER 91-SAR-B-012

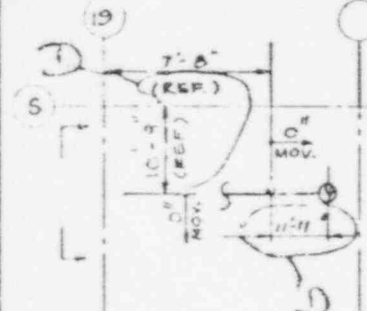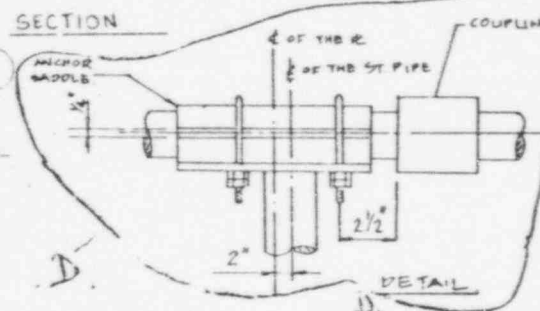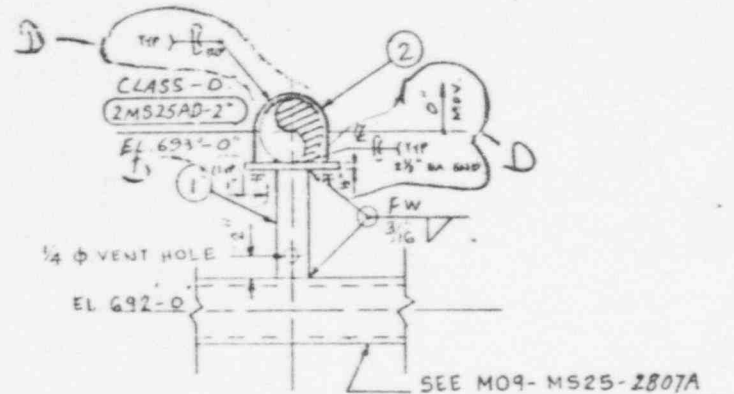

KEY PLAN

SERVICE LEVEL	LOAD (LBS)			FORCES (LBS)			MOMENTS (FT-LBS)		
	F _x	F _y	F _z	M _x	M _y	M _z			
OPERATING (A)	245	175	-5	10	34	662			
DESIGN (B)	300	220	70	76	190	251			
EMERGENCY (C)	-71	12	-22	-62	-146	-147			
FAULTED (D)	350	275	147	194	327	1203			
	-120	-25	-149	-127	-223	-200			


BILL OF MATERIAL			
ITEM	QUAN	FIG NO OR PART NO	DESCRIPTION
1			COMPONENT SUPPORT ASSEMBLY CONSISTING OF
1/1			4" ϕ SCH XXS STANCHION PIPE, 0'-8" LG.
2/1			ANCHOR TYPE "B" SEE DETAIL. M-1100 SHT. 33

LOADS (LBS)		
DESIGN	OPERATING	HYDRO TEST
SEE	TABLE	

WELD NO	WELD PROCEDURE	EXAMINATION PROCEDURE

NOTE: GIFT ANCHOR ASSEMBLY 2" NORTH TO M1100 COUPLING. STANCHION WILL REMAIN ON ϕ OF SUPPORT LOCATION.

BUNDLE # TAG
FC-49

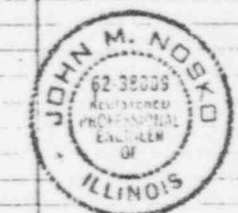

REVISED AS NOTED/REV. B

REV	DATE	BY	DESCRIPTION
1	11-11-82	J.M. Nosko	DESIGN
2	12-15-82	J.M. Nosko	REVISED

REV	DATE	BY	DESCRIPTION
A	3-25-81	B. Rao	DESIGN
B	8-27-81	B. Rao	REVISED
C	6-22-82	B. Rao	REVISED
D	9-15-82	B. Rao	REVISED

PURPOSE REVISED PER 4P-11344, I1987 AND REANALYSIS (REV. D)

40-6026

FOR-D SPEC. J-2530

EMD REVIEW
Royesh Gupta



LA SALLE COUNTY STATION
UNIT -2
COMMONWEALTH EDISON COMPANY
CHICAGO, ILLINOIS


MAIN STEAM PIPING SYSTEM

NO SCALE PROJECT NO 4267 (X)	DRAWING NO. M109 MS25-2823A	REV D
---------------------------------	-----------------------------------	----------


SARGENT LUNDY ENGINEERS CHICAGO

822A SHEET 1 OF 1

AS RECEIVED FROM QUANTITY DEPARTMENT PER 81-SAR-B-022

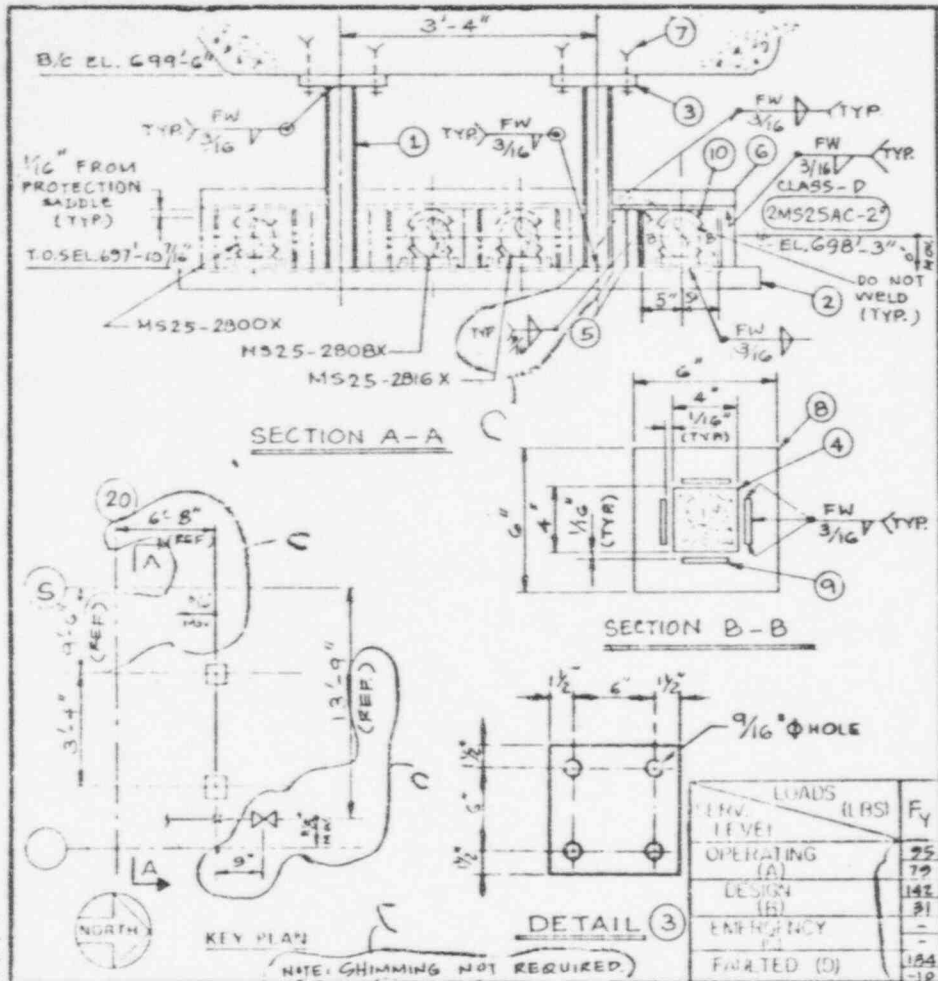

BILL OF MATERIAL				P&S	CSS	PRIM	F&C	ALG	COMPONENT WEIGHT (LB)
ITEM	QUAN	FIG NO OR PART NO	DESCRIPTION						
1			COMPONENT SUPPORT ASSEMBLY CONSISTING OF						
1	2		C3 x 4.1 x 1'-7" LG. LG						13.0
2	1		C3 x 4.1 x 6'-5" LG						26.3
3	2		1/2" x 9" CS R, 0'-9 LG. (SEE DETAIL - 3)						23.0
4	1		1/2" x 4" x 4" LUBRITE PLATE (20-375)						2.0
5	2		L1 1/2 x 1 1/2 x 1/4 x 0'-9 1/4 LG.						3.2
6	1		L1 1/2 x 1 1/2 x 1/4 x 1'-5" LG.						3.3
7	3		1/2" x 5 1/2" HILTI KWIK-BOLTS (8D MIN. EMBEDMENT)						3.2
B	1		1/2" x 6" x 6" C.S. PLATE						5.0
9	4		1/4" x 1/4" x 3" C.S. LUG						0.2
10	2	162	2" PROTECTION SADDLE						6.4
BUNDLE & TAG FC-49									
									85.7
WELD NO									
WELD PROCEDURE									
EXAMINATION PROCEDURE									
LOADS (LBS)									
DESIGN									
OPERATING									
HYDRO TEST									
EMERGENCY									
FAULTED									

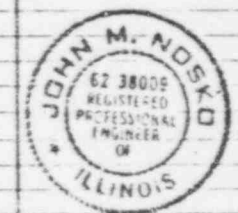

REFERENCE DRAWINGS	DWG NO	REV	DWG NO	REV	DWG NO	REV	DWG NO	REV
M-966-43	E	M-1418-2	E	1E-2-3335	B			
M-525	C	S-940	M					

REV	DATE	REL'D	PREPARED	REVIEWED	APPROVED	FILM
A	3-25-81		A. Young	Nicholson	T.K. Marzoff	CHANG
B	8-27-81		K. Kelly	18 Nov	W. Marzoff	1/1/82
C	9-15-82		See file		P. J. Carter	D.C.


EMD 037954, B-11-82

PURPOSE FOR RECORD & FILE PER REANALYSIS (REV-C)

FOR D SPECS (J-2930)

WELD NO	WELD PROCEDURE	EXAMINATION PROCEDURE	Nuclear Services Corporation
REVISED AS NOTED/REV.B			REV B
LOADS (LBS)			
DESIGN	OPERATING	HYDRO TEST	EMERGENCY
SEE TABLE			
EMD REVIEW		LA SALLE COUNTY STATION UNIT-2 COMMONWEALTH EDISON COMPANY CHICAGO, ILLINOIS	
VICTORY G. PENACERRA REGISTERED PROFESSIONAL ENGINEER ILLINOIS		MAIN STEAM PIPING SYSTEM.	
NO SCALE	PROJECT NO	DATE	REV
	4267-00		
SAIGENT LUNBY ENGINEERS CHICAGO		MOA-MS25-2824X	C
823A		SHEET 1 OF 1	

REV. A DATED 8-27-81 SUBSYS 2MS-56
 AS RECEIVED FROM QUADRA PER 61-SAR-B-022

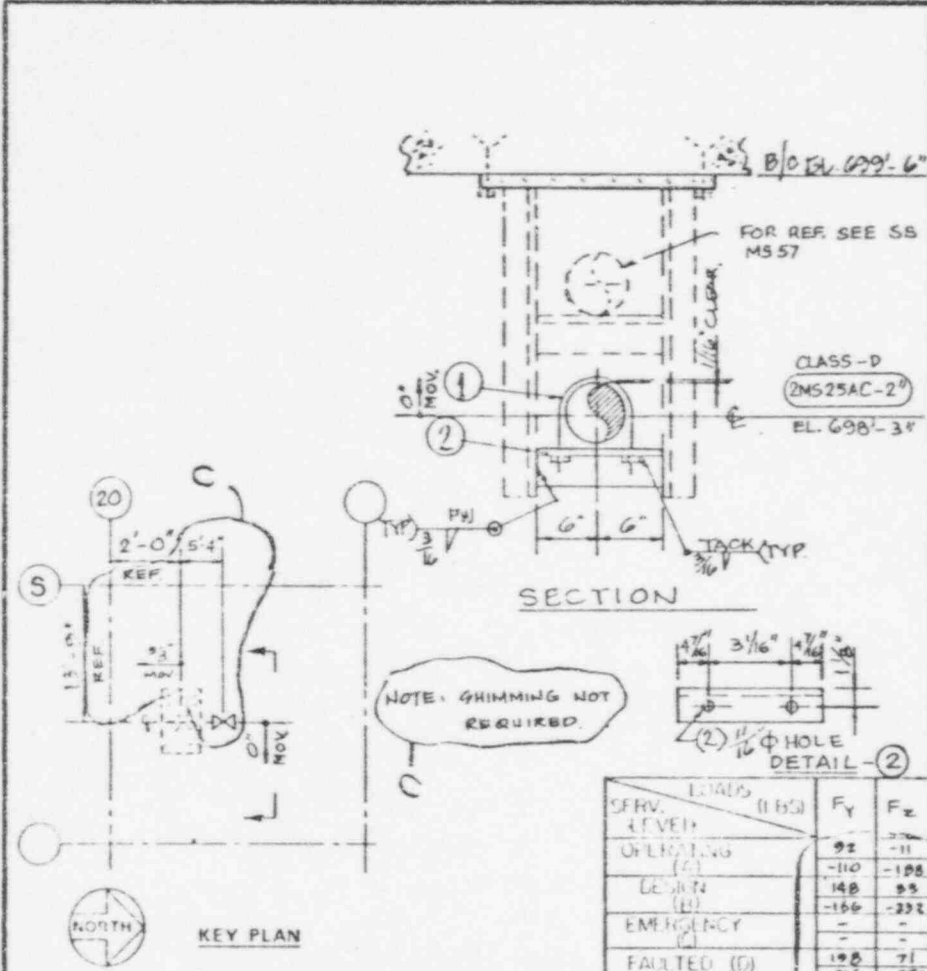

BILL OF MATERIAL				P.65	CLASS	PART	SEC.	A.I.C.	COMPONENT WEIGHT (LBS)	REMARKS
ITEM	QUAN	FIG NO. OR PART NO	DESCRIPTION							
			COMPONENT SUPPORTARY CONSISTING OF:							
1	1	-	5/8" x 2" U-BOLT, TL = 2 1/2" B = 3/4" DL = 0-10 1/8" NUTS (HEAVY DUTY)						1.0	
2	1	-	L2" x 2" x 3/16" 1'-0" LG (SEE DETAIL 2)						4.7	
			BUNDLE & TAG FC-49							
									5.7	TOTAL WEIGHT
										REVISED AS NOTED/REV. B

SEV. LEVEL	LOADS (LBS)	F _y	F _z
OPERATING (O)	92	-11	-198
DESIGN (D)	148	95	-232
EMERGENCY (E)	-	-	-
FAULTED (F)	198	71	-270

REV	DATE	REL'D	PREPARED	REVIEWED	APPROVED	FILM
A	3-25-81		M. Wong / Siebtrau	A. Bahig / K. M. Muel	P. Penacerrada	
B	8-27-81		V. Hoff / Siebtrau	M. W. G. / K. M. Muel	P. Penacerrada	
C	9-15-82		Z. G. / Siebtrau	D. S. Parker / D. C.	J. H. / Siebtrau	

PURPOSE FOR RECORD & FILE PER REANALYSIS (REV. C)
 11-6026 FOR "D" SPEC (J-2530)

EMD REVIEW


Regis Campbell

LASALLE COUNTY
UNIT-2
COMMONWEALTH EDISON CO.
CHICAGO, ILLINOIS


MAIN STEAM PIPING SYSTEM.

NO SCALE	DRAWING NO.
PROJECT NO. 4267-00	M33
SARGENT & LUNDY ENGINEERS CHICAGO, ILL.	MS25-2826G
825A	SHEET 1 OF 1

AS RECEIVED FROM QUADRA PER 81-SAR-8 - C

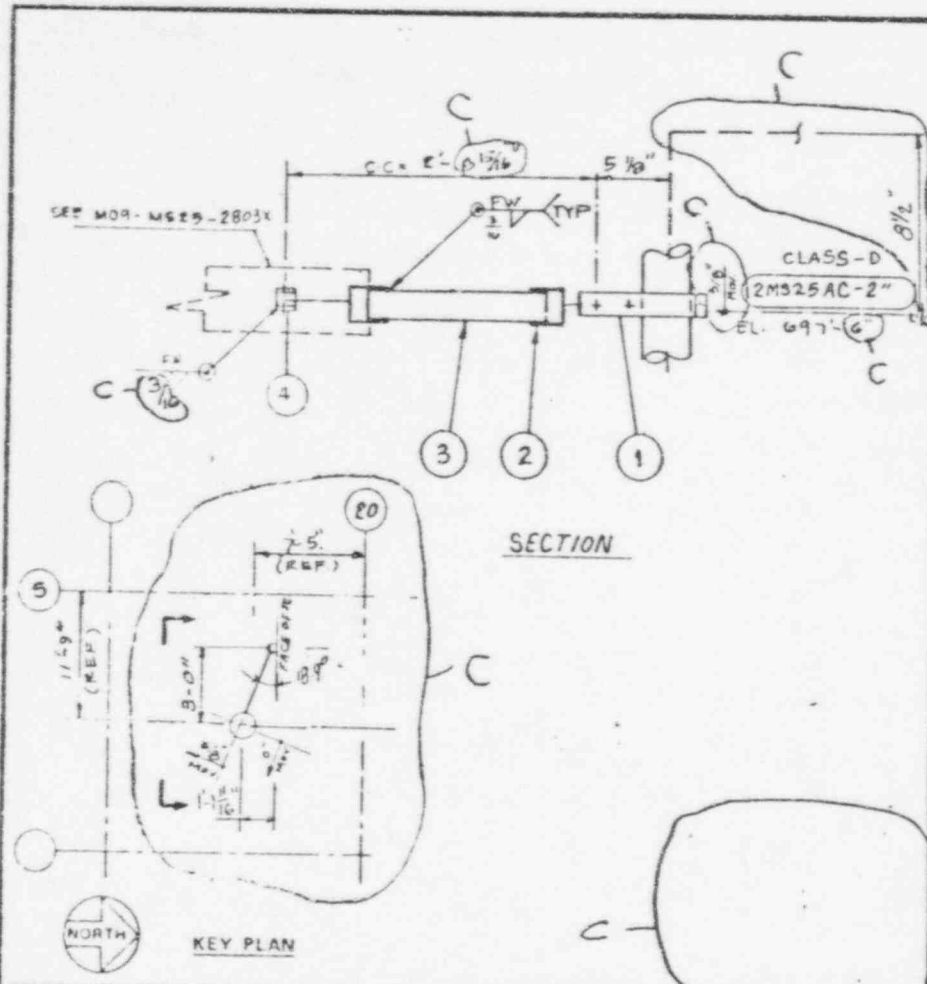

ITEM		FIG NO OR PART NO	DESCRIPTION	COMPONENT WEIGHT (LBS)	REMARKS
BILL OF MATERIAL					
COMPONENT SUPPORT ASSY. CONSISTING OF:					
1	1	8H-1407	2" ϕ PIPE CLAMP	2.6	
2	2	1801912-01	ADAPTER ASSY PER PSA-1/4 *	51.7	
3	1		3/4" SCH XXS EXT. PIPE 2'-4" LG	5.7	
4	1	1001535-01	REAR BRACKET PER PSA-1/4 *	0.4	
* SUPPLIED BY BULK ORDER					
1			BUNDLE & TAG FC-49		
WELD NO.				EXAMINATION PROCEDURE	
WELD PROCEDURE				EXAMINATION PROCEDURE	
LOADS (LBS)					
DESIGN		OPERATING		FAULTED	
77/-16		56/4		95/-34	
HYDRO TEST				EMERGENCY	
				TOTAL WEIGHT	
				10.4	
REVISED AS NOTED/REV. B					

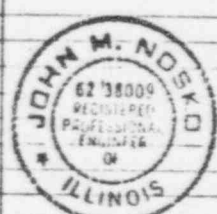

REF	DWG NO	REV	DWG NO	REV	DWG NO	REV	DWG NO	REV
1	M-806-43		M-1418-2	E	1E-2-3325	B		
2	M-584	C	S-940	M				

2MS-56 NP 405 (2 SKW) DRAWING RELEASE RECORD EMD-037954, 8-11-82


REV	DATE HELD	PREPARED	REVIEWED	APPROVED	FILM
A	3-25-81	J. Geiger / S. B. Howell	H. P. Kelly / H. K. Johnson	V. Penacerrada	
B	2-27-81	J. Geiger / S. B. Howell	M. J. Cantel / J. C. L. ...	V. Penacerrada	
C	9-15-82	J. Geiger / S. B. Howell	M. J. Cantel / J. C. L. ...	J. M. ...	

PURPOSE REVISED PER SP-T1307-03 (REV. C) PER KBA/ALY/119

SEE CSD-6026 FOR D SPECS (J-2530)

VICTORY G. PENACERRADA 062 001132 REGISTERED PROFESSIONAL ENGINEER OF ILLINOIS		LA SALLE COUNTY STATION UNIT-2 COMMONWEALTH EDISON COMPANY CHICAGO, ILLINOIS	
NO SCALE PROJECT NO 4267-00		MAIN STEAM PIPING SYSTEM	
SARGENT & LUNDY ENGINEERS CHICAGO		MS25-2827X	
826A		SHEET 1 OF 1	


REV. A DATED 5/27/80 AS RECEIVED FROM QUAD PER 81-SAR-5 - 022

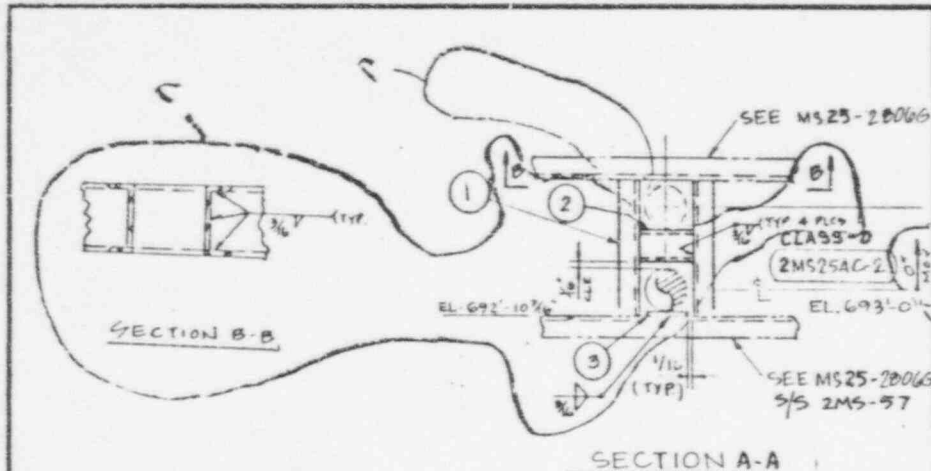

ITEM		FIG. NO. OR PART NO.	DESCRIPTION	LOADS (LBS)		
ONE	1		COMPONENT SUPPORT ASSEMBLY CONSISTING OF:			
	2		C3 x 4-1 x 5/16 LG.			
	2		T6 2 1/2 x 1 1/2 x 3/4 d = 2 1/2 LG			
	3		3/8" x 1 3/8" x 9/2" C + PLATE			
	1		BUNDLE & TAG FC-49			
				DESIGN	OPERATING	HYDRO TEST
				EMERGENCY	SEE LOAD TABLE	
				FAULTED		

COMPONENT WEIGHT (LBS)	EXAMINATION PROCEDURE
7.22	
1.48	
0.88	
9.58	TOTAL WT

REVISED AS NOTED / REV. B

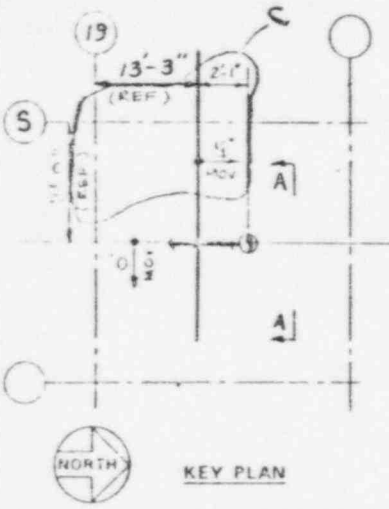

SERV. LEVEL	LOADS (LBS)	
	F _Y	F _Z
OPERATING (A)	208	68
DESIGN (P)	220	82
EMERGENCY (E)	—	—
FAULTED (D)	970	99



REV	DATE	BY	FOR	APP. NO.	REV	DWG NO.	REV	DWG NO.	REV	DWG NO.	REV
A	3-25-81	J. Geary / ...	HNB America / ...		B	1E-2-3335					
B	8-27-81	J. Geary / ...	M. ... / ...		M	5-940					
C	9-15-82	... / ...	N.S. ... / ...								

LA SALLE COUNTY STATION
UNIT-2
COMMONWEALTH EDISON COMPANY
CHICAGO, ILLINOIS



PROJECT NO. 4267-00		DRAWING NO. M09-	
SARGENT & LUNDY ENGINEERS CHICAGO		M525-2830G C	
829A		SHEET 1 OF 1	


PURPOSE: REVIEWER PER ANALYSIS (REV. C)
CED-6026 FOR DR. SPECS (J-2530)

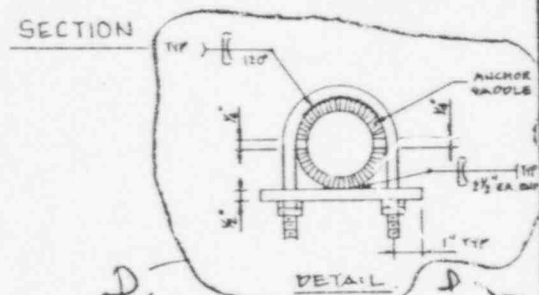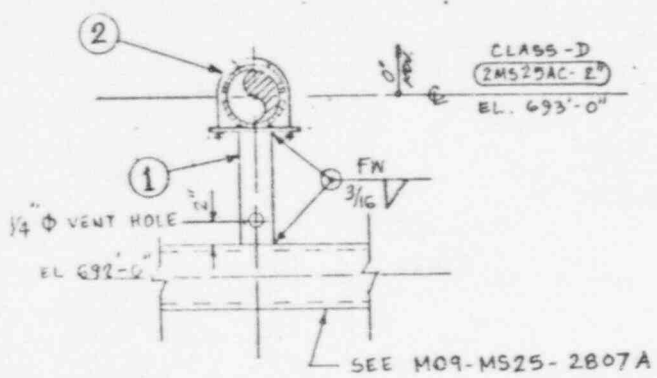

LOAD SERVICE LEVEL	FORCES (LBS)			MOMENTS (FT-LB)		
	F _x	F _y	F _z	M _x	M _y	M _z
OPERATING (A)	200	113	-1	13	29	191
DESIGN (B)	323	195	7	44	54	322
EMERGENCY (C)	-	-	-	-	-	-
FAULTED (D)	343	152	14	46	68	267
	-7	-41	-95	-2	26	-105

BILL OF MATERIAL				PKS	CIS	PRY	SEC	A/C
ITEM	QUAN	FIG NO OR PART NO	DESCRIPTION					
1	1		COMPONENT SUPPORT ASSEMBLY CONSISTING OF					
1	1		4" φ, SCH 40, 0'-8" LG. STANCHION PIPE					
2	1		ANCHOR TYPE "B", SEE DETAIL - M-1100, SHEET 33.					
1	1		BUNDLE & TAG FC-49					

COMPONENT WEIGHT (LB)	REMARKS
18.36	
18.6	
36.26	

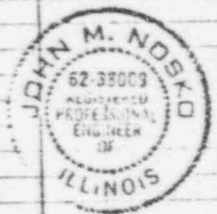

WELD NO.	WELD PROCEDURE	EXAMINATION PROCEDURE

DESIGN	OPERATING	HYDRO TEST	EMERGENCY	FAULTED

REFERENCE D	DWG NO	REV	DWG NO	REV	DWG NO	REV	DWG NO	REV
	1-906 SH 43	E	5-969	Y				
	5-1016	B	5-975	M	1E-2-3335	F		

REV	DATE	BY	CHKD	REASON
A	3-25-81	SK Saha / J. Gebreau		
B	8-27-81	J. Geiger / Subethan		
C	6-22-82			
D	9-15-82			

PURPOSE: REVISED PER GP-T-1556 & P&E REANALYSIS (REV. D)

CEC-6026 FOR D SPEC (J-2530)

LA SALLE COUNTY STATION
UNIT-2
COMMONWEALTH EDISON COMPANY
CHICAGO, ILLINOIS

MAIN STEAM PIPING SYSTEM

DRAWING NO. M525-2831A
REV. 1.03
SHEET 1 OF 1

PROJECT NO. 4267-00


SARGENT & LUDBY ENGINEERS CHICAGO

830A



AS RECEIVED FROM CU W PER 81-SAR-C-60

REV B DATED 8-27-81
 AS RECEIVED FROM QUANTITY
 PER 81-SAR-9-022

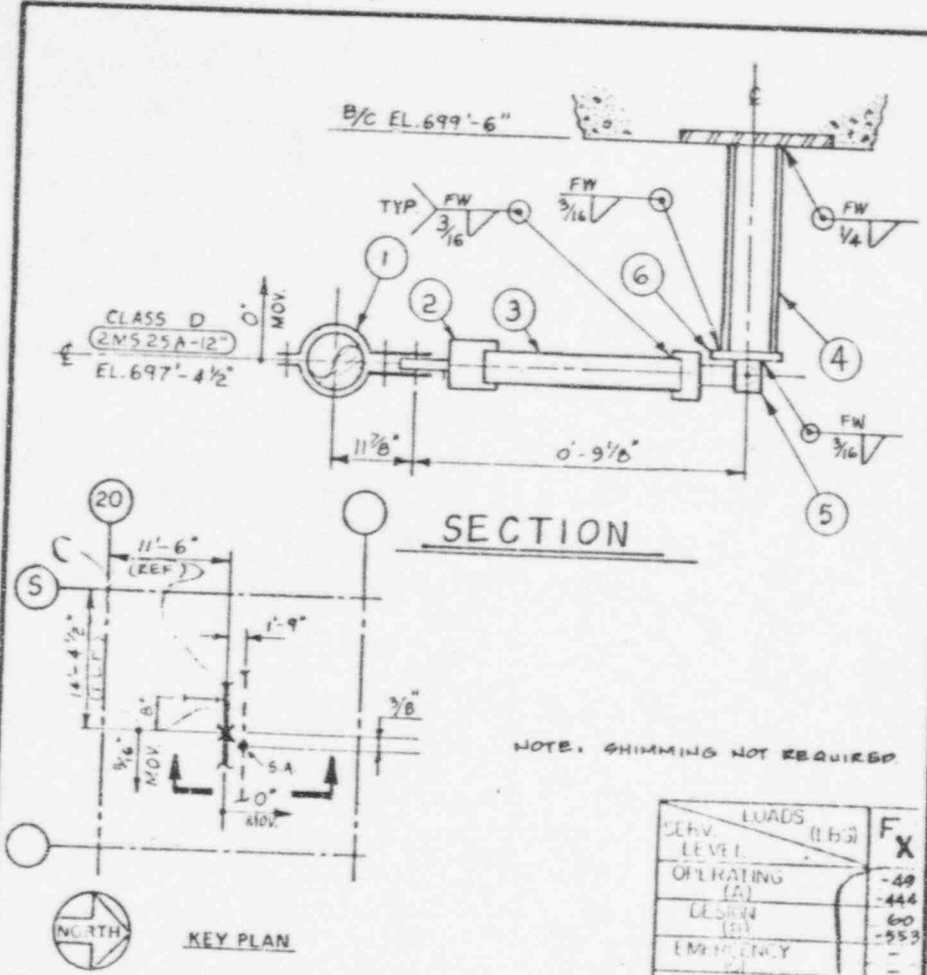

ITEM		FIG. NO. OR PART NO.	DESCRIPTION	PKS	PCS	PRM	SEC	AISC	COMPONENT WEIGHT (LB)
1			COMPONENT SUPPORT ASSEMBLY CONSISTING OF						
1	1	BH-1271	12" PIPE CLAMP						26.5
2	2	180313-02	ADAPTER ASSY. FOR PSA-1 *						2
3	1	---	1" EXT. PIPE, SCH.XXS, 0'-5" LG.						1.5
4	1	---	M 4 x 13, 1'-11 1/4" LG.						25.2
5	1	180155B-03	REAR BRACKET FOR PSA-1 *						1.1
6	1	---	1/2" x 4 1/2" C.S.TE, 0'-4 1/2" LG.						2.9

* SUPPLIED BY BULK ORDER

BUNDLE & TAG
 FC-47



LOADS (LBS)		FX
SEV. LEVEL		
OPERATING (A)		-444
DESIGN (B)		60
EMERGENCY		-353
FAULTED (D)		155
		-642

WELD NO.	WELD PROCEDURE	EXAMINATION PROCEDURE	59-2	TOTAL WEIGHT
DESIGN	OPERATING	HYDRO TEST	EMERGENCY	FAULTED
		SEE TABLE		

REVISED AS NOTED/REV.B

REFERENCE DRAWINGS	DWG. NO.	REV.	DWG. NO.	REV.	DWG. NO.	REV.	DWG. NO.	REV.
	M-700, SW22	K	M-111B, SH. 2	E	IE-2-3335	B		
	M-584	C	S-940	M				

REV.	DATE REL'D	PREPARED	REVIEWED	APPROVED	EMD REVIEW
A	3-25-81	Richard / Subline	J. High, J. M. ...	W. ...	
B	27-81	J. G.	
C	9-15-82	

PURPOSE FOR RECORD & FILE PER REANALYSIS (RBYC)
 CED 6026 FOR D SPECS (J-2530)

PIPE CLASS D



LA SALLE COUNTY STATION
 UNIT-2
 COMMONWEALTH EDISON COMPANY
 CHICAGO, ILLINOIS


MAIN STEAM PIPING SYS

NO SCALE
 PROJECT NO 4267 00

DRAWING NO. M09-MS25-2840X

SARGENT & LUNDY ENGINEERS CHICAGO

D.W. 5, DATED 0-27-82, CUBSYS 0203-56
 AS RECEIVED FROM QUADRA PER 81-SAR-B-022

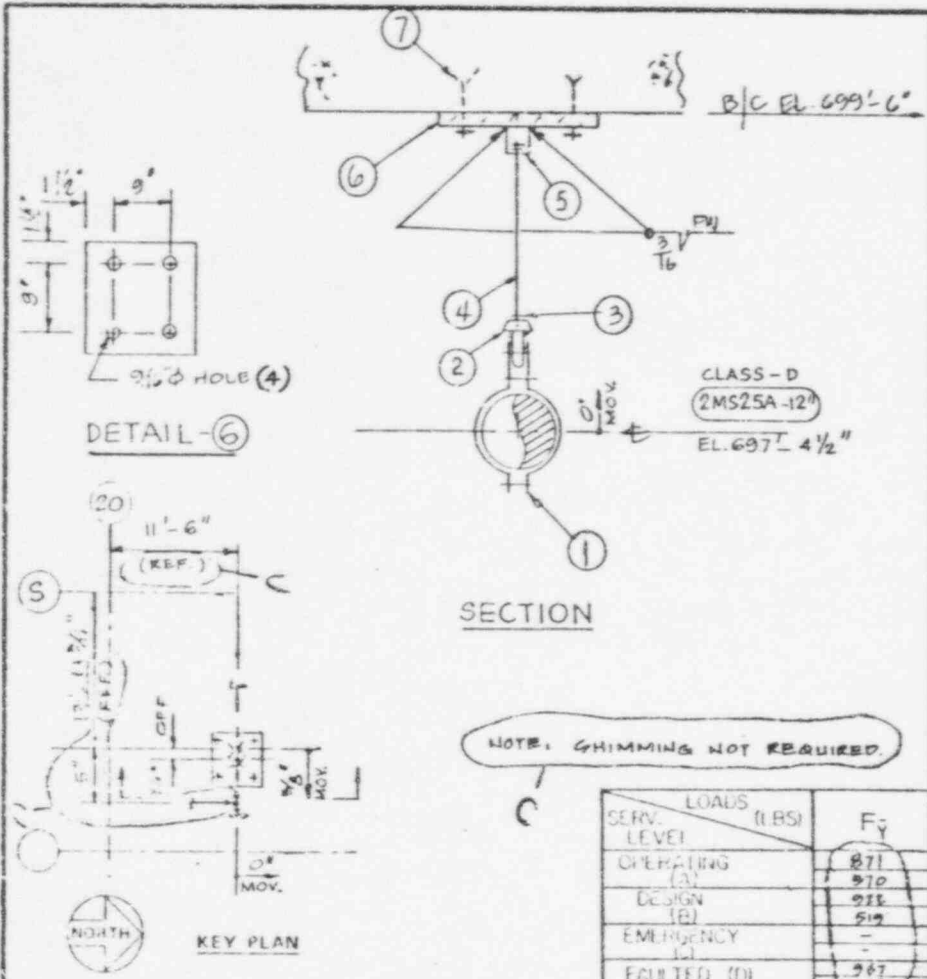

ITEM		FIG NO OR PART NO	DESCRIPTION	PKS	CS	PRIM	SEC	ALG
COMPONENT SUPPORT ASSY CONSISTING OF:								
1	1	295	12" φ DOUBLE BOLT PIPE CLAMP					
2	1	290	1/2" WELDLESS EYE NUT					
3	3	-	1/2" HEX NUTS					
4	1	140	1/2" x 0'-10 1/2" ROD W/T.F.L.					
5	1	66	1/2" WELDED BEAM ATTACHMENT					
6	1	-	1/2" x 12" CSR; 1'-0" LG. (SEE DETAIL-6)					
7	4	-	1/2" x 9 1/2" HILTI KWIK-BOLT					
BUNDLE & TAG FC-49								
WELD NO.				WELD PROCEDURE				EXAMINATION PROCEDURE
DES'GN				OPERATING				HYDRO TEST
SEE TABLE				EMERGENCY				FAULTED

COMPONENT WEIGHT (LBS)
22.3
.6
.2
.6
1.0
21.0
1.6
47.3
TOTAL WEIGHT

JOHN M. NOSKO
 623009 REGISTERED PROFESSIONAL ENGINEER
 ILLINOIS

Revised As Noted/Rev. B

LOADS (LBS)	F _y
OPERATING (A)	871
DESIGN (B)	970
EMERGENCY (C)	519
FAULTED (D)	987
	424

REFERENCE DRAWINGS	DWG NO	REV	DWG NO	REV	DWG NO	REV	DWG NO	REV
M-900-22	K	M-1418-2	E	IE-2-3335	B			
M-584	C	S-940	M					

2MS-56 NF-535(Y) DRAWING RELEASE RECORD EMD-037954 B-11-82

REV	DATE	BY	APPROVED
A	3-25-81	M. S. Wong / Sieber	[Signature]
B	8-27-81	[Signature]	[Signature]
C	9-15-82	[Signature]	[Signature]

PURPOSE FOR RECORD & FILE PER REANALYSIS (REV. C)
 CED-6026 FOR D, SPEC. J-2530


EMD REVIEW
APPROVED
[Signature]

VICTORY & PENACERRA
 062 003132 REGISTERED PROFESSIONAL ENGINEER OF ILLINOIS


SUPPORT CLASS D

LA SALLE COUNTY STATION UNIT-2	
COMMONWEALTH EDISON COMPANY CHICAGO, ILLINOIS	
MAIN STEAM PIPING SYS.	
NO SCALE PROJECT NO 1267-00	DRAWING NO. M325-2038 R
SARGENT & LUNDY ENGINEERS CHICAGO	837A SHEET 1 OF 1

REV. 2 DATED 6-1-82
 AS RECEIVED FROM QUADREX
 SUBSYS 210-56
 PER 61-SAR-6-022

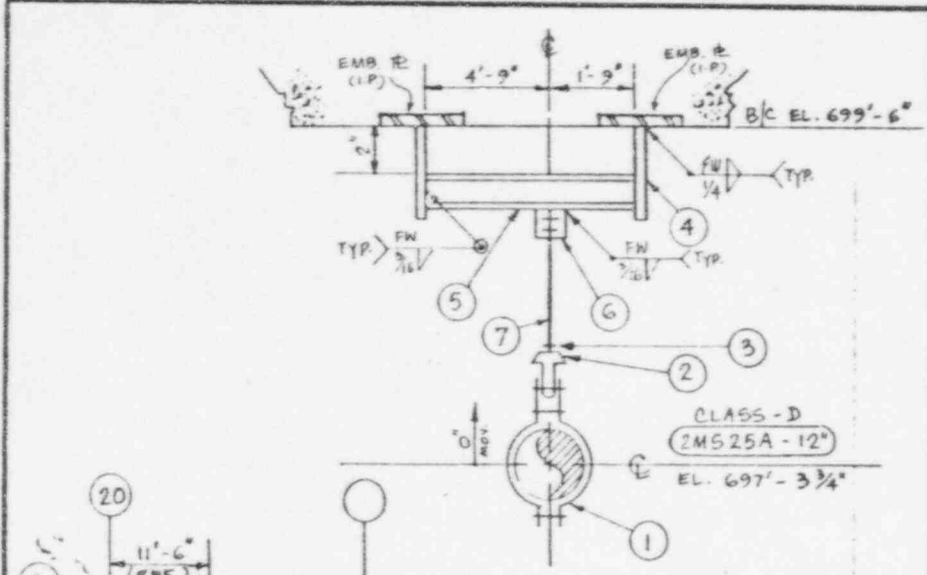

CLASS-D
 (2MS25A-12)
 EL. 697'-3 3/4"

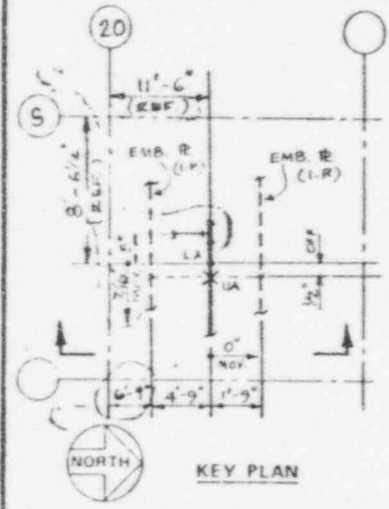


BILL OF MATERIAL

ITEM	QUAN	FIG. NO. OR PART NO.	DESCRIPTION	COMPONENT WEIGHT (LBS)
1			COMPONENT SUPPORT ASSEMBLY	
			CONSISTING OF :	
1	1	295	12" Ø DOUBLE BOLT PIPE CLAMP	22.3
2	1	290	1/2" WELDLESS EYE NUT	.6
3	3		1/2" HEX NUT	.2
4	2		3/4" X 5" C.S. R, 0'-7" LG.	14.9
5	1		W4 X13, 6'-5 1/4" LG.	83.7
6	1	66	1/2" WELDED BEAM ATTACHMENT	1.3
7	1	140	1/2" X Ø" ROD W/TFL	.4
1			BUNDLE & TAG	
			FC-49	
				123.4
				TOTAL WEIGHT

SERV. LEVEL	LOADS (LBS)	Fy
OPERATING	669	420
DESIGN (H)	721	248
EMERGENCY		
FAULTED (D)	767	522
HYDRO-TEST (T)		

WELD NO	WELD PROCEDURE	EXAMINATION PROCEDURE	LOADS (LBS)
			DESIGN OPERATING HYDRO TEST EMERGENCY FAULTED
			(SEE LOAD TABLE)

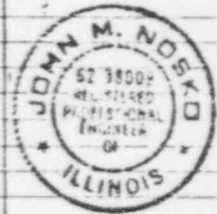

REVISED AS NOTED/REV. B

REFERENCE DRAWINGS	DWG NO	REV	DWG NO	REV	DWG NO	REV	DWG NO	REV
	M-900-22	K	M-1418-2	E	IE-2-3335	B		
	M-584	C	S-940	M				

REV	DATE REL'D	PREPARED	REVIEWED	APPROVED	FILM	END REVIEW
A	3-25-81	S.K. Guba / Rubeltran	N.M. ADRIAN / Rubeltran	V. Penacerrada		
B	8-27-81	W.H. Rubeltran	W.H. Rubeltran / J. Carter	V. Penacerrada		
C	9-15-82	Evgite	W.S. Carter D.C.	J.H. H. Koko		




PURPOSE: FOR RECORD & FILE FOR REANALYSIS (REV. C).



LA SALLE COUNTY STATION
 UNIT-2
 COMMONWEALTH EDISON COMPANY
 CHICAGO, ILLINOIS
 MAIN STEAM PIPING SYS.


NO SCALE PROJECT NO	DRAWING NO. REV
1667-00	M09 MS25-2839R C
SARGENT & LUNDY ENGINEERS CHICAGO	

REV. B DATED 2/10/82 AS RECEIVED FROM USGAS FILE E1-SAR-B-022

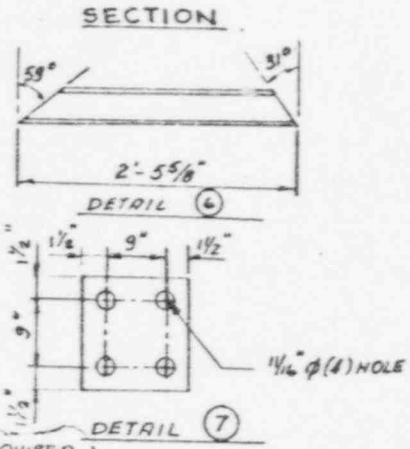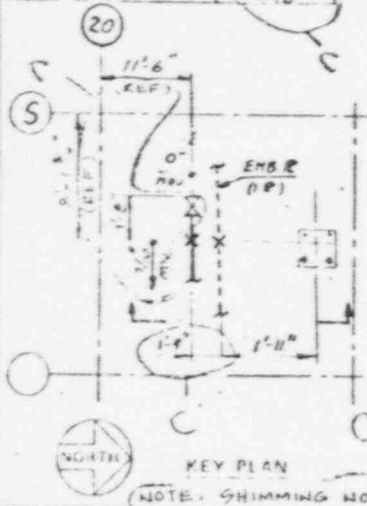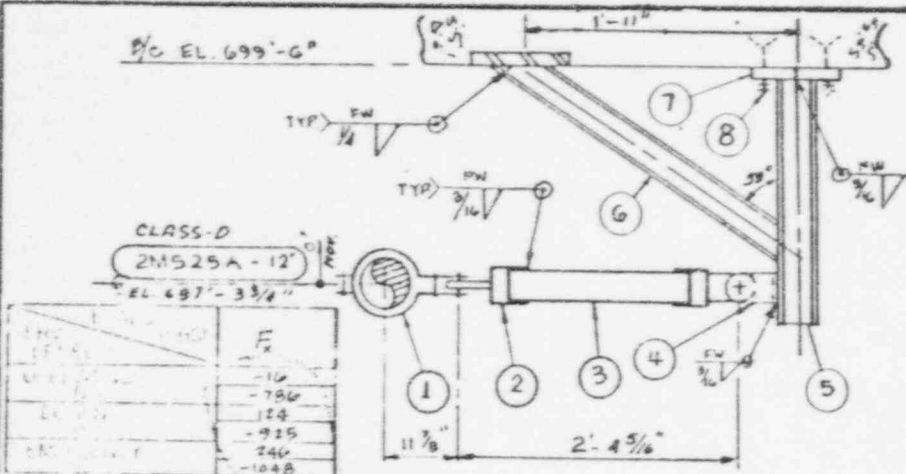

ITEM		QUAN	FIG NO OR PART NO	DESCRIPTION	REV	DATE	BY	CHKD	APP'D										
BILL OF MATERIAL																			
ONE COMPONENT SUPPORT ASSY CONSISTING OF:																			
1	1	8H-1271	12 3/4" OD	PIPE CLAMP															
2	2	1801513-02		ADAPTER ASSY PER PSA-1 *															
3	1	-	1"	SCH 80 EXT PIPE, 2'-0" LG															
4	1	1801558-03		REAR BRACKET PER PSA-1 *															
5	1	-	W4x13,	2'-3 1/2" LG															
6	1	-	W4x13,	2'-5 5/8" LG (PER DETAIL-6)															
7	1	-	1/2" x 12" C.S.R,	1'-0" LG (PER DETAIL-7)															
8	4	-	5/8" x 8 1/2"	HILTI KWIK BOLT															
* SUPPLIED BY BULK ORDER																			
1 BUNDLE & TAG FC-49																			
WELD NO.		WELD PROCEDURE			EXAMINATION PROCEDURE														
					<table border="1"> <tr> <td>DESIGN</td> <td>OPERATING</td> <td>HYDRO. TEST</td> <td>EMERGENCY</td> <td>FAULTED</td> </tr> <tr> <td></td> <td>SEE TABLE</td> <td></td> <td></td> <td></td> </tr> </table>					DESIGN	OPERATING	HYDRO. TEST	EMERGENCY	FAULTED		SEE TABLE			
DESIGN	OPERATING	HYDRO. TEST	EMERGENCY	FAULTED															
	SEE TABLE																		

COMPONENT WEIGHT (LBS)	REV	DATE	BY	CHKD	APP'D										
26.5															
20															
4.3															
11															
29.8															
32.1															
20.4															
3.5															
1197 TOTAL WEIGHT															
<table border="1"> <tr> <td>DESIGN</td> <td>OPERATING</td> <td>HYDRO. TEST</td> <td>EMERGENCY</td> <td>FAULTED</td> </tr> <tr> <td></td> <td>SEE TABLE</td> <td></td> <td></td> <td></td> </tr> </table>						DESIGN	OPERATING	HYDRO. TEST	EMERGENCY	FAULTED		SEE TABLE			
DESIGN	OPERATING	HYDRO. TEST	EMERGENCY	FAULTED											
	SEE TABLE														
REVISED AS NOTED/REV. B															

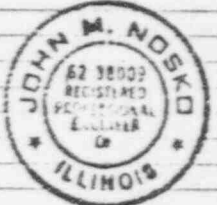

REFERENCE	REV	DATE	BY	CHKD	APP'D	
M-907	0122		M-141B	SH 2	E 1E-2-9335	B
M-584	C	5-940	M			

REV	DATE	PREPARED	REVIEWED	APPROVED	FILM	EMD REVIEW
A	3-25-81	G. O. ...	H. ...	H. ...		
B	8-27-81	H. ...	M. ...	H. ...		
C	9-15-82	Z. ...	N. ...	H. ...		✓

PURPOSE FOR RECORD & FILE PER KEANALY414 (REV. C)

SEE CLD-6026 FOR D. SPEC. J-2530.

EMD REVIEW




SUPPORT CLASS D

LA SALLE COUNTY STATION
UNIT -2
COMMONWEALTH EDISON COMPANY
CHICAGO, ILLINOIS

MAIN STEAM PIPING SYS.

NO. SCALE PROJECT NO.	DRAWING NO.	REV.
4267-00	MS25-2837X	C
SARGENT LUDDY ENGINEERS CHICAGO		
836A	SHEET 1 OF 1	

REV. B DATED 8-27-81
 AS RECEIVED FROM QUAD
 SUBSYS 2413-56
 PER 81-SAR-B-012

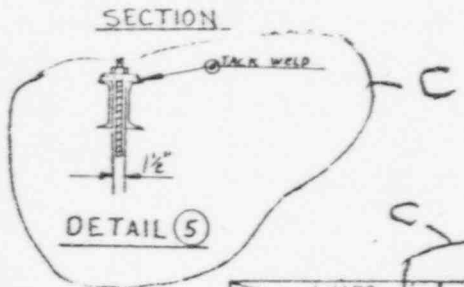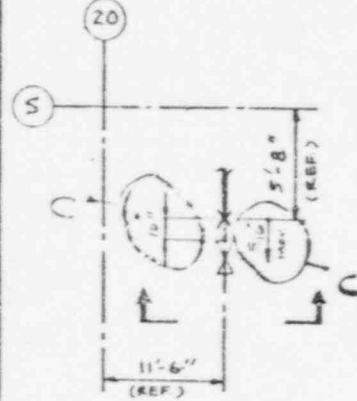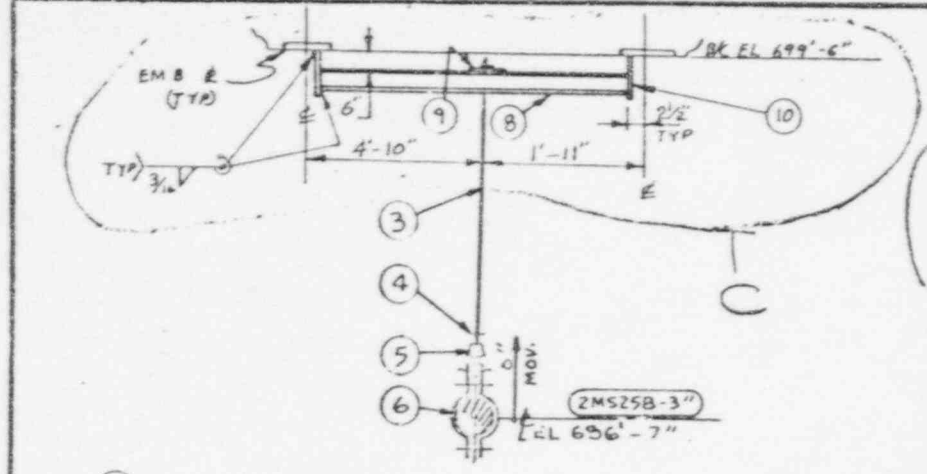

SERV. LEVEL	LOADS (LBS)	Fy
	(A)	
OPERATING (A)		691
DESIGN (A)		721
EMERGENCY (A)		-
FAULTED (E)		748

BILL OF MATERIAL

ITEM	QUAN	FIG NO OR PART NO	DESCRIPTION	COMPONENT WT LBS
			RIGID HANGER ASSY CONSISTING	
1			DELETED	
2			DELETED	
3	1	140	(1) 1/2" X 2-2/16" W/6" TBE	1.5
4	3		1/2" HEX NUT	0.20
5	1	290	1/2" WELDLESS EYE NUT	0.6
6	1	295	3" Φ DOUBLE BOLT PIPE CLAMP	3.0
7			DELETED	
8	2		C4 X 5.4, 6'-4" LG	68.4
9	1	60	2" Ø WASHER R	1.1
10	2		1/2" X 6" CS. R 1'-0" LG	20.4
1			BUNDLE & TAG FC-49	



93.2 TOTAL WT
 REVISED AS NOTED/REV. B

REFERENCE DRAWINGS	DWG NO	REV	DWG NO	REV	DWG NO	REV	DWG NO	REV
	M-900-22	K	M-1418-2	E	IE-2-3335	B		
	M-584	C	S-940	M				

DATE HELD	PREPARED	REVIEWED	APPROVED	FILM
A 3-25-81	S. Carraway/W. P. K. H. [Signature]	J. [Signature]	J. [Signature]	
B 8-27-81	V. [Signature]	J. [Signature]	J. [Signature]	
C 9-15-82	P. [Signature]	D. S. [Signature]	J. [Signature]	

DESIGN	LOADS (LBS)			
	OPERATING	HYDRO TEST	EMERGENCY	FAULTED
SEE LOAD TABLE				

END REVIEW

VICTORY G. PENACERRA
 652 203432
 REGISTERED PROFESSIONAL ENGINEER
 OF ILLINOIS

SUPPORT CLASS D

LA SALLE COUNTY STATION
 UNIT-2
 COMMONWEALTH EDISON COMPANY
 CHICAGO, ILLINOIS

MAIN STEAM PIPING SYS.

NO SCALE PROJECT NO. 4267-00

SARGENT & LUNDY ENGINEERS CHICAGO


MO9 MS25-2832R

SHEET 1 OF 1

PURPOSE REVISED PER SP 4-T-1312 (REV C) & PER REANALYSIS.
 CED-6026 FOR D SPECS (J-2530)



ITEM NO.	FIG NO OR PART NO	DESCRIPTION	COMPONENT WT LBS
1	2	RIGID STRUT ASSY CONSISTING	20.4
2	1	1/2" x 12" C.S. R. 1'-0" LG. (PER DET. 1 SH. 2)	3.2
3	1	1/2" x 5 1/2" MILTI KNIK - BOLTS	41.7
4	1	W 4 x 13 x 3'-2" LG	35
5	1	W 4 x 13 x 2'-7 1/2" LG (PER DET. 4 SH. 2)	0.4
6	1	PSA-1/4 REAR BRACKET *	1.7
7	1	PSA-1/4 ADAPTER ASSY *	3.5
8	1	3/4" SCH-XXS EXTENSION PIPE 1'-5" LG	3.0
9	1	3/2" P.O.D. PIPE CLAMP	

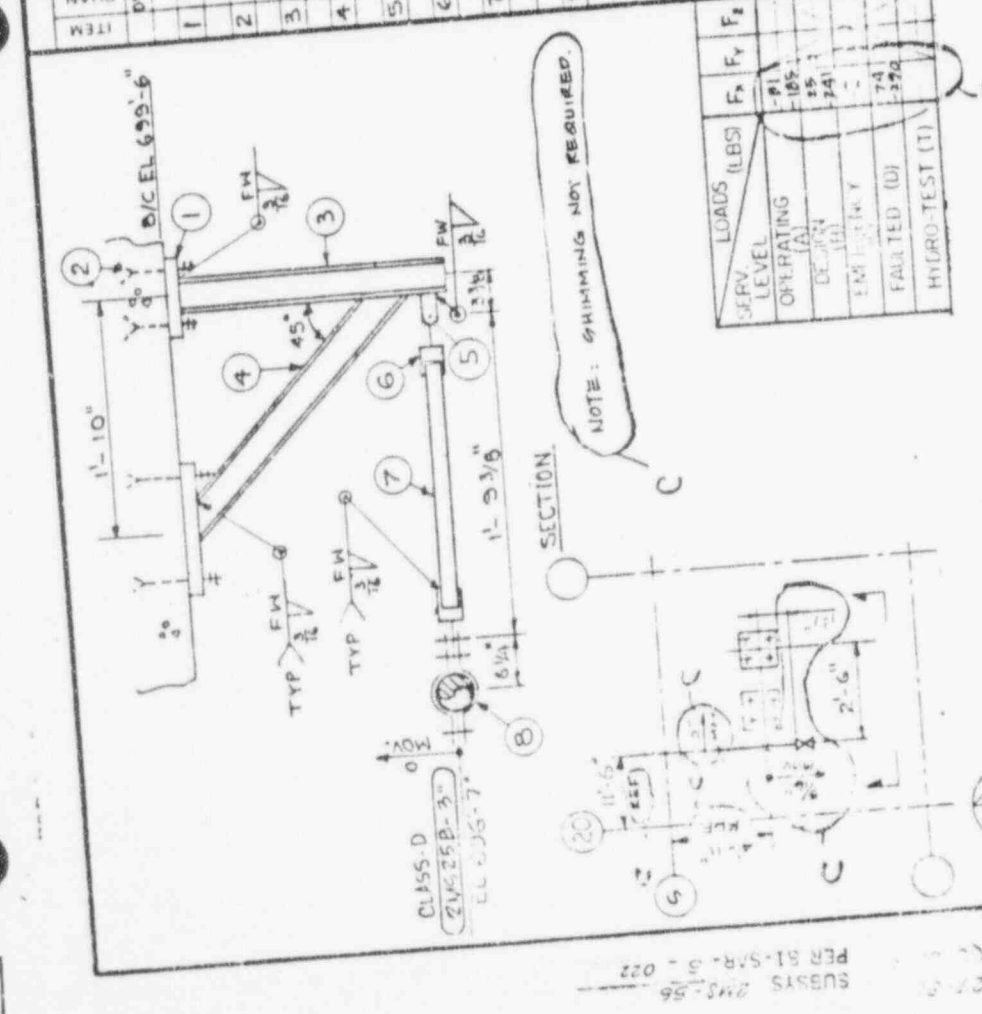

WELD NO.	WELD PROCEDURE	EXAMINATION PROCEDURE	LOADS (LBS)	OPERATING	HYDRO TEST	EMERGENCY	FAULTED
1	# SUPPLIED BY BULK ORDER						
1	BUNDLE & TAG FC-49						

REV	DATE	BY	DESCRIPTION
1	11-11-82	W. M. NOSTKE	DESIGN
2	11-11-82	W. M. NOSTKE	END REVIEW
3	11-11-82	W. M. NOSTKE	REVISION

LA SALLE COUNTY STATION
UNIT - 2
COMMONWEALTH EDISON COMPANY
CHICAGO, ILLINOIS





MAIN STEAM PIPING SYSTEM.
DRAWING NO. M09
PROJECT NO. 4267-00
NO SCALE

PROFESSIONAL ENGINEER OF ILLINOIS
SEE RECORD & FILE FOR REANALYSIS DATED 8-11-82 (REV C)

SEE CED-6026 FOR D SPEC (J-2930)
REANALYSIS (REV C)
PIPE CLASS

AS RECEIVED FROM QUANT...
SUBSYS 2MS-56
PER 81-SAR-6-02
REV 11-11-82
DATE 11-11-82
RECEIVED FROM...


RLV B - DATED 7-31-81
 AS RECEIVED FROM QUANT
 PER 81-SAR-B-022

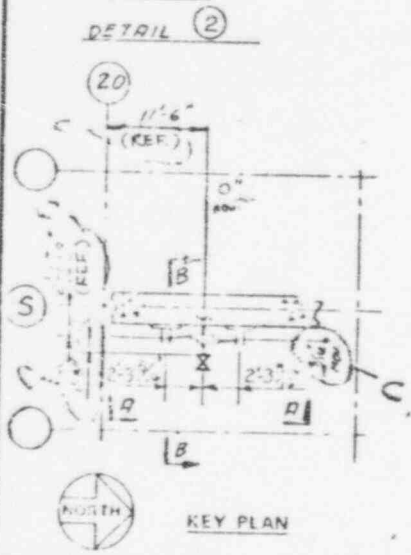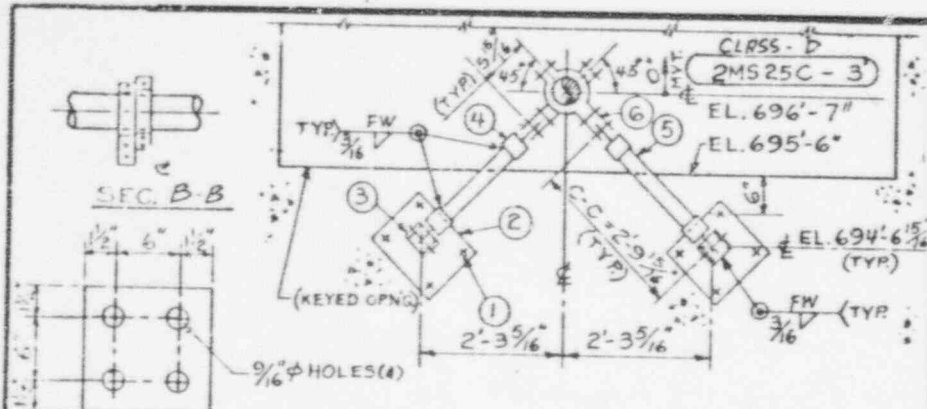

NOTE: GRIMMING NOT REQUIRED.

SERV. LEVEL	LOADS (LBS)	
	F _x	F _y
OPERATING (A)	267	27
DESIGN (B)	320	116
EMERGENCY (C)	-17	34
FAULTED (D)	411	122

BILL OF MATERIAL			COMPONENT WEIGHT (LB)
ITEM	QUAN.	FIG NO. OR PART NO	
1	—	COMPONENT SUPPORT ASSEMBLY CONSISTING OF	
1	8	1/2" x 1' HILTI KWIK-BOLT	3.9
2	2	1/2" x 9" x 9" C.S. PLATE, (PER DET. 2)	23.0
3	2	1801558-01 REAR BRACKET PER PSA - 1/2	0.8
4	4	1801512-01 ADAPTER ASSY. PER PSA - 1/2	3.3
5	2	3/4" SCH. XXS-PIPE EXTENSION, 2'-6" LG.	12.2
6	2	3M-1107 3 1/2" O.D. PIPE CLAMP	6.1
1	—	BUNDLE & TAG FC-49	
WELD NO.			EXAMINATION PROCEDURE
DESIGN			OPERATING
HYDRO TEST			EMERGENCY
FAULTED			
TOTAL WEIGHT			190

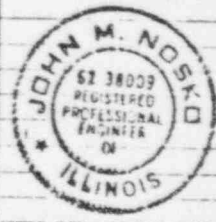

REFERENCE DRAWINGS	DWG NO	REV	DWG NO	REV	DWG NO	REV	DWG NO	REV
	M-900 SH-22	K	M-1418 SH-2	E	M-584	C	S-40	M
	IE-2-3335	B						

REV	DATE	PREPARED	REVIEWED	APPROVED
A	3-25-81	G. Quischo / Debra	N.M. Adipon / M.S. HONG	P. Penacera
B	7-31-81	G. Quischo / Alth	M. P. P. / W. H. H.	P. Penacera
C	9-15-82	E. J. G.	D. S. / W. H. H.	J. H. H.

PURPOSE FOR RECORD & FILE PER REANALYSIS (REV. C)
 110-6026 FOR D'S SPEC J-2530



LA SALLE COUNTY STATION
 UNIT - 2
 COMMONWEALTH EDISON COMPANY
 CHICAGO, ILLINOIS

MAIN STEAM PIPING SYSTEM


NO SCALE
 PROJECT NO. 4267 - (U)

SARGENT & LUNDY
 ENGINEERS
 CHICAGO

DRAWING NO. MS25-2834G
 SHEET 1 OF 1

REV. B - DATED 7-31-81
 AS RECEIVED FROM QUANT
 PER 81-SAR-B-022


REV A DATED 8-16-81
 AS RECEIVED FROM QUAD...
 PER 01-SAR-B-012

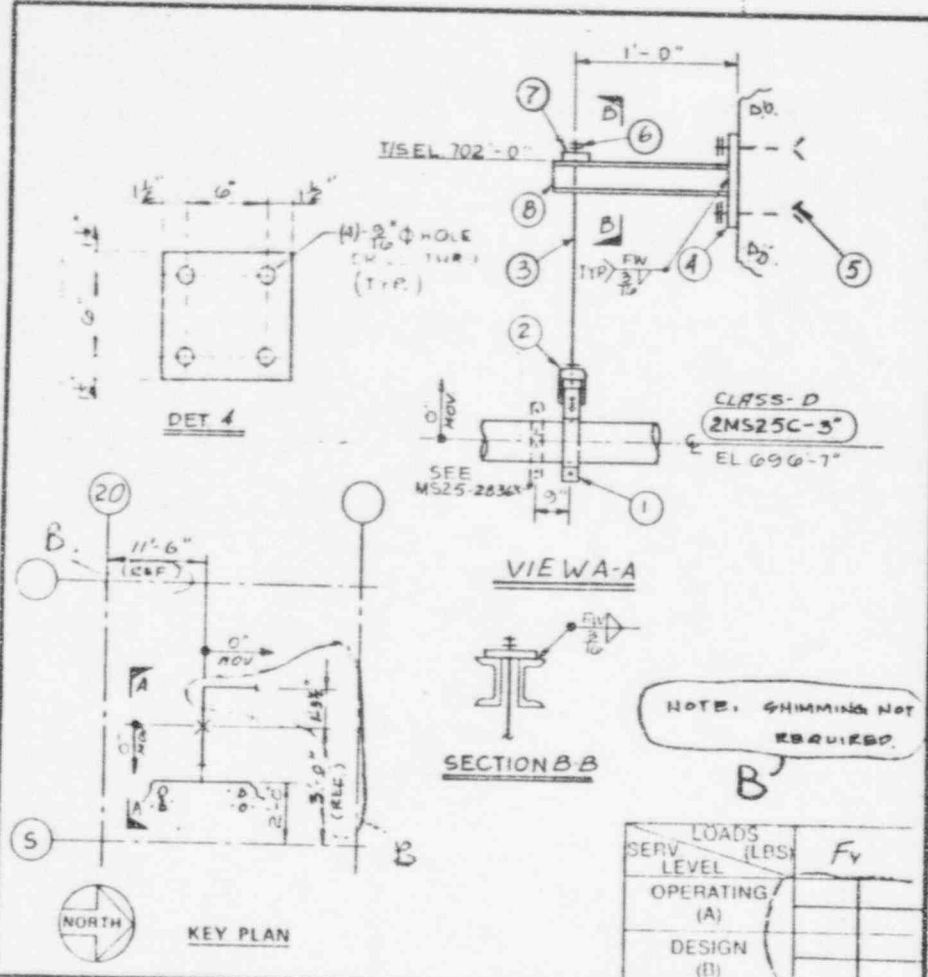

NOTE: GIMMING NOT REQUIRED.

SERV LEVEL	LOADS (LBS)	Fv
OPERATING (A)		
DESIGN (E)		

ITEM		QUAN		FIG NO OR PART NO	DESCRIPTION	PKS	CSS	PRIM	SEC	ALIC	COMPONENT WEIGHT (LB)
1 COMPONENT SUPPORT ASSEMBLY CONSISTING OF											
1	1	295			3"φ DOUBLE BOLT PIPE CLAMP						4.0
2	1	290			1/2"φ WELDLESS EYE NUT						1.0
3	1	140			1/2"φ 5'-0" LG. W/6" TBE						4.0
4	1				1"x9" C.S.R. 0'-9" LG (PER DET 4)						23.0
5	4				1/2"φ x 5 1/2" MILT. KNICK-BOLT						2.0
6	3				1/2" HEX NUT						1.0
7	1	60			1/2" STEEL WASHER R						1.0
8	2				C3x4.1, 1'-0 3/4" LG B-D-1 1/2"						9.0
1 BUNDLE & TAG FC-49											45.0
WELD NO. WELD PROCEDURE EXAMINATION PROCEDURE											TOTAL WEIGHT
DESIGN OPERATING HYDRO TEST EMERGENCY FAULTED											187/-136

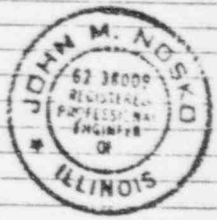

REFERENCE DRAWINGS	DWG NO	REV	DWG NO	REV	DWG NO	REV	DWG NO	REV
	M-900	22	J	S-940	M	1E-2-3355		

REV	DATE	REL'D	PREPARED	REVIEWED	APPROVED	FILM
A	8-18-81		G. [Signature]	Phallamathu / J. MEI	[Signature]	
B	9-15-82		Z. [Signature]	N. S. [Signature]	[Signature]	

PURPOSE FOR RECORD & FILE PER
 ANALYSIS (REV. C)

CED 6026 FOR-D SPECS (J-253c)

EMD REVIEW

[Signature]

SUPPORT CLASS D

VICTORY G. PENACERRA
 REGISTERED PROFESSIONAL ENGINEER OF ILLINOIS

LA SALLE COUNTY STATION
 UNIT-2
 COMMONWEALTH EDISON COMPANY
 CHICAGO, ILLINOIS

MAIN STEAM PIPING SYSTEM


NO SCALE PROJECT NO. 4267 00

SARGENT & LUNDY ENGINEERS CHICAGO

662I


DRAWING NO. M09-MS25-2835E
 SHEET 1 OF 1

REV. B. DATE 7/1/81 AS RECEIVED FROM VU. PER 81-SAR-B-022

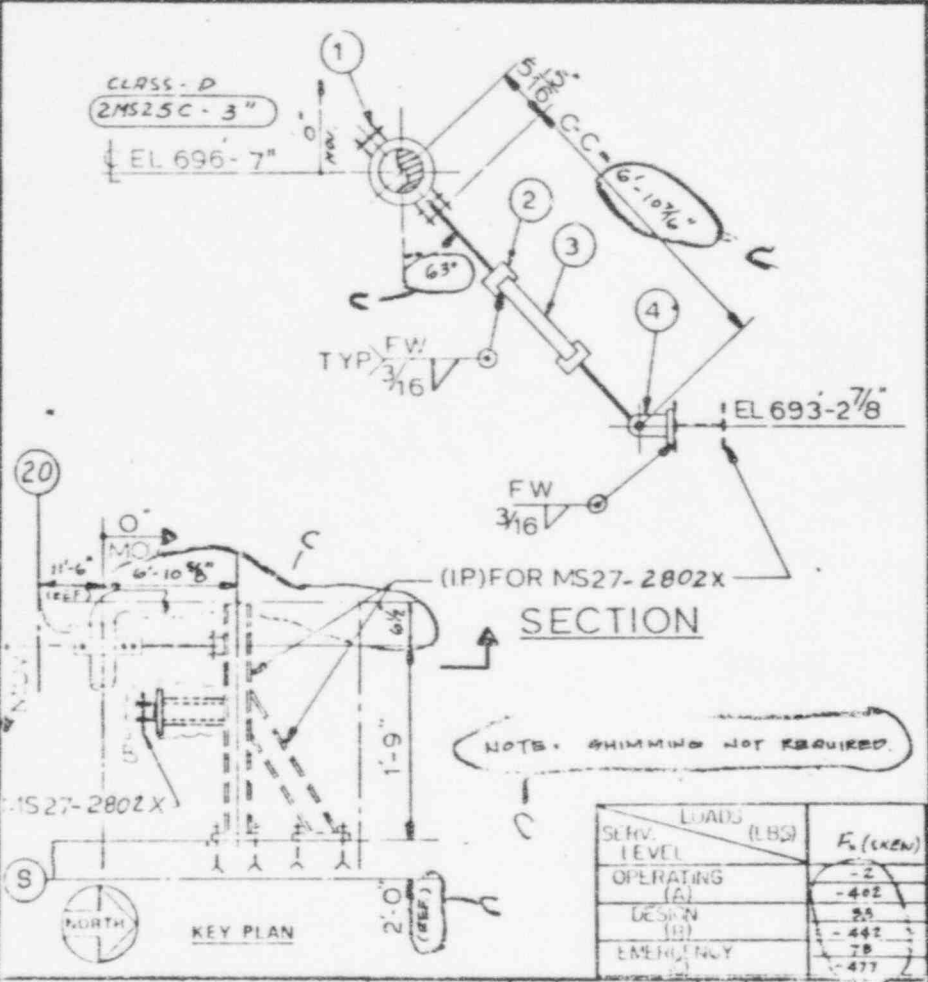

BILL OF MATERIAL				P&S	CBS	PRIM	SEC	AUG	COMPONENT WEIGHT (LB)
ITEM	QUAN	FIG NO OR PART NO	DESCRIPTION						
1			COMPONENT SUPPORT ASSEMBLY CONSISTING OF						
1	1	SA-913-1	3/2" OD PIPE CLAMP						6.1
2	2	101918-02	ADAPTER ASSY PER PSA (1) *						2.0
3	1		1" SCH 40 EXT PIPE 6'-6" LG						6.2
4	1	101958-01	REAR BRACKET PER PSA (1) *						10.91
									1.13
1			BUNDLE AND TAG FC-49						
									26.34

* SUPPLIED BY BULK ORDER

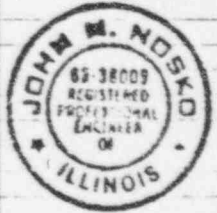

SEV. LEVEL	LOADS (LBS)	F ₁ (KWF)
OPERATING (A)		-2
DESIGN (B)		-402
EMERGENCY		25
		-442
		28
		-477

REFERENCE DRAWINGS	ENG NO	REV	DWG NO	REV	DWG NO	REV	DWG NO	REV
	M-900SH22	K	M-1418 SH.2	E	E-2-3335	B	M-854	C
	S-9.10	M						

NO	DATE REL	PREPARED	REVIEWED	APPROVED	FILE
A	3-25-81	J. G. Ziger / [Signature]	N. M. APONIC / [Signature]	[Signature]	
B	7-31-81	G. [Signature]	[Signature]	[Signature]	
C	9-15-82	[Signature]	H. S. Miller / DC	H. H. [Signature]	X

PURPOSE REVISED PER REANALYSIS (REV. C)

111-6026 FOR E&F, SPEC J-2530

REVIEW

[Signature]

SUPPORT CLASS D

LA SALLE COUNTY STATION
UNIT-2
COMMONWEALTH EDISON COMPANY
CHICAGO, ILLINOIS


MAIN STEAM PIPING SYSTEM

NO SCALE
PROJECT NO 42167-00

SARGENT & LUNDY
ENGINEERS
CHICAGO

DRAWING NO M09
MS25-2836X
SHEET 1 OF 1

835A

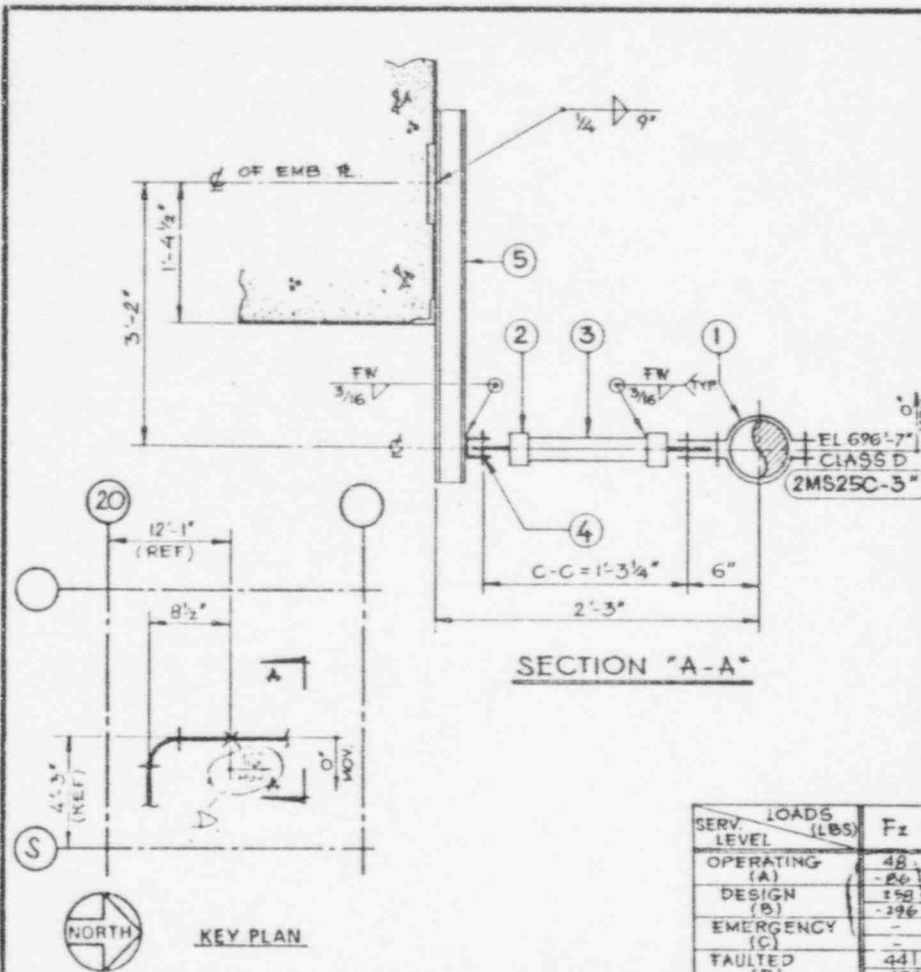

ITEM		FIG. NO. OR PART NO.	DESCRIPTION	COMPONENT WEIGHT (LB)
1			COMPONENT SUPPORT ASSEMBLY CONSISTING OF	
1	1	BHT-1407	3 1/2" O D PIPE CLAMP	30
2	2	180132-01	ADAPTER ASSY PER PSA - 1/4"	17
3	1	-	3/4" SCH XXS EXT PIPE, 1'-0" LG	30
4	1	180158-01	REAR BRACKET PER PSA - 1/4"	04
5	1	-	M4 x 13, 4'-2" LG	54.2
6	1		DELETED	
7	2		DELETED	
8	8		DELETED	
1		-	* SUPPLIED BY BULK ORDER BUNDLE & TAG FC-49	
				62.3
				TOTAL WEIGHT


SERV. LEVEL	LOADS (LBS)	Fz
OPERATING (A)	48	-26
DESIGN (B)	158	-296
EMERGENCY (C)	-	-
FAULTED (D)	44	-472

WELD NO.	WELD PROCEDURE	EXAMINATION PROCEDURE

REFERENCE DRAWINGS	DWG NO.	REV.	DWG NO.	REV.	DWG NO.	REV.	DWG NO.	REV.
	M-900 SH 22	K	M-1418 SH 2	E	IE-2-3335	B		
	S-940		M-584	C				

REV.	DATE REL'D	PREPARED	REVIEWED	APPROVED	FILM
C	4-15-82	<i>[Signature]</i>	<i>[Signature]</i>	<i>[Signature]</i>	X
D	9-15-82	<i>[Signature]</i>	<i>[Signature]</i>	<i>[Signature]</i>	X

END REVIEW
 D
 PIPE CLASS D

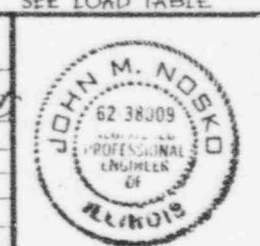



LA SALLE COUNTY STATION
 UNIT-2
 COMMONWEALTH EDISON COMPANY
 CHICAGO, ILLINOIS

MAIN STEAM PIPING SYSTEM

SUPPORT NO. M09
 MS25-2842 X

PURPOSE: FOR RECORD & FILE & PER REANALYSIS (REV D)

NO SCALE PROJECT NO 4267 00
 SARGENT & LUNDY ENGINEERS CHICAGO ILL.
 REV D

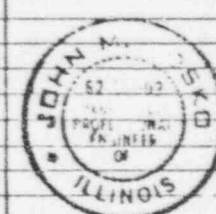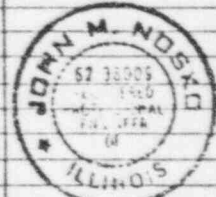

ITEM NO	FIG NO OR PART NO	DESCRIPTION	COMPONENT WEIGHT (LBS)
1	1	COMPONENT SUPPORT ASSEMBLY CONSISTING OF	59.0
1	1	W4 X 13.1 4'-6 1/2" LG.	1.0
2	1	1/2" WELDED BEAM ATTACHMENT	1.3
3	1	ROD ASSY. CONSISTING OF:	.8
1	140	1/2" X 3'-0" W/ TFL	.2
1	140	1/2" X 1'-3" W/ TFL	.2
1	135	1/2" STEEL ROD COUPLING	.6
4	4	1/2" HEX NUT	3.0
5	290	1/2" WELDLESS EYE NUT	91.7
6	295	3" DOUBLE BOLT PIPE CLAMP	17.4
7	7	3/4" X 12" X 1/2" C.S. PLATE, SEE DET. 7	31.9
8	8	3/4" X 10" HILTI KWIK BOLT	52.0
9	2	1 1/2" X 2" X 1/4" 5'-0" LG.	55.3
10	1	W4 X 13.1 4'-5 LG.	
11	1	W4 X 13.1 4'-5 LG.	
12	1	1/2" X 18" X 3/4" C.S. PLATE	
13	2	7 1/2" X 3" X 3/4" LONG	
14	1	BUNDLE S TANG	
15	1	FC-49	



LA SALLE COUNTY STATION
UNIT-2
COMMONWEALTH ENGINEER COMPANY
CHICAGO, ILLINOIS


MAIN STEAM PIPING SYS

DRAWING NO. 15111-DY
REV. MS25-
DATE 4-27-60

9724
ILLINOIS

VICTORY G. PENACERRADA
REGISTERED PROFESSIONAL ENGINEER
ILLINOIS

NO SCALE
PROJECT NO. 4267-00
SARGENT & LUNDY
D.F.V. NO. M09-
REV.

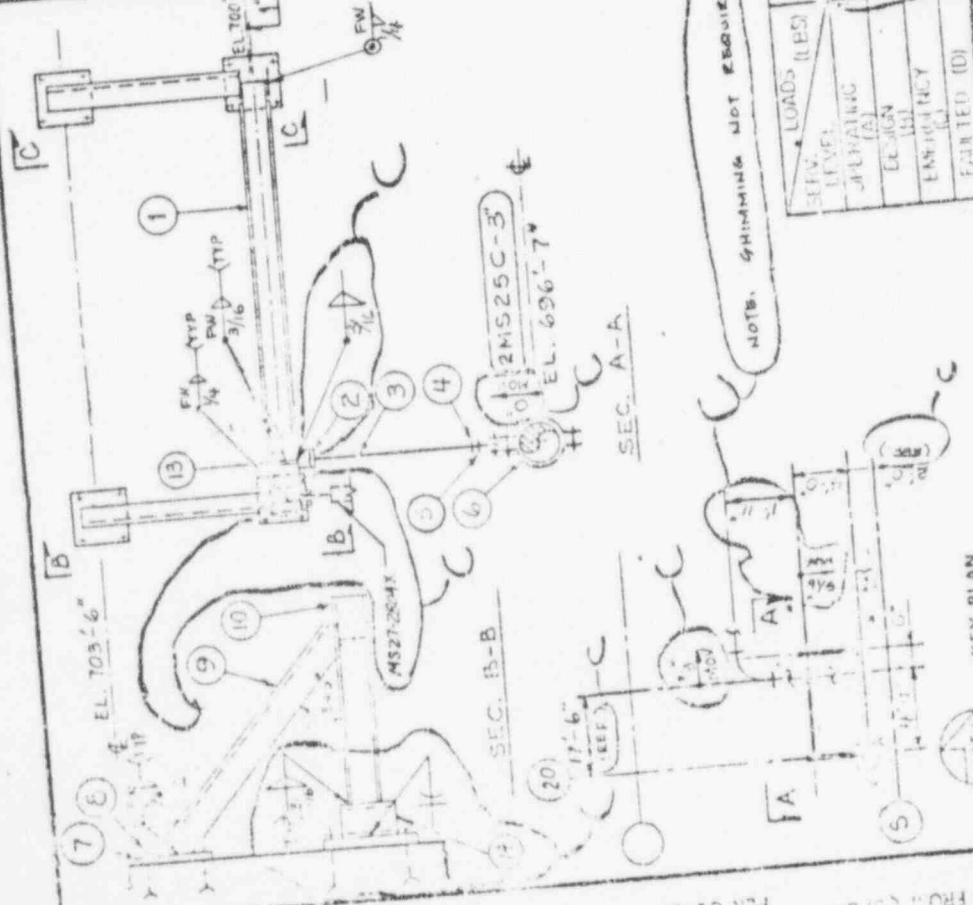

REV.	DATE	BY	CHKD.	APP.	DESCRIPTION
2MS	5-10-60	MP	1430	Y	PREPARED
A	5-25-61	MP	1416	2	REVISED
B	7-31-61	MP	925	M	REVISED
C	9-15-62	MP	584	M	REVISED

AS RECEIVED FROM QUADRIX
SUBSYS 2MS-50
FOR 81-SAR-9-022

AS RECEIVED FROM QUADRIX
SUBSYS 2MS-50
FOR 81-SAR-9-022

DATE 11-12-62

PURPOSE: REVISED PER SP # 7135-4 (REV.C)
PER REANALYSIS

6026 FOR 'D' SPEC J-2530
REANALYSIS 11324 (REV.C)
SUPPORT

6026 FOR 'D' SPEC J-2530
REANALYSIS 11324 (REV.C)
SUPPORT

LA SALLE COUNTY STATION
UNIT-2
COMMONWEALTH ENGINEER COMPANY
CHICAGO, ILLINOIS

MAIN STEAM PIPING SYSTEM


DRAWING NO. 15111-DY
REV. MS25-
DATE 4-27-60

9724
ILLINOIS

VICTORY G. PENACERRADA
REGISTERED PROFESSIONAL ENGINEER
ILLINOIS

NO SCALE
PROJECT NO. 4267-00
SARGENT & LUNDY
D.F.V. NO. M09-
REV.

RECEIVED FROM COMPANY
 DATE 10-1-79
 80355 RKS-5
 PER 81-SAR-B-022

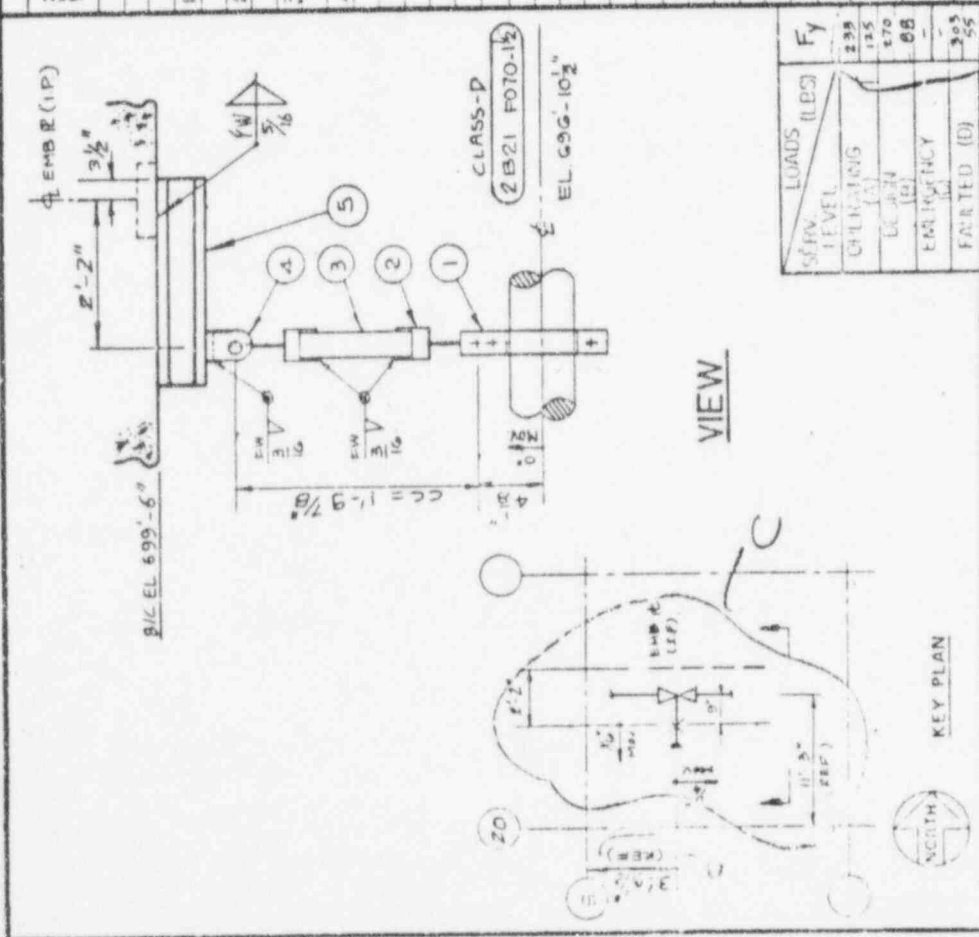

BILL OF MATERIAL			DESCRIPTION	COMPONENT SUPPORT ASSEMBLY CONSISTING OF:	COMPONENT WEIGHT (L.B.)
ITEM	QUAN	FIG NO OR PART NO			
1	1	CH1019	1 1/2" φ PIPE CLAMP	2.3	
2	2	1801212.01	PGA-1/4 ADAPTER ASSEMBLY	1.7	
3	1	---	3/4" SCH XKS EXT PIPE 1'-5" LG	3.5	
4	1	1801558.01	PSA-1/4 REAR BRACKET	0.4	
5	1	---	W4X13, 2'-8" LG	33.0	
* SUPPLIED BY BULK ORDER BUNDLE & TAG FC-49					



409
 REVISED AS NOTED/REV. B

	LA SALLE COUNTY STATION UNIT - 2 COMMONWEALTH EDISON COMPANY CHICAGO, ILLINOIS
MAIN STEAM PIPING SYSTEM NO SCALE PROJECT NO 4267-00	DRAWING NO 179E MOD MS25-2843X SHEET 1 OF 1

REV	DATE	BY	CHKD	APP'D	DESCRIPTION
A	3-25-81	E. Bunko	S. Bunko	P. Bunko	PREPARED
B	8-27-81	J. Geiger	J. Geiger	J. Geiger	REVISION
C	9-15-82	J. Geiger	J. Geiger	J. Geiger	REVISION



PURPOSE FOR RECORD & FILE PER REANALYSIS (REV. C)

2005 605 (X) DRAWING RELEASE RECORD EMD-007954 8-11-82


CEP-6026 FOR D 3 SPECS (J-2530)

AS RECEIVED FROM QUADREX PER 81-SAR-M-022

AS RECEIVED FROM QUADREX PER 81-SAR-M-022

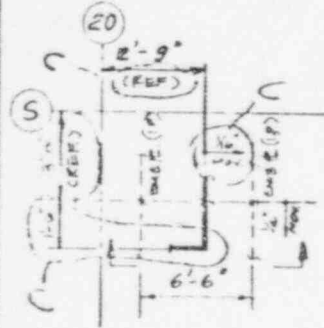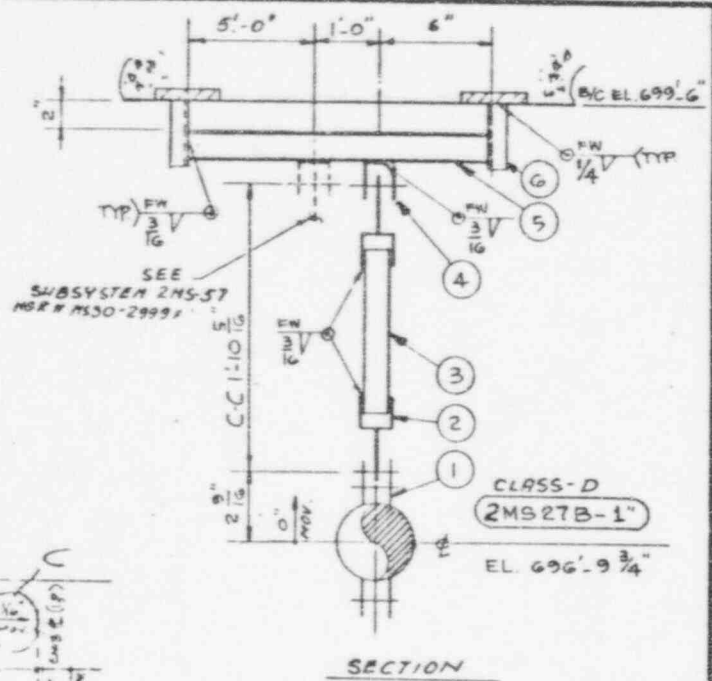

BILL OF MATERIAL				P&S	CSS	PRIM	SEC	ALC	COMPONENT WEIGHT (LB)	REMARKS	
ITEM	QUAN	FIG. NO OR PART NO.	DESCRIPTION								
1			COMPONENT SUPPORT ASSEMBLY CONSISTING OF:								
1	1	BH1292	1" ϕ PIPE CLAMP						.8		
2	2	1801312.01	PSA-1/4 ADAPTER ASSEMBLY *						1.7		
3	1	-	3/4" SCH. XXS EXT. PIPE, 1'-6" LG						37		
4	1	1801598.01	PSA-1/4 REAR BRACKET *						.4		
5	1	-	M4 X 130, 6'-6" LG.						84.5		
6	2	-	C4 X 5.4 X 6 1/2" LG.						59		
										97	TOTAL WEIGHT

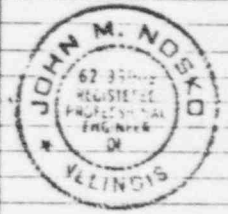

* SUPPLIED BY BULK ORDER BUNDLE & TAG FC-49

SERV. LEVEL	LOADS (LBS)	F _y
OPERATING (A)		
DESIGN (B)		
EMERGENCY (C)		

DESIGN	LOADS (LBS)			EMERGENCY	FAULTED
	OPERATING	HYDRO TEST	EMERGENCY		
697-B	46/14			897-2B	

REFERENCE DRAWINGS	DWG NO	REV	DWG NO	REV	DWG NO	REV	DWG NO	REV
	N-963 SH.43	E	M-1418 SH.2	E	IE-23335	B		
	4-584	C	S-940	M				

REV	DATE	BY	PREPARED	REVIEWED	APPROVED	FILM
A	3-25-81	G. Ouellet	G. Ouellet	T. K. M. M. M.	P. Penacerrada	
B	7-31-81	G. Ouellet	G. Ouellet	T. K. M. M. M.	P. Penacerrada	
C	9-15-82	G. Ouellet	G. Ouellet	N.S. Carter	J. H. H. H.	Rajesh Gupta




LA SALLE COUNTY STATION
UNIT - 2
COMMON-WEALTH EDISON COMPANY
CHICAGO, ILLINOIS

MAIN STEAM PIPING SYSTEM

NO SCALE PROJECT NO. 4267-00	SARGENT & LUNDY ENGINEERS CHICAGO	DRAWING NO. MS27-2800X	REV. C
		SHEET 1 OF 1	

PURPOSE FOR RECORD & FILE PER REANALYSIS (REV. C)
CED-6026 FOR "D" SPEC J-2530

REV. B, DATED 8-2-81, SUBSYS 2MS-56 AS RECEIVED FROM QUADREX PER 61-SAR-5-022

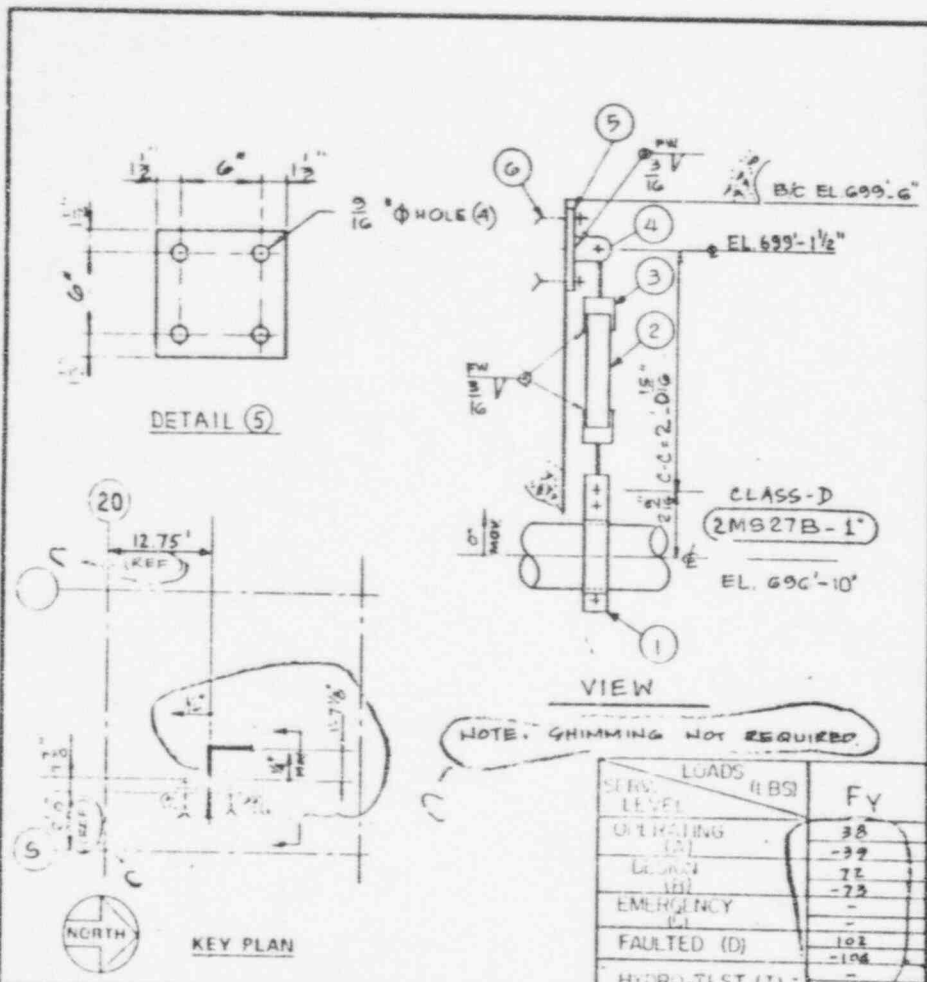


NOTE: GIMMING NOT REQUIRED.

SERV. LEVEL	LOADS (LBS)	FY
OPERATING	38	-39
EMERGENCY	72	-72
FAULTED (D)	102	-102
HYDRO-TEST (T)	102	-102

BILL OF MATERIAL

ITEM	QUAN	FIG NO. OR PART NO	DESCRIPTION	P&S	US	PRIM	SEC	ALIC	COMPONENT WEIGHT (LB.)	REMARKS
1			COMPONENT SUPPORT ASSEMBLY CONSISTING OF:							
1	1	BH1407	1" ϕ PIPE CLAMP						0.8	
2	1	-	3/4" SCH. XXS EXT PIPE 1' 5"						4.3	
3	2	1801212-01	PSA. 1/4 ADAPTER ASSEMBLY *						1.7	
4	1	180155B-01	PSA. 1/4 REAR BRACKET *						0.4	
5	1	-	1/2" x 9" C.G. ϕ , 0-9" LG. (PER DETAIL - 5)						9.1	
6	4	-	1/2" x 5 1/2" HILTI KWIK-BOLT						1.6	
										* SUPPLIED BY BULK ORDER
1			BUNDLE & TAG FC-4D							
									17.9	TOTAL WEIGHT
										REVISED AS NOTED/REV.B

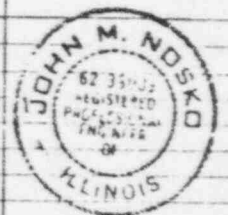

REFERENCE DRAWINGS	DWG NO	REV	DWG NO	REV	DWG NO	REV	DWG NO	REV
	M-966 (SH 43)	E	M-141B (SH-2)	E	M-584	C	S-940	M
	IE-2-3335							

REV	DATE	PREPARED	REVIEWED	EMD REVIEW
A	3-25-81	G. Lash / R. Johnson	H. Powell / M. Chang	Rajesh Gupta
B	8-27-81	J. Gauger / R. Johnson	H. Powell / M. Chang	Rajesh Gupta
C	9-15-82	Inv. G. Lash	J. S. Walker, P.E.	J. M. Nosko

PURPOSE: FOR RECORD & FILE PER CED-6026 FOR D SPECS (U-2530) REANALYSIS (REV. C).




LA SALLE COUNTY STATION
UNIT-2
COMMONWEALTH EDISON COMPANY
CHICAGO, ILLINOIS,
MAIN STEAM PIPING SYSTEM


NO SCALE
PROJECT NO: 4267-00
DRAWING NO. PLV: MS27-2801X
SHEET 1 OF 1

SARGENT & LUNDY
ENGINEERS
CHICAGO

REV. B DATED 7-11-82 AS RECEIVED FROM QUADREX

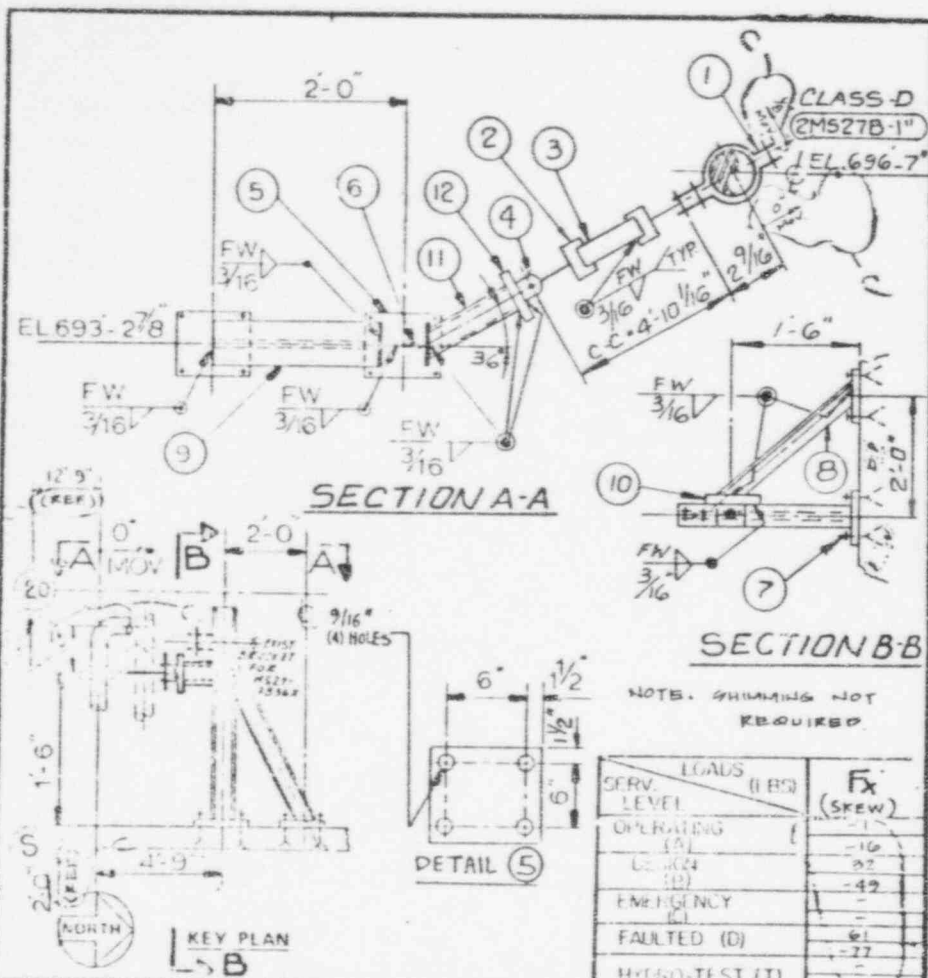

BILL OF MATERIAL				P&S	LCS	PART	SEC	AISC	COMPONENT WEIGHT (LB)
ITEM	QUAN	FIG NO OR PART NO	DESCRIPTION						
1			COMPONENT SUPPORT ASSEMBLY CONSISTING OF						
1	1	BH1407	1 3/8" OD PIPE CLAMP						8
2	2	18013120	ADAPTER ASSY PER PSA -1/4 *						17
3	1		3/4" SCH. 160 EXT PIPE 4'-5" LG.						86
4	1	18015580	REAR BRACKET PER PSA -1/4 *						04
5	3		1/2" x 9" x 9" CS PLATE (PER DET. 5)						34.4
6	1		W4 x 13 x 2'-2" LG						28.0
7	12		1/2" x 7" HILTI KWIK BOLT						5.5
8	1		2" x 2" x 3/8" ANGLE 2'-5" LG.						11.4
9	1		W4 x 13 x 2'-6" LG						32.5
10	1		3/8" x 5" x 5" CS PLATE						2.7
11	1		T.S. 2x2x1/4 1'-0" FIELD CUT TO SUIT						5.4
12	1		1/2" x 3" x 3" C.S. PLATE						1.3
			* SUPPLIED BY BULK ORDER.						
			BUNDLE AND TAG FC-49						
			WELD NO	WELD PROCEDURE	EXAMINATION PROCEDURE		132.7 TOTAL WEIGHT		
			LOADS (LBS)			Nuclear Services Corporation			
			DESIGN	OPERATING	HYDRO TEST	EMERGENCY	FAULTED	REVISED PER STRESS ANALYSIS/REV-B	
			SEE LOAD TABLE						

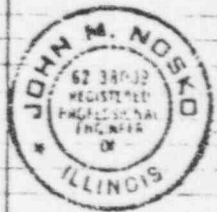

LOADS (LBS)	Fx (SKEW)
SERV. LEVEL	
OPERATING (A)	-16
EMERGENCY (B)	-42
FAULTED (D)	61
HYDRO-TEST (T)	-77

REV	DATE	REL D	PREPARED	REVIEWED	APPROVED	FILED
A	7-25-81		R. W. De / R. Debraun	A. P. Holm / A. K. Gwyn	V. P. Pascarella	
B	7-31-81		G. Quirk / A. Hoff	A. P. Holm / A. K. Gwyn	V. P. Pascarella	
C	9-15-82		See file	N. S. Guba D.C.	J. H. Hoko	X

EMD REVIEW

VICTORY G. PENACERADA
 062 0031132
 REGISTERED PROFESSIONAL ENGINEER
 OF ILLINOIS

SUPPORT CLASS D

LA SALLE COUNTY STATION
 UNIT-2
 COMMONWEALTH EDISON COMPANY
 CHICAGO, ILLINOIS

MAIN STEAM PIPING SYSTEM

NO SCALE
 PROJECT NO 4267-00

DRAWING NO. MS27-2802X
 SHEET 1 OF 1

SARGENT & LUNDY ENGINEERS CHICAGO


841A

110-6026 FOR "D" SPEC J-2530


PURPOSE FOR RECORD & FILE PER REANALYSIS (REV C)

REV B. WELD 8-27-81 AS RECEIVED FROM QUINCY

REV B. WELD 8-27-81 AS RECEIVED FROM QUINCY

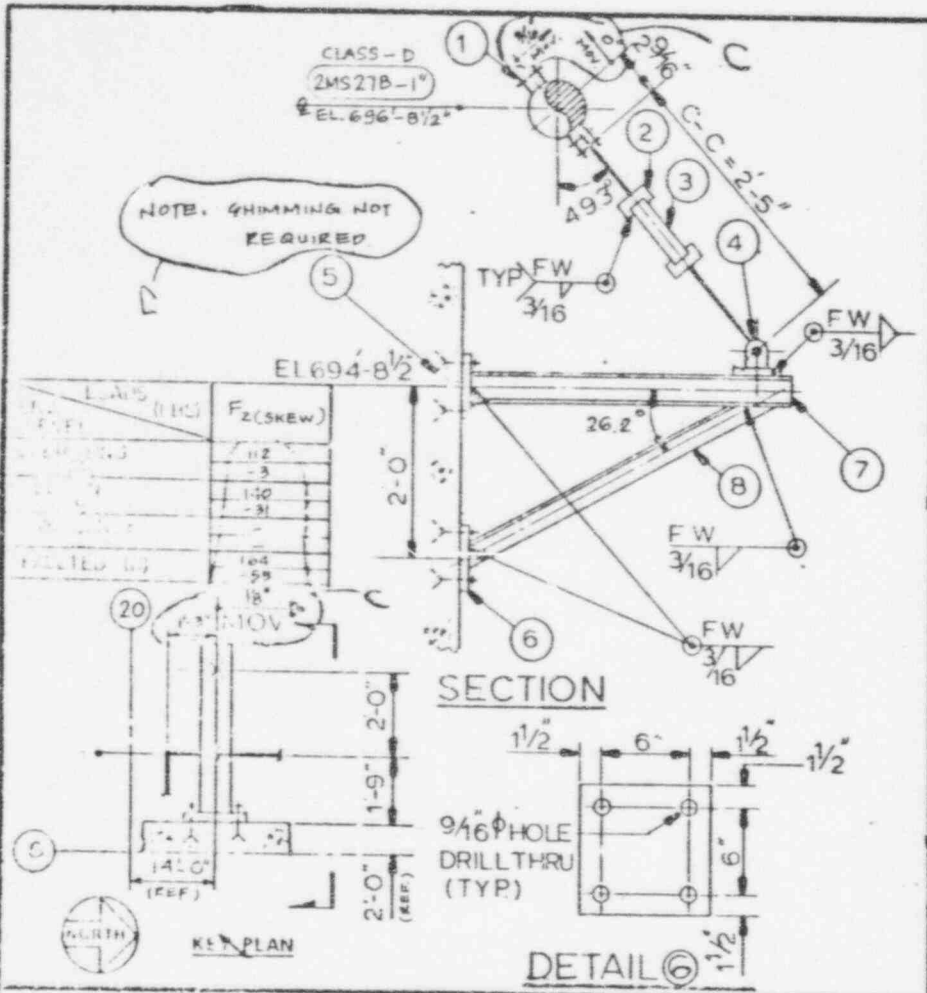

ITEM		QUAN	FIG. NO. OR PART NO	DESCRIPTION	COMPONENT WEIGHT (LB)
				COMPONENT SUPPORT ASSEMBLY CONSISTING OF:	
1	1	BH-1252	1 3/8 OD PIPE CLAMP		1.0
2	2	7801312 01	A DAPTER ASSY. PER PSA-1/4 *		2.0
3	1		3/4" SCH XXS EXT PIPE 2'-0" LG.		5.0
4	1	1801568 01	REAR BRACKET PER PSA-1/4 *		0.5
5	8		1/2" x 7" HILT-KWIK BOLTS		4.0
6	2		1/2" x 9" x 9" CS PLATE PER DET 6		23.0
7	1		W4 x 13 x 4'-0" LG		52.0
8	1		3 x 3 x 3/8 ANGLE 4'-6" LG		33.0
				* SUPPLIED BY BULK ORDER	
				BUNDLE AND TAG FC-49	120.5

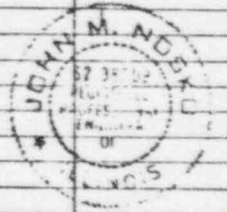

REV	DATE	REL'D	PREPARED	REVIEWED	APPROVED	FILM
A	3-25-81		M Wong / Diebitsch	W. J. D. / A. J. K. / R. J. C.	H. P. S. / R. P. S.	
B	8-27-81		J. Gauger / Diebitsch	M. Chang / T. K. / R. J. C.	H. P. S. / R. P. S.	
C	9-15-82		See file	N. S. / R. J. C.	H. P. S. / R. P. S.	

PURPOSE: FOR RECORD & FILE PER REANALYSIS (REV. C).

CLD-6026 FOR D SPEC5(J-2930)

DESIGN	OPERATING	HYDRO TEST	EMERGENCY	FAULTED
SEE	LOAD TABLE			

LOADS (LBS.)

WELD NO. WELD PROCEDURE EXAMINATION PROCEDURE

NO SCALE PROJECT NO 4267 00

SARGENT & LUNDY ENGINEERS CHICAGO

LA SALLE COUNTY STATION UNIT-2 COMMONWEALTH EDISON COMPANY CHICAGO, ILLINOIS

MAIN STEAM PIPING SYSTEM

DRAWING NO. MS27-2803X REV C


842 A SHEET 1 OF 1

VICTORY & PENACERRA REGISTERED PROFESSIONAL ENGINEER OF ILLINOIS

SUPPORT CLASS D


SUBSYS 2MS-56
PER 91-SAR-2-022

REV. B DATED 8-27-81
AS RECEIVED FROM QUADREX

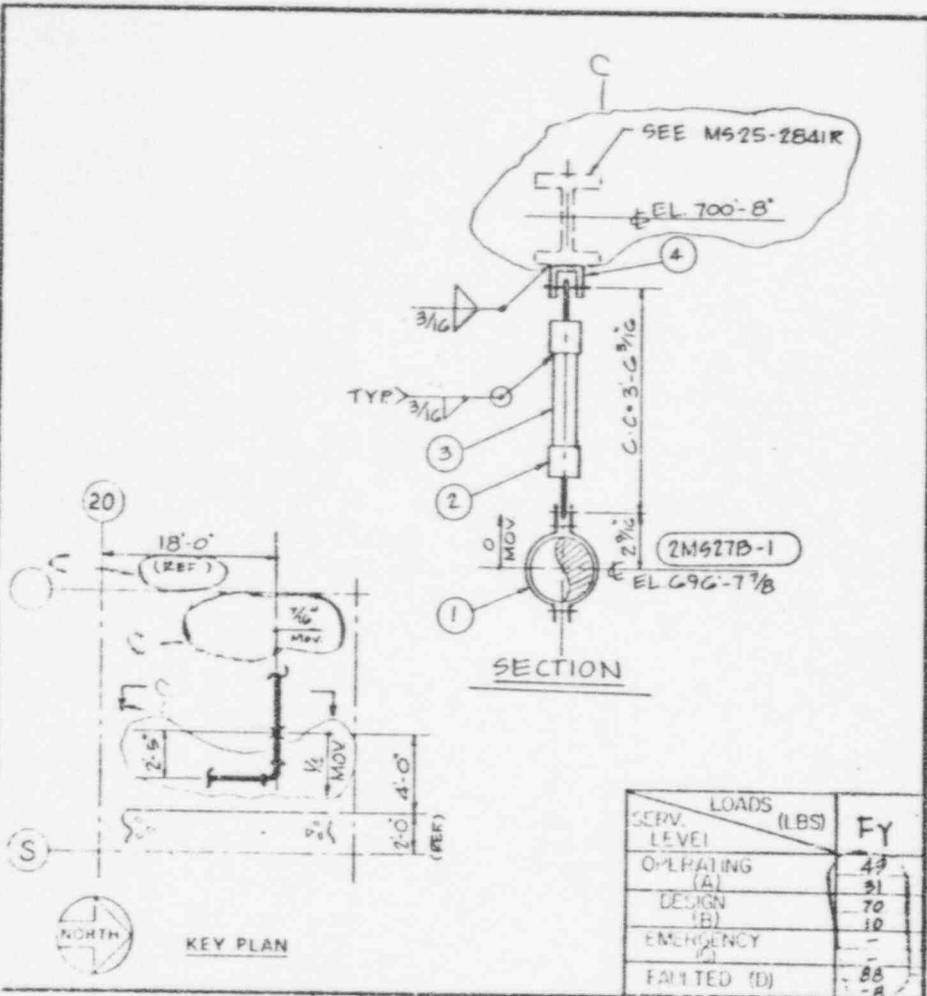

BILL OF MATERIAL				P&S	CSS	PRTY	S/C	ALC	COMPONENT WEIGHT (LB)
ITEM	QUAN	FIG NO. OR PART NO	DESCRIPTION						
1	1		COMPONENT SUPPORT ASSEMBLY CONSISTING OF						
1	1	BH1252	1 3/16" O.D. PIPE CLAMP						0.8
2	2	1801912-01	ADAPTER ASSY PER PSA-1/4 *						1.7
3	1		3/4" O SCH XXS EXT PIPE 3'-1" LG						5.9
4	1	1801558-01	REAR BRACKET PER PSA-1/4 *						0.4
1			BUNDLE & TAG FC-49						8.8

* SUPPLIED BY BULK ORDER

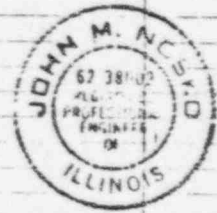

SEV. LEVEL	LOADS (LBS)	Fy
OPERATING (A)	49	31
DESIGN (B)	70	10
EMERGENCY (C)	-	-
FAULTED (D)	88	8

REF. DRAWING	DWG. NO	REV	DWG. NO	REV	DWG. NO	REV	DWG. NO	REV
M-906-43	E	M-1418-2	E	1E-2-3335	B			
M-584	C	S-929						

REV	DATE	BY	PREPARED	REVIEWED	APPROVED	FILM
A	3-25-81	Kielbaso/Siebert		A. Elftouh	V. Penacerrada	
B	8-27-81	J. Gager/Siebert		A. Elftouh	V. Penacerrada	
C	9-15-82	A.F. Lays		N.G. Colby	V. Penacerrada	

PURPOSE REV PER SP-10140 (REV C) & PER REANALYSIS (REV C)

1-6026 FOR "D" SPEC. J2530

EMD REVIEW

VICTORY G. PENACERRADA
687 004132
REGISTERED PROFESSIONAL ENGINEER OF ILLINOIS

SUPPORT CLASS 0

LA SALLE COUNTY STATION
UNIT-2
COMMONWEALTH EDISON COMPANY
CHICAGO ILLINOIS


MAIN STEAM PIPING SYSTEM.

NO SCALE
PROJECT NO. 4267 00

DRAWING NO. REV. M03 MS27-2801X C

SHEET 1 OF 1

847A

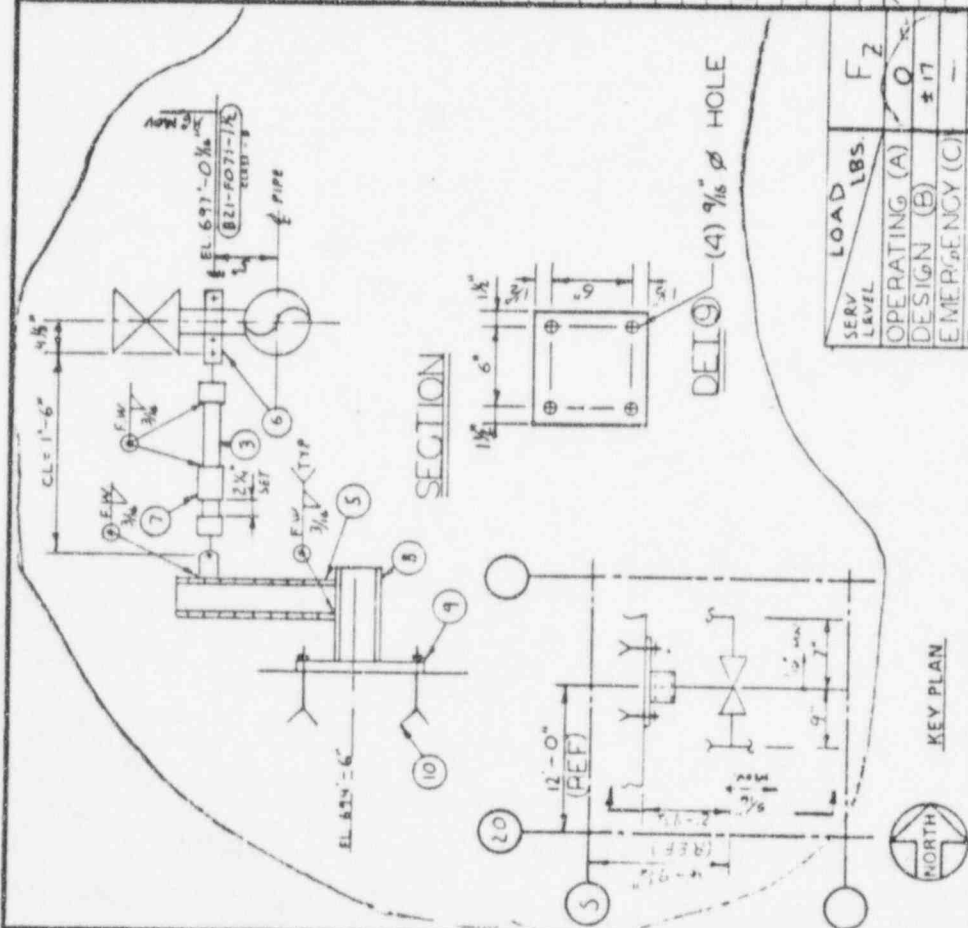

REV	DATE	REL'D	PREPARED	REVIEWED	APPROVED	FILM
C	9-15-82		J. L. G. B.			
DRAWING RELEASE RECORD EMP-987264 OUTPUT: 8-11-82						
2MS-56 NP-795 (2)						

LOAD	LBS	SERV LEVEL
OPERATING (A)	F2	
DESIGN (B)	Q	
EMERGENCY (C)	±17	
FAULTED (D)	±31	

REFERENCE DRAWINGS	DWG NO.	REV	DWG NO.	REV	DWG NO.	REV
M-766-43	E	M-1418-1	E	12-2-3335	B	
M-515	C	S-940	L	S-107	D	

PURPOSE REDRAWN & REVISED PER SPRT-1216 (REV L) & PER REBANALY-14

ITEM		QUAN	FIG. NO. OR PART NO	DESCRIPTION	COMPONENT SUPPORT ASSEMBLY CONSISTING OF	COMPONENT WEIGHT (LB.)	TOTAL WEIGHT	
3	1	—	—	3/4" SCH XXS EXT. PIPE O'-4 1/8" LG		0.96		
5	1	—	—	W4 X 13, 2'-6" LG		32.5		
6	1	—	BB-1407	2 3/4" O.D PIPE CLAMP		2.72		
7	1	—	1801104-05	MODEL PSA-1/4, MECH. SHOCK ARRESTOR W/		3.60		
8	1	—	1801574-05	TRANSITION TUBE KIT		1.44		
9	1	—	1801581-01	REAR BRACKET		0.42		
10	4	—	—	W4 X 13, 0'-10" LG		10.84		
* SUPPLIED BY BULN ORDER BUNDLE & TAB								
FC-49								
1/2" X 7" C.S. 4'-0'-9" LG PER DET. 7.							11.48	
1/2" X 7" LG HILTI-KWIK BOLT							1.78	
							65.66	

DESIGN	OPERATING	HYDRO TEST	EMERGENCY	FAULTED
SEE TABLE	SEE TABLE	SEE TABLE	SEE TABLE	SEE TABLE

EMD REVIEW

Richard Smith

LA SALLE COUNTY STATION UNIT - COMMONWEALTH EDISON COMPANY CHICAGO, ILLINOIS

NO SCALE PROJECT NO 4207 00

SUPPORT NO. 1 REV C

M09 MS27-2905

SARGENT & LUNDY ENGINEERS

JOHN M. NIOSKO REGISTERED PROFESSIONAL ENGINEER ILLINOIS

CFD-6026 FOR 'D' SPEC J-2530

001	Program Identification, File Assignments, Etc.	B-1 - E-1
	Basic Data Input	F-1 - K-1
	Input for Analyses	M-1 - N-1
	File Assignments for Analysis	B-2 - F-2
	PIPLOT Routine	G-2 - J-2
		K-2 - N-2
		B-3 - F-3
	Basic Data - Section C	G-3 - N-3
		3-4 - N-4
		B-5 - I-5
	Plot Generation - Section J	J-5 - N-5
		B-6 - N-6
		B-7 -
	Dead Weight Analysis - Section E	G-7 - N-7
		B-8 - N-8
		B-9 - N-9
		B-10 - G-10
	Hydro Test Analysis - Section G	H-10 - N-10
		B-11 - N-11
		B-12 - N-12
		B-13 - M-13
	Thermal Expansion Modes - Section D	N-13
		B-14 - N-14
		B-15 - N-15
		B-16 - M-16
002	Thermal Expansion Modes - Section D (Continued)	B-1 - N-1
		B-2 - N-2
		B-3 - N-3
		B-4 - 1-4
	OBEHALFPERCENT Seismic - Section F	K-4 - N-4
		B-5 - N-5
		B-6 - N-6
		B-7 - N-7
		B-8 - N-8
		B-9 - N-9
		B-10 - N-10
		B-11 - N-11
		B-12 - N-12
		B-13 - N-13
		B-14 - N-14
		B-15 - N-15
		B-16 - M-16

003 OBEHALFPERCENT SEISMIC - Section F

(Continued)

Class 2 - Design Basis Stress

Combined Reactions Design Basis

004

Combined Reactions-Design Basis Criteria
Section B

B-1 - N-1
B-2 - N-2
B-3 - N-3
B-4 - N-4
B-5 - N-5
B-6 - N-6
B-8 - N-8
B-9 - N-9
B-10 - N-10
B-11 - N-11
B-12 - N-12
B-13 - N-13
B-14 - J-14
K-14 - N-14
B-15 - H-15

I-15 - N-15
B-16 - M-16
R-1 - N-1
B-2 - N-2
B-3 - N-3
B-4 - N-6
B-5 - N-5
B-6 - D-6

E-6 - N-6
B-7 - N-7
B-8 - N-8
B-9 - N-9
B-10 - N-10
B-11 - N-11
B-12 - N-12
B-13 - J-13

OVERSIZE DOCUMENT PAGE PULLED

SEE APERTURE CARDS

NUMBER OF OVERSIZE PAGES FILMED ON APERTURE CARDS 10

9512280098

103

107

115

121

126

131

136

144

151

APERTURE CARD/HARD COPY AVAILABLE FROM

RECORDS AND REPORTS MANAGEMENT BRANCH