



101 California Street, Suite 1000, San Francisco, CA 94111-5894

415/397-5600

August 13, 1984
84056.020

Mr. J. B. George
Project General Manager
Texas Utilities Generating Company
Highway FM 201
Glen Rose, Texas 76043

Subject: Conduit Support Walkdown Questions
Comanche Peak Steam Electric Station
Independent Assessment Program - Phase 4
Texas Utilities Generating Company
Job No. 84056

Dear Mr. George:

Cygn conducted a walkdown of the various conduit supports to assure that the as-built condition properly reflects the designed support. Several discrepancies were discovered during the course of the walkdown. These discrepancies are listed in Attachment A. Please provide the information requested for each item.

If there are any questions, don't hesitate to call.

Very truly yours,

N. H. Williams
Project Manager

NHW:jm

cc: Mr. S. Burwell
Mr. S. Treby
Mr. D. Wade
Mr. G. Grace
Mrs. J. Ellis
Mr. R. Ballard

50-445/446

8409050148 840813
PDR ADOCK 05000445
A PDR

ADD. NSIC
Region 10
H001
1/1

ATTACHMENT A

CONDUIT WALKDOWN QUESTIONS

1. Support C12002935-4, Type CSM-6b (Reference drawing 2323-S-0910, sht CSM-6b)

Member P1001C3 is attached to a bridge beam which is specified as a Unistrut P1001 section in the above-referenced drawing. The installed section is a P5000 which is not indicated on any available documentation. Use of a P5000 section instead of a P1001 section will affect the support's load carrying capability since a P5000 has lower section properties.

Please provide Cygna with justification for using a P1001.

2. Conduit C12G02851 contains an S_3 offset of 2'-10". The allowable S_3 offset for a 1" diameter conduit per drawing 2323-S-0910, p. 6, sht 2, revision 8 is 2'-3". (See Cygna isometric sheet, attached).

Please provide Cygna with justification for allowing an offset dimension of $S_3 = 2'-10"$ for conduit C12G02851 which exceeds the allowable of $S_3 = 2'-3"$.

3. Conduit supports C12G02851-6 and C12002935-3 are type CA-5a supports. Cygna's walkdown noted that the conduit clamps were severely deformed in their installed position. As indicated by the attached sketch, even with the clamp deformation, expansion anchor nuts and washers were in full bearing against the clamp, indicating that the anchors were installed at angles to the perpendicular to the concrete surface.

Please provide Cygna with documentation which addresses the acceptability of deformed clamps as described above.

4. For support C11004359-1, type IN-CSM-15a, Cygna's walkdown noted the installed configuration appears as shown in the attached sketch. Due to an irregular concrete surface, the leg of the right angle is not flush against the tube steel section but is rotated such that the tip of the other leg is in bearing against the concrete.

The installed configuration impacts the functional capacity of the support in the following fashion:

- a. The bearing area required for proper load transfer at the support concrete interface may not exist which would result in concrete stresses greater than allowables.

Mr. J. B. George
84056.020

August 13, 1984
Page 2 of 2

ATTACHMENT A (Continued)

- b. With the angle rotated as shown, only one side of the Hilti expansion anchor is in bearing against the angle. Such a configuration results in the introduction of bending stresses within the bolt which have not been considered in the design.
- c. Due to the rotation of the angles, it would not be possible to place the groove welds between the tube and the angle as shown on the support drawing.

Please provide Cygna with justification for QC acceptance of the base angle installation for support C11004359-1.





Line #s

C13G 02851 (1"φ)
C13G 03528 (1 1/2"φ)

Conduit Support Walkdown Checklist

Handwritten: 7/12/24

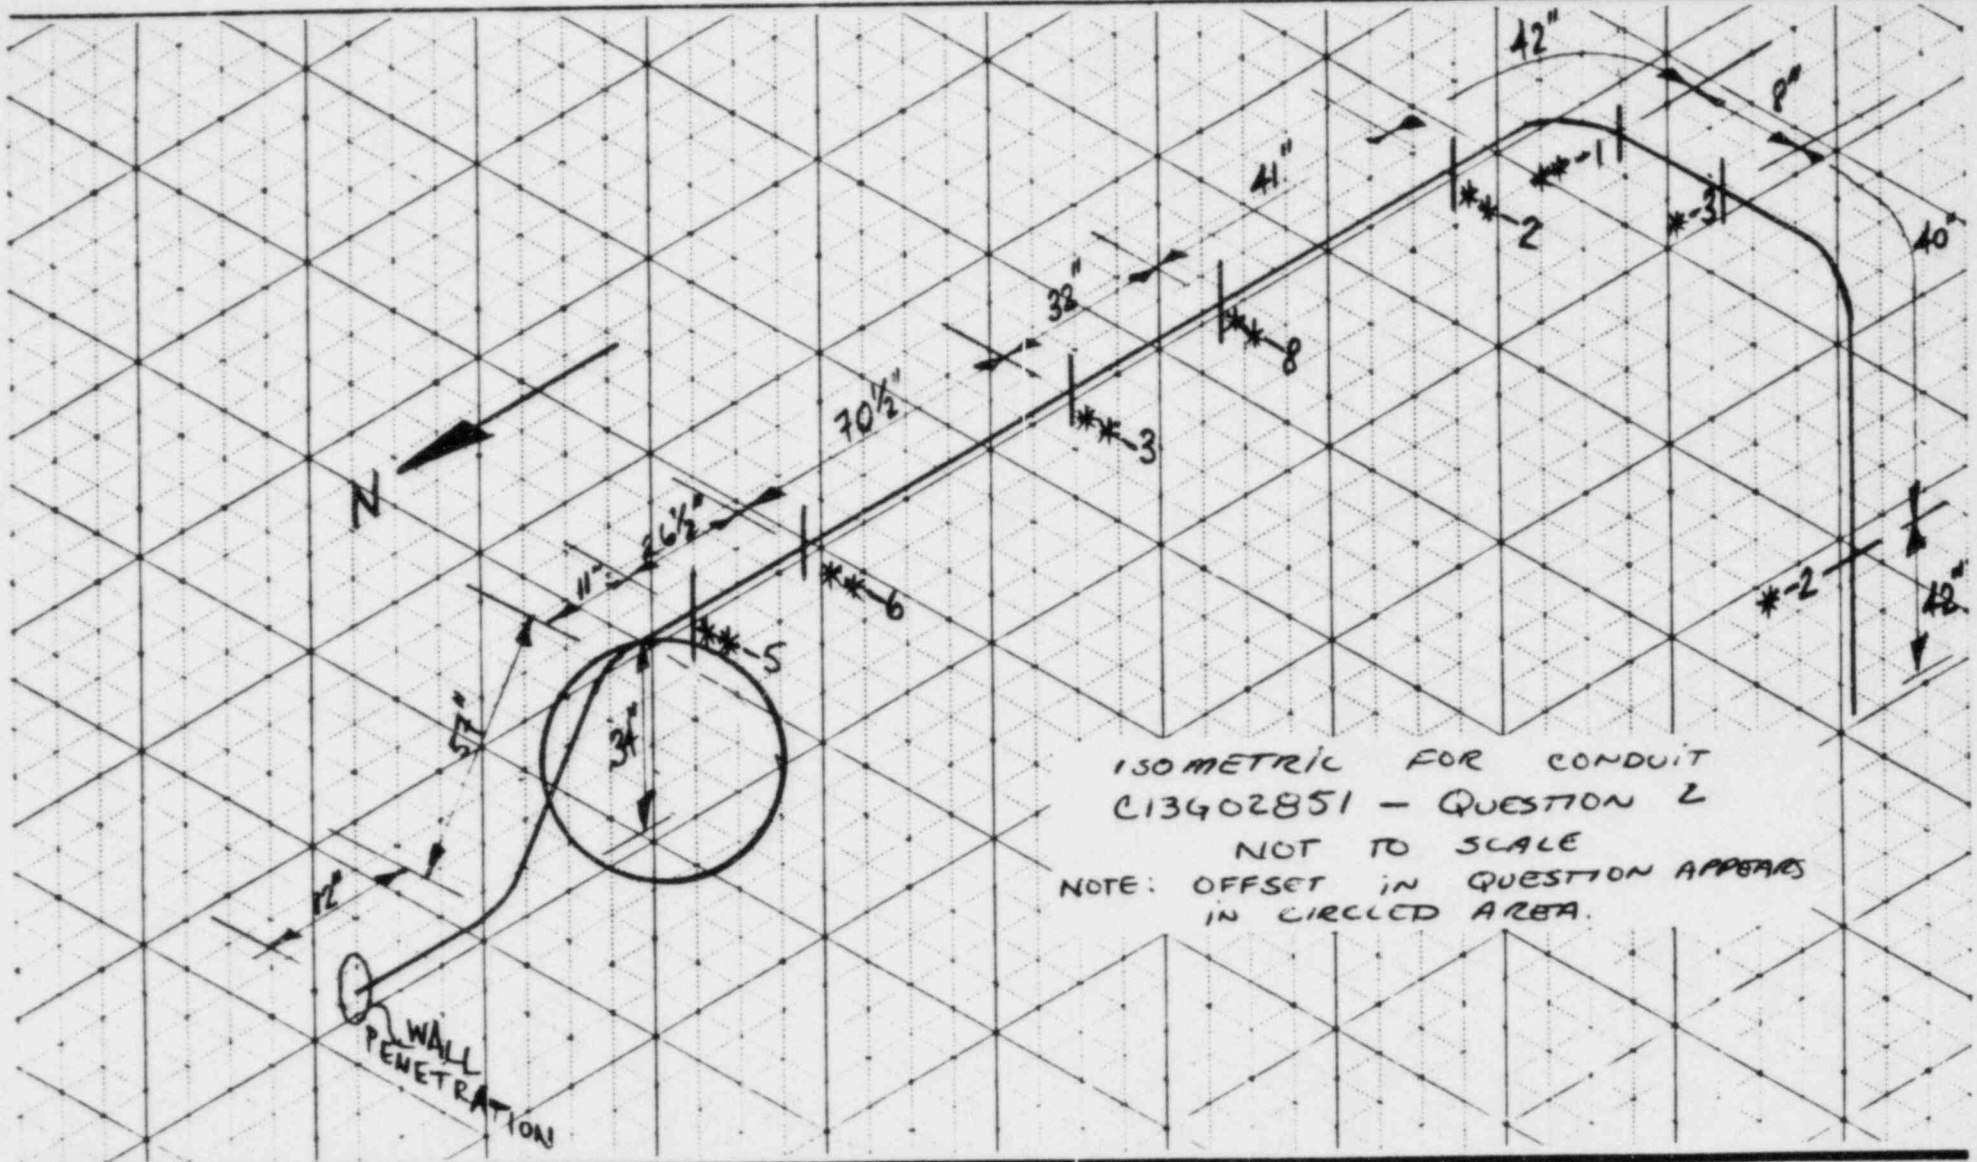


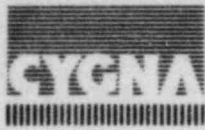

Calculation Sheet

Project	TEXAS UTILITIES - CPS&S IAP	Prepared By	J. P. R.	Date	13 AUG '84
Subject	CONDUIT WALKDOWN QUESTION 3	Checked By		Date	
System	SUPPORTS C12402851-6, C12402935-3	Job No.	84056	File No.	
Analysis No.		Rev. No.	0	Sheet No.	

HILTI NUTS & WASHERS
IN FULL CONTACT W/CLAMP

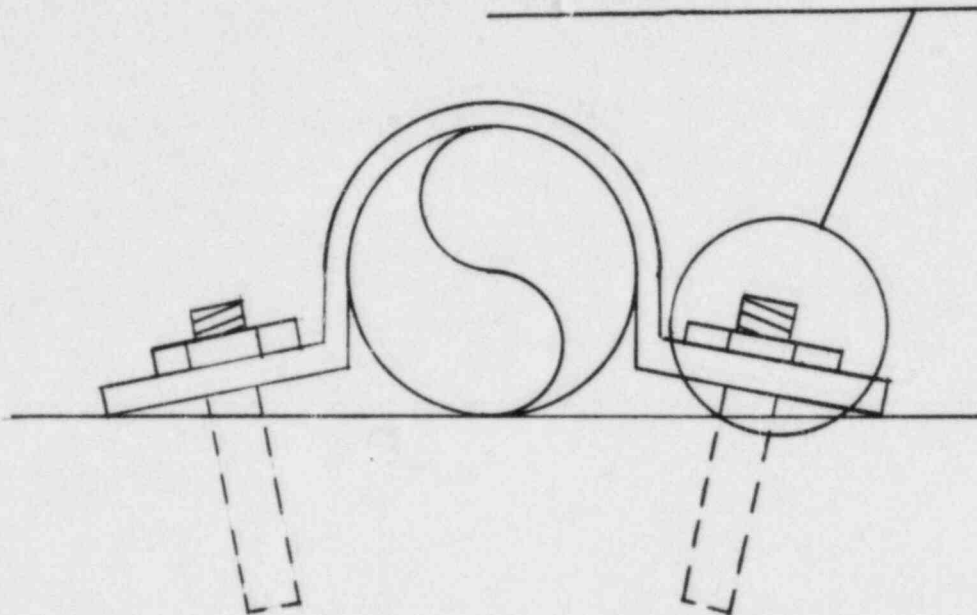


DEFORMED CONDUIT CLAMP
FOR CSD-5a TYPE
CONDUIT SUPPORT

(NOT TO SCALE)



Calculation Sheet

Project	TEXAS UTILITIES - CASE IAP	Prepared By	J.P.R.	Date	13 AUG 1984
Subject	CONDUIT WALKDOWN QUESTION 4	Checked By		Date	
System	SUPPORT C11 Ø 04359-1	Job No	84056	File No	
Analysis No		Rev. No	0	Sheet No	

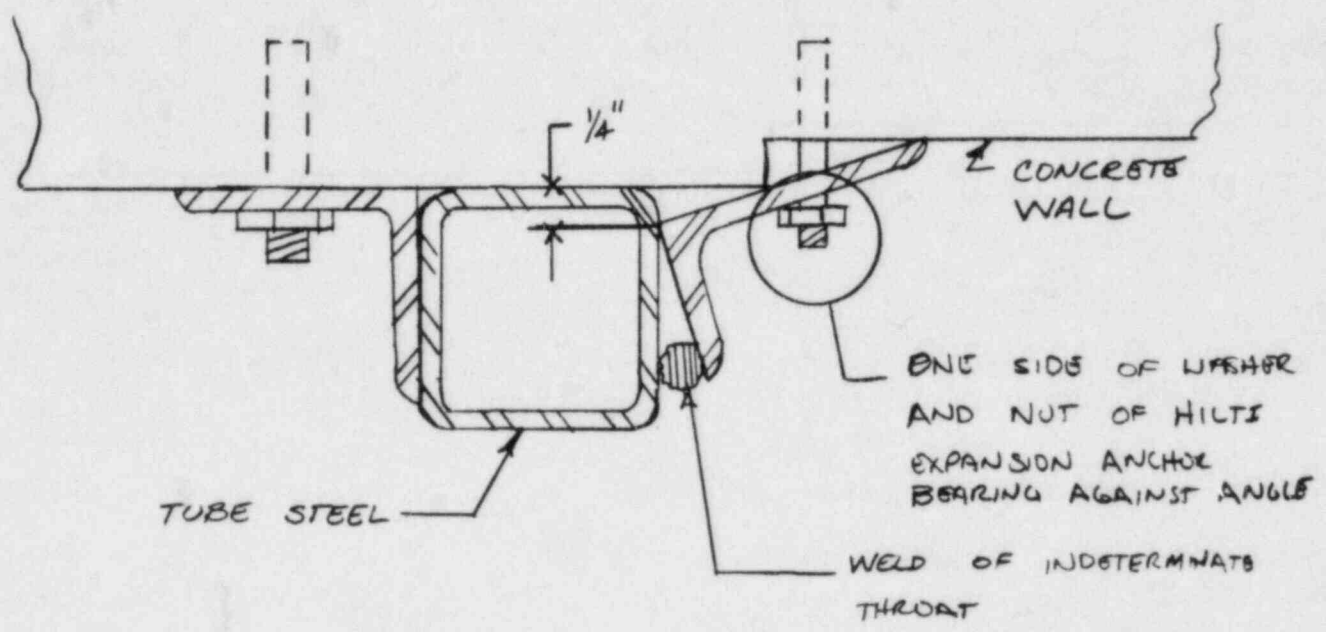

PLAN VIEW OF
SUPPORT C11 Ø 04359-1
TYPE IN-CSM-15u

(NOT TO SCALE)