



FIELD INSPECTION REPORT
RECORD COPY


APPL. EX. 87

3 RECORD CONTROL
CONTROL NO. C-418 493
FILE NO. _____

1 PROJECT NO. 8031 2 DATE 7/4/77 PAGE 1 OF 2

4 ITEM INSPECTED Reinspection of walls in question in Quality Control inspection plan C-418-116-W-1-1. Angles to columns fillet welds, beams 129A3 left hand end, near side to column 12302 beam 129A5 right hand end near side to column 12501 beam 129A1 right hand end near & far side to column 12502 beam 129A7 right hand end near side to column 12301 - 13" only remainder in concrete beam 134B2 left hand end near far side to column 12301 - 9" only on both sides remainder in concrete beam 129A11 right hand end, near far side to column 12102 - 14 1/2" only on that side remainder in concrete. (cont.)

5 LOCATION Edwards Elev 191'

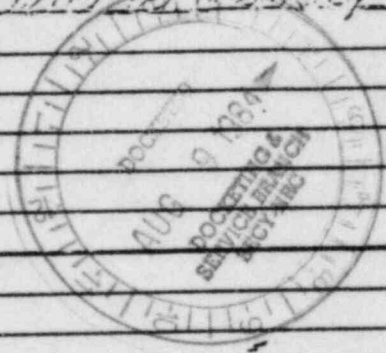

6 TYPE OF INSPECTION Visual & dimensional

7 STANDARD / CODE / PROCEDURE / DRAWING / SPECIFICATION AWS D11-72, R1-73, 92-74
OCT Inspection Plan C-418-116-W-1-1 C-418/5-1-1-1-4
Dwg. C-545/3

8 INSPECTION EQUIPMENT USED Fillet weld gage & wire brush

9. RESULTS OF INSPECTION: SATISFACTORY UNSATISFACTORY

10. ACTION TAKEN IF UNSATISFACTORY None - 2710

8411270389 840507
PDR ADOCK 05000352 PDR
9

NOTE: FOR INSPECTIONS PREVIOUSLY ACCOMPLISHED - AL-
SET DGG-1 REPORT # C-63-16 dated 1-1-76 S.O. Quinn
ALSO SEE REPORT # C-63-22 dated 4-5-77 7-23

Distribution
White - CC Files
Green - C-12 Files

Paul H. Turley
11. ENGINEER



CONTINUATION SHEET
RECORD COPY

3. RECORD CONTROL
CONTROL NO. 6414-25
FILE NO. _____
4. PAGE 2 OF 2

1. PROJECT NO. 8031 2. DATE 7/2/77

6. BLOCK CONT'D	5. FORM NO.	7. REPORT NAME
4	CC-01-1	Re-inspection of welds in Quality Control Plan-374-11
8. <u>and beam 1798b right hand end, near 6'6" side to column 10402,</u>		

NCR-1930

3.11 Edition
Online - CC Files
Date - Originator

re B. D. C. ^{7/2/77} ENGINEER Carl H. Lusk

RECORD COPY

FILED AT 103C4, 110C1
 FILED AT 103C1, 106C2
 FILED AT 109C2

TYPICAL BEAMS TO COL. WEBS.

Contd. No. C-411-493, & C-103-30
 File No. _____


(BOLTED CONNECTION)

BECHTEL DESIGN C-5423

AMERICK GENERATING STATION
 UNIT 1 & 2 CONTRACT 0001
 PHILADELPHIA ELECTRIC COMPANY
 RADWASTE BUILDING

DETAILS ON THIS DRAWING SHOW
 THE FINAL AS-BUILT STRUCTURAL
 STEEL, CERTIFIED TO BE CORRECT
 FOR MICROFILMING BY THE OWNER

Superior

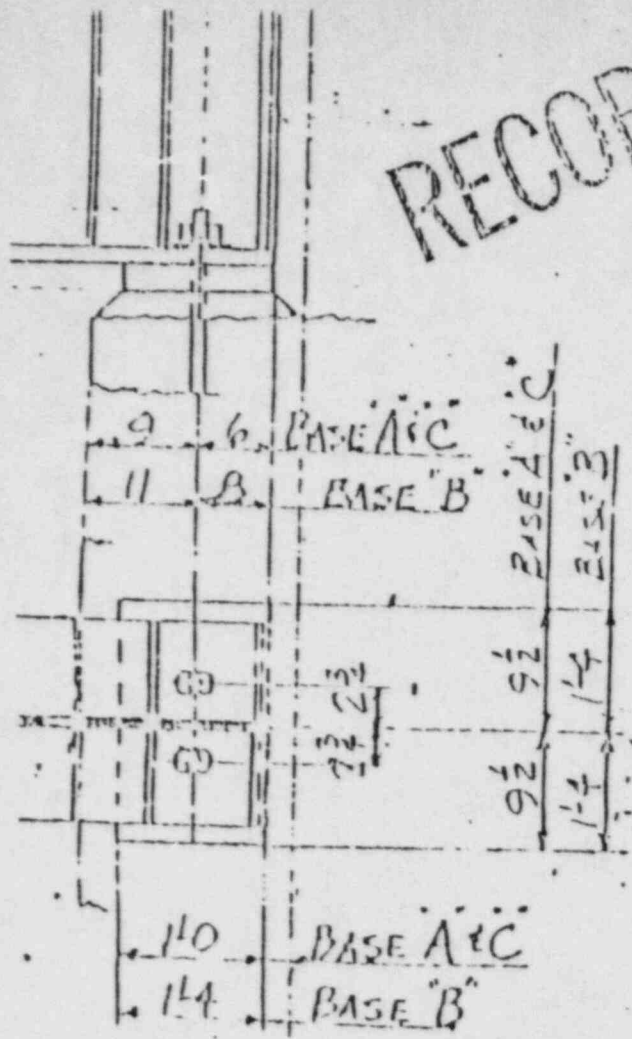

411-116-4



American Bridge
 Division of United States Steel Corporation

FABRICATION ASSIGNED TO ELMIRA
 DRAWING MADE BY AMBRIDGE
 MADE BY RJM DATE 11-15-73 CHECKED BY LJH DATE 1-24-74
 IN CHARGE OF G.H.R.

F		
E		
D		
C		
B	4/23/74	D
A	3-2-74	G
REVISIONS		

ORDER NO. K5944 SHEET NO. E3

SEE A B & C WALL BEARING BEAMS