

EDWIN I. HATCH NUCLEAR PLANT  
UNIT 1

CONTAINMENT LEAK RATE TEST PROGRAM

1903090183

Docket # 50-321  
Central # 7903090170  
Date 3/5/79 of Document:  
REGULATORY DOCKET FILE

TABLE OF CONTENTS

I. INTRODUCTION . . . . .	I-1
II. PROPOSED PLANT MODIFICATIONS . . . . .	II-1
III. PROGRAM DESCRIPTION. . . . .	III-1

## I. INTRODUCTION

Contained in this document is a reevaluation of the Plant Hatch Unit 1 Containment Leak Rate Test Program. The original program for Unit 1 was prepared with the intent of meeting the requirements of 10CFR50, Appendix J, "Reactor Containment Leakage Testing for Water Cooled Power Reactors", dated February 14, 1973. Since that time the Plant Hatch Unit 2 Containment Leak Rate Test Program has been reviewed and approved by the NRC. In order to maintain a continuity of test procedures and interpretation of 10CFR50, Appendix J between the two units, a rereview of the Unit 1 program was conducted. Each primary containment penetration on Unit 1 was compared to its similar penetration on Unit 2 and evaluated under the same guidelines used to develop the Unit 2 program.

## II. PROPOSED PLANT MODIFICATIONS

Leakage testing capabilities for each penetration were examined in the as-built condition. Several penetrations have primary containment isolation valves which are presently capable of being leakage rate tested only by pressurizing in a direction opposite to the primary containment pressure. However, their designs do not offer conservatism or justification for testing in the reverse direction. Also identified in the review was an additional penetration whose associated system piping cannot be considered a closed system unless a specific portion of connecting piping is removed. Therefore, modifications are required to enable leakage tests which are in compliance with the requirements of 10CFR50, Appendix J.

A detailed discussion for each of the affected penetrations is provided in this section including proposed plant modifications. It should be noted that the proposed modifications, when compared to Unit 2, were part of the Unit 2 initial design or were made to conform with the requirements of 10CFR50, Appendix J during the Unit 2 licensing process. Therefore, they are needed on Unit 1 to standardize the leakage testing program between the two units.

Penetrations Requiring Modification  
To Conform to 10CFR50, Appendix J

Penetration X25 - Vent Purge Supply:

Valve T48-F118A is a globe valve pressurized in the reverse direction during leakage testing. The valve cannot be conservatively tested in the reverse direction. A blocking valve and test connection installed as shown on Figure 1 will allow testing of valve T48-F118A in the proper direction. The modification shown in Figure 1 will also allow pressurizing of valves T48-F114 and T48-F322 in the correct direction. This arrangement is beneficial, although the two control valves may be conservatively tested as installed. This modification requires one 2" and one 3/4" ASME Section III Class 2 valves.

Penetration X26 - Vent Purge Return/H<sub>2</sub> & O<sub>2</sub> Analyzer:

This penetration has three control valves not conservatively tested in the reverse direction: T48-F335A and B, and P33-F002. As shown on Figure 2, T48-F335A and B can be tested in the correct direction by installing one blocking valve and a single valve test connection in the common line. P33-F002 has a blocking valve upstream and needs only the addition of a single valve test connection. Two 3/4" and one 2" ASME Section III Class 2 valves are required for these modifications.

Penetration X28A - Recirculation Sample

Valve B31-F019 is a globe valve that cannot be conservatively tested in the reverse direction. As shown on Figure 3, a blocking valve is presently installed but a test connection is required between B31-F019 and the blocking valve. Two 3/4" ASME Section III Class 1 valves are required for this modification.

Penetration X28F - H<sub>2</sub> & O<sub>2</sub> Analyzer:

P33-F003 is a control valve non-conservatively pressurized in the reverse direction. As shown on Figure 4, a blocking valve is presently installed, but a test connection is required between P33-F003 and the blocking valve. One 3/4" ASME Section III Class 2 valve is required for this modification.

Penetration X31F - Recirculation Pump Seal Water:

The present system design does not provide testing capabilities for check valves B31-F013A or B31-F017A. Test connections are required as shown in Figure 5. This modification requires four 3/4" ASME Section III Class 2 valves.

Penetration X45F - ILRT Verification Flow:

The inboard isolation globe valve, T23-F004, cannot be conservatively leakage rate tested by applying pressure in the reverse direction. T23-F004 can be tested in the correct direction by installing a flange on the pipe termination inside the drywell and testing through a blind flange with an installed test connection.

Penetration X46 - Demineralized Water:

The present system design has check valve P21-F372 installed between locked closed manual isolation valves P21-F406 and P21-F353. This arrangement results in the utilization of check valve P21-F372 as an isolation valve. The relative position of valves P21-F372 and P21-F353 should be interchanged and the test connection should be between P21-F353 and P21-F406 as shown in Figure 6. P21-F406 should be tested with pressure in the correct direction by pressurizing through a drywell hose connection. No additional valves are required for this modification.

Penetration X59A - Recirculation Pump Seal Water:

This penetration design is identical to X31F (see Figure 5). Testing capabilities are not provided for check valves B31-F013B or B31-F017A. Test connections are required as shown in Figure 5. This modification requires four 3/4" ASME Section III Class 2 valves.

Penetration X205 - Containment Purge and Inerting:

Globe isolation valve T48-F118B cannot be tested conservatively in the reverse direction. The modification shown in Figure 7 is similar to the one discussed for penetration X25.

Penetration X210 - Radwaste Connection:


The radwaste (G11) connection should be removed from Core Spray Loop B as shown in Figure 8. The G11 tie-in consists of quality group D piping and valves and does not meet the quality group B requirement for closed systems. Consequently, the Core Spray piping cannot be considered a closed system unless the G11 connection is removed. An identical situation existed on Unit 2 and was corrected by removing and capping the tie-in after it was determined that the line was not required. The same modification is required on Unit 1.

Penetration X217 - H<sub>2</sub> & O<sub>2</sub> Analyzer:


P33-F007 cannot be leakage tested in the correct direction and a reverse pressure test is not conservative. A blocking valve is part of the present system design. Therefore, an installed test connection will provide the required leakage testing capability for this valve (see Figure 9). This modification requires one 3/4" ASME Section III Class 2 valve.

Penetration X220 - Vent Purge Outlet/H<sub>2</sub> & O<sub>2</sub> Analyzer:

Valves T48-F333A/B are control valves that are utilized as primary containment isolation valves. The valves cannot be conservatively tested in the reverse direction and are not presently capable of being tested from the containment direction. The addition of a blocking valve and a test connection as shown in Figure 10 will enable acceptable leakage rate testing of these valves. Isolation valve P33-F006 has a blocking valve installed, but requires the installation of a test connection for leakage rate testing. This modification requires one 2" and two 3/4" ASME Section III, Class 2 valves.

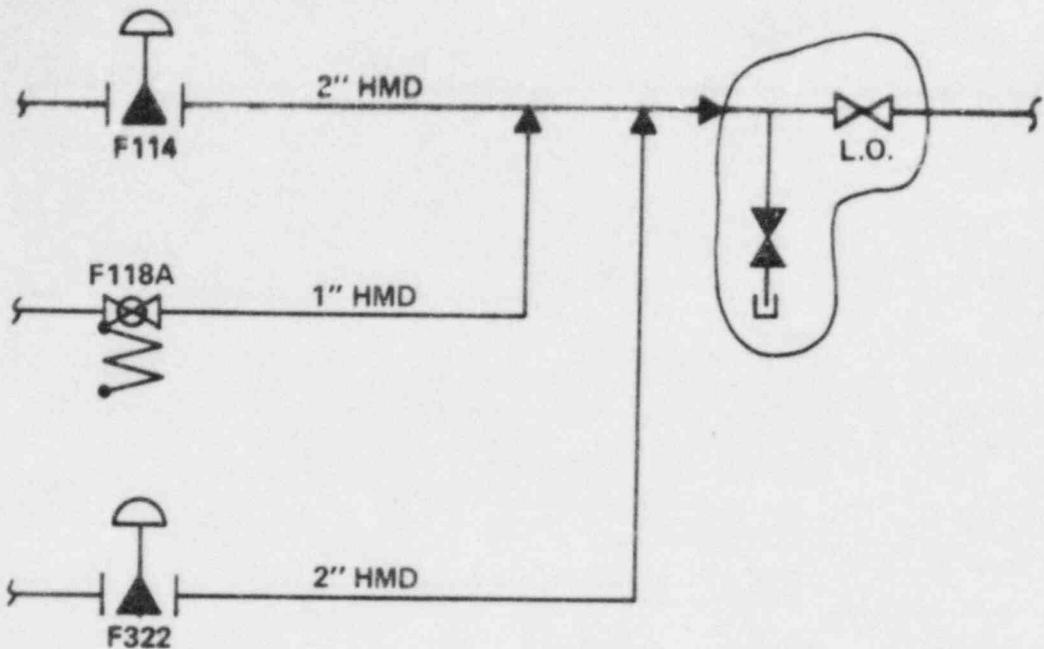


**PENETRATION X25: ADD A BLOCKING VALVE AND TEST CONNECTION BETWEEN  
VALVE T48-F118A AND THE PENETRATION**  
Figure 1 (Reference H-16000)

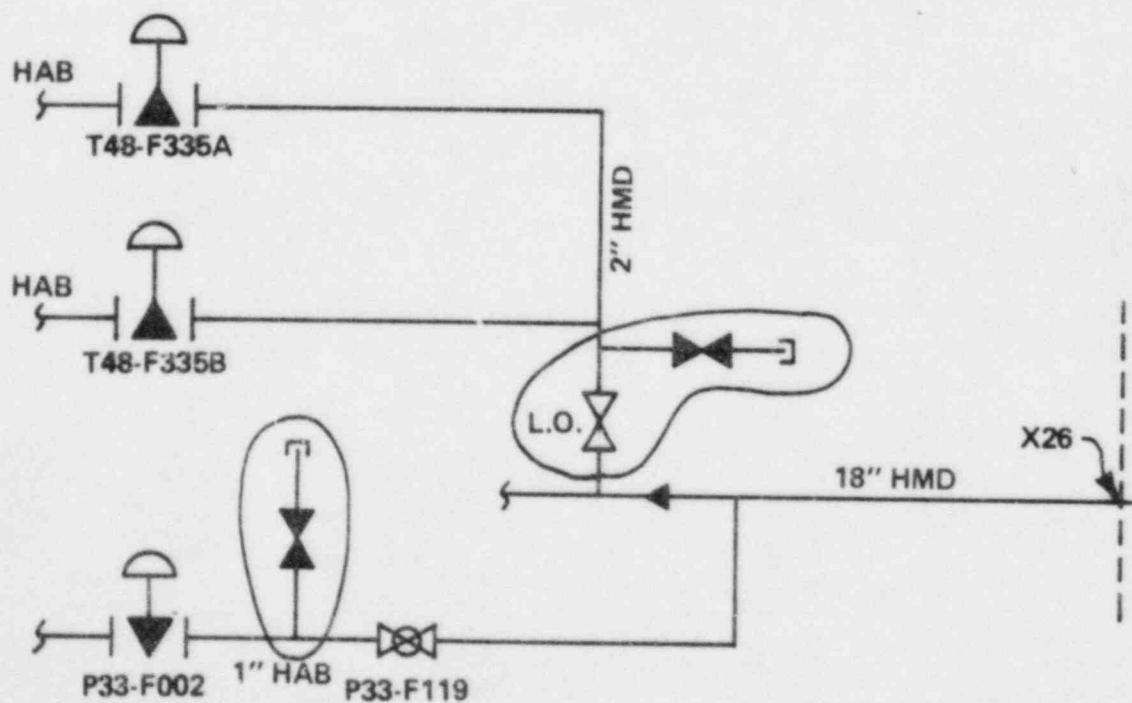


**PENETRATION X26: ADD TEST CONNECTIONS AND A BLOCKING VALVE**

Figure 2 (Reference H-16024 and H-16276)

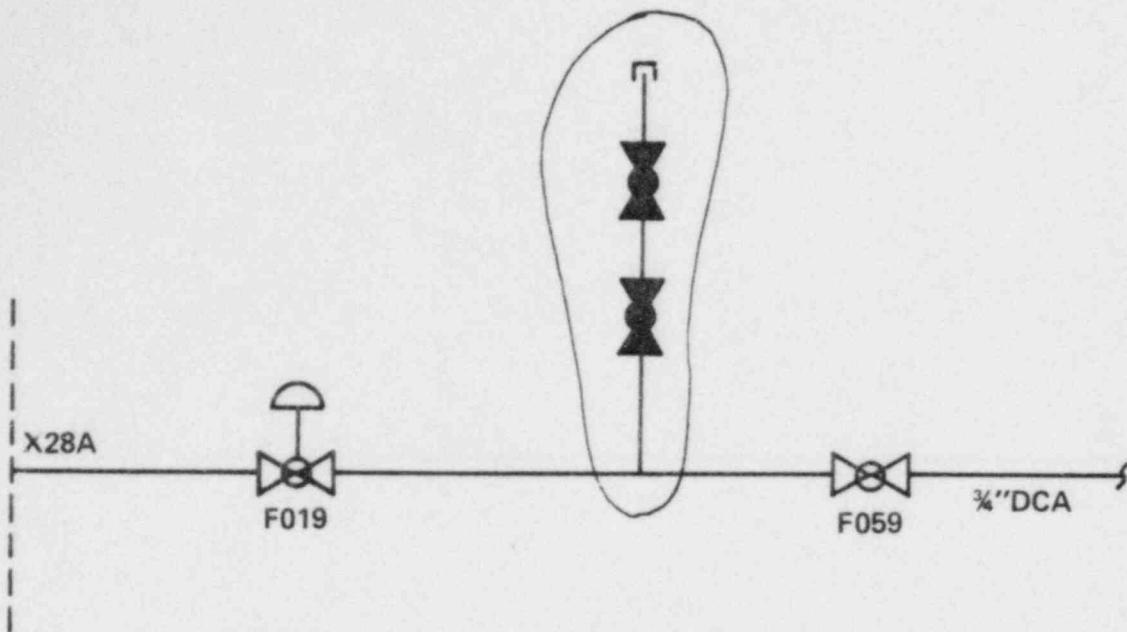


PENETRATION X28A: ADD A TEST CONNECTION

Figure 3 (Reference H-16066)

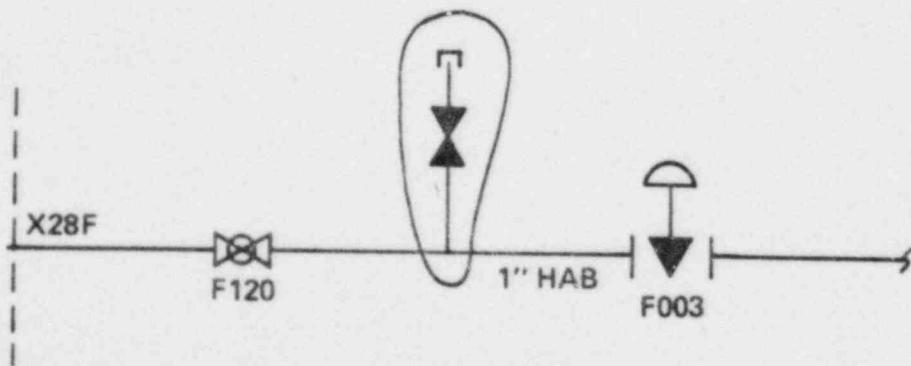

PENETRATION X28F: ADD A TEST CONNECTION


Figure 4 (Reference H-16276)

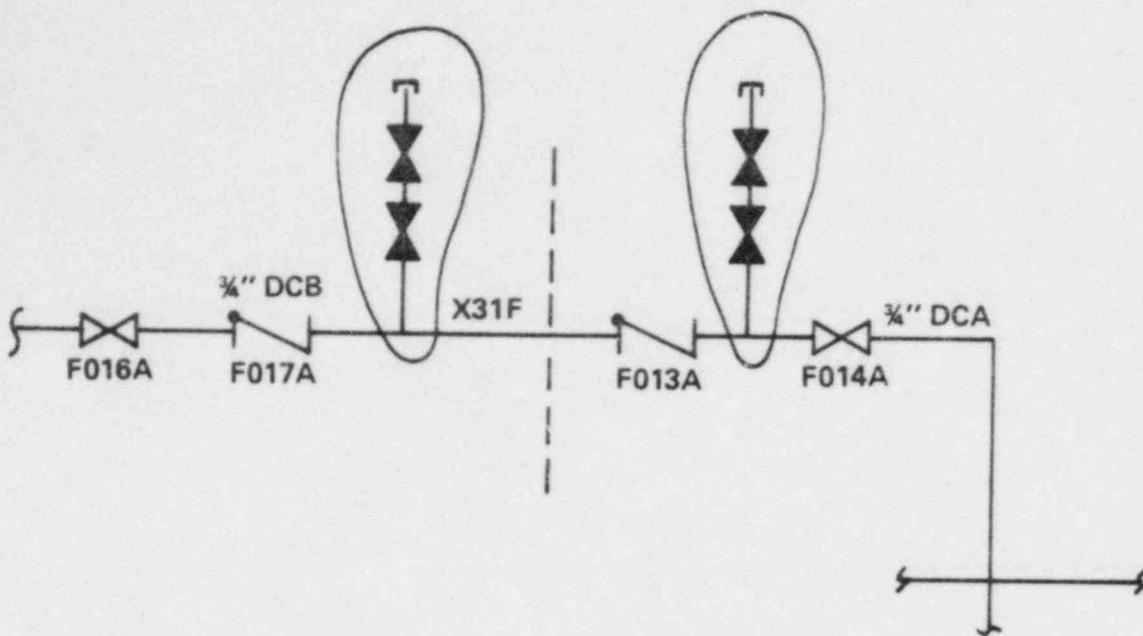

**PENETRATION X31F:** ADD TEST CONNECTIONS BETWEEN VALVES  
B31-F017A, B31-F013A, AND B31-F014A.


**PENETRATION X59A IS IDENTICAL.**

Figure 5 (Reference H-16066)

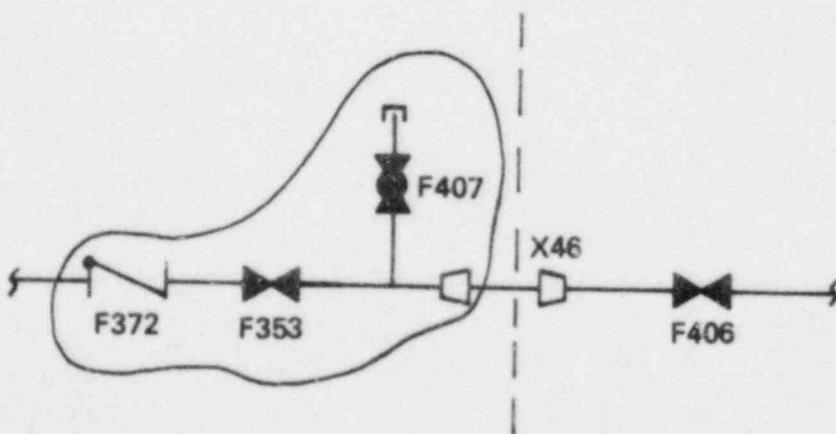


**PENETRATION X46:** EXCHANGE POSITION OF P21-F353 AND P21-F372  
ENSURE TEST CONNECTION IS BETWEEN P21-F353  
AND P21-F406.

Figure 6 (Reference H-16015)

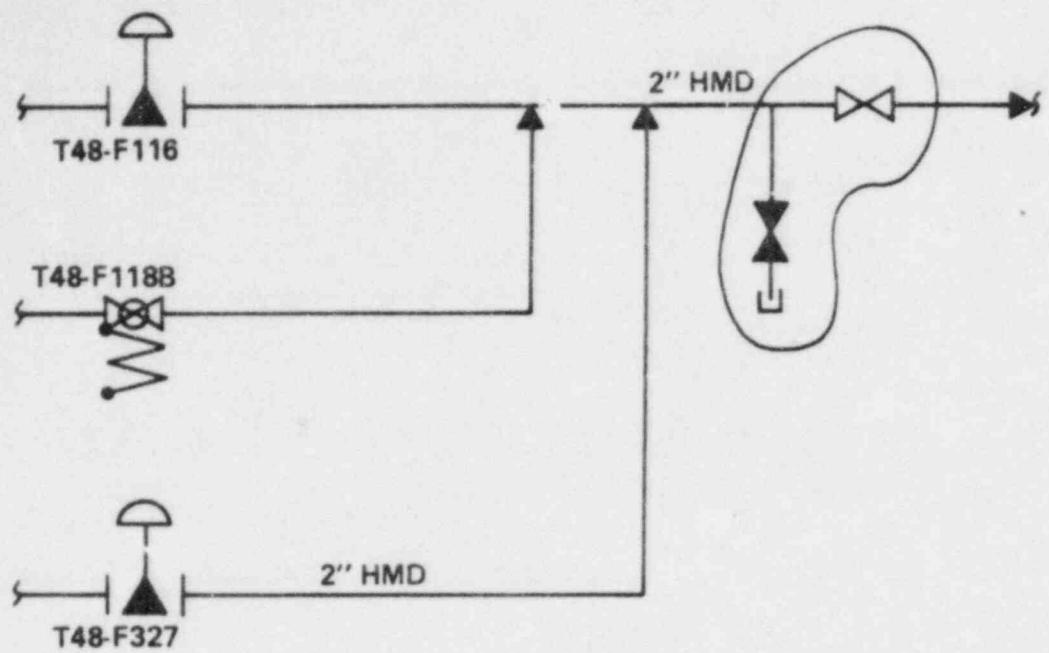


PENETRATION X205: INSTALL A BLOCKING VALVE AND TEST CONNECTION  
BETWEEN T48-118B AND THE PENETRATION

Figure 7 (Reference H-16000)

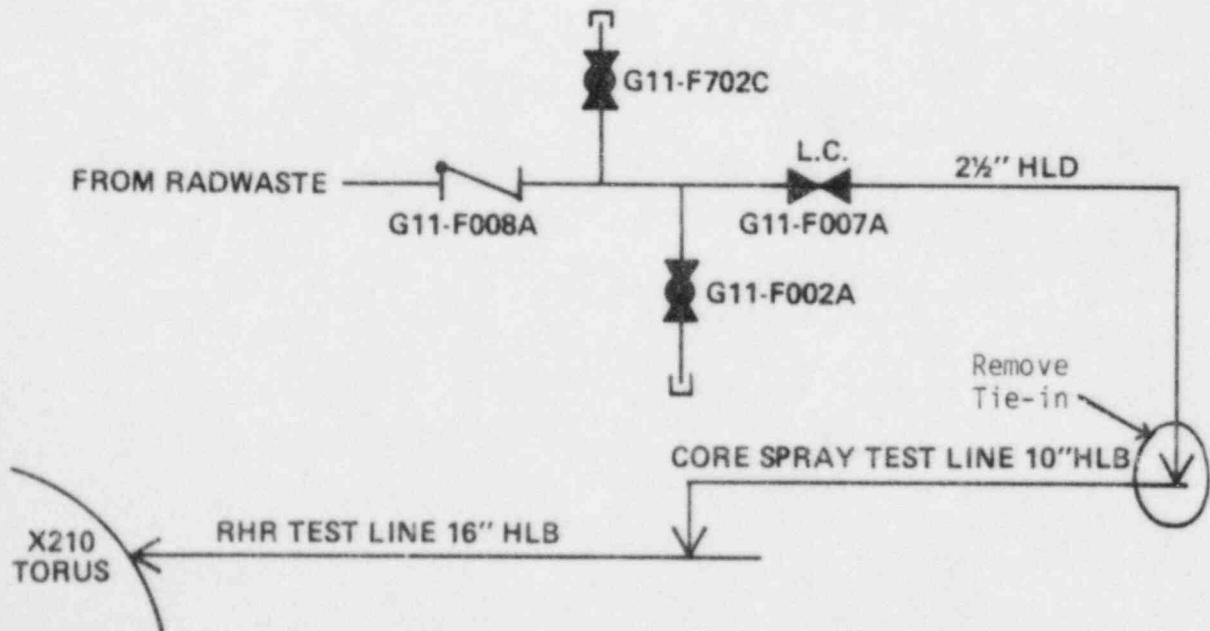


PENETRATION X210: REMOVE AND CAP G11 TIE-IN TO CORE SPRAY

Figure 8 (Reference H-16176 and H-16331)

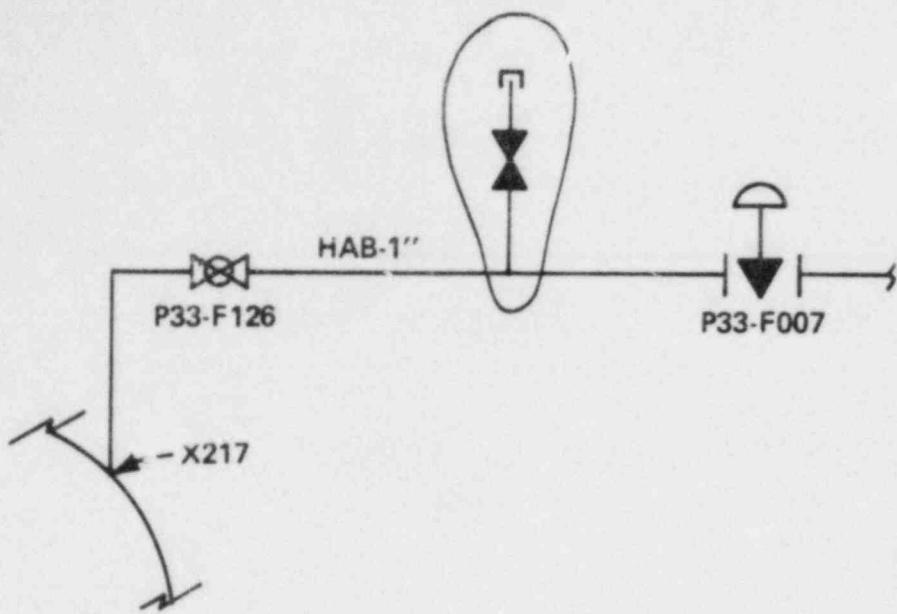

**PENETRATION X217: ADD A TEST CONNECTION BETWEEN P33-F007 AND P33-F126**

Figure 9 (Reference H-16276)

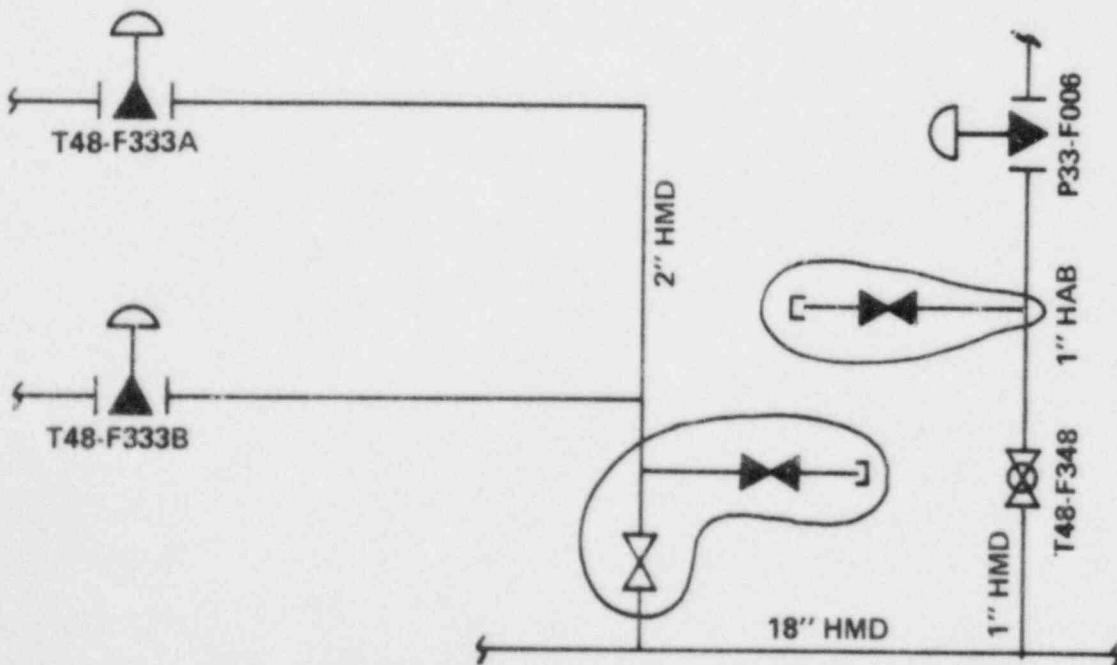

**PENETRATION X220: ADD A BLOCKING VALVE AND TEST CONNECTION BETWEEN T48-F333A/B AND THE PENETRATION, ADD A TEST CONNECTION BETWEEN T48-F348 AND P33-F006.**

Figure 10 (Reference H-16024 and H-16276)

### III. PROGRAM DESCRIPTION:

Provided in this section is a penetration leakage rate test list which describes the inboard and outboard isolation barrier for each of the Unit 1 primary containment penetrations. It has been compiled in tabular form similar to Table 3.8-12 in the Unit 2 FSAR. It has also been formulated assuming all of the proposed plant modifications described in Section II have received NRC approval and have been completed. Piping and Instrumentation Drawings are also provided as referenced in the test schedule.

The basis used to establish testing requirements and acceptance criteria for the Unit 1 program is identical to that used on Unit 2. This includes the use of closed systems outside the primary containment as isolation barriers. In most instances, the valve chosen as the primary containment isolation valve for the closed system is the outboard isolation valve.

## CONTAINMENT LEAK RATE TEST PROGRAM

Penetration No.	Description	Type Test	Inboard Isolation Barrier	Notes	Outboard Isolation Barrier	Notes	P & ID No.
1A	Equipment Hatch	B	Double O Rings	16			
1B	Equipment Hatch	B	Double O Rings	16			
2	Personnel Lock Inner Door Outer Door Barrel	B B B	Double O Rings Double O Rings Inner Door	16, 20 16, 20	Outer Door		
4	Head Access Hatch	B	Double O Rings	16			
5A-H	Vent Line	B	Expansion Bellows	15			
6	Control Rod Drive Removal Hatch	B	Double O Rings	16			
7A	Main Steam	C B	B21-F022A Expansion Bellows	5,13,14 15	B21-F028A	13, 14	H-16062
7B	Main Steam	C B	B21-F022B Expansion Bellows	5,13,14 15	B21-F028B	13, 14	H-16062
7C	Main Steam	C B	B21-F022C Expansion Bellows	5,13,14 15	B21-F028C	13, 14	H-16062
7D	Main Steam	C B	B21-F022D Expansion Bellows	5,13,14 15	B21-F028D	13, 14	H-16062
8	Condensate Drain	C B	B21-F016 Expansion Bellows	24 15	B21-F019		H-16062
9A	Primary Feedwater	C B	B21-F010B Expansion Bellows	12 15	B21-F032B E41-F006	12 12	H-16062 H-16332

## CONTAINMENT LEAK RATE TEST PROGRAM

Penetration No.	Description	Type Test	Inboard Isolation Barrier	Notes	Outboard Isolation Barrier	Notes	P & ID No.
98	Primary Feedwater	C	B21-F010A	12	B21-F032A E51-F013 G31-F039	12 12 12	H-16062 H-16334 H-16188
		B	Expansion Bellows	15			
10	Steam to RCIC Turbine	C	E51-F007	24	E51-F008		H-16334
		B	Expansion Bellows	15			
11	Steam to HPCI Turbine	C	E41-F002	24	E41-F003		H-16332
		B	Expansion Bellows	15			
12	RHR Suction	C	E11-F008		Closed System	21	H-16329
		B	Expansion Bellows	15			
13A	RHR Return to Recirculation	C	E11-F015A		Closed System	21	H-16330
		B	Expansion Bellows	15			
13B	RHR Return to Recirculation	C	E11-F015B		Closed System	21	H-16329
		B	Expansion Bellows	15			
14	Reactor Water Cleanup Supply	C	G31-F001		G31-F004		H-16188
		B	Expansion Bellows	15			
15	Spare	A					
16A	Core Spray	C	E21-F005A		Closed System	21	H-16331
		B	Expansion Bellows	15			H-16328
16B	Core Spray	C	E21-F005B		Closed System	21	H-16331
		B	Expansion Bellows	15			H-16328
17	RPV Head Spray	C	E11-F023		Closed System	21	H-16329
		B	Expansion Bellows	15			H-16328

## CONTAINMENT LEAK RATE TEST PROGRAM

Penetration No.	Description	Type Test	Inboard Isolation Barrier Notes	Outboard Isolation Barrier Notes	P & ID No.
18	Equipment Drain Pump Discharge	C	G11-F019	G11-F020	H-16176
19	Floor Drain Pump Discharge	C	G11-F003	G11-F004	H-16176
20	Service Water Supply	C	Closed System	19 P41-F049	25, 12 H-16011
21	Service Air	C	P51-F514	P51-F513	H-16013
22	Drywell Pneumatic Supply	C	P70-F004, P70-F005	P70-F020	H-16286
23	RBCCW Supply	C	Closed System	19 P42-F051	25, 12 H-16009
24	RBCCW Return	C	Closed System	19 P42-F052	25, 12 H-16009
25	Vent Purge Supply	C	T48-F307	7 T48-F308, T48-F324, T48-F105	H-16024
		C	T48-F114	T48-F113	H-16000
		C	T48-F118A	T48-F104	
		C	T48-F322	T48-F321	
		B	Butterfly Valve O Rings		
26	Vent Purge Return/H <sub>2</sub> & O <sub>2</sub> Analyzer	C	T48-F319	7 T48-F320	H-16024
		C	T48-F341	T48-F340	
		C	T48-F335B	T48-F334B	
		C	T48-F335A	T48-F334A	
		C	P33-F002	P33-F010	H-16276
27A	Spare	A			
27B	Spare	A			

## CONTAINMENT LEAK RATE TEST PROGRAM

Penetration No.	Description	Type Test	Inboard Isolation Barrier	Notes	Outboard Isolation Barrier	Notes	P & ID No.
27C	Drywell Pressure	A	E11-F043A, E11-F037A	2			H-16330
27D	Drywell Pressure	A	E11-F043C, E11-F037C	2			H-16330
27E	Drywell Pressure	A	T48-F304B	2			H-16024
27F	Spare	A					
28A	Recirculation Sample	C	B31-F019		B31-F020		H-16066
28B	RPV Instrumentation	A	B21-F047B	1			H-16063
28C	RPV Instrumentation	A	B21-F045B	1			H-16063
28D	RPV Instrumentation	A	B21-F065B	1			H-16063
		A	B21-F049B	1			H-16063
28E	RPV Instrumentation	A	B21-F043B	1			H-16063
28F	H <sub>2</sub> & O <sub>2</sub> Analyzer	C	P33-F003		P33-F011		H-16276
29A	Spare	A					
29B	RPV Instrumentation	A	B21-F047A	1			H-16063
29C	RPV Instrumentation	A	B21-F045A	1			H-16063
29D	RPV Instrumentation	A	B21-F065A	1			H-16063
		A	B21-F049A	1			H-16063
29E	RPV Instrumentation	A	B21-F043A	1			H-16063

## CONTAINMENT LEAK RATE TEST PROGRAM

Penetration No.	Description	Type Test	Inboard Isolation Barrier	Notes	Outboard Isolation Barrier	Notes	P & ID No.
29F	RPV Instrumentation	A	B21-F041	1			H-16063
30A	RPV Instrumentation	A	B21-F055	1			H-16063
30B	RPV Instrumentation	A	B21-F057	1			H-16063
30C	Main Steam Flow	A	B21-F015G	1			H-16062
30D	Main Steam Flow	A	B21-F015H	1			H-16062
30E	HPCI Steam Flow	A	E41-F024B	1			H-16332
30F	HPCI Steam Flow	A	E41-F024D	1			H-16332
31A	Recirculation Loop Instrumentation	A	B31-F009A	1			H-16066
		A	B31-F009D	1			H-16066
31B	Recirculation Loop Instrumentation	A	B31-F010A	1			H-16066
		A	B31-F010D	1			H-16066
31C	Spare	A					
31D	H <sub>2</sub> & O <sub>2</sub> Analyzer	C	P33-F004	6	P33-F012		H-16276
31E	Spare	A					
31F	Recirculation Pump Seal Water	C	B31-F013A		B31-F017A		H-16066
32A	Recirculation Loop Instrumentation	A	B31-F040A	1			H-16066
32B	Recirculation Loop Instrumentation	A	B31-F040C	1			H-16066
32C	Recirculation Loop Instrumentation	A	B31-F057A	1			H-16066

## CONTAINMENT LEAK RATE TEST PROGRAM

Penetration No.	Description	Type Test	Inboard Isolation Barrier		Outboard Isolation Barrier		P & ID No.
				Notes		Notes	
32D	Spare	A					
32E	Recirculation Loop Instrumentation	A	B31-F003A	1			H-16066
32F	Recirculation Loop Instrumentation	A	B31-F004A	1			H-16066
33A	Recirculation Loop Instrumentation	A	B31-F011A B31-F011D	1 1			H-16066 H-16066
33B	Recirculation Loop Instrumentation	A	B31-F012A B31-F012D	1 1			H-16066 H-16066
33C	Spare	A					
33D	Spare	A					
33E	Spare	A					
33F	Spare	A					
34A	Recirculation Loop Instrumentation	A	B31-F040B	1			H-16066
34B	Recirculation Loop Instrumentation	A	B31-F040D	1			H-16066
34C	Recirculation Loop Instrumentation	A	B31-F003B	1			H-16066
34D	Recirculation Loop Instrumentation	A	B31-F004B	1			H-16066
34E	Spare	A					
34F	Recirculation Loop Instrumentation	A	B31-F057B	1			H-16066
35A	Tip Drive	C B	Ball Valve A Double O Ring	16	Shear Valve A	22	H-16070 H-16070

## CONTAINMENT LEAK RATE TEST PROGRAM

Penetration No.	Description	Type Test	Inboard Isolation Barrier	Notes	Outboard Isolation Barrier	Notes	P & ID No.
35B	Tip Drive	C B	Ball Valve B Double O Ring	16	Shear Valve B	22	H-16070 H-16070
35C	Tip Drive	C B	Ball Valve C Double O Ring	16	Shear Valve C	22	H-16070 H-16070
35D	Tip Drive	C B	Ball Valve D Double O Ring	16	Shear Valve D	22	H-16070
35E	Tip N <sub>2</sub> Purge	C B	Check Valve Double O Ring	16	Solenoid Valve		H-16070
36	Spare	B	Welded Cap		Welded Cap		
37A-D	CRD Insert	A			Hydraulic Control Unit	23	
38A-D	CRD Withdraw	A			Scram Discharge Header	23	
39A	Containment Spray	C	E11-F016A		Closed System	21	H-16330 H-16328
39B	Containment Spray	C	E11-F016B		Closed System	21	H-16329 H-16328
40A-A	Recirculation Loop Instrumentation	A	B31-F055B	1			H-16066
40A-B	Recirculation Loop Instrumentation	A	B31-F055D	1			H-16066
40A-C	RPV Instrumentation	A	E21-F018A	1			H-16331
40A-D	Spare	A					
40A-E	Recirculation Loop Instrumentation	A	B31-F055E	1			H-16066
40A-F	Recirculation Loop Instrumentation	A	B31-F055G	1			H-16066

## CONTAINMENT LEAK RATE TEST PROGRAM

Penetration No.	Description	Type Test	Inboard Isolation Barrier Notes	Outboard Isolation Barrier Notes	P & ID No.
40B-A	Spare	A			
40B-B	Spare	A			
40B-C	Spare	A			
40B-D	Spare	A			H-16334
40B-E	RCIC Steam Flow	A	E51-F044B		
40B-F	RCIC Steam Flow	A	E51-F044D		H-16334
40C-A	Spare	A			
40C-B	Spare	A			
40C-C	Spare	A			
40C-D	Spare	A			
40C-E	Spare	A			
40C-F	Drywell Pneumatic Outlet	C	P70-F002		H-16286
40D-A	RPV Instrumentation	A	E21-F018B		H-16331
400-B	Spare	A			
400-C	Recirculation Loop Instrumentation	A	B31-F055F		H-16066
400-D	Recirculation Loop Instrumentation	A	B31-F055H		H-16066
400-E	Recirculation Loop Instrumentation	A	B31-F055A		H-16066
					III-9

## CONTAINMENT LEAK RATE TEST PROGRAM

Penetration No.	Description	Type Test	Inboard Isolation Barrier	Notes	Outboard Isolation Barrier	Notes	P & ID No.
40D-F	Recirculation Loop Instrumentation	A	B31-F055C	1			H-16066
41	Spare	A					
42	Standby Liquid Control	C	C41-F007		C41-F006		H-16061
43	Drywell Test and Fill	B	Double O Ring	16			
44	Service Water Return	C	Closed System	19	P41-F050	25, 12	H-16011
45A	HPCI Steam Instrumentation	A	E41-F024A	1			H-16332
45B	HPCI Steam Instrumentation	A	E41-F024C	1			H-16332
45C	Drywell Pressure	A	E11-F043D, E11-F037D	2			H-16329
45D	Drywell Pressure	A	E11-F043B, E11-F037B	2			H-16329
45E	Drywell Pressure	A	T48-F303B	2			H-16024
45F	ILRT Verification Flow	C	T23-F004		T23-F005		H-16060
46	Demineralized Water	C	P21-F406		P21-F353		H-16015
47	Spare	A					
49A	Jet Pump Instrumentation	A	B21-F058A	1			H-16063
49B	Jet Pump Instrumentation	A	B21-F059G	1			H-16063
49C	Jet Pump Instrumentation	A	B21-F059E	1			H-16063
49D	Jet Pump Instrumentation	A	B21-F059A	1			H-16063

## CONTAINMENT LEAK RATE TEST PROGRAM

Penetration No.	Description	Type Test	Inboard Isolation Barrier	Notes	Outboard Isolation Barrier	Notes	P & ID No.
49E	Jet Pump Instrumentation	A	B21-F059C	1			H-16063
49F	Jet Pump Instrumentation	A	B21-F051A	1			H-16063
50A	Jet Pump Instrumentation	A	B21-F053B	1			H-16063
50B	Jet Pump Instrumentation	A	B21-F059H	1			H-16063
50C	Jet Pump Instrumentation	A	B21-F059F	1			H-16063
50D	Jet Pump Instrumentation	A	B21-F059B	1			H-16063
50E	Jet Pump Instrumentation	A	B21-F059D	1			H-16063
50F	Jet Pump Instrumentation	A	B21-F051B	1			H-16063
51A	Jet Pump Instrumentation	A	B21-F059M	1			H-16063
51B	Jet Pump Instrumentation	A	B21-F053D	1			H-16063
51C	Jet Pump Instrumentation	A	B21-F059U	1			H-16063
51D	Jet Pump Instrumentation	A	B21-F059P	1			H-16063
51E	Jet Pump Instrumentation	A	B21-F059S	1			H-16063
51F	Jet Pump Instrumentation	A	B21-F051D	1			H-16063
52A	Jet Pump Instrumentation	A	B21-F059L	1			H-16063
52B	Jet Pump Instrumentation	A	B21-F053C	1			H-16063

## CONTAINMENT LEAK RATE TEST PROGRAM

Penetration No.	Description	Type Test	Inboard Isolation Barrier	Notes	Outboard Isolation Barrier	Notes	P & ID No.
52C	Jet Pump Instrumentation	A	B21-F059T	1			H-16063
52D	Jet Pump Instrumentation	A	B21-F059N	1			H-16063
52E	Jet Pump Instrumentation	A	B21-F059E	1			H-16063
52F	Jet Pump Instrumentation	A	B21-F051C	1			H-16063
53A-F	Power Test	A				Welded Cap	
54A	RPV Instrumentation	A	B21-F061	1			H-16063
54B	RPV Instrumentation	A	E21-F018C	1			H-16331
54C	Main Steam Instrumentation	A	B21-F015K	1			H-16062
54D	Main Steam Instrumentation	A	B21-F015J	1			H-16062
54E	RCIC Steam Instrumentation	A	E51-F044A	1			H016334
54F	RCIC Steam Instrumentation	A	E51-F044C	1			H-16334
59A	Recirculation Pump Seal Water	C	B31-F013B		B31-F017B		H-16066
59B	Recirculation Loop Instrumentation	A	B31-F009C	1			H-16066
		A	B31-F009B	1			H-16066
59C	Recirculation Loop Instrumentation	A	B31-F010B	1			H-16066
		A	B31-F010C	1			H-16066
59D	Spare	A					H-16066

## CONTAINMENT LEAK RATE TEST PROGRAM

Penetration No.	Description	Type Test	Inboard Isolation Barrier Notes	Outboard Isolation Barrier Notes	P & ID No.
59E	Recirculation Loop Instrumentation	A A	B31-F012B B31-F012C	1 1	H-16066 H-16066
59F	Recirculation Loop Instrumentation	A A	B31-F011B B31-F011C	1 1	H-16066 H-16066
60A	Spare	A			
60B	Spare	A			
61A	Spare	A			
61B	Spare	A			
62	Spare	A			
100A	Neutron Monitoring	B	Canister		
100B	Neutron Monitoring	B	Canister		
100C	Spare	A			
100D	Neutron Monitoring	B	Canister	17	
100E	Neutron Monitoring	B	Canister	17	
100F-A	Main Steam Flow	A	B21-F015C	1	H-16062
100F-B	Main Steam Flow	A	B21-F015M	1	H-16062
100F-C	Main Steam Flow	A	B21-F015L	1	H-16062
					III-13

## CONTAINMENT LEAK RATE TEST PROGRAM

Penetration No.	Description	Type Test	Inboard Isolation Barrier		Outboard Isolation Barrier		P & ID No.
				Notes		Notes	
100F-D	Main Steam Flow	A	B21-F015S	1			H-16062
100F-E	Main Steam Flow	A	B21-F015R	1			H-16062
100F-F	Main Steam Flow	A	B21-F015D	1			H-16062
101A-F	Recirculation Pump Power	B	Canister	17			
102A	Indication and Control	B	Canister	17			
102B	Spare	A					
103A	Indication and Control	B	Canister	17			
103B-A	Main Steam Instrumentation	A	B21-F015A	1			H-16062
103B-B	Main Steam Instrumentation	A	B21-F015N	1			H-16062
103B-C	Main Steam Instrumentation	A	B21-F015P	1			H-16062
103B-D	Main Steam Instrumentation	A	B21-F015F	1			H016062
103B-E	Main Steam Instrumentation	A	B21-F015E	1			H016062
103B-F	Main Steam Instrumentation	A	B21-F015B	1			H016062
104A,B,C	CRD Rod Position Indication	B	Canister	17			
104D, E	Spare	A					
104F,G,H	CRD Rod Position Indication	B	Canister	17			
105A	600 Volt Power	B	Canister	17			

## CONTAINMENT LEAK RATE TEST PROGRAM

Penetration No.	Description	Type Test	Inboard Isolation Barrier		Outboard Isolation Barrier		P & ID No.
				Notes		Notes	
105B	Spare	A					
105C	600 Volt Power	B	Canister	17			
105D	Spare	A					
106A	Spare	A					
106B	Thermocouples	B	Canister	17			
107A, B	Spare	A					
108A	Grounding Rod	A	Welded				
108B	Grounding Rod	A	Welded				
200A	Torus Access Hatch	B	Double O Rings	16			
200B	Torus Access Hatch	B	Double O Rings	16			
201A-H	Drywell to Torus Vent Lines	B	Expansion Bellows	15			
202	Control and Indication	B	Canister	17			
203	RCIC Pump Suction	C	E51-F003	7, 12	E51-F031	12	H-16334
204A	RHR Pump Suction	C	E11-F004A, F030A	12	Closed System	21	H-16330
204B	RHR Pump Suction	C	E11-F004B, F030B	12	Closed System	21	H-16329
204C	RHR Pump Suction	C	E11-F004C, F030C	12	Closed System	21	H-16330

## CONTAINMENT LEAK RATE TEST PROGRAM

Penetration No.	Description	Type Test	Inboard Isolation Barrier		Outboard Isolation Barrier		P & ID No.
				Notes		Notes	
204D	RHR Pump Suction	C	E11-F004D, F030D	12	Closed System	21	H-16329
205	Containment Purge and Inerting	A	T48-F302	2			H-16024
		A	T48-F303A	2			
		A	T48-F301	2			
		C	T48-F311	7	T48-F328B		
		C	T48-F310	7	T48-F328A		
		C	T48-F309	7	T48-F324		
		C	T48-F116		T48-F115		
		C	T48-F118B		T48-F104		
		C	T48-F327		T48-F325		
		B	Butterfly Valve O Rings	16			
206A	Torus Water Level	A	T48-F331B	2			H-16024
		A	E41-F109	2			H-16332
206B	Torus Water Level	A	T48-F331A	2			H-16024
		A	E41-F110	2			H-16332
206C	Torus Water Level	A	T48-F330B	2			H-16024
		A	E41-F107	2			H-16332
206D	Torus Water Level	A	T48-F330A	2			H-16024
		A	E41-F108	2			H-16332
206E-H	Spare	A					
207	HPCI Pump Suction	C	E41-F051	7, 12	E41-F042	12	H-16332
208A	Core Spray Pump Suction	C	E21-F001A	12	Closed System	21	H-16331
208B	Core Spray Pump Suction	C	E21-F001B	12	Closed System	21	H-16331

## CONTAINMENT LEAK RATE TEST PROGRAM

Penetration No.	Description	Type Test	Inboard Isolation Barrier	Outboard Isolation Barrier		P & ID No.	
			Notes	Notes			
209A-D	Torus Water Temperature	A	Welded Thermowells				
210A	RHR/Core Spray Test Line	C	E11-F028A E11-F007A E11-F011A E11-F103A E11-F055A Thermal Relief E11-F029 E11-F025A E21-F015A	11 3, 11 3, 11 10 9 9 9 9 5, 11	Closed System Closed System E11-F026A, Closed System Closed System Closed System Closed System Closed System Closed System Closed System	21 21 11, 21 21 21 21 21 21 21	H-16330 H-16331 H-16334
		C	E21-F036A E51-F019	10, 11 4, 11	Closed System E51-F021	21 11	
210B	RHR/Core Spray Test Line	C	E11-F028B E11-F007B E11-F011B E11-F103B E11-F055B Thermal Relief E11-F025B E21-F015B	11 3, 11 3, 11 10 9 9 9 5, 11	Closed System Closed System E11-F026B, Closed System Closed System Closed System Closed System Closed System Closed System	21 21 11, 21 21 21 21 21 21	H-16329 H-16331 H-16176 H-16182 H-16332
		C	E11-F097 E21-F036B	9 10, 11	Closed System Closed System	21 21	
		C	E41-F012	4, 11	E41-F046	11	
211A	Torus Spray	C	E11-F028A		Closed System	21	H-16330

## CONTAINMENT LEAK RATE TEST PROGRAM

Penetration No.	Description	Type Test	Inboard Isolation Barrier	Outboard Isolation Barrier	Notes	P & ID No.
211B	Torus Spray	C	E11-F028B	Closed System	21	H-16329
212	RCIC Turbine Exhaust	C	E51-F001	E51-F040	11	H-16334
213	RCIC Turbine Vacuum Pump Discharge	C	E51-F002	E51-F028	11	H-16334
214	HPCI Turbine Exhaust	C	E41-F021	E41-F049	11	H-16332
215	HPCI Exhaust Drain	C	E41-F022	E41-F040	11	H-16332
216A-D	Torus Air Temperature	A	Welded Thermowell			
217	H <sub>2</sub> & O <sub>2</sub> Analyzer	C	P33-F007	P33-F015		H-16276
218A, B	Construction Drain	B	Flange, Double O Rings		16	
220	Vent Purge Outlet	A	T48-F304A		2	
		C	T48-F333A	T48-F332A		
		C	T48-F333B	T48-F332B		
		C	T48-F318	T48-F326	7	
		C	T48-F339	T48-F338	5	
		C	P33-F006	P33-F014		
221A	Spare	A				
221B	Spare	A				
221C	RCIC Turbine Exhaust Vacuum Breaker	C	E51-F105	E51-F104	24	H-16334
222A	HPCI Turbine Exhaust Vacuum Breaker	C	E41-F111	E41-F104	24	H-16332
222B	Spare	A				
223A A-F	Control Air for Vacuum Breaker	C	Air Cylinder	T48-F342 G-L	18	4

## CONTAINMENT LEAK RATE TEST PROGRAM


Penetration No.	Description	Type Test	Inboard Isolation Barrier Notes	Outboard Isolation Barrier Notes	P & ID No.
223B A-F	Control Air for Vacuum Breaker	C	Air Cylinder	T48-F342 A-F	4 H-16024  111-19

NOTES

1. Seismic Category I instrument line with an orifice and excess-flow check valve (EFCV). The EFCV is subjected to operability testing in accordance with the Technical Specifications. This line does not isolate during a LOCA and can leak only if the line or instrument should rupture.
2. Instrument line does not communicate with the reactor coolant pressure boundary. The isolation valve is manually operated and the design satisfies the requirements of Regulatory Guide 1.11, with backfit supplement, for plants which have had a Construction Permit hearing prior to December 30, 1969. Type C testing is not required by 10CFR50, Appendix J. The lines are subjected to pressure during the Type A test.
3. Gate valve tested in the reverse direction.
4. Globe valve tested in the reverse direction.
5. Globe valve tested in the reverse direction. Conservative test: test pressure tends to unseat the disc. (See Figures 11 and 12)
6. Control valve tested in the reverse direction. Conservative test: test pressure tends to unseat the disc. (See Figure 13)
7. Butterfly valve tested in the reverse direction. Same seating surface is tested when test pressure is applied from either direction. (See Figures 14 and 15)
8. Stop check valve pressurized in the reverse direction. Test pressure tends to lift the disc from the seat; therefore, the reverse pressure test is conservative. (See Figure 16)
9. Isolation barrier is the discharge side of a relief valve. The relief valve is tested in the inlet direction; conservative test since containment pressure tends to seat the disc and test pressure tends to unseat it.
10. Untestable globe or check valve; leakage prevented by a closed system.
11. Valve is sealed from the primary containment atmosphere because its line terminates below the water level of the torus. Leakage is not included in the  $0.60 L_a$  Types B and C tests local leakage totals.
12. System remains water filled post LOCA. Isolation valves are tested with water at a pressure of  $1.10 P_a$ . Leakage is not included in the  $0.60 L_a$  Types B and C tests local leakage totals.


13. Tested at one-half  $P_a$ .
14. MSIV leakage rate shall not exceed 11.5 scfh for any valve. Leakage is not included in  $0.60 L_a$  acceptance criteria for Type B and C tests.
15. Penetration has a double-ply, bellows-type seal which will be tested by pressurizing between the two plies through a test connection.
16. Penetration is sealed by a blind flange or door with double O-ring seals. These seals are leakage rate tested by pressurizing between the O-rings.
17. Electrical penetrations are tested by pressurizing between the seals through a valved test connection.
18. The inboard isolation barrier is the vacuum breaker exercising cylinder. The barrier is provided by seals on the air-operated piston. The exercising cylinder, although not Quality Group B, was specified by the vacuum breaker vendor to be qualified to the postulated post-LOCA environment. The cylinder is designed to operate with an air pressure of 95 to 100 psig, which is significantly higher than the post-LOCA containment pressure and is Type C leakage rate tested.
19. The inboard isolation barrier is a closed system inside primary containment. The closed system is subject to the in-service inspection requirements of ASME Section XI for Nuclear Class 3 piping. The system remains water filled post-LOCA and is, therefore, pressurized with water to 1.10 Pa during the Type C test. In accordance with 10CFR50, Appendix J, Paragraph III.C.3, the leakage is excluded from the  $0.60 L_a$  criteria. Leakage acceptance criteria are based upon maintaining a 30-day inventory of water.
20. The personnel air lock door seals shall be tested at 10 psig; the barrel shall be tested at  $P_a$ . The lock barrel test leakage rate shall not exceed  $0.05 L_a$ .
21. The outboard isolation barrier is a closed system outside primary containment. The closed system is subject to the in-service inspection requirements of the ASME Code Section XI for Nuclear Class 2 piping, which requires that any visible leakage be repaired. The system is filled with water and operating at a pressure greater than  $P_a$ , post-LOCA. Leakage is not included in the  $.60 L_a$  Types B and C local leakage totals.
22. The operation of the TIP drive shear valve is described in FSAR Section 5.2.3.5.2. Since the shear valve isolates the TIP tubing by shearing the tube and drive cable and by jamming the sheared ends of the tubing into a teflon coating on the shear valve disc, the valve can not be Type C tested without destroying the drive tube. Therefore, the TIP shear valves are not Type C tested. However, each lot of valves are sample leakage tested by the manufacturer prior to delivery. Failure of a single valve to meet the  $10^{-2} \text{cc/sec}$  leakage criteria set for the leakage test results in the rejection of the entire

- lot. Explosive charges, which operate the shear valves, are in-service inspected in accordance with the requirements of ASME Section XI.
23. The design of the CRD insert and withdraw lines is discussed in FSAR Section 5.2.3.5.1. The design of these lines does not facilitate Type C testing as described in 10CFR50, Appendix J. However, adequate leakage monitoring of the CRD lines is provided by normal plant operating procedures and the Type A leakage rate tests. Since the insert and withdraw lines are pressurized to at least reactor operating pressure by the cooling water flow during normal plant operation, leakage from these lines would be immediately evident.
- The hydraulic control units are installed on El. 130' of the reactor building, a relatively high traffic area. In addition, the HNP-2 Daily Rounds procedure requires that an operator make a visual inspection for leakage in the CRD hydraulic area of the reactor building at least once per shift and that he record the inspection.
- The RPV and the nonseismic portions of the CRD system are vented during the performance of the Type A test. Therefore, leakage from the insert and withdraw lines will be included in the total Type A test leakage.
24. Gate valve tested in the reverse direction. A generic leakage test is performed for this valve since the opposite seat is tested on the outboard valve. Both isolation valves are the same design and, therefore, have similar leakage characteristics. This valve is also subjected to Pa during the Type A test. Piping outboard of the second primary containment isolation valve is seismic Category I, Quality Group B.
25. Local leakage rate test required in accordance with Appendix J, Art. III.A.1.d. However, leakage is not included in the  $0.60 L_a$  Types B and C test acceptance criteria.

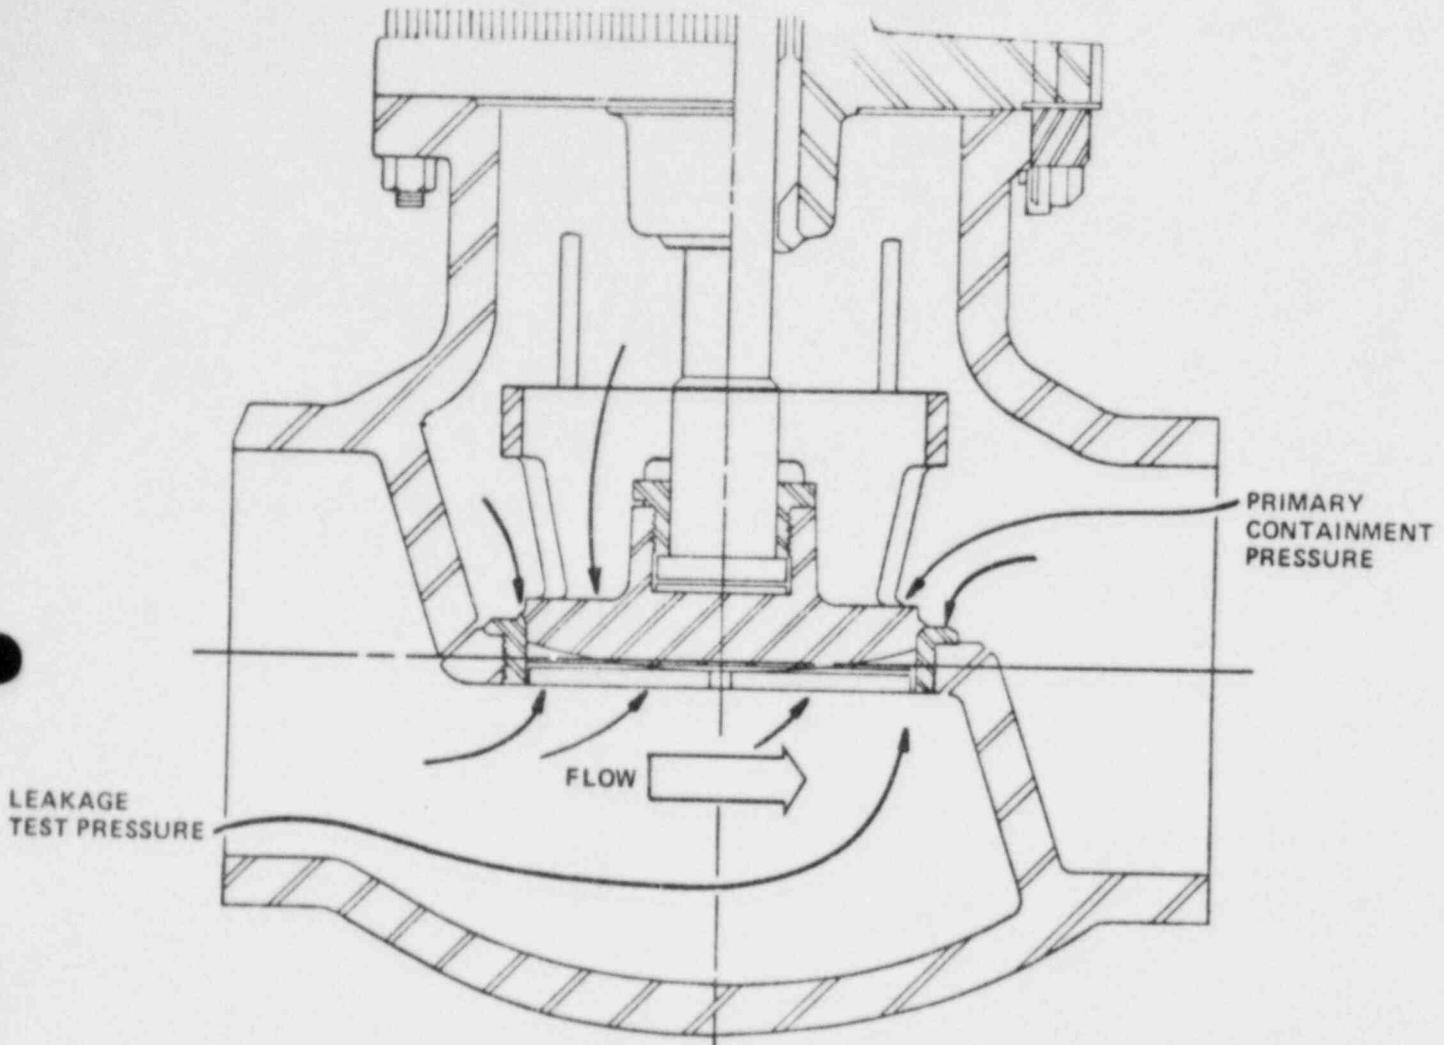


FORCES CAUSED BY THE APPLICATION OF LEAKAGE TEST PRESSURE UNDER THE VALVE DISC ACT AGAINST THE SEATING FORCE CREATED BY THE STEM ACTING ON THE DISC. FORCES DUE TO CONTAINMENT PRESSURE ACT ON TOP OF THE DISC AND ARE ADDITIVE TO THE SEATING FORCES OF THE STEM AGAINST THE DISC AND TEND TO SEAT THE VALVE MORE TIGHTLY.

Figure 11 Globe Valve: Applicable To Valves E21-F015A, B and T48-F339, 341

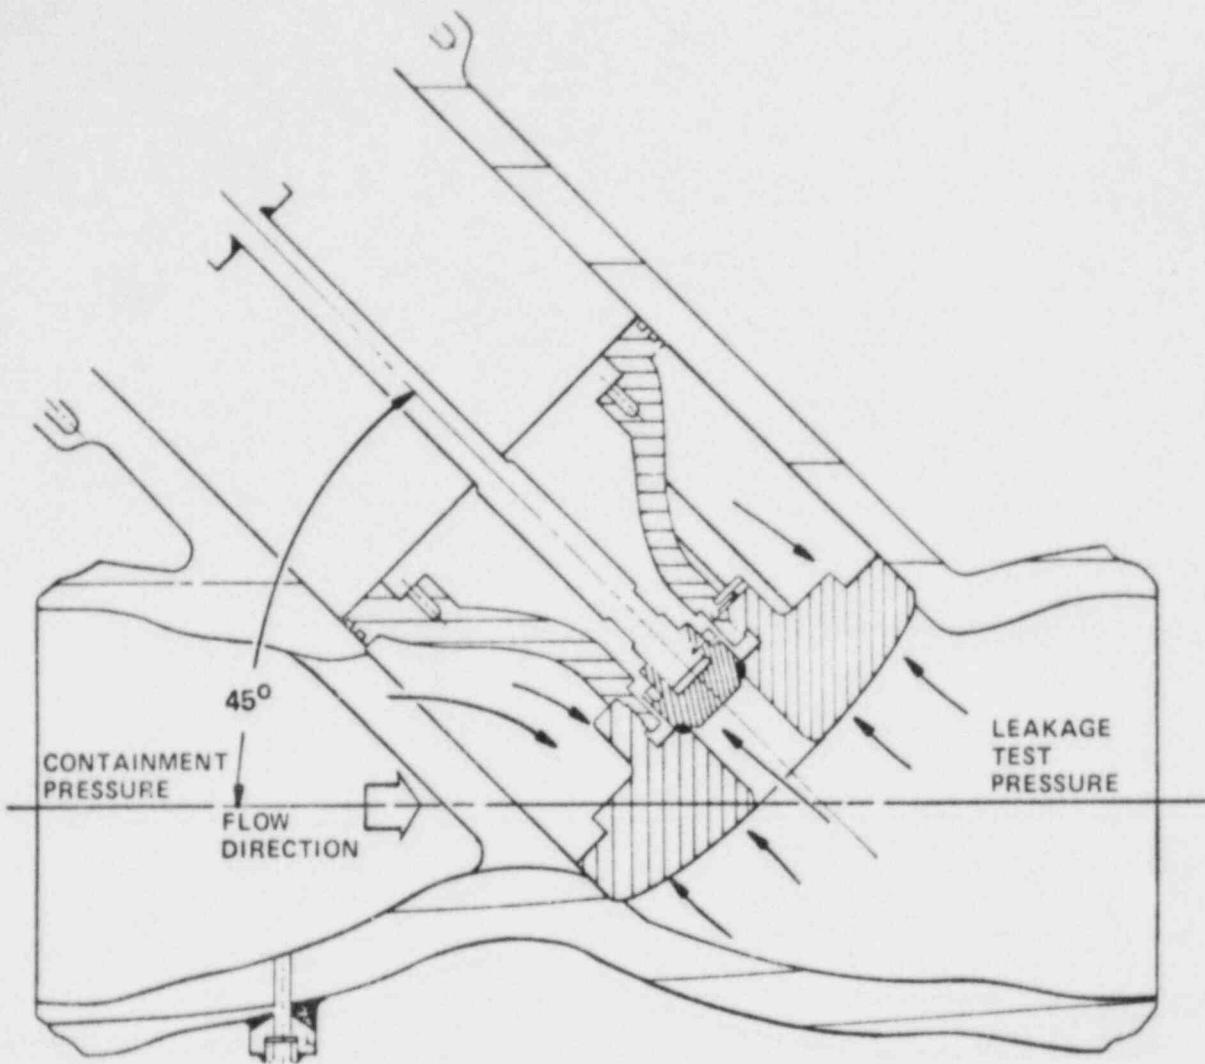

FORCES DUE TO THE LEAKAGE TEST PRESSURE ACT AGAINST THE SEATING FORCES OF THE VALVE. AS THE VALVE IS DESIGNED TO USE UPSTREAM PRESSURE TO PROVIDE A TIGHT SEAT, PRESSURE FORCES FROM THE CONTAINMENT DIRECTION WILL TEND TO SEAT THE VALVE.

Figure 12 Main Steam Isolation Globe Valve  
Applicable to Valves B21-F022 A,B,C,D

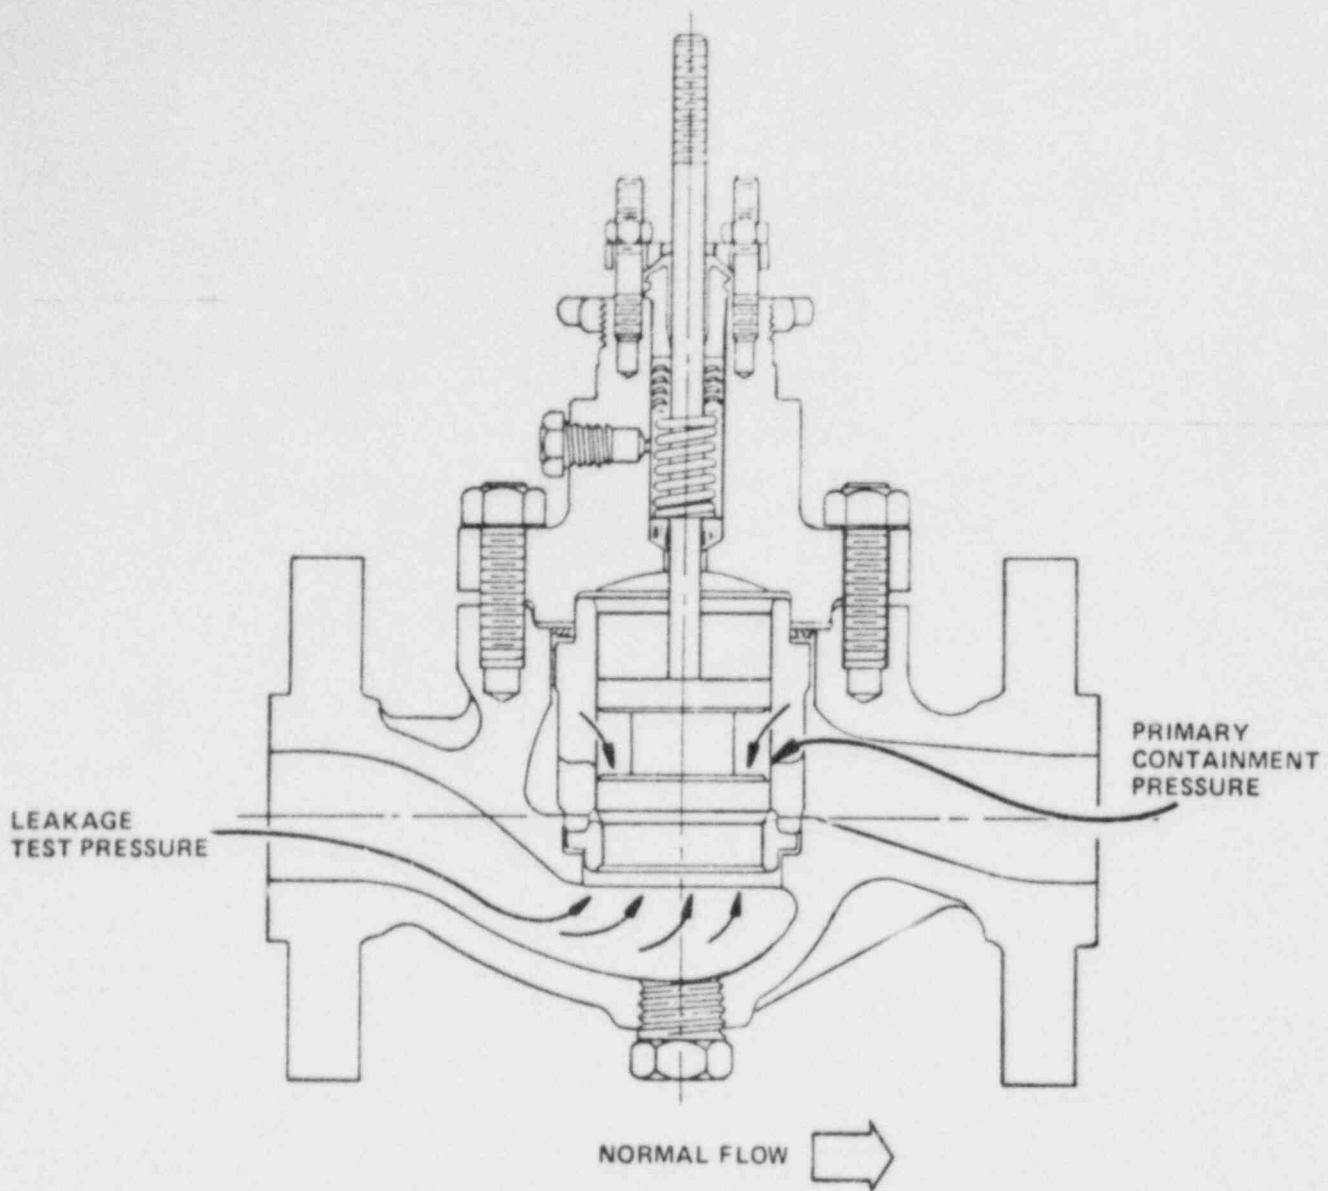

THE SUBJECT VALVES ARE OF THE UNBALANCED FLOW TO OPEN DESIGN; THEREFORE, WITH AN OBSERVED PRESSURE DROP IN THE REVERSE FLOW DIRECTION, AN ADDITIONAL SEATING LOAD WILL BE EXPERIENCED DUE TO THE HIGHER PRESSURE AT THE OUTLET OF THE VALVE BEING REGISTERED ON TOP OF THE VALVE PLUG, THUS SUPPLYING A FORCE IN THE DOWNWARD DIRECTION. THEREFORE, PRIMARY CONTAINMENT PRESSURE WILL TEND TO SEAT THE VALVE MORE TIGHTLY, WHEREAS TEST PRESSURE APPLIED ON THE SIDE OPPOSITE CONTAINMENT ACTS AGAINST THE SEATING FORCES.

Figure 13 Control Valve, Applicable to Valve P33-F004

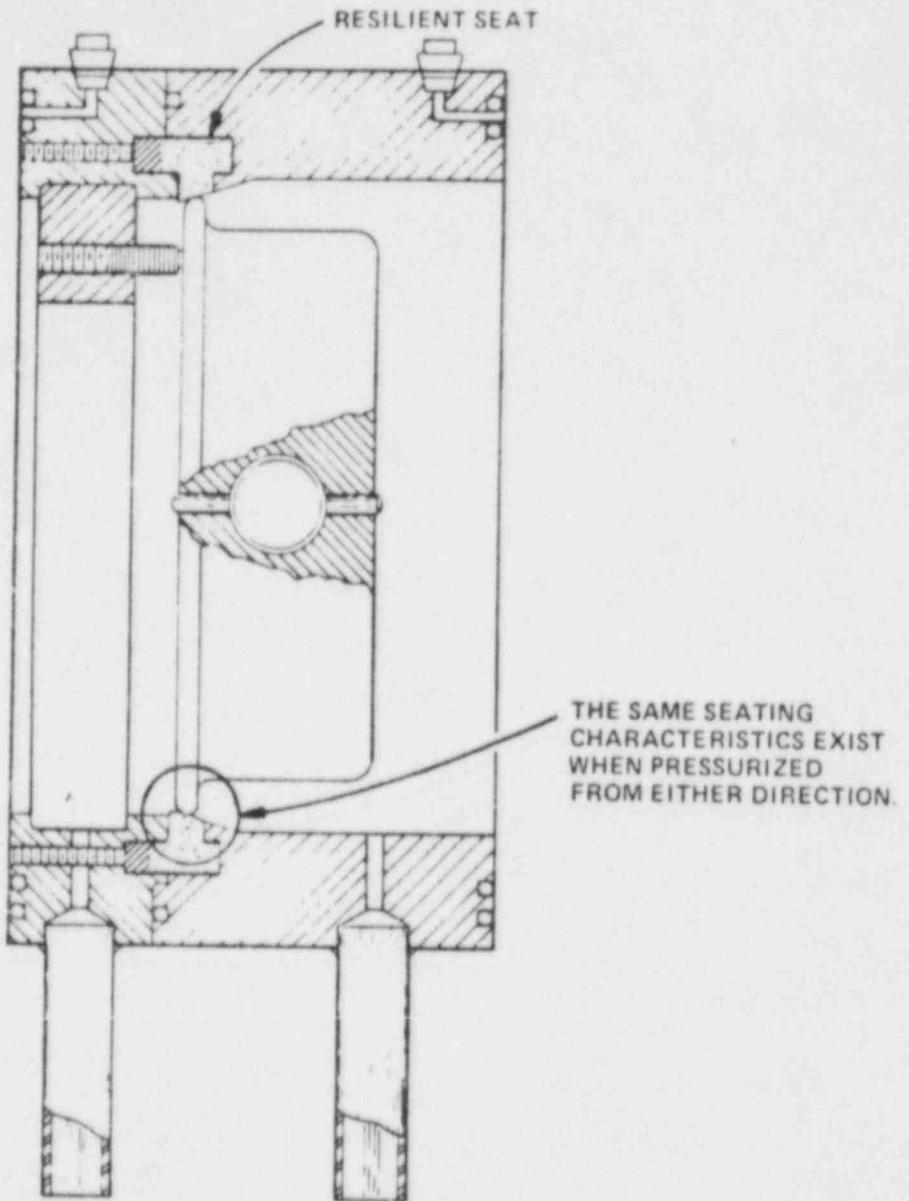


Figure 14 Butterfly Valve, Applicable to Valves T48-F307, F309, F310, F311 F318, and F319.

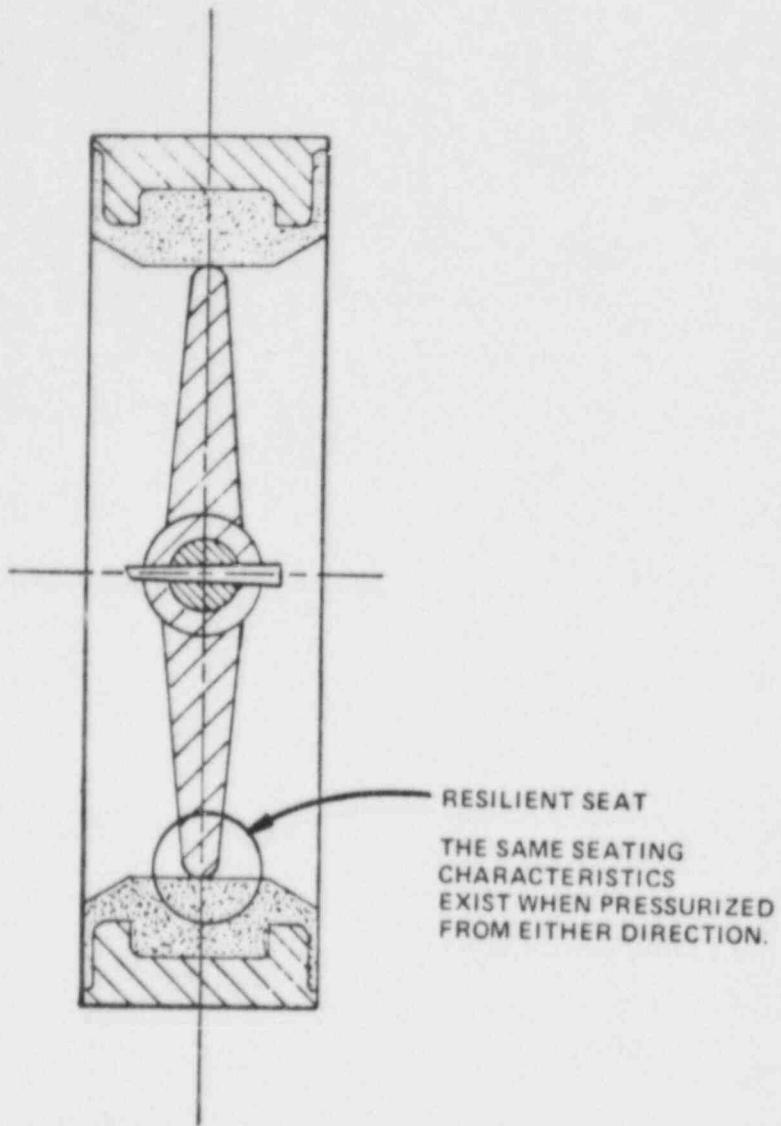


Figure 15 Butterfly Valve, Applicable To  
Valves E41-F051 and E51-F003



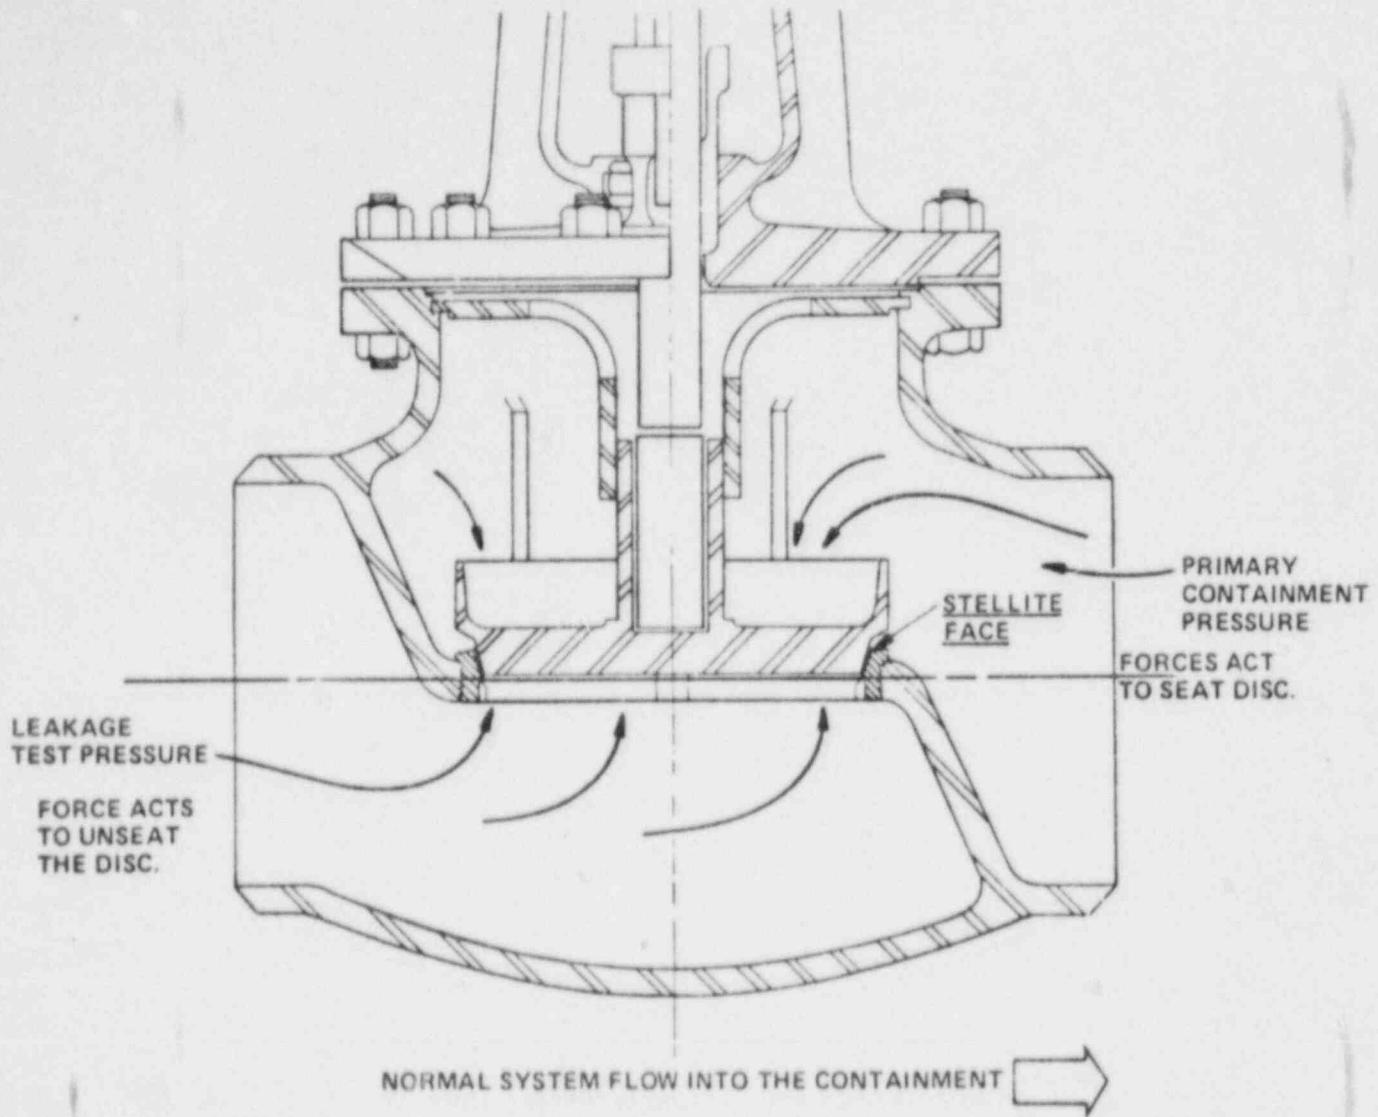


Figure 16 Stop Check Valve, Applicable To  
Valves E51-F001, F002 and E41-F021,F022

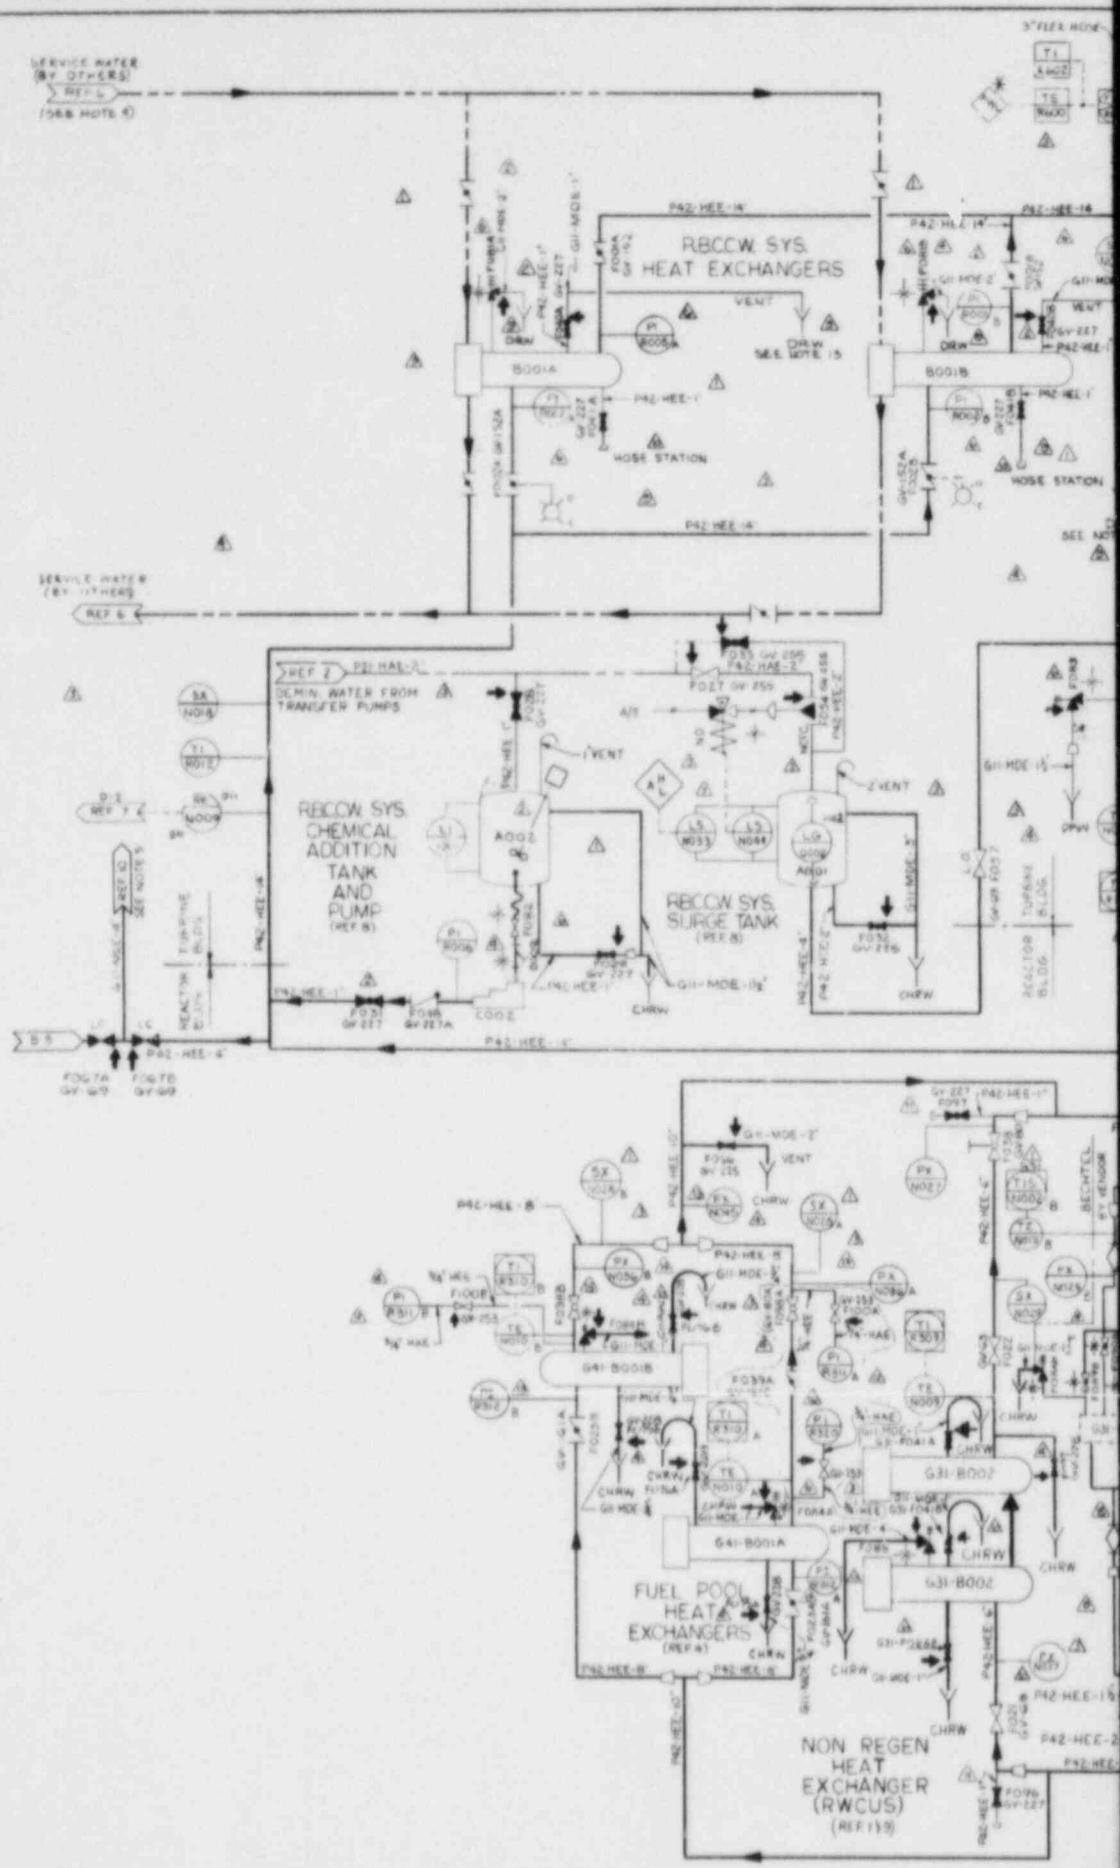

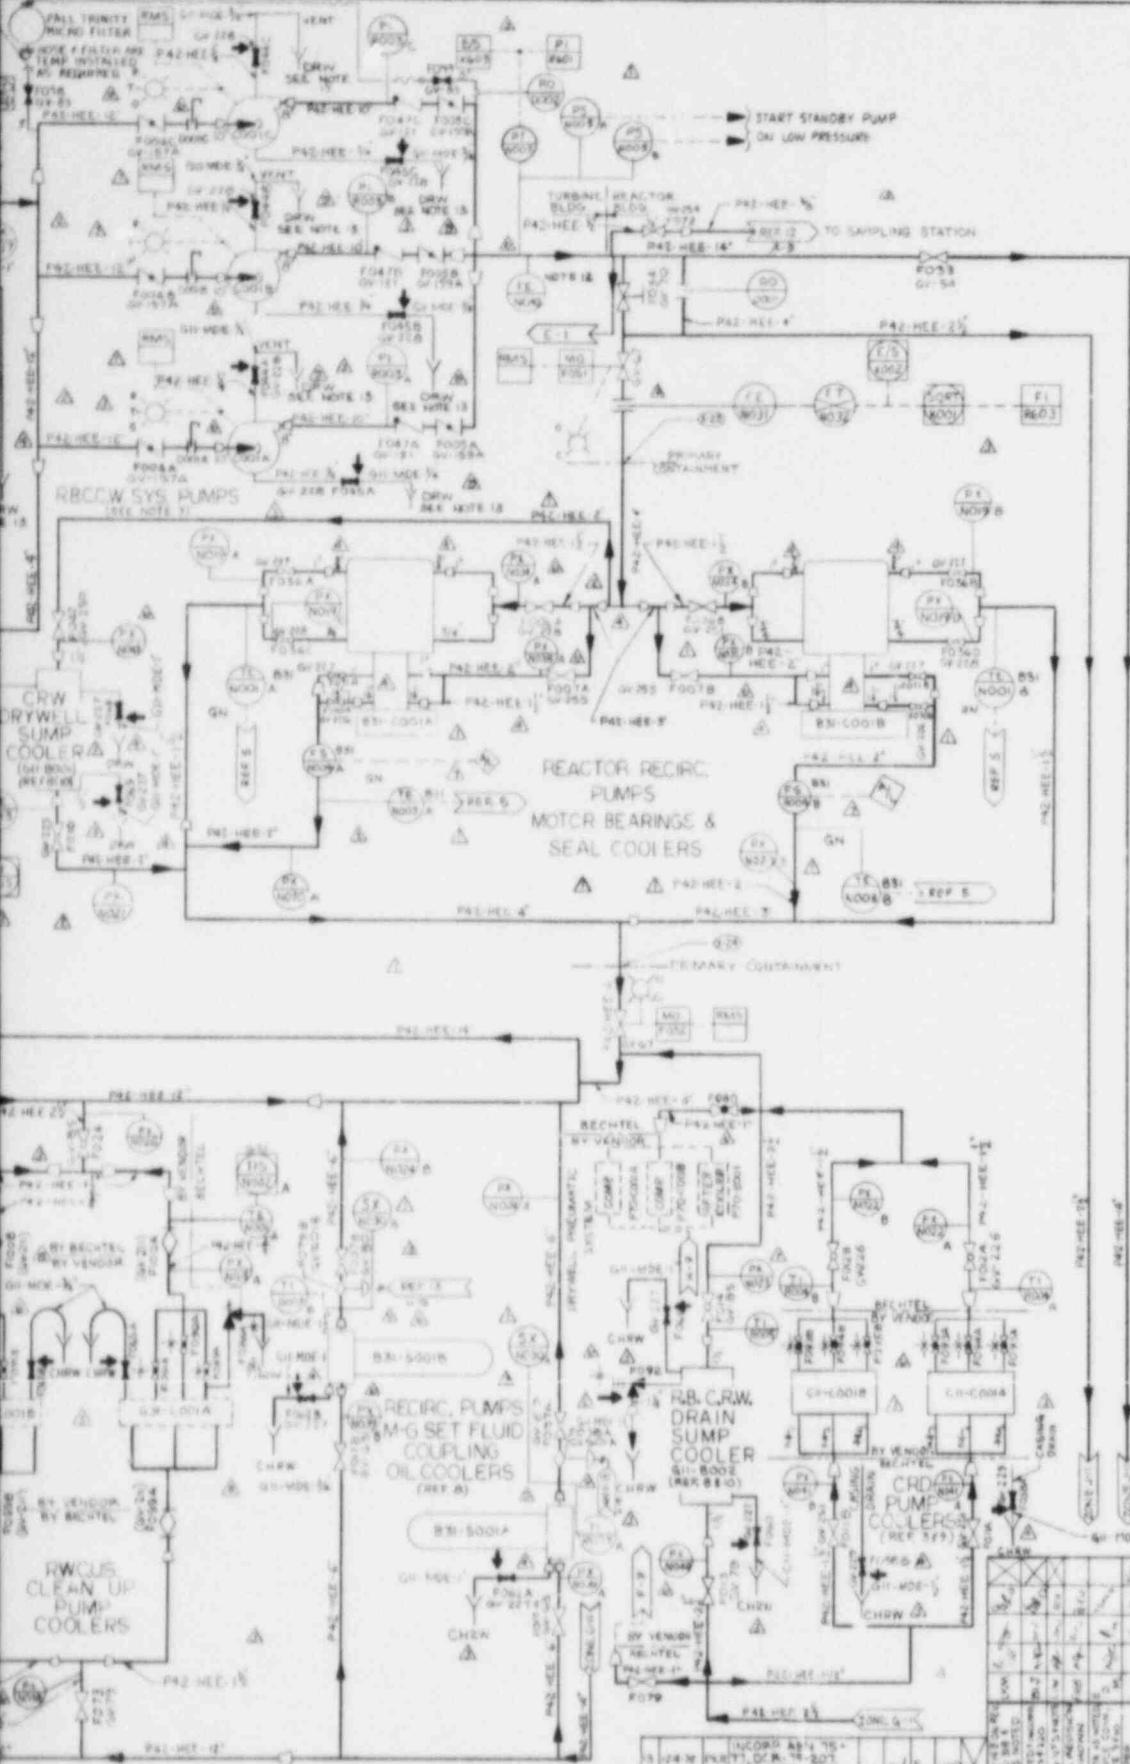

ALL EQUIPMENT IS LOCATED INSIDE THE REACTOR BUILDING EXCEPT FOR THE RBCW SYS HT EXCH. ITEM NO. P42-200 A,B AND THE RBCW SYS PUMPS (ITEM NO. P42-2001A,B).

(NOTES CONTINUED)  
13. UNLESS OTHERWISE INDICATED, DRAINS SHALL BE CONVEYED TO CROW.

#### NOTES

1. ALL ITEM NUMBERS ARE TO BE PREFIXED BY P42 TO COMPLETE MPL LISTING UNLESS SHOWN OTHERWISE.

2. PIPING VENTS & DRAINS ARE TO BE ADDED LATER AT ALL PIPING HIGH POINTS LOW POINTS AS REQUIRED.

3. PUMP CONNECTION SIZES WILL BE SPECIFIED BY THE PUMP MANUFACTURER.

4. VALVES F001, F002, F005, F008, F034, F034, F024, AND F028 SHALL BE LOCATED IN AN AREA THAT IS ACCESSIBLE DURING NORMAL PLANT OPERATION. HANDWHEELS FOR VALVES F008 & F028 SHALL BE ACCESSIBLE DURING NORMAL PLANT OPERATION ALSO.

5. LINE RELATED TO WASTE STORE TANK MAY BE CONNECTED TO RBCW AND DRAIN AS REQUIRED.

6. ALL ALARMS AND INDICATING LIGHTS ARE LOCATED IN THE MAIN CONTROL ROOM.

7. SAMPLE COCKS WILL BE ADDED AS REQUIRED.

8. ANNUNCIATOR LOCATED IN MAIN CONTROL ROOM PANEL A.

9. THE SERVICE WATER PRESSURE MUST BE 6PSI (40KPA) HIGHER THAN THE OUTLET OF THE PRE-OP AT THE HEAT EXCHANGER. THE INSTRUMENTATION FOR THE SERVICE WATER IS TO BE PROVIDED BY OTHER.

10. WHERE GN-NOS ARE SHOWN, THE VALVES ARE TAGGED WITH THESE NOS. WHERE GH-NOS ARE NOT SHOWN THE VALVES ARE TAGGED WITH THE NEL-NOT NOS. THIS TEMP ORDERED BY ESS.

#### REFERENCE

1. P42-1 CLEAN PUMP	03-10-0	H-1618	
2. P42-2 DEMIN WATER PUMP	F201-010	H-1619	
3. P42-3 AU PUMP	G4-1-010	H-1605T	
4. P42-4 FUEL POOL COOLER PUMP	G4-1-011	H-1605Z	
5. P42-5 REFRIGERATION CHILLER	G4-1-012	H-1604	
6. P42-6 PLANT SERVICE WATER TURBINE PUMP	H-11-024		
7. P42-7 PENTEL KIT, NITR	U11-10-01	H-1617	
8. P42-8 PENTEL KIT, NITR	U11-10-02	H-1618	
9. P42-9 PENTEL KIT, NITR	U11-10-03	H-1619	
10. P42-10 PENTEL KIT, NITR	U11-10-04	H-1620	
11. P42-11 PENTEL KIT, NITR	U11-10-05	H-1621	
12. P42-12 PENTEL KIT, NITR	U11-10-06	H-1622	
13. P42-13 PENTEL KIT, NITR	U11-10-07	H-1623	
14. P42-14 PENTEL KIT, NITR	U11-10-08	H-1624	
15. P42-15 PENTEL KIT, NITR	U11-10-09	H-1625	
16. P42-16 PENTEL KIT, NITR	U11-10-10	H-1626	

11. SAMPLE SP51 PUMP & PFM P501-010 H-1618  
12. INVESTIGATE LUB OIL PUMP P501-010 H-1619  
13. DRY WELL PNEUMATIC SVCS P70-1010 H-1628

MPL NO. P42-1010 (REV F100B)

BECTEL ASSOCIATES

JOB 8511


SOUTHERN SERVICES INC.  
FOR


GEORGIA POWER CO., ATLANTA, GA  
GENERAL ENGINEERING DEPARTMENT

EDWIN LATCH NUCLEAR PLANT UNIT NO. 1  
REACTOR BLDG.

CLOSED COOLING WATER SYSTEM P&D

No. DATE BY	REVISIONS	1	2	3	4	5	6	7	8	9	10	11	12	13
1. 12-12-00	INCORP. ABN 11-20	UNKNOWN												
2. 12-12-00	INCORP. ABN 11-20	UNKNOWN												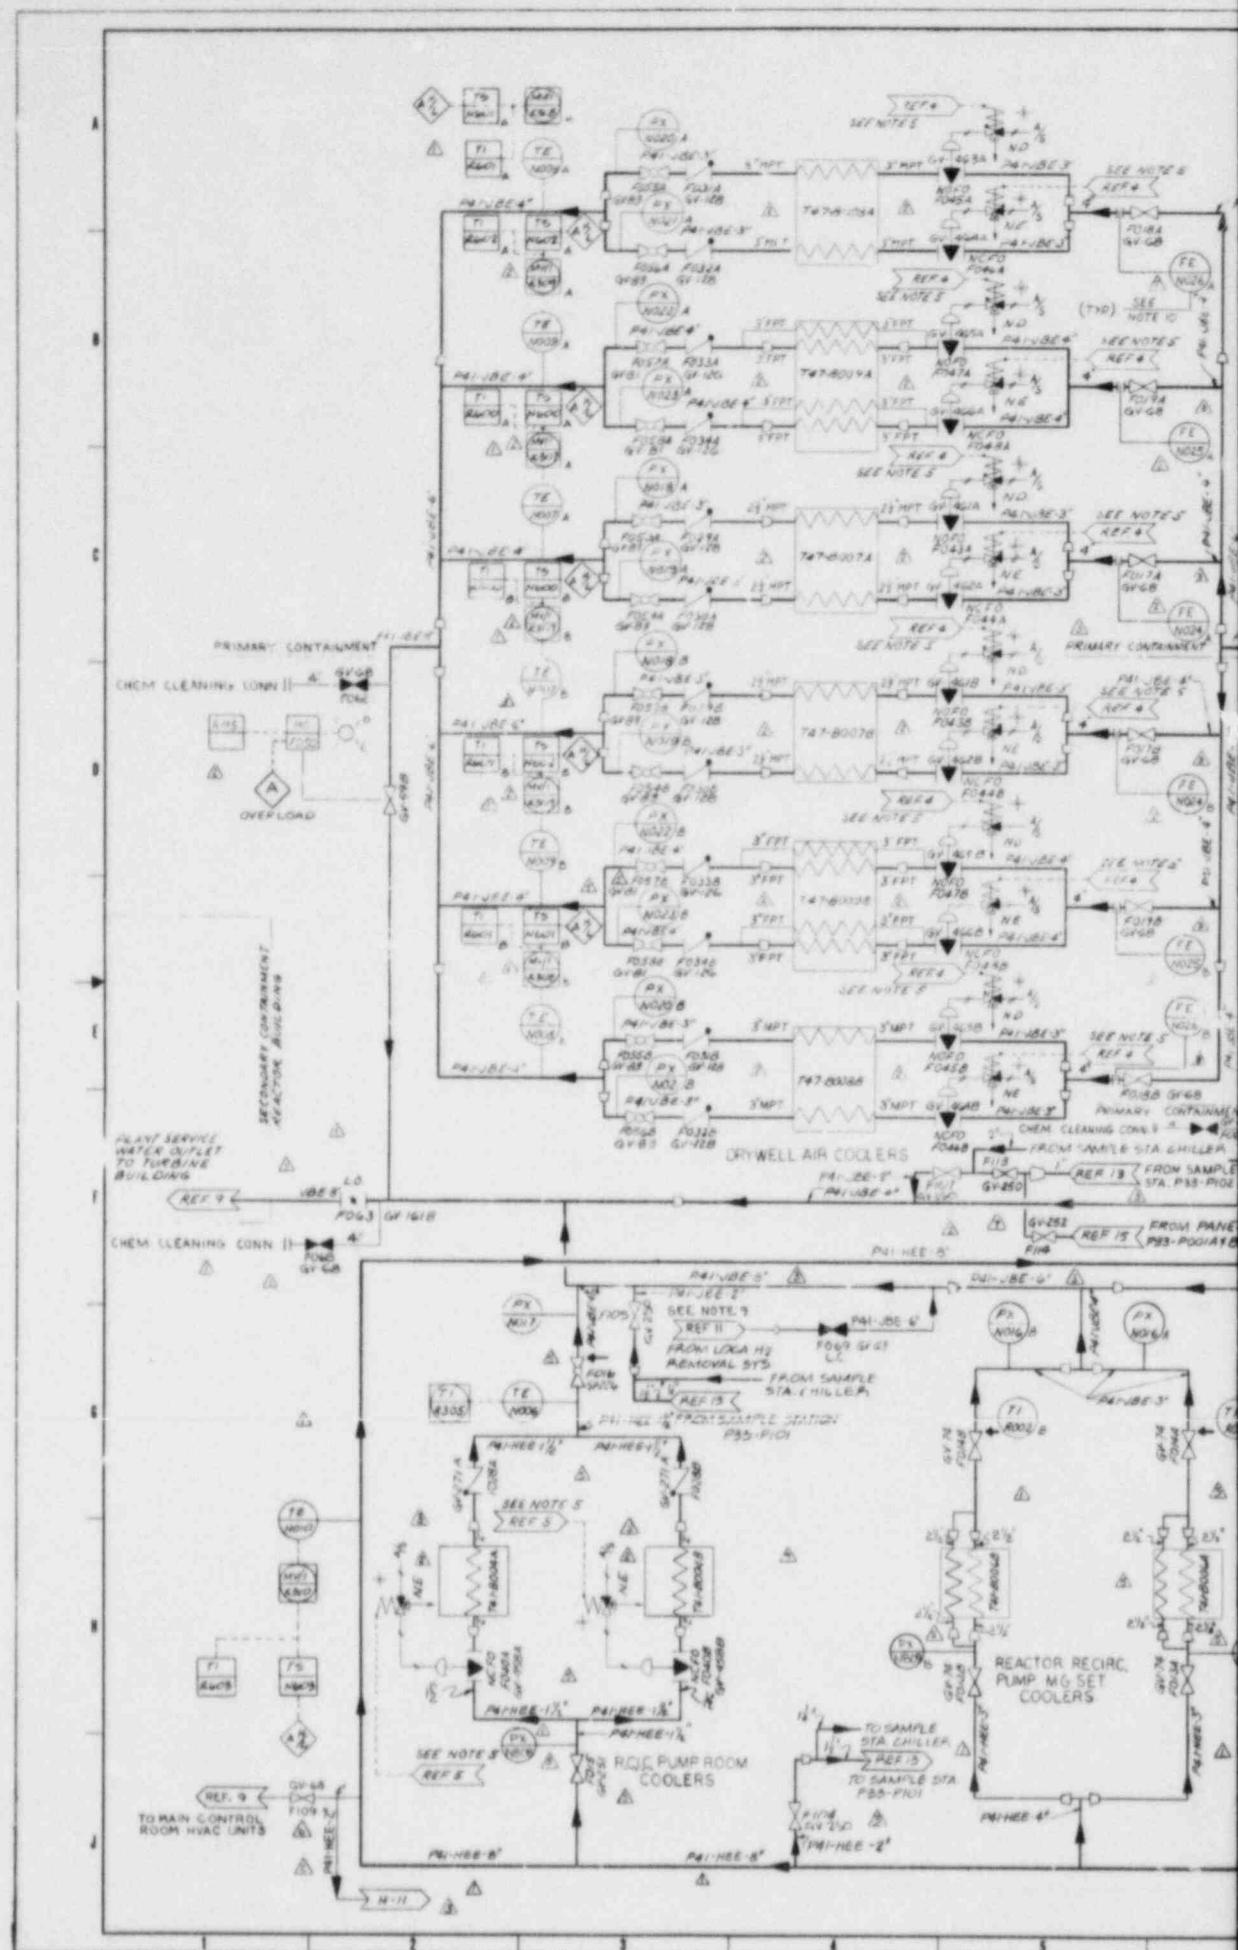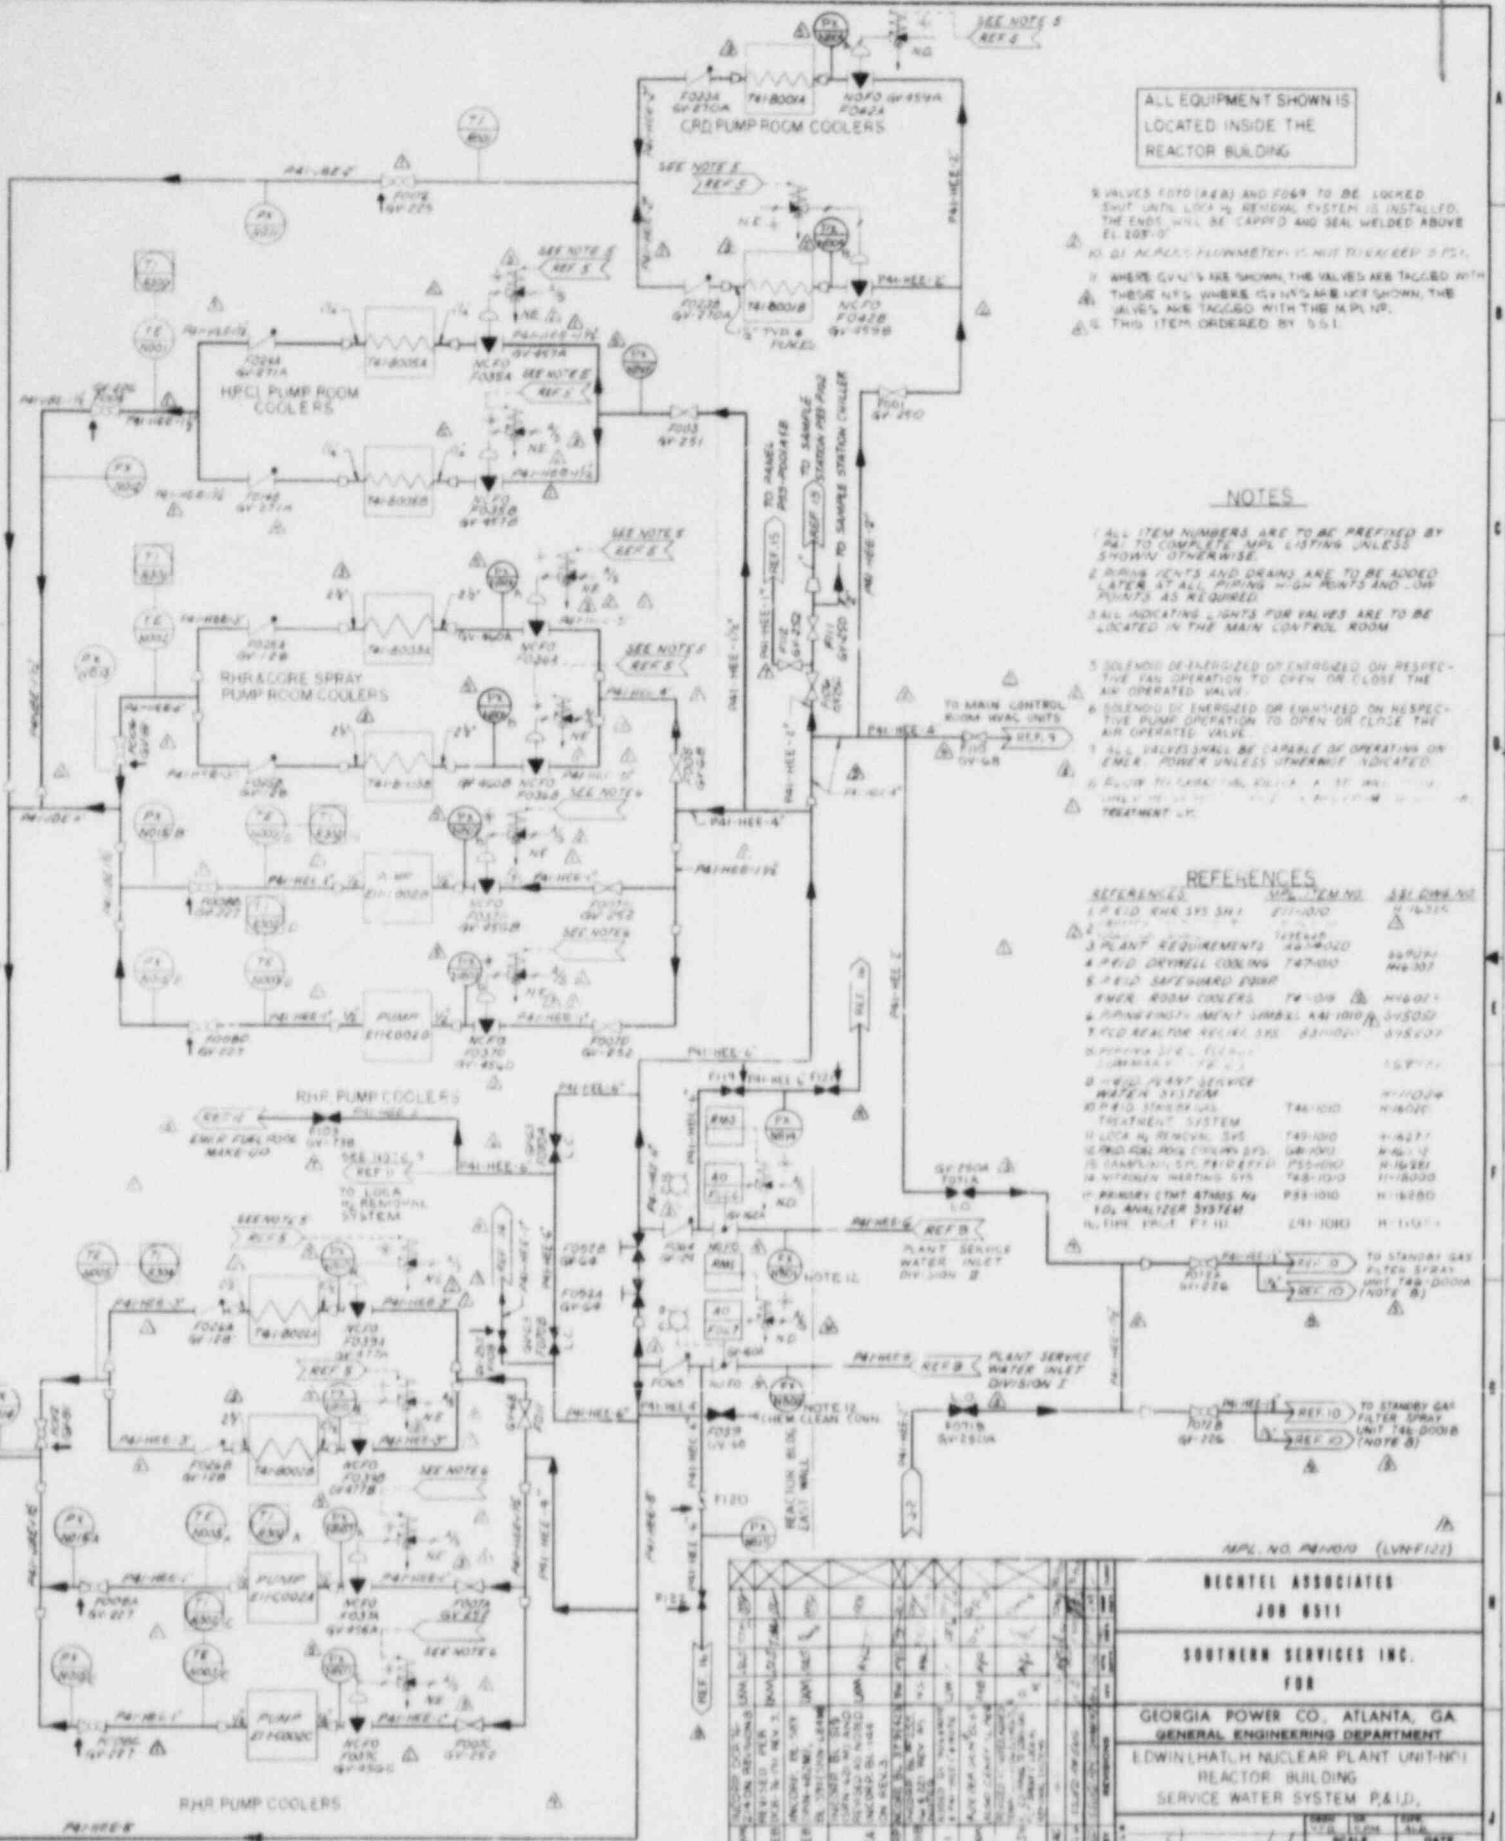
ALL EQUIPMENT SHOWN IS  
LOCATED INSIDE THE  
REACTOR BUILDING

VALVES FOTO (A4B) AND F069 TO BE LOCKED  
SHUT UNTIL LOCA H-1 RECLINER SYSTEM IS INSTALLED.  
THE ENDS WILL BE CAPPED AND SEAL WELDED ABOVE  
EL 208'-0".

KÖRZÉSI ALKALMAZÁSOK KÖRNYEZETI VÉDELEMHEZ

WHERE GUNS ARE SHOWN, THE VALVES ARE TAGGED WITH

THESE NTS WHICH ARE NOT USED  
ARE TAGGED WITH THE M IN NO.

ITEMS ARE PRICED WITH THE  
ONE ITEM ORDERED BY \$61

## NOTES

ALL ITEM NUMBERS ARE TO BE PREFIXED BY  
PAI TO COMPLETE MPL LISTING UNLESS  
SHOWN OTHERWISE.

2. PIPING JOINTS AND DRAINS ARE TO BE ADDED LATER AT ALL PIPING HIGH POINTS AND LOW POINTS AS REQUIRED.

ALL INDICATING LIGHTS FOR VALVES ARE TO BE LOCATED IN THE MAIN CONTROL ROOM

5 SOLENOID DE-ENERGIZED OR ENERGIZED ON RESPECTIVE FAN OPERATION TO OPEN OR CLOSE THE AIR OPERATED VALVE.

6 SOLENOID DE ENERGIZED OR ENERGIZED ON RESPECTIVE PUMP OPERATION TO OPEN OR CLOSE THE AIR OPERATED VALVE.

ALL VALVES SHALL BE CAPABLE OF OPERATING ON  
ELETRIC POWER UNLESS OTHERWISE SPECIFIED.

卷之三十一

1992-1993 学年第一学期期中考试卷

#### TREATMENT - II

## REFERENCES.

REFERENCE	ITEM NO.	DESCRIPTION
P-010 RHR 315 SH1	747-000	N-747-00
P-010 PLANT REQUIREMENTS	747-000	A
P-010 COOLING	747-000	B-747-00
P-010 SAFEGUARD EQUIP	747-000	M-747-00
P-010 ROOM COOLERS	747-000	D-747-00
P-010 VENTILATION SYSTEM	747-000	S-747-00
P-010 REACTOR REACT. 315	747-000	S-747-00
P-010 PLANT SERVICE		
P-010 WATER SYSTEM		
P-010 STAINLESS	747-100	H-747-00
P-010 TREATMENT SYSTEM		
P-010 LIQUID HEATING	747-100	F-747-00
P-010 LIQUID COOLING	747-100	G-747-00
P-010 CAMPBELL STAINLESS	747-100	H-747-00
P-010 VAPOR HEATING	747-100	I-747-00
P-010 CHIMNEY	747-100	J-747-00
P-010 ANALYZER SYSTEM	747-100	K-747-00
P-010 FUEL PUMP	747-100	L-747-00

MPU NO. 810000 (VME12)


BECHTEL ASSOCIATES  
JDR 8511


SOUTHERN SERVICES INC.  
FOR

GEORGIA POWER CO., ATLANTA, GA.  
GENERAL ENGINEERING DEPARTMENT

**EDWIN HATCH NUCLEAR PLANT UNIT NO. 1  
REACTOR BUILDING  
SERVICE WATER SYSTEM PADS**

SERVICE WATER SYSTEM P&I.D.	
NAME OR TITLE	DATE
SCALING NOTES	7-13-0
DRAWING NUMBER	
LOCATION	SHEET
10-502	H-4601

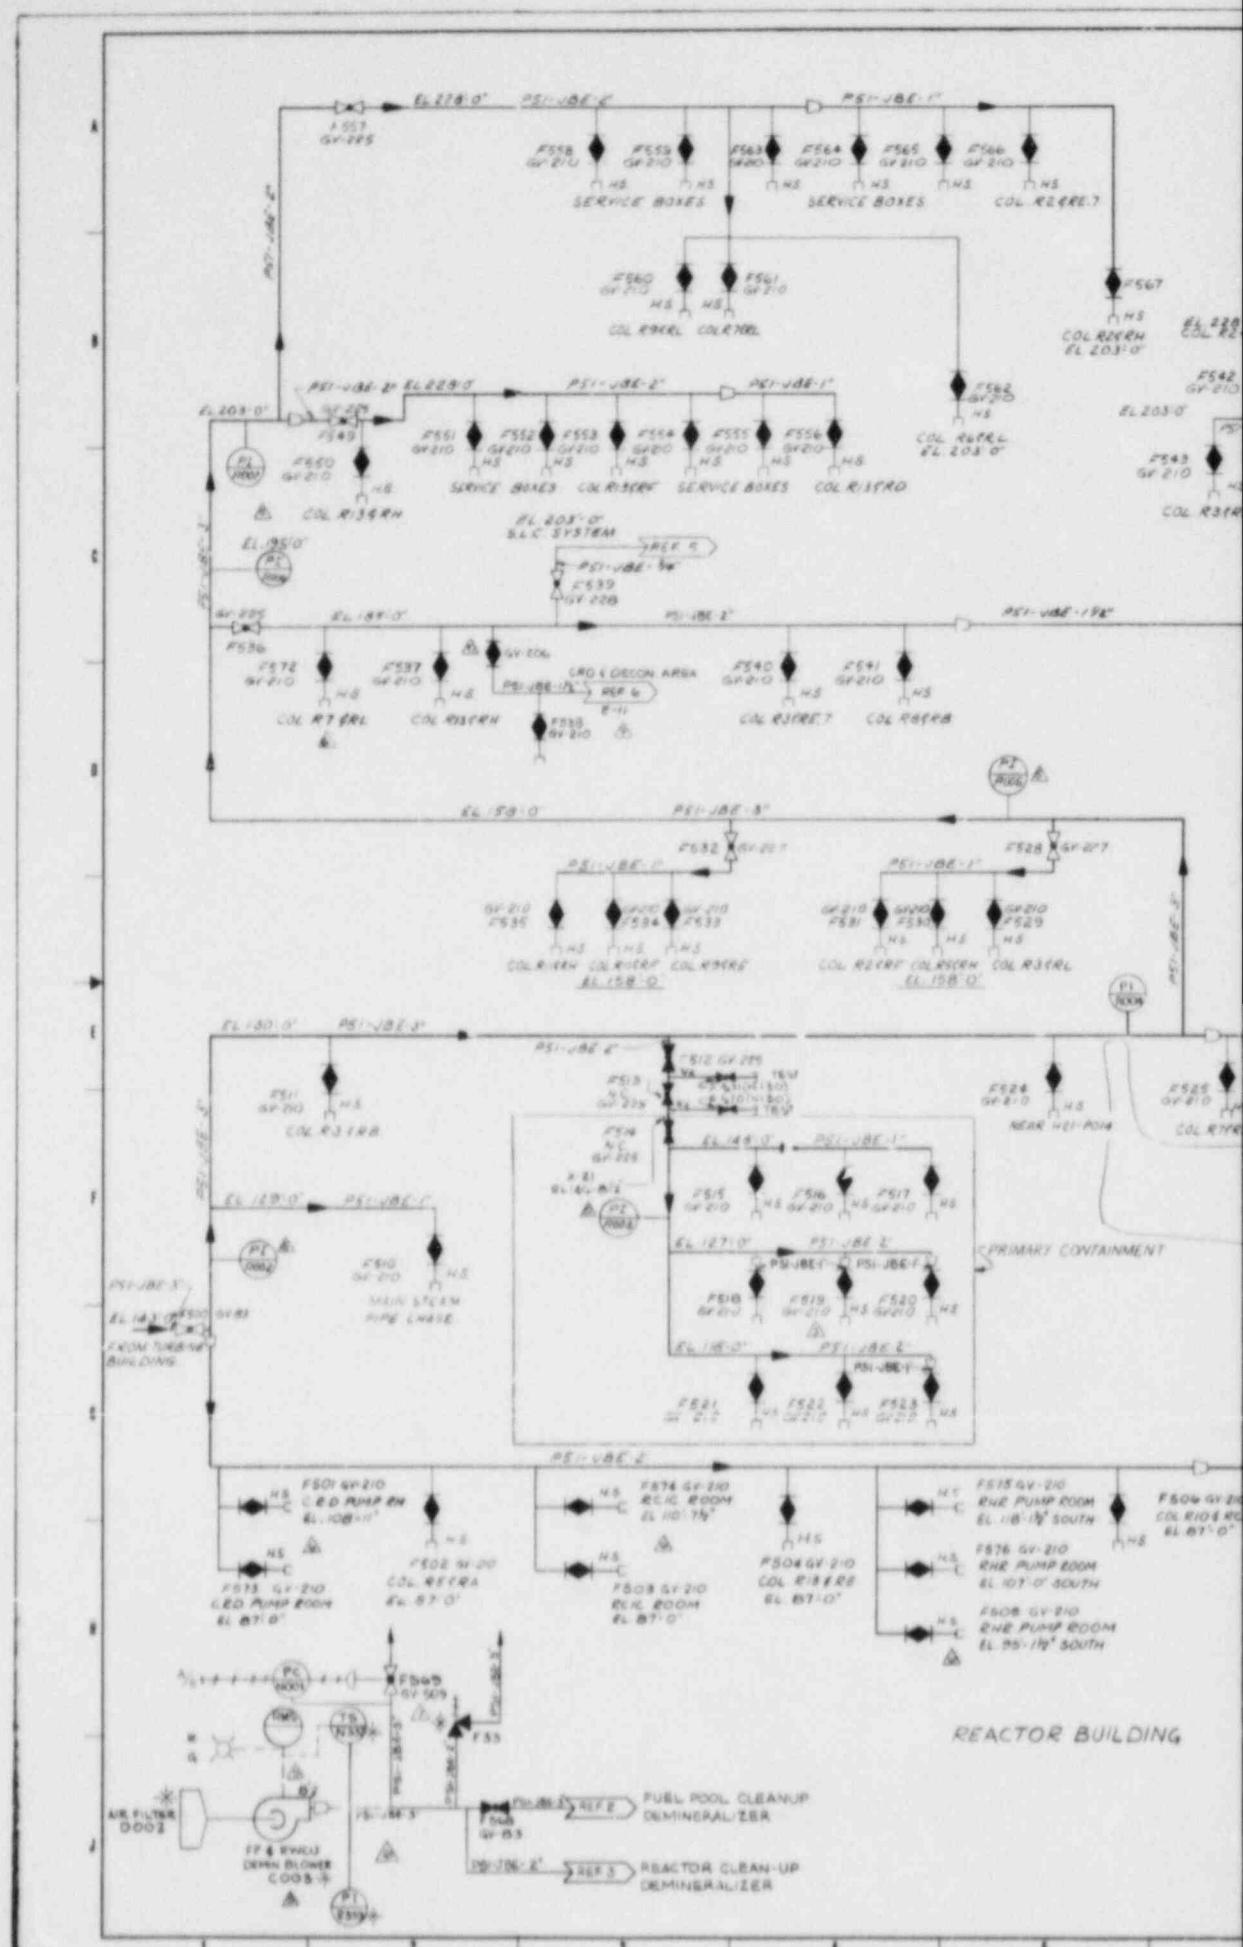

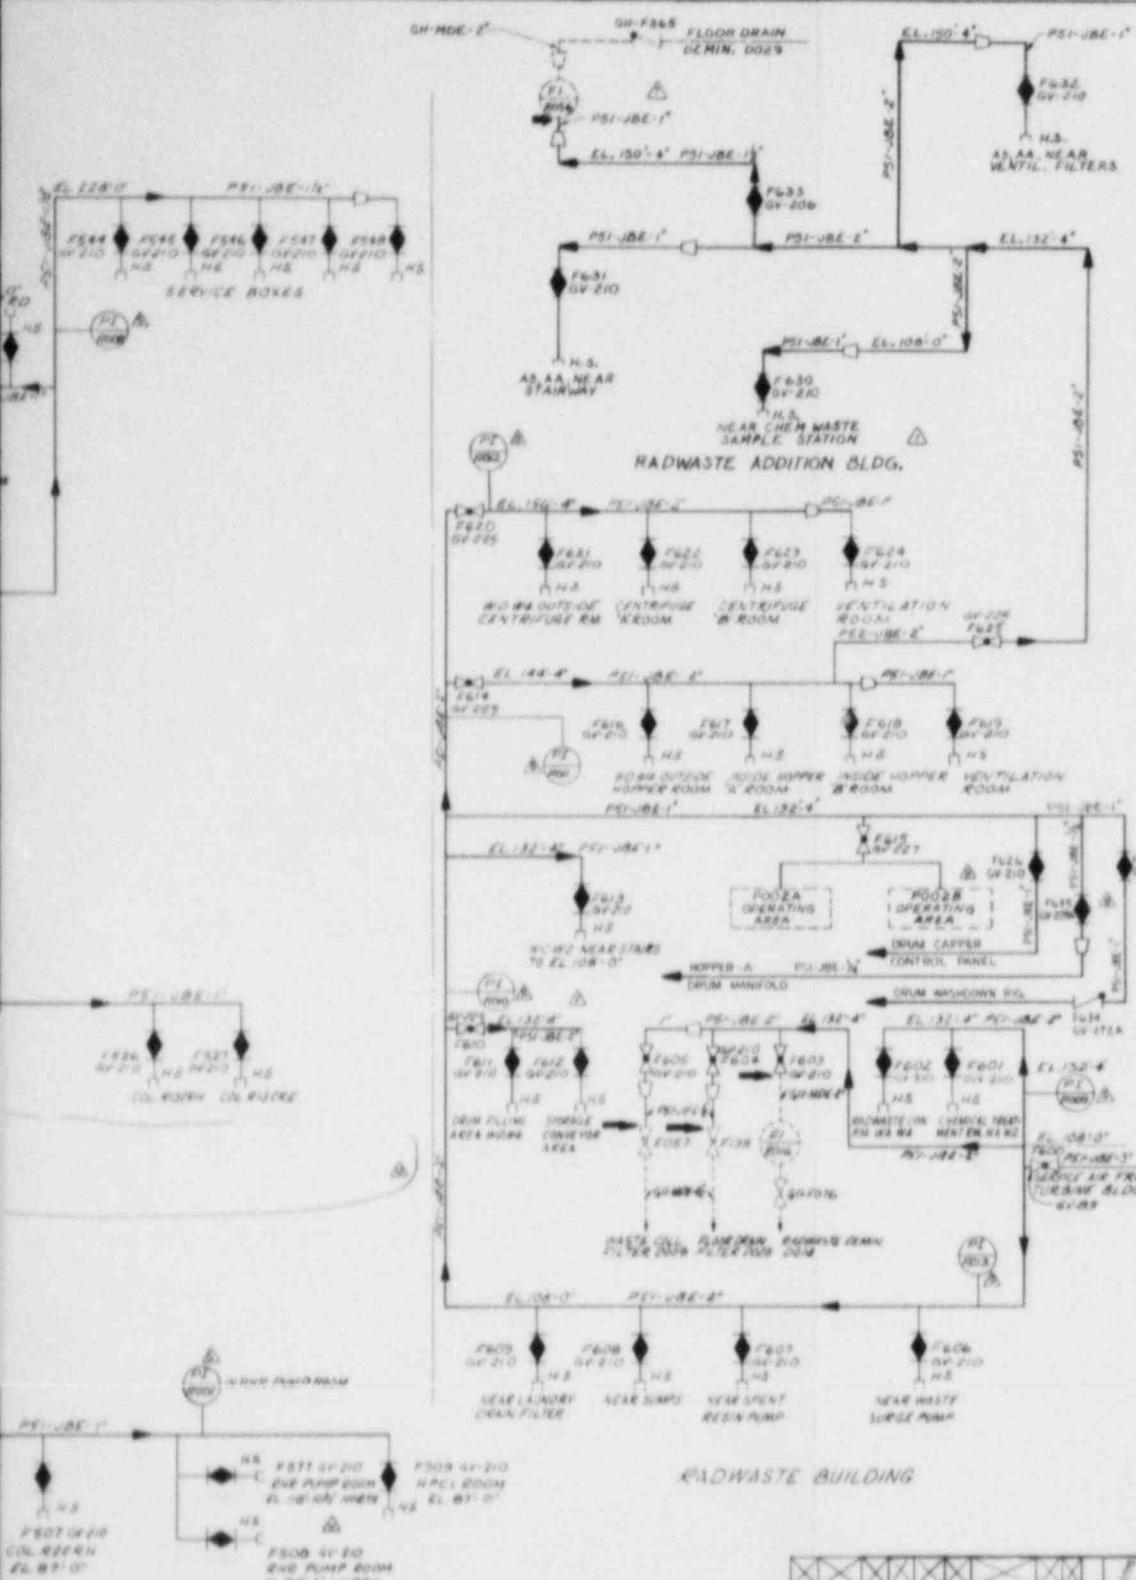

NOTES  
1 ALL ITEM NUMBERS TO BE PREFIX BY PSI TO  
COMPLETE API LISTING UNLESS SHOWN  
OTHERWISE.  
2 ALL HOSE STATIONS/HDS ARE PER JOB IT UNLESS  
SHOWN OTHERWISE.  
3 WHERE G/F NO'S ARE SHOWN THE VALVES ARE TAGGED  
WITH THESE NO'S. WHERE G/F NO'S ARE NOT SHOWN  
THE VALVES ARE TAGGED WITH THE API NO.  
4 THE ASTERISK (\*) INDICATES EQUIPMENT ORDERED  
BY API.

#### REFERENCES

REFERENCES	MPL ITEM NR.	SS.DRQ.NR.
REFD. RADWASTE SYS.	G-11-100	H-16-007
2.REFD. FUEL POOL F10-SYS.	G-10-1020	H-16-003
3. REACTOR AFTER CLEAN-UP SYS.	G-10-1010	H-16-008
4. REF'D. NITROGEN INERTING	T-48-1000	H-16-000
SYS.		
5.REFD. STANDBY LI-QUEO.	G-10-1010	H-16-001
CONTROL SYSTEM		
6. REF'D. DECONTAMINATION	D-40-1010	H-16-012
FACILITY		

140-148-1202 (LVNRB F573) 6

BECHTEL ASSOCIATES

JOB 8511

SOUTHERN SERVICES INC.

F 0 1


**GEORGIA POWER CO., ATLANTA, GA.**  
**GENERAL ENGINEERING DEPARTMENT**


**EDWIN L HATCH NUCLEAR PLANT UNIT NO. 1  
REACTOR & RADWASTE BUILDINGS  
SERVICE AND SYSTEMS INC.**

REAR  
WHEEL

BL-7-J-100	00002	NONE	11/1970
		DRAWINGS NUMBER	
		LOCATION	SHEET N
		10-502	H-1601

12 | Page

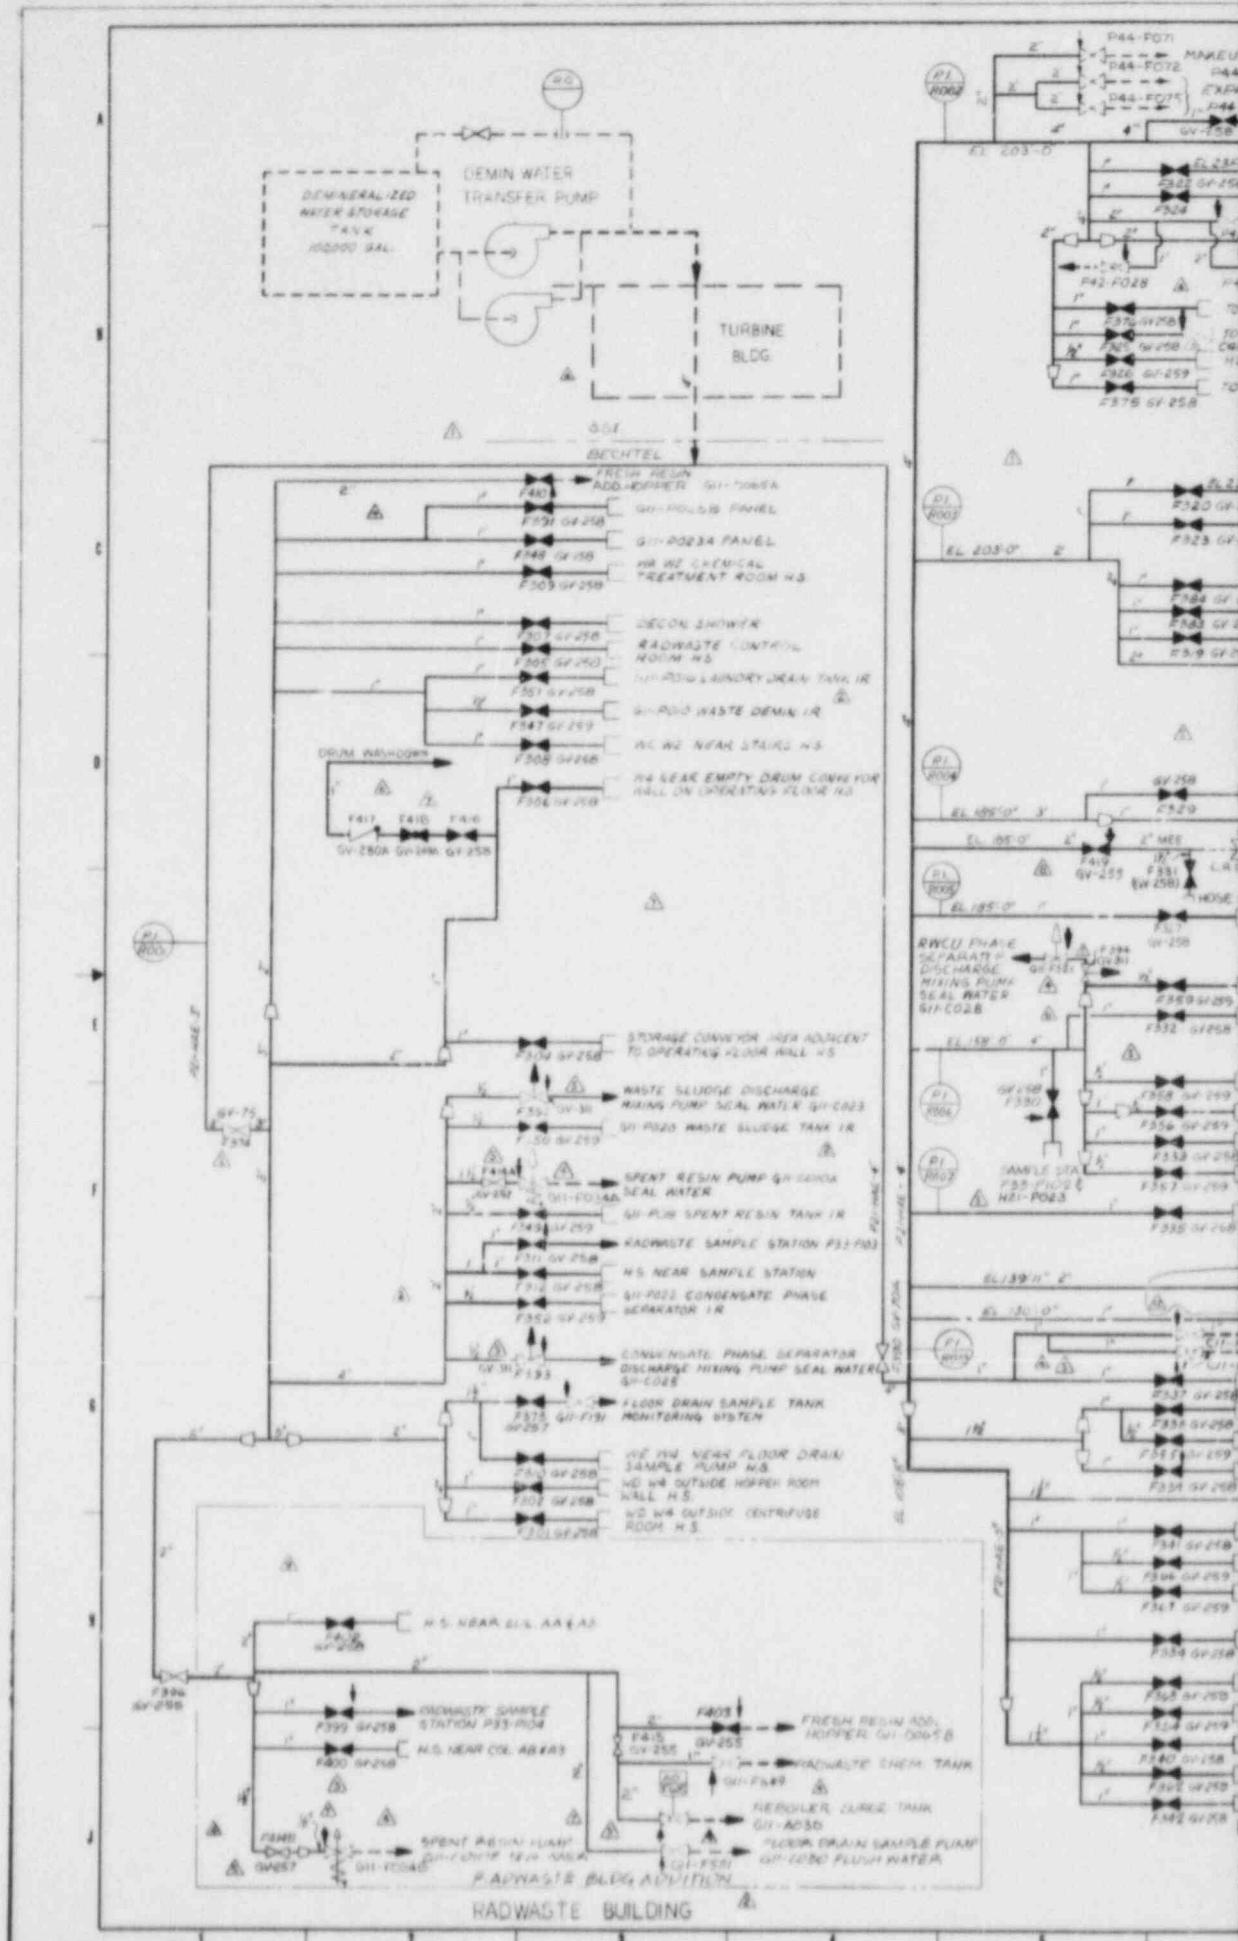


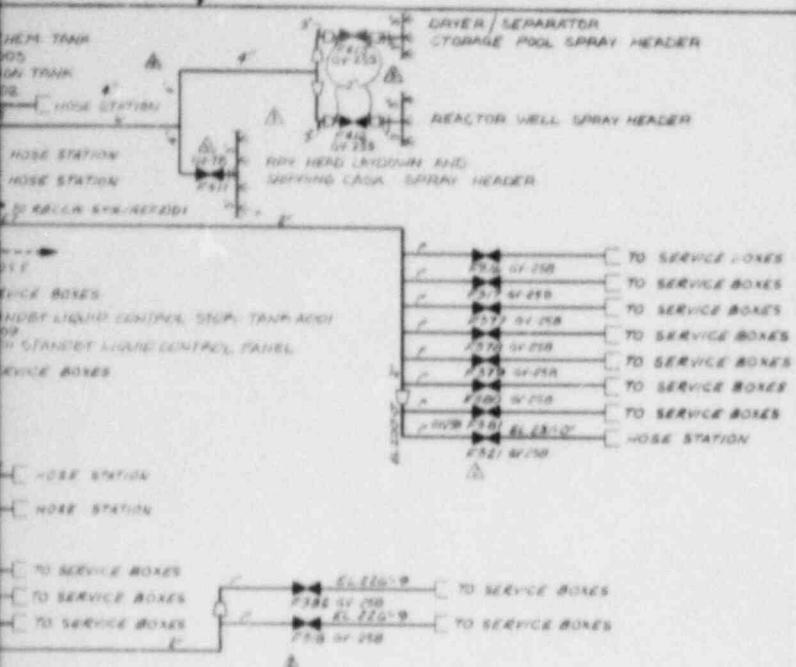

## NOTES

1. HS - HOSE STATION
  2. IRI - INSTRUMENT RACK
  3. UNLESS OTHERWISE NOTED, ALL PIPE IN THIS SYSTEM IS IRG
  4. ALL EQUIPMENT AND INSTRUMENTS ON THIS DRAWING PRECEDED BY MFC NR P21 UNLESS OTHERWISE NOTED.
  5. LOCATIONS OF HIGHPOINT VENTS AND LOWPOINT DRAINS TO BE DETERMINED BY PHYSICAL PIPING ARRANGEMENT.
  6. MOMENTARY PUSH BUTTON SW-7CH LOCATED IN CONVENTIONAL SYSTEM OPERATING AISLE NEAR PUMP MOTOR SCREW POSITION.

WHERE GRADS ARE SHOWN THE VALUES ARE TRIMMED  
WITH THESE NOT WHERE GRADS ARE NOT SHOWN THE  
VALUES ARE TRIMMED WITH THE MPG HD.

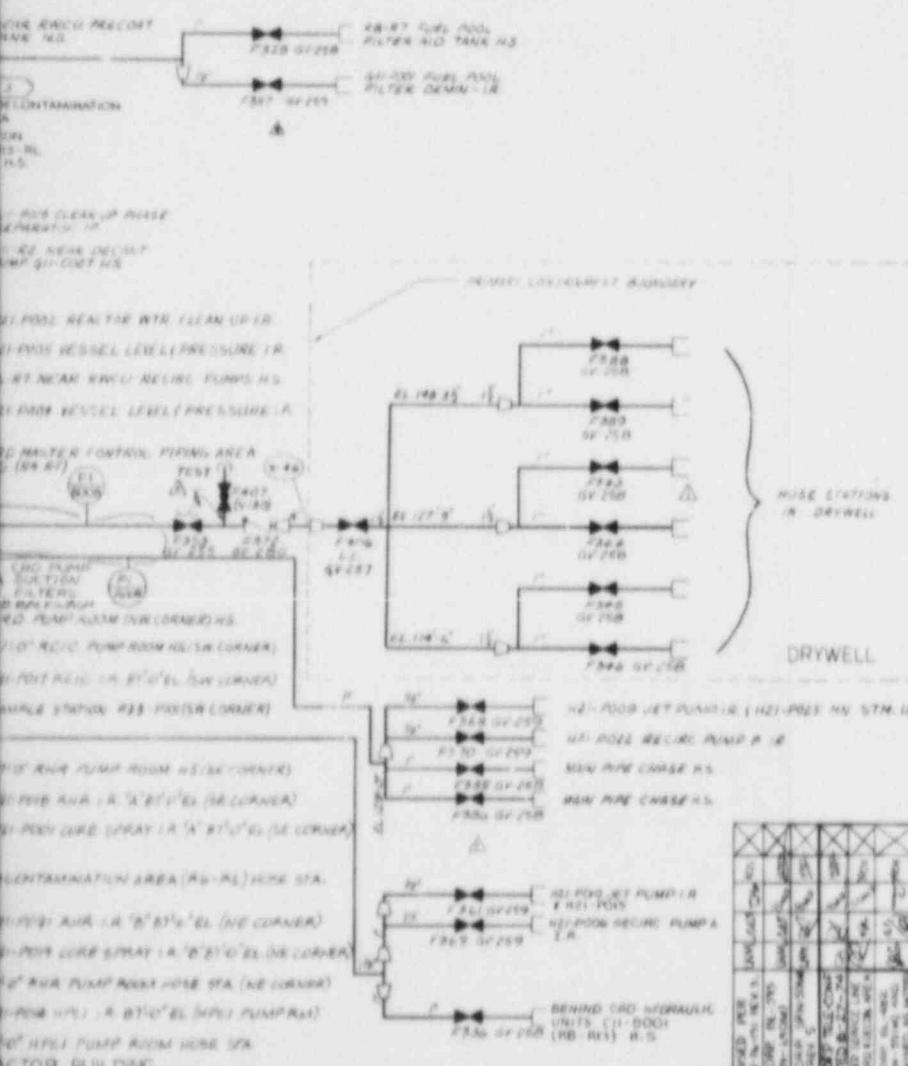

#### REFERENCES

REFERENCES	NUMBER	DATE
1 STANLEY W-4000 CATIONIC SYS	C40-1010	H-16061 B
2 REACTOR BLOC CLOSED COOLING WATER SYSTEM	A42-1010	H-16009
3 DECONTAMINATION	D40-1010	H-16112


DOI: 10.1109/TPDS.2019.2913123


WEIGHTEL ASSOCIATES  
1000 BOSTON

SOUTHERN SERVICES INC.

GEORGIA POWER CO., ATLANTA, GA.  
GENERAL ENGINEERING DEPARTMENT  
EDWIN L HATCH NUCLEAR PLANT UNIT #1  
REACTOR BUILDING DEMINERALIZED  
WATER SYSTEM DIAGRAM & FIELD

<i>John Tefco</i>	MRA	EPA	ALA
	NAME	NAME	4/20/70
	MANUFACTURER NUMBER		
	LOCATION	I-502	SHEET NO.
			1-HG005

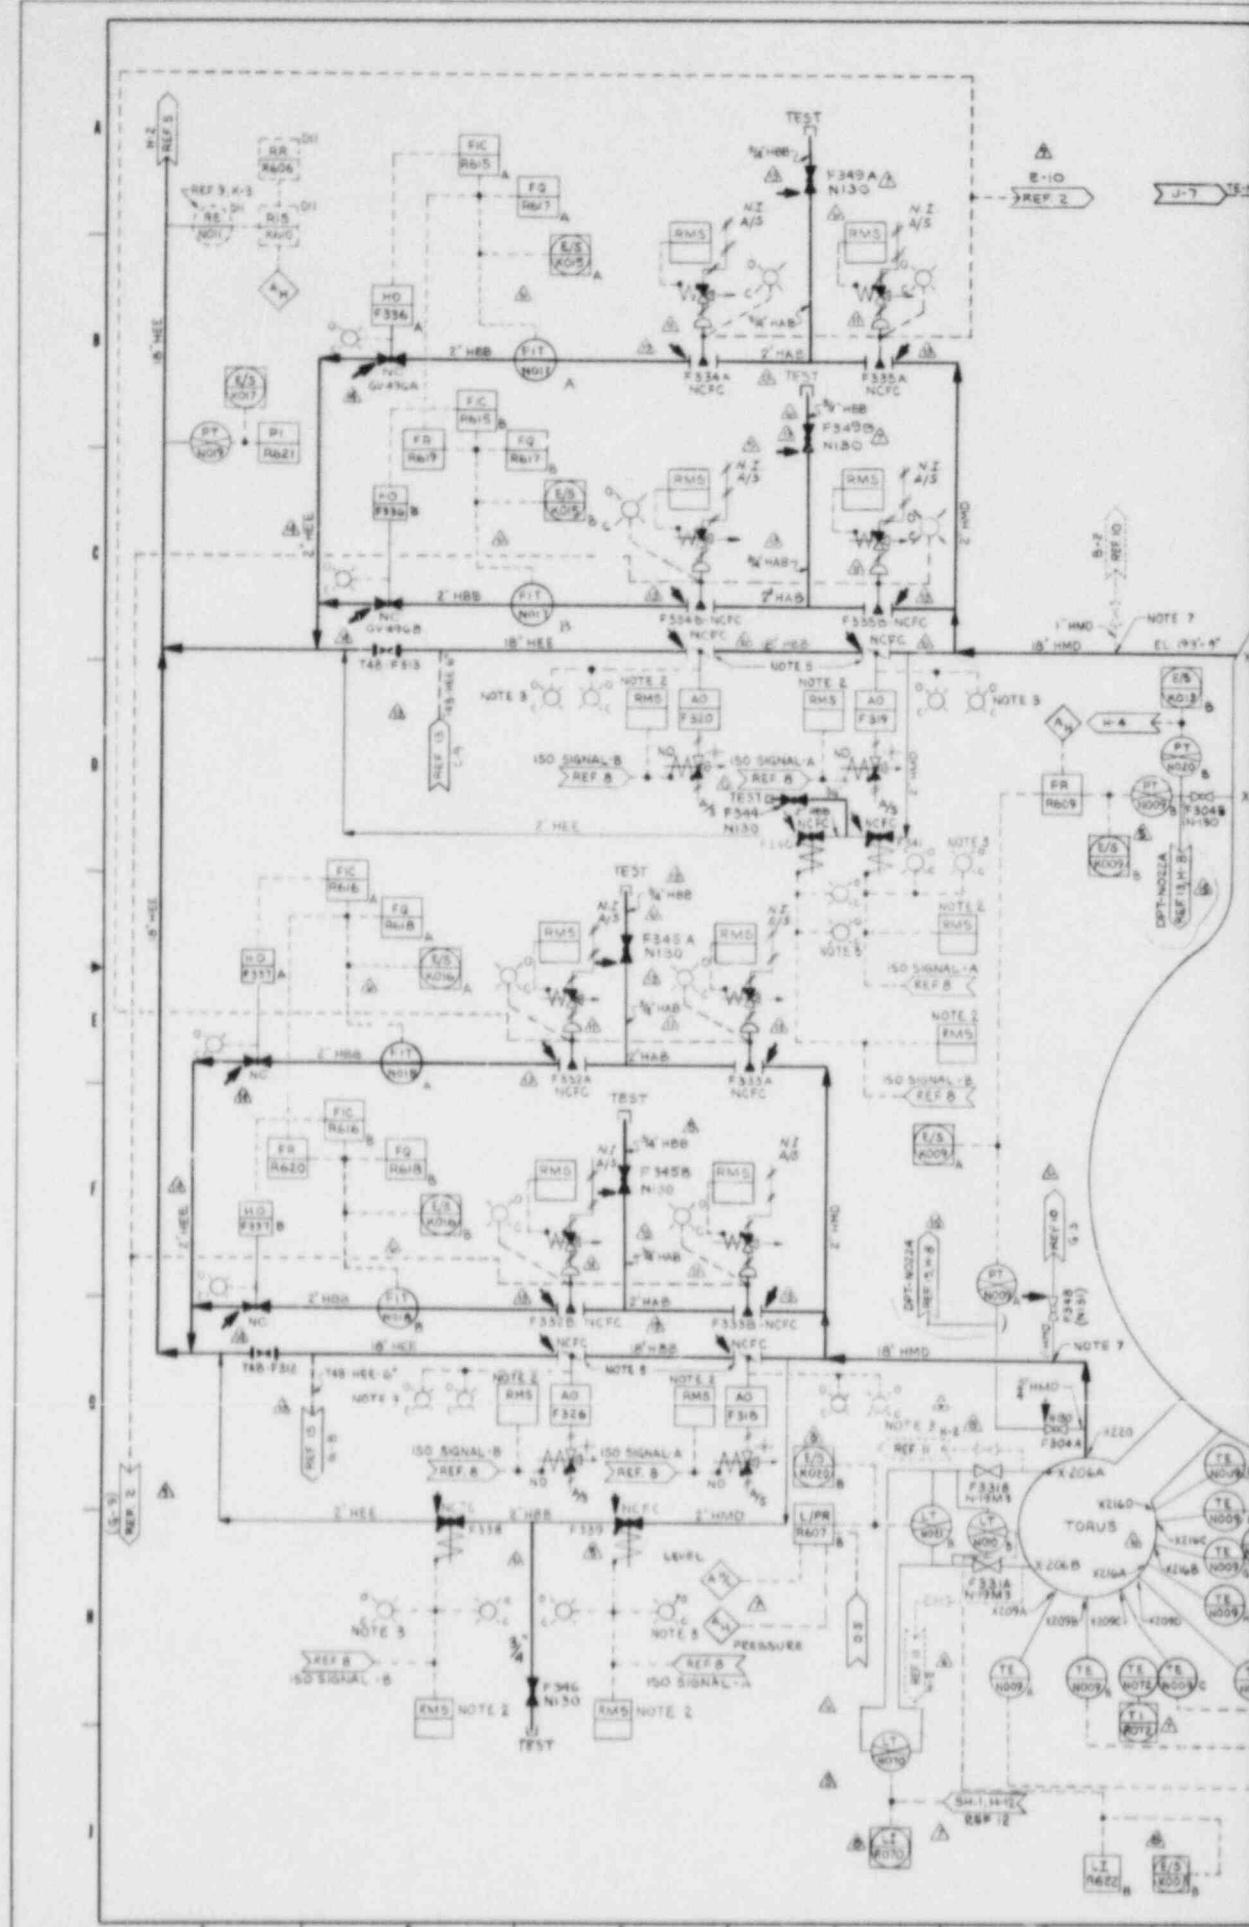

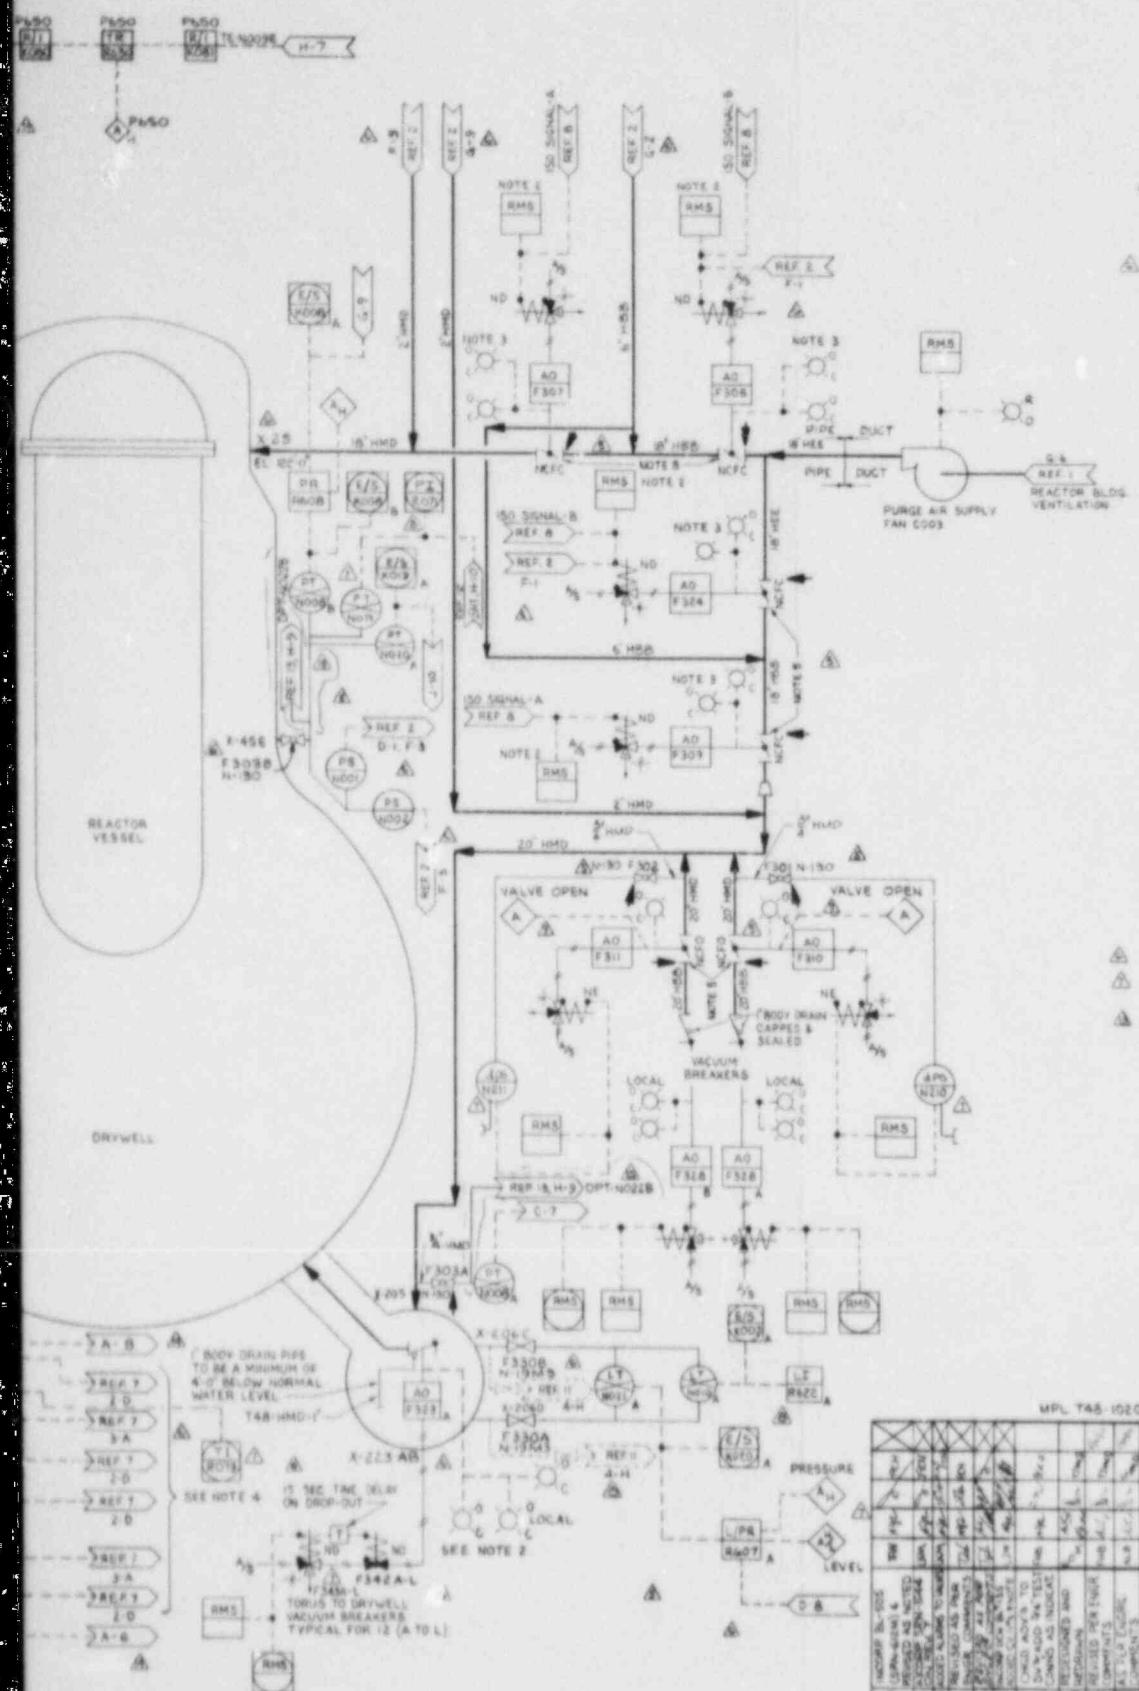

## NOTES

- EQUIPMENT AND INSTRUMENT NOS. ON THIS DWG. PRECEDED BY TAG, EXAMPLE: TAG-2003 EXCEPT AS INDICATED. SEE NOTES 2 & 3.
  - SWITCHES AND LIGHTS INDICATED BY THIS NOTE ARE PART OF THE P.C.I.S. SYSTEM (PRIMARY CONTAINMENT ISOLATION SYSTEM) MPL C61 AND ARE MOUNTED ON BENCHBOARD HII-P602.
  - INDICATING LIGHTS LOCATED ON GRAPHIC DISPLAY ON BENCHBOARD HII-P601.
  - TEMPERATURE ELEMENTS ARE INPUT TO A RECORDER SHOWN ON REF. 7.
  - LEAKOFF CONNECTION ON VALVE TO BE USED FOR LOCAL LEAK RATE TESTING.
  - WHERE GNO'S ARE SHOWN THE VALVES ARE TAGGED WITH THESE NOS. WHERE GNO'S ARE NOT SHOWN, THE VALVES ARE TAGGED WITH THE MPL NO.
  - SAMPLE POINT CONNECTION ON VENT PURGE OUTLET LINE IS TO BE LOCATED AS CLOSE TO THE TORUS AND DRYWELL AS POSSIBLE; PROBABLY AT THE BOTTOM OF THE 20" X 18" REDUCER ON THE DRYWELL SIDE OF THE LINE.

#### REFERENCES

REFERENCE	MPL NO.	SS NO.
1. REACTOR BUILDING VENTILATION FLOW DRAG	T41-1040	H-16005
2. NITROGEN INERTING SYSTEM P&ID	T48-1010	H-16000
3. PIPING & INSTRUMENT 3.1BOL5	A41-1010A	S-15051
4. PHR SYS. P&ID	E11-1010	H-16529
5. STANDBY GAS TREATMENT SYSTEM	T48-1010	H-16020
6. REACTOR BUILDING VENTILATION P&ID	T41-1020	H-16005
7. DRYWELL COOLING SYSTEM P&ID	T47-1010	H-16007
8. PRIMARY CONTAINMENT ISOLATION SYSTEM	CII-1040	H-17501-805
9. PROCESS RADIATION MONITORING SYSTEM	DII-1010	S-17790
10. H2OLANL SYS. P&ID	P33-1010	H-16276
11. HPCI SYS. P&ID	E41-1010	H-16332
12. ELCG SYS. P&ID	E51-1010	H-16254
13. DRYWELL TO TORUS DIFFERENTIAL PRESSURE SYSTEM P&ID	T48-1030	H-16158


15 4/8/77	UKM	INCORP BL-618(SRN-702C) LDM 4/8/77-110	LKM	DATE RECEIVED																								
14 4/10/77	UKP	INCORP TELECON DATED 4/16 EXCR 74-119	LKM	DATE RECEIVED																								
15 3/17/77	CA	ADDED TORUS TO DRY WELL OF SIS ISOLATION VALVES E RELOCATED. (4) E BY PASS E CAD THIS THE-10 REVISED PER ENHRS COMMENTS	LKM	DATE RECEIVED																								
15 3/17/77	CA	INCORP SRN-SUMMONS REV. B DRAFTED BY REVISIONS	LKM	DATE RECEIVED																								
MPL TABS-1020																												
BECHTEL ASSOCIATES 108-8511																												
SOUTHERN SERVICES INC.																												
FOR																												
GEORGIA POWER CO., ATLANTA, GA.																												
GENERAL ENGINEERING DEPARTMENT																												
EDWIN L HATCH NUCLEAR PLANT UNIT NO 1 PRIMARY CONTAINMENT PURGE & INERTING SYSTEM P&ID																												
<table border="1"> <tr> <td>PRINT</td> <td>REV.</td> <td>DATE</td> <td>FILED</td> </tr> <tr> <td>4/16/77</td> <td>1</td> <td>4/16/77</td> <td>4/16/77</td> </tr> <tr> <td colspan="2">DRAWING NUMBER</td> <td colspan="2">SHEET NO.</td> </tr> <tr> <td colspan="2">10-5402</td> <td colspan="2">1</td> </tr> <tr> <td colspan="2">LOCATION</td> <td colspan="2">DRAWING NUMBER</td> </tr> <tr> <td colspan="2">10-5402</td> <td colspan="2">1</td> </tr> </table>					PRINT	REV.	DATE	FILED	4/16/77	1	4/16/77	4/16/77	DRAWING NUMBER		SHEET NO.		10-5402		1		LOCATION		DRAWING NUMBER		10-5402		1	
PRINT	REV.	DATE	FILED																									
4/16/77	1	4/16/77	4/16/77																									
DRAWING NUMBER		SHEET NO.																										
10-5402		1																										
LOCATION		DRAWING NUMBER																										
10-5402		1																										


REPTILE ASSOCIATES

100 8511


SOUTHERN SERVICES, INC.


GEORGIA POWER CO., ATLANTA, GA.  
GENERAL ENGINEERING DEPARTMENT  
EDWIN L HATCH NUCLEAR PLANT UNIT NO 1  
PRIMARY CONTAINMENT PURGE &  
INERTING SYSTEM PAID

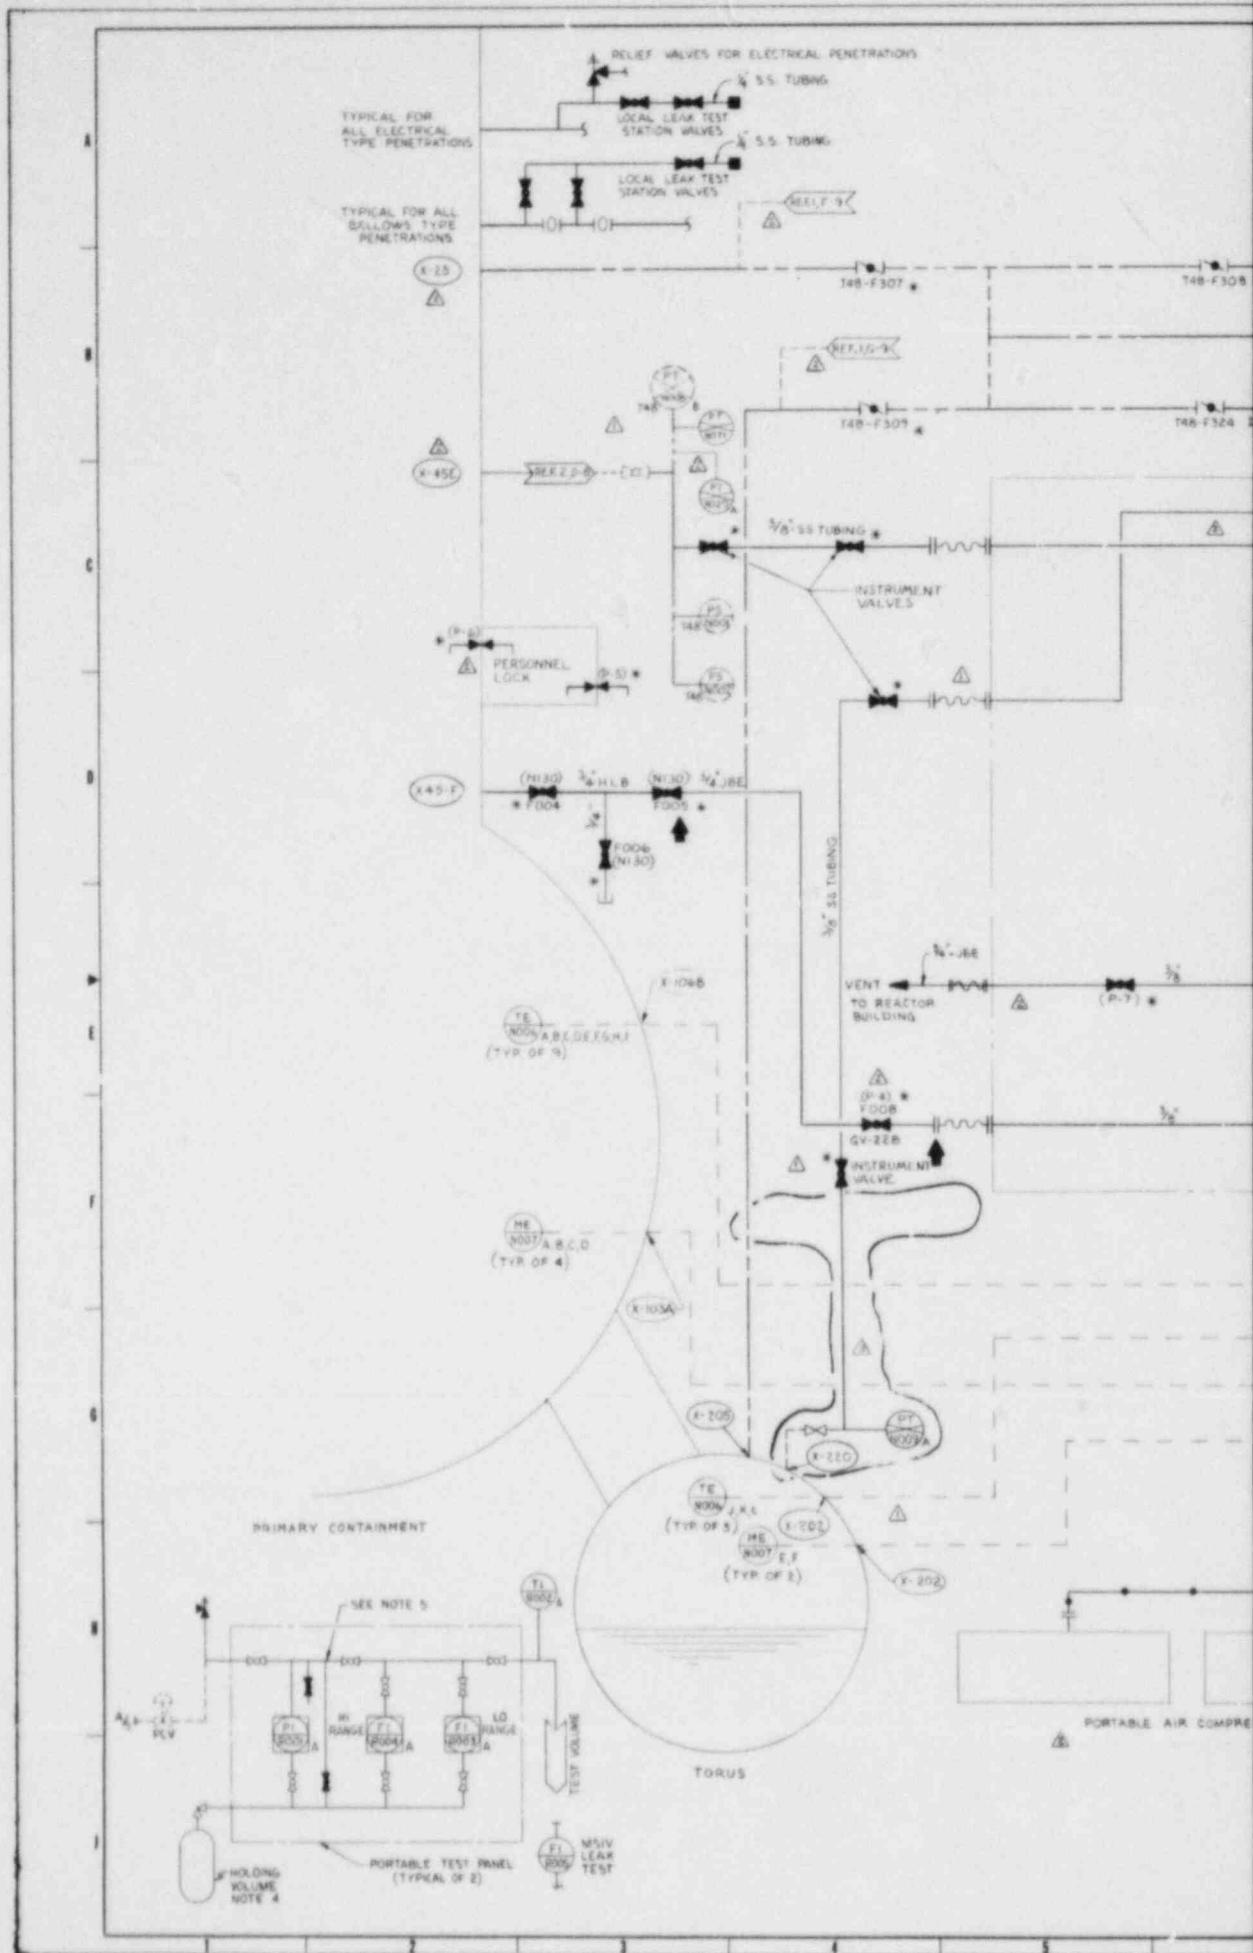

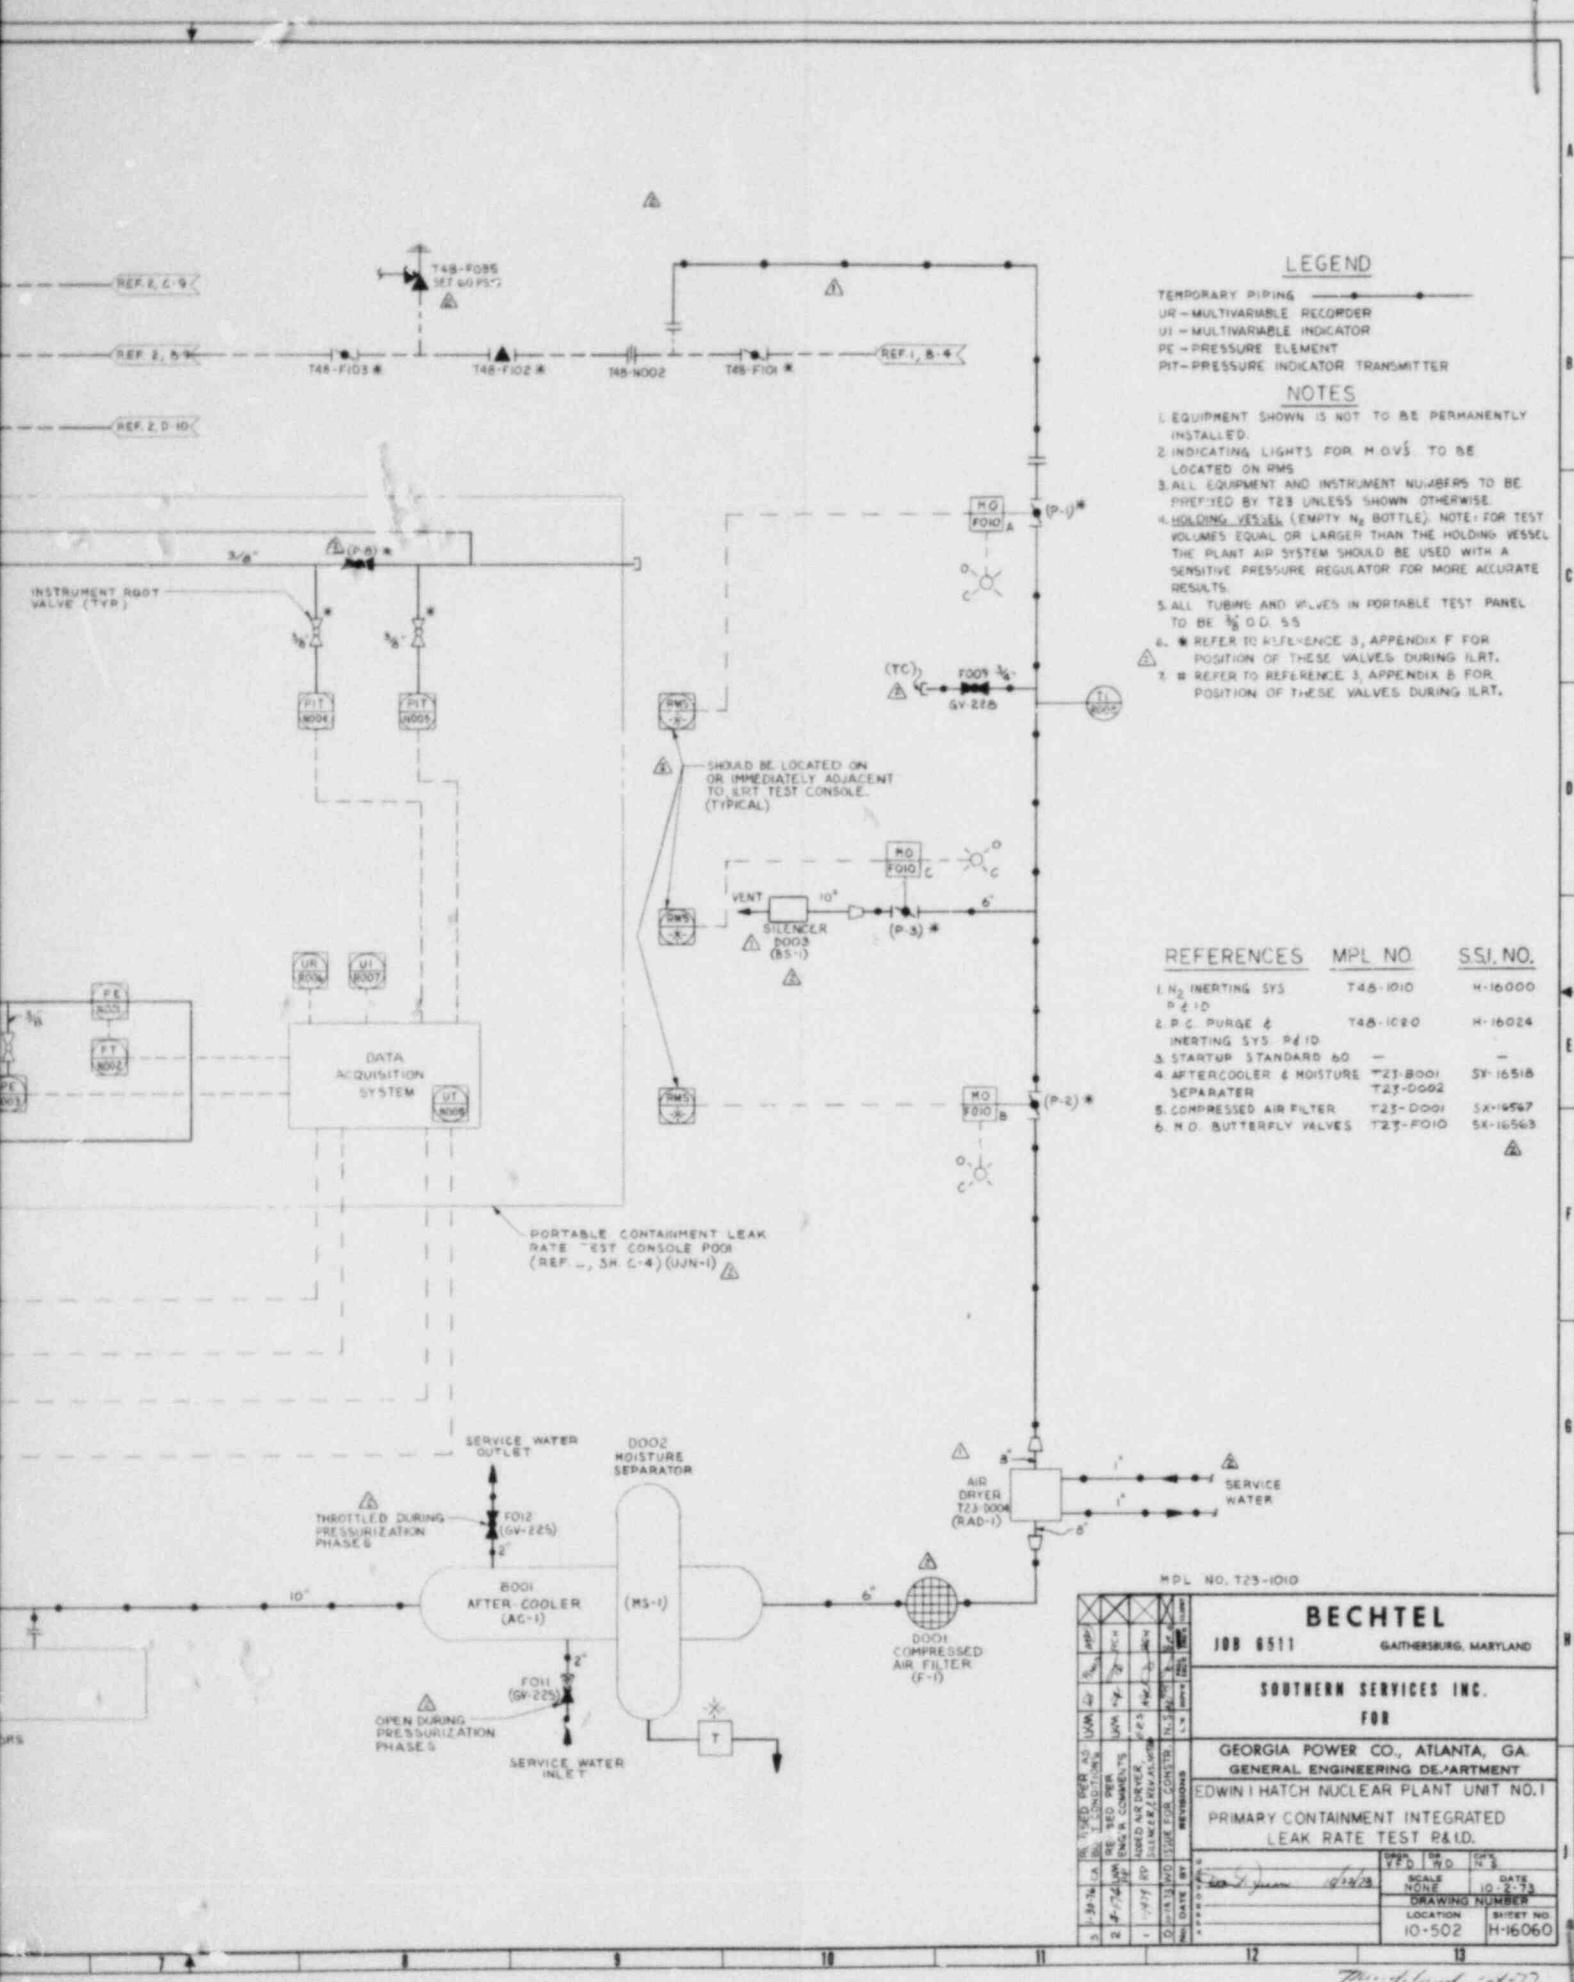

GEORGIA POWER CO., ATLANTA, GA. GENERAL ENGINEERING DEPARTMENT			
DWI N HATCH NUCLEAR PLANT UNIT NO. I			
PRIMARY CONTAINMENT INTEGRATED LEAK RATE TEST R&D.			
DRAWN BY	DESIGNED BY	DATE	REV.
<i>John D. Green</i>	<i>John D. Green</i>	10-2-73	N 3
SCALE	10-2-73	DATE	
None		DRAWING NUMBER	
LOCATION	10-502		SIZE/SET NO.
			H-16060

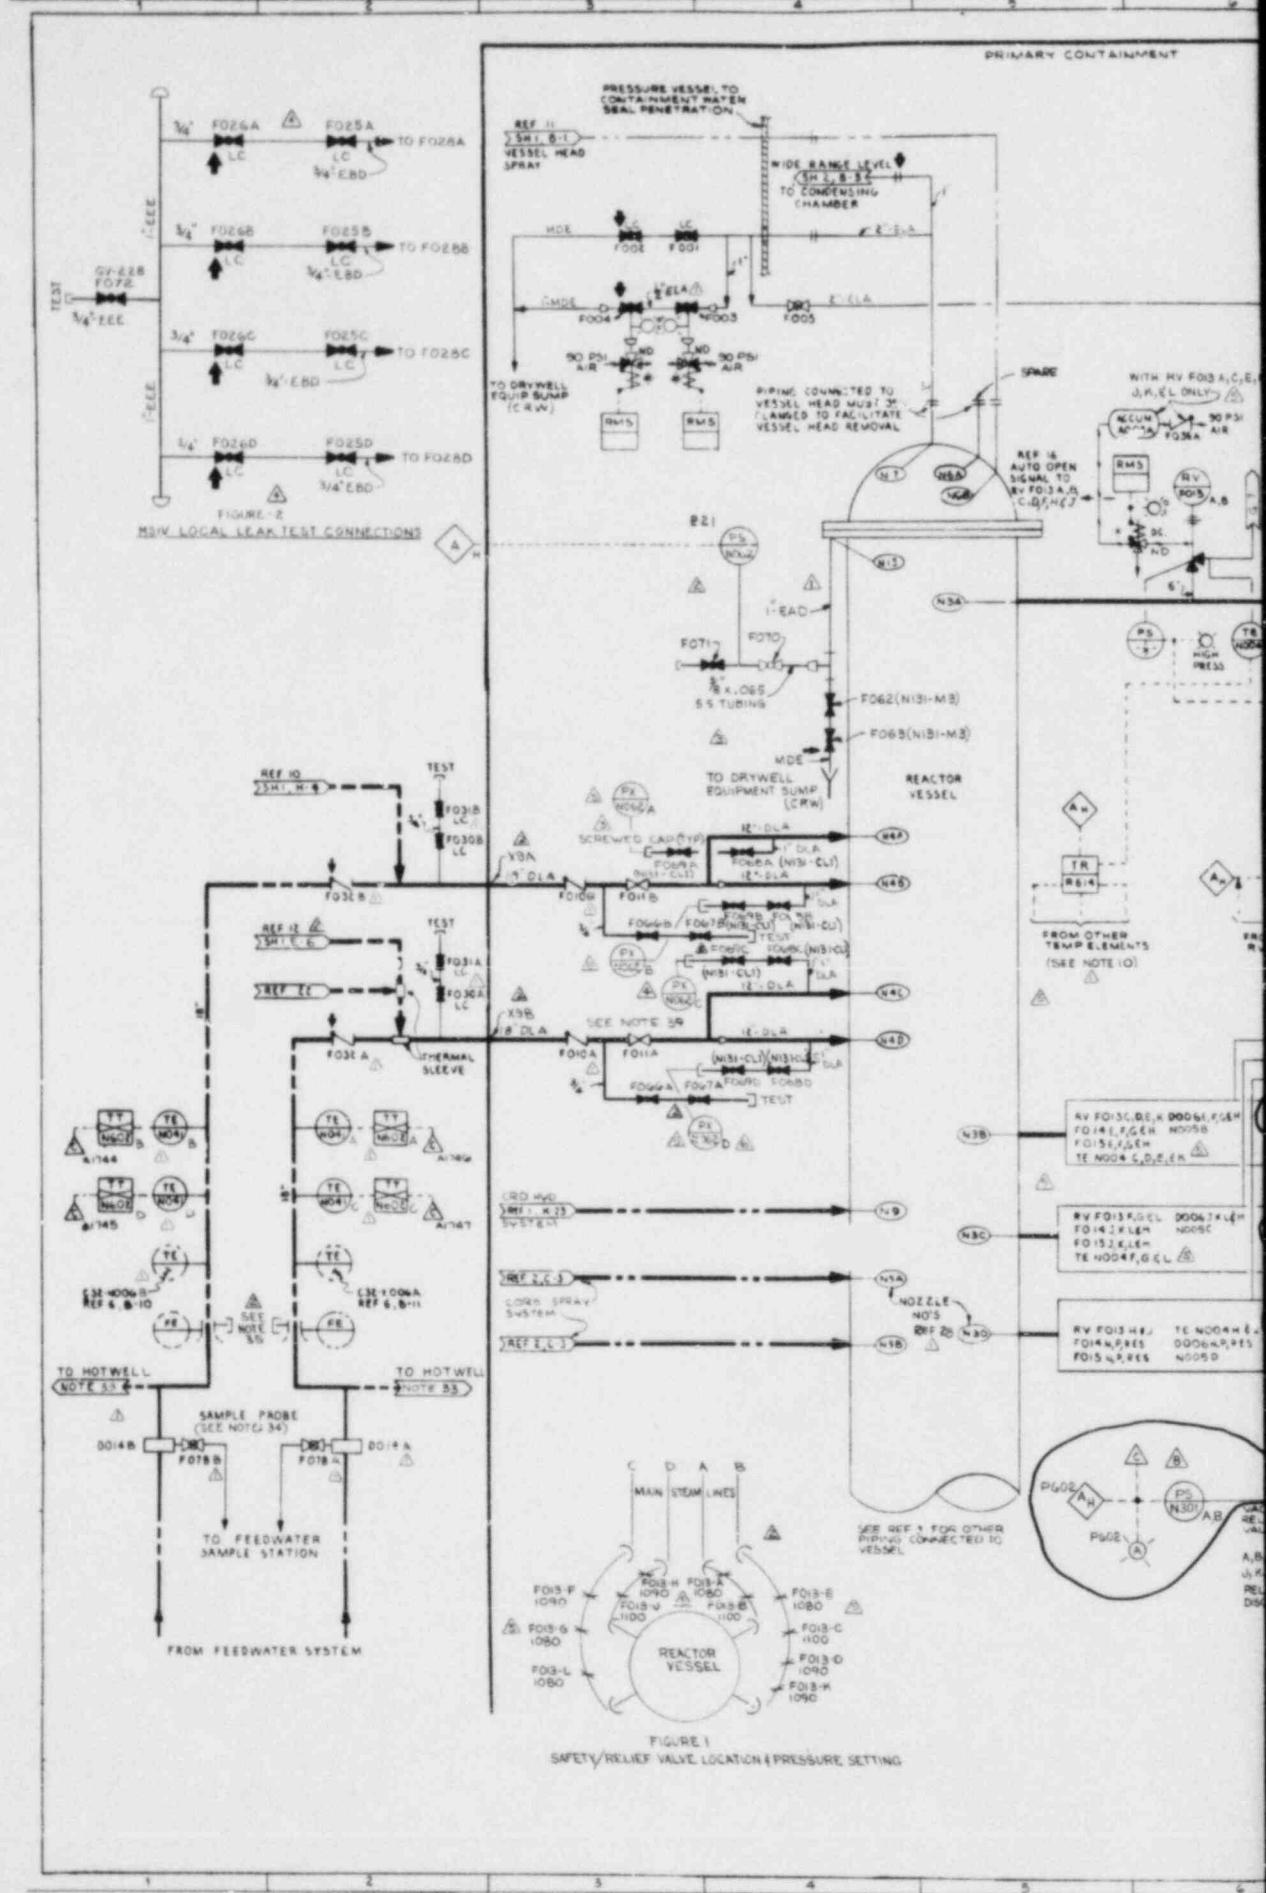

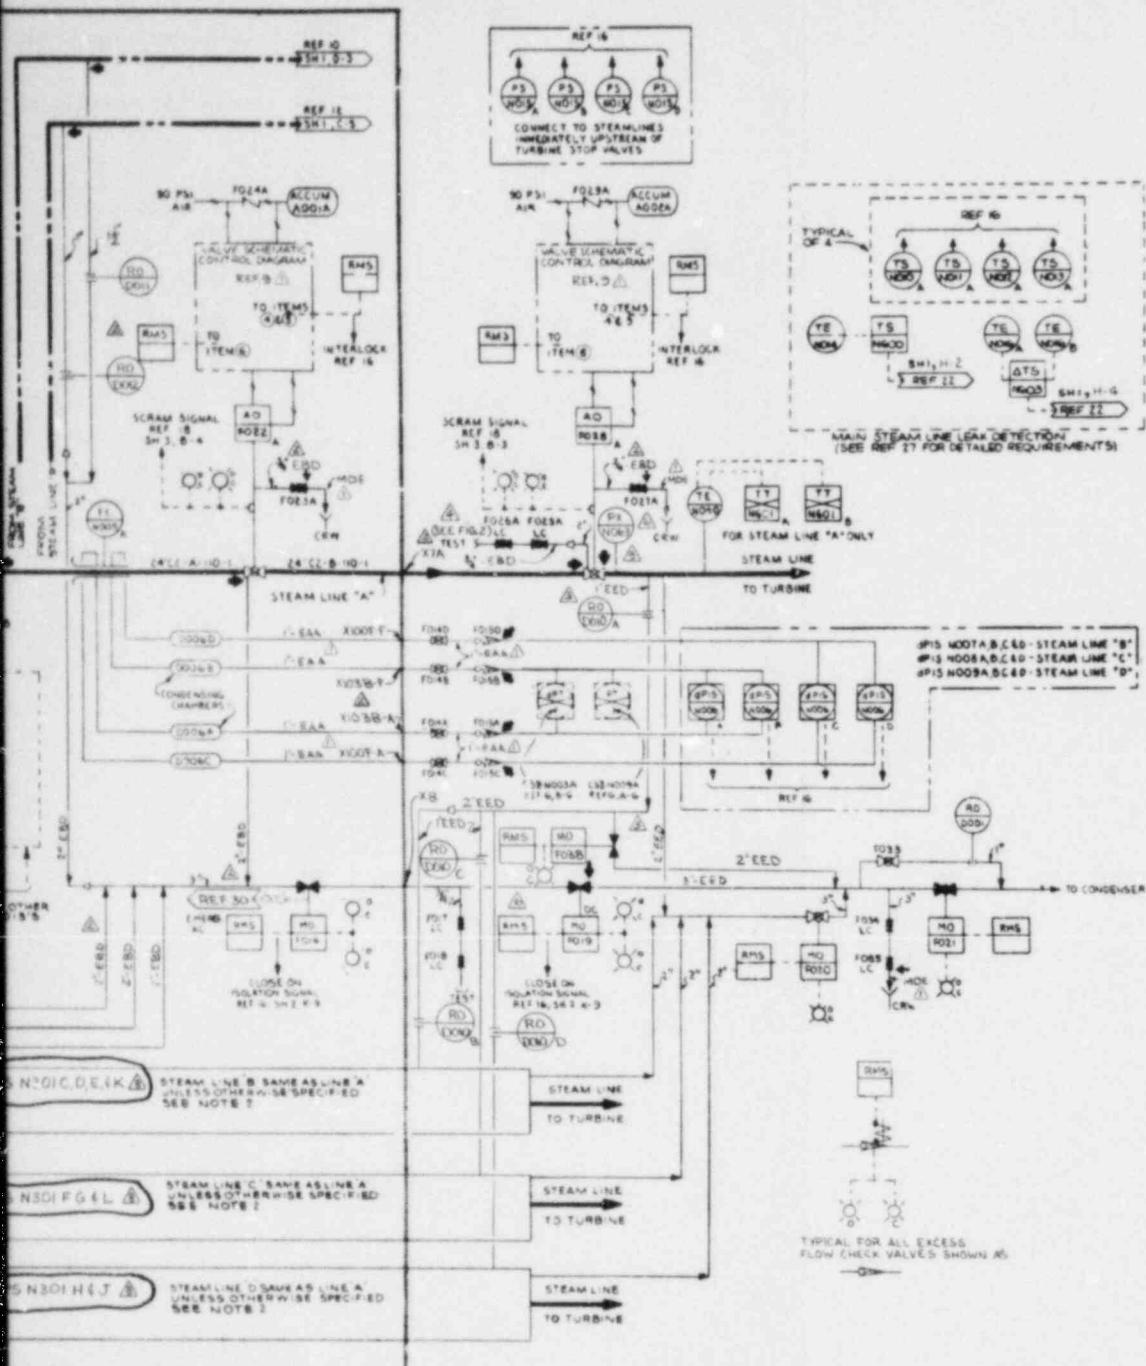

四三

1. ALL EQUIPMENT & INSTRUMENTS ARE PRECEDED BY HPL NO. B21 UNLESS OTHERWISE NOTED.
  2. STEAM LINES, ENCLOSED IN BOXES SHALL HAVE PART NOS. CORRESPONDING TO ITS RESPECTIVE LINE NO. UNLESS OTHERWISE NOTED.  
EXAMPLE: XXXX IS ON LINE "B"  
XXXX IS ON LINE "C"
  3. WHERE G/H NUMBERS ARE SHOWN THE VALVES ARE TAGGED WITH THESE NUMBERS. WHERE G/H-NUMBERS ARE NOT SHOWN THE VALVES ARE TAGGED WITH THE HPL NUMBER.
  4. HIGH POINT VENTS AND LOW POINT DRAINS ARE TO BE PROVIDED WHERE NECESSARY AS PROVIDED BY PHYSICAL ROUTING OF PIPE.
  
  5. INDICATED LEVEL TRIP SETTINGS VERSUS ACTUAL LEVEL INSIDE DRYER SKIRT IS BASED UPON:
    - A. CALIBRATION OF DEVICES AT 10000 PSIG REACTOR DOME PRESSURE AND 135°F DRYBELL AMBIENT TEMPERATURE.
    - B.  $\Delta P$  = OPERATOR PRESSURE DROP AT RATED LOAD = 10". HOT WATER.
    - C. CARRY UNDER CORRECTION (BASED ON 0.35 AS WEIGHT CARRY UNDER) = 5.5% DENSITY.
    - D. FEEDWATER LEVEL TENSION ERROR BAND =  $\pm 25$  RANGE.
    - E. SAFEGUARDS LEVEL SENSOR ERROR BAND =  $\pm 35$  RANGE.
  6. T/S FUNCTION BOX (LOCALLY MOUNTED) (BY OTHERS) EACH T/S FUNCTION BOX TO HAVE ONE SET OF TERMINALS.  
A.

(NOTES CONT'D ON SHT. 2) □

第二章

- |  |                         |                               |
|--|-------------------------|-------------------------------|
| 1. CONTROL ROB DRIVE HYDRAULIC SYS   | CII-1810                | K-14095                       |
| 2. CORE SPRAY SYSTEM PAID  | S71-1810                | K-14531                       |
| 3. REACTOR RECIRCULATION SYS P&ID  | SMT 1<br>SMT 2<br>SMT 3 | K-14531<br>K-14531<br>K-14531 |
| 4. PIPING & INSTRUMENT SYMBOLS   | AII-1000                | S1885                         |
| 5. REACTOR FESSI PURCHASE PART DWS   | SWS-1000                | S1-13-03                      |
| 6. FEEDWATER CONTROL SYSTEM IED  | CII-1810                | S1-14-01                      |
| 7. REACTOR BURNER SYSTEM IED   | CII-1810                | S1-14-02                      |
| 8. STANDBY LIQUID CONTROL SYS PAID   | SMT-1<br>SMT 1<br>SMT 2 | K-14531<br>K-14531<br>K-14531 |
| 9. ISOLATION VALVE PURCHASE PART DWS   | SII-1822/1823           | K-14247                       |
| 10. HPCI SYSTEM PAID   | SMT 1<br>SMT 2<br>SMT 3 | K-14532<br>K-14533<br>K-14530 |
| 11. RHW SYSTEM PAID  | SMT 1<br>SMT 2          | K-14531<br>K-14534            |
| 12. RCIC SYSTEM P&ID   | SII-1810                | S1-14-03                      |
| 13. HPCI SYSTEM FCD  | SII-1810                | S1-14-04                      |
| 14. RHW SYSTEM FCD   | SII-1810                | S1-14-05                      |
| 15. RCIC SYSTEM FCD  | SII-1810                | S1-14-06                      |
| 16. NUCLEAR BOILER SYSTEMS FCD   | SII-1810                | S1-14-07                      |
| 17. CORE SPRAY SYSTEM FCD  | SII-1810                | S1-14-08                      |
| 18. REACTOR PROTECTION SYSTEM IED  | SII-1810                | S1-14-09                      |
| 19. REACTOR SYSTEM P&ID<br>& INSTRUMENTATION & TUNING<br>INSTALL SPECIFICATION | SII-1810                | S1-14-09-01-05                |
| 20. PLANT REQUIREMENTS   | AII-4878                | S-                            |
| 21. REACTOR RECIRCULATION SYSTEM FCD   | SII-1810                | S1-14-09-05-08                |
| 22. REACTOR WATER CLEANER SYSTEM P & ID SMT 1                                  | SII-1810                | S1-14-08                      |
| 23. PRESSURE DIFFERENTIALITY OF PIPING &<br>EQUIPMENT PRESSURE PARTS           | AII-4820                | S1-14-02                      |
| 24. NUCLEAR BOILER SYSTEM PROCESS DIAG   | SII-1820                | S1-14-05                      |
| 25. NUCLEAR BOILER SYSTEM DESIGN SPEC.   | AII-4820                | S1-14-03                      |
| 26. FEEDWATER CONTROL SYSTEM DESIGN SPEC.                                      | SII-1820                | S1-14-02                      |
| 27. REACTOR BURNER LEAN DETECTION<br>DESIGN SPEC.                              | AII-4820                | S1-14-03                      |
| 28. REACTOR SYSTEM OUTLINE   | SII-1810<br>AII-2850    | S1-14-05-07                   |
| 29. REACTOR ASSMBLY  | SII-1810                | S1-14-06-08                   |
| 30. DRYWELL VALVE & EQUIP  | H-16-99                 |                               |


THIS DWG. DEVELOPED FROM G.E. DWG.  
NO. 720E616BA REV. 5 SHT. 1


(MPL NO. 821-1010)


BECHTEL ASSOCIATES  
JBB 6511


SOUTHERN SERVICES INC.

GEORGIA POWER CO., ATLANTA, GA.  
GENERAL ENGINEERING DEPARTMENT  
DWI-1, HATCH NUCLEAR PLANT UNIT NO. 1  
NUCLEAR BOILER SYSTEM P-10

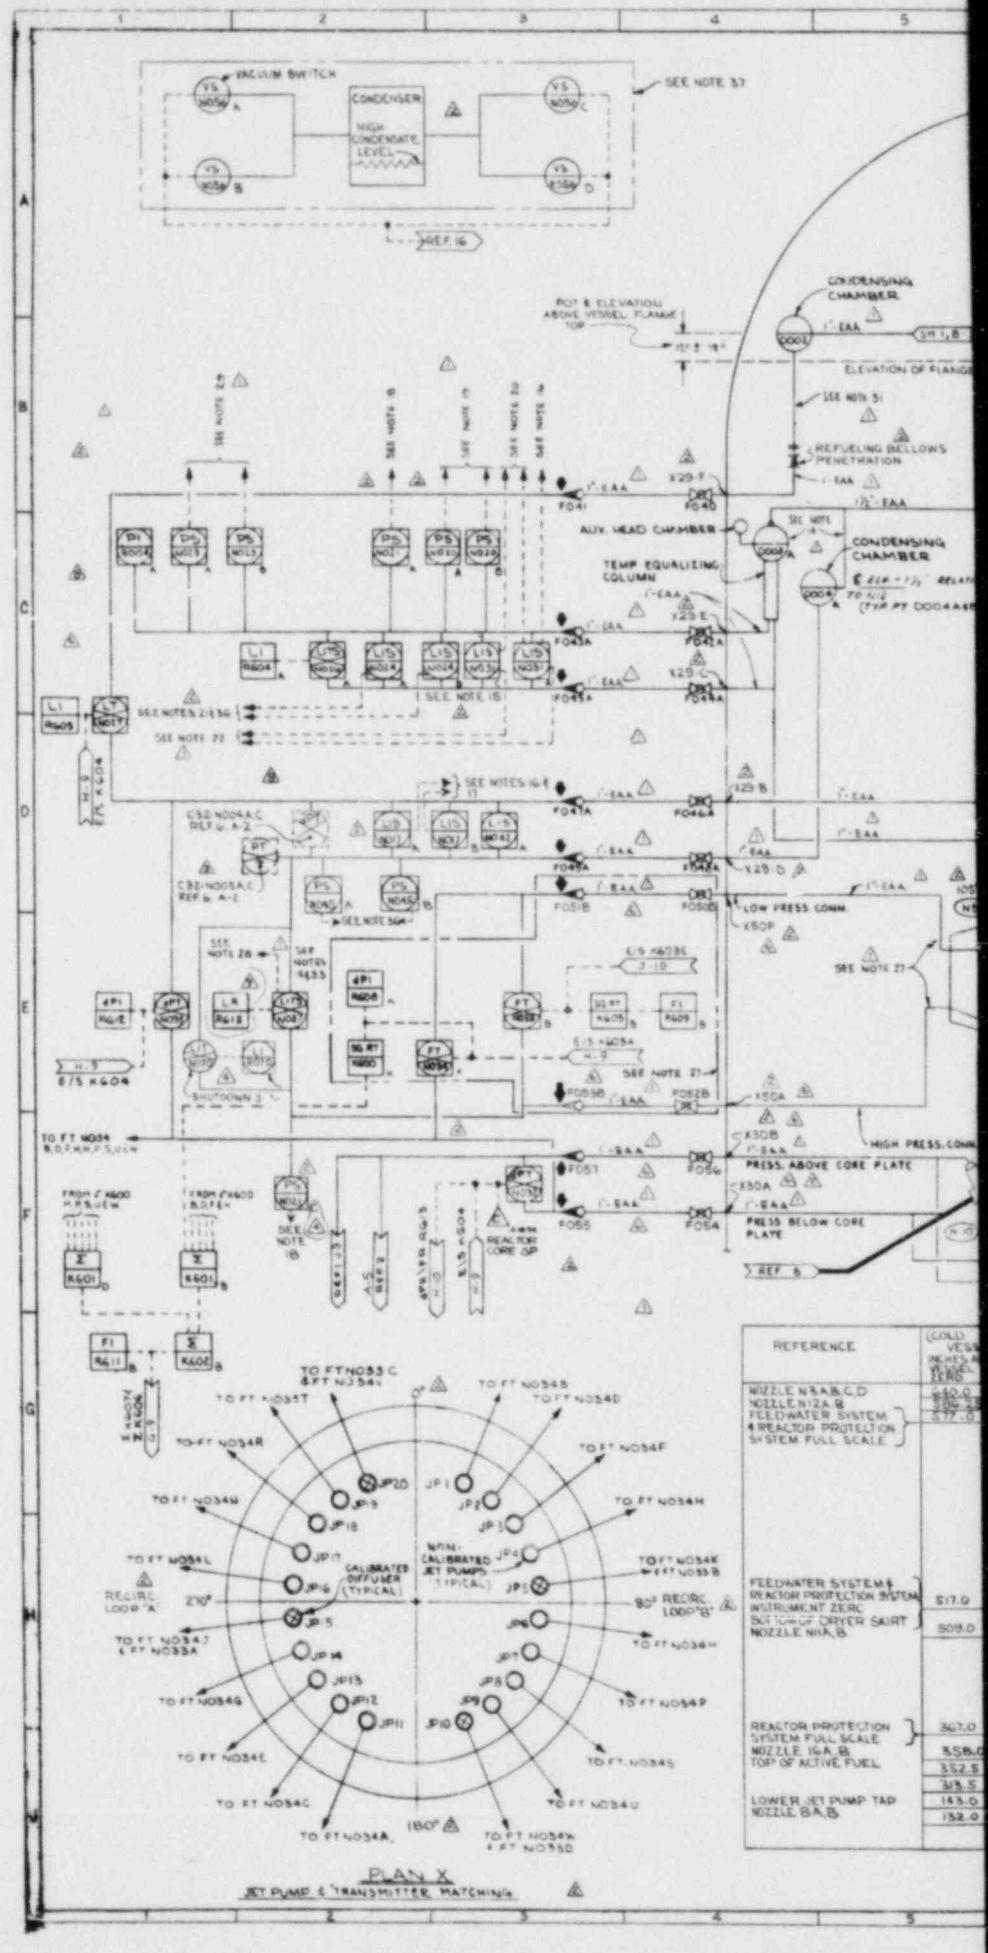

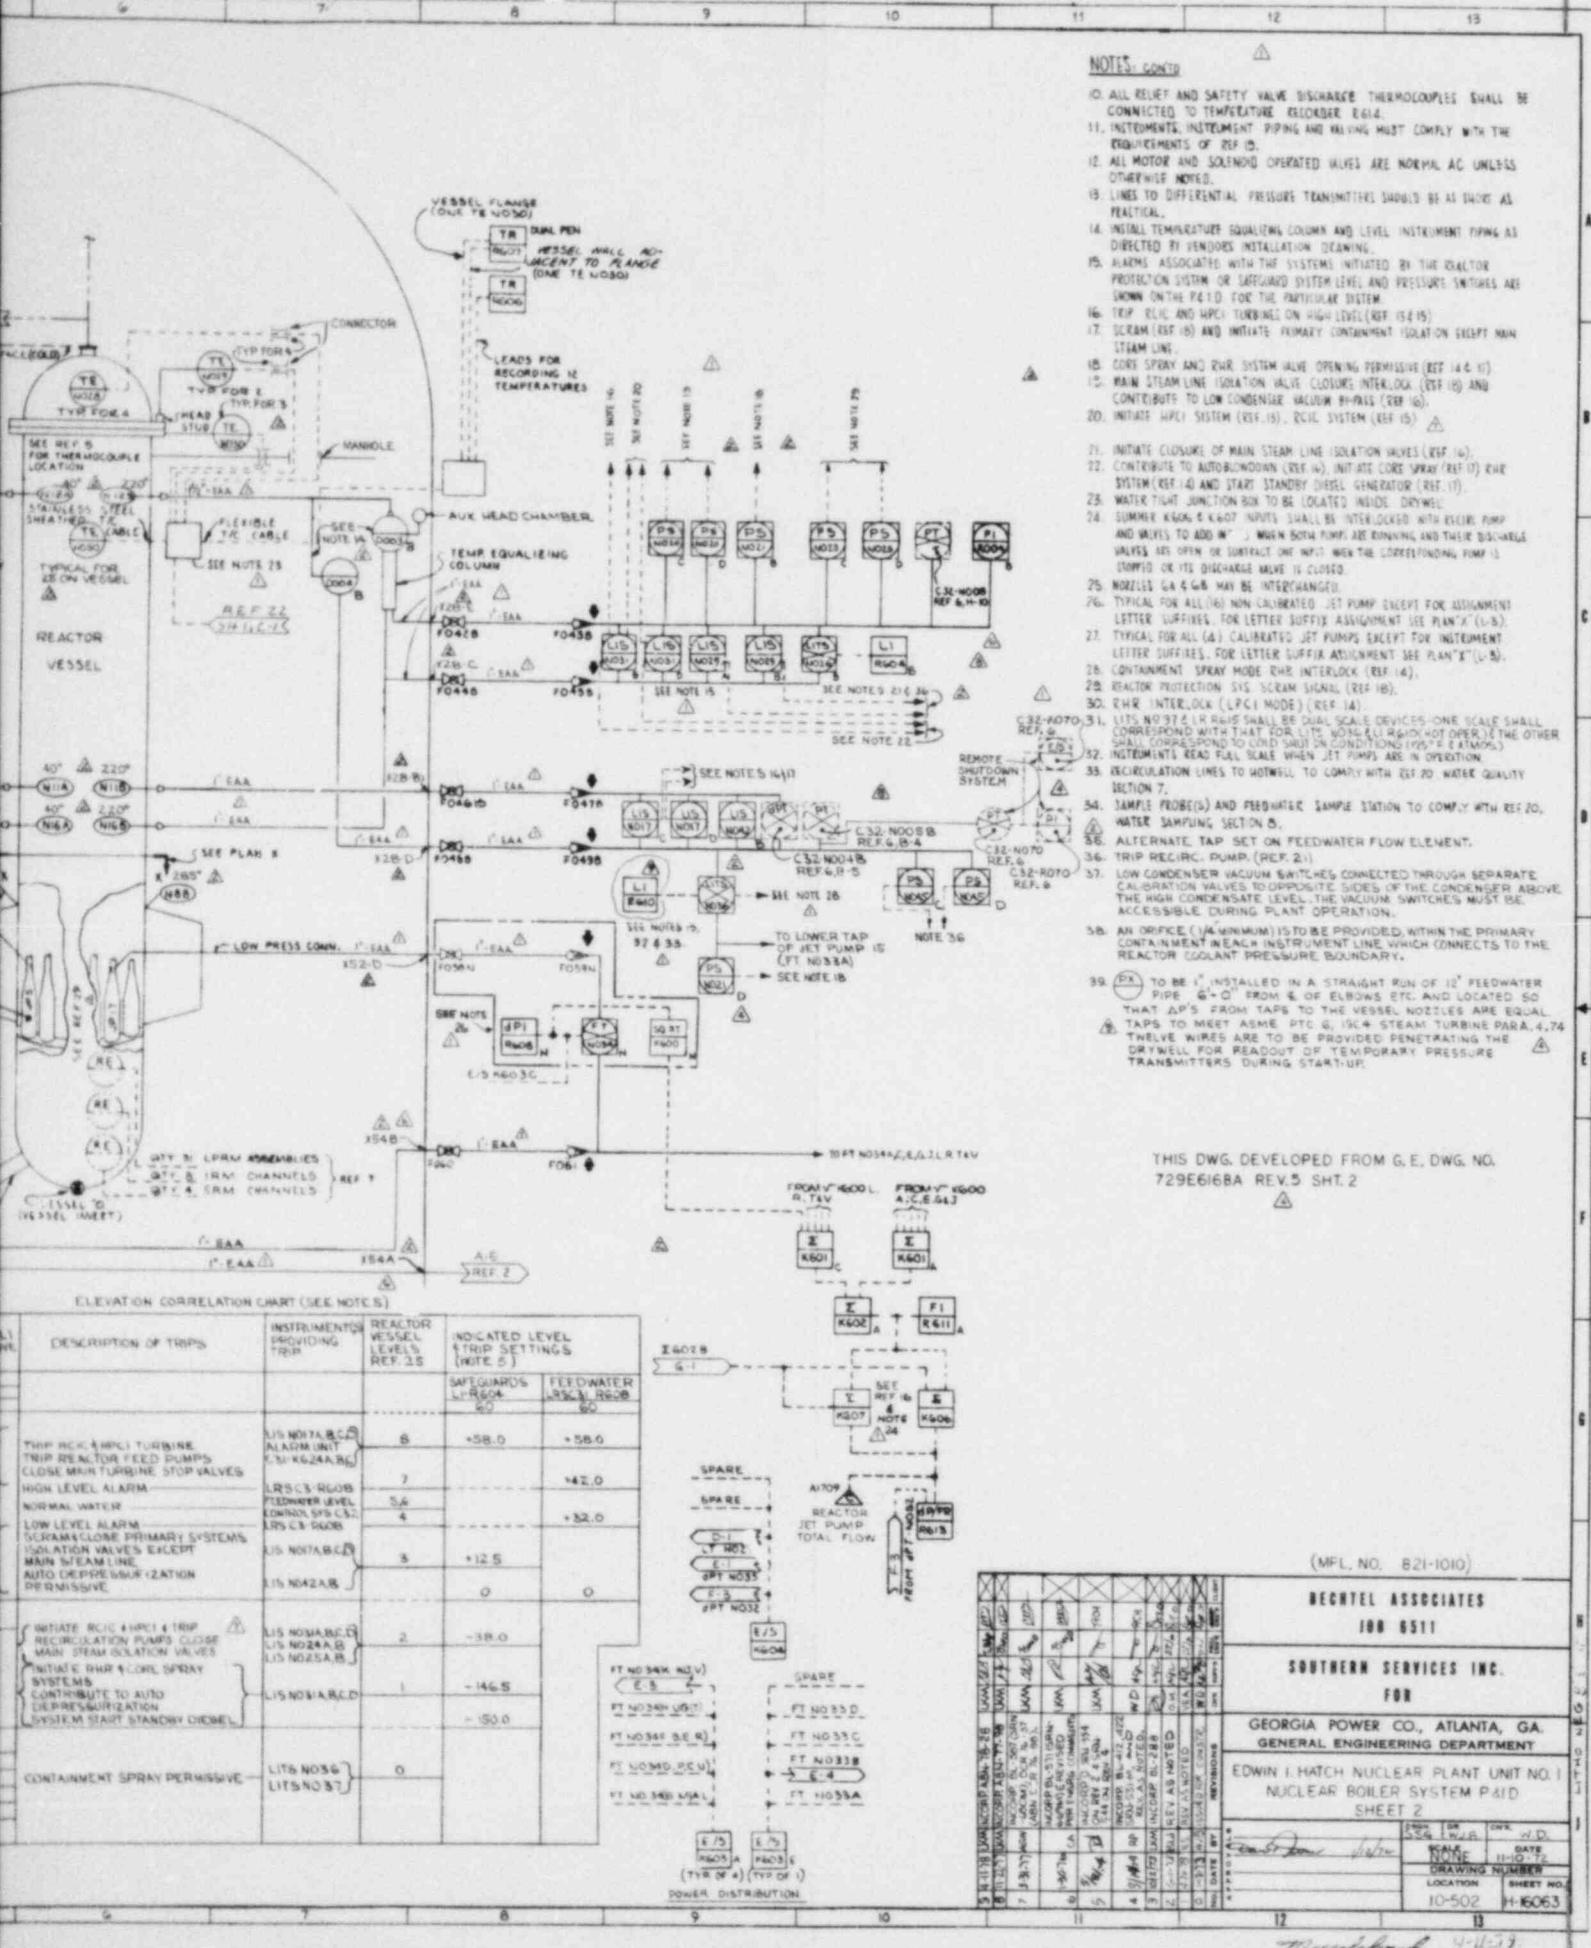

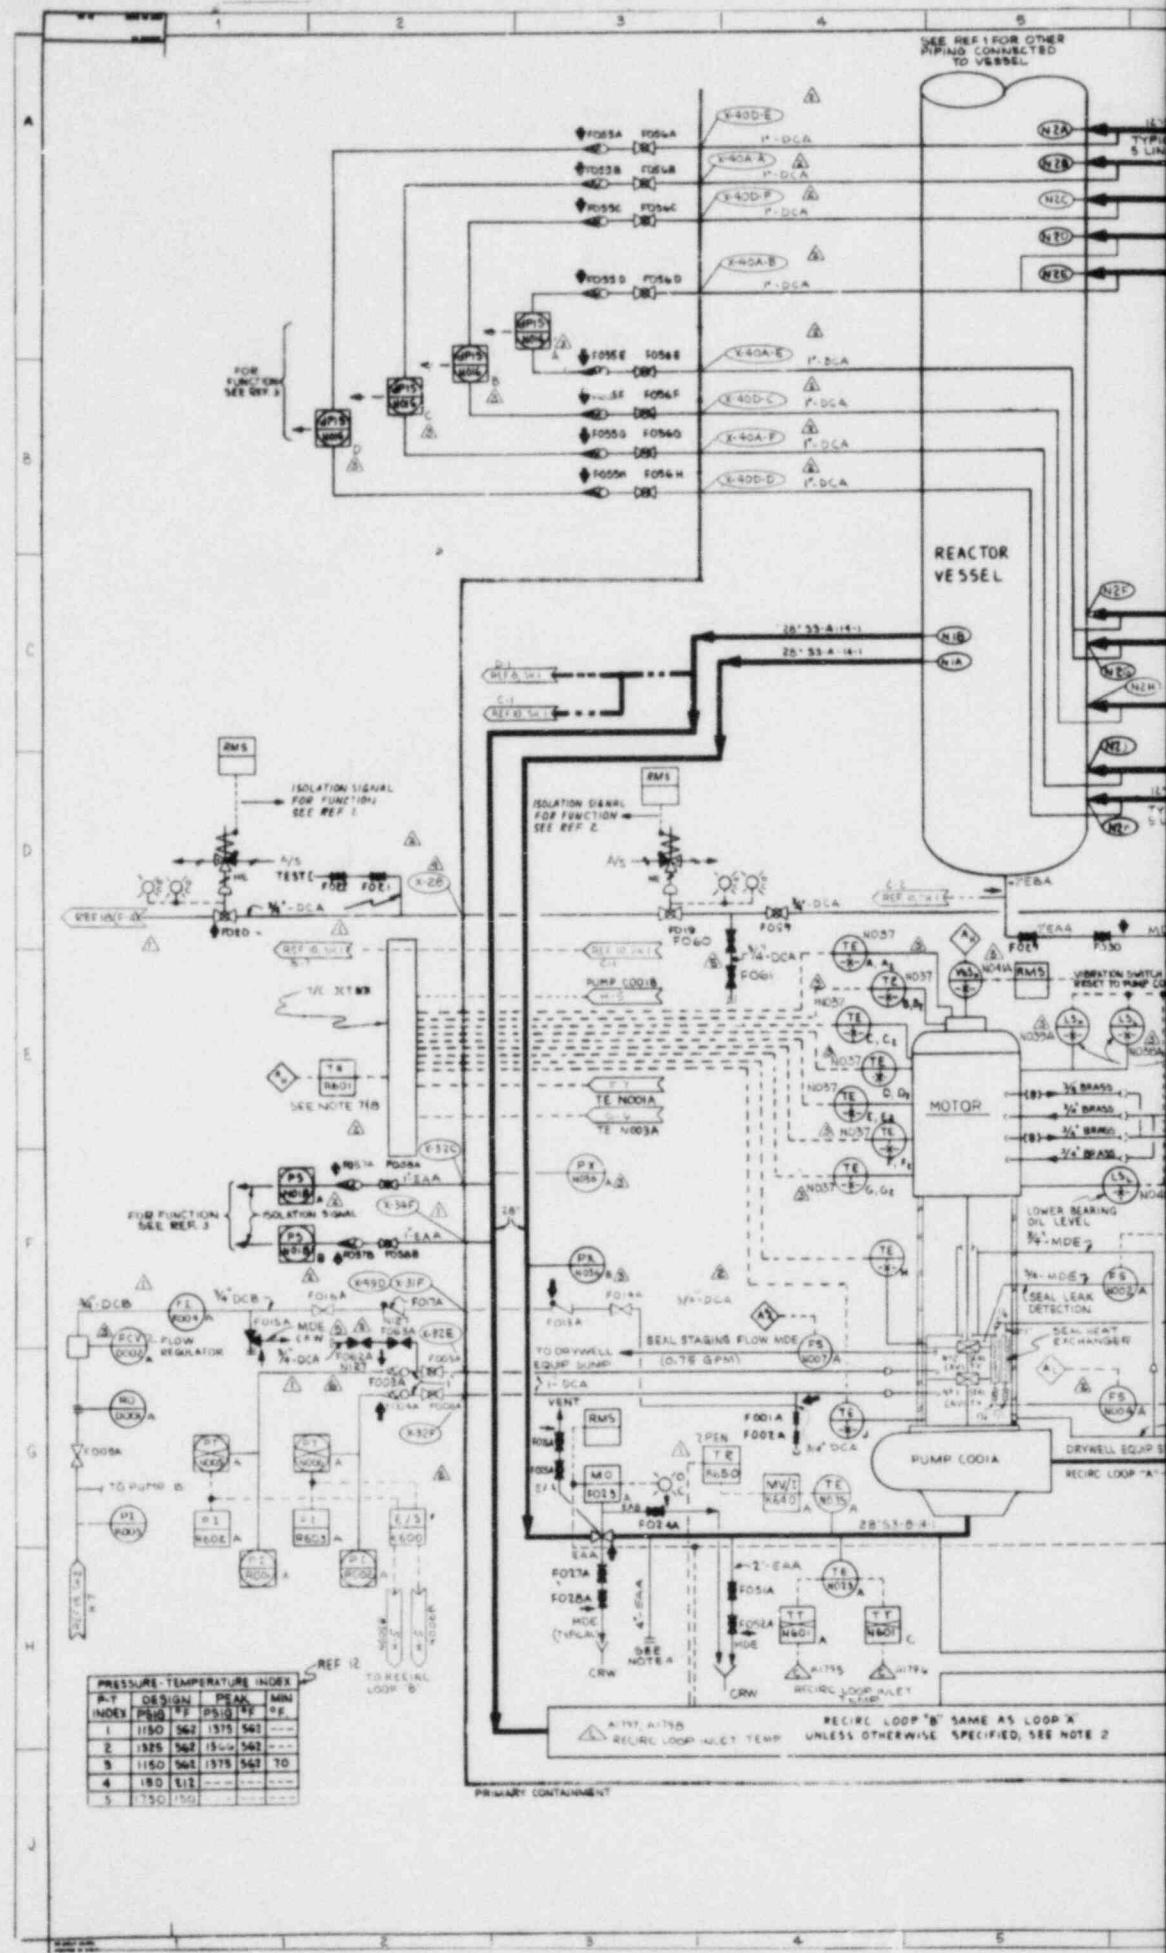

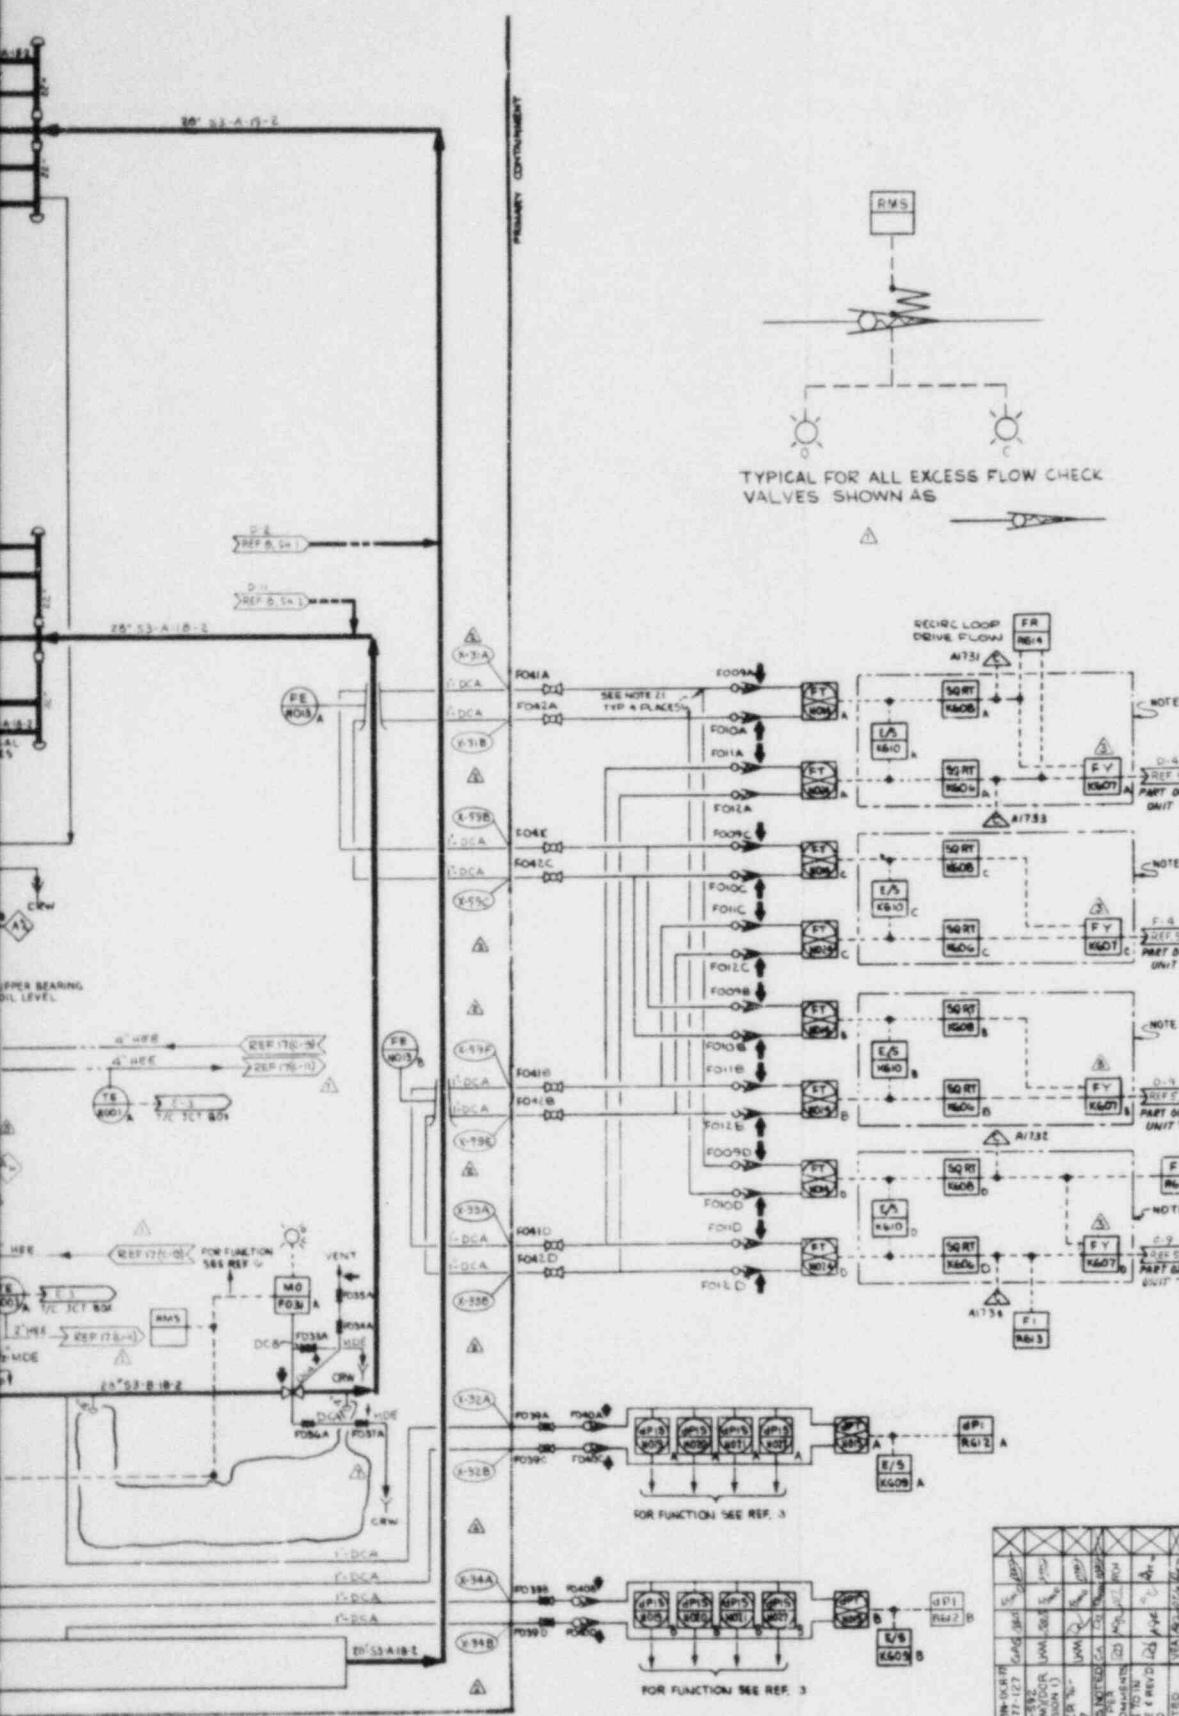



THIS DNG DEVELOPED FROM G.E. DNG  
723 E 608 BA RSV G.

**BECHTEL ASSOCIATES**

SOUTHERN SERVICES INC.  
500

GEORGIA POWER CO., ATLANTA, GA.  
GENERAL ENGINEERING DEPARTMENT  
DWI N HATCH NUCLEAR PLANT UNIT NO.  
REACTOR RECIRCULATION SYSTEM P&ID  
SHEET NO. 1

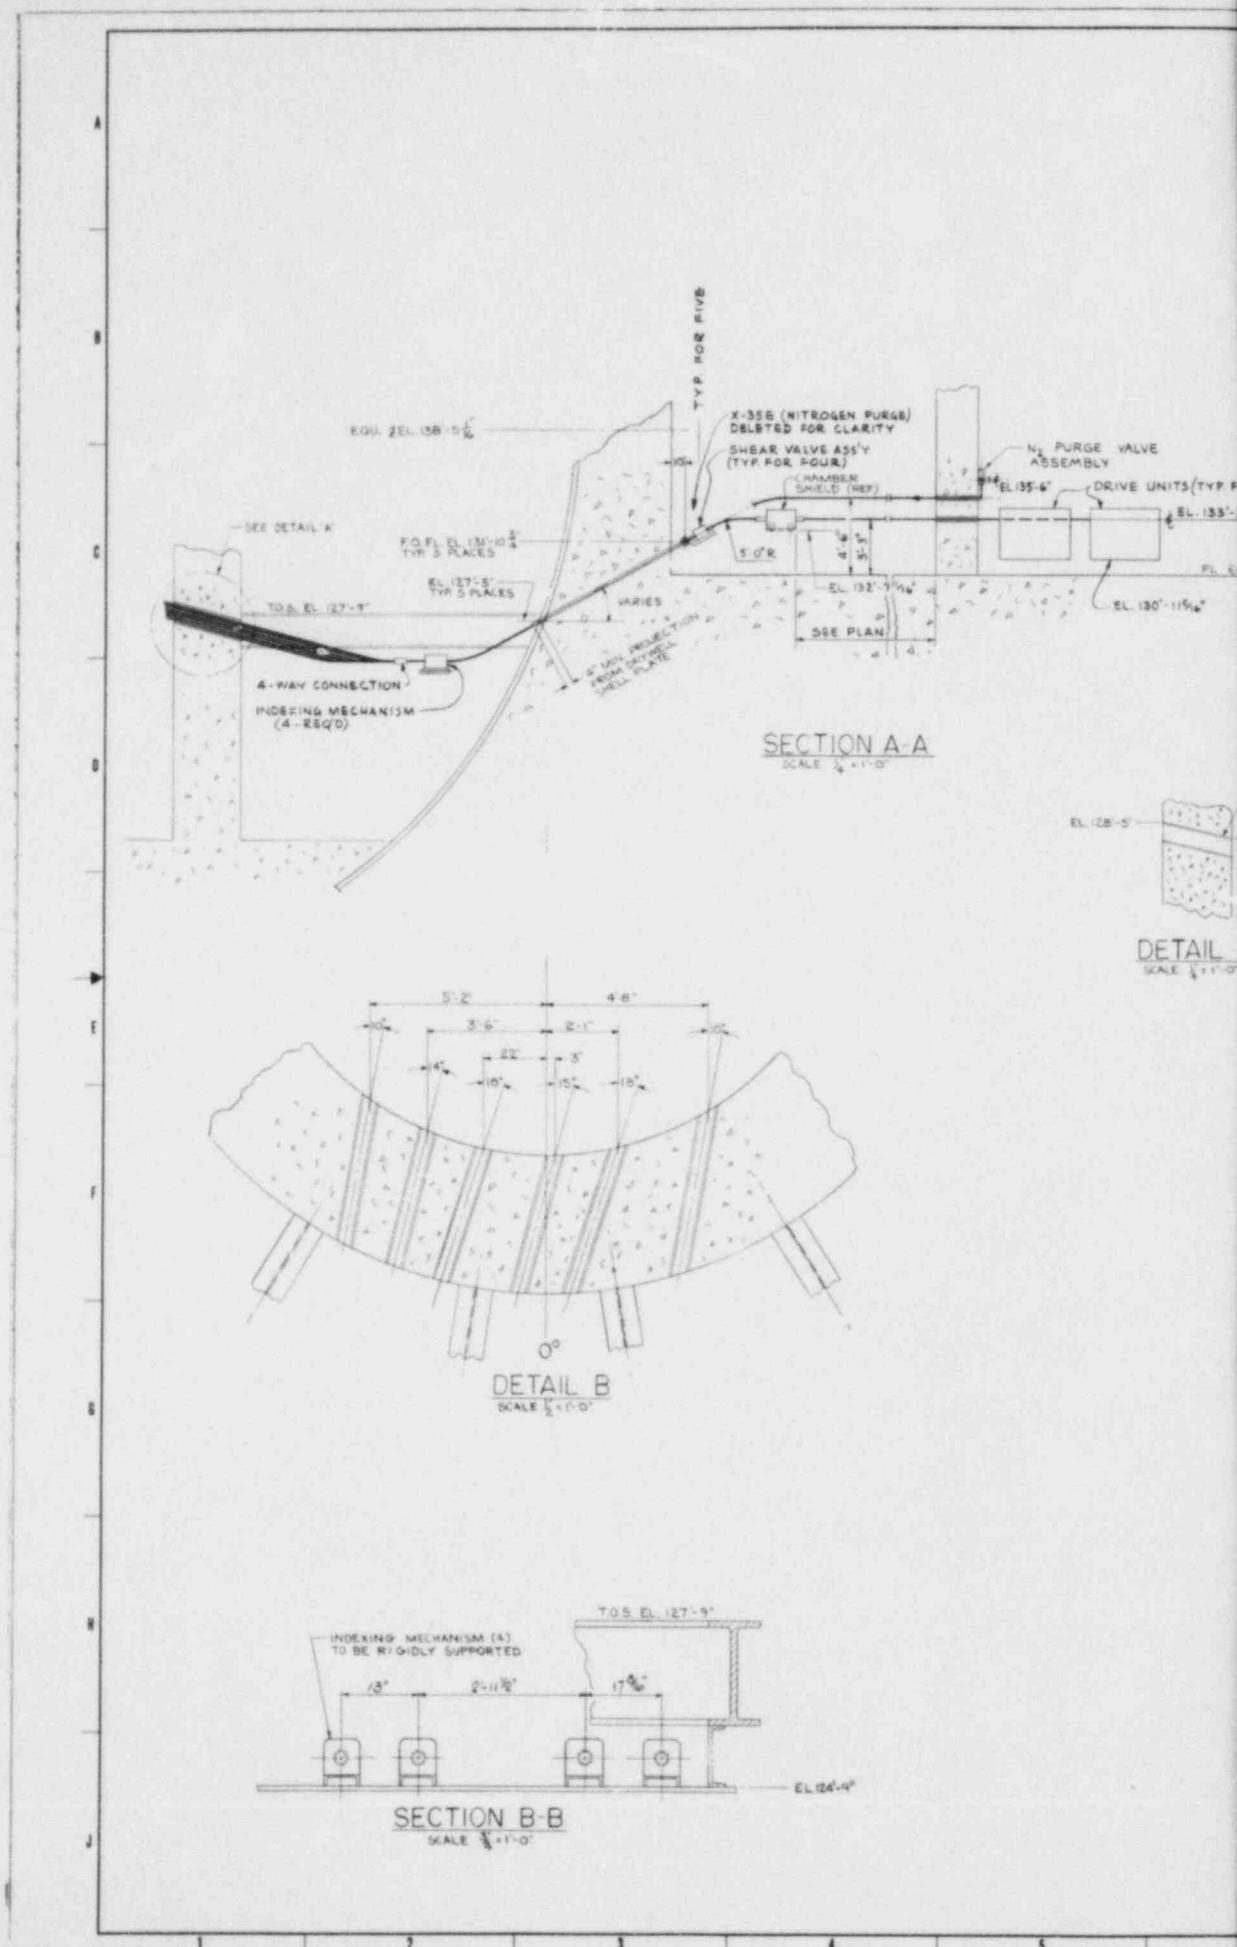

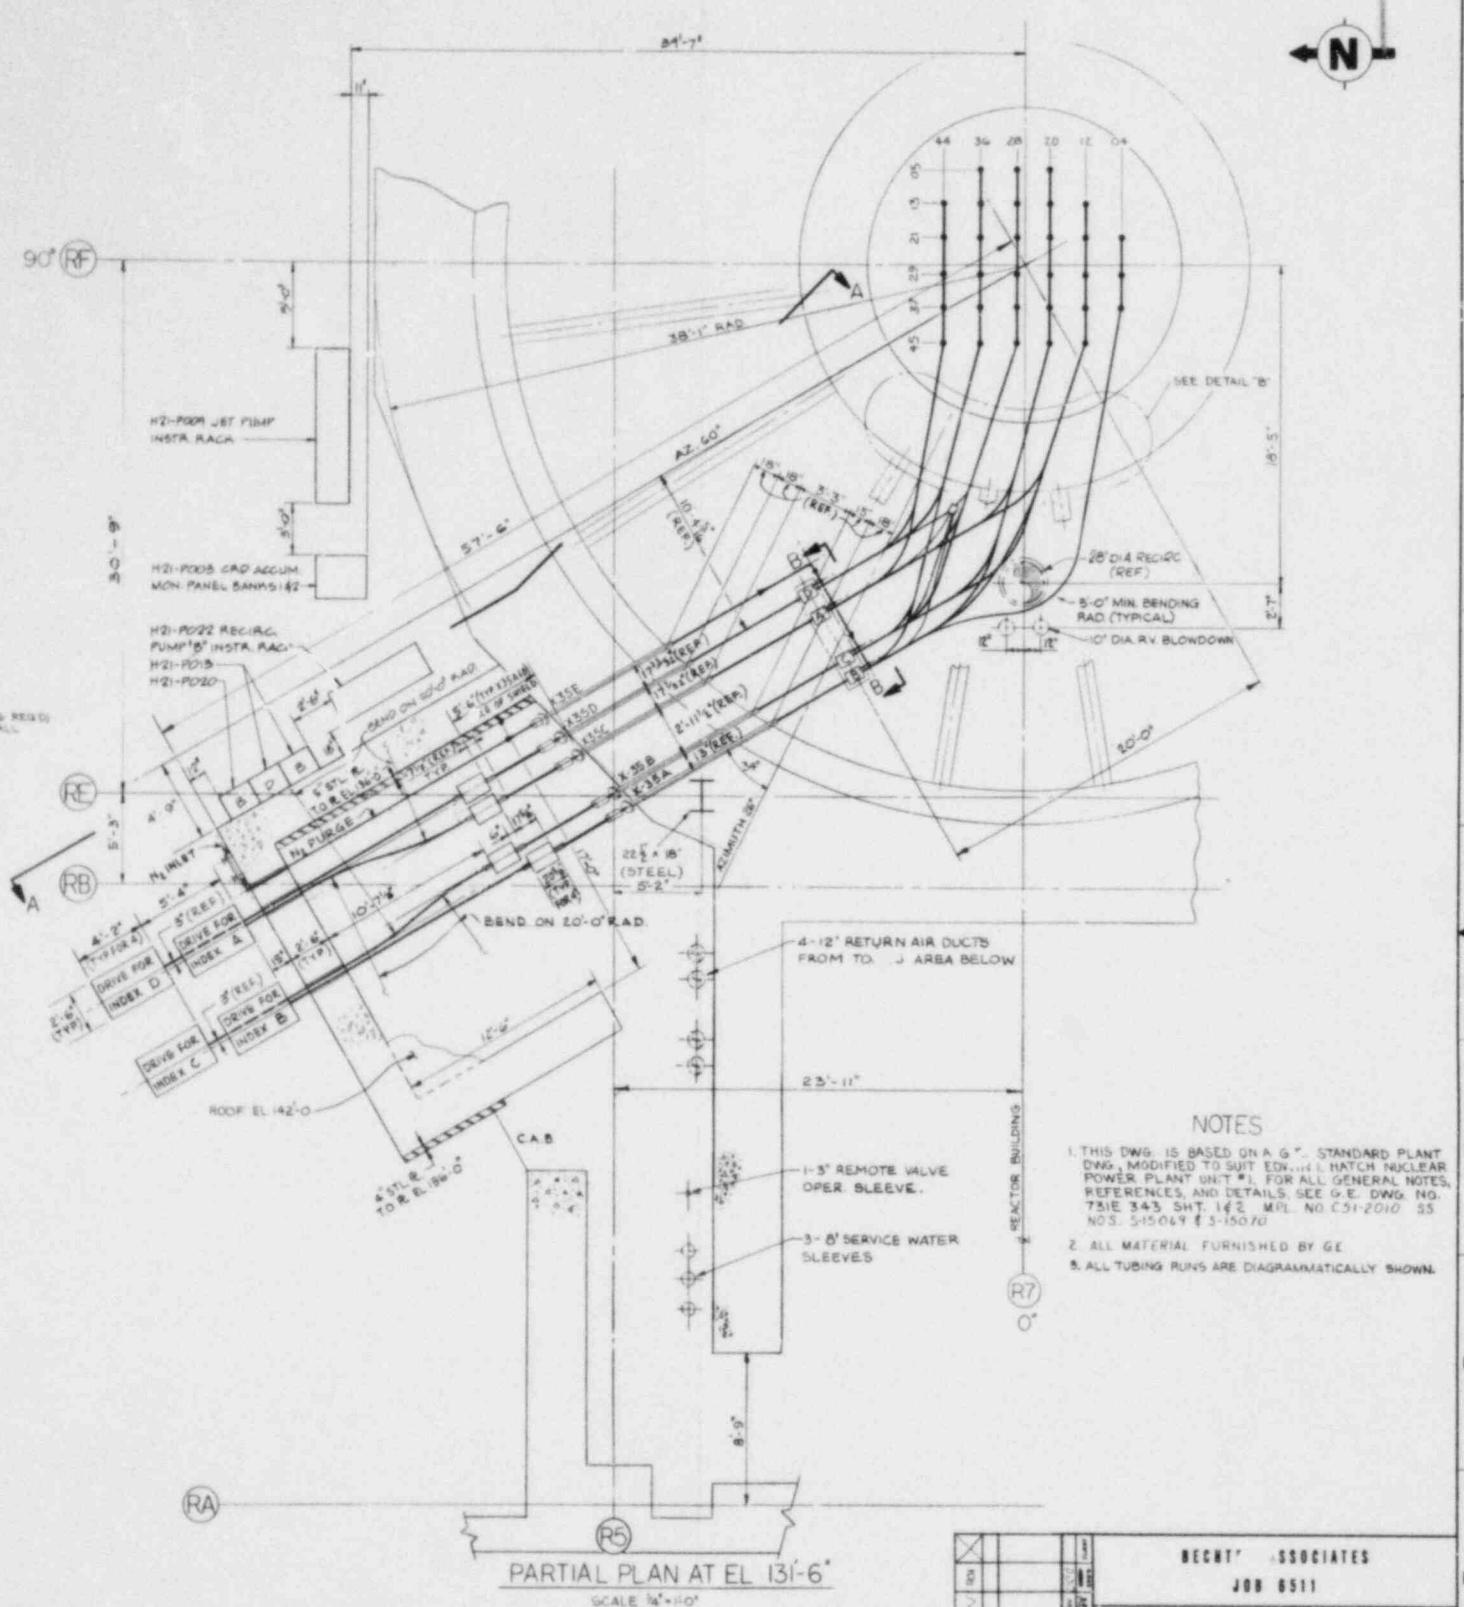



RECHT & ASSOCIATES  
JOB 6511


SOUTHERN SERVICES INC.


GEORGIA POWER CO., ATLANTA, GA.  
GENERAL ENGINEERING DEPARTMENT

		BECHT & ASSOCIATES	
		JOB 6511	
SOUTHERN SERVICES INC.			
FOR			
GEORGIA POWER CO., ATLANTA, GA			
GENERAL ENGINEERING DEPARTMENT			
EDWIN L HATCH NUCLEAR PLANT UNIT NO.1			
TRaversing IN-CORE PROBE SYSTEM			
DRAWING NUMBER 10-502 REV B 10-5-70		DATE 10-5-70 SCALE AS NOTED DRAWING NUMBER 10-502 LOCATION SHEET NO. 14-16070-1	
DATE 10-5-70 BY J. D. JONES APPROVED DATE 10-5-70 APPROVED DATE 10-5-70		DRAWING NUMBER 10-502 DATE 10-5-70 SCALE AS NOTED DRAWING NUMBER 10-502 LOCATION SHEET NO. 14-16070-1	

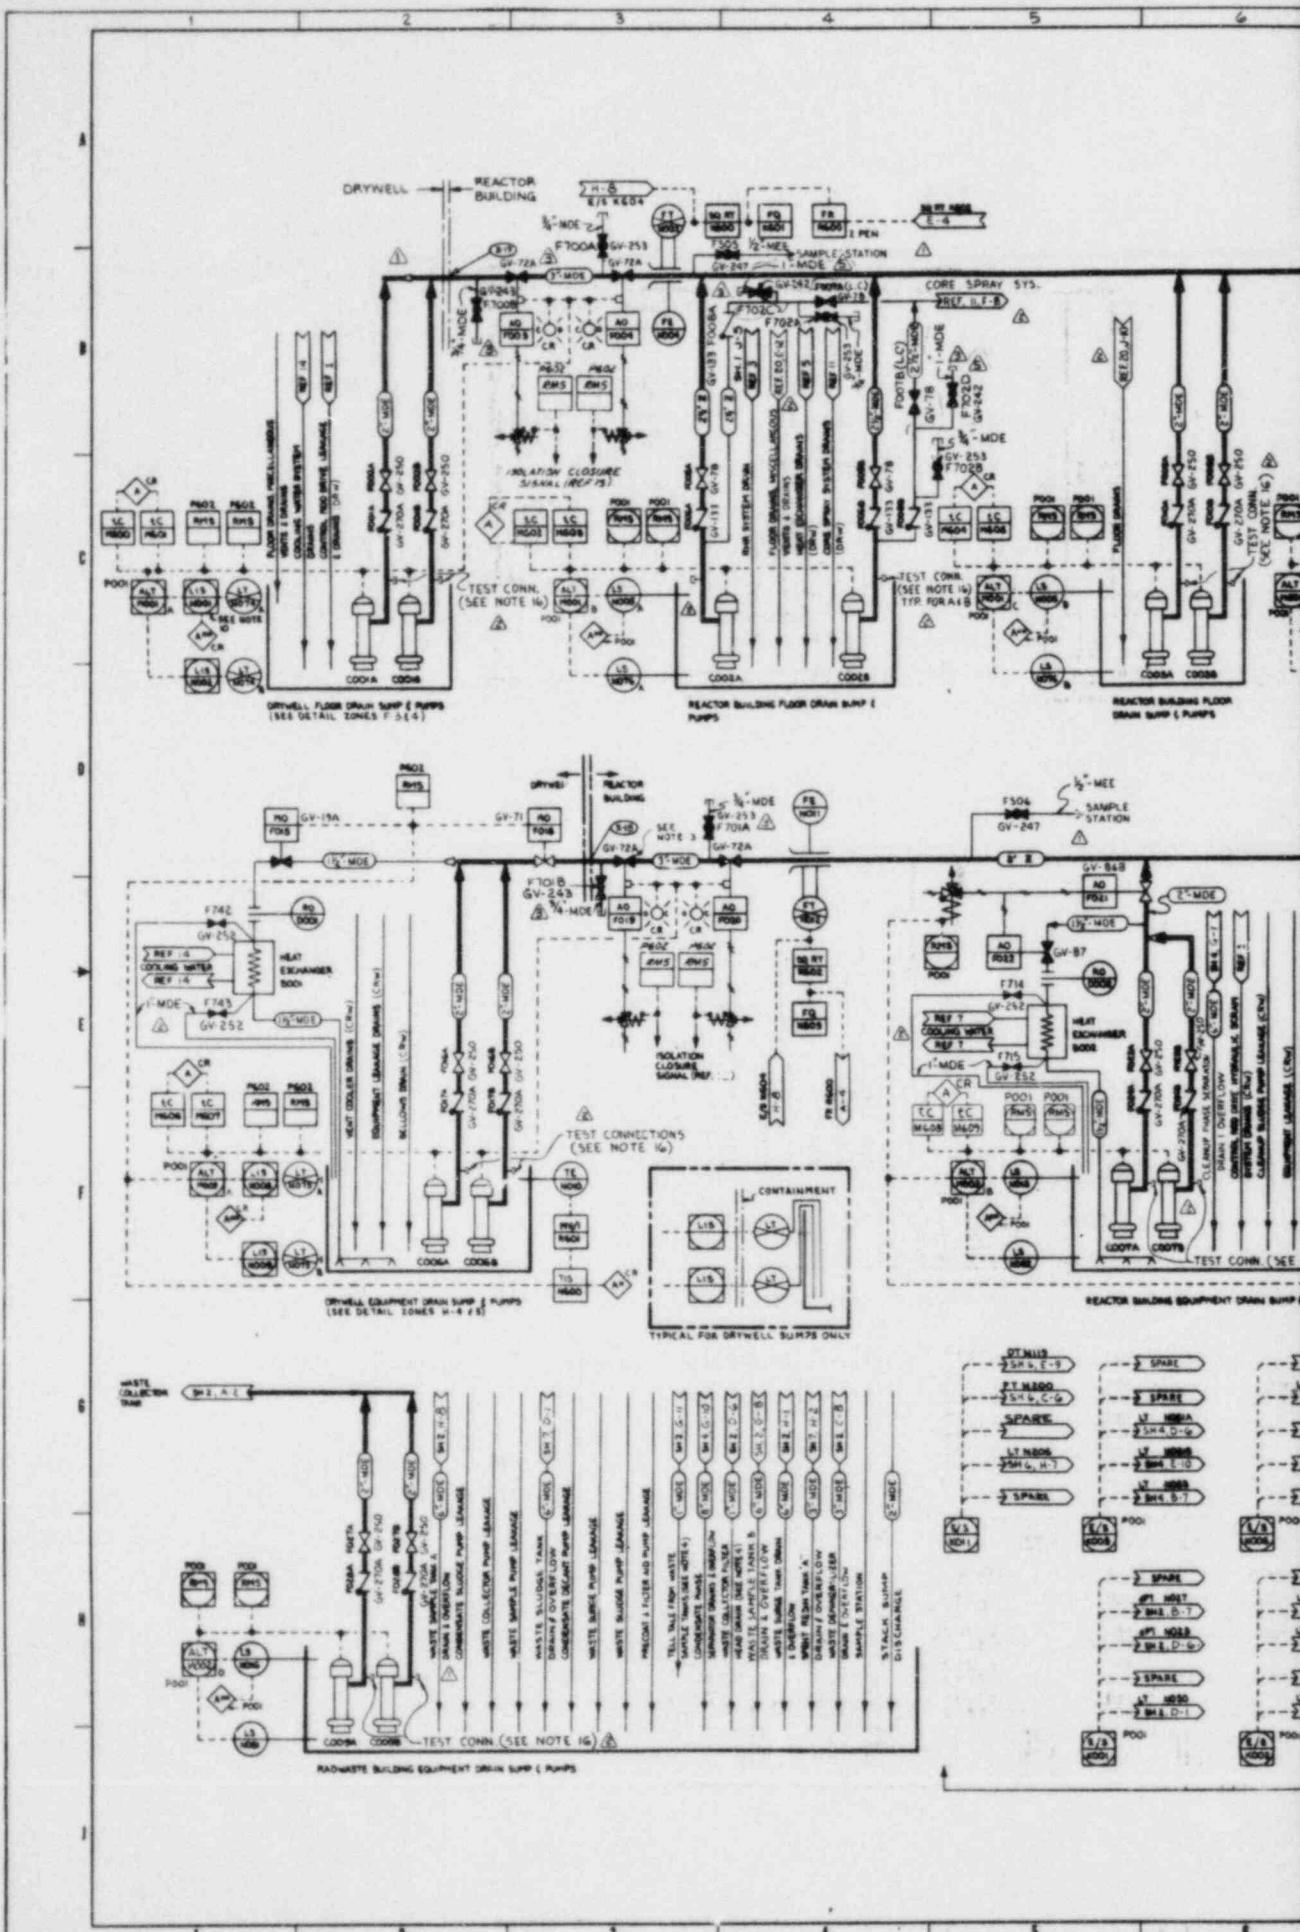

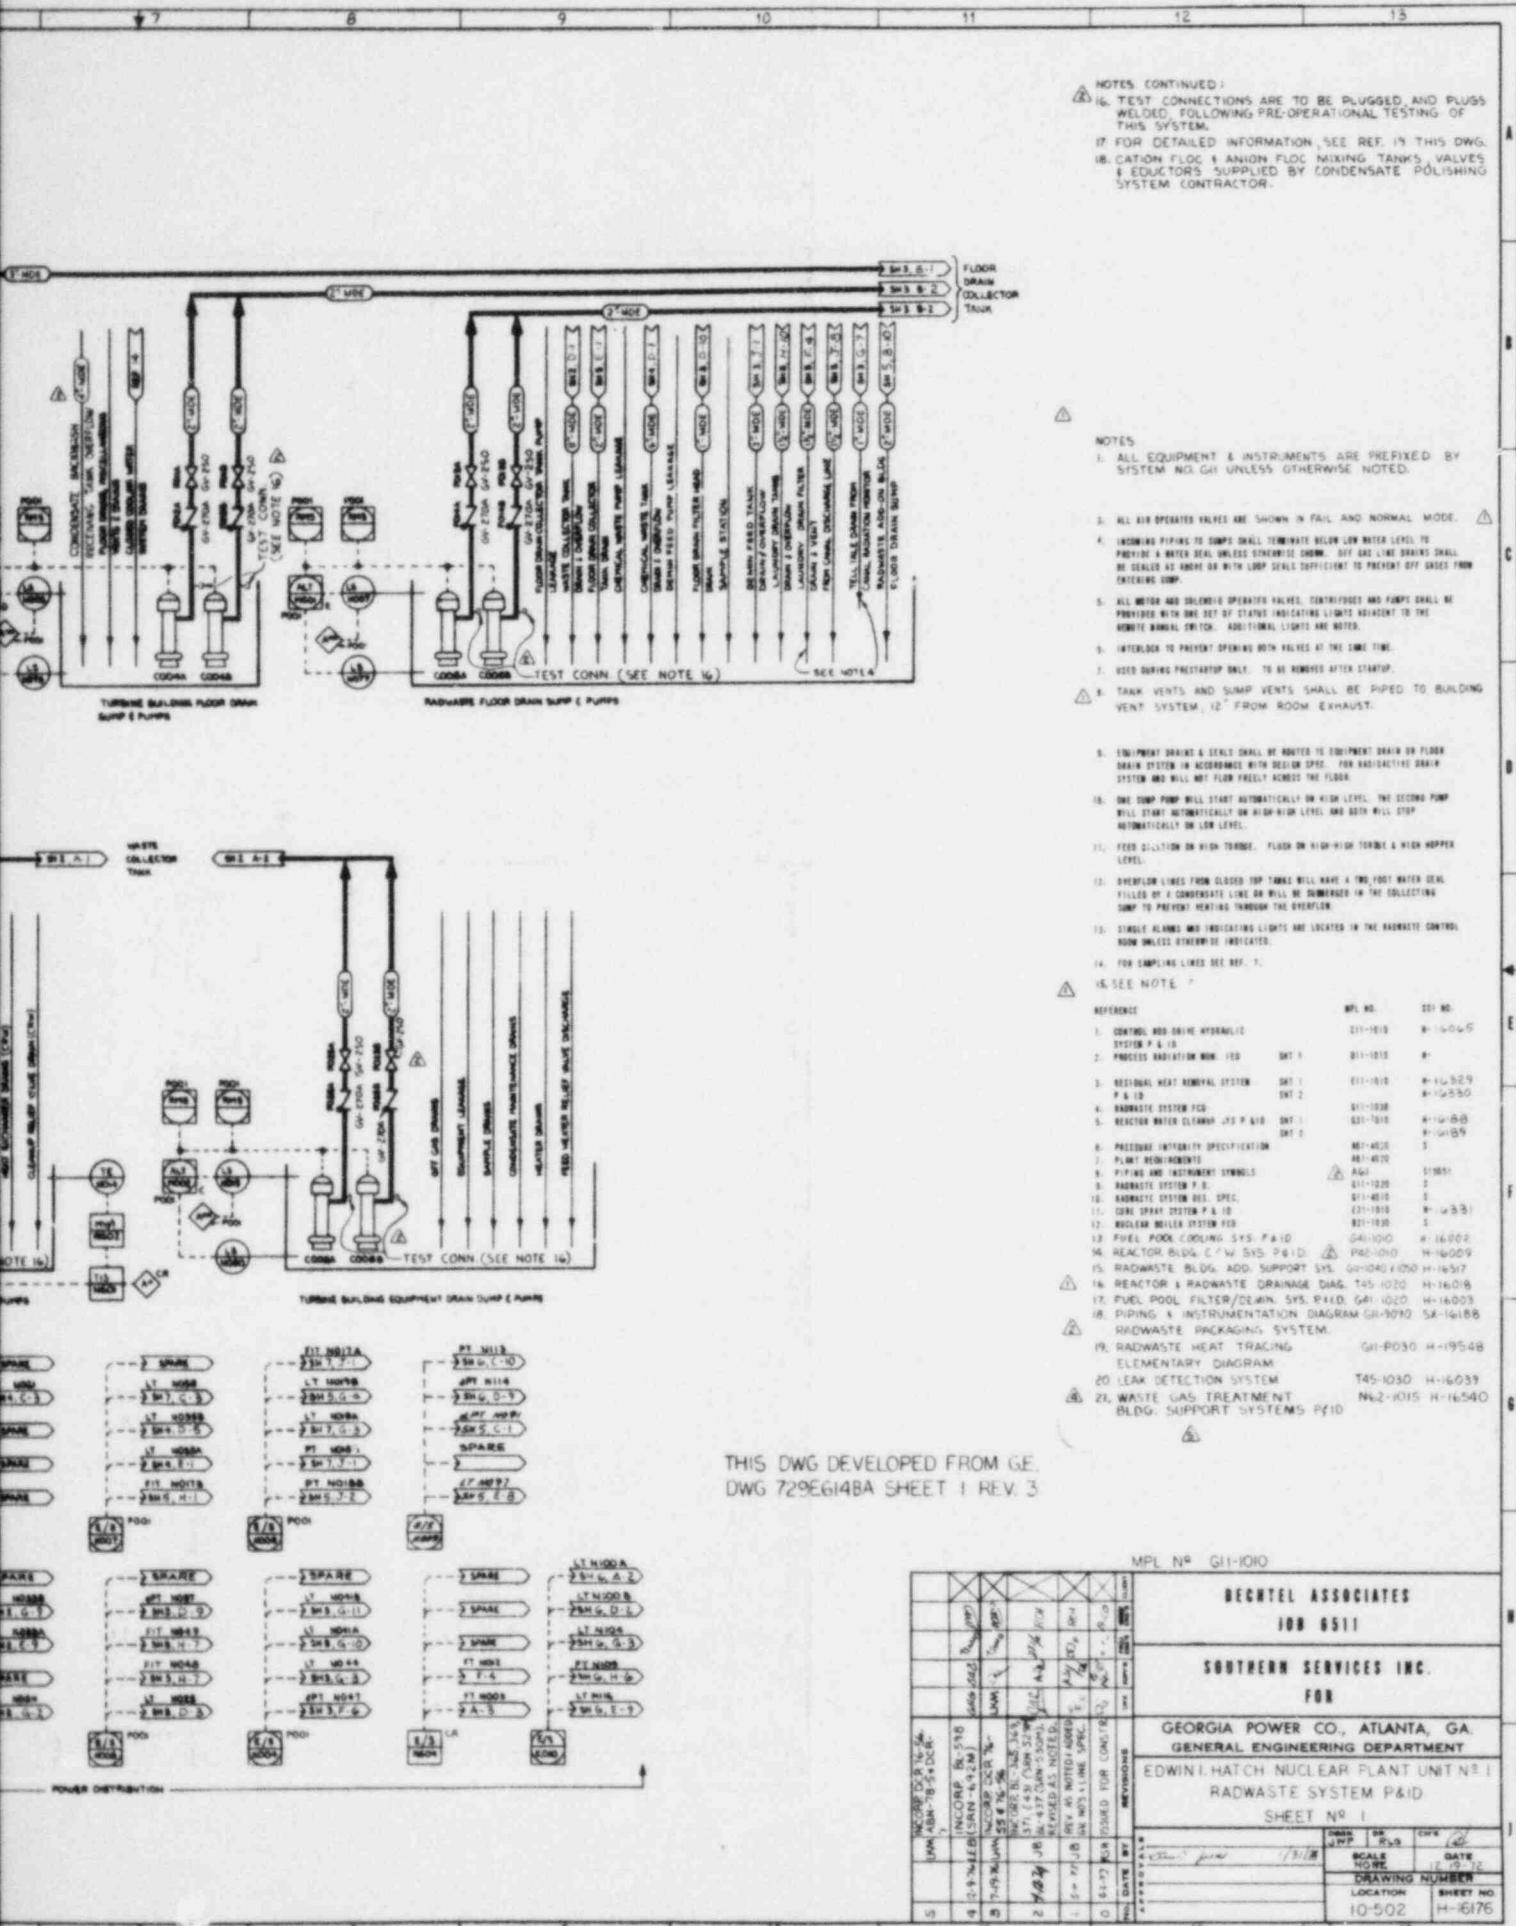

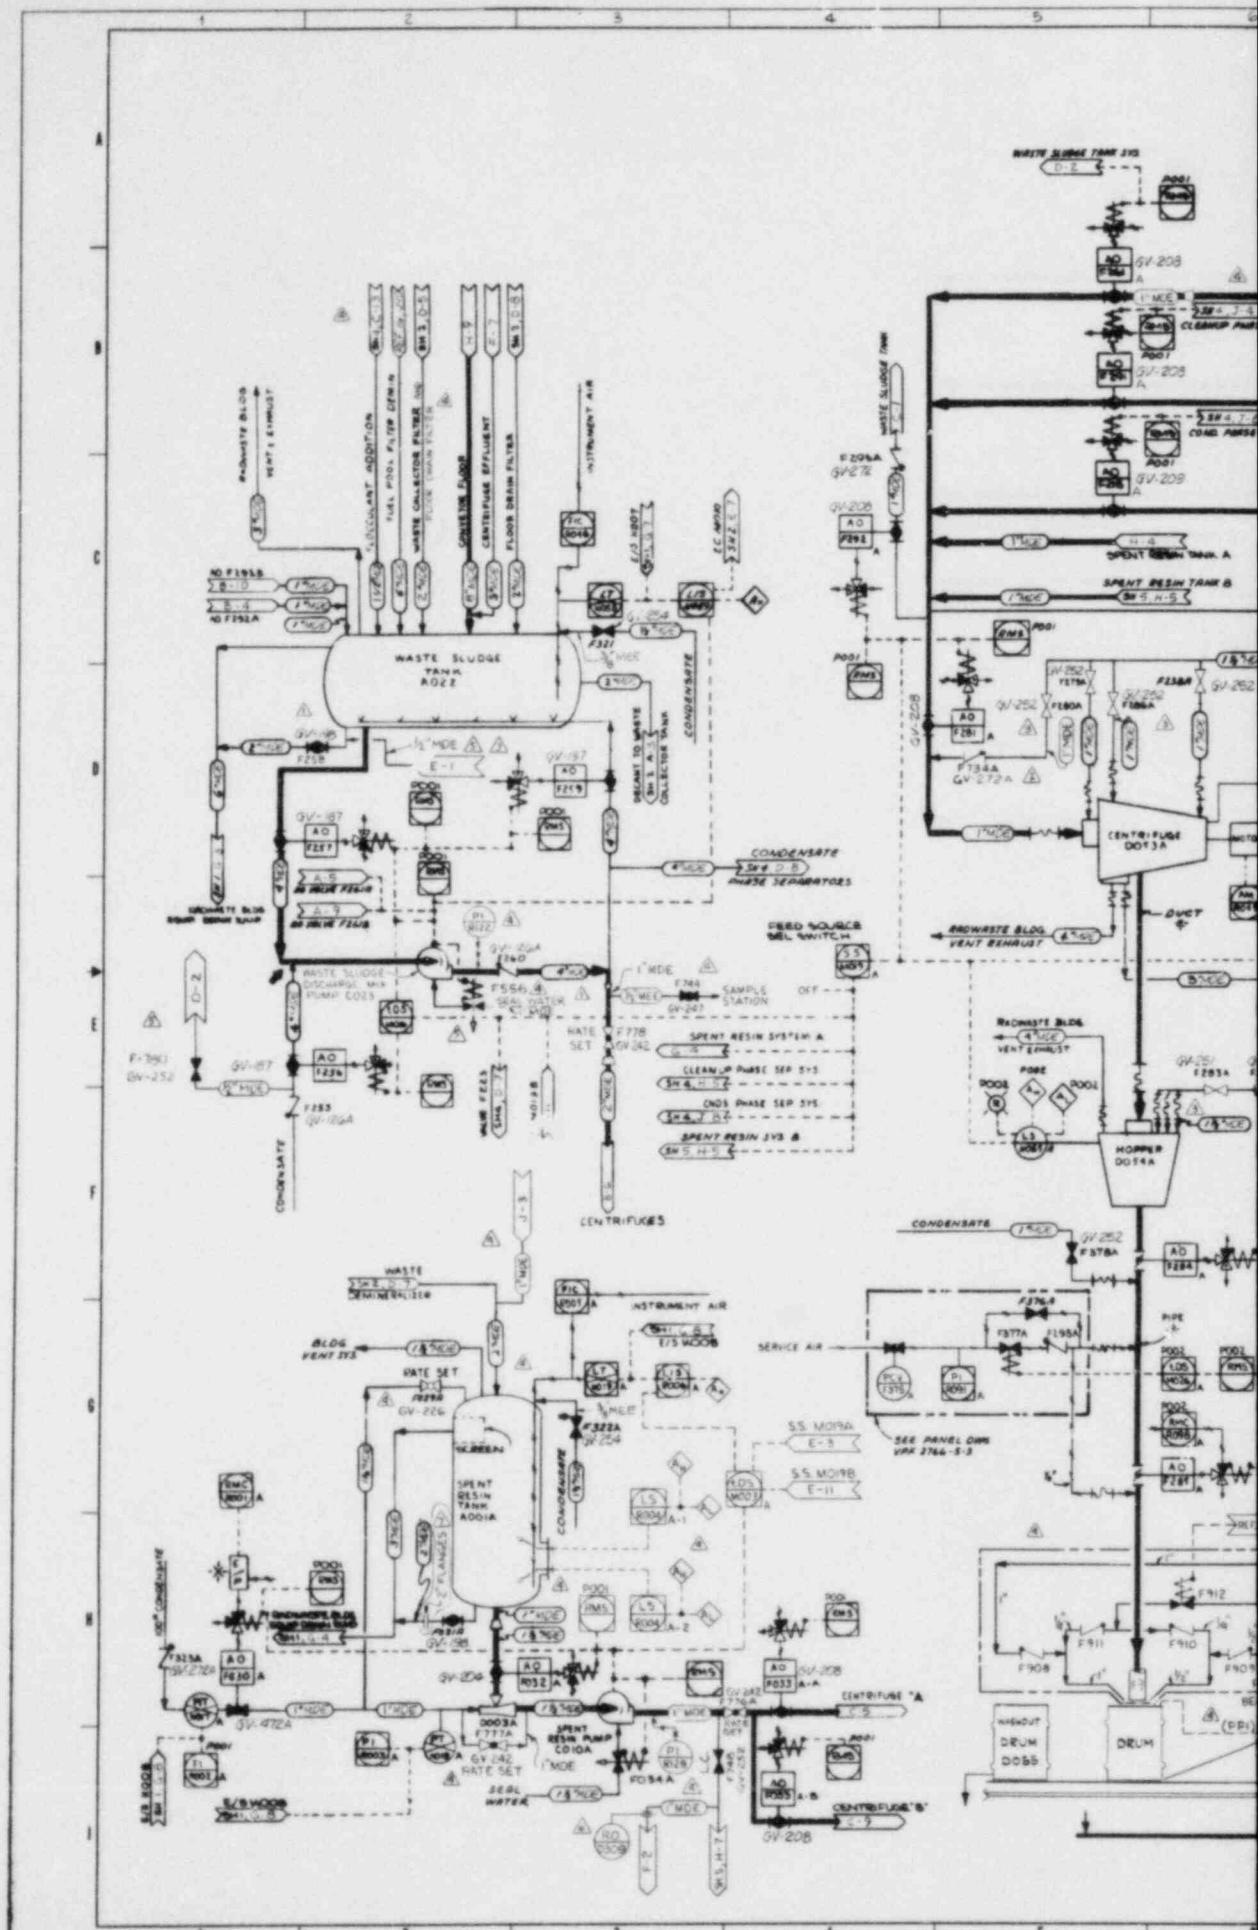

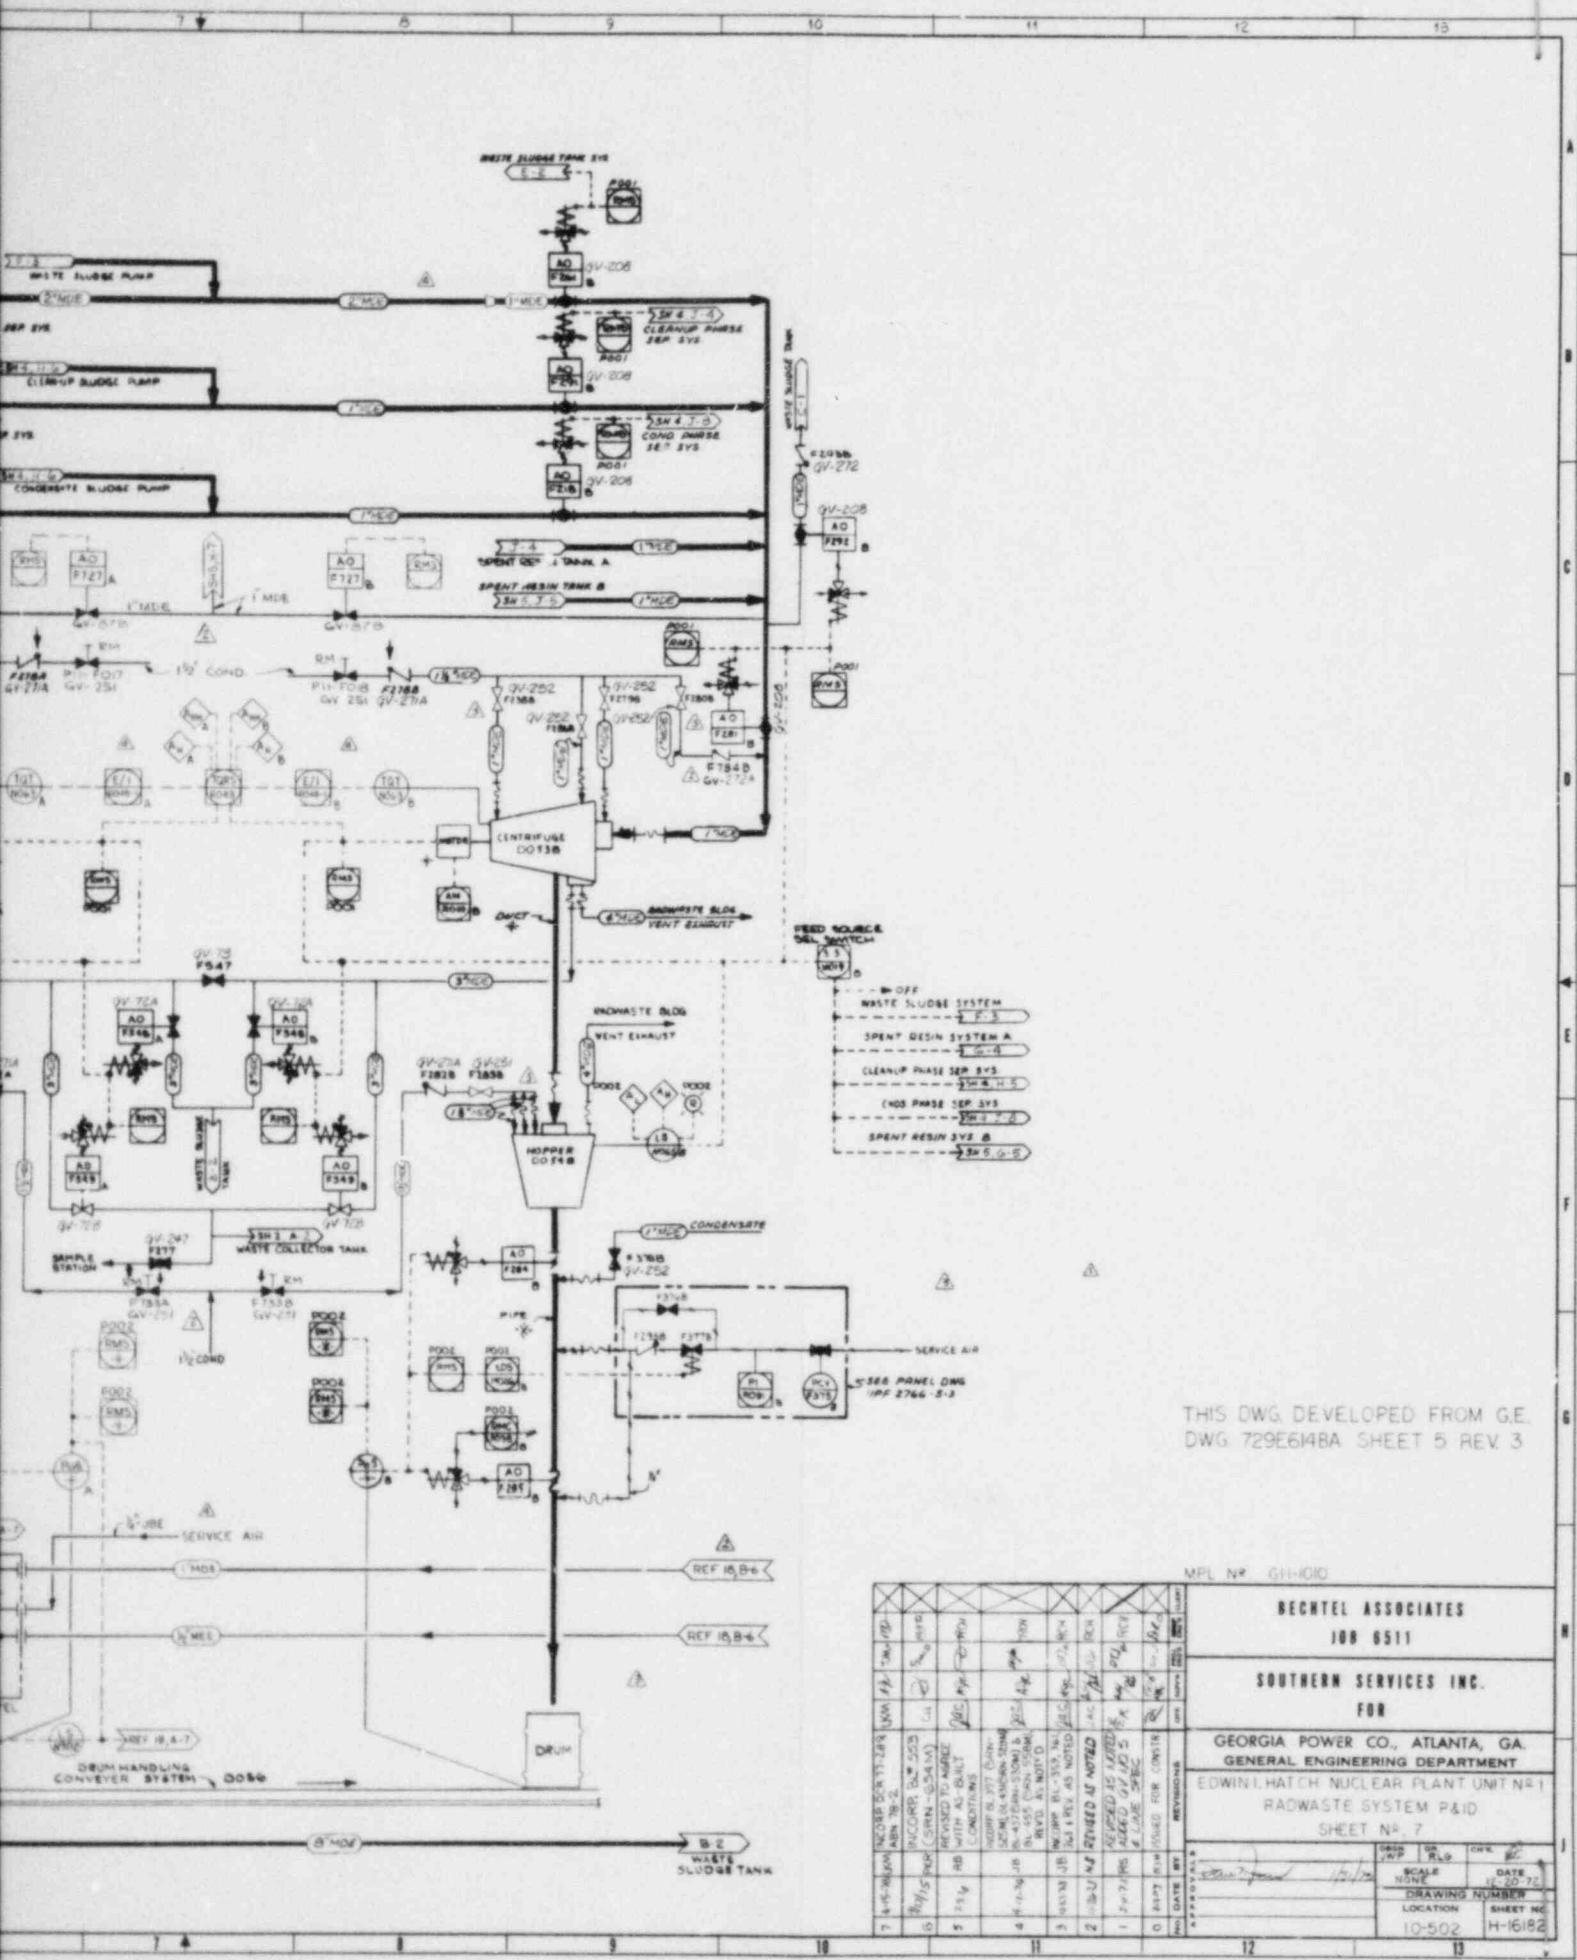

THIS DWG. DEVELOPED FROM G.E.  
DWG. 729E614BA SHEET 5 REV. 3

MPL NR GII-HGIO

BECHTEL ASSOCIATES  
108-6511

SOUTHERN SERVICES INC.

100

**GEORGIA POWER CO., ATLANTA, GA.  
GENERAL ENGINEERING DEPARTMENT**

EDWIN L. HATCH NUCLEAR PLANT UNIT NO 1

#### RADIATION WASTE SYSTEM PAID

SHEET N<sup>o</sup>. 7


DRUGS  
J.W.P. DR.  
R.G. CHEL.


SCALE  
NONE


DRAWING NUMBER


LOCATION STREET NO  
18502 H-16182

12 13

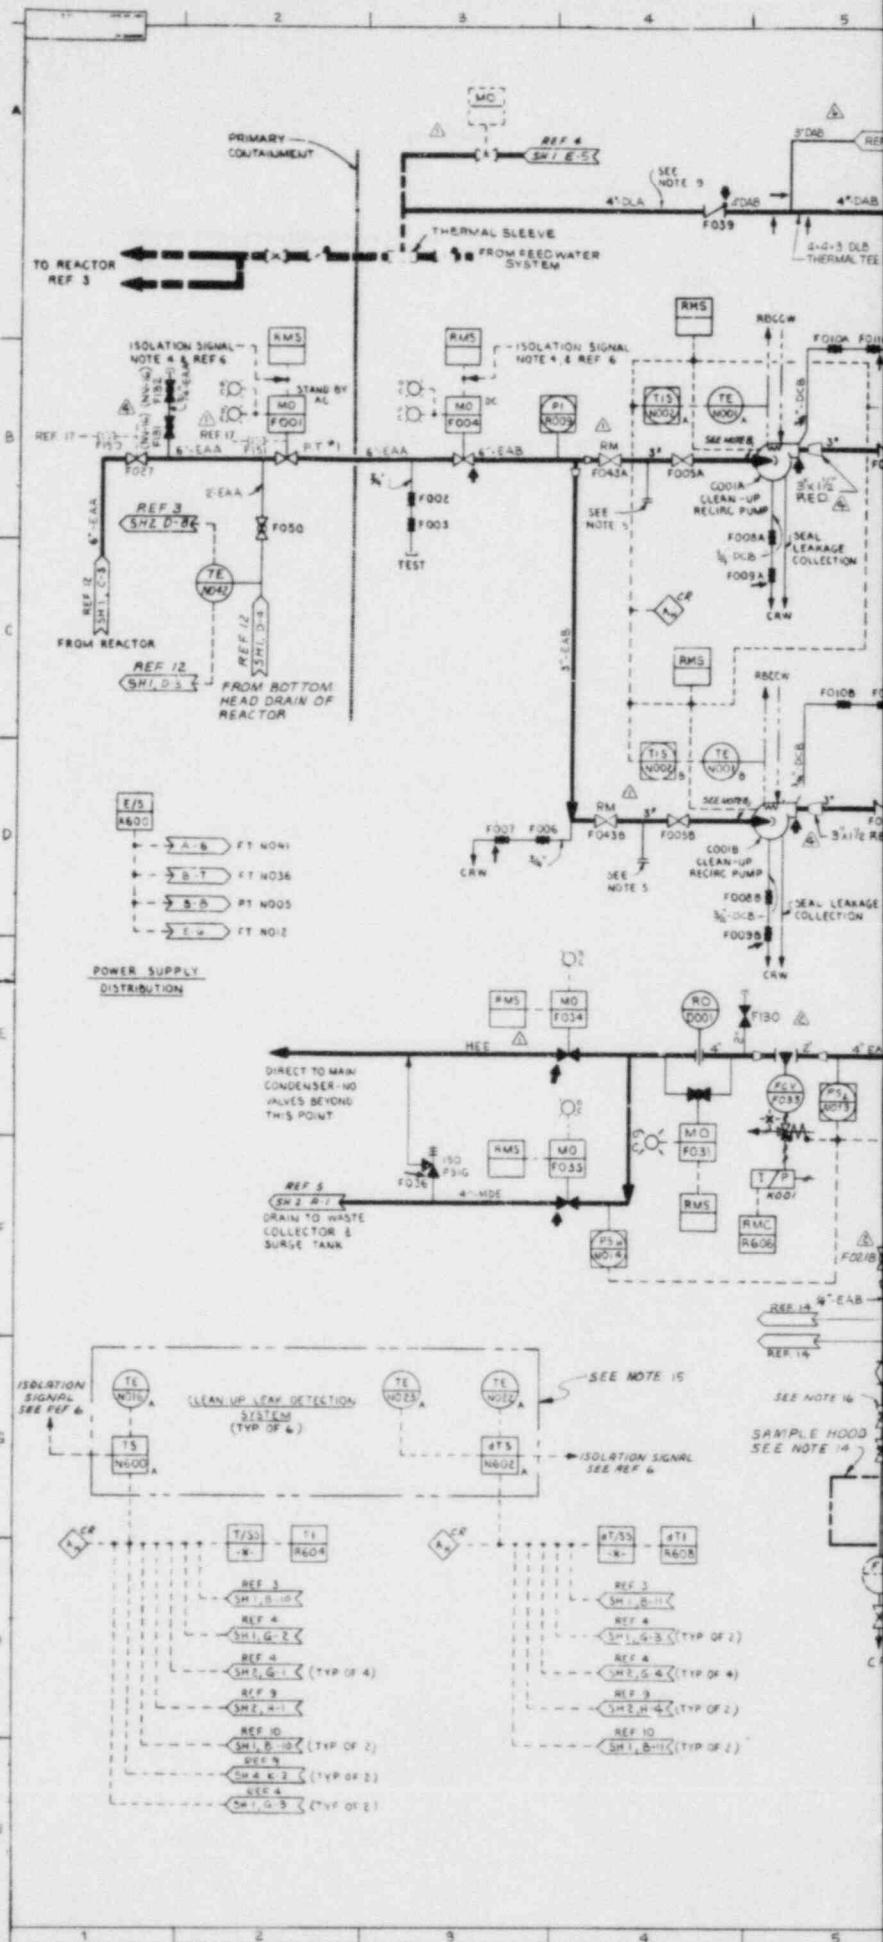

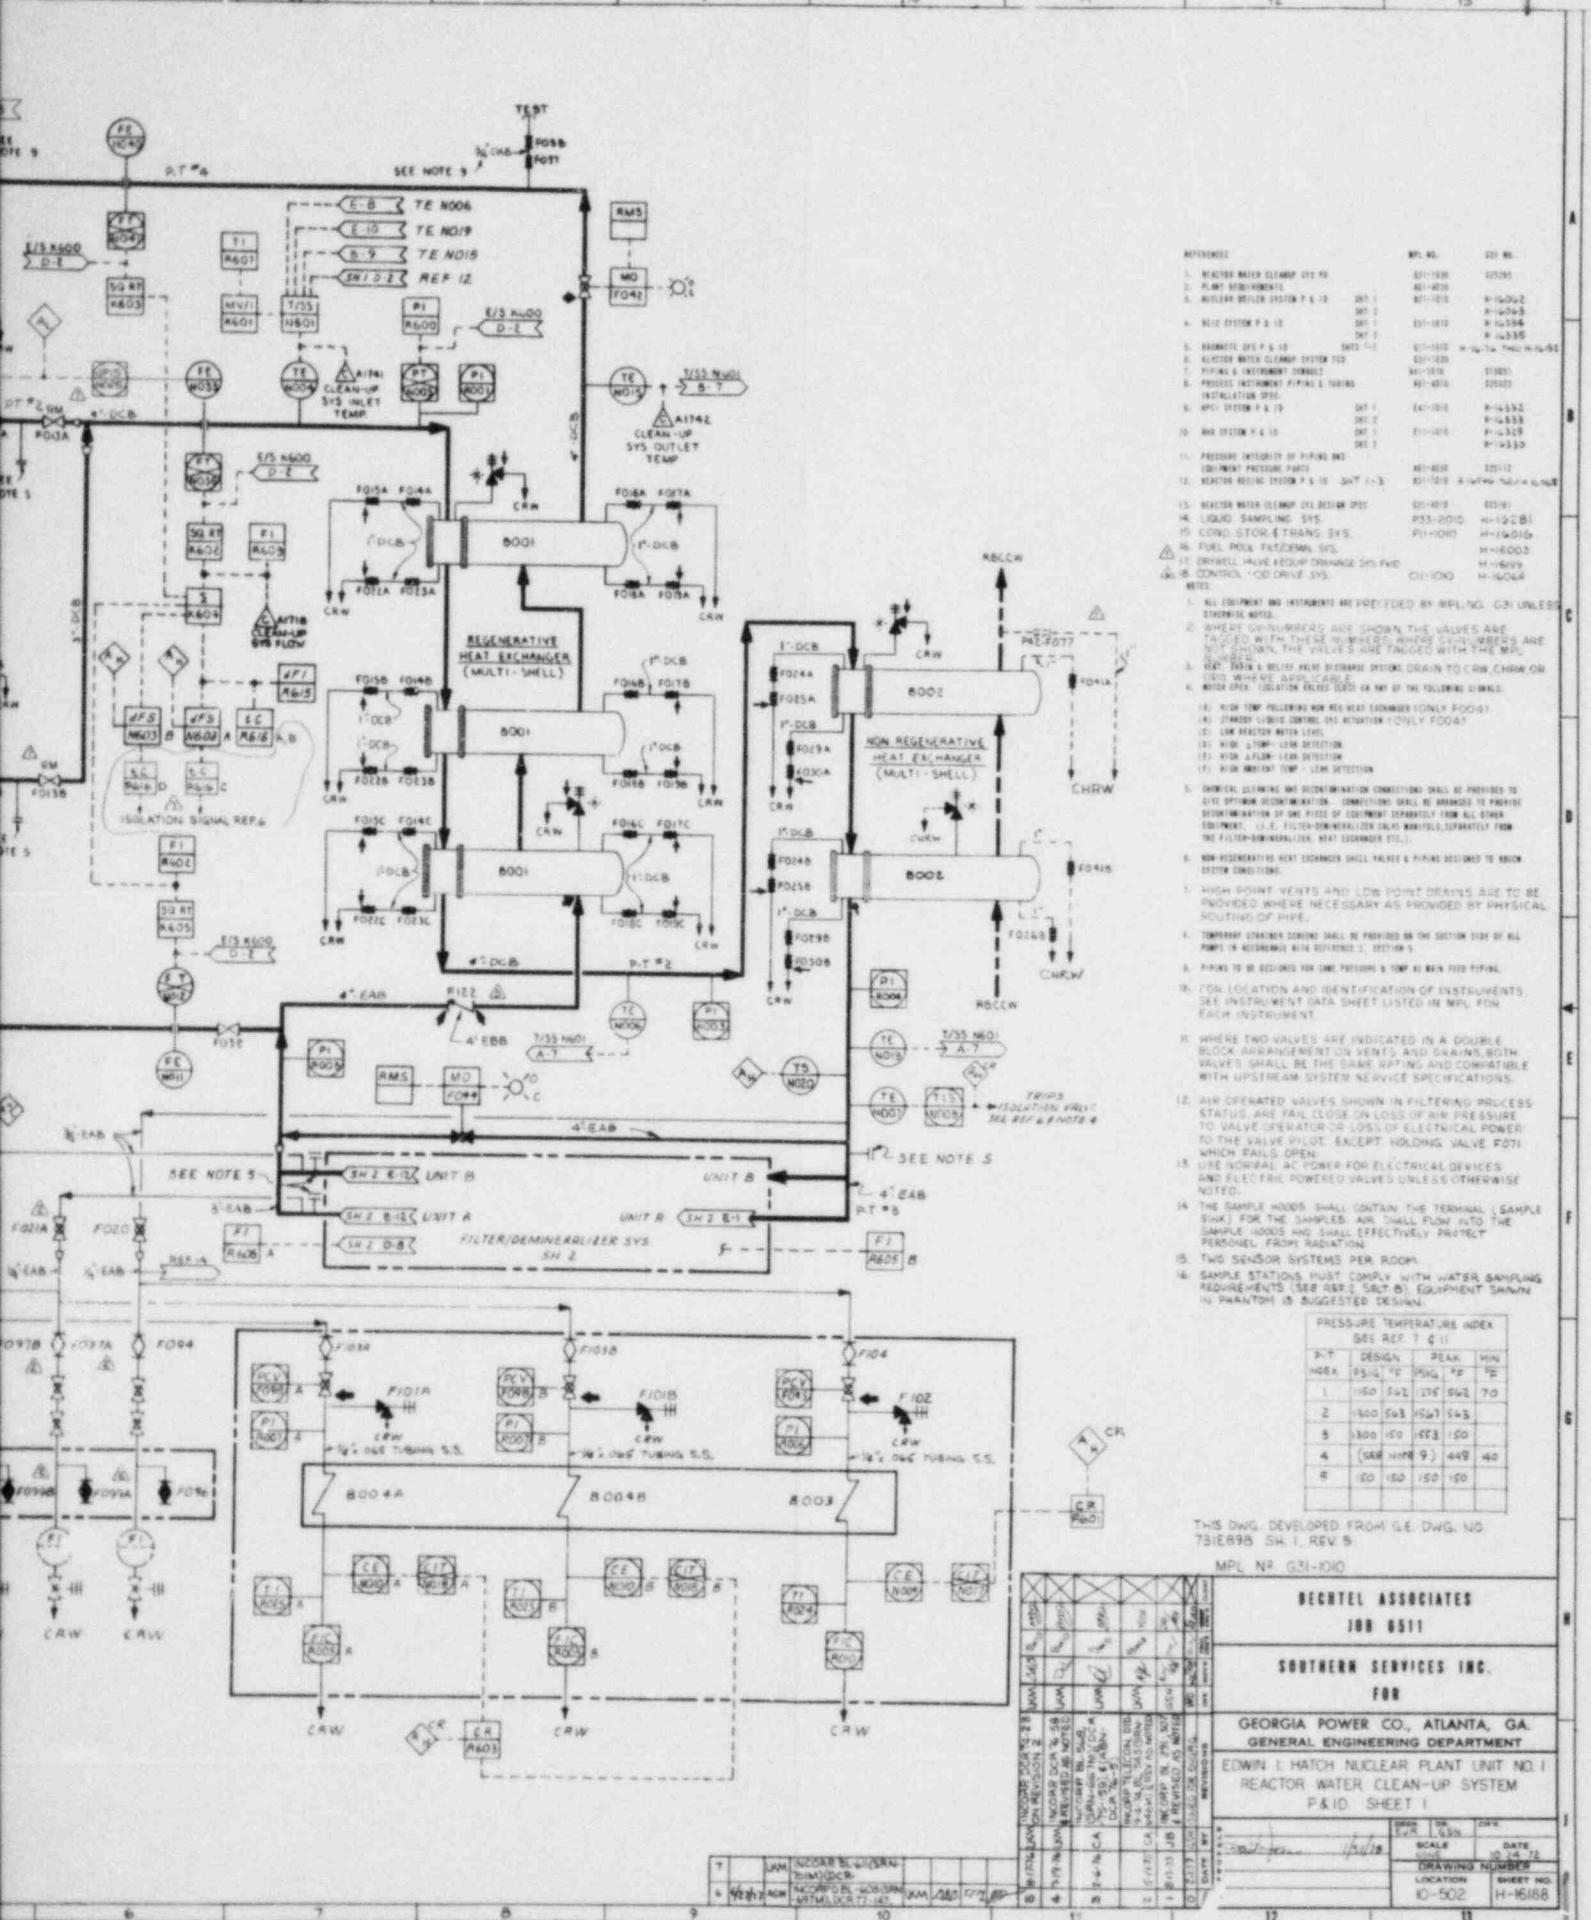

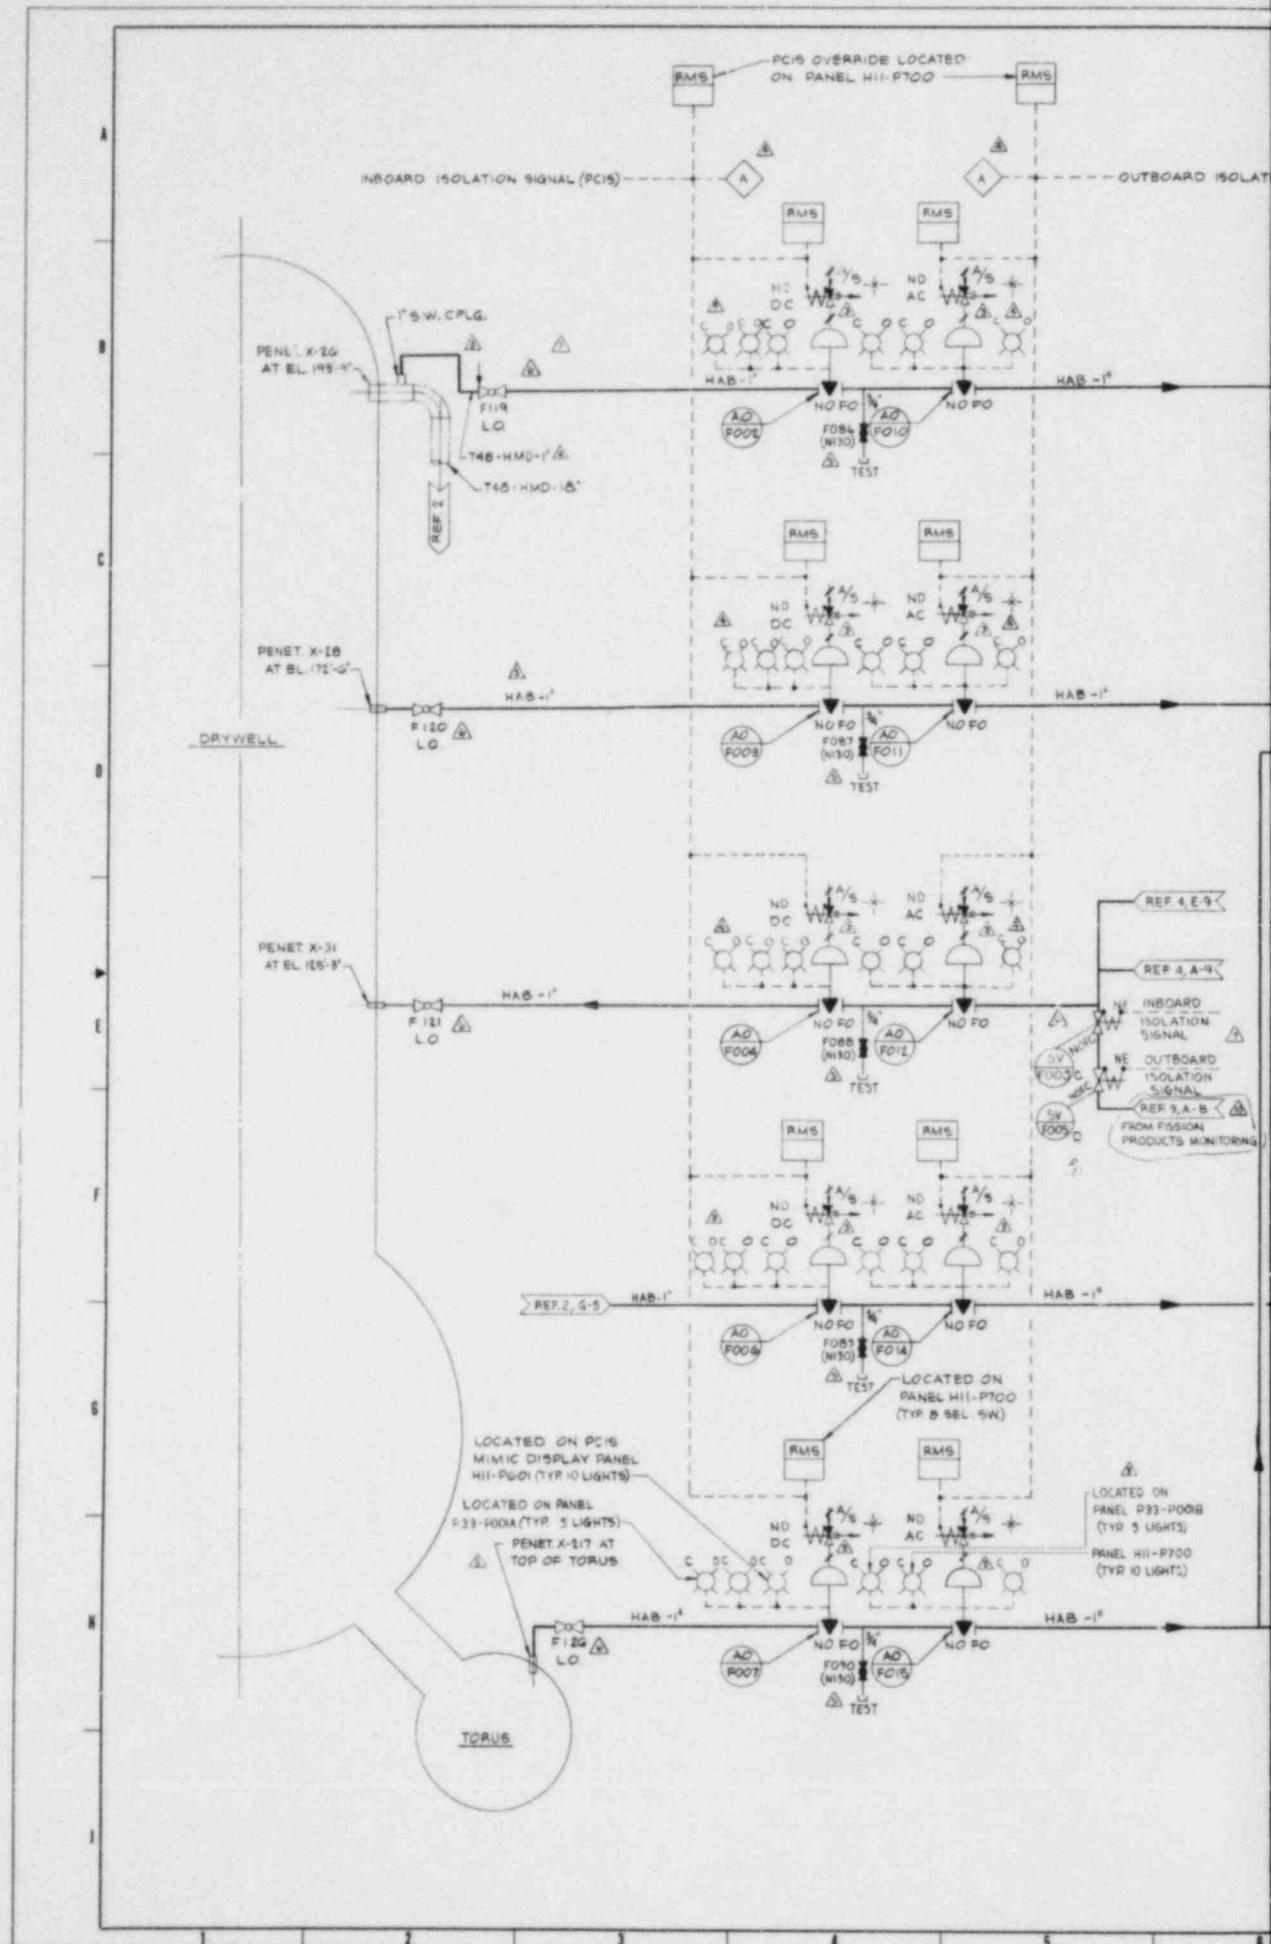

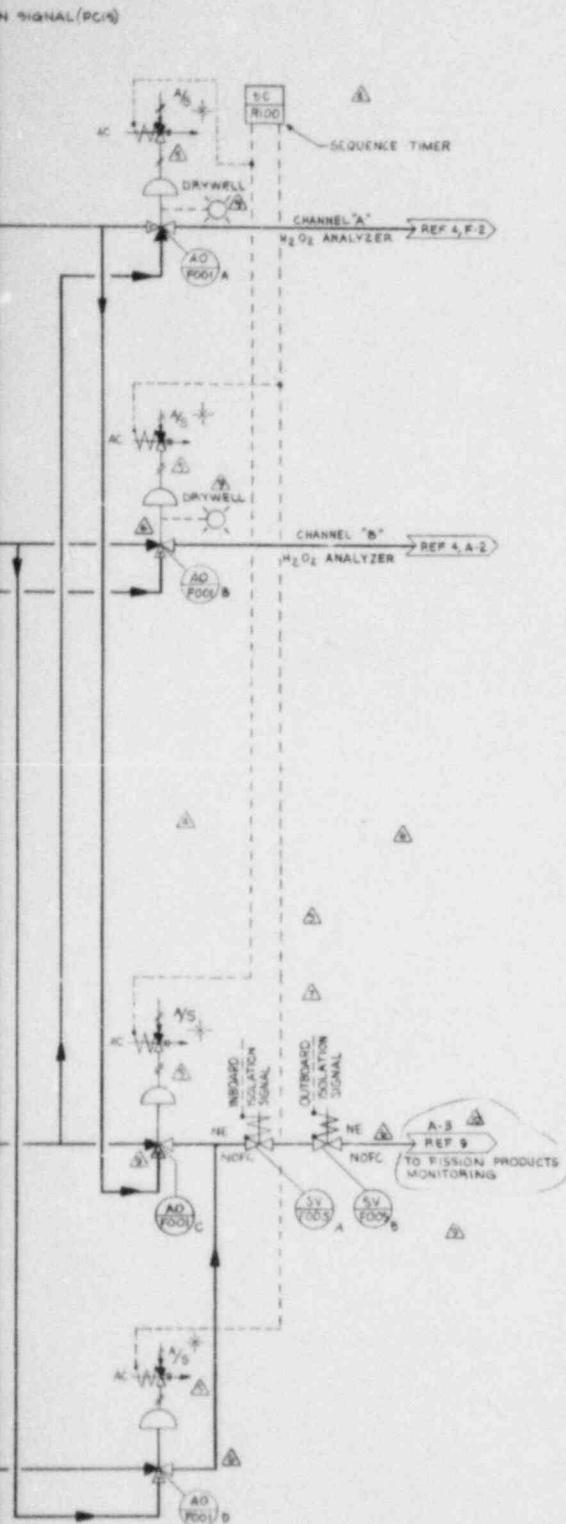

## NOTES.

1. ALL EQUIPMENT & INSTRUMENT NUMBERS ARE TO BE PRECEDED BY MPL PBS UNLESS OTHERWISE NOTED. EXAMPLE: P93-A001.
  2. REDUNDANT MODES:
    - A) ENERGIZE F001 A,C; DE-ENERGIZE F001 B,D
    - B) ENERGIZE F001 B; DE-ENERGIZE F001 A,C
  3. OPERATION: MODES WILL ALTERNATE AT 24HR INTERVALS
  4. SOLENOID VALVES F001 A,B,C,D SHOULD BE LOCATED AS CLOSE AS POSSIBLE TO THE H<sub>2</sub>O<sub>2</sub> ANALYZER AND FISSION PRODUCTS MONITORING PANELS.
  5. RETURN LINES SHOULD "TEE" TOGETHER AS CLOSE AS POSSIBLE TO THE H<sub>2</sub>O<sub>2</sub> ANALYZER AND FISSION PRODUCTS MONITORING PANELS.
  6. ROUTING OF THESE GAS SAMPLE LINES IS AS SHOWN ON REFERENCES 5,6,7,8.

## REFERENCES

REFERENCE	MPL NR.	S.S.NR.
1. PIPING & INSTRUMENT SYMBOLS	A44-1010 A	S-15051
2. PRIMARY CONT. PURGE T&G-1020 INERTING SYSTEM		H-16024
3. PRIMARY CONT. FISSION PRODUCTS MONITORING SYS	A44-1020 - P011	SZ-16927
4. H <sub>2</sub> O <sub>2</sub> ANALYZER SYSTEM P-33-1010 P-14 FOR PANEL NOS. P-33-P01A & B		H-16280
5. SAMPLE LINE ROUTINGS REACTOR & RADW.BLDGS. BELOW EL. 130'-0"		H-16553
6. SAMPLE LINE ROUTINGS REACTOR & RADW. BLDGS. EL. 130'-0"		H-16554
7. SAMPLE LINE ROUTINGS REACTOR & RADW. BLDGS. EL. 158"-0"		H-16556
8. SAMPLE LINE ROUTINGS REACTOR & RADW. BLDGS. EL. 185"-0"		H-16557
9. FISSION PRODUCTS MONITORING SYS. P41.D		H-16274


MPN NO PBB-1010



BECHTEL ASSOCIATES  
108-6511

SOUTHERN SERVICES INC


GEORGIA POWER CO., ATLANTA, GA.  
GENERAL ENGINEERING DEPARTMENT

**EDWIN I. HATCH NUCLEAR PLANT UNIT NO. 1  
PRIMARY CONTAINMENT ATMOSPHERE**

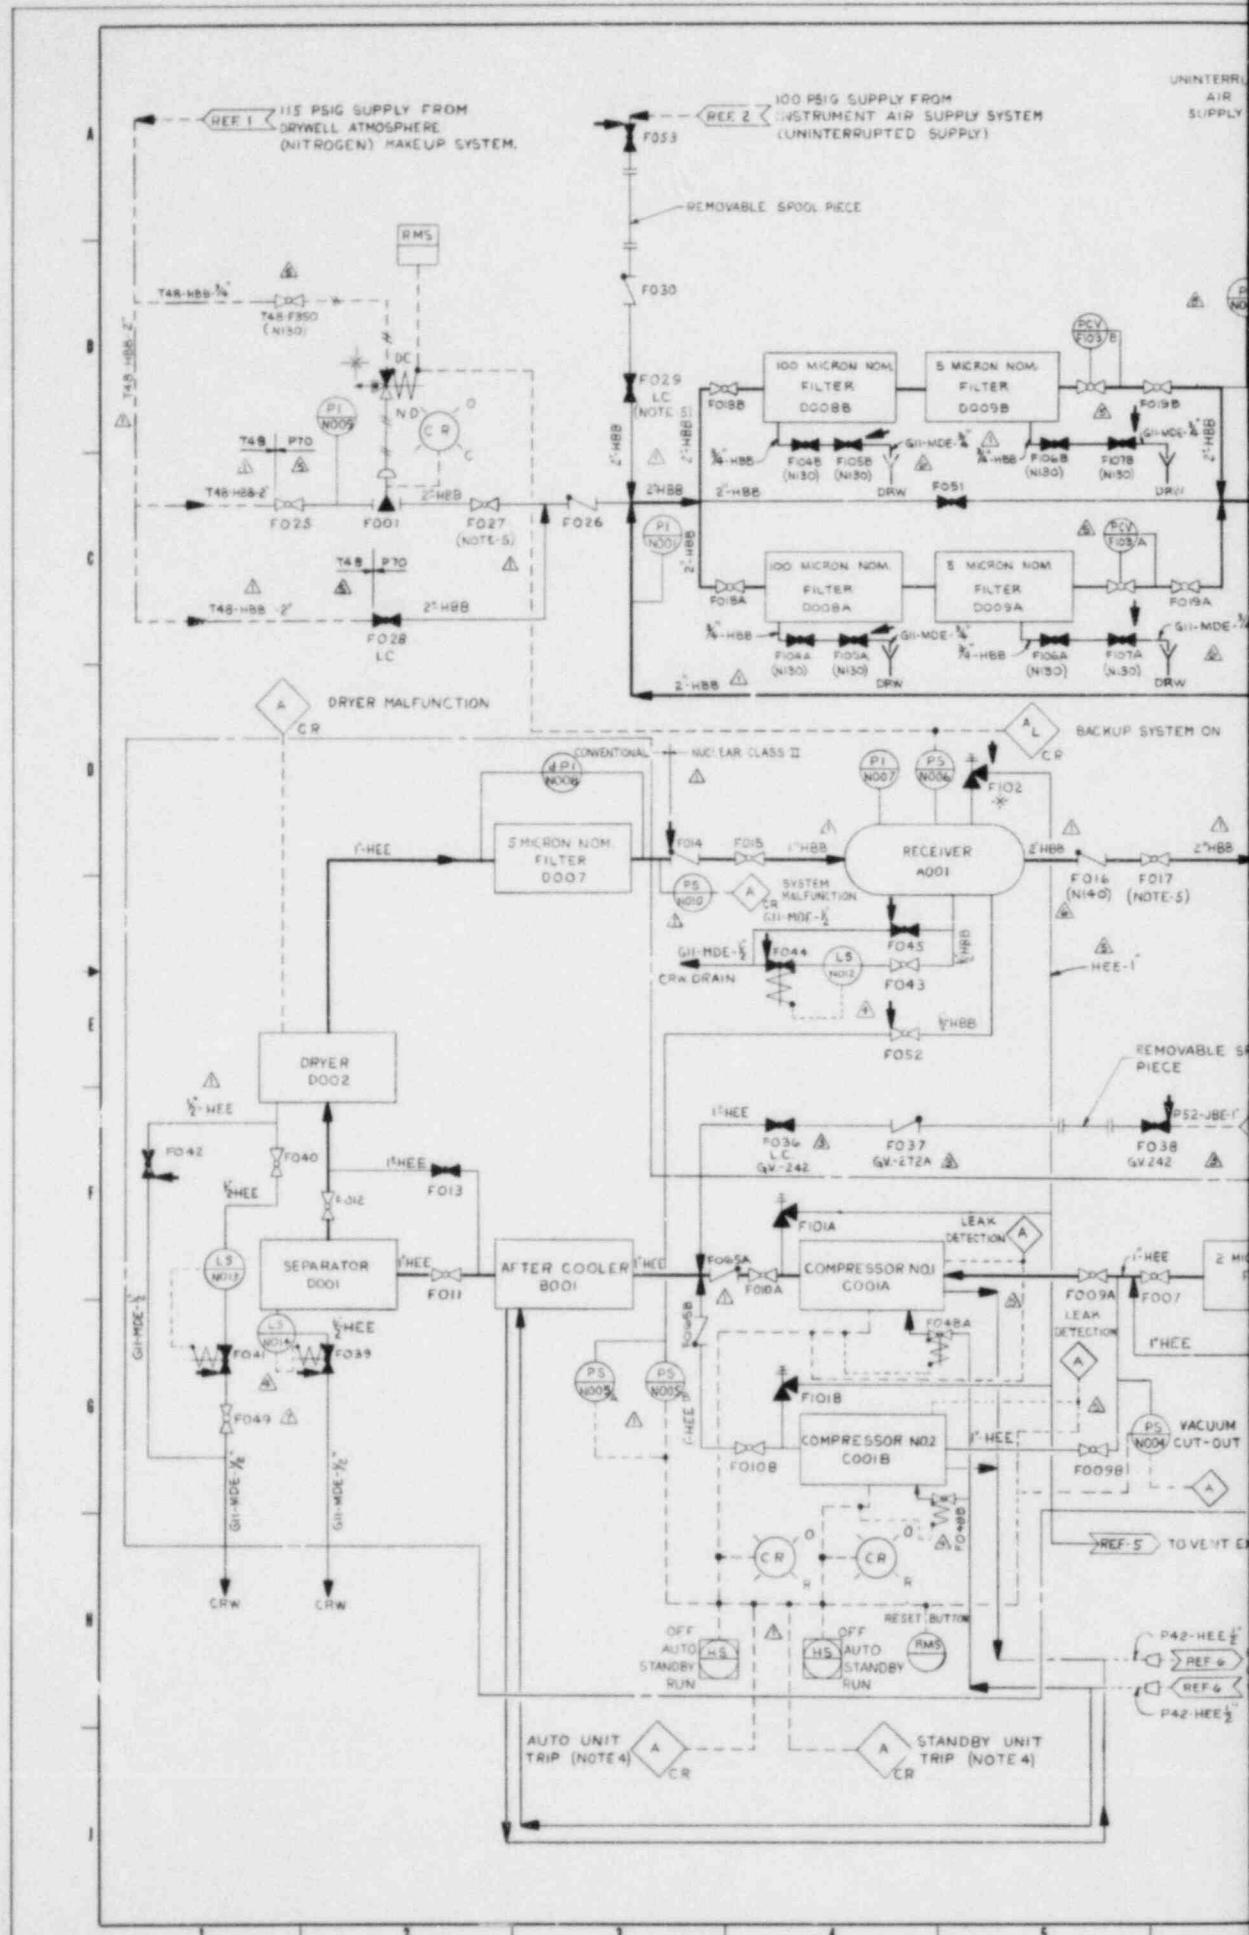

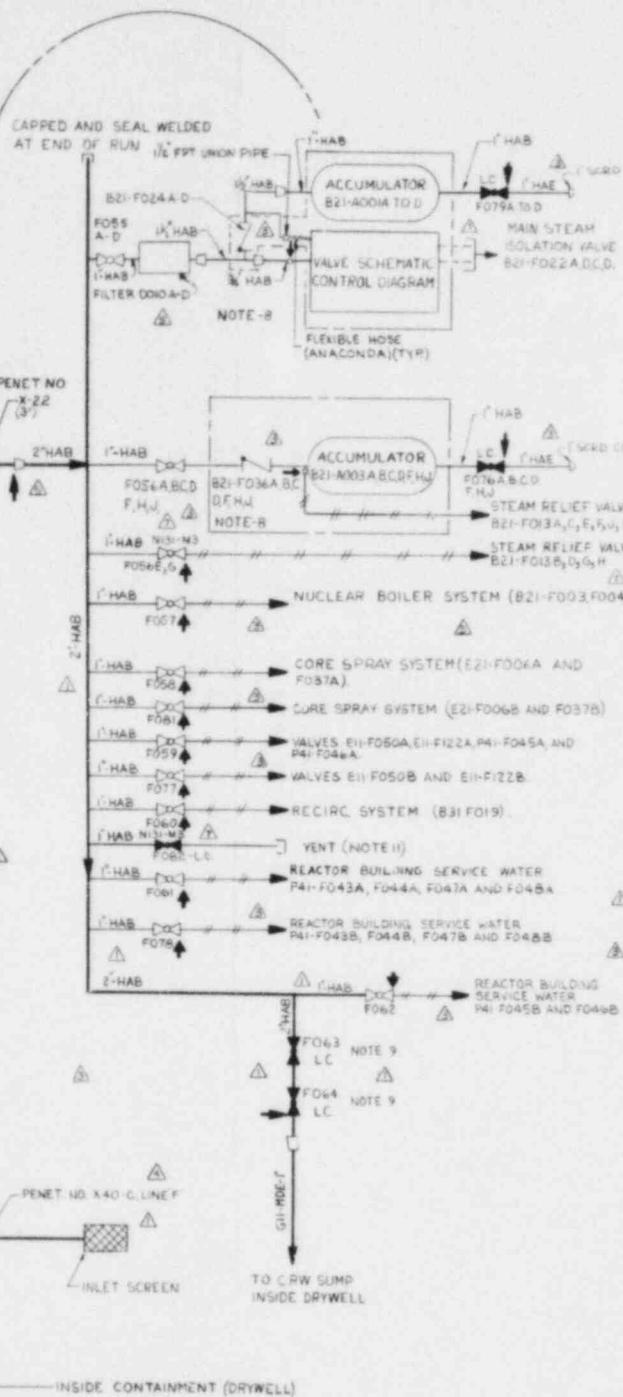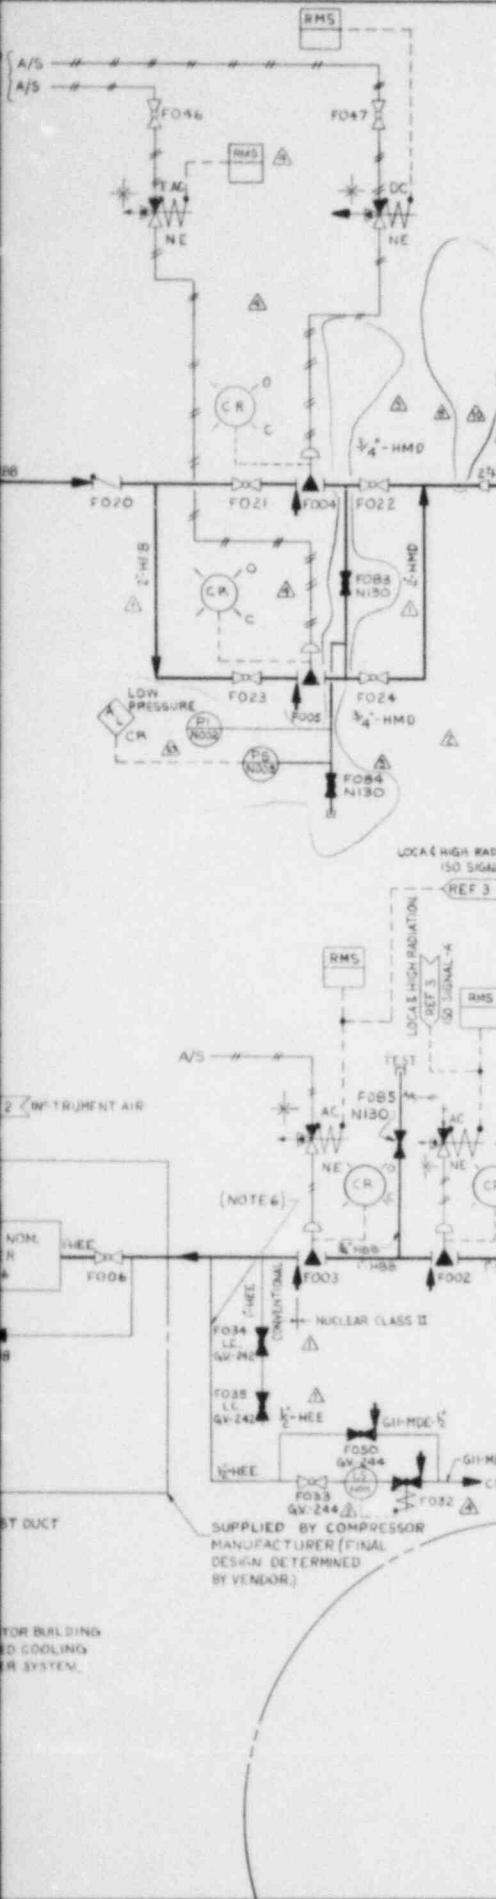

- REFERENCES
- | REFERENCES  | MPL NO.     | SS. NO. |
|---|-------------|---------|
| 1. NITROGEN INERTING SYSTEM P&ID                        | T48-1010    | H-16000 |
| 2. INSTRUMENT AIR SYSTEM P&ID                           | P52-1010    | H-16235 |
| 3. PRIMARY CONTAINMENT ISOLATION SYSTEM (BECHTEL PLAN)  | H-17801-804 | △ □     |
| 4. PIPING AND INSTRUMENTATION P&ID SYMBOLS              |             | Z10051  |
| 5. REACTOR BUILDING VENTILATION SYSTEM P&ID             | T48-1010    | H-16005 |
| 6. REACTOR BUILDING CLOSED P&ID<br>COOLING WATER SYSTEM |             | H-16009 |
- MPL. NO:P70-1010 (LVN 03)
- BECHTEL ASSOCIATES  
JOB 8511
- SOUTHERN SERVICES INC.  
FOR  
GEORGIA POWER CO., ATLANTA, GA.  
GENERAL ENGINEERING DEPARTMENT  
EDWIN L HATCH NUCLEAR PLANT UNIT NO. 1  
DRYWELL PNEUMATIC SYSTEM  
P&ID
- DRAFTER: J. A. BROWN DATE: 4/16/75  
REVIEWER: C. A. REED DATE: 4/16/75  
APPROVED: R. L. HATCH DATE: 4/16/75  
DRAWING NUMBER: 10-502 H-16286  
LOCATION: SHEET NO. 13

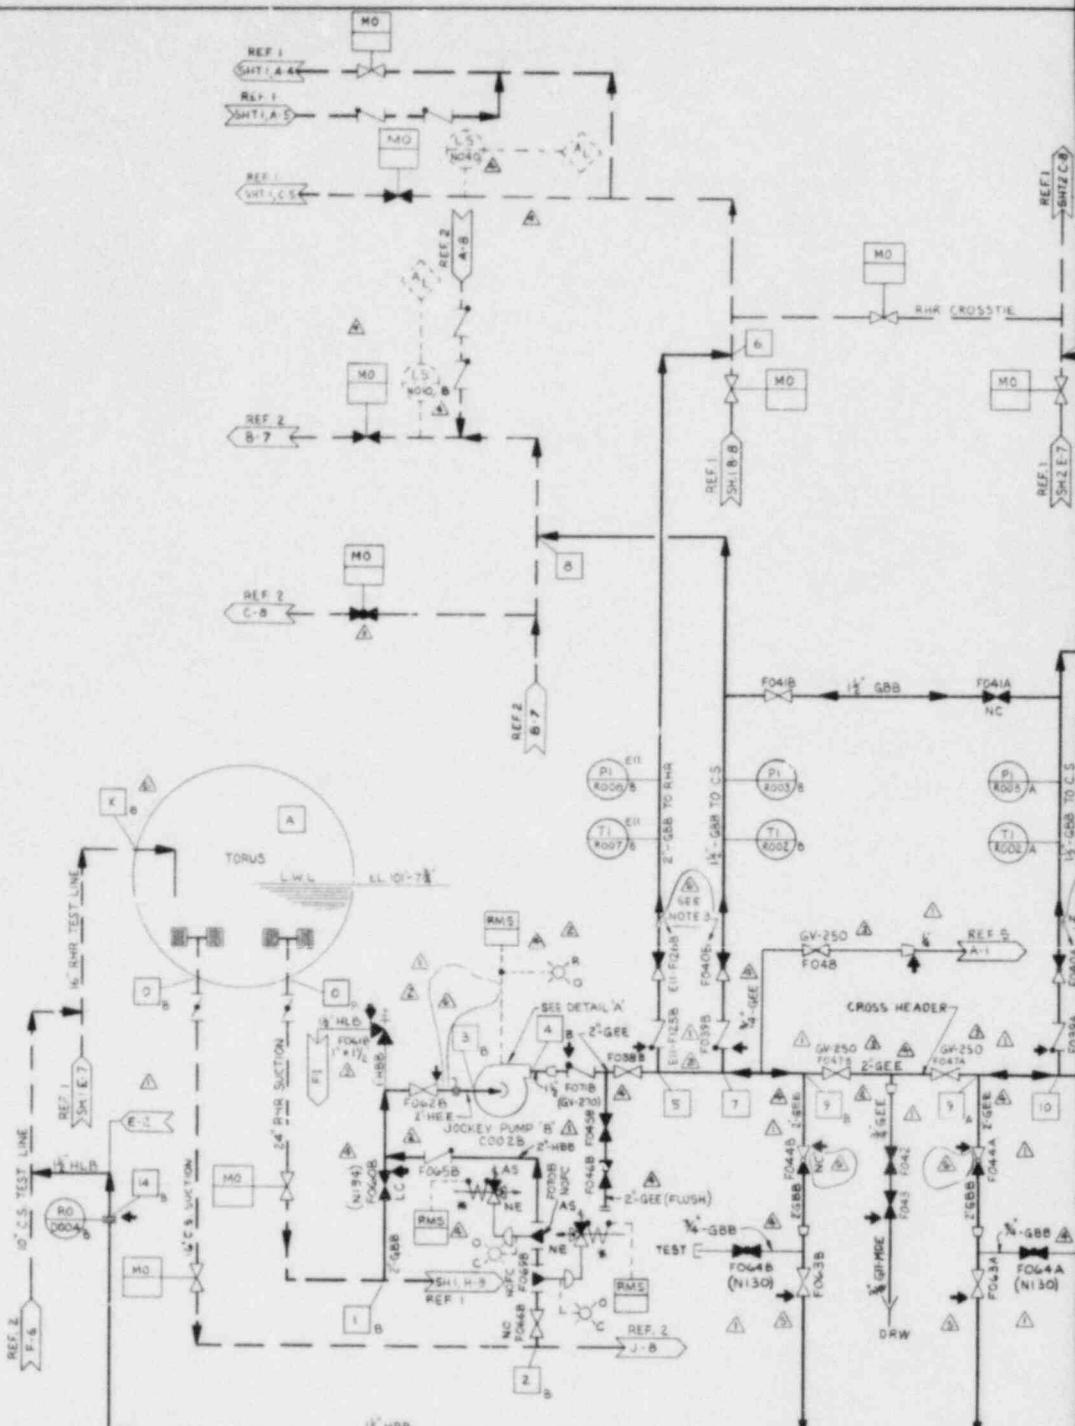

MODE A - FULL FLOW TO RHR PUMPS DISCHARGE LEG (FAR SIDE)


POSITION	A	O <sub>A</sub>	I <sub>A</sub>	O <sub>A</sub>	2A	3A	4A	5	G	7	9 <sub>A</sub>	10	12	X <sub>A</sub>
FLOW - GPM	-	0	40	-	30	-	40	-	10					
PRESSURE - PSIA	14.7													
TEMP - °F (MAX)	200°													
MAX. PRESSURE DROP - FEET														

REQD TDH = 121.5 FT.

MODE B - FULL FLOW TO C.S. PUMP DISCHARGE LEG

POSITION	A	O <sub>A</sub>	I <sub>A</sub>	O <sub>A</sub>	2A	3A	4A	5
FLOW - GPM	-	0	40	-	30	-	30	-
PRESSURE - PSIA	14.7							
TEMP - °F (MAX)	200°							
MAX. PRESSURE DROP - FEET								

REQD TDH = 126 FT.

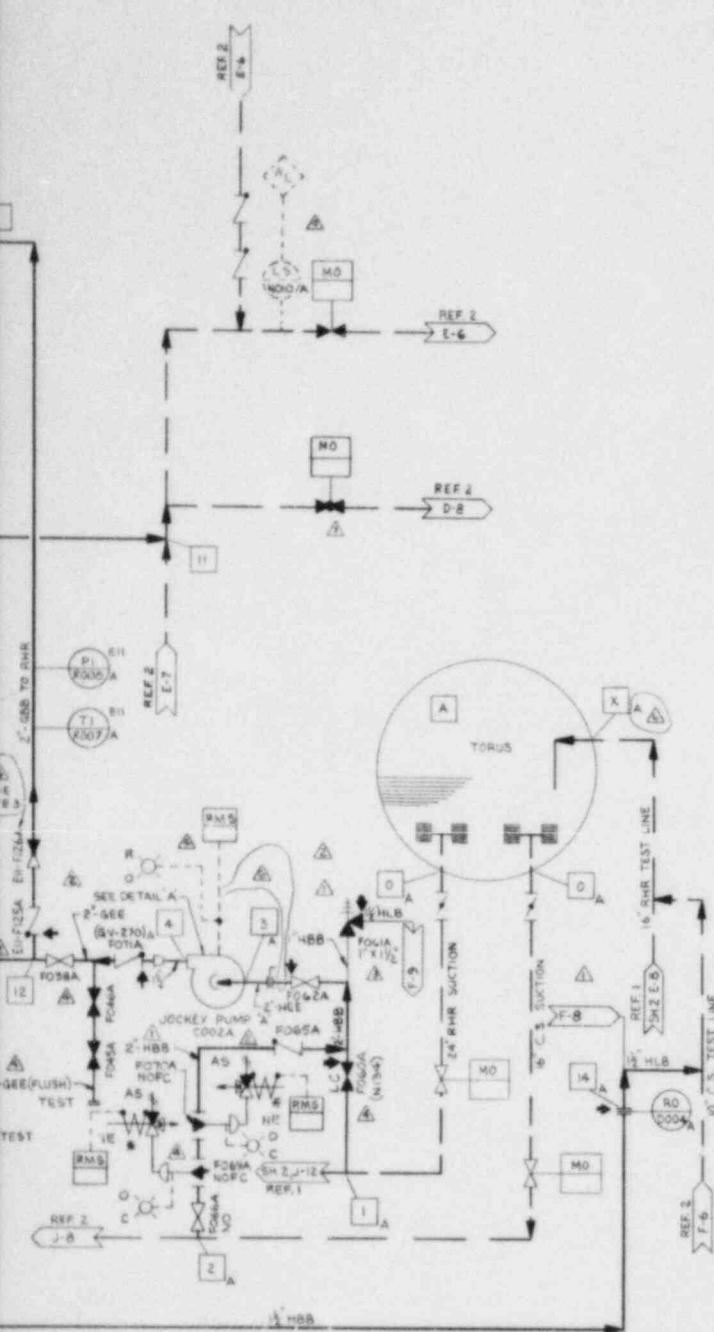

## MODES

MODE A - FULL FLOW FOR EXCESS AMOUNT OF LEAKAGE AT CHECK VALVE SEATS EII-F0BIA OR C (REF. 1, SH.1&2).  
MODE B - FULL FLOW FOR EXCESS AMOUNT OF LEAKAGE AT CHECK VALVE SEAT E2I-F0B3A (REF. 2).  
MODE C - NORMAL OPERATION, SYSTEM PRESSURIZED, MIN. FLOW RECIRCULATION.

#### GENERAL NOTES

1. ALL EQUIPMENT AND INSTRUMENT NUMBERS ARE TO BE PRECEDED BY MPL-E21 UNLESS OTHERWISE NOTED. EXAMPLE E21-C002A.
  2. FOR WEIGHT & MATERIAL OF PIPE, VALVES & FITTINGS SEE MATERIAL SPEC SS-6309-1.
  3. ALL CHECK & GLOBE STOP CHECK VALVES MUST BE LOCATED CLOSE TO THE CROSS HEADER.
  4. JOCKEY PUMPS DRAINS & VENTS TO DRW.
  5. PUMP C002A IS RUNNING & C002B IS ON STANDBY
  6. ALL HIGH POINT VENTS ARE  $\frac{3}{4}$ " AND ALL LOW POINT DRAINS ARE 1" UNLESS NOTED OTHERWISE.

## PROCESS FLOW NOTES

1. FOR PUMP NPSH<sub>AVAIL</sub> CALCULATIONS:  
MAX. TORUS WATER TEMP = 200°F  
TORUS PRESS = 147 PSIA
  2. MAX. NPSH<sub>AVAIL</sub> CALCULATED = 7 FT.
  3. VALVES WILL BE THROTTLED TO MAINTAIN DESIGN FLOWS.
  4. WHEN THE CORE SPRAY SYSTEM IS AT TEST MODE THEN  
SUCTION TO JOCKEY PUMP WILL BE THROUGH  
 A,  B,  C.
  5. THE JOCKEY PUMPS ARE TO PROVIDE A MINIMUM OF  
10 PSIG PRESSURE IN THE MAIN PUMP DISCH. LEGS IN  
ADDITION TO HEAD PRESSURE FROM WATER COLUMN.
  6. THE RESTRICTING ORIFICES ARE DESIGNED TO DROP  
THE DISCH. HEAD TO A LOW TORUS PRESSURE  
(15.7 PSIA)
  7. RELIEF VALVES FOG1 & B  
SET PRESSURE SHALL BE 100 PSIG.
  8. CAP SUCTION LINE FROM PWR. SUCTION AND SPOOL  
THROUGH SUCTION LINE FROM CORE SPRAY SUCTION  
UNTIL VALVES FOG0 A&B, FOG5A&B, AND  
FOG0A & B ARE DELIVERED.
  9. PUMPS COOPA & B SHALL OPERATE ON EMERGENCY  
A-C PUMPS.


## REFERENCES

REFERENCE	MPL. NO.	S.S.L. NO.
1. RHR. SYS. PBD	EII-1010 SH 1	H-16329
	SH 2	H-16330
2. CORE SPRAY SYS. PBD	EII-1010	H-16351
3. RHR. SYS. PROCESS DIA.	EII-1020	\$-15326-18328
4. CORE SPRAY PROCESS DIA.	EII-1020	5-15117
5. SAMPLING SYSTEM PFD (PFD)	P35-1010	H-16281
6. PUMP SEAL DIA.	EII-C0024E8	5X-15024
7. JOCKEY PUMP INST. MANUAL	EII-C0024E8	5X-15025
8. JOCKEY PUMP OUTLINE	EII-C0024E8	5X-15109
9. PIPING & INTL. SYMBOLS	A41-1010 □	S-15051


**LEGEND**


- EXISTING PIPING FOR EII-1010 AND/OR EII-1010.
- PIPING FOR JOCKEY PUMP

DETAIL "A"  
VENT & DRAIN CONNECTIONS  
(TYPICAL PLACES)

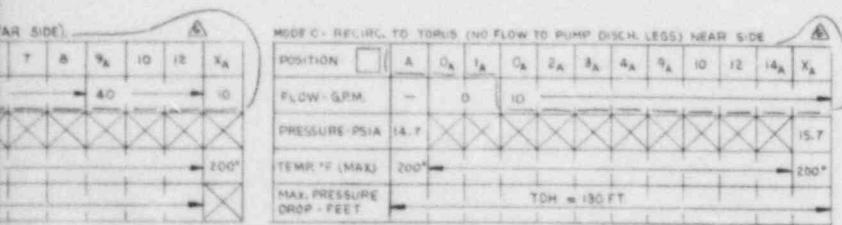



Microfilmed 7-9-7

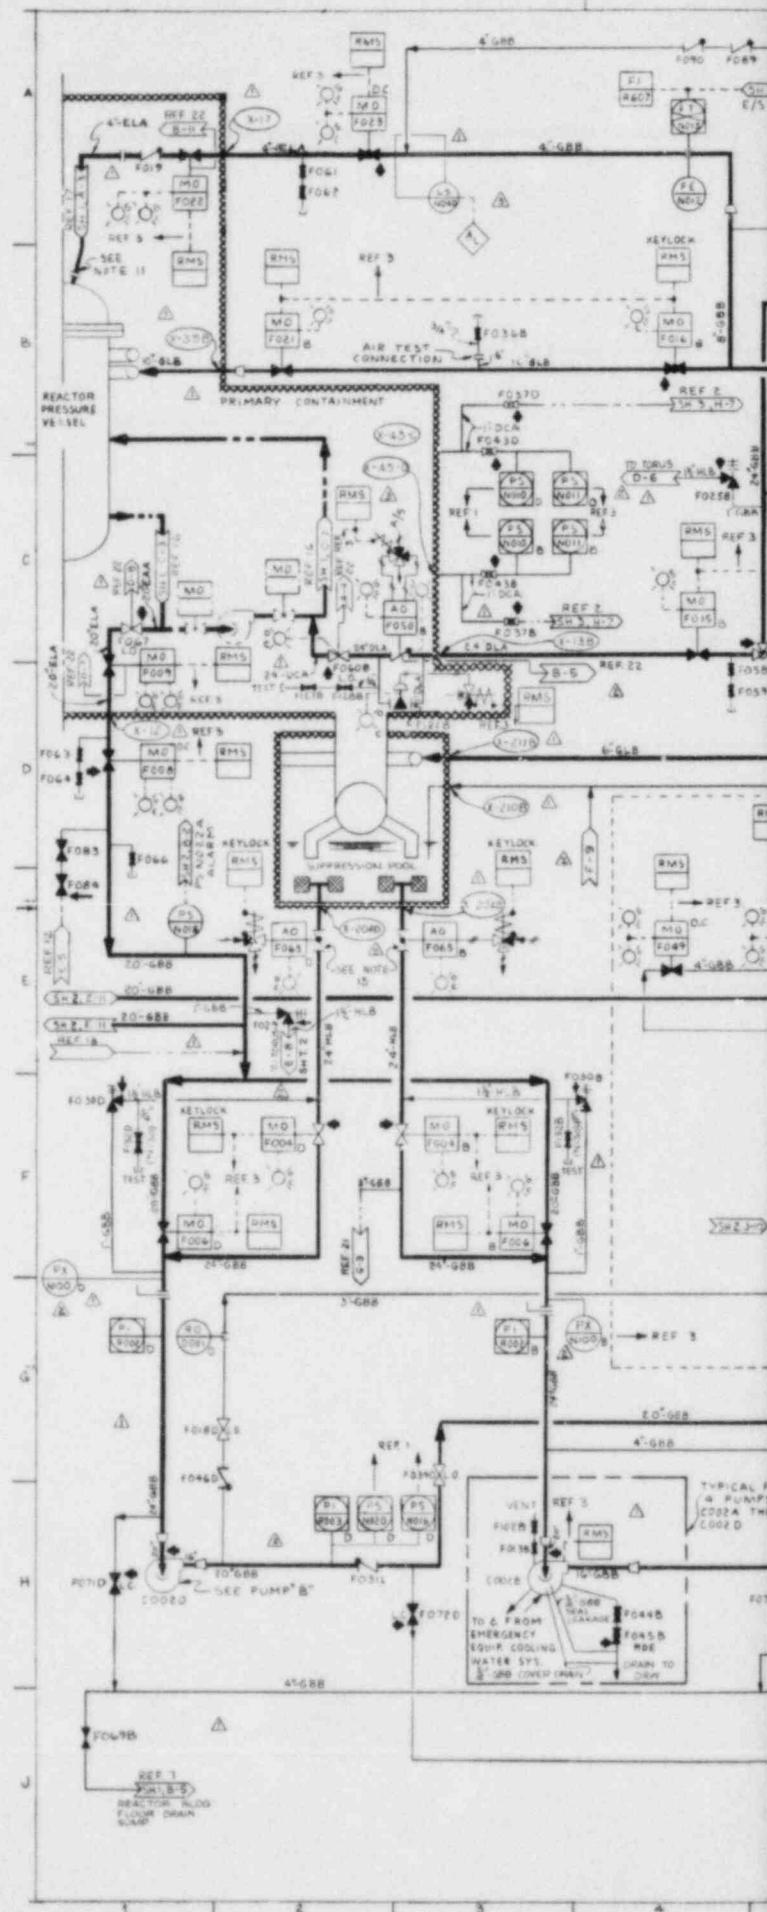

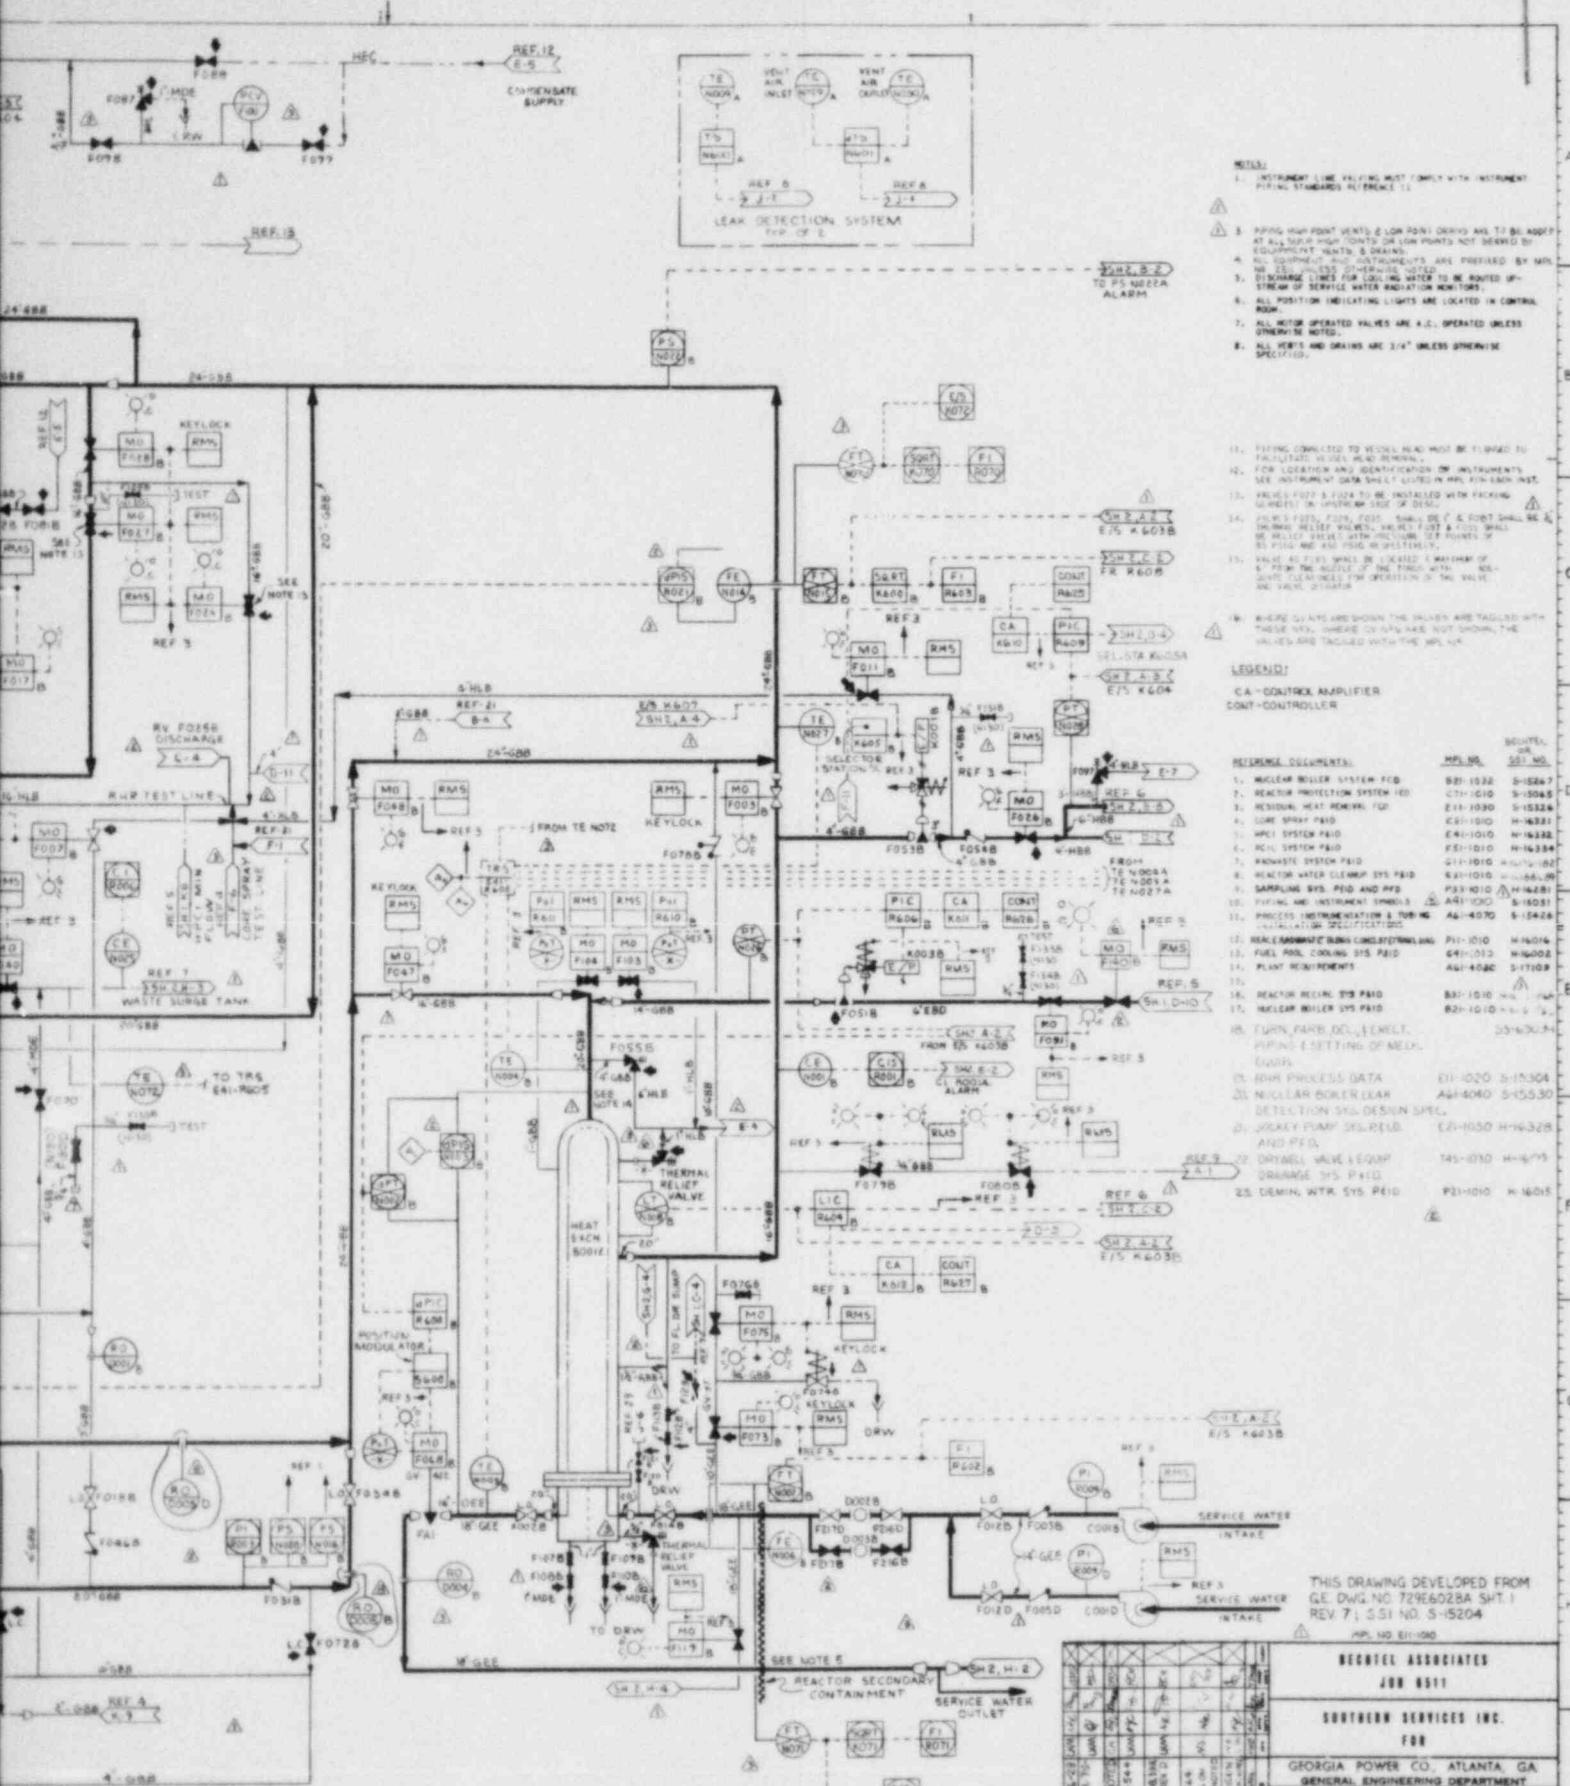

REvised per  
ECP NE 72970  
10-502  
Drawing No. H-16325  
Location Sheet No. H-16325

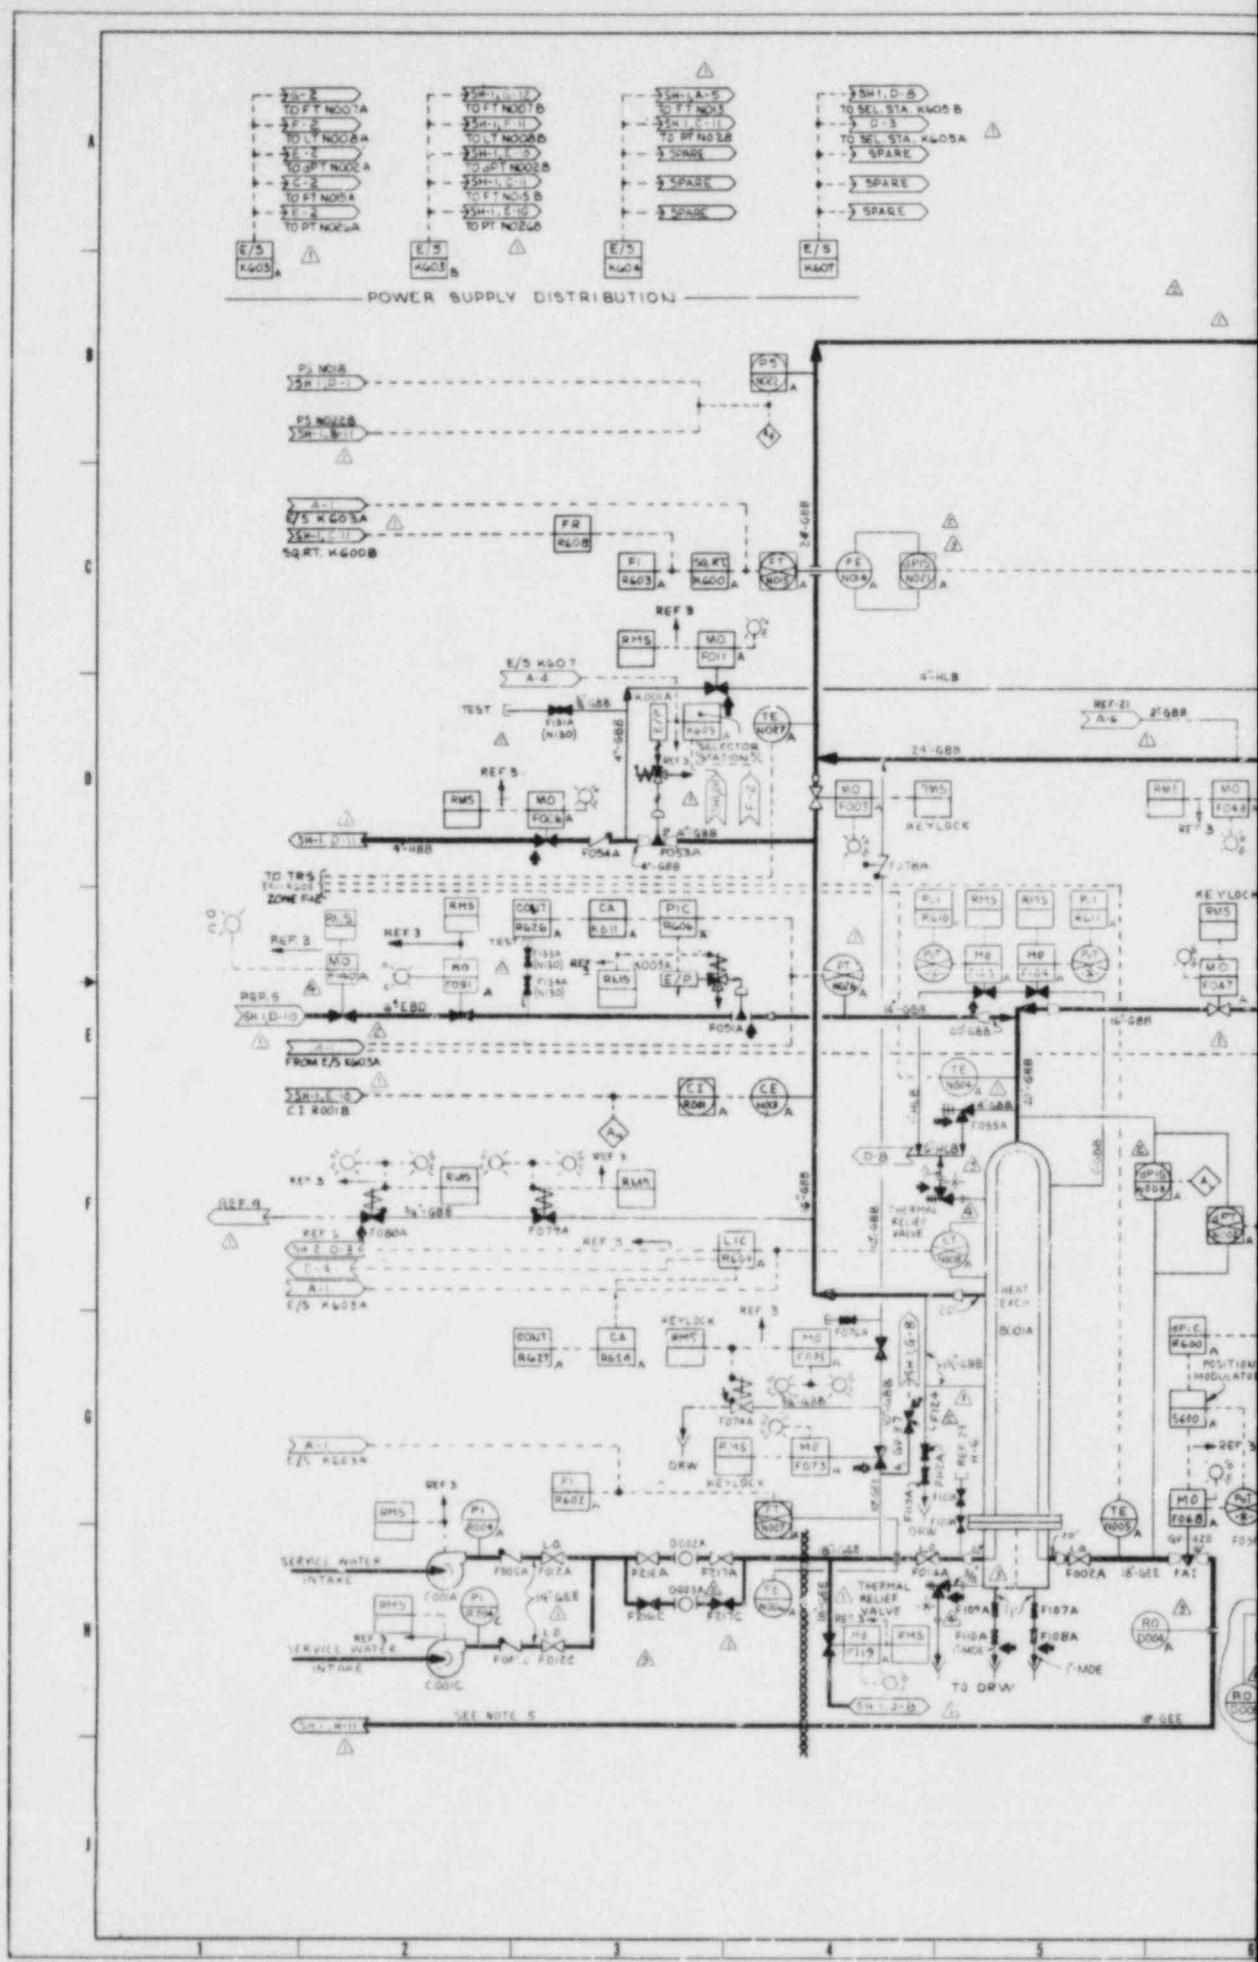

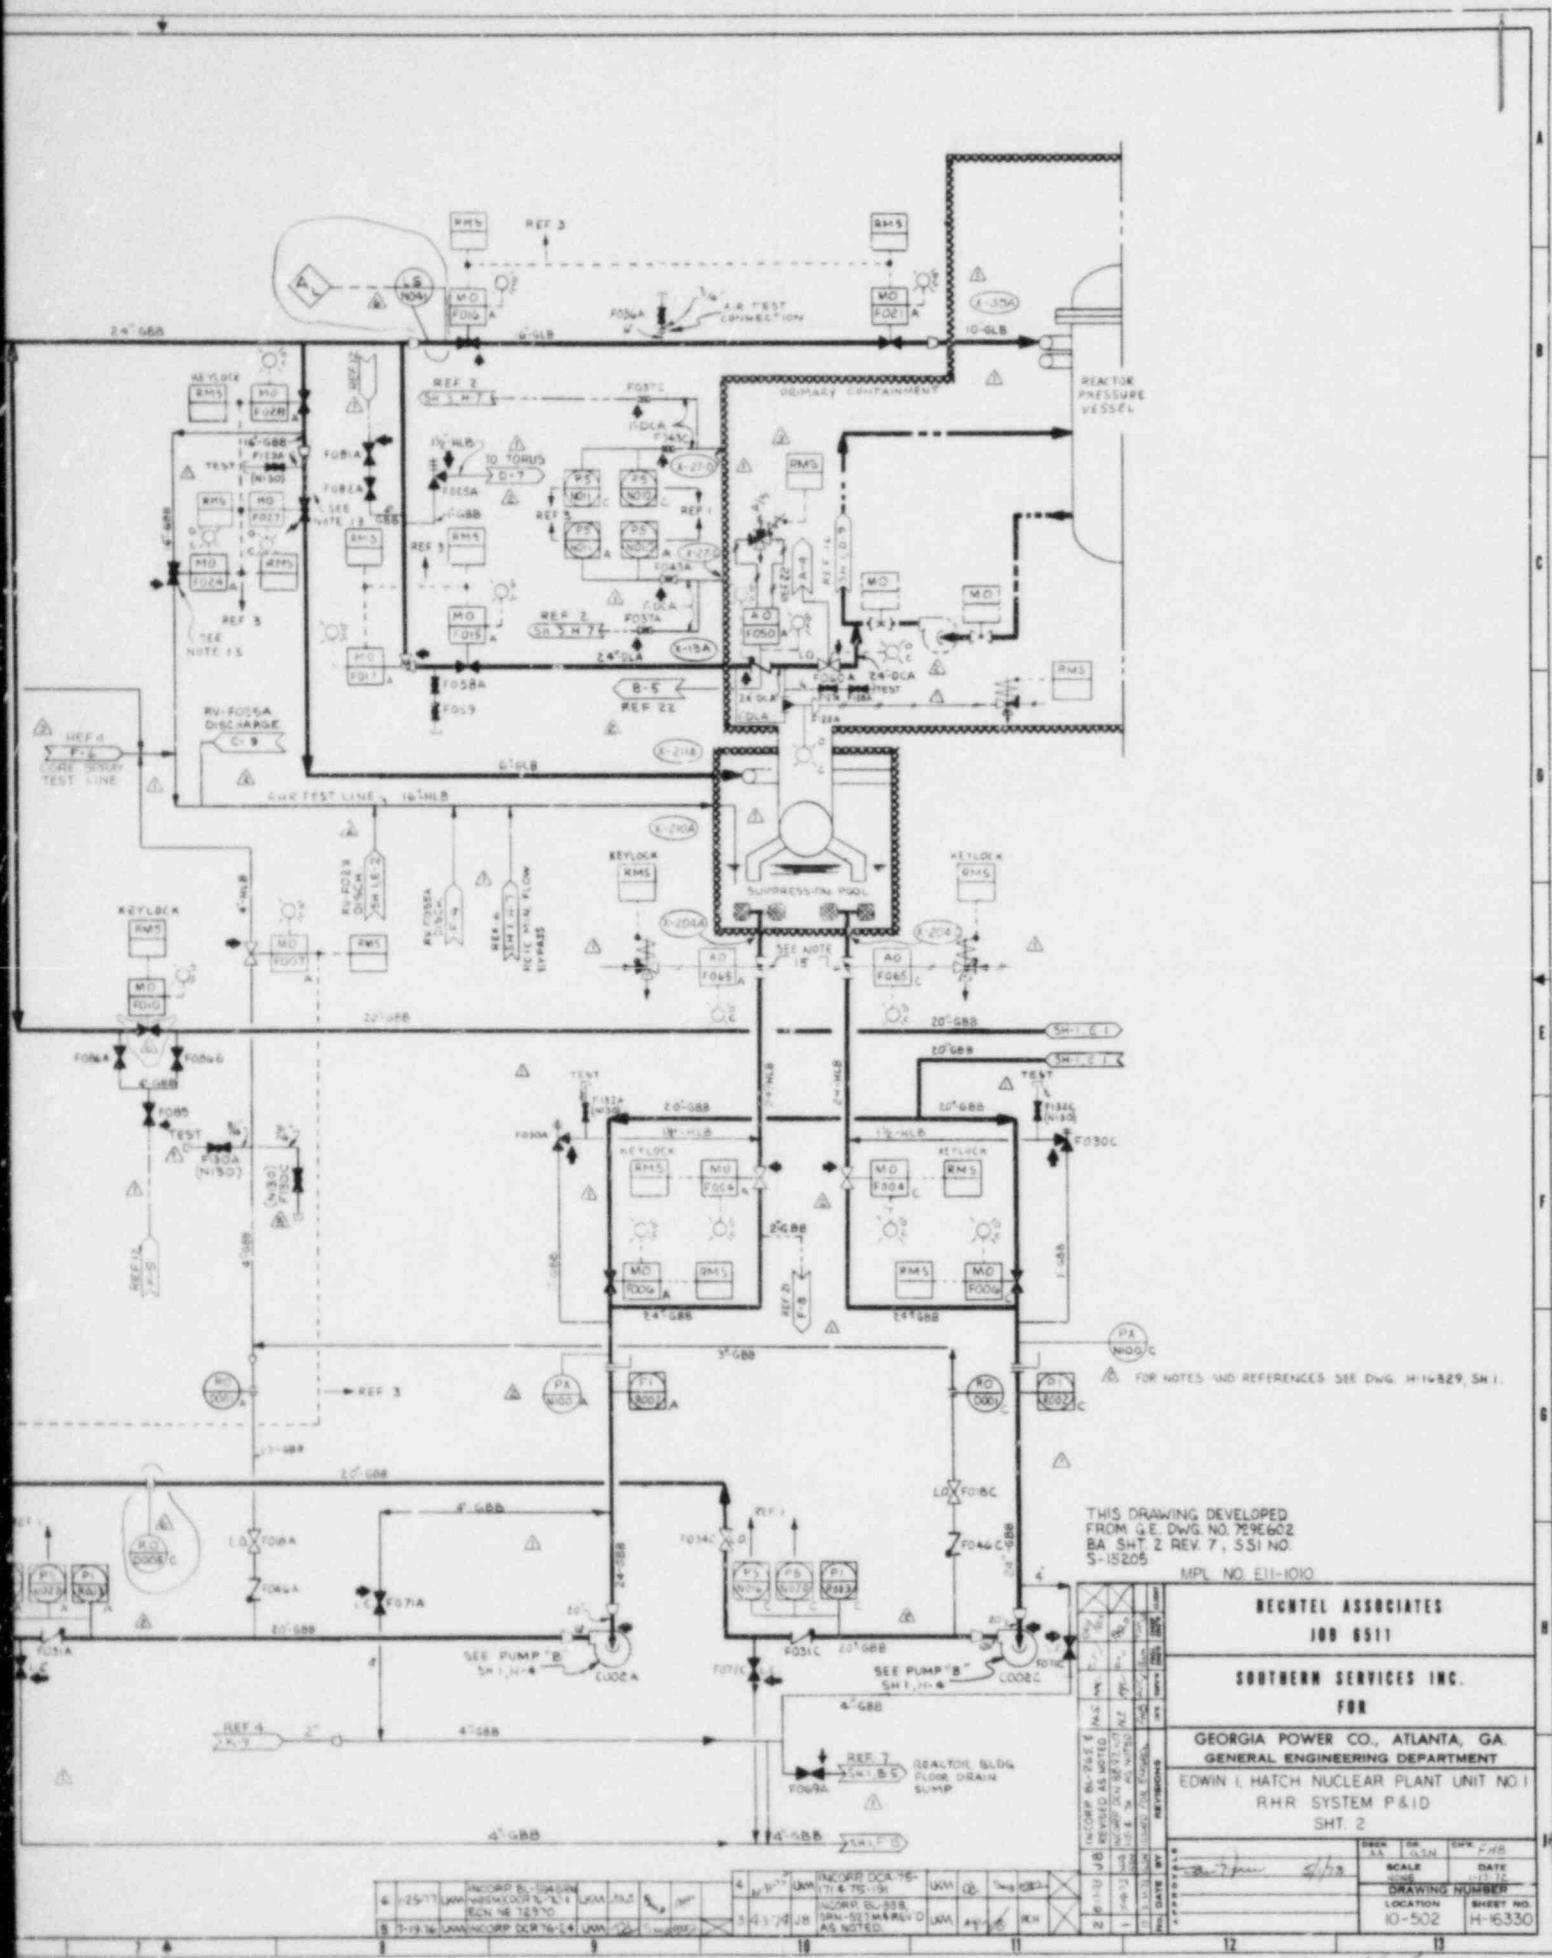

THIS DRAWING DEVELOPED  
FROM G.E. DWG. NO. 729E602  
BA SHT 2 REV. 7, SSI NO.  
5-15205

MPL NO. EII-1010

BECHTEL ASSOCIATES

J08 6511


SOUTHERN SERVICES INC.


FOI


GEORGIA POWER CO., ATLANTA, GA.  
GENERAL ENGINEERING DEPARTMENT


EDWIN I. HATCH NUCLEAR PLANT UNIT NO 1  
RHR SYSTEM P&ID

SHT. 2

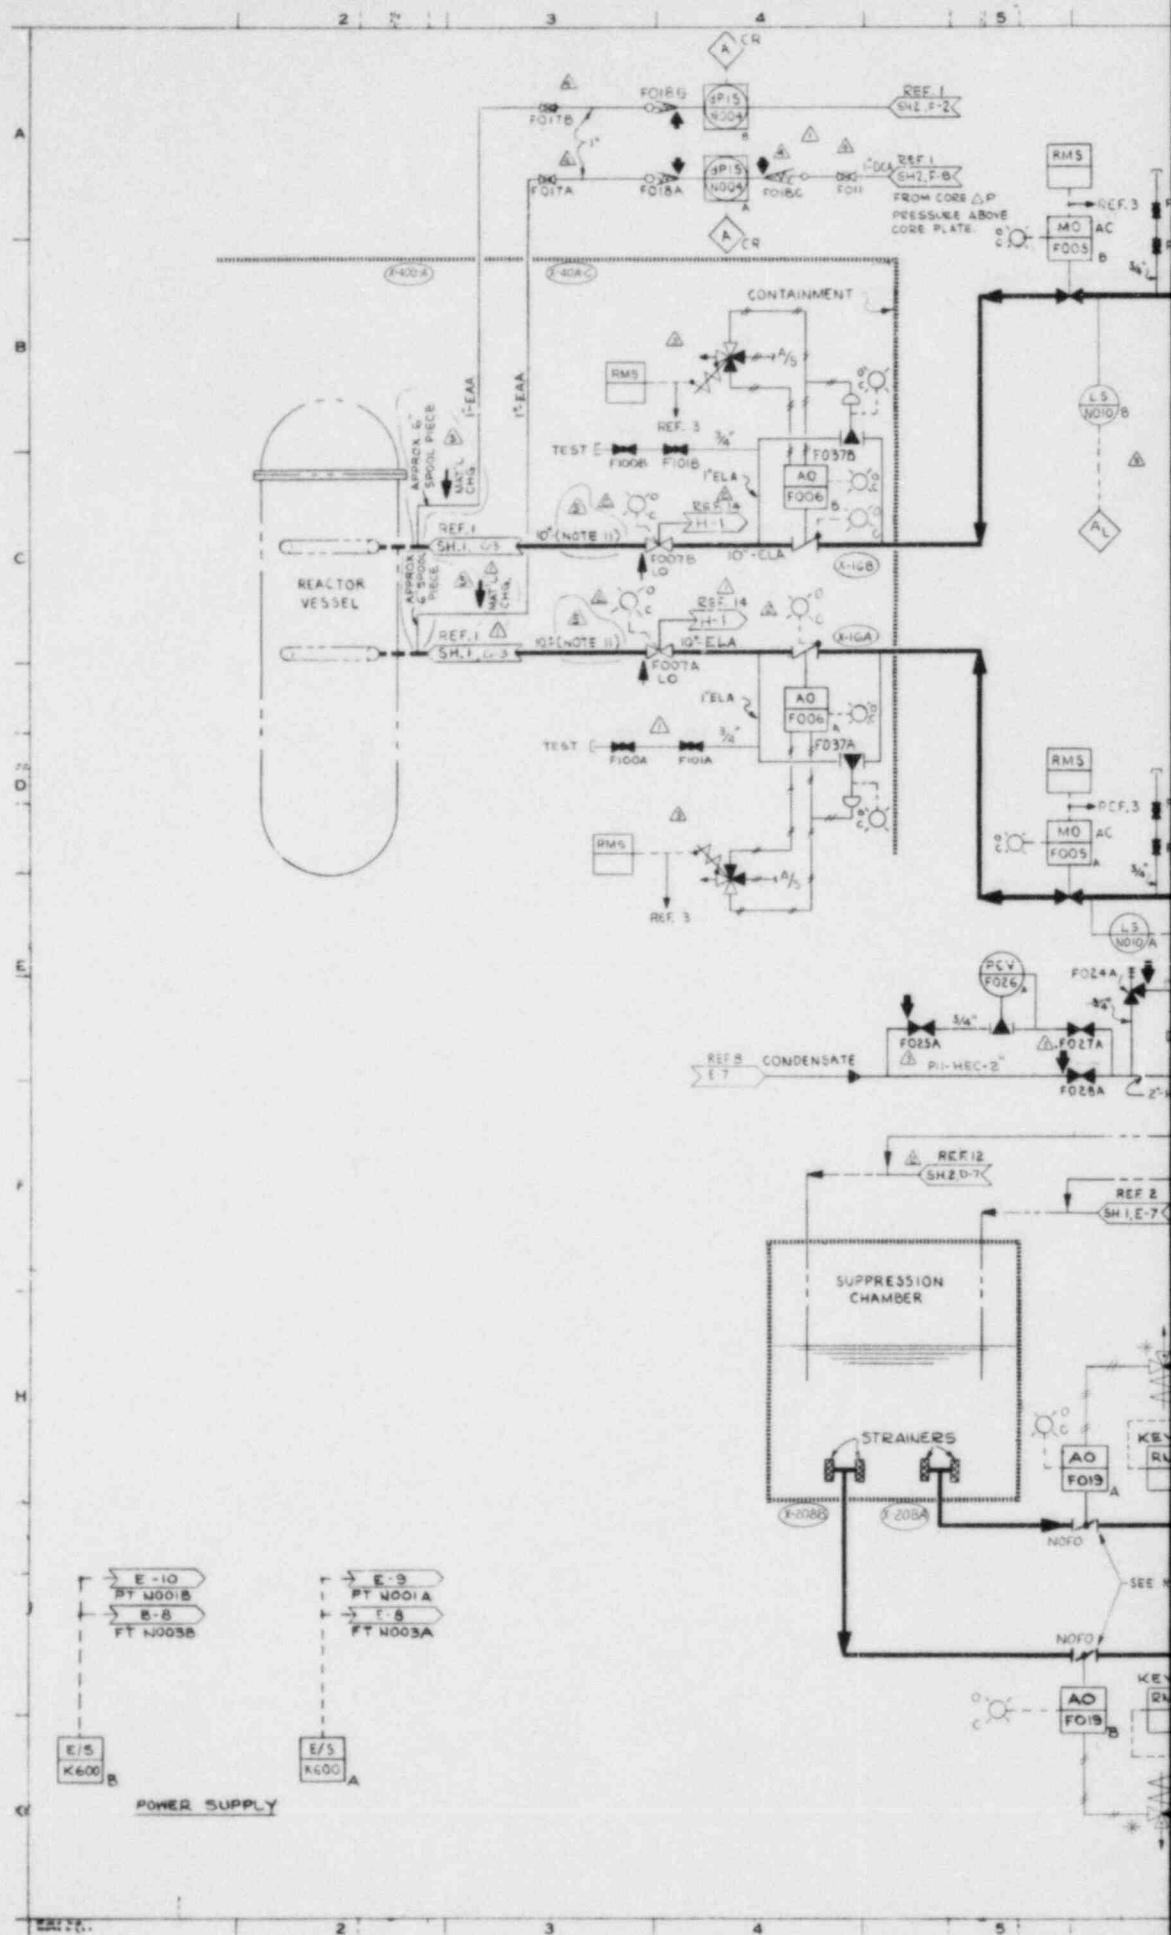

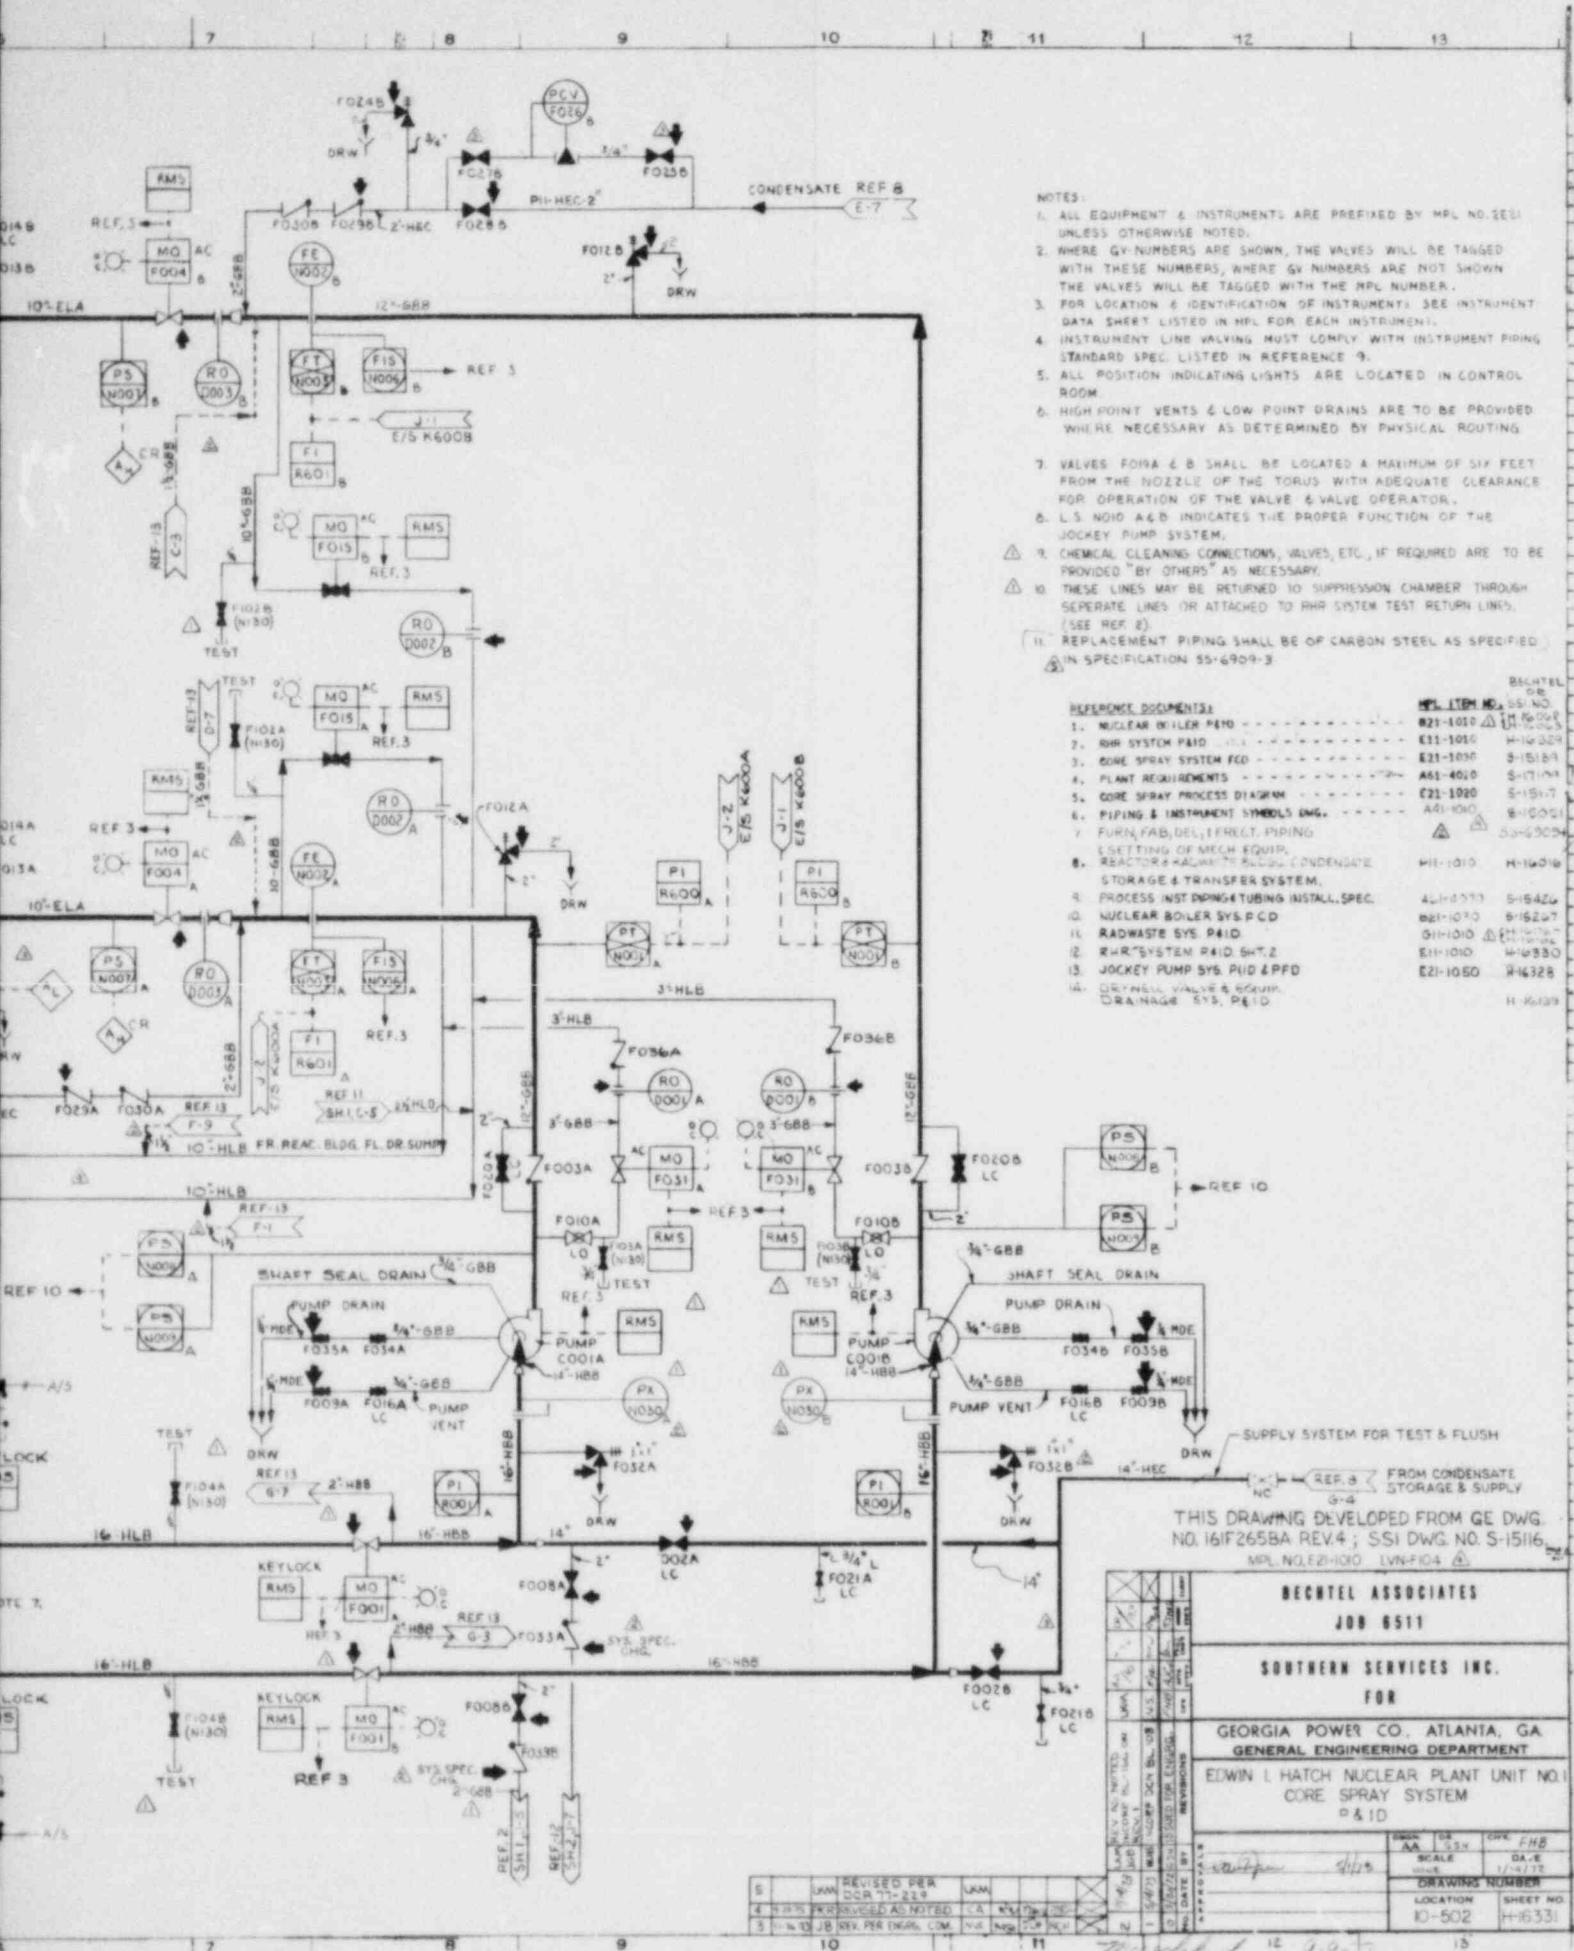

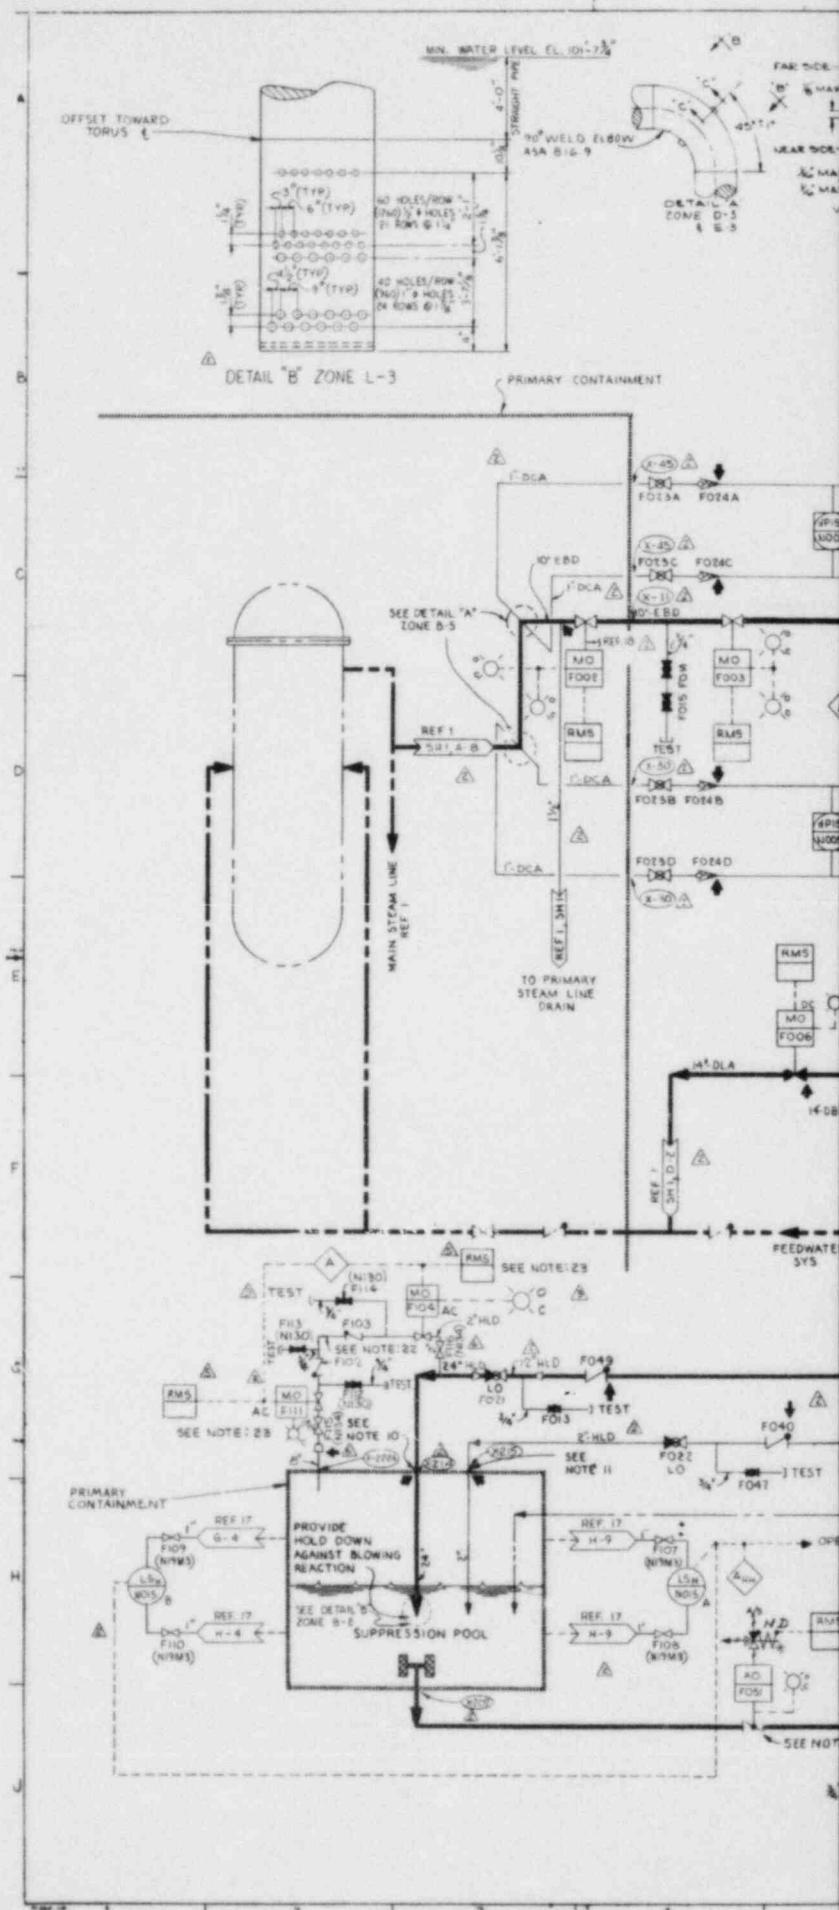

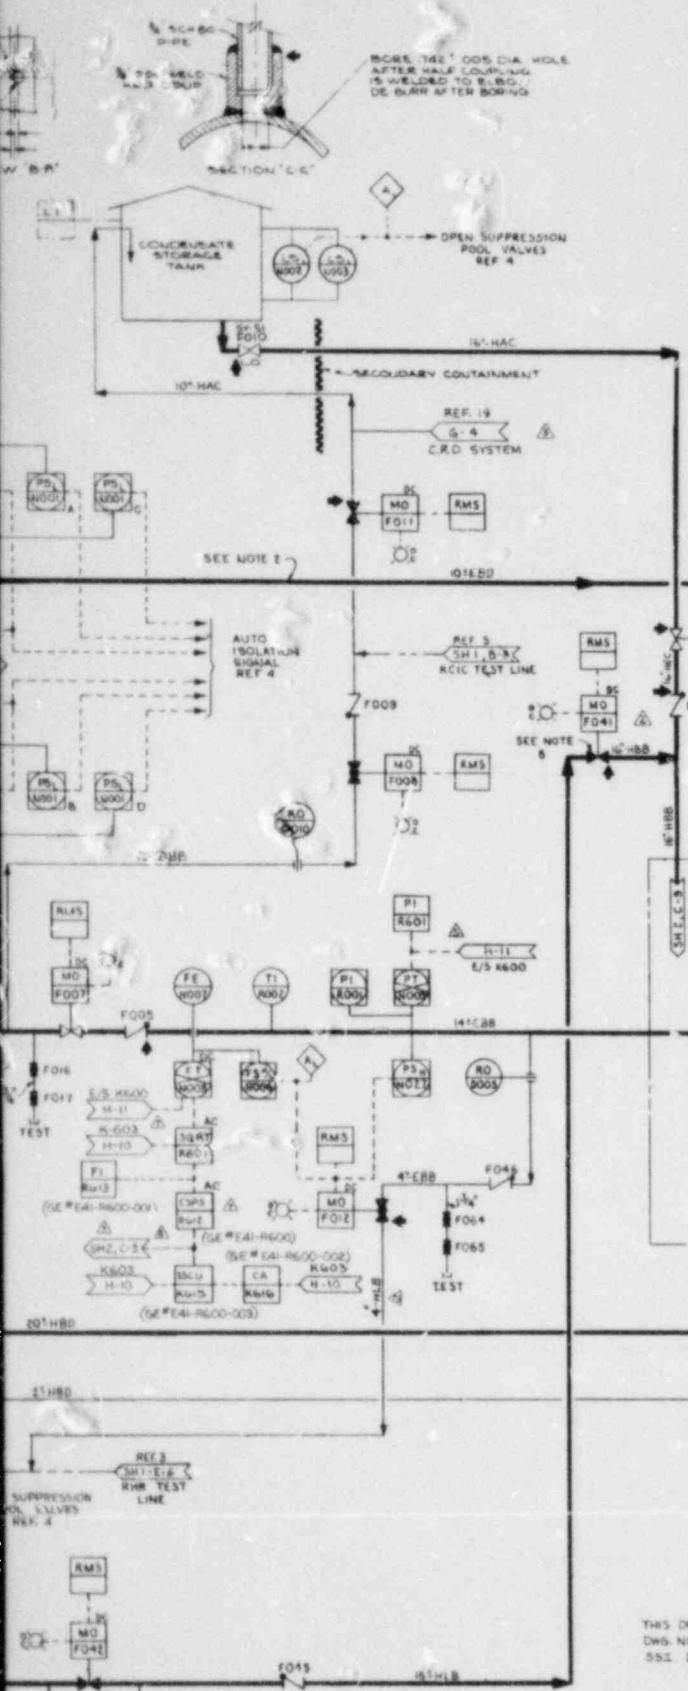

THIS DRAWING DEVELOPED FROM G.E.  
DWS-NR 729E600BA SHT 1, REV 4.  
S5I DWS-NR 5-1G150

• • • •

JOB 651

SOUTHERN SERVICES INC.


FBI

GEORGIA POWER CO., ATLANTA, GA.  
GENERAL ENGINEERING DEPARTMENT

EDWIN I. HATCH NUCLEAR PLANT UNIT NO.1  
HPCI SYSTEM PAID  
SHEET NO.1

*and you reflect*

10-502 H-16332

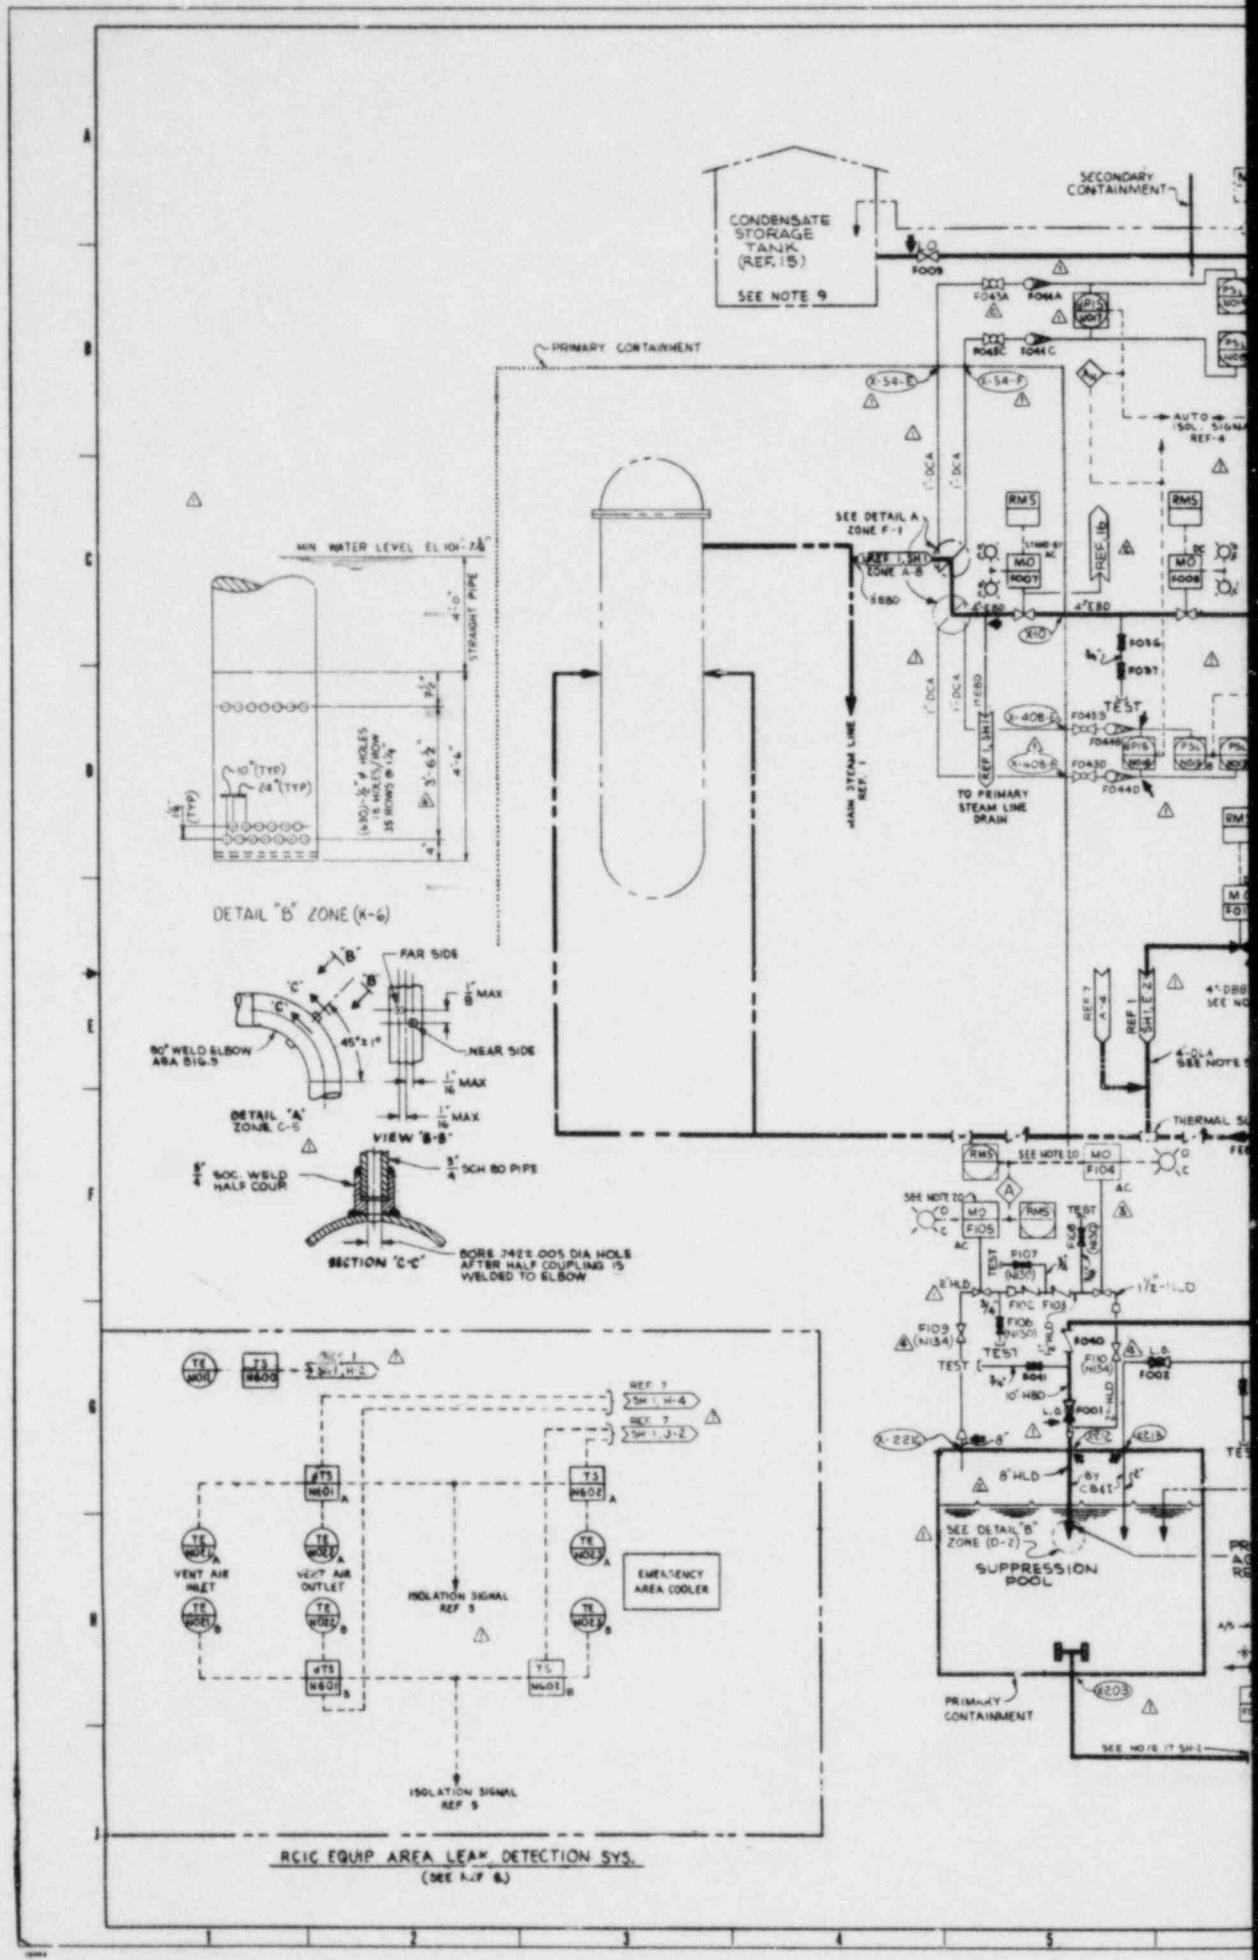

NOTES

1. CHEMICAL CLEANING CONNECTIONS, VALVES, ETC. IF REQUIRED, ARE TO BE PROVIDED AS NECESSARY.
2. SLOPE STEAM LINE DOWN ALL THE WAY FROM MAIN STEAM LINE TO DRAIN POT JUST AHEAD OF TURBINE.
3. INSTRUMENT LINE VALVING MUST COMPLY WITH INSTRUMENT PIPING STANDARDS.
4. DESIGN PRESSURE & TEMP. TO BE ESTABLISHED BASED ON MAIN FED PUMP SHUT-OFF PRESSURE AND/OR RCIC PUMP SHUT-OFF PRESSURE & FEEDWATER TEMP.
5. EQUIPMENT VENT & DRAIN QUANTITIES SHOWN ARE TO BE MODIFIED TO AGREE WITH VPF DATA FOR ACTUAL EQUIPMENT PURCHASED. PIPING HIGH POINT VENTS & LOW POINT DRAINS TO BE ADDED AS NECESSARY.
6. EQUIPMENT AND INSTRUMENTS ARE PREFIXED BY MPL NO. ESI UNLESS OTHERWISE NOTED.
7. LOCATE VALVE FO29 (ZONE D-6) AS CLOSE AS POSSIBLE TO PUMP SUCTION LINE FROM CONDENSATE STORAGE.
8. REQUIRED TOTAL RESERVE STORAGE FOR RCIC SYS. AND HPCI SVS. 100,000 GAL. THIS AMOUNT OF STORAGE SHALL BE CAPABLE OF BEING ISOLATED FROM SERVING OTHER SYSTEMS.
9. "A-C" POWER FOR RCIC INSTRUMENTS SHALL BE DERIVED FROM A "D-C" SOURCE SEPARATE FROM THAT WHICH SUPPLIES THE HPCI SYSTEM.
10. FOR INTERLOCKING REQUIREMENTS AND AUTO VALVE ACTUATION SEE FUNCTIONAL CONTROL DIAGRAM, REF. 2.

NOTES CONT'D ON SH. 2.

REFERENCES

REF DOCUMENTS	MPL ITEM NO.	PECHTEL DR S.S.I. NO.
1. NUCLEAR BOILER SVS P&ID SHEET 14Z B21-1010 H-16062 6/53		
2. NUCLEAR BOILER SVS F&C B21-1080 S-15267		
3. RHR SVS P&ID E11-1010 H-16325		
4. HPCI SVS P&ID E41-1010 H-16332		
5. RCIC SVS F&C E51-1030 S-1558		
6. NUCLEAR BOILER LEAK DETECTION AG1-4040 S-15530 SVS DESIGN SPEC.		
7. RWCU SVS P&ID SHEET 14Z G31-1010 H-16188-89		
8. PIPING & INSTRUMENT SYMBOLS AG1-1010 S-15051		
9. PROCESS INSTRUMENT PIPING AND AG1-4070 S-15424 TUBING INSTALLATION SPEC.		
10. PLANT REQUIREMENTS AG1-4220 S-17109		
11. TURBINE CONTROL DWG. VFP 2157-014		
12. FURN. & FAIR. OF PIPING & SETTING OF MECH. EQUIP.		55-6707-1
13. TURBINE OUTLINE ESI-0002 S-1549		
14. HPCI SVS F&C E41-1030 S-16153		
15. REACTOR & RADWASTE BUILDINGS PH1-1010 H-16016		
16. DRYWELL VALVE & EQUIP. DRAINAGE SVS P&ID H-16199		
17. PRIMARY CONTAINMENT PURGE & INERTING SVS P&ID TAE-1020 H-16024		

LEGEND

CA - CONTROL AMPLIFIER  
SSCU - SELF SYNCHRONIZING CONTROL UNIT  
CSPS - CONTROL SET POINT STATION

THIS DWG DEVELOPED FROM GE DWG. NO. T2EGQ04A SHEET 1, REV A, SSI DWG. NO. S16157.

MPL. NO. ESI-1010

LVR-F113

BECHTEL ASSOCIATES

108 8511

SOUTHERN SERVICES INC.

FOR

GEORGIA POWER CO., ATLANTA, GA.  
GENERAL ENGINEERING DEPARTMENT

EDWIN I. HATCH NUCLEAR PLANT UNIT NO. I  
RCIC SYSTEM P&ID  
SHEET NO. 1

DATE	REV	SCALE	DATE
7-10-78	A	1:100	7-10-78
6-19-78	B	1:100	6-19-78
5-17-78	C	1:100	5-17-78
5-17-78	D	1:100	5-17-78
5-17-78	E	1:100	5-17-78
5-17-78	F	1:100	5-17-78
5-17-78	G	1:100	5-17-78
5-17-78	H	1:100	5-17-78
5-17-78	I	1:100	5-17-78
5-17-78	J	1:100	5-17-78
5-17-78	K	1:100	5-17-78
5-17-78	L	1:100	5-17-78
5-17-78	M	1:100	5-17-78
5-17-78	N	1:100	5-17-78
5-17-78	O	1:100	5-17-78
5-17-78	P	1:100	5-17-78
5-17-78	Q	1:100	5-17-78
5-17-78	R	1:100	5-17-78
5-17-78	S	1:100	5-17-78
5-17-78	T	1:100	5-17-78
5-17-78	U	1:100	5-17-78
5-17-78	V	1:100	5-17-78
5-17-78	W	1:100	5-17-78
5-17-78	X	1:100	5-17-78
5-17-78	Y	1:100	5-17-78
5-17-78	Z	1:100	5-17-78
5-17-78	AA	1:100	5-17-78
5-17-78	BB	1:100	5-17-78
5-17-78	CC	1:100	5-17-78
5-17-78	DD	1:100	5-17-78
5-17-78	EE	1:100	5-17-78
5-17-78	FF	1:100	5-17-78
5-17-78	GG	1:100	5-17-78
5-17-78	HH	1:100	5-17-78
5-17-78	II	1:100	5-17-78
