


123 Main Street
White Plains, New York 10601
914 681-6200

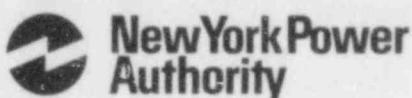

November 7, 1984
JPN-84-73

Director of Nuclear Reactor Regulations
U.S. Nuclear Regulatory Commission
Washington, D.C. 20555

Attention: Mr. Domenic B. Vassallo, Chief
Operating Reactor Branch No. 2
Division of Licensing

Subject: James A. FitzPatrick Nuclear Power Plant
Docket No. 50-333
Recirculation System Welds

References: 1. NYPA letter, C.A. McNeill, Jr. to D.B.
Vassallo, dated October 25, 1984 (JAfp-84-1001)

2. NYPA Letter, C.A. McNeill, Jr. to D.B.
Vassallo, dated October 21, 1984
(JAfp-84-0979).

Dear Sir:

In References 1 and 2 we transmitted information regarding
cracking in the recirculation system welds which was
discovered during the September 1984 outage.

The enclosure to this letter responds to questions which were
transmitted to us in a telephone conversation on October 31, 1984.
Attachments 1 to 4 refer to question 1 of the enclosure.

If you have any further questions, please contact
Mr. J.A. Gray, Jr. of my staff.

Very truly yours,

Robert P. Bayne
for
J. P. Bayne
First Executive Vice President
Chief Operations Officer

cc: Office of the Resident Inspector
U.S. Nuclear Regulatory Commission
Post Office Box 136
Lycoming, New York 13093

Enclosure

8411140071 841107
PDR ADOCK 05000333
PDR
P

A001
111

Enclosure to

JPN-84- 73

Recirculation System Welds

James A. FitzPatrick Nuclear Power Plant
Docket No. 50-333

Response to question 1.

Weld 12-23

In 1977, General Electric Co. performed an inspection on the subject weld as did Ebasco in the Summer, 1983 outage. These inspections resulted in the findings of indications which were deemed to be geometric in origin. The plots made were based on a projected OD/ID profile (flat-topped weld crown and ideal ID profile) and did not reflect the actual conditions. In addition to this, the exams were performed using full-length 45° wedges which prevented the shoe from going beyond the "butt-up" position which is necessary to obtain a meaningful examination. The shortened (EPRI-modified) wedges were not available until late (fall) 1983. Replotting of the 1983 data using 1984 ID/OD profile information (Attachment #1) shows that weld geometry was the cause of the indication recorded by Ebasco. In the September, 1984 outage, further investigation was performed by the NYPA and Ebasco Level III's including examination of OD profile. As a result it was determined that a 45° exam, even if performed with the EPRI-modified wedges, would not examine the area-of-interest (the heat affected zone between the counterbore and root) due to the O.D. configuration (See Attachment #2). Based on this information and the projected exit point vs. area-of-interest relationship, a 60° exam was performed on weld 12-23. The remainder of the welds which have a similar OD profile, were also examined using a 60° shear wave if the 45° exam proved inadequate. As a result of these inspections, all pipe-safe end welds which were inspected in 1983 were reinspected (i.e., welds 12-1, 12-7, & 12-75). These inspections, utilizing the 60° technique, revealed that these three weldments were free of reportable indications. Attachment #3 is a resubmittal of weld 12-23 data which was generated in 1983 and Attachment #4 is the 1984 data.

Response to question 2.

Sizing Techniques

In NYPA Letter JAFP-84-1001, Introduction, a reference was made to "headwave, creeping wave on ID." The correct reference is "head wave, creeping wave on OD."

Response to question 3.

As-Built Overlay Thicknesses

Weld Number	As-built thickness after 1st layer (in)	Thickness with 1st layer (in)
12-12	0.499	0.644
12-23	0.568	0.680
12-64	0.671	0.705
12-69	0.482	0.596
12-70	0.385	0.504

Response to question 4.
Measured Axial Shrinkage

Weld Number	Axial Shrinkage (in)
12-12	0.135
12-23	0.180
12-64	0.223
12-69	0.126
12-70	0.199

Response to questions 5 and 6.

Shrinkage Stresses

There are no unrepaired cracked welds on the same run of pipe (riser) as an overlay. Therefore, there is no significant effect of shrinkage stresses due to overlay on other unrepaired flawed welds. The analyses previously submitted to you are, therefore, accurate.

Preliminary conservative hand calculations for shrinkage of approximately 0.2" resulted in maximum shrinkage stresses of 7000 psi (7 ksi) at the sweepolet to riser pipe weld (on the manifold) associated with the individual safe-end. Final, detailed calculations are still in progress.

Response to question 7.

Weld 12-17

In the report on the subject weld, the word "seismic" was omitted from the stress equation. This was a typographical error and does not affect the numerical values of the equation which are correct.

ATTACHMENT I


JPN-84-73

RECIRCULATION SYSTEM WELDS

JAMES A. FITZPATRICK NUCLEAR POWER PLANT

DOCKET NO. 50-333

REFERENCED WELD & BASED ON 1983 EST. AS MEASURED FROM S.E. SIDE - TO - ROOT RELATIONSHIP.

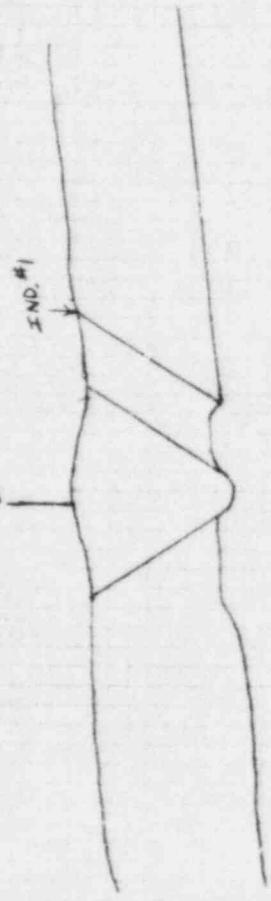

SE-PLOT OF 1983 DATA USED TO GO PLOT ESTABLISHED IN 1989

NOTE: Full-length 45° Shears were used in 1983 prohibiting the side to go beyond the "built-up" position so as to obtain a meaningful estimation. Short-hopped (EPRI-MED/150) measures were available to plants knowledge until late (fall) 1983.

ATTACH. #1


G. SECHLER
SCALE: 1 @ 1

ATTACHMENT II

JPN-84-73

RECIRCULATION SYSTEM WELDS

JAMES A. FITZPATRICK NUCLEAR POWER PLANT
DOCKET NO. 50-333

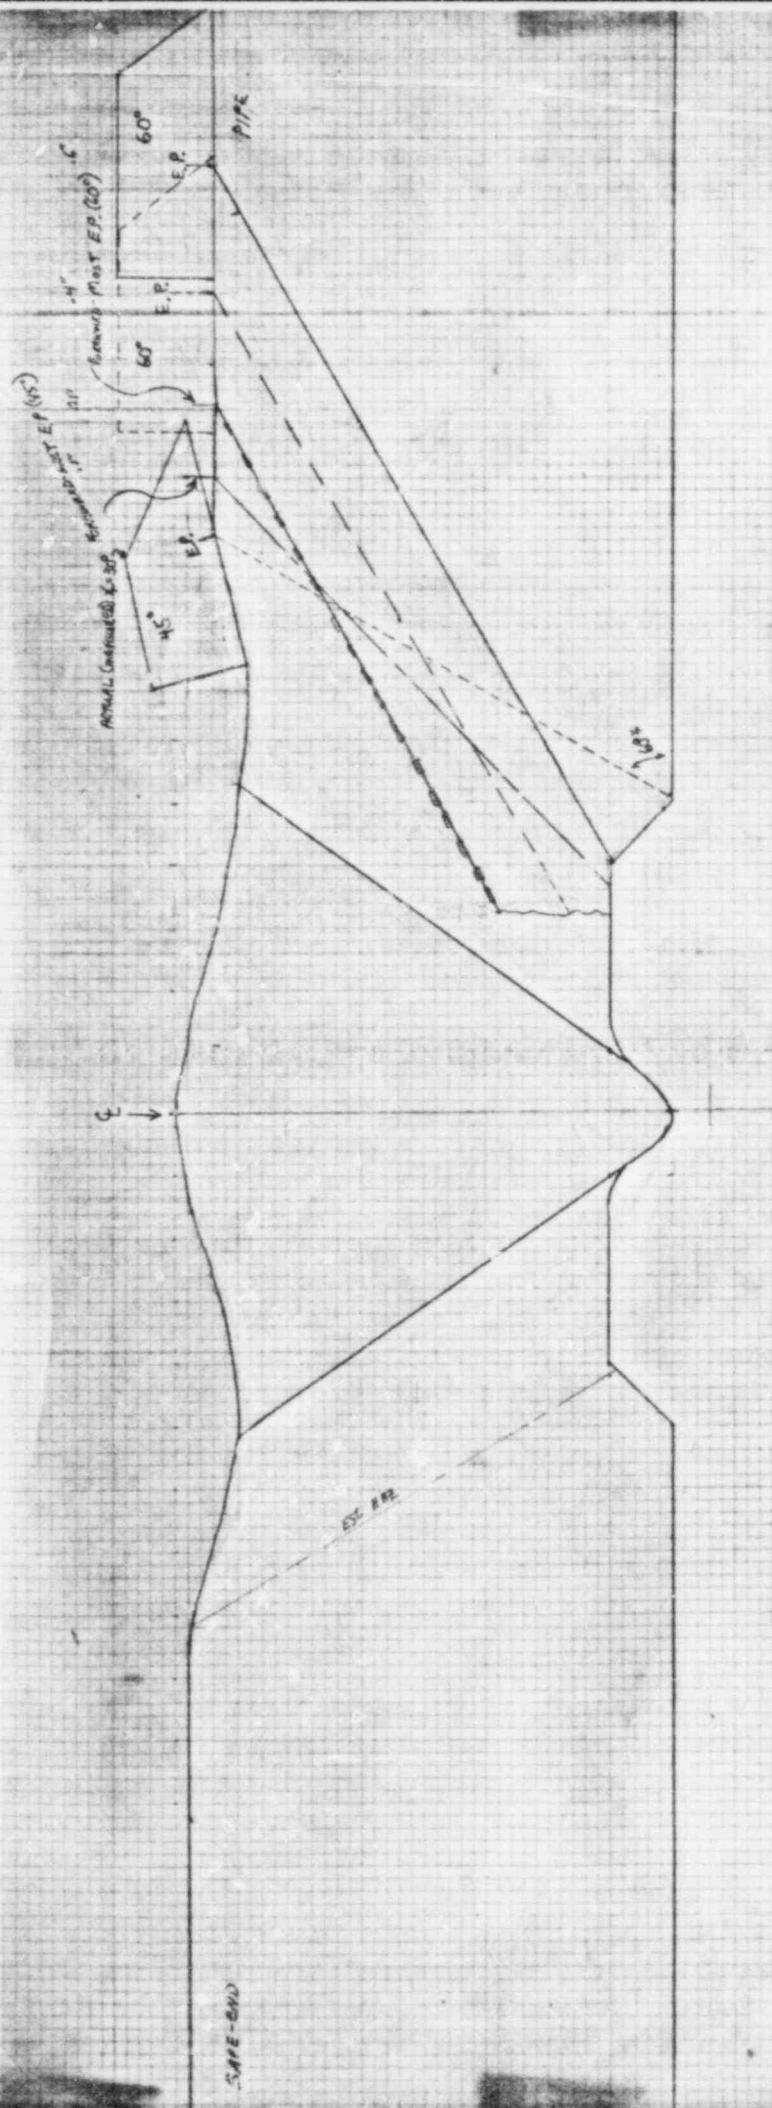

ATTACH. #2

SCALE: 5:1

F. SECHLER

ATTACHMENT III

JPN-84-73

RECIRCULATION SYSTEM WELDS

JAMES A. FITZPATRICK NUCLEAR POWER PLANT

DOCKET NO. 50-333

EIASCO SERVICES INCORPORATED
QUALITY ASSURANCE ENGINEERING
INSERVICE INSPECTION
CALIBRATION DATA

PROJECT J.A. FITZPATRICKDATA SHEET NO. SOJ-09-IG DATE 6-14-83PROCEDURE ISI-UT-JAFUTS REV 3COMPONENT OR SYSTEM Recirc. Riser C PIPE OD (IF APPLICABLE) 12"ITEM IDENTIFICATION NO(S). LISTED ON REVERSE SIDE - COMPONENT TEMP 85° EXAM. SURFACE ID OD
CALIBRATION BLOCK NO. D A376 THICKNESS .76" TEMP 80°

SCAN COVERAGE

 0° WHAZ 0° BASE MATERIAL AXIAL CIRCUMFERENTIAL

EQUIPMENT DATA


SEARCH UNIT

Manufacturer AEROTECH
 Style GAMMA
 Serial No. D22072
 Size 1/2" Frequency 2.25MHz
 Angle 45° Mode SHEAR

Couplant ULTRAGEL II Batch No. 833D

INSTRUMENT

Manufacturer KBi Model 4SL-3B
 Serial No. 210692 Coaxial Cable Length 6'
 Frequency 2.5MHz Reject OFF
 Rep Rate NA Damping OFF
 dB Gain - Coarse 20 Fine 26

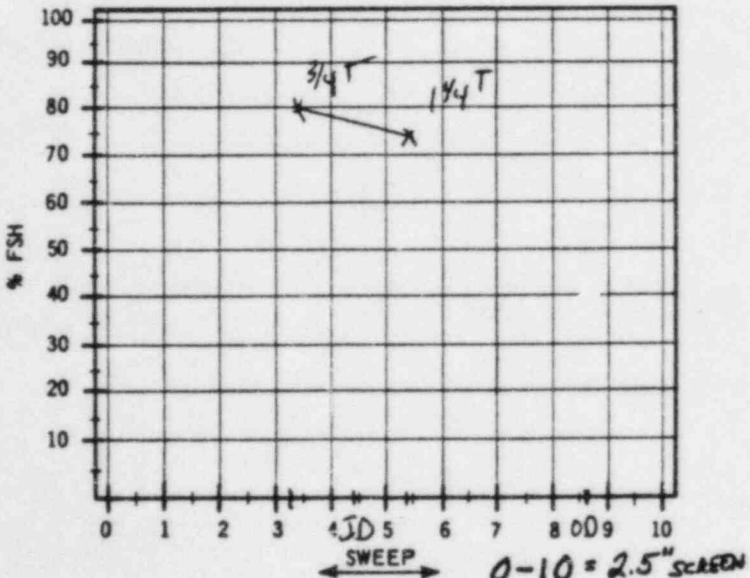Primary Reference Response
Amplitude % Full Screen Height 80%DAC PLOT - TIME 3:35 AM, PM

NOTE: When performing examinations where no DAC is required, indicate reference reflector location and amplitude above.

CALIBRATION CHECKS

AMPL ± 20% (2dB) OF INITIAL AMPL		SWEEP ± 5% OF INITIAL LOCATION		
TIME	YES	NO	YES	NO
6:10	✓		✓	

NOTE: If response above is "NO" refer to Calibration Check section of procedure.

EXAMINER(S)

1. Richard Dele TC-1A LEVEL II
 2. James Cawd TC-1A LEVEL II
 REVIEWED BY J. Lewis III DATE 6-22-83

ADDITIONAL REMARKS

I6SCC EXAMINATION

JULY 1984 NYP4 6/23/83

EBASCO SERVICES INCORPORATED
QUALITY ASSURANCE ENGINEERING
INSERVICE INSPECTION
INDICATION DATA

SHEET 2 OF 3ITEM IDENTIFICATION 2-02-2-23CALIBRATION DATA SHEET NO. SOJ-09-16

DATA TABULATION												STRAIGHT BEAM (CAL. ON BACK REFLECTION)		
SCAN DIRECTION			INDI-CATION NO.	EXAM. ON (ADJ WELD) SIDE OF WELD	MAX DAC	SWEEP READING	SEARCH UNIT EXIT POINT LOCATION		50° DAC OR HALF MAXIMUM AMPLITUDE				INDICATION AMPLITUDE (% FSH)	BACK REFLECTION AMPLITUDE (% FSH)
ST. BEAM	CIR-CUM-FEREN-TIAL	AXIAL					CIRCUMFERENTIAL (DISTANCE CW OR CCW FROM REFERENCE LINE)	AXIAL (DISTANCE FROM WELD G)	MINIMUM SWEEP READING	S.U. POSITION	MAXIMUM SWEEP READING	S.U. POSITION		
			1	PIPE	100	3.8	10" CCW	1"	3.8	84	4.4	144		
RESULTS	INDICA-TION NO.	LOCATION OF INDICATION		LENGTH	DEPTH (IF PLANAR)	DISTANCE FROM SURFACE	WIDTH (IF LAMINAR)	COMMENTS						
		CIRC	AXIAL	360° INTERMITTENT				<i>Geometric reflects 360° INTERMITTENT Reading taken at 1-3", 9-12", 20-21" 29-33"</i>						
								<i>Note: 84 = Butt-up toe of the weld.</i>						

EXAMINER(S)

Richard Deed
Tom Fruey 9/24/83, Stanay Corp
John M. Fruey III

TC-1A LEVEL II


TC-1A LEVEL II

DATE 6-22-83

12-02-2-23

S02-09-IG

Pg. 3 of 3

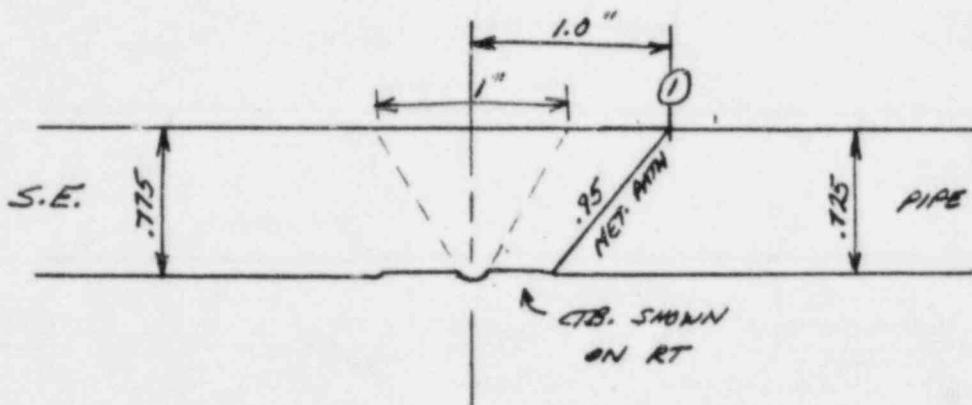

ADDITIONAL THICKNESS
READINGS TAKEN - SEE DATA
SHEET # S02-49-IG AND
PT REPORT # S02-12-PT.

ADDITIONAL THICKNESS
READINGS TAKEN SEE DATA
SHEET # S02-51-IG.

ATTACHMENT IV

JPN-84-73

RECIRCULATION SYSTEM WELDS

JAMES A. FITZPATRICK NUCLEAR POWER PLANT

DOCKET NO. 50-333

Weld 12-02-2-23

ULTRASONIC DATA SHEET

UNIT: JACKNO	SYSTEM: 02-2	COMPONENT: piping walls								
DESCRIPTION: Pipe - 6 - Side end; Top of Riser "C"										
WELD ID: 12-02-2-2-3	PROCEDURE: 042 80 + Shell.	MATERIAL: SS								
INSTRUMENT(S): GIC-38	CAL-BLOCK(S): (See cal. Sheets)	CRYSTAL: 53425								
NODE: S	BEAM DIRECTION (Front, Left, Right)	CRYSTAL: 84-88								
DISTANCE: 1.0"	#1 REF: Top - of pipe	CRYSTAL:								
COUPLANT: ULTRACHEL II	COUPLANT BATCH NO.: 8443	ANGLE: 45°								
CAL. SHEET: GIC-38 <009	TIME STOP: 100	ANGLE: 23°								
PERFORMED BY: George Schaefer	DATE: 12/18/84	ANGLE:								
PERFORMED BY: <i>George Schaefer</i>	ID#: S-1765	TIME START: 100								
	LEVEL: II	TIME STOP: 100								
	ID#: <i>74</i>	DATE: 12/18/84								
	LEVEL: II	DATE:								
LIMITED SCAN										
POSITION	LAMINATION (ONLY)		LEN. LEN.		BEAM DIRECTION	(INCHES)		HALF MAXIMUM AMPLITUDE		<input checked="" type="checkbox"/> YES (IF SO WHY) <input type="checkbox"/> NO
	MAX. SIGNAL (% OF DAC)		DEPTH (IN)			LENGTH(%DAC)		MINIMUM		
A	B	20 TO 20		50 TO 50		100 TO 100		DISTANCE IN.		POSITION (IN.)
										(IN.)
										1
										2
										A
										B
										REMARKS
<i>See attached chart for 2nd (B' Scans) for review - 360° Intermittent - 1-75% through-wall.</i>										

REVIEWED BY:

LEVEL:

WRED NO.:

FIGURE NO.:

DATE REVIEWED:

SK-IAF-82-002

MEET NO.: JAF-FML-005

TIME: 1100 HR

DATE: 10/15/84

INIT: JAFCPP

EXAMINER: George Sekler *George Sekler*

EXAMINER: off

SYSTEM: 02-2/Racine

COMPONENT: piping weld

ID#: 51765

LEVEL: III

COUPLANT: ACTRAGEL II

ID#: 146

LEVEL: 1/2

COUPLANT ID#: 5993

INSTRUMENT

D#: 210586

LINEARITY CHECK YES NO

REJECT: off %DB

MAT'L. CAL.: 182

DELAY: 678

PULSE ENERGY: 5.F.D.

COARSE GAIN IN DB: 40

FINE GAIN IN DB: 12

FINE GAIN: 10 %

SCREEN RANGE: 2.5

SCREEN DEPTH: 1.0 IN.

 T&R } NORMAL }

FREQUENCY: 5 MHZ.

 NORMAL } RF }

REP. RATE: 1K

ZERO CONTROL: 0 0

DAMPING: off

GAIN: }

DLY: } DAC }

SLP: }

POLARITY: }

WIDTH: } RATE }

DELAY: }

 NORMAL } FIRST ECHO }

REVIEWED BY

LEVEL

CALIBRATION BLOCK

ID#: CTD-A376-25

LENGTH: IN.

OD: IN.

THICKNESS: IN.

CRYSTAL

ID# 5395

TYPE CWL

FREQ. MHZ

SIZE 4

ACTUAL &

45°

SYSTEM CALIBRATION

ANGLE 45° NODE shear

REFLECTOR	AMPLITUDE % OF FULL SCREEN	SCREEN READING IN INCHES
.10" 18-NODE	100 + %	50% - 10 IN.
.15" 18-NODE	100 + %	60% - 15 IN.
.20" 18-NODE	100 + %	40% - 20 IN.
.25" 18-NODE	100 + %	40% - 25 IN.
.30" 18-NODE	100 + %	30% - 30 IN.
.35" 18-NODE	100 + %	25% - 35 IN.
TOP NOTCH	%	IN.
OPPOSITE NOTCH	%	IN.
BKR-CB	%	IN.
BKR-P	%	IN.

CALIBRATION BLOCK SIMULATOR

SERIAL NO.

SCREEN RANGE

SIGNAL AMP

% SCREEN READING

COURSE GAIN DB

FINE GAIN DB

SEARCH UNIT CABLE

TYPE BNC/8BT

LENGTH 6'

CAL. BLOCK TEMP. F°

CAL. BLOCK SIMULATOR TEMP. F°

(REQUIRED SUMMER 73 FOR VESSELS
REQUIRED WINTER 75 FOR PIPING)

FIGURE NO(S), EXAMINED

12-02-2-12

12-02-2-17

12-02-2-23

12-02-2-64

12-02-2-58

12-02-2-75

12-02-2-81

N

A

CALIBRATION CONFIRMATION

TIME	1400 HRS.	HRS.	HRS.	HRS.	HRS.	HRS.	HRS.
BLOCK SIM.	%	IN.	%	IN.	%	IN.	%
BACK REFL.	%	IN.	%	IN.	%	IN.	%
.15" 18-NODE	100 %	10% - 15	%	IN.	%	IN.	%
.25" 18-NODE	100 %	10% - 25	%	IN.	%	IN.	%
.35" 18-NODE	100 %	25% - 35	%	IN.	%	IN.	%
INITIALS	<i>George Sekler</i>						

* BKR CB (BACK REFLECTION FROM CAL. BLOCK)

* BKR P (BACK REFLECTION FROM PART)

SK-JAF-81-011

DATE REVIEWED

CALIBRATION SHEET

SET NO.	JAF 009	TIME:	1000	HR	DATE: 10/15/94	
ITT:	JACUPL	SYSTEM:	02-2/Electric		COMPONENT: PIPE WELD	
EXAMINER:	George Saliba	ID#:	S-1765	LEVEL:	202	COUPLANT: ELECTRAFEL II
AMINER:	✓	ID#:	✓	LEVEL:	✓	COUPLANT ID#: 8443
INSTRUMENT	210568	CALIBRATION BLOCK ID#:	40-1376-75	CRYSTAL ID#:	84708	CALIBRATION BLOCK SIMULATOR
#:		LENGTH:	12 IN	TYPE:	ATO	SCREEN RANGE
NEARITY CHECK	<input checked="" type="checkbox"/> YES	DO:	1.25 IN	FREQ.	2 MHZ	SIGNAL AMP % SCREEN READING
EFFECT:	OFF	THICKNESS:	0.75 IN	SIZE:	6X1.3 IN	COURSE GAIN DB
AT'L. CAL.:	966	ACTUAL:	0.73 IN	ACTUAL:	73°	FINE GAIN DB
ELAY:	682	ANGLE:	73°	NODE:	Long. Thread	SEARCH UNIT CABLE LENGTH 6'
UL. S. ENERGY:	0.5	REFLECTOR	AMPLITUDE % OF FULL SCREEN	SCREEN READING IN INCHES SD		TYPE DIALE
DARSE GAIN IN DB:	40	REFLECTOR	100% /B-NODE	3 SD. IN.	CAL. BLOCK TEMP. FO	
INE GAIN IN DB:	22	REFLECTOR	90% /B-NODE	4 SD. IN.	CAL. BLOCK SIMULATOR TEMP. FO	
THE GAIN:	15	REFLECTOR	70% /B-NODE	5 SD. IN.	(REQUIRED SUMMER 75 FOR VESSELS REQUIRED WINTER 70 FOR PIPING)	
CREEN RANGE:	0.5	REFLECTOR	55% /B-NODE	6 SD. IN.	FIGURE NO(9). EXAMINED	
CREEN DEPTH:	6.0 IN.	REFLECTOR	50% /B-NODE	7 SD. IN.		
OPERATION	Z.5 MHZ.	REFLECTOR	30% /B-NODE	8 SD. IN.		
FREQUENCY:	2.5 MHZ.	TOP NOTCH	%	IN.		
RF	[WAVEFORM]	OPPOSITE NOTCH	%	IN.		
REP. RATE:	1K	BKR. CB	%	IN.		
ZERO CONTROL:	0	BKR. P	%	IN.		
DAMPING:	OFF					
BAIN:	—	DAC				

TIME	1330 HRS.	HRS.	HRS.	HR
DLY,	—	% IN.	% IN.	% IN.
SLP,	—	% IN.	% IN.	% IN.
POLARITY,	—	% IN.	% IN.	% IN.
WIDTH,	—	% IN.	% IN.	% IN.
DELAY,	—	% IN.	% IN.	% IN.
ECHO START	—	% IN.	% IN.	% IN.
INITIALS	Staloff J.			
BKR CB (BACK REFLECTION FROM CAL. BLOCK) BKR P (BACK REFLECTION FROM PART)				
SK-JAF-81-011 DATE REVIEWED _____				

REPORT OF UT INSPECTION

PAGE 4 OF 0
REPORT NO. JAF 101584-1CLIENT New York Power Authority
LOCATION James A. FitzpatrickDATE 10-13-84

WELD IDENTIFICATION NO. 12-02-2-23 DRAWING NO. N. A.
 TYPE OF WELDING PIPE TO SAFEND MATERIAL: BASE SS WELD SS
 SIZE OF PIPE 12" O.D. INCHES WALL THICKNESS .65 INCHES
 SURFACE CONDITION OF PIPE ground OF WELD ground
 WELDING PROCEDURE OR WELD RECORD n.a. TEMPERATURE 100 °F
 METHOD OF EXAMINATION: AUTOMATIC + MANUAL X SEMI-AUTO +
 UT. PROCEDURE NO. UTL - UT - S - 1 Rev. 0 DATE 11-15-83 CLIENT APPROVAL yes
 form rev. 1 dated 4-17-84

	PROBE NO. 1	PROBE NO. 2	PROBE NO. 3	PROBE NO. 4	PROBE NO. 5	PROBE NO. 6	PROBE NO. 7
PROBE TYPE AND/OR MANUFACTURER	KK WSY 70	KK MWB 46	KK MWB 60	RTD SEL 70	SRI SLIC40	SUSI SUS42B	KK MWB 70
SERIAL NO.	#7		V#2	80-580			
TRANSDUCER SIZE (MM) (INCHES)	8x9	8x9	8x9	2x7x15	2x ^ø 9.5	^ø 9.5	8x9
FREQUENCY MHZ	2	2	2	4	5	5	2
ANGLE OF INCIDENCE	68°/32°		57°	70			
EXIT POINT (MM) (INCHES)	12/10		13	9			
REMARKS:	mode-conversion	shear	shear	high-long-mode	long-shear	shear	shear

EQUIPMENT MODEL NO.
SERIAL NUMBER
CALIBRATION DATE
CABLE TYPE
CABLE LENGTH

AUTOMATIC	MANUAL
	4K USK 7
	27274-2613
	09-10-84
	COAXIAL
	24

COUPLING ULTRAGEL II
 MFG. TECHNICARE-ECHO, Inc.
 B. ACCT. NO. # 8330

PERSONNEL PERFORMING EXAMINATION:

NAME <u>M. DALICHOW</u>	LEVEL <u>II</u>	SIGNATURE <u>D. Dalichow</u>
NAME <u>U. Horsthemke</u>	LEVEL <u>IV</u>	SIGNATURE <u>U. Horsthemke</u>
NAME _____	LEVEL _____	SIGNATURE _____
NAME _____	LEVEL _____	SIGNATURE _____
NAME _____	LEVEL _____	SIGNATURE _____

SYSTEM CALIBRATION VERIFICATION RECORD

PAGE 2 OF 6
 REPORT NO. JAF 101584-1
 DATE 10-13-84

LINEARITY CHECK

VERTICAL

SIGNAL 1	100	90	80	70	60	50	40	30	20	10
SIGNAL 2	50	45	40	35	30	25	20	15	10	5

SIGNAL 2 SHALL EQUAL 50% OF SIGNAL 1 \pm 5% OF FULL SCALE

ATTENUATOR

TESTER GAIN	SET	-6	-12	SET	+12	SET	+6
SIGNAL AMP	80%	32-48	16-24	20%	64-96	40%	84-96
		40	20		80		80

DAILY LINEARITY CHECKS SATISFACTORY, REFER TO CAL. NO. 1776-091084

REFERENCE BLOCK DATA


SERIAL NUMBER 12-A 376-66DRAWING NUMBER n.a.MATERIAL SS 304REFERENCE REFLECTORS 10% NOTCH ID

REFERENCE REFLECTORS _____

REFERENCE REFLECTORS _____

REFERENCE REFLECTORS _____

REFERENCE REFLECTORS _____

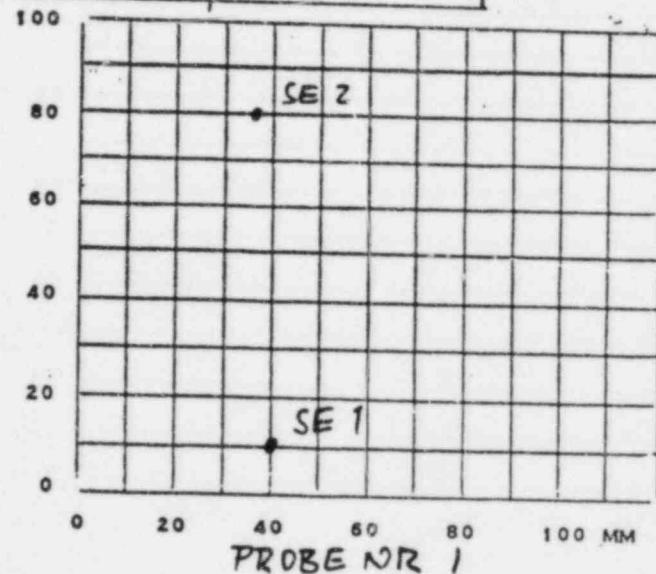

V-PATH DATA

PROBE NO.	PROBE NO.	METAL (MM) PATH (INCHES)	AMPLITUDE (dB)	PROJECTION DISTANCE (MM) (INCHES)

RECHECK DATA

CAL. BLOCK 12-A 376-66 S/N ✓ REF. REFL. 10% NOTCH ID TEMP. 110 °FREF. BLOCK ✓ S/N ✓ REF. REFL. ✓ TEMP. ✓ °FTHERMOMETER SERIAL NO. UTL 010

NAME	TIME	DAC (RECORD AMPLITUDE)	SWEEP RANGE
JALICHOW	16:00	SE 2 46 dB 80% FSH	3.7
JALICHOW	19:30	SE 2 46 dB 80% FSH	3.7

SYSTEM CALIBRATION VERIFICATION RECORD



PAGE 3 OF 6
REPORT NO. JAF 101584-1
DATE 10-13-84


DAC DATA



REFERENCE POINT LOCATION TOP OF THE PIPE

EXAM NO.	PROBE NO.	IND. NO.	REFLECTOR POSITION/mm			Z DEPTH POS. FROM SURFACE % OF 'T.'			ECHO HEIGHT DIFF. dB			METAL PATH MM	
			Y LINEAR EXTEND FROM REFERENCE	X LINEAR EXTEND FROM WELD CT LINE	Z DEPTH POS. FROM SURFACE % OF 'T.'	START	AT MAX	END	START	AT	END		
1	1	1	0	20	60	÷	-15	÷	÷	>50%	÷	-6	42
1	3	1	0	20	40	÷	-15	÷	÷	>50%	÷	±0	28
1	4	1	5	20	40	÷	-9	÷	÷	÷	75%	÷	42
1	1	1	15	20	35	÷	-18	÷	÷	>50%	÷	-8	40
7	1	1	÷	20	÷	BUTTED UP	-21	-34	÷	÷	>50%	÷	-6
SHOW ANGLE STRAIGHT													
7 10° TO WCL													

PAGE 4 OF 6
 REPORT NO. JAF101584-1
 DATE 10-13-84

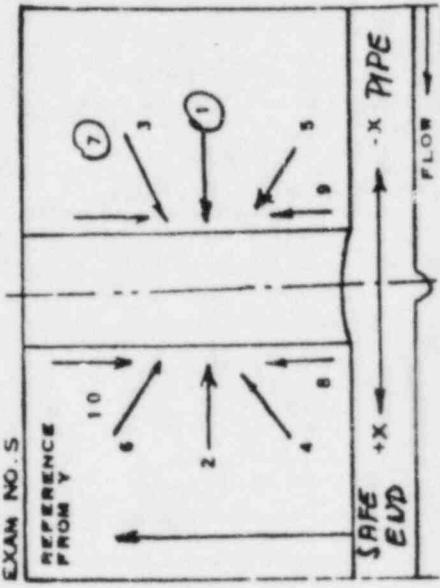

EXAMINER DRAUCHOW / HORSTHEUKE LEVEL II

SIGNATURE [Signature]

AUTHORIZED INSPECTOR [Signature]



REQUIRING NOTIFICATION
CLIENT Energy Institute



REPORT NO. JAF 101584-1
PAGE 5 OF 6

DATA STANDARD REPORT OF INDICATION NUMBER 1

SIGNAL NO.	PROBE NO.	ANGLE OF INCIDENT	EXAM NO.	EXIT X	POINT Y	GAIN DB 100% DAC	METAL PATH	REMARKS
1	1	32°	1	30	20	52	42	<u>SEZ</u>
2	1	$32^\circ-70^\circ-70^\circ$	1	41	20	54	40	<u>SE1</u>
3	3	56°	1	38	20	40	28	
4	4	70°	1	34	20	68	^{4 mm 40°} <u>SE7TH RD</u>	

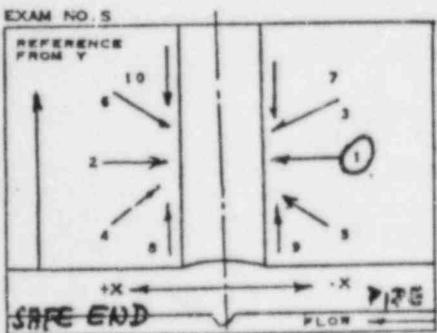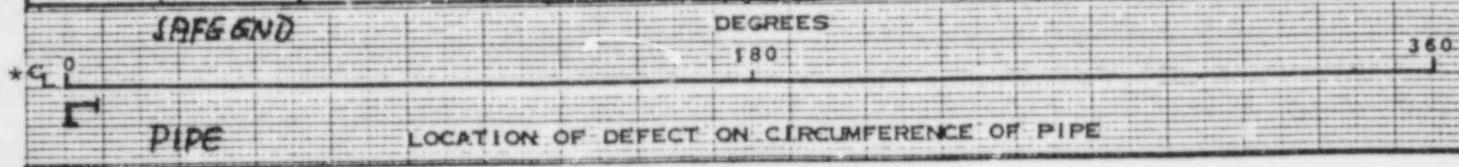

EXAMINER JAIUCHOW/MORSTHEMME LEVEL II
Reviewed by WILHELM E. DREY, DATE 10-15-84
AUTHORIZED INSPECTOR _____

* THE ABOVE GRAPH REPRESENTS THE POSITION OF THE DEFECT IN RELATIONSHIP TO THE WELD CENTERLINE.



-INSPECTION -IGSCC-


old Identification No 12-02-2-23
gmat No INDICATION NR 1
ordinate from reference point "Y" 20 mm CW

Probes Used	Probe No.	Signal No.
Wall Thickness	MSEB 4H	÷
Root Center	MSEB 4H	÷
Other Data	1	1, 2
	3	3
	4	4

INSPECTION CONTOUR

WCL
MM ← → MM

+120 +110 100 +90 +80 +70 +60 +50 +40 +30 +20 +10 0 -10 -20 -30 -40 -50 -60 -70 -80 -90 -100 -110 -120

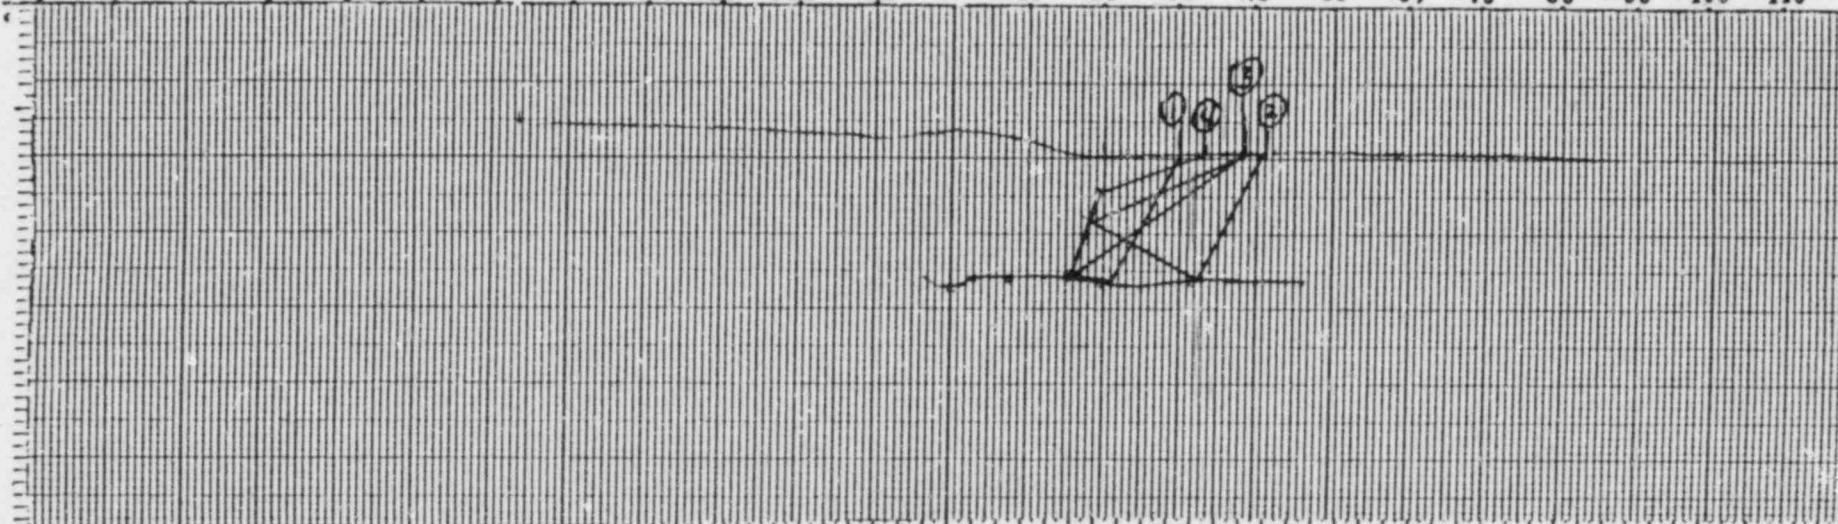

OD

ID

+76+72+68+64+60+56+52+48+44+40+36+32+28+24+20+16+12 +8 +4 0 -4 -6 -8 -12 -16 -20 -24 -28 -32 -36 -40 -44 -48 -52 -56 -60 -64 -68 -72

INSPECTOR DALICHOW / Horstewinkel Level

ATE

10-13-84

WCL
← →
INCHES
1/16"

Report No. JAF 10584-1 page 6 of 6

EBASCO SERVICES INCORPORATED
QUALITY ASSURANCE ENGINEERING
INSERVICE INSPECTION

CALIBRATION DATA

PROJECT JAF ISI OUTAGE
DATA SHEET NO. JAF-085/A DATE 10/12/84
PROCEDURE JAF UT5 Add 1&2 REV 3

COMPONENT OR SYSTEM RECIRCULATION System Loop "A" PIPE OD (IF APPLICABLE) 12"

ITEM IDENTIFICATION NO(S). LISTED ON REVERSE SIDE - COMPONENT TEMP 120°F

CALIBRATION BLOCK NO. 12-A376 THICKNESS .66 TEMP 110°F

SCAN COVERAGE

θ WHAZ

θ BASE MATERIAL

AXIAL

CIRCUMFERENTIAL

EQUIPMENT DATA

SEARCH UNIT

Manufacturer Nortec
Style ZT-Z
Serial No. 15462
Size .50" Frequency 2.25 MHz
Angle 43° Mode SHEAR


Couplant ULTRAGE II Batch No. 8439

INSTRUMENT

Manufacturer KRAUTKRAMER Model USK-7
Serial No. 27276-1534 Cable Length 6'
Frequency BB Reject min
Rep Rate N/A Damping N/A
dB Gain - Coarse 20 Fine 20

Primary Reference Response 80%
Amplitude % Full Screen Height 80%

DAC PLOT - TIME 8:00 AM, PM

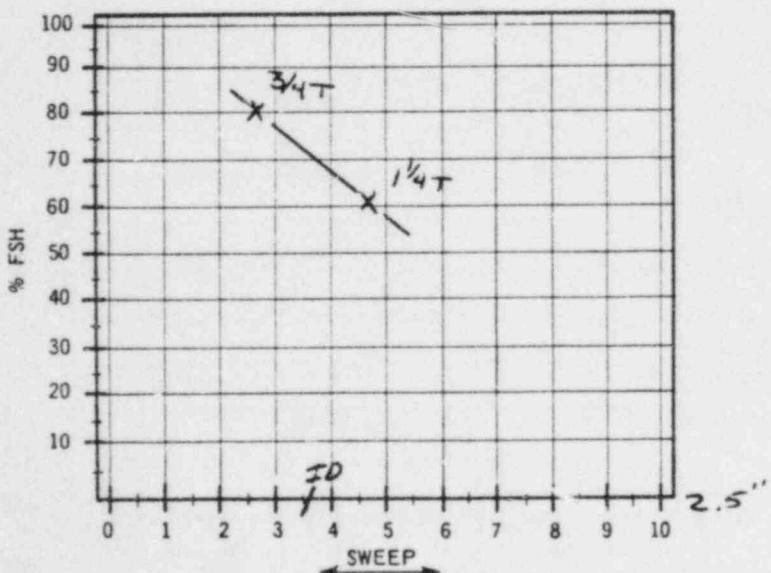

NOTE: When performing examinations where no DAC is required, indicate reference reflector location and amplitude above.

CALIBRATION CHECKS

AMPL ± 20% (2dB) OF INITIAL AMPL		SWEEP + 10% OF INITIAL LOCATION		
TIME	YES	NO	YES	NO
1145	<input checked="" type="checkbox"/>	N/A	<input checked="" type="checkbox"/>	N/A

NOTE: If response above is "NO" refer to Calibration Check section of procedure.

EXAMINER BY	<u>L. Danzo</u>	TC-1A LEVEL	<u>II</u>
REVIEWED BY	<u>M. Goldfarb</u>	TC-1A LEVEL	<u>I</u>
		DATE	<u>10/17/84</u>

ADDITIONAL REMARKS ID. 3.6

3/4T - 2.6 80%

1/4T - 4.6 62%

Scotthoff Nov 17 '84 4 TEP
10/17/84 106

EBASCO SERVICES INCORPORATED

BY _____ DATE _____

SHEET 3 OF 4

CHKD. BY _____ DATE _____

OFS NO. _____

DEPT.
NO. _____



CLIENT NYPA

PROJECT J. A. Fitzpatrick

Data Sheet # JAF-085/A

SUBJECT 12-02-2-23

A Loop Recirculation System

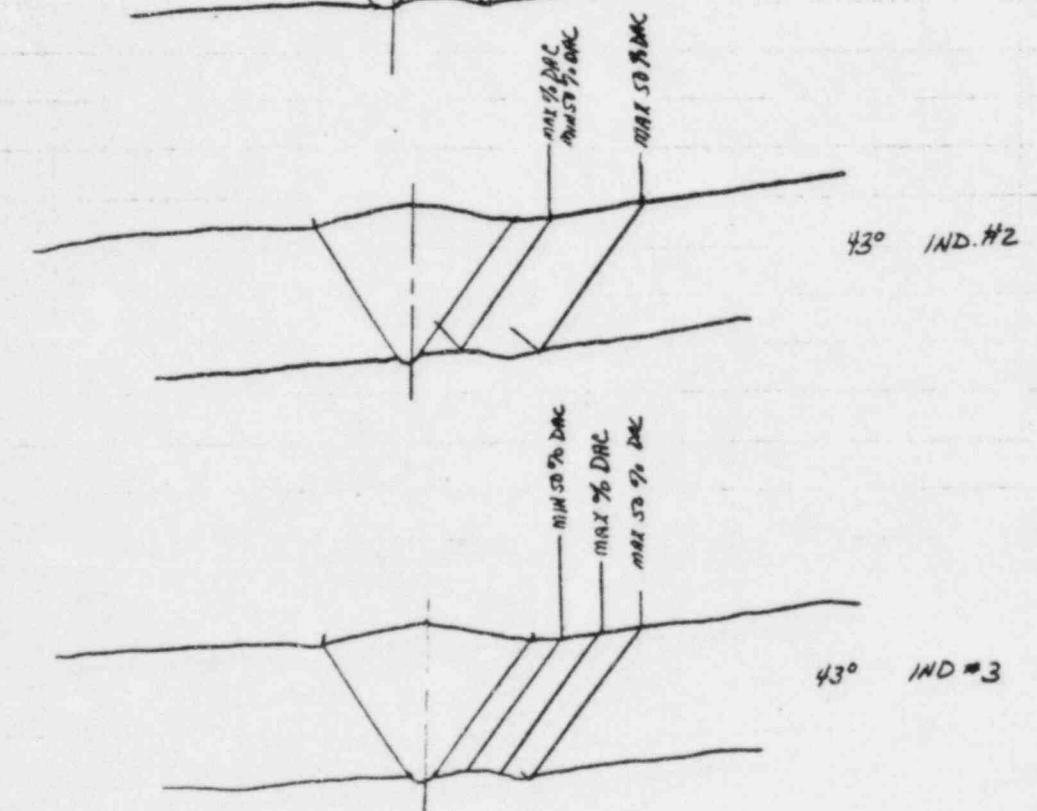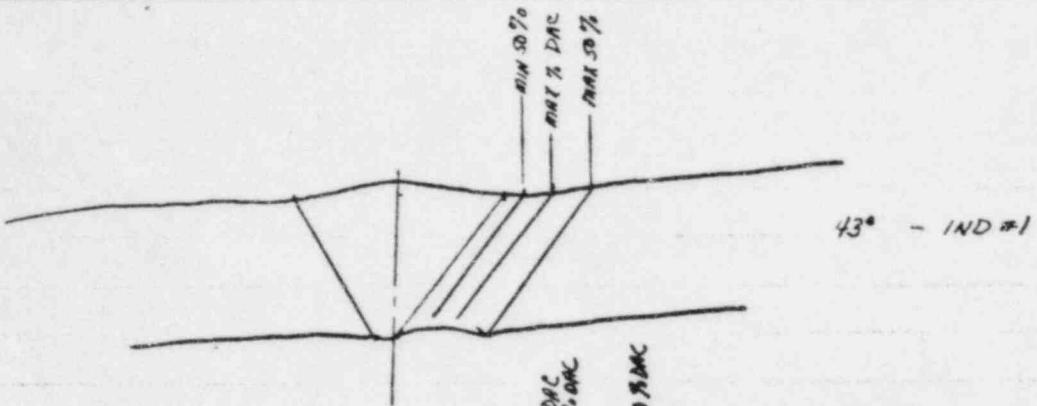


12-02-2-23

EBASCO SERVICES INCORPORATED
QUALITY ASSURANCE ENGINEERING

WELD THICKNESS DATA SHEET

Data Sheet # JAF-085/A.

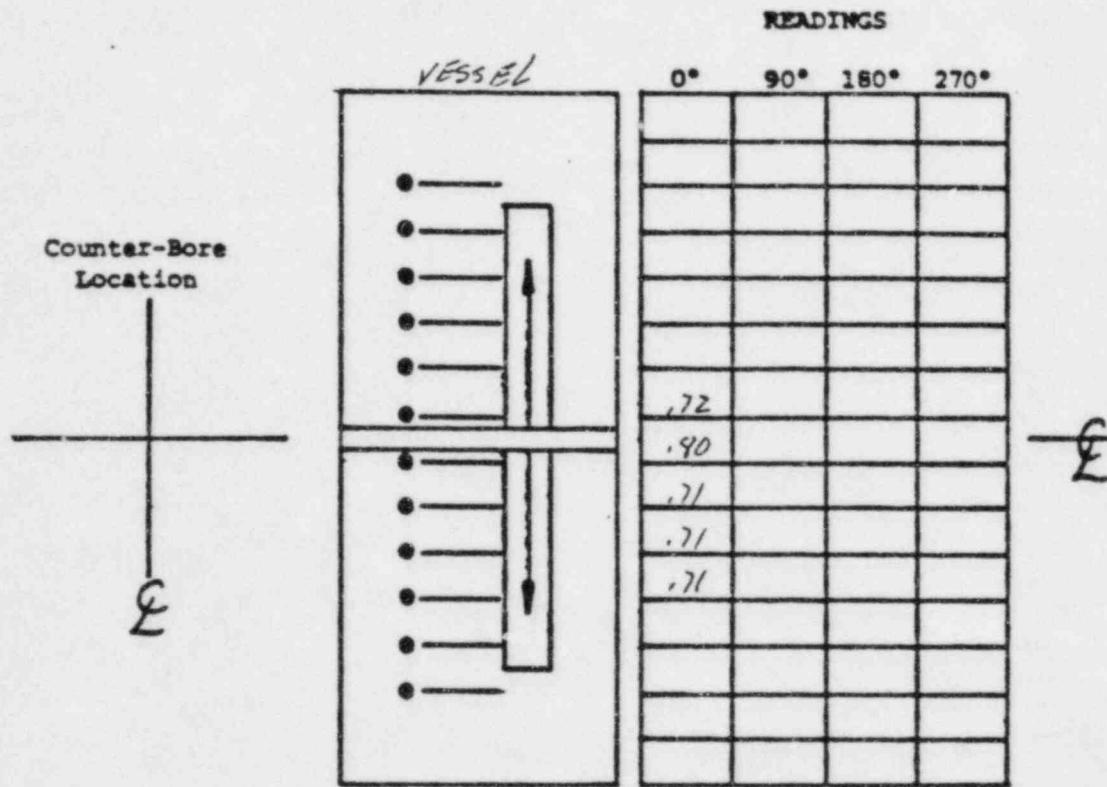

Transducer Size .50 Weld No. 12-02-2-23 System/Area PECIRE SAW-EAST

Examiner J. Flanagan Level IV Date 10-13-84

EBASCO SERVICES INCORPORATED
QUALITY ASSURANCE ENGINEERING
INSERVICE INSPECTION
CALIBRATION DATA

PROJECT J.A.F. + zpatrick

DATA SHEET NO. JAF-C86/1 DATE 10-16-8

PROCEDURE JAF-UT 5 Addl+2 REV 3

COMPONENT OR SYSTEM Recirculation Loop "A" PIPE OD (IF APPLICABLE) 12"

ITEM IDENTIFICATION NO(S). LISTED ON REVERSE SIDE - COMPONENT TEMP 115°F

CALIBRATION BLOCK NO. 12-A376 THICKNESS 0.66" TEMP 120°F

SCAN COVERAGE

 10° WHAZ 10° BASE MATERIAL AXIAL CIRCUMFERENTIAL

EQUIPMENT DATA


SEARCH UNIT

Manufacturer K.B. Aerotech
 Style GAMMA
 Serial No. E1411Z
 Size 0.5" Dia. Frequency 2.25 MHz
 Angle 62° Mode SHEAR
 Couplant ULTRAGEL II Batch No. 8439

INSTRUMENT

Manufacturer KRAUTKRAMER-BRANSON Model USL-38
 Serial No. 210571 Cable Length 6'
 Frequency 2.5 MHz Reject OFF
 Rep. Rate N/A Damping OFF
 dB Gain - Coarse 20 Fine 34
 Primary Reference Response Amplitude % Full Screen Height
 80%FSH

DAC PLOT - TIME 1200 AM (PM)

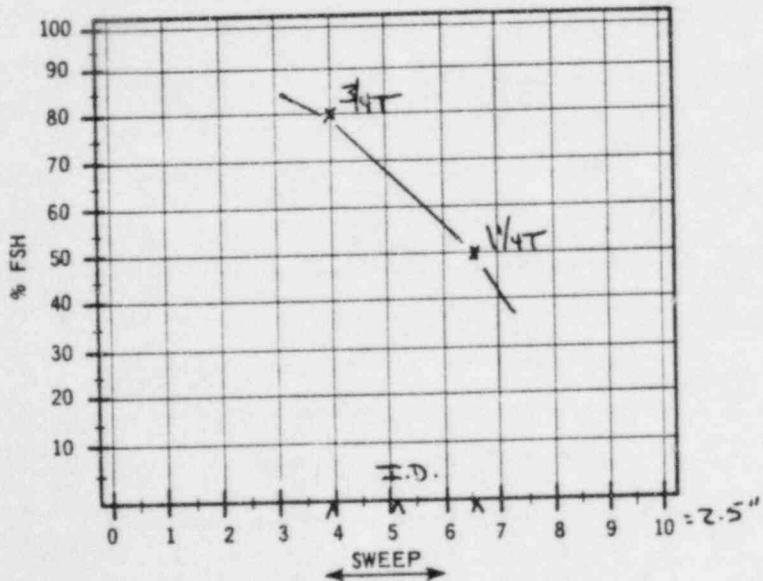

NOTE: When performing examinations where no DAC is required, indicate reference reflector location and amplitude above.

ADDITIONAL REMARKS

CALIBRATION CHECKS

AMPL ± 20% (2dB) OF INITIAL AMPL		SWEEP + 10% OF INITIAL LOCATION		
TIME	YES	NO	YES	NO
1335	✓	N/A	✓	N/A

NOTE: If response above is "NO" refer to Calibration Check section of procedure.

EXAMINER(S)

1. James Dush TC-1A LEVEL III
 2. Robert Bourque TC-1A LEVEL I
 REVIEWED BY Thomas Smith II DATE 10/17/84

George J. Lubell, NYPA 10/17/84

EBASCO SERVICES INCORPORATED
QUALITY ASSURANCE ENGINEERING
INSERVICE INSPECTION
INDICATION DATA

TCP 10-16-84
SHEET 2 OF 4

ITEM IDENTIFICATION 12-02-2-23

CALIBRATION DATA SHEET NO. JAF-086/A

DATA TABULATION														
SCAN DIRECTION			INDI-CATION NO.	EXAM. ON (ADJ WELD) SIDE OF WELD	MAX % DAC	SWEEP READING	SEARCH UNIT EXIT POINT LOCATION		50% DAC OR HALF MAXIMUM AMPLITUDE				STRAIGHT BEAM (CAL ON BACK REFLECTION)	
							CIRCUMFERENTIAL (DISTANCE CW OR CCW FROM REFERENCE LINE)	AXIAL (DISTANCE FROM WELD)	MINIMUM		MAXIMUM		INDICATION AMPLITUDE (% FSH)	BACK REFLECTION AMPLITUDE (% FSH)
ST. BEAM	CIR-CUM-FEREN-TIAL	AXIAL							SWEET READING	S.U. POSITION	SWEET READING	S.U. POSITION		
			✓ 1	Pipe	44	1.6	0°	0.65"						
			✓ 2		62	3.8	4" cw	0.65"						
			✓ 3		21	3.4	5" cw	0.65"						
			✓ 4		31	3.2	6" cw	0.65"						
			✓ 5		25	3.8	9" cw	0.65"						
			✓ 6		19	3.0	10" cw	0.65"						
			✓ 7		38	4.0	12" cw	0.65"						
			✓ 8		31	2.8	13" cw	0.65"						
			✓ 9		31	3.8	15" cw	0.65"						
			✓ 10		25	4.0	16" cw	0.65"						
			✓ 11		25	3.8	17" cw	0.65"						
			✓ 12		19	4.0	20" cw	0.65"						
			✓ 13		25	2.6	26" cw	0.65"						
RESULTS	INDICA-TION NO.	LOCATION OF INDICATION		LENGTH			%		DEPTH (IF PLANAR)	DISTANCE FROM SURFACE	WIDTH (IF LAMINAR)	COMMENTS		
		CIRC	AXIAL									<i>Multiple Signals 360° transmitted around pipe.</i>		

* NOTE: MEASUREMENTS TAKEN From toe of weld.

CONTINUATION ATTACHED - Yes No

EXAMINER(S)
 1. Laura Parker TC-1A LEVEL III
 2. Robert Bayly TC-1A LEVEL II
11-16-84

EBASCO SERVICES INCORPORATED
QUALITY ASSURANCE ENGINEERING
INSERVICE INSPECTION
INDICATION DATA

SHEET 3 OF 4ITEM IDENTIFICATION LZ-022-2-27CALIBRATION DATA SHEET NO. JAF-086/1A

DATA TABULATION

SCAN DIRECTION			INDI-CATION NO.	EXAM. ON (ADJ WELD) SIDE OF WELD	MAX % DAC	SWEEP READING	SEARCH UNIT EXIT POINT LOCATION		50% DAC OR HALF MAXIMUM AMPLITUDE				STRAIGHT BEAM (CAL ON BACK REFLECTION)	
ST. BEAM	CIR-CUM-FEREN-TIAL	AXIAL					CIRCUMFERENTIAL (DISTANCE CW OR CCW FROM REFERENCE LINE)	AXIAL (DISTANCE FROM WELD E)	MINIMUM		MAXIMUM		INDICATION AMPLITUDE (% FSH)	BACK REFLECTION AMPLITUDE (% FSH)
	SWEET READING	S.U. POSITION							SWEET READING	S.U. POSITION	SWEET READING	S.U. POSITION		
	/	14	PIPE	21	3.0		27 1/2" cw	0.65"						
	/	15		21	3.2		31 1/2" cw	0.65"						
	/	16		31	4.0		32 1/2" cw	0.65"						
	/	17		28	3.0		34" cw	0.65"						
	/	18		21	3.5		35" cw	0.65"						
	/	19		25	3.2		36" cw	0.65"						
	/	20		25	2.8		37" cw	0.65"						
	/	21		19	3.4		38" cw	0.65"						
	/	22		25	3.3		39 1/2" cw	0.65"						
	/	23		62	2.0		1" cw	0.65"						

RESULTS	INDICA-TION NO.	LOCATION OF INDICATION		LENGTH	%t		WIDTH (IF LAMINAR)	COMMENTS
		CIRC	AXIAL		DEPTH (IF PLANAR)	DISTANCE FROM SURFACE		
								<i>Multiple Signals 360° Intermittent around pipe.</i>

* Note: MEASUREMENTS TAKEN FROM TOE OF WELD.

CONTINUATION ATTACHED - Yes No

EXAMINER(S)
 1. James E. Ogle TC-1A LEVEL III
 2. Robert Bruegh TC-1A LEVEL I
 REVIEWED BY Alvin Smith III DATE 10/17/84

EBASCO SERVICES INCORPORATED

BY _____ DATE _____

CHKD. BY JF DATE 10-16-84

SHEET 4 OF 4

DEPT.
NO.


CLIENT NYPA

PROJECT Fitz 151


Data Sheet # JAF-086/M

SUBJECT _____

12-02-2-23

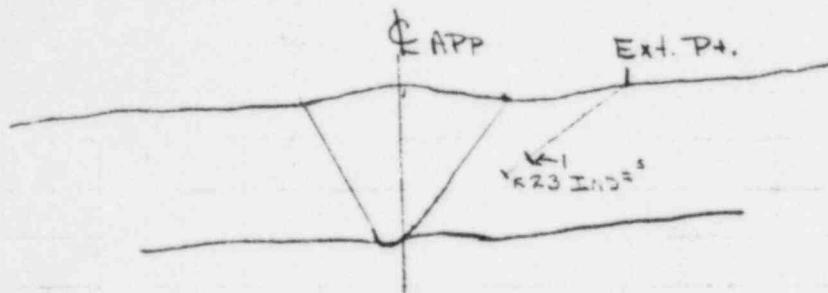


12-02-2-23

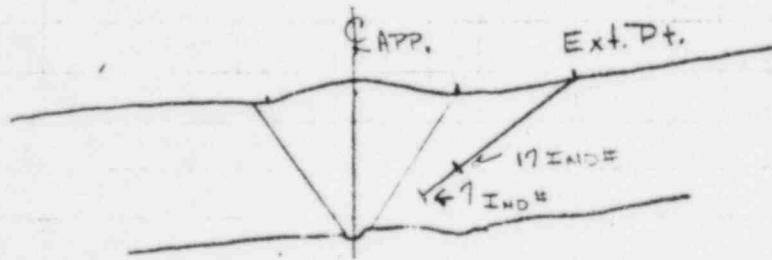

12-02-2-23

WEDNESDAY NOVEMBER 22-2000 SUSAN PIOT

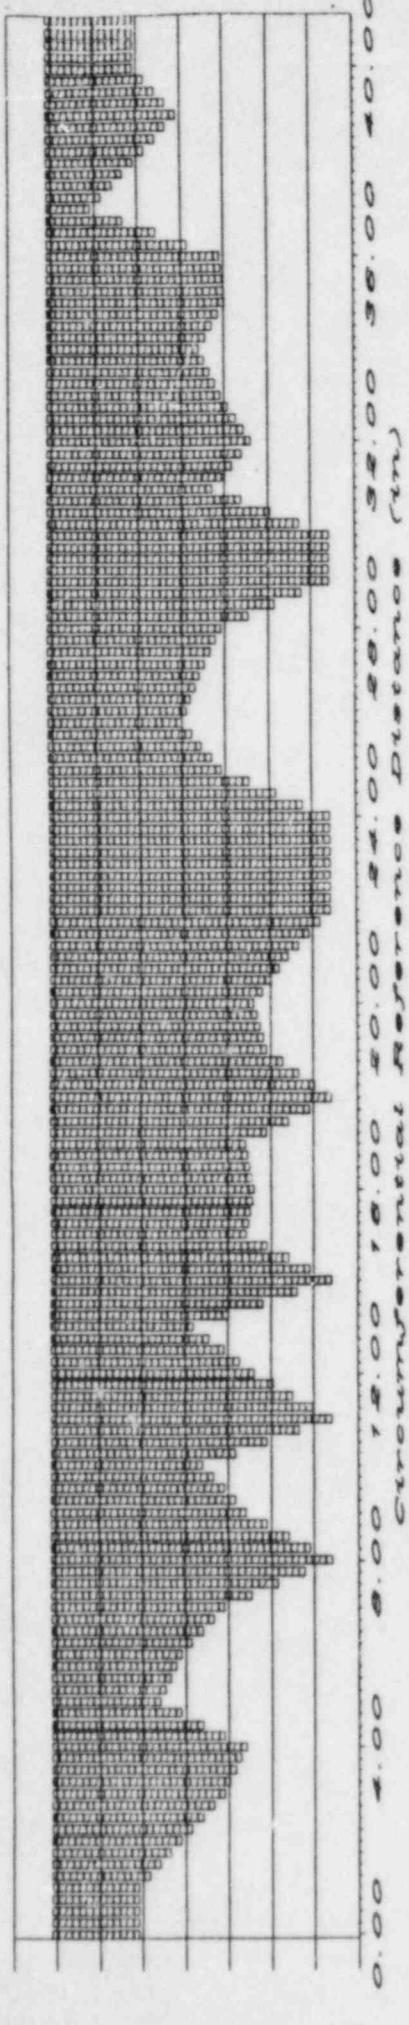

Weld 12-02-2-23

Reference Distance (inches)	Remaining Wall	Crack Depth	Nominal Wall Thickness
0.00	0.2000	0.5100	0.660
0.25	0.2000	0.5100	0.660
0.50	0.2000	0.5100	0.660
0.75	0.2000	0.5100	0.660
1.00	0.2000	0.5100	0.660
1.25	0.2250	0.4850	0.660
1.50	0.2500	0.4600	0.660
1.75	0.2750	0.4350	0.660
2.00	0.3000	0.4100	0.660
2.25	0.3250	0.3850	0.660
2.50	0.3500	0.3600	0.660
2.75	0.3750	0.3350	0.660
3.00	0.4000	0.3100	0.660
3.25	0.4125	0.2975	0.660
3.50	0.4250	0.2850	0.660
3.75	0.4375	0.2725	0.660
4.00	0.4500	0.2600	0.660
4.25	0.4000	0.3100	0.660
4.50	0.3500	0.3600	0.660
4.75	0.3000	0.4100	0.660
5.00	0.2500	0.4600	0.660
5.25	0.2625	0.4475	0.660
5.50	0.2750	0.4350	0.660
5.75	0.2875	0.4225	0.660
6.00	0.3000	0.4100	0.660
6.25	0.3250	0.3850	0.660
6.50	0.3500	0.3600	0.660
6.75	0.3750	0.3350	0.660
7.00	0.4000	0.3100	0.660
7.25	0.4625	0.2475	0.660
7.50	0.5250	0.1850	0.660
7.75	0.5875	0.1225	0.660
8.00	0.6500	0.0600	0.660
8.25	0.6000	0.1100	0.660
8.50	0.5500	0.1600	0.660
8.75	0.5000	0.2100	0.660
9.00	0.4500	0.2600	0.660
9.25	0.4250	0.2850	0.660
9.50	0.4000	0.3100	0.660
9.75	0.750	0.3350	0.660
10.00	0.3500	0.3600	0.660
10.25	0.4250	0.2850	0.660
10.50	0.5000	0.2100	0.660
10.75	0.5750	0.1350	0.660
11.00	0.6500	0.0600	0.660
11.25	0.6050	0.1050	0.660
11.50	0.5600	0.1500	0.660
11.75	0.5150	0.1950	0.660
12.00	0.4700	0.2400	0.660
12.25	0.4350	0.2750	0.660

Weld 12-02-2-23

Reference Distance (inches)	Remaining Wall	Crack Depth	Nominal Wall Thickness
12.50	0.4000	0.3100	0.660
12.75	0.3650	0.3450	0.660
13.00	0.3300	0.3800	0.660
13.25	0.4100	0.3000	0.660
13.50	0.4900	0.2200	0.660
13.75	0.5700	0.1400	0.660
14.00	0.6500	0.0600	0.660
14.25	0.6000	0.1100	0.660
14.50	0.5500	0.1600	0.660
14.75	0.5000	0.2100	0.660
15.00	0.4500	0.2600	0.660
15.25	0.4550	0.2550	0.660
15.50	0.4600	0.2500	0.660
15.75	0.4650	0.2450	0.660
16.00	0.4700	0.2400	0.660
16.25	0.4650	0.2450	0.660
16.50	0.4600	0.2500	0.660
16.75	0.4550	0.2550	0.660
17.00	0.4500	0.2600	0.660
17.25	0.5000	0.2100	0.660
17.50	0.5500	0.1600	0.660
17.75	0.6000	0.1100	0.660
18.00	0.6500	0.0600	0.660
18.25	0.6125	0.0975	0.660
18.50	0.5750	0.1350	0.660
18.75	0.5375	0.1725	0.660
19.00	0.5000	0.2100	0.660
19.25	0.4925	0.2175	0.660
19.50	0.4850	0.2250	0.660
19.75	0.4775	0.2325	0.660
20.00	0.4700	0.2400	0.660
20.25	0.4900	0.2200	0.660
20.50	0.5100	0.2000	0.660
20.75	0.5300	0.1800	0.660
21.00	0.5500	0.1600	0.660
21.25	0.5750	0.1350	0.660
21.50	0.6000	0.1100	0.660
21.75	0.6250	0.0850	0.660
22.00	0.6500	0.0600	0.660
22.25	0.6500	0.0600	0.660
22.50	0.6500	0.0600	0.660
22.75	0.6500	0.0600	0.660
23.00	0.6500	0.0600	0.660
23.25	0.6500	0.0600	0.660
23.50	0.6500	0.0600	0.660
23.75	0.6500	0.0600	0.660
24.00	0.6500	0.0600	0.660
24.25	0.5875	0.1225	0.660
24.50	0.5250	0.1850	0.660
24.75	0.4625	0.2475	0.660

Weld 12-02-2-23

Reference Distance (inches)	Remaining Wall	Crack Depth	Nominal Wall Thickness
25.00	0.4000	0.3100	0.660
25.25	0.3775	0.3325	0.660
25.50	0.3550	0.3550	0.660
25.75	0.3325	0.3775	0.660
26.00	0.3100	0.4000	0.660
26.25	0.3200	0.3900	0.660
26.50	0.3300	0.3800	0.660
26.75	0.3400	0.3700	0.660
27.00	0.3500	0.3600	0.660
27.25	0.3625	0.3475	0.660
27.50	0.3750	0.3350	0.660
27.75	0.3875	0.3225	0.660
28.00	0.4000	0.3100	0.660
28.25	0.4625	0.2475	0.660
28.50	0.5250	0.1850	0.660
28.75	0.5875	0.1225	0.660
29.00	0.6500	0.0600	0.660
29.25	0.6500	0.0600	0.660
29.50	0.6500	0.0600	0.660
29.75	0.6500	0.0600	0.660
30.00	0.6500	0.0600	0.660
30.25	0.5825	0.1275	0.660
30.50	0.5150	0.1950	0.660
30.75	0.4475	0.2625	0.660
31.00	0.3800	0.3300	0.660
31.25	0.4025	0.3075	0.660
31.50	0.4250	0.2850	0.660
31.75	0.4475	0.2625	0.660
32.00	0.4700	0.2400	0.660
32.25	0.4525	0.2575	0.660
32.50	0.4350	0.2750	0.660
32.75	0.4175	0.2925	0.660
33.00	0.4000	0.3100	0.660
33.25	0.3875	0.3225	0.660
33.50	0.3750	0.3350	0.660
33.75	0.3625	0.3475	0.660
34.00	0.3500	0.3600	0.660
34.25	0.3650	0.3450	0.660
34.50	0.3800	0.3300	0.660
34.75	0.3950	0.3150	0.660
35.00	0.4100	0.3000	0.660
35.25	0.4075	0.3025	0.660
35.50	0.4050	0.3050	0.660
35.75	0.4025	0.3075	0.660
36.00	0.4000	0.3100	0.660
36.25	0.3250	0.3850	0.660
36.50	0.2500	0.4600	0.660
36.75	0.1750	0.5350	0.660
37.00	0.1000	0.6100	0.660
37.25	0.1250	0.5850	0.660

Weld 12-02-2-23

Reference Distance (inches)	Remaining Wall	Crack Depth	Nominal Wall Thickness
37.50	0.1500	0.5600	0.660
37.75	0.1750	0.5350	0.660
38.00	0.2000	0.5100	0.660
38.25	0.2250	0.4850	0.660
38.50	0.2500	0.4600	0.660
38.75	0.2750	0.4350	0.660
39.00	0.3000	0.4100	0.660
39.25	0.2750	0.4350	0.660
39.50	0.2500	0.4600	0.660
39.75	0.2250	0.4850	0.660
40.00	0.2000	0.5100	0.660
40.25	0.2000	0.5100	0.660
40.50	0.2000	0.5100	0.660
40.75	0.2000	0.5100	0.660
41.00	0.2000	0.5100	0.660