

South Texas Project Electric Generating Station P.O. Box 289 Wadsworth, Texas 77483

November 25, 1998
NOC-AE-000365
File No.: G09.16
10CFR50.55a

U. S. Nuclear Regulatory Commission
Attention: Document Control Desk
Washington, DC 20555

South Texas Project
Units 1 and 2
Docket Nos. STN 50-498, STN 50-499
Supplemental Information for Request for Relief from
ASME Code Case N-498 (RR-ENG-28)

Reference:

Correspondence from Thomas J. Jordan, South Texas Project, to NRC Document Control Desk dated October 8, 1998 (NOC-AE-000313)

In accordance with the provisions of 10CFR50.55a(a)(3)(ii), the South Texas Project submitted the referenced request for relief from the requirements of ASME Section XI Code Case N-498. ASME Code Case N-498 has been approved for use previously and is listed in Regulatory Guide 1.147, "Inservice Inspection Code Case Acceptability ASME Section XI Division 1," Revision 11. Approval of this relief request will exempt Class 1 components from being tested at full Reactor Coolant System pressure if they are normally isolated from full Reactor Coolant System pressure.

Attached is supplemental information in support of the relief request providing justification as to why South Texas Project compliance with Code Case N-498 would result in hardship without a compensating increase in the level of quality and safety. In addition, the list of affected valves has been revised and the valves categorized according to their specific surveillance considerations.

If there are any questions, please contact either Mr. P. L. Walker at (512) 972-8392 or me at (512) 972-7902.

Thomas J. Jordan
Manager,
System Engineering

AD47

PLW

Attachment:

Supplemental Information for Request for Relief from ASME Code Case N-498 (RR-ENG-28)

9812070099 981125
PDR ADOCK 05000498
G PDR

c:

Ellis W. Merschoff
Regional Administrator, Region IV
U. S. Nuclear Regulatory Commission
611 Ryan Plaza Drive, Suite 400
Arlington, TX 76011-8064

Thomas W. Alexion
Project Manager, Mail Code 13H3
U. S. Nuclear Regulatory Commission
Washington, DC 20555-0001

Cornelius F. O'Keefe
Sr. Resident Inspector
c/o U. S. Nuclear Regulatory Commission
P. O. Box 910
Bay City, TX 77404-0910

J. R. Newman, Esquire
Morgan, Lewis & Bockius
1800 M. Street, N.W.
Washington, DC 20036-5869

M. T. Hardt/W. C. Gunst
City Public Service
P. O. Box 1771
San Antonio, TX 78296

A. Ramirez/C. M. Canady
City of Austin
Electric Utility Department
721 Barton Springs Road
Austin, TX 78704

Jon C. Wood
Matthews & Branscomb
One Alamo Center
106 S. St. Mary's Street, Suite 700
San Antonio, TX 78205-3692

Institute of Nuclear Power
Operations - Records Center
700 Galleria Parkway
Atlanta, GA 30339-5957

Richard A. Ratliff
Bureau of Radiation Control
Texas Department of Health
1100 West 49th Street
Austin, TX 78756-3189

D. G. Tees/R. L. Balcom
Houston Lighting & Power Co.
P. O. Box 1700
Houston, TX 77251

Central Power and Light Company
ATTN: G. E. Vaughn/C. A. Johnson
P. O. Box 289, Mail Code: N5012
Wadsworth, TX 77483

U. S. Nuclear Regulatory Commission
Attention: Document Control Desk
Washington, D.C. 20555-0001

**SOUTH TEXAS PROJECT
UNITS 1 AND 2
Supplemental Information for Request for Relief from
ASME Code Case N-498 (RR-ENG-28)**

Introduction:

ASME Code Case N-498, "Alternative Rules for 10-year Hydrostatic Pressure Testing for Class 1 and 2 Systems, Section XI, Division 1," allows use of a system leakage test (IWB-5221) in lieu of a hydrostatic test. Code Case N-498 requires that the boundary subject to test pressurization during the system pressure test extend to all Class 1 pressure-retaining components within the system boundary.

Pressurization of these components to full RCS pressure is impractical under normal operating conditions, resulting in hardship without a compensating increase in the level of quality and safety. Consequently, the South Texas Project requests relief from testing Class 1 components at full Reactor Coolant System pressure for those components that are normally isolated from Reactor Coolant System pressure. Components covered under the scope of this relief request are located inside containment.

Under this relief, the pressure-retaining boundary during the 10-year hydrostatic test shall correspond to the reactor coolant system boundary, with all valves in the normal position, that is required for normal reactor operation startup. VT-2 examination shall, however, extend to and include the second closed valve at the boundary extremity. This portion of the Class 1 boundary will be VT-2 inspected at a stabilization pressure achieved based on seat leakage from the first isolation valve.

10CFR50 Appendix A, "General Design Criteria for Nuclear Power Plants," and Appendix J, "Primary Reactor Containment Leakage Testing for Water-cooled Power Reactors," elaborate on testing valves which provide containment isolation. However, the valves addressed by this relief request are double isolation valves located only inside containment. Consequently, Appendix A and Appendix J do not apply to the components addressed by this relief request.

Hardship Considerations and Compensatory Factors:

The valves to be included under this relief request have been categorized according to the types of hardship imposed by testing under Code Case N-498. Each category is provided with a list of factors that would compensate for not testing the listed valves under Code Case N-498.

1. The Class 1 piping and valves identified below are normally isolated from RCS pressure by the upstream check valve during normal operations. Consequently, the pressure attained as a result of leakage past the check valve may not reach RCS operating pressure, but rather would be dependent upon the relative leak rates of the two isolation valves.

Note: The following check valves and piping are located inside Reactor Containment.

- 6"/8"SI1(2)108BB1 between XSI0009A and XSI0010A (High Head Safety Injection) (Drawing 5N129F05013)
- 8"RH1(2)112BB1 between XRH0020A and 8"SI1(2)108BB1 (Residual Heat Removal) (Drawing 5N129F05013)
- 6"SI1(2)111BB1 between XSI0007A and 10"RH1(2)108BB1 (High Head Safety Injection) (Drawing 5N129F05013)
- 8"/10"RH1(2)108BB1 between XRH0032A, and 12"SI1(2)125BB1 (Residual Heat Removal System Train A) (Drawing 5N129F05013)
- 6"/8"SI1(2)208BB1 between XSI0009B and XSI0010B (High Head Safety Injection) (Drawing 5N129F05014)
- 8"RH1(2)212BB1 between XRH0020B and 8"SI1(2)208BB1 (Residual Heat Removal System) (Drawing 5N129F05014)
- 6"SI1(2)211BB1 between XSI0007B and 10"RH1(2)208BB1 (High Head Safety Injection) (Drawing 5N129F05014)
- 8"/10"RH1(2)208BB1 between XRH0032B and 12"SI1(2)218BB1 (Residual Heat Removal System Train B) (Drawing 5N129F05014)
- 8"SI1(2)327BB1 between XSI0009C and XSI0010C (High Head Safety Injection) (Drawing 5N129F05015)
- 8"RH1(2)315BB1 between XRH0020C and 8"SI1(2)327BB1 (Residual Heat Removal System)(Drawing 5N129F05015)
- 6"SI1(2)308BB1 between XSI0007C and 10"RH1(2)308BB1 (High Head Safety Injection) (Drawing 5N129F05015)
- 8"/10"RH1(2)308BB1 between XRH0032C and 12"SI1(2)315BB1 (Residual Heat Removal System Train C) (Drawing 5N129F05015)
- 12"SI1(2)125BB1 between XSI0038A and XSI0046A (RCS Cold Leg Loop 1) (Drawing 5N129F05016)
- 12"SI1(2)218BB1 between XSI0038B and XSI0046B (RCS Cold Leg Loop 2) (Drawing 5N129F05016)
- 12"SI1(2)315BB1 between XSI0038C and XSI0046C (RCS Cold Leg Loop 3) (Drawing 5N129F05016)

Hardships Associated with Testing the Listed Components under Code Case N-498

- No means exists to measure the pressure to which these components are subjected during testing without developing special test methodology. Testing of these systems at elevated pressures to meet Code Case N-498 would require a special test procedure which would involve cross-connecting the Safety Injection test lines used for leak testing these check valves and operating a hydrostatic test pump to pressurize each of the identified Class 1 lines. This test would place the plant in a lineup not previously used or evaluated for use at the South Texas Project.

- The support systems used for testing would have to be pressurized to higher than their normal operating levels. Specifically, the interconnected Safety Injection system test lines with a defined operating pressure as low as 55 psig would be subjected to greater than RCS normal operation pressure.
- Because all of the listed components are at least partially contained inside the bioshield, application of Code Case N-498 requirements would result in additional radiation exposure to plant personnel.
- Leakage past the valve to the RCS could affect the boron concentration of the RCS and complicate the task of maintaining homogeneous boron concentrations during this Mode 3 test.

Compensatory Factors

- The pressure boundary integrity of these components is validated and documented each refueling outage by a system leakage test.
 - RCS pressure boundary valve leak checks are performed every refueling outage to validate the leak rates of all lines subjected to normal RCS pressure.
 - These components function to provide redundant protection. If the line downstream from the first isolation valve were to fail, the first isolation valve will still provide the pressure boundary protection function.
2. The Class 1 piping and valves identified below are normally isolated from RCS pressure by the first isolation valve (RH-0060A, B, C) during normal operation. Consequently, the pressure attained as a result of leakage through the first valve will depend on the relative leak rates of the two valves in series and may not reach RCS operating pressure.

Note: The following isolation valves and piping are all located inside the Containment.

- 12"RH1(2)101BB1 between XRH0060A and XRH0061A (RCS Hot Leg Loop 1)
(Drawing 5R169F20000)
- 12"RH1(2)201BB1 between XRH0060B and XRH0061B (RCS Hot Leg Loop 2)
(Drawing 5R169F20000)
- 12"RH1(2)301BB1 between XRH0060C and XRH0061C (RCS Hot Leg Loop 3)
(Drawing 5R169F20000)
- 1" line associated with and including isolation valves HV3657A and HV3658A
(Drawing 5R149F05001)
- 1" line associated with and including isolation valves HV3657B and HV3658B
(Drawing 5R149F05001)

Hardships Associated with Testing the Listed Components under Code Case N-498

- No means exists to measure the pressure to which these components are subjected during testing. Testing these systems at elevated pressures would necessitate generation of a special test procedure because this test would place the plant in a configuration that has

not been previously performed or evaluated for use at the South Texas Project. For the case of the RHR suction isolation valves, this test would involve overriding a protective interlock to open the first isolation valve.

- Opening the first isolation valve would result in single-valve protection of the RHR system, which has a design pressure of 600 psig. An intersystem LOCA could occur should the second valve open or allow sufficient leakage to cause the RHR relief valve to lift.
- Opening the second isolation valve in order to pressure up against the first isolation valve is impractical because the RHR operating pressure is 359 psig. The design pressure of the RHR system is only 600 psig for the downstream portion of the system. To pressurize the RHR to RCS pressure could create a failure in the system resulting in an intersystem LOCA.

Compensatory Factors

- The pressure boundary integrity of these components is validated and documented each refueling outage by a system leakage test.
 - These components function to provide redundant protection. If the line downstream from the first isolation valve were to fail, the first isolation valve will still provide the pressure boundary protection function.
3. The following vent and drain lines and associated manual isolation valves isolate the RCS from the RCB atmosphere. These components are normally isolated from RCS pressure by the first normally closed isolation valve during normal operations. Consequently, the pressure attained as a result of leakage through that first isolation valve will depend on the leak rate and the tightness of the downstream isolation components and may not reach RCS operating pressure.

Note: The following drain isolation valves and piping are all located inside the Containment Bioshield.

- 2"RC1(2)121BB1 between RC0057A and RC0058A (RCS Loop 1) (Drawing 5R149F05001)
- 2"RC1(2)220BB1 between RC0057B and RC0058B (RCS Loop 2) (Drawing 5R149F05001)
- 2"RC1(2)321BB1 between RC0057C and RC0058C (RCS Loop 3) (Drawing 5R149F05001)
- 2"RC1(2)418BB1 between RC0057D and RC0058D (RCS Loop 4) (Drawing 5R149F05001)
- ¾" line associated with and including isolation valves RC0123 and RC0152 (Drawing 5R149F05001)
- ¾" RC1(2)122BB1 and RC0200 (Drawing 5R149F05001)
- ¾" line associated with and including isolation valves RC0128 and RC0146 (Drawing 5R149F05001)

- ¾" line associated with and including isolation valves RC0129 and RC0142 (Drawing 5R149F05001)
- 1" line associated with and including isolation valves SI0168 and SI0203 (Drawing 5N129F05015)
- 1" line associated with and including isolation valves SI0170 and SI0202 (Drawing 5N129F05015)

Hardships Associated with Testing the Listed Components under Code Case N-498


- No means exists to measure the pressure to which these components are subjected during testing. Testing of these systems at elevated pressures would necessitate generation of a special test procedure because this test would place the plant in a lineup that has not been previously used or evaluated for use at the South Texas Project. Because there are no test connections between these valves, the test would involve opening the first manual isolation valve.
- Opening the first isolation valve would result in single-valve protection to the RCB atmosphere.
- Because the identified components are inside the bioshield, testing under the criteria of Code Case N-498 would result in additional radiation exposure to plant personnel.

Compensatory Factors

- The pressure boundary integrity of these components is validated and documented each refueling outage by a system leakage test.
- These components function to provide redundant protection. If the line downstream of the first isolation valve were to fail, the first isolation valve would still provide pressure boundary protection.

COMBINED LIST OF AFFECTED COMPONENTS


- 6"/8"SI1(2)108BB1 between XSI0009A and XSI0010A (High Head Safety Injection)
- 8"RH1(2)112BB1 between XRH0020A and 8"SI1(2)108BB1 (Residual Heat Removal)
- 6"SI1(2)111BB1 between XSI0007A and 10"RH1(2)108BB1 (High Head Safety Injection)
- 8"/10"RH1(2)108BB1 between XRH0032A, and 12"SI1(2)125BB1 (Residual Heat Removal System Train A)
- 6"/8"SI1(2)208BB1 between XSI0009B and XSI0010B (High Head Safety Injection)
- 8"RH1(2)212BB1 between XRH0020B and 8"SI1(2)208BB1 (Residual Heat Removal System)
- 6"SI1(2)211BB1 between XSI0007B and 10"RH1(2)208BB1 (High Head Safety Injection)
- 8"/10"RH1(2)208BB1 between XRH0032B and 12"SI1(2)218BB1 (Residual Heat Removal System Train B)
- 8"SI1(2)327BB1 between XSI0009C and XSI0010C (High Head Safety Injection)
- 8"RH1(2)315BB1 between XRH0020C and 8"SI1(2)327BB1 (Residual Heat Removal System)
- 6"SI1(2)308BB1 between XSI0007C and 10"RH1(2)308BB1 (High Head Safety Injection)
- 8"/10"RH1(2)308BB1 between XRH0032C and 12"SI1(2)315BB1 (Residual Heat Removal System Train C)
- 12"SI1(2)125BB1 between XSI0038A and XSI0046A (RCS Cold Leg Loop 1)
- 12"SI1(2)218BB1 between XSI0038B and XSI0046B (RCS Cold Leg Loop 2)
- 12"SI1(2)315BB1 between XSI0038C and XSI0046C (RCS Cold Leg Loop 3)
- 12"RH1(2)101BB1 between XRH0060A and XRH0061A (RCS Hot Leg Loop 1)
- 12"RH1(2)201BB1 between XRH0060B and XRH0061B (RCS Hot Leg Loop 2)
- 12"RH1(2)301BB1 between XRH0060C and XRH0061C (RCS Hot Leg Loop 3)
- 2"RC1(2)121BB1 between RC0057A and RC0058A (RCS Loop 1)
- 2"RC1(2)220BB1 between RC0057B and RC0058B (RCS Loop 2)
- 2"RC1(2)321BB1 between RC0057C and RC0058C (RCS Loop 3)
- 2"RC1(2)418BB1 between RC0057D and RC0058D (RCS Loop 4)
- ¾" line associated with and including isolation valves RC0123 and RC0152
- ¾" RC1(2)122BB1 and RC0200
- ¾" line associated with and including isolation valves RC0128 and RC0146
- ¾" line associated with and including isolation valves RC0129 and RC0142
- 1" line associated with and including isolation valves HV3657A and HV3658A
- 1" line associated with and including isolation valves HV3657B and HV3658B
- 1" line associated with and including isolation valves SI0168 and SI0203
- 1" line associated with and including isolation valves SI0170 and SI0202

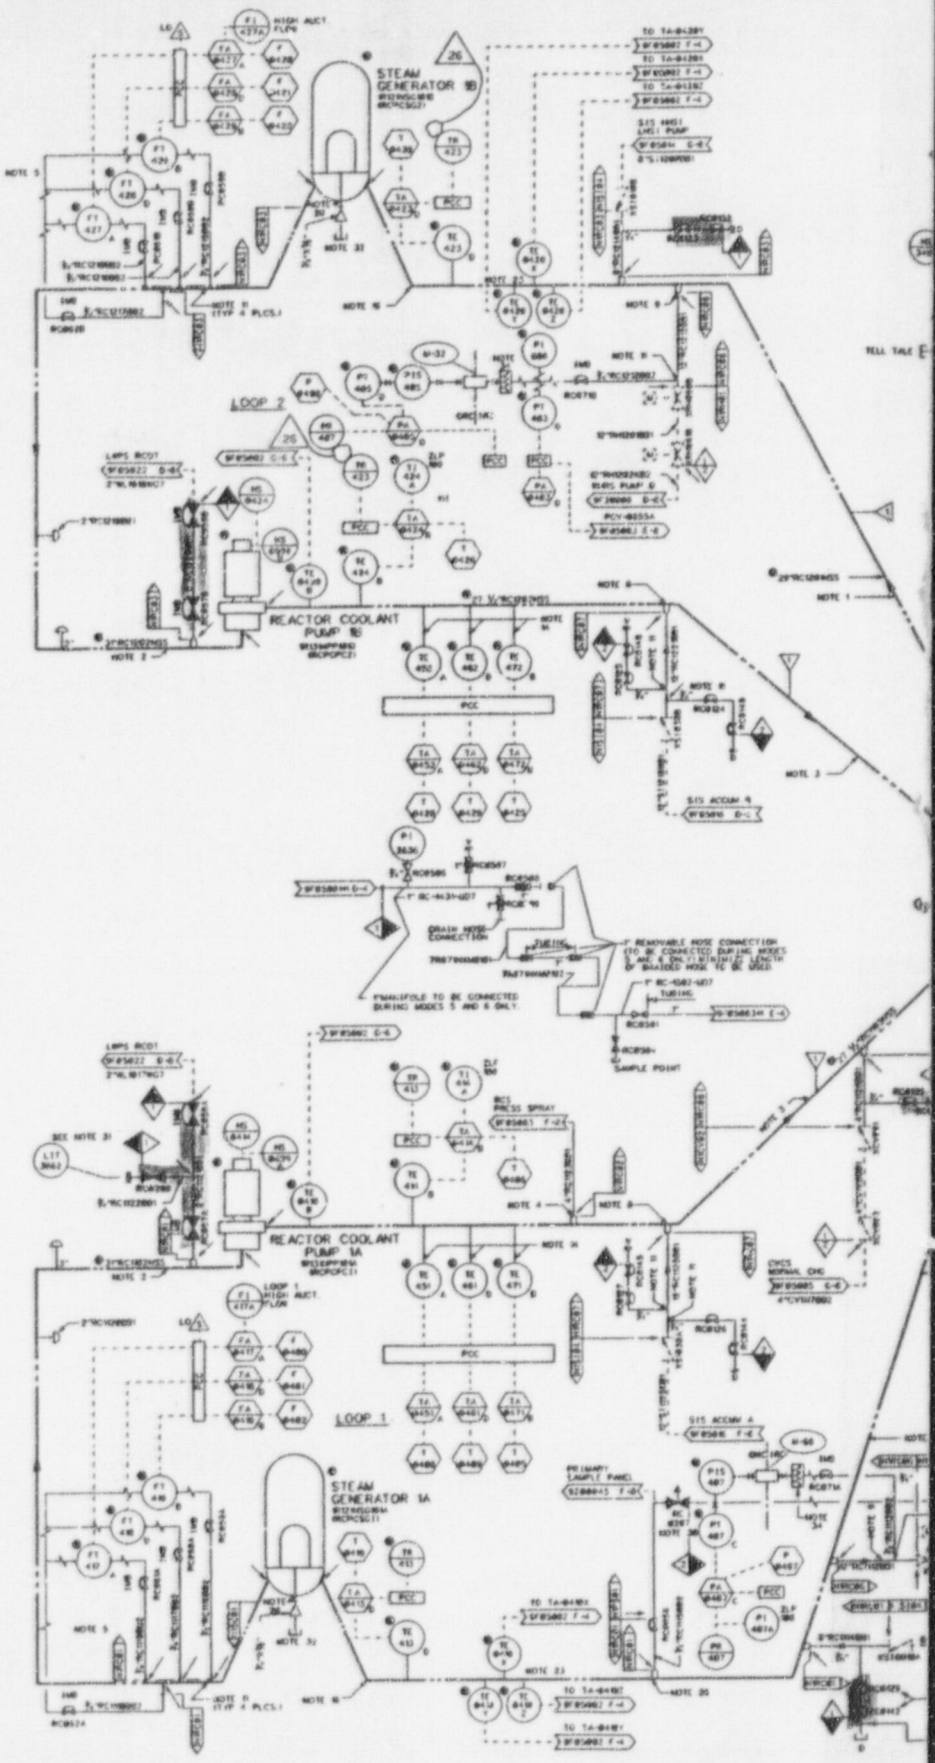

NO.	DATE	REVISION	BY	CHK	RE	DV	MA	SC	PE	NO.	ISSUE DATE
20	1-27-59	ENCLAMP DCH 988788									
21	6-30-59	ENCLAMP DCH 9914275A									
24	1-29-60	ENCLAMP DCH CORRECTION									
25	6-29-61	ISSUED FOR CONSTRUCTION									

8 | 7 | 6
 D | C | B

APERTURE CARD
Also Available on Aperture Card

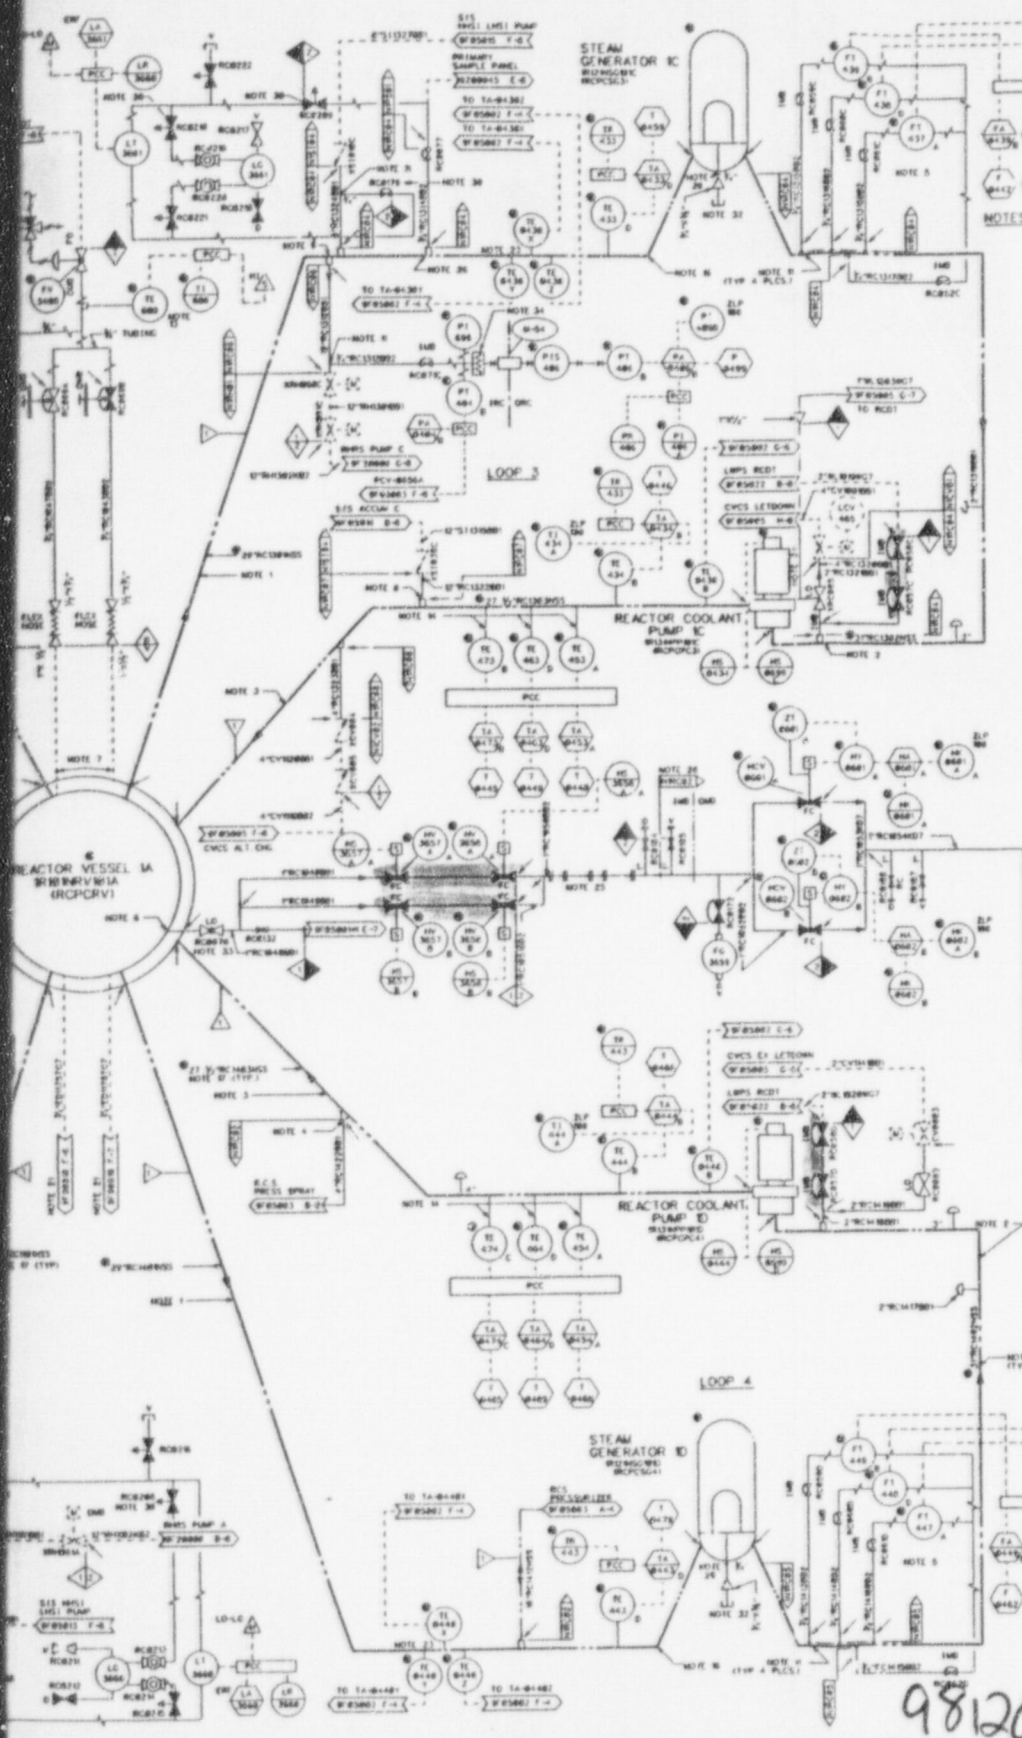

- NOTES:**
- 1 2" INSIDE DIAMETER
 - 2 1 1/2" INSIDE DIAMETER
 - 3 1" INSIDE DIAMETER
 - 4 SPRAY LINE SCOOP
 - 5 LOOP FLOW METER
 - 6 VENT PIPES FURNISHED WITH REACTOR VESSEL HEAD
 - 7 HEAD GASKET MONITORING CONNECTIONS FURNISHED WITH REACTOR VESSEL. THE P-TRIMMER IS CONNECTED TO THE OUTER MONITOR TUBE.
 - 8 INCLUDE MONITORING TUBES
 - 9 LOCATE CONNECTION IN BOTTOM HALF OF REACTOR COOLANT PUMP IN 90 DEGREE ANGLE TO VERTICAL.
 - 10 LOOP IDENTIFICATION AS SHOWN
 - 11 PROVIDE AS IS TO LOW REACTOR PER ENG SPECIFIC FOR REACTOR FROM SC TO SC
 - 12 A BOND PLATE IS TO BE USED FOR ALL MODES OF OPERATION EXCEPT FOR OUTAGES WHEN THE REACTOR COOLANT SYSTEM HAS BEEN BRANDED BELOW THE STEAM GENERATOR MODULES REFER TO THE INSTRUMENTATION DRAWINGS FOR DETAILS OF THE HARDWARE WHICH ALLOWS THE USE OF TYPING MACHINE TO DRAIN THE BOTTOM OF THE STEAM GENERATOR CHIMNEY.
 - 13 STRAP-ON SURFACE MOUNTED RTD LOCATED AT BOTTOM OF PIPE.
 - 14 FAST RESPONSE WIDE RANGE TEMPERATURE DETECTORS LOCATED IN SAME VERTICAL PLANE ON BONES APART.
 - 15 REFER TO DRAWING 243700001 AND 243700002 FOR IDENTIFICATION NUMBER DETAILS
 - 16 FURNISHED BY WESTINGHOUSE
 - 17 INSTRUMENTATION SHOWN ON THIS PFD HAVE SYSTEM DESIGNATOR RC
 - 18 ALL INSTRUMENTS SHOWN ON THIS PFD HAVE SEPARATION GROUP UNLESS OTHERWISE NOTED
 - 19 STEAM GENERATOR IS FURNISHED WITH 1/2" FLOW REACTOR FOR TRANSITION FROM SC TO SC
 - 20 PIPING PROVIDED BY REC TO COLLECT DRAINAGE FROM THE REACTOR VESSEL. FLOW DRAIN MAINLINE DRAIN PIPE LOCATED AT THE INLET TO AIR-LIFT ONLY DRAIN BRANDED WHICH COLLECTS DRAINAGE FROM 3/4" COOLANT LINE ASSEMBLIES IS FURNISHED BY WESTINGHOUSE BELLEVILLE
 - 21 FAST RESPONSE WIDE RANGE TEMPERATURE DETECTORS FOR REACTOR CONTROL AND PROTECTION SYSTEM. SEE INSTRUMENT DETAIL FOR ACTUAL PHYSICAL LAYOUT
 - 22 VALVE STEEL LEAKOFF LINES ARE TO BE SLOPED DOWNWARD AND SHALL NOT BE SHARP 90 DEGREE
 - 23 PROVIDE SPIN PIECE ON EACH SIDE OF CABLE BRIDGE FOR TRANSITION FROM SC TO SC
 - 24 THE PROVISION OF A BOND PLATE IN THE 9000 EDITION (SEE ADDENDUM OF BOND CODE SECTION 11) IS A REQUIREMENT OF INTENT OF THE PROVISIONS OF 90-0211 OF THE 9000 EDITION. THE USE OF A BOND PLATE IN THE 9000 EDITION IS NOT PERMITTED AS PERMITTED UNDER PARAGRAPH 90-0448
 - 25 FROM THE FIRST APPROX BEYOND THE RETAINING BRIDGE
 - 26 THE REACTOR HEAD VENT LINE IS TO BE TESTED ONLY WHEN THE FOLLOWING CONDITION EXIST:
 - a. PRESSURE IS AT OR BELOW 900 PSIG
 - b. TEMPERATURE IS AT OR BELOW 250 F
 - 27 DURING A MODES OF OPERATION (EXCEPT MID-LOOP OPERATION) THE LEAK GAUGE AND MANIFOLD SHALL BE ISOLATED AT VALVES RC024, RC025, RC026, RC027, RC028, RC029 & RC030
 - 28 THIS CONNECTION IS TO BE USED DURING MID-LOOP OPERATION FOR LEVEL INDICATOR LIT-046 REFER TO INSTRUMENTATION ENG DRAWING SH-13 FOR INSTALLATION DETAIL. DURING NORMAL OPERATION, LINE TO BE CAPPED OFF.
 - 29 THIS CHANGE IS TO REFLECT THE AS-BUILT CONDITION PER THE PARTIAL DISPOSITION OF 90-0448
 - 30 VALVE TO BE LOCKED OPEN DURING MODES L2, 4 & 4
 - 31 DISCHARGE ISOLATOR SUPPLIED AS PART OF PIS-485, PIS-486 & PIS-487

- REFERENCES:**
- 1 FOR PIPING & INSTRUMENT SYMBOLS SEE ENG 900001 & 900002
 - 2 WESTINGHOUSE ENG NO. D478-504 & SH-1 OF 3. REC NO. 1076-02040000-001

9812070099-01

HOUSTON LIGHTING & POWER COMPANY
SOUTH TEXAS PROJECT ELECTRIC GENERATING STATION

PIPING AND INSTRUMENTATION DIAGRAM
RCS PRIMARY COOLANT LOOP


REVISION	BY	CHKD	RE	DATE	SCALE	REV
5						
4						
3						
2						
1						

SCALE	DOC NO	REV
NONE	5714 OF 95001 RI	26

30:1


DATE: 11/19/76
BY: G. B. B. / J. B. B.

PRIORITY: NO. 124789/28

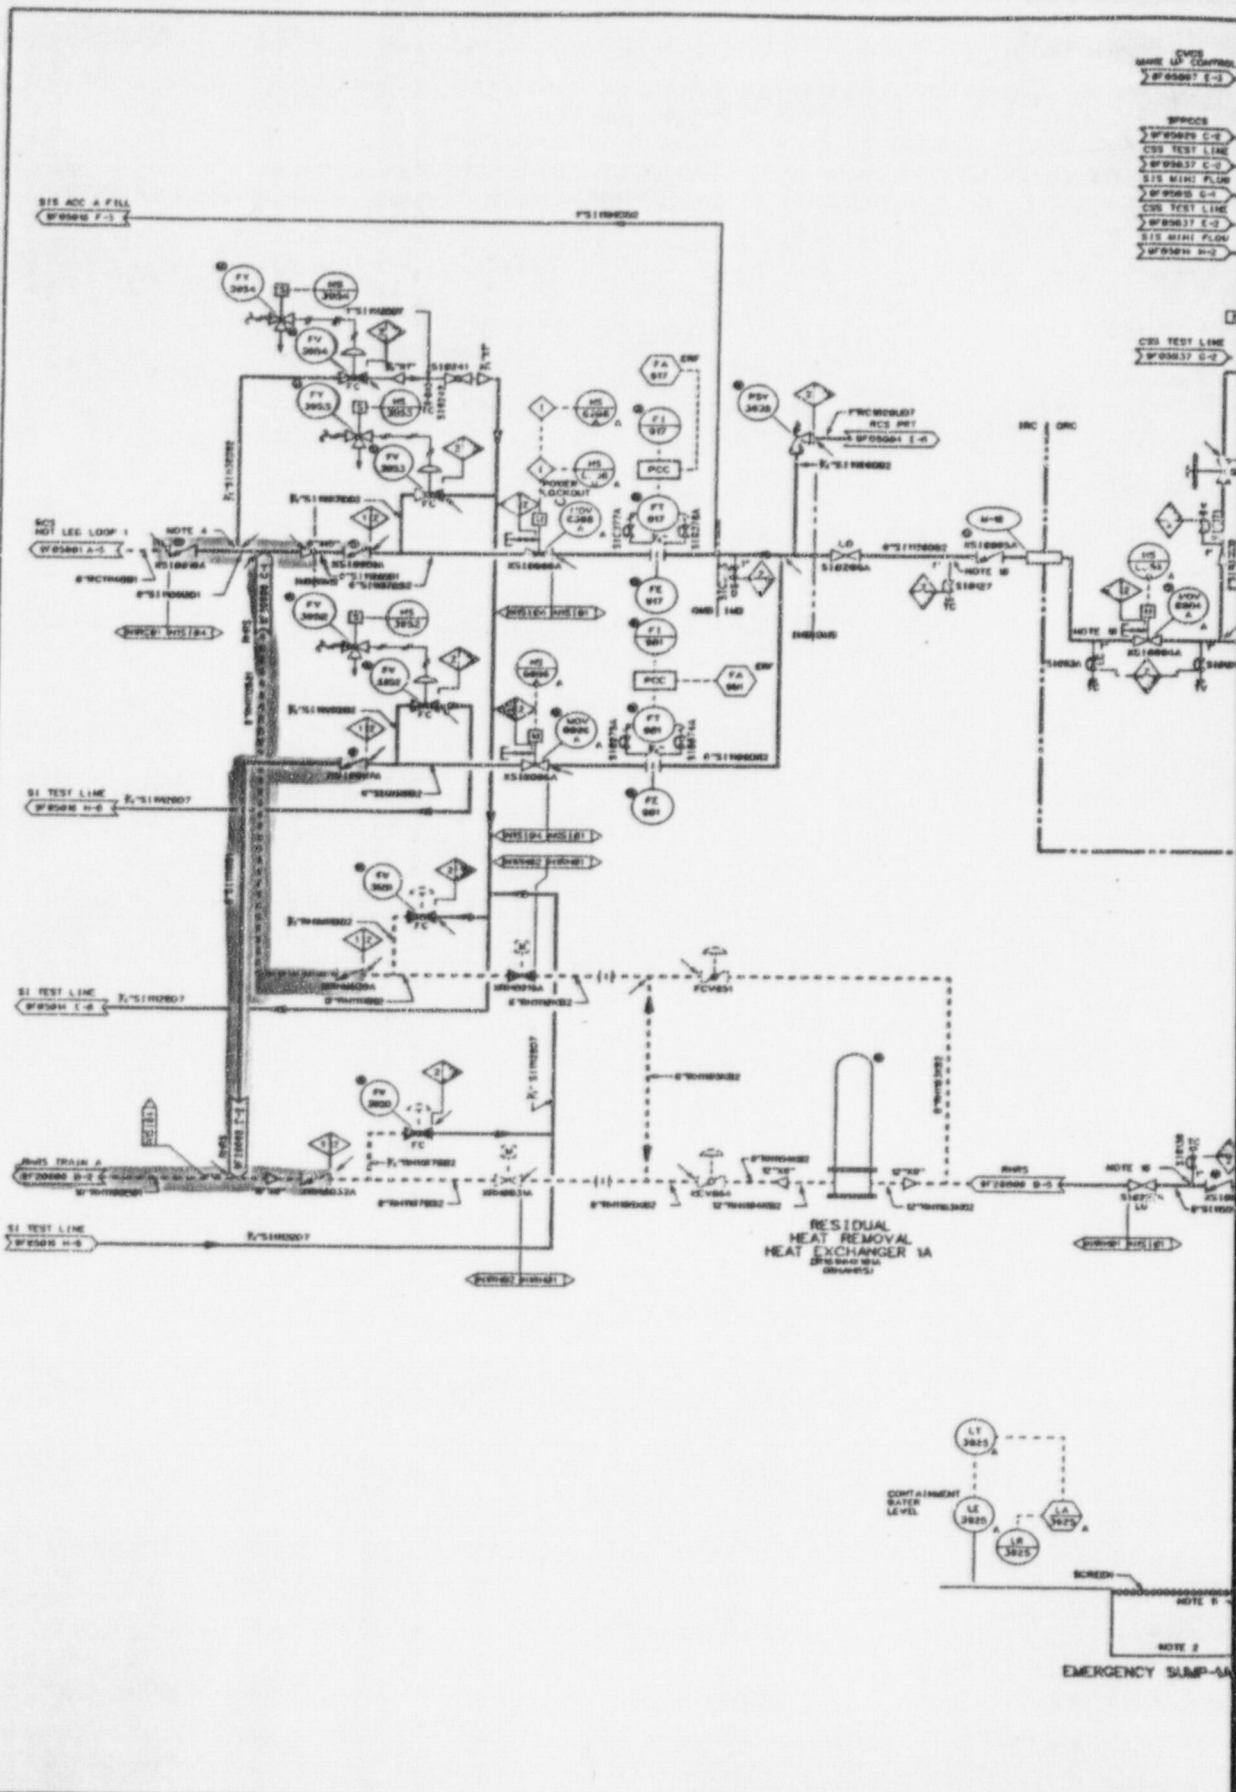

NO.	ISSUE DATE	REVISION	ORIG	CHK	RE	BY	SE	NO.	ISSUE DATE
21	9-2-57	INCOMP DCN 9881754							
20	8-2-57	ISSUED FOR CONSTRUCTION							

VAM STONEMAN ON FILE
 EMERGENCY SLUMP-A
 NOTE 1
 NOTE 2

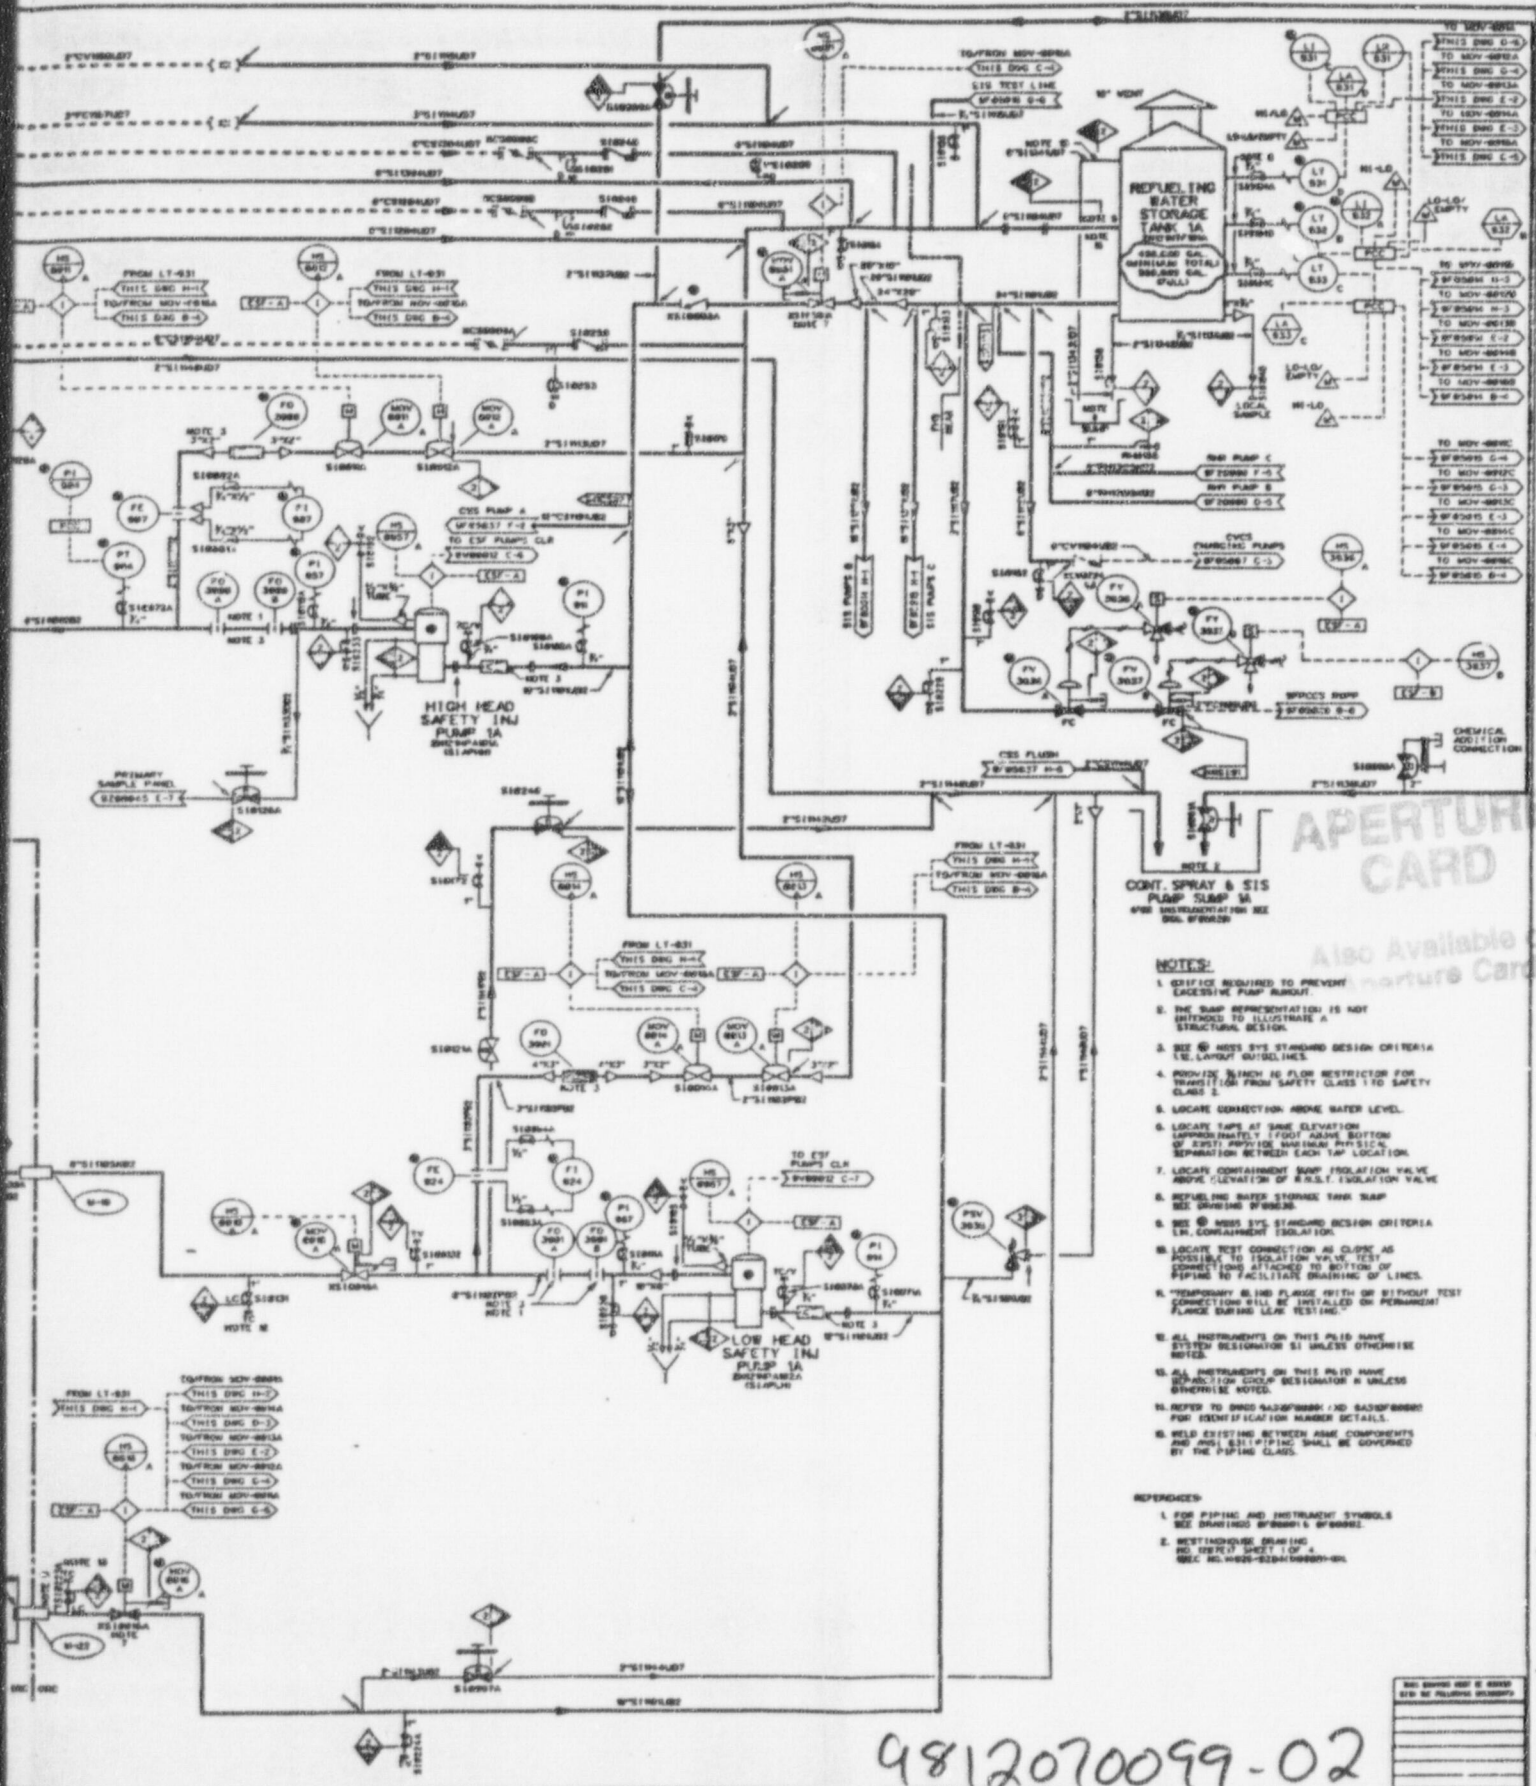

APERTURE CARD
Also Available on Aperture Card

- NOTES:**
1. INSTRUMENTS REQUIRED TO PREVENT EXCESSIVE PUMP RUNOUT.
 2. THE PUMP REPRESENTATION IS NOT INTENDED TO ILLUSTRATE A STRUCTURAL DESIGN.
 3. SEE 8000 2% STANDING DESIGN CRITERIA FOR LATEST OUTLET LINES.
 4. PROVIDE 1/2" IN FLOW RESTRICTOR FOR TRANSITION FROM SAFETY CLASS 1 TO SAFETY CLASS 2.
 5. LOCATE CONNECTION ABOVE WATER LEVEL.
 6. LOCATE TAPS AT SAME ELEVATION (APPROXIMATELY 1 FOOT ABOVE BOTTOM OF EXIST) PROVIDE MAXIMUM PHYSICAL SEPARATION BETWEEN EACH TAP LOCATION.
 7. LOCATE CONTAINMENT SUMP ISOLATION VALVE ABOVE ELEVATION OF H.H.S.I. ISOLATION VALVE.
 8. REFUELING WATER STORAGE TANK SUMP SEE DRAWING 8000-1.
 9. SEE 8000 2% STANDING DESIGN CRITERIA FOR CONTAINMENT ISOLATION.
 10. LOCATE TEST CONNECTION AS CLOSE AS POSSIBLE TO ISOLATION VALVE. TEST CONNECTIONS ATTACHED TO BOTTOM OF PIPING TO FACILITATE DRAINING OF LINES.
 11. TEMPORARY BLIND FLANGE WITH OR WITHOUT TEST CONNECTIONS WILL BE INSTALLED ON PERMANENT FLANGE DURING LEAK TESTING.
 12. ALL INSTRUMENTS ON THIS PLOT HAVE SYSTEM DESIGNATOR 51 UNLESS OTHERWISE NOTED.
 13. ALL INSTRUMENTS ON THIS PLOT HAVE IDENTIFICATION GROUP DESIGNATOR 4 UNLESS OTHERWISE NOTED.
 14. REFER TO 8000 2% STANDING DESIGN CRITERIA FOR IDENTIFICATION NUMBER DETAILS.
 15. WELD EXISTING BETWEEN ANNE COMPONENTS AND FIELD ASSEMBLY SHALL BE GOVERNED BY THE PIPING CLASS.

- REFERENCES:**
1. FOR PIPING AND INSTRUMENT SYMBOLS SEE DRAWING 8000-1 & 8000-2.
 2. WELDING SYMBOLS AND FIELD ASSEMBLY FOR 8000 2% STANDING DESIGN CRITERIA.


9812070099-02

**SOUTH TEXAS PROJECT
NUCLEAR OPERATING COMPANY**

PIPING & INSTRUMENTATION DIAGRAM
SAFETY INJECTION SYSTEM

REVISION	DATE	BY	CHK	REV	PRIORITY	ANWEXN. NO.	DOC. CR. NO.	CADD FILE NO.	SCALE	ENC. NO.	REV.
					1	512070099-02	DE7922	F.A.07.21	NONE	5N129F05013#1	21




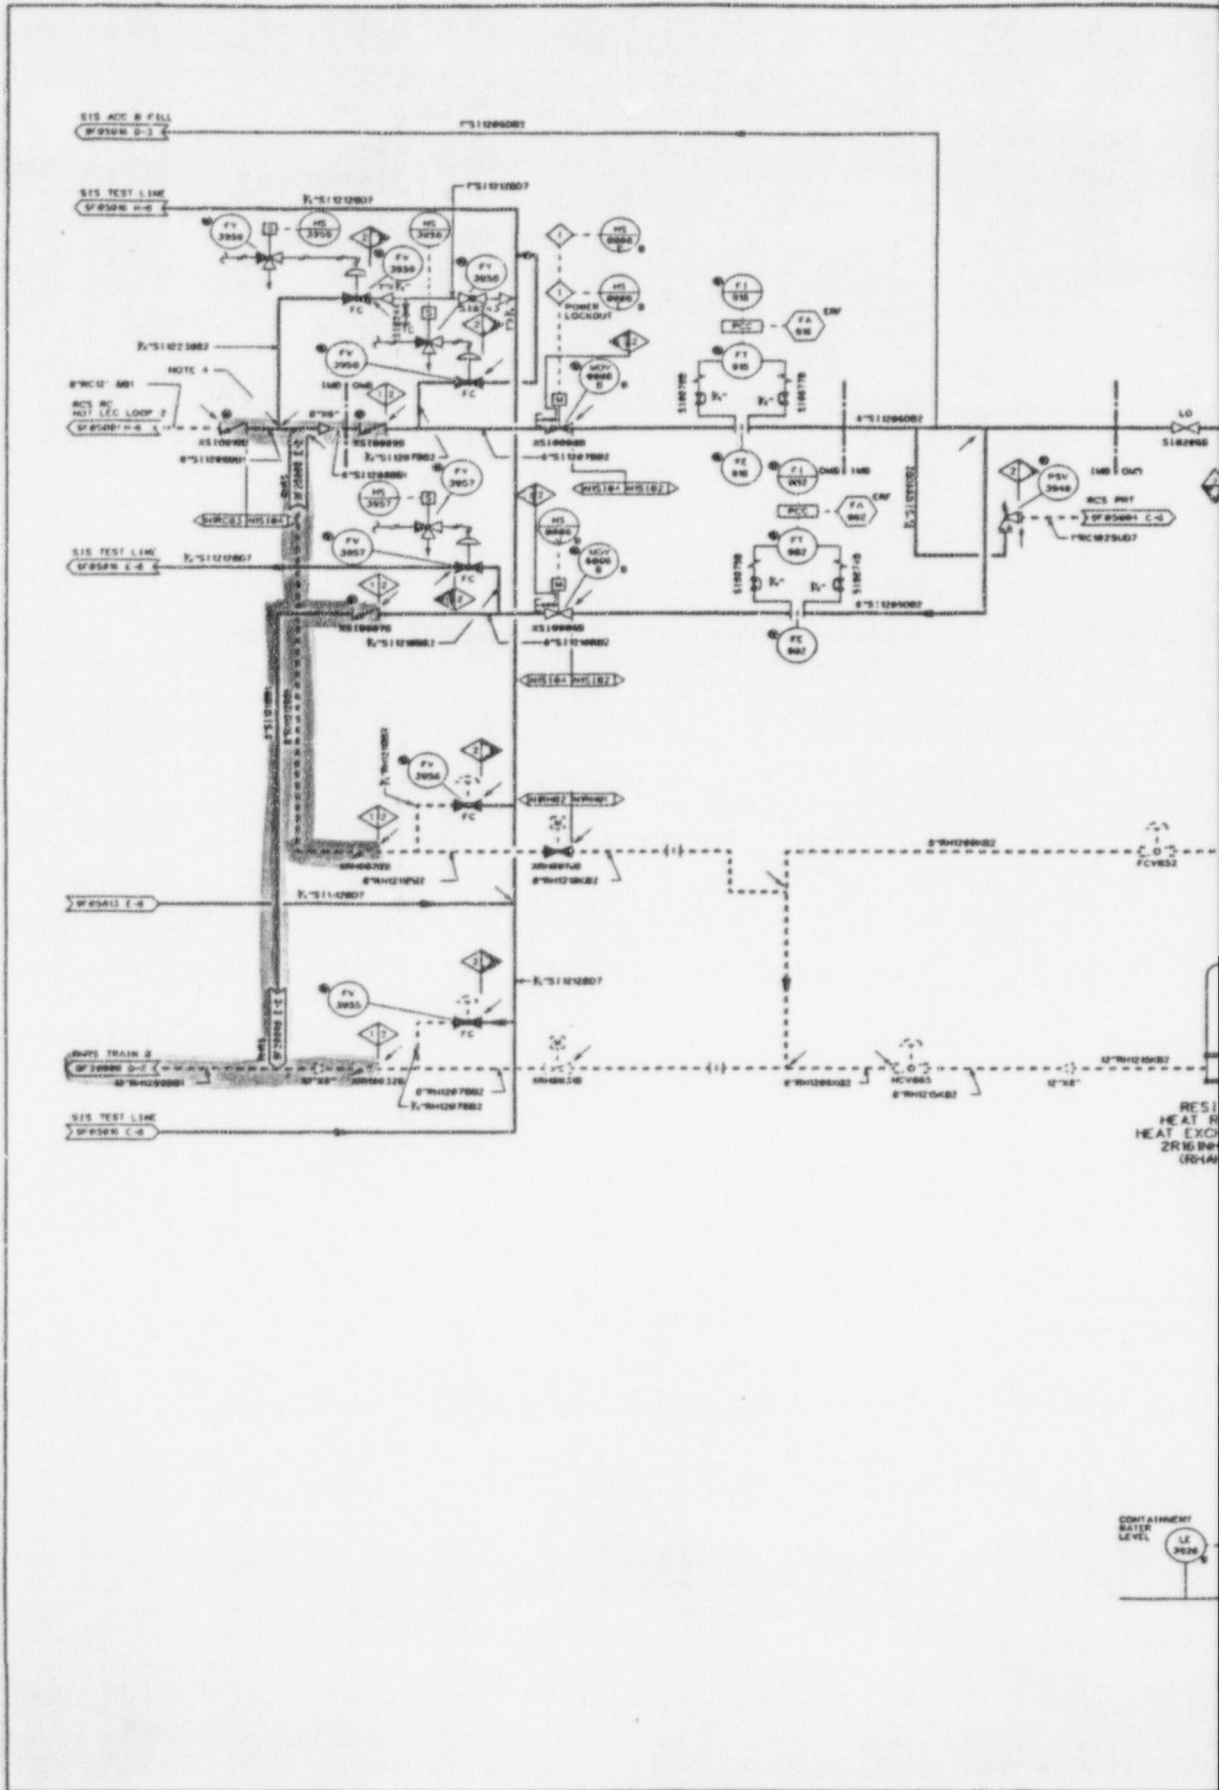

NO.	ISSUE DATE	REVISION	BY	CHK	RE	DY	NA	SE	PE	NO.	ISSUE DATE	REVISED
13	10-11-81	INCCORP DCN 98B3454										
12	9-24-81	INCCORP DCN MD-2774										
11	11-2-80	HL&P ASSUMES DESIGN CHANGE CONTROL INCCORP EGN 88C883C										
10	2-4-81	ISSUED FOR CONSTRUCTION										

CONTAINMENT
WATER
LEVEL
LL
3036

SP 100 80/20
I certify that the design provided
has been prepared and signed in accordance
with the rules and regulations of the
Professional Engineering Board of the
State of Maryland.

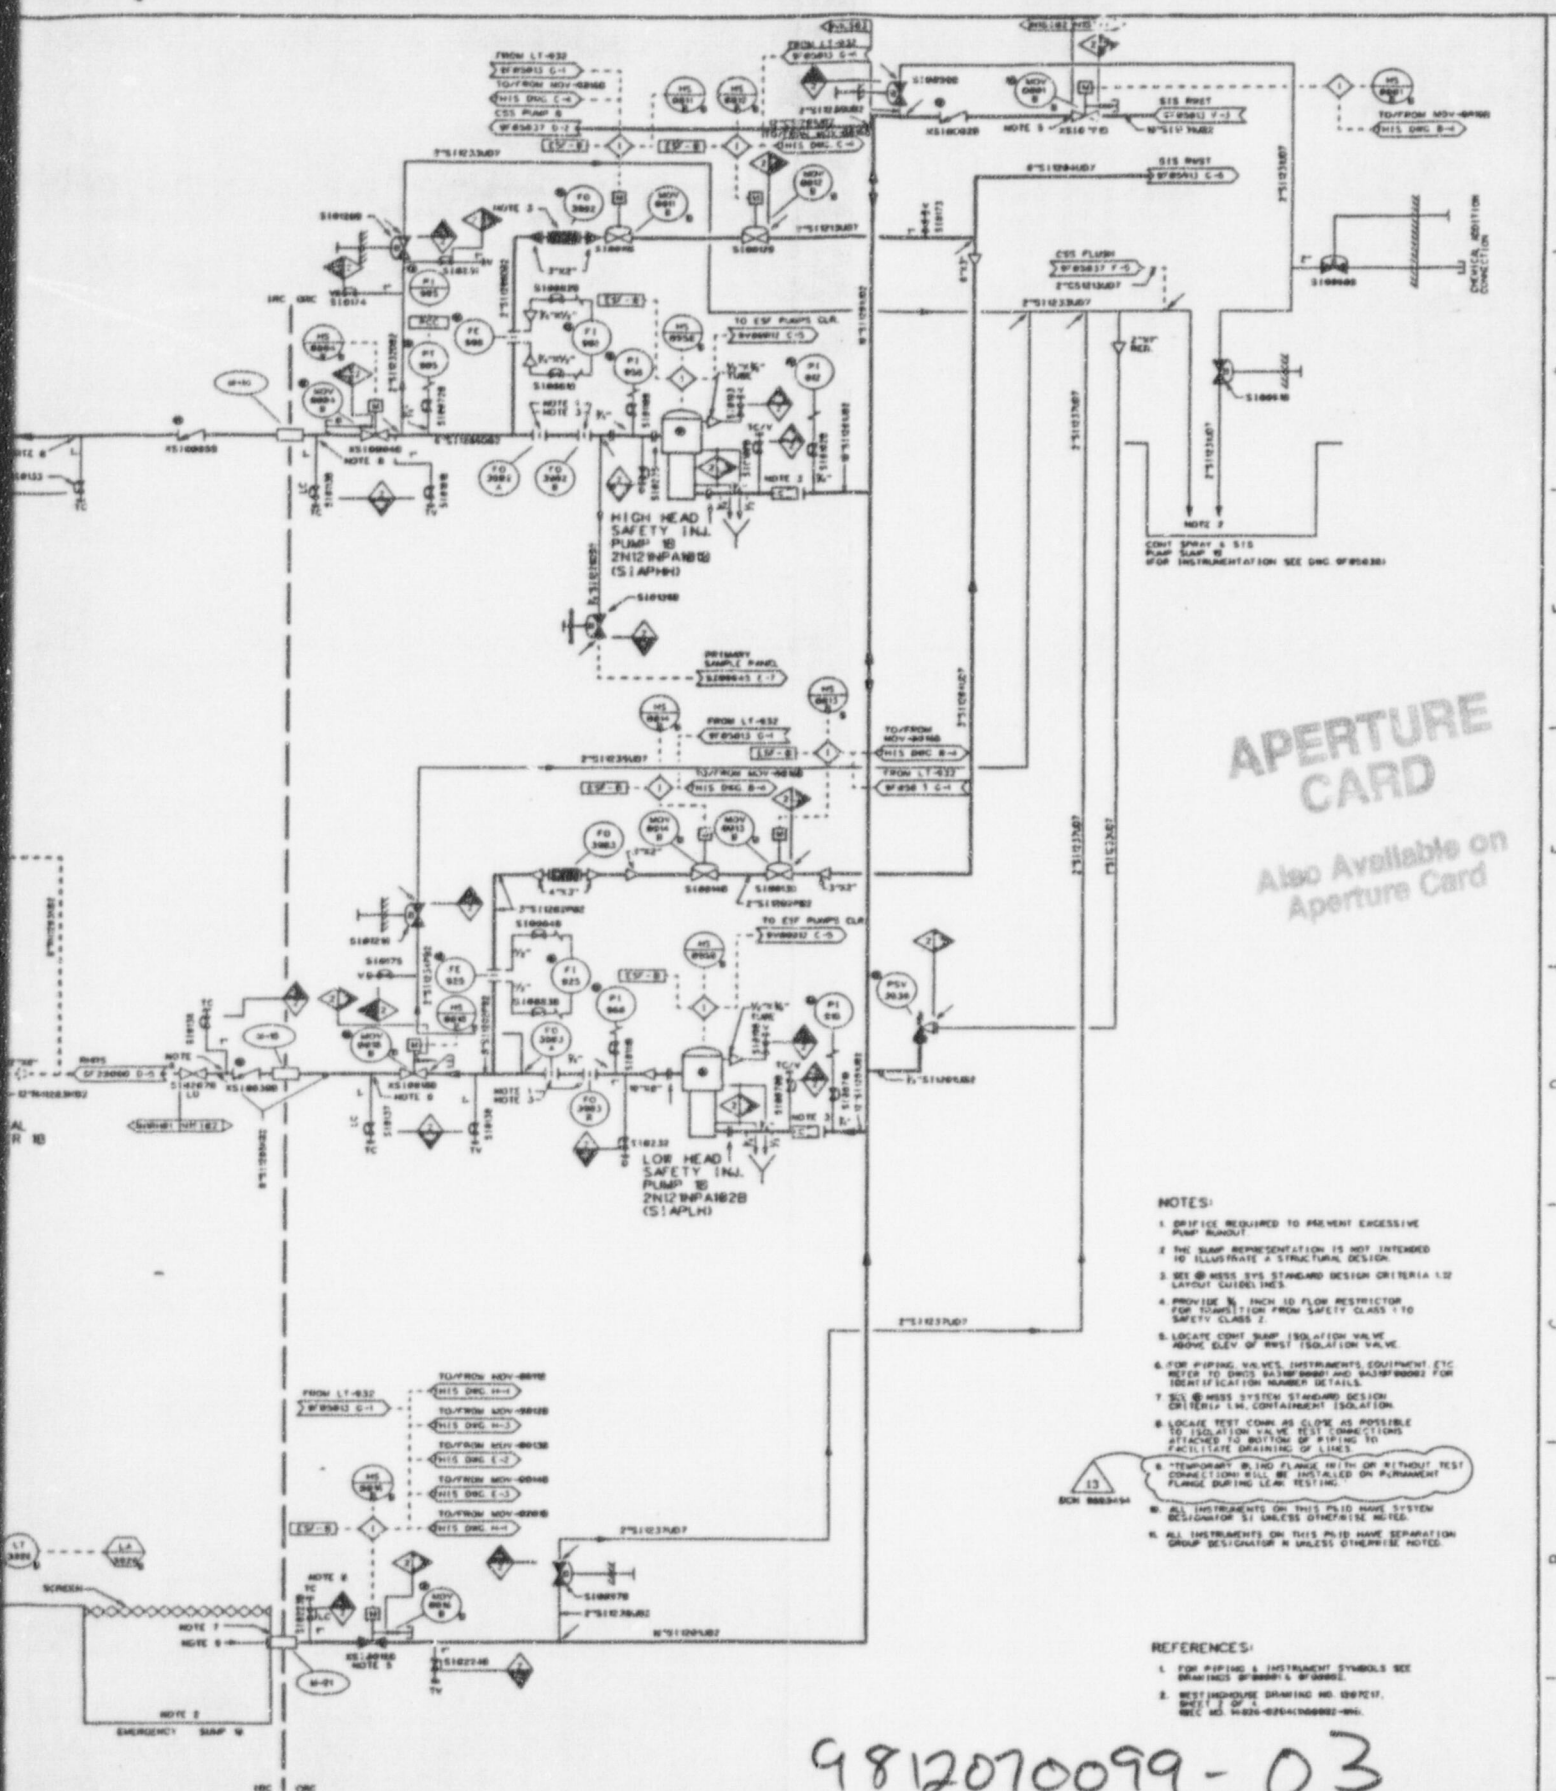

APERTURE CARD
 Also Available on Aperture Card

- NOTES:**
1. DRIFICE REQUIRED TO PREVENT EXCESSIVE PUMP RUNOUT.
 2. THE SHARP REPRESENTATION IS NOT INTENDED TO ILLUSTRATE A STRUCTURAL DESIGN.
 3. SEE @MESS SYS STANDARD DESIGN CRITERIA L12 LAYOUT GUIDELINES.
 4. PROVIDE 1/2 INCH ID FLOW RESTRICTOR FOR ISOLATION FROM SAFETY CLASS 1 TO SAFETY CLASS 2.
 5. LOCATE CONT SHUT ISOLATION VALVE ABOVE ELEV OF RWST ISOLATION VALVE.
 6. FOR PIPING VALVES, INSTRUMENTS, EQUIPMENT, ETC REFER TO DMSO DRAWINGS AND SWSR#0002 FOR IDENTIFICATION NUMBER DETAILS.
 7. SEE @MESS SYSTEM STANDARD DESIGN CRITERIA L14, CONTAINMENT ISOLATION.
 8. LOCATE TEST COUPLER AS CLOSE AS POSSIBLE TO ISOLATION VALVE TEST CONNECTIONS ATTACHED TO BOTTOM OF PIPING TO FACILITATE DRAINING OF LINES.
 9. TEMPORARY DRIND FLANGE WITH OR WITHOUT TEST CONNECTIONS WILL BE INSTALLED ON PERMANENT FLANGE DURING LEAK TESTING.
 10. ALL INSTRUMENTS ON THIS P&ID HAVE SYSTEM DESIGNATOR S1 UNLESS OTHERWISE NOTED.
 11. ALL INSTRUMENTS ON THIS P&ID HAVE SEPARATION GROUP DESIGNATOR N UNLESS OTHERWISE NOTED.

- REFERENCES:**
1. FOR PIPING & INSTRUMENT SYMBOLS SEE DRAWINGS SWSR#0001 & SWSR#0002.
 2. BEST AVAILABLE DRAWING NO. 800701, SHEET 2 OF 4, REC NO. 4-825-02(100000)-000.

9812070099-03

HOUSTON LIGHTING & POWER COMPANY
 SOUTH TEXAS PROJECT ELECTRIC GENERATING STATION


PIPING AND INSTRUMENTATION DIAGRAM
 SAFETY INJECTION SYSTEM

SCALE	DRG. NO.	REV.
NONE	5N129F05014 #1	13


BY	CHK	RE	DV	NA	SE	PE

30.1

PRIORITY 0070928 FJA158.131

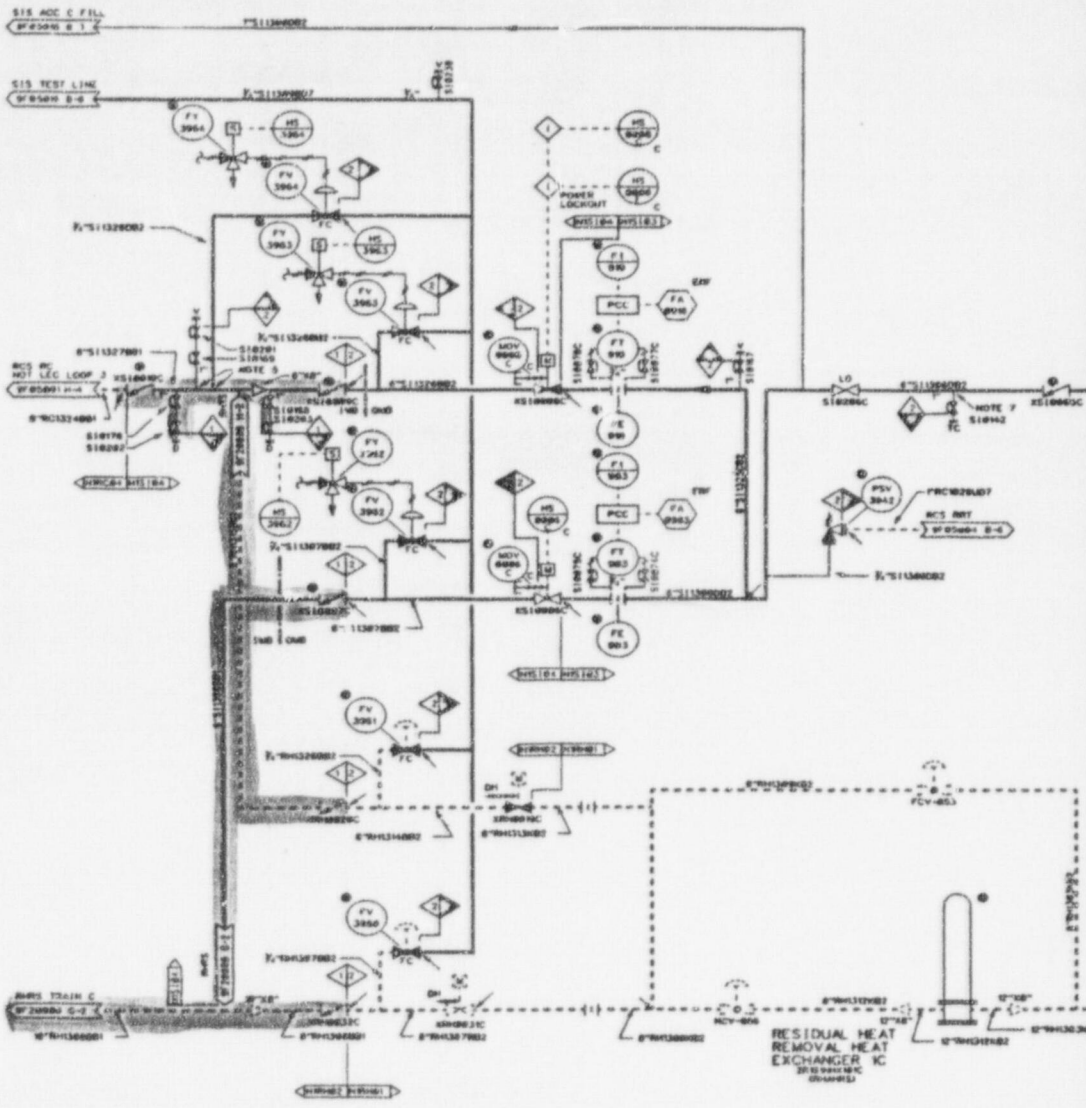

NO.	ISSUE DATE	REVISION	BY	CHK	RE	DV	NA	SE	PC	NO.	ISSUE DATE
11	11-14-71	INCORP DCN 0003464									
12	5-23-73	INCORP DCN 00-0774									
13	3-9-76	INC DCN 00-064									
14	8-23-78	INCORPORATED DCN 00-1003A									
15	09-27-88	NSP ASSUMES DESIGN CHANGE CONTROL AND INCORP HCP'S 00-1003A & 00-1003B									
16	07-24-83	ISSUED FOR CONSTRUCTION									

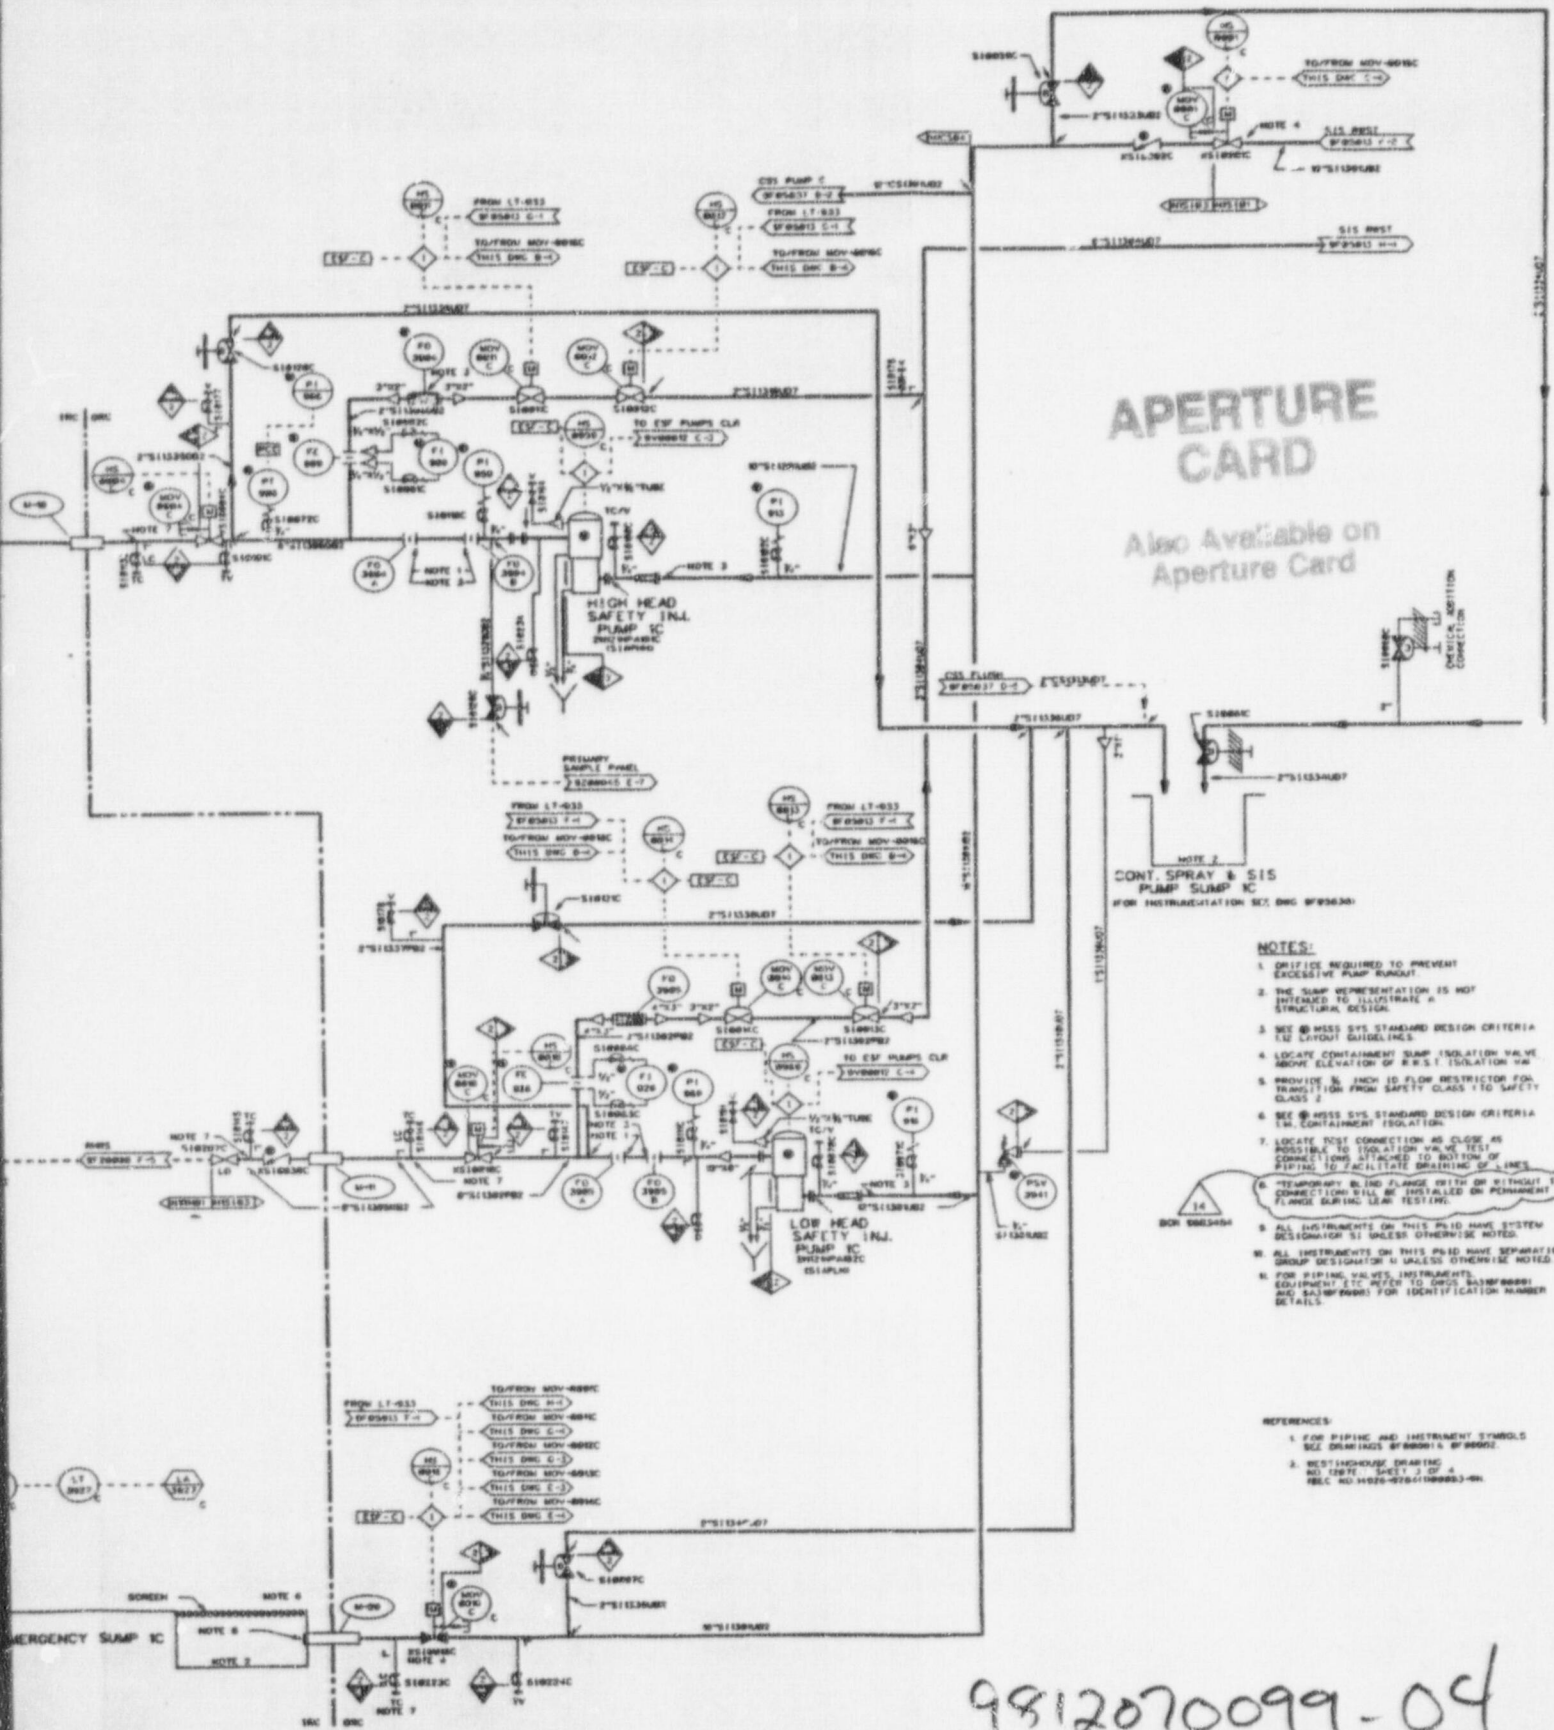

APERTURE CARD
 Also Available on Aperture Card

- NOTES:**
1. DRIFTS REQUIRED TO PREVENT EXCESSIVE PUMP RUNOUT
 2. THE SLUMP REPRESENTATION IS NOT INTENDED TO ILLUSTRATE A STRUCTURAL DESIGN
 3. SEE MISS SYS STANDARD DESIGN CRITERIA LAYOUT GUIDELINES
 4. LOCATE CONTAINMENT SLUMP ISOLATION VALVE ABOVE ELEVATION OF R.R.T. ISOLATION VM
 5. PROVIDE 8 INCH ID FLOW RESTRICTOR FOR ISOLATION FROM SAFETY CLASS 1 TO SAFETY CLASS 2
 6. SEE MISS SYS STANDARD DESIGN CRITERIA FOR CONTAINMENT ISOLATION
 7. LOCATE POST CONNECTION AS CLOSE AS POSSIBLE TO ISOLATION VALVE TEST CONNECTIONS ATTACHED TO BOTTOM OF PIPING TO FACILITATE DRAINING OF LINES
 8. *TEMPORARY BLEND FLANGE WITH OR WITHOUT TEST CONNECTION WILL BE INSTALLED ON PERMANENT FLANGE DURING LEAK TESTING
 9. ALL INSTRUMENTS ON THIS PID HAVE SYSTEM DESIGNATOR SI UNLESS OTHERWISE NOTED
 10. ALL INSTRUMENTS ON THIS PID HAVE SEPARATION GROUP DESIGNATOR U UNLESS OTHERWISE NOTED
 11. FOR PIPING VALVES, INSTRUMENTS, EQUIPMENT, ETC REFER TO DWS 8435880001 AND 8435880002 FOR IDENTIFICATION NUMBER DETAILS

- REFERENCES:**
1. FOR PIPING AND INSTRUMENT SYMBOLS SEE DRAWINGS 8435880001 & 8435880002
 2. BEST AVAILABLE DRAWING NO 12071, SHEET 2 OF 4, IELC NO 1422-925-1100003-04

9812070099-04


HOUSTON LIGHTING & POWER COMPANY
 SOUTH TEXAS PROJECT ELECTRIC GENERATING STATION

PIPING AND INSTRUMENTATION DIAGRAM SAFETY INJECTION SYSTEM		
SCALE	DWG. NO.	REV.
NONE	5N129F05015 #1	14
PRIORITY	087826	FJ155.141

REVISION


5	4	3	2	1
BY	CHK	REV	BY	DATE

30-1

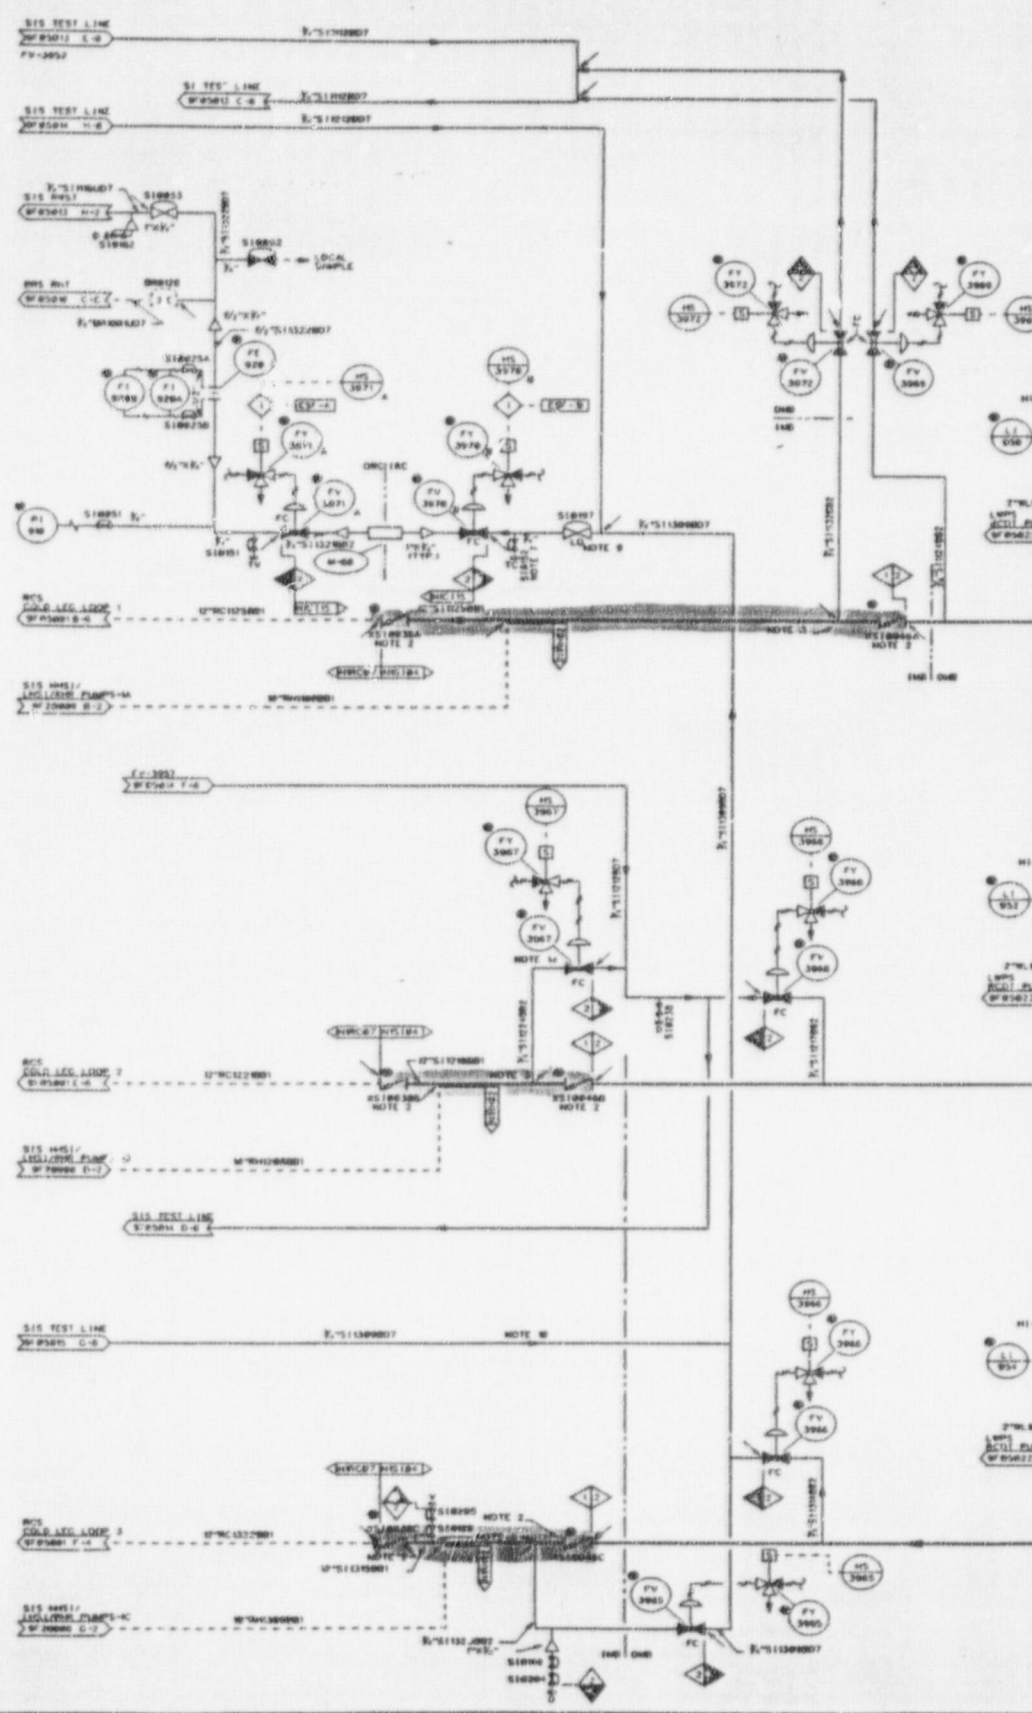

NO.	DATE	REVISION	BY	CHK	RE	DV	NA	SE	PL	NO.	ISSUE DATE
1	20/01/83	REVISED CONTINUATION AND EDITORIAL									
2	8-24-83	INCORP BCH MD-2774									
3	9-14-83	MAP ASSUMES DESIGN CHANGE CONTROL & INC BCH MD-1986									
4	10/24/83	ISSUE FOR CONSTRUCTION									

BY: [Signature]
 CHK: [Signature]
 RE: [Signature]
 DV: [Signature]
 NA: [Signature]
 SE: [Signature]
 PL: [Signature]
 NO: [Signature]
 ISSUE DATE: [Signature]

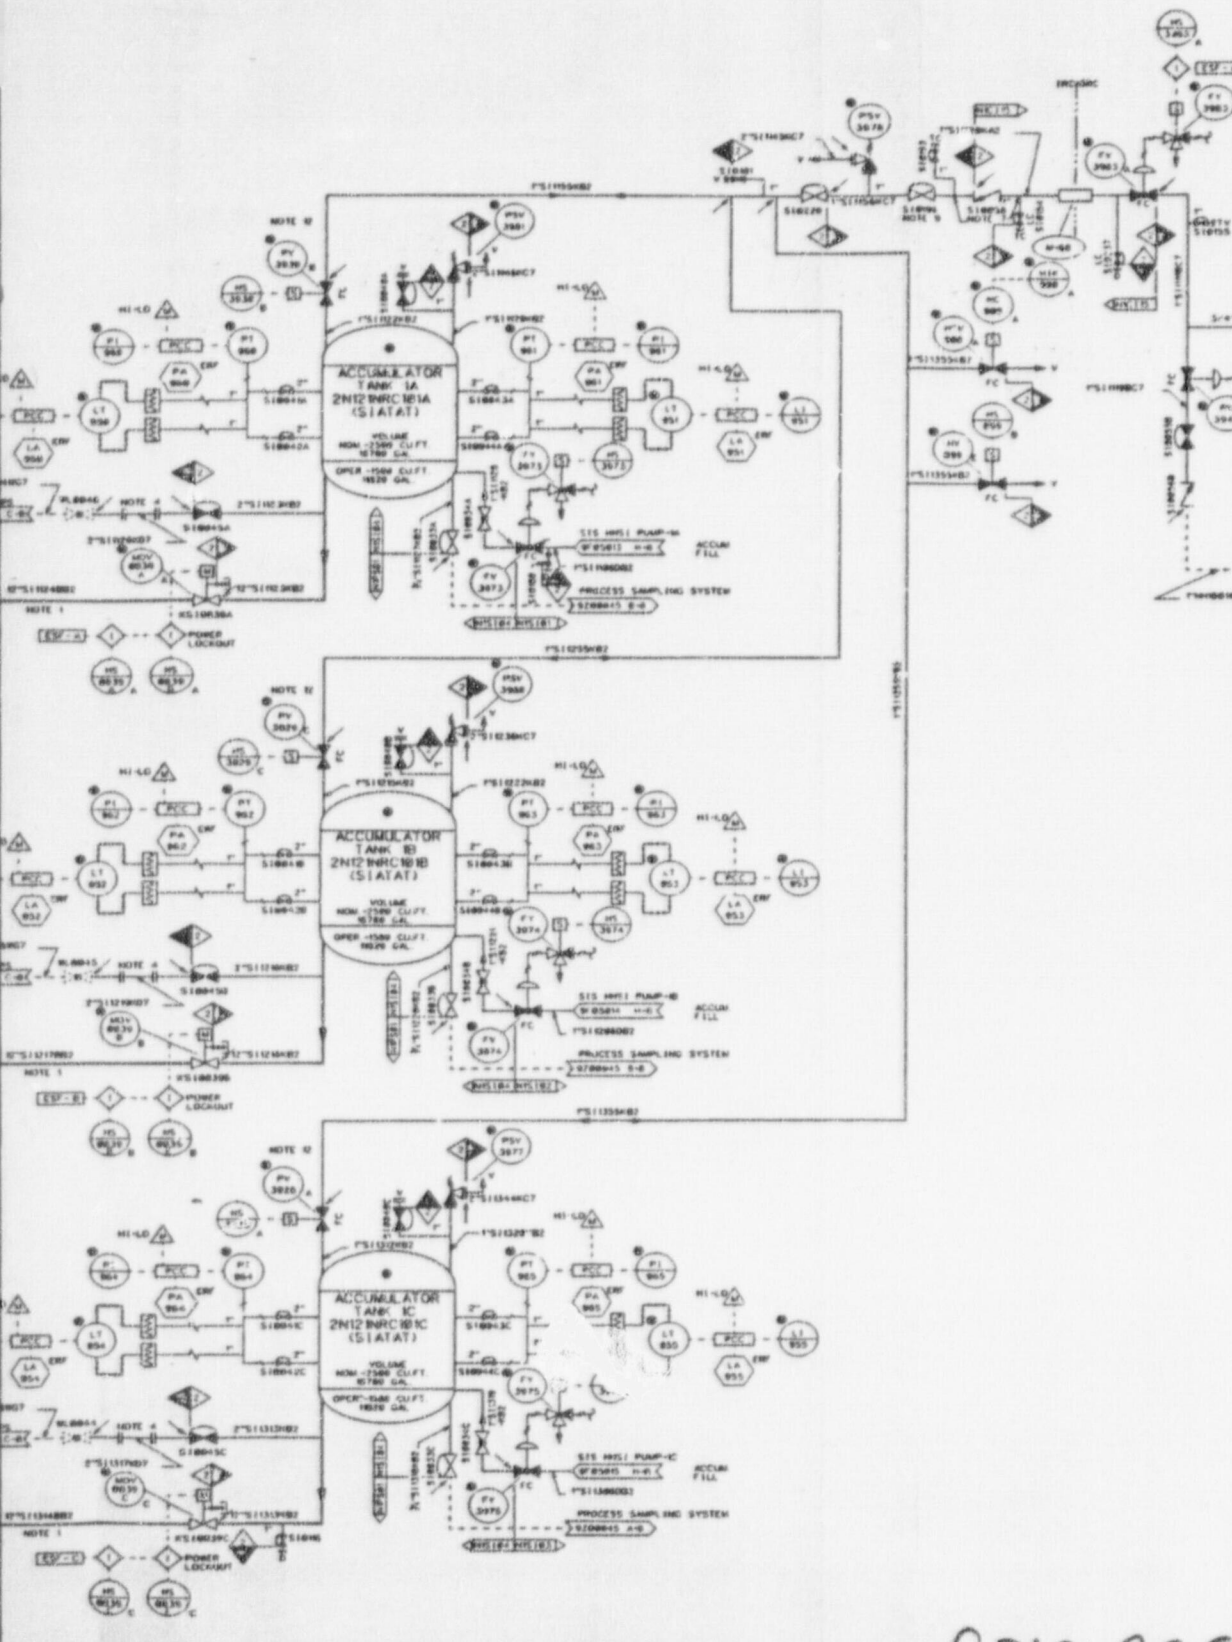

APERTURE CARD
 Also Available on Aperture Card

- NOTES:**
1. PIPING SCHEDULE MS MUST BE USED TO MEET SAFETY ANALYSIS FLOW REQUIREMENTS.
 2. CHECK VALVES SHOULD BE LOCATED AS CLOSE TOGETHER AS POSSIBLE AND AS CLOSE TO THE REACTOR COOLANT PIPE AS POSSIBLE.
 3. PROVIDE 3/8" I.D. FLOW RESTRICTOR FOR TRANSMISSION FROM SAFETY CLASS 1 TO SAFETY CLASS 2.
 4. BLIND FLANGES NORMALLY INSTALLED SPUD PIPING TO BE INSTALLED DURING ACCUMULATOR SPRINGING ONLY AFTER DEPRESSURIZATION.
 5. NOTE DELETED.
 6. ALL INSTRUMENTS ON THIS PID HAVE SEPARATION GROUP DESIGNATION "H" UNLESS OTHERWISE NOTED.
 7. TEST CONNECTIONS ATTACHED TO BOTTOM OF PIPING TO FACILITATE SPRINGING OF LINES.
 8. ALL INSTRUMENTS ON THIS PID HAVE SYSTEM DESIGNATION "S" UNLESS OTHERWISE NOTED.
 9. LOCATE TEST BARREL VALVE AS CLOSE TO TEST CONNECTION AS POSSIBLE.
 10. LOCATED OUTSIDE THE MISSILE BARRIER.
 11. REFER TO ENCS 943M00001 AND 943M00002 FOR IDENTIFICATION NUMBER DETAILS.
 12. VALVES PV3020, PV3025 AND PV3030 ARE TO BE INSTALLED IN THE REVERSE DIRECTION; & THE VALVE INLETS SHALL BE TOWARDS THE ACCUMULATOR.

- REFERENCES:**
1. FOR PIPING & INSTRUMENT SYMBOLS SEE DRAWING 8700001 & 8700002.
 2. BEST AVAILABLE DRAWING NO. ENCEP17 SHEET 2 OF 2. REL. NO. 1122-0204100000-0000.


9812070099-05

 HOUSTON LIGHTING & POWER COMPANY SOUTH TEXAS PROJECT ELECTRIC GENERATING STATION										PIPING AND INSTRUMENT DIAGRAM SAFETY INJECTION SYSTEM	
REVISION	BY	CHK	REL	DV	NA	SC	PC	SCALE	DWG. NO.	SHEET	TOTAL
5								NONE	SN129F05016 W1	11	11

30:1

À B C D

PROJ. NO. 067028 F. J. ANG. III

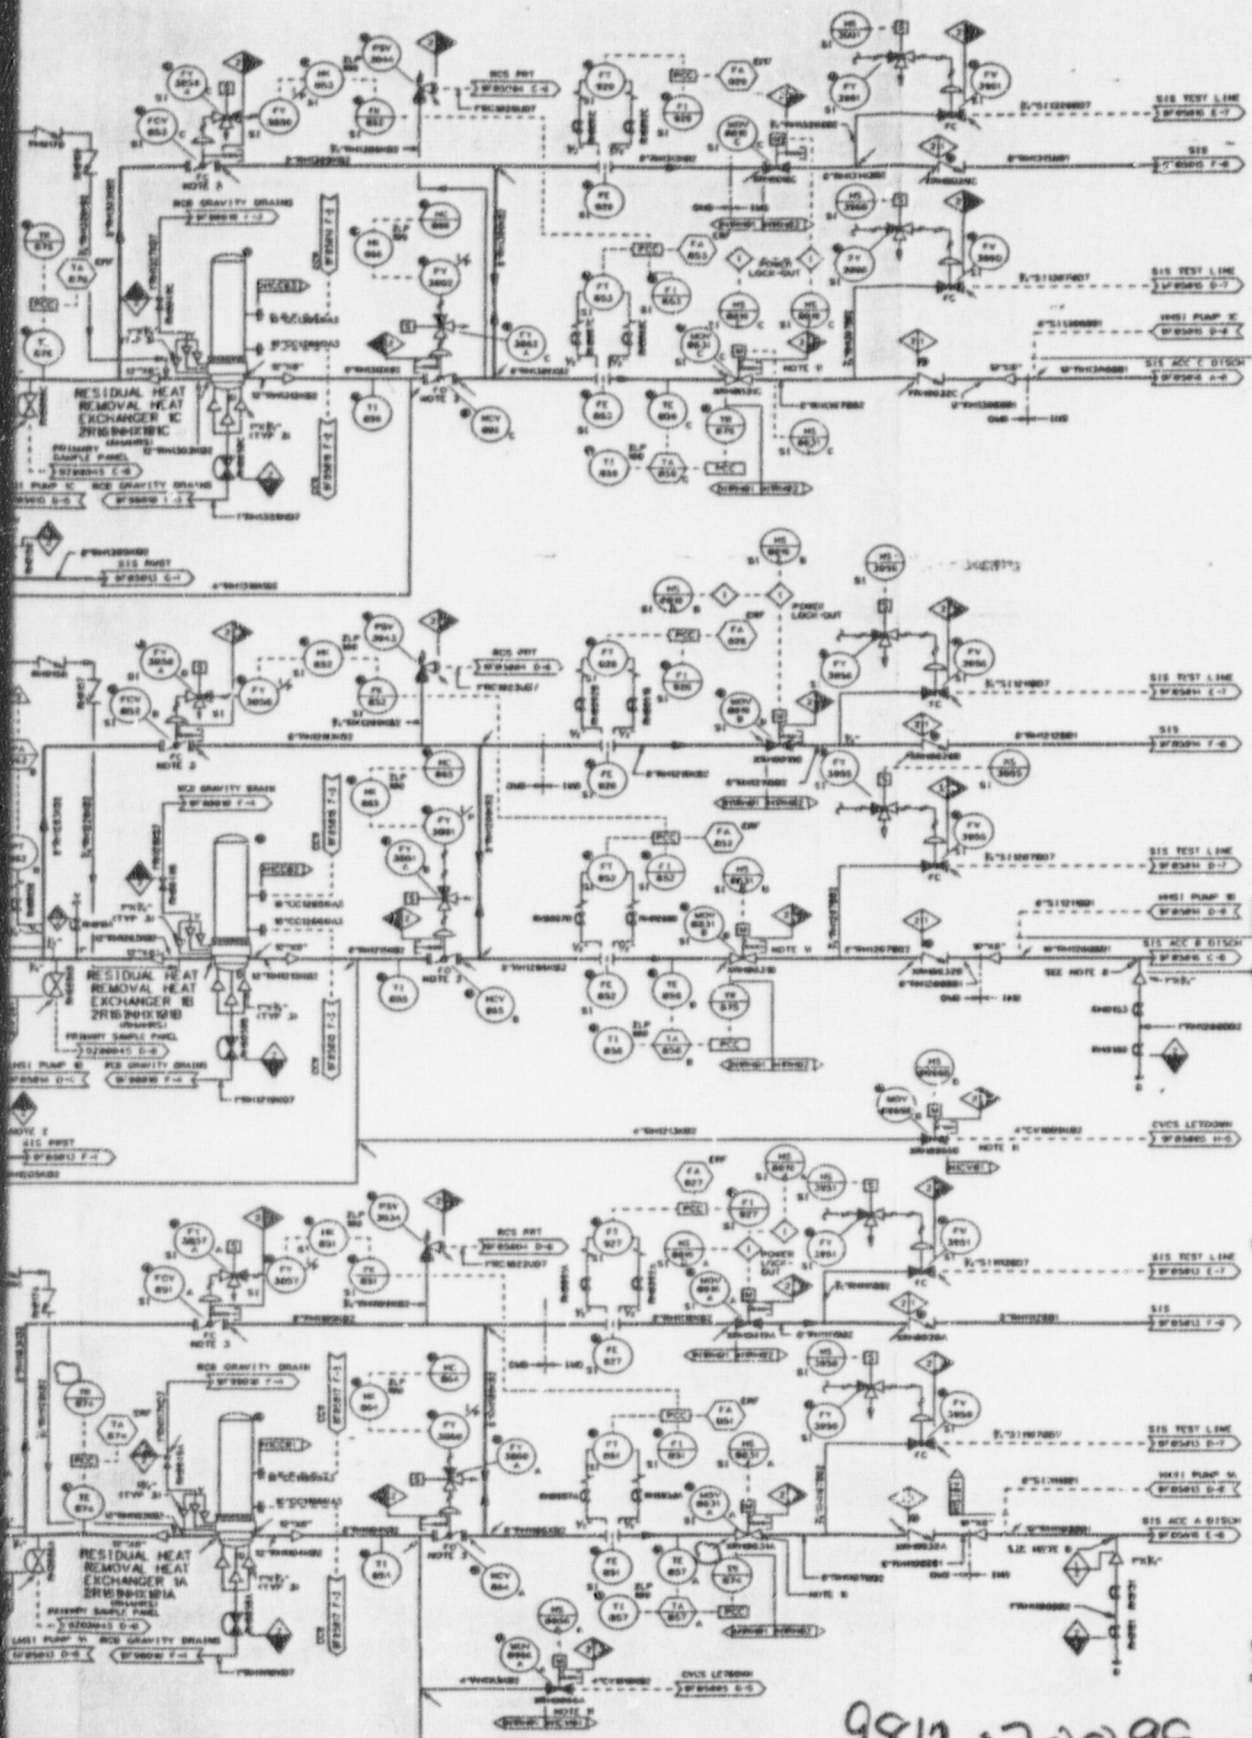

APERTURE CARD
 Also Available on Aperture Card

- NOTES**
- SEE ALL MISS SYS STANDARD DESIGN CRITERIA L&E LAYOUT SHEETS.
 - LOCATE TEST CONNECTION AS CLOSE AS POSSIBLE TO 150.0000 V.C. TEST CONNECTIONS ATTACHED TO BOTTOM OF PIPING TO FACILITATE DRAINING OF LINES.
 - WATING PLUGS FOR VALVE MUST BE 300A GRADE F30 TO MEET 30" PIPE SPEC. 6-4788A-REV.2 REQUIREMENTS.
 - LOCATE SHOPS AS CLOSE AS POSSIBLE TO THE ABOVE TEST CONNECTION.
 - ALL INSTRUMENTS ON THIS P & ID HAVE SYSTEM DESIGNATOR 'M' UNLESS OTHERWISE NOTED.
 - ALL INSTRUMENTS ON THIS P & ID HAVE SEPARATOR GROUP DESIGNATOR 'H' UNLESS OTHERWISE NOTED.
 - DELETED.
 - PROVIDE 1/2" ID FLOW RESTRICTOR FOR TRANSITION FROM SAFETY CLASS 1 TO SAFETY CLASS 2.
 - DELETED.
 - BREAKFAST PLUGS ARE REQUIRED FOR PUMP REMOVAL FOR MAINTENANCE.
 - THIS VALVE IS POWER LOCKED OUT AT V.C. MCC.
 - STAMPING VALVE IS TO BE LOCKED CLOSED IN MODES 2 AND 3 AND IN MODE 4 WHEN THE P&ID PRESSURE IS LESS THAN THE STATIC HEAD OF THE WATER COLUMN IN THE STAMPING.
 - THE AUTO CLOSE FEATURE FOR MOV'S 698A, B, C & 699A, B, C HAS BEEN DELETED.

- REFERENCES**
- FOR PIPING & INSTRUMENT SYMBOLS SEE DRAWINGS 6-4788A-REV.2 & 6-4788B-REV.2
 - MULTILINGUAL DRAWING NO. 100017
 - NOTE 1.1.1
 - NO. 100017-010-00000-00
 - NO. 100017-010-00000-01
 - NO. 100017-010-00000-02

9812070099-06



HOUSTON LIGHTING & POWER COMPANY
 SOUTH TEXAS PROJECT ELECTRIC GENERATING STATION

PIPING AND INSTRUMENTATION DIAGRAM
 RESIDUAL HEAT REMOVAL SYSTEM

REVISION	BY	CHK	RE	OV	NA	CE	PE
5							
4							
3							
2							

SCALE	DWG. NO.	REV.
NONE	SR09F28000 01	28