



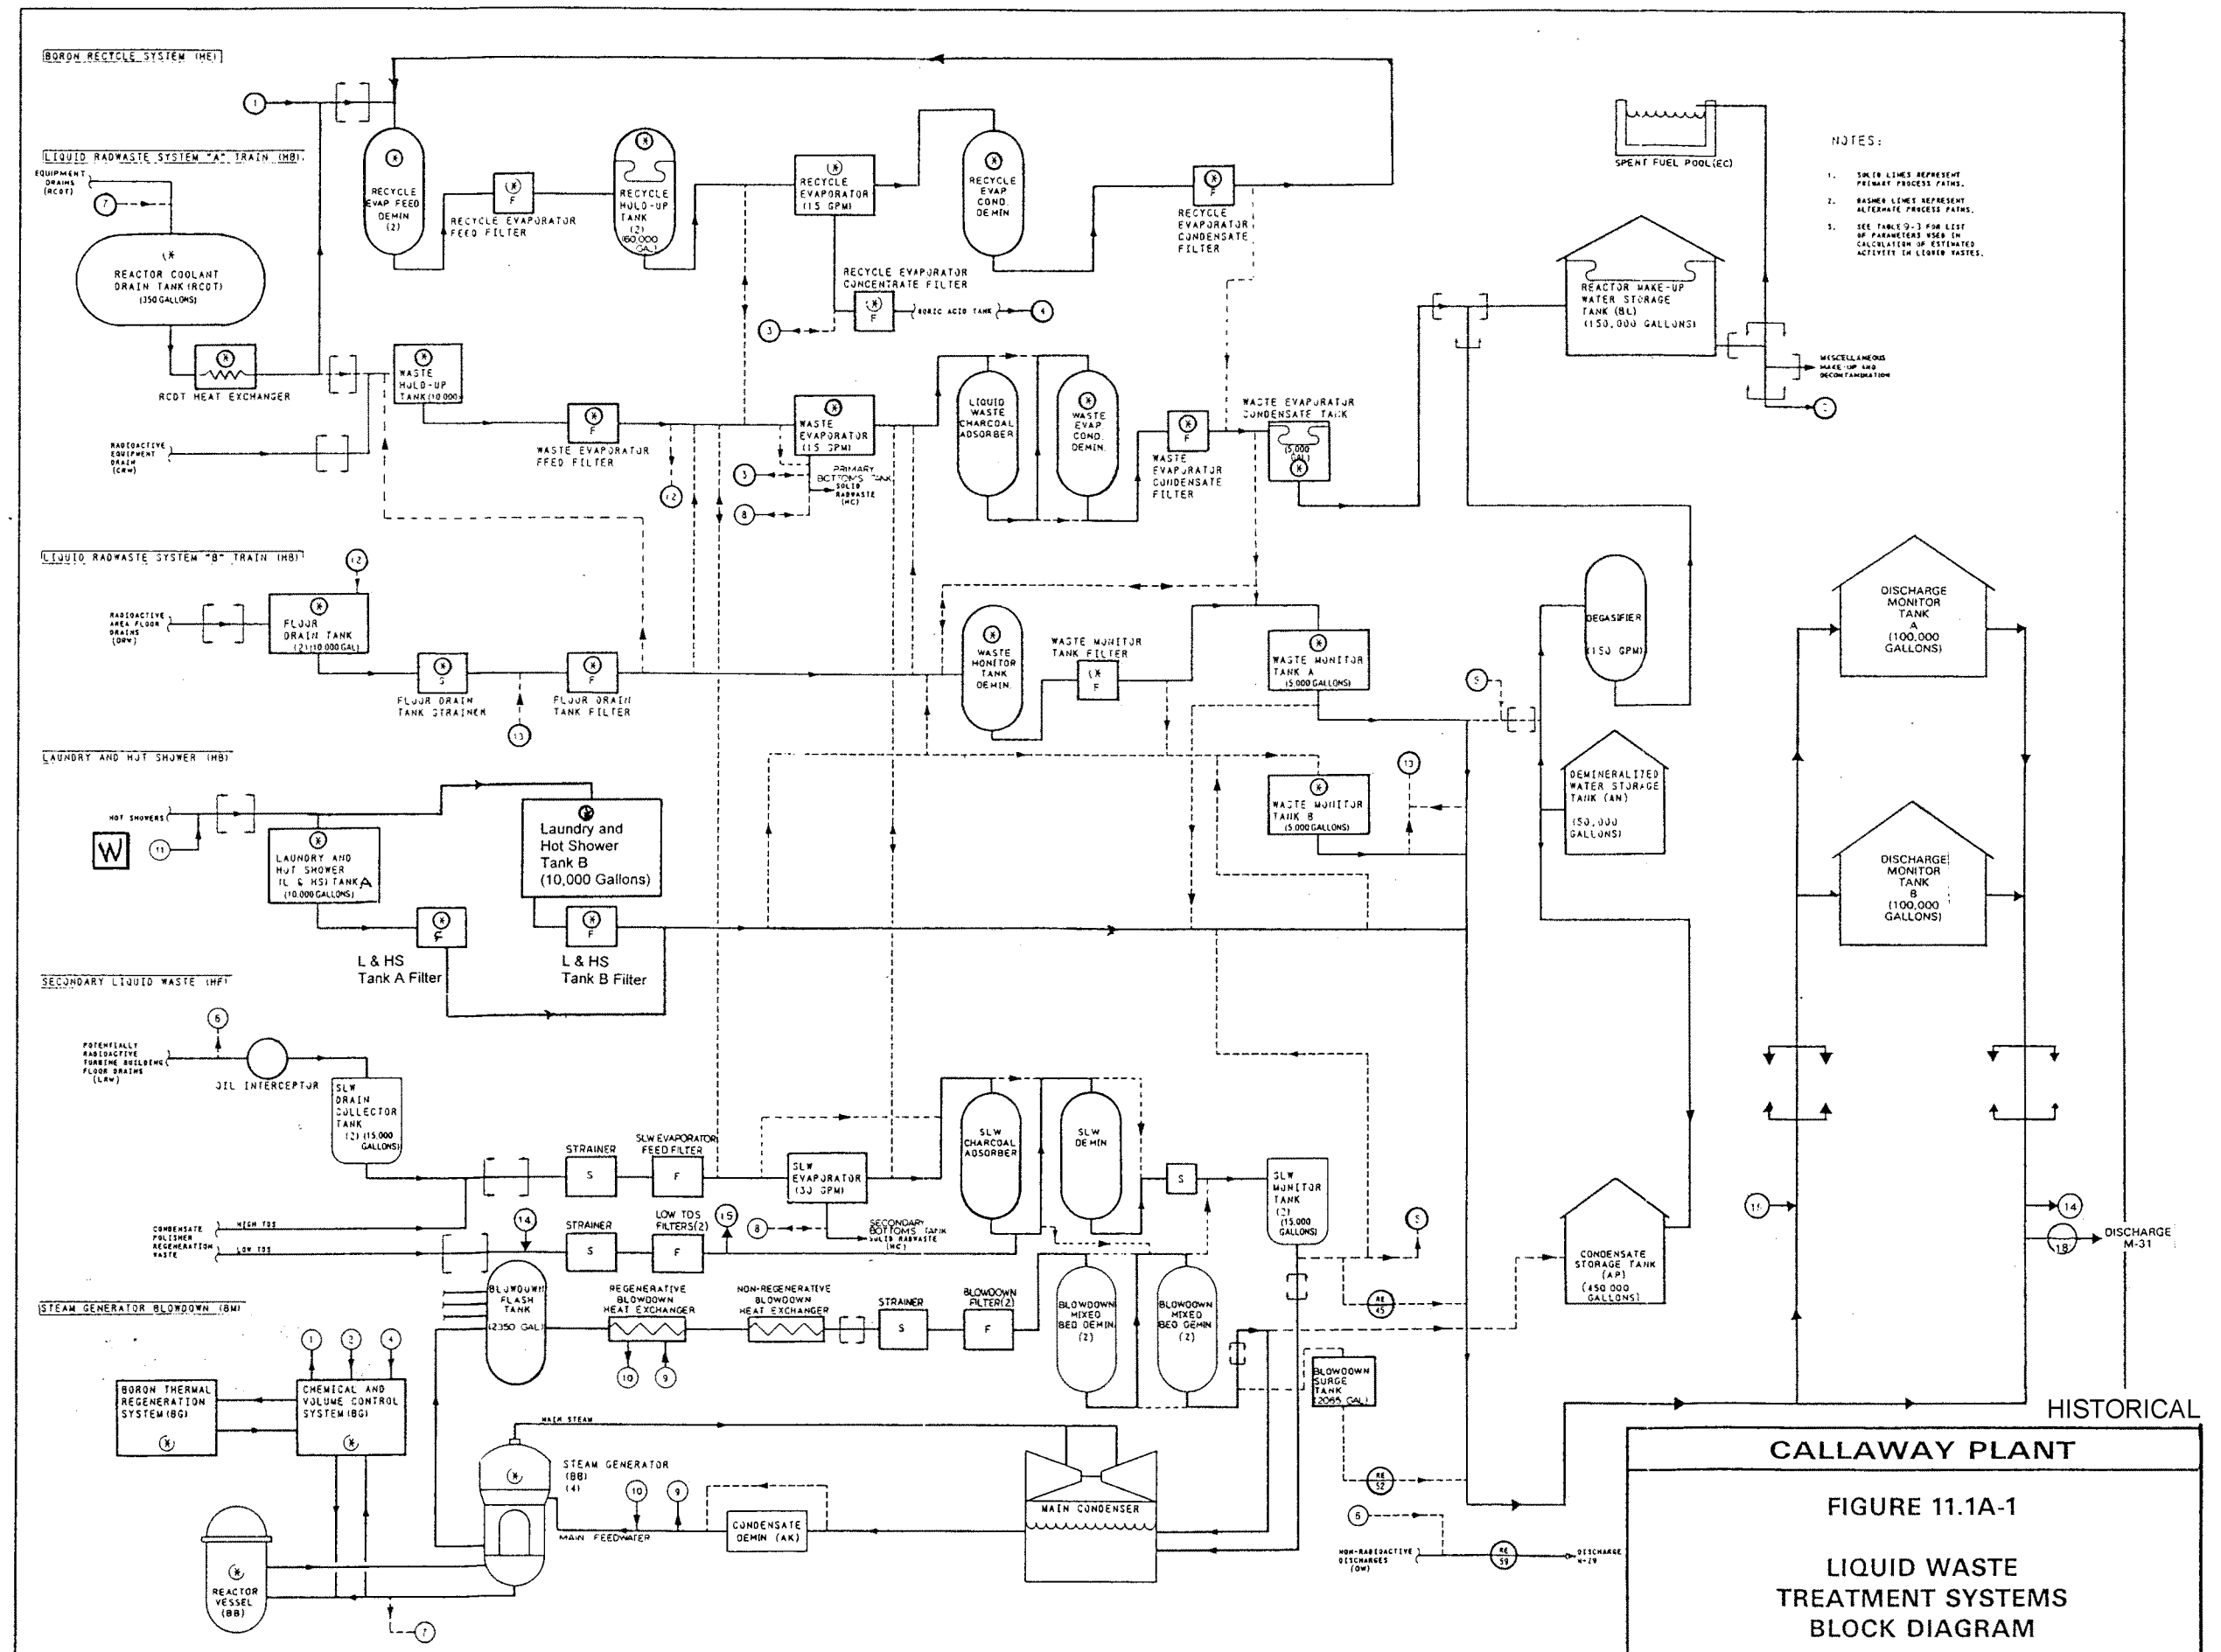

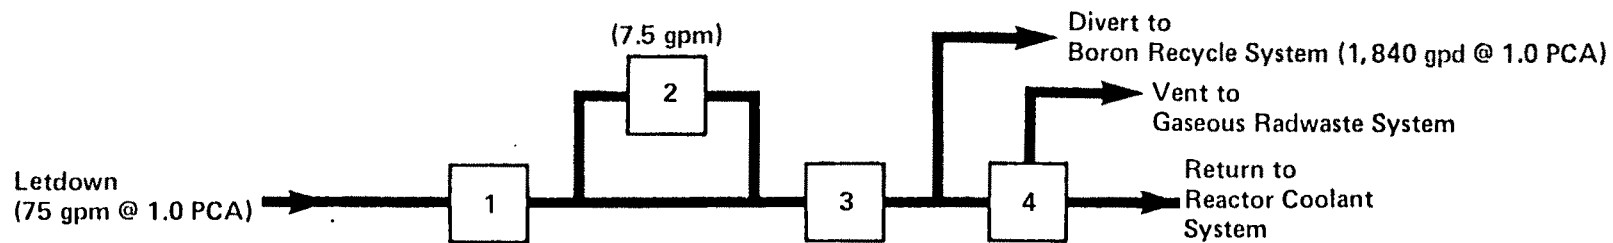

#### DECONTAMINATION FACTORS

|                                       | <u>Iodine</u> | <u>Cesium &amp; Rubidium</u> | <u>Other Nuclides</u> |
|---------------------------------------|---------------|------------------------------|-----------------------|
| 1. Mixed Bed Demineralizers           | 10            | 2                            | 10                    |
| 2. Cation Bed Demineralizer           | 1             | 10                           | 10                    |
| 3. Reactor Coolant Filter             | 1             | 1                            | 1                     |
| 4. Volume Control Tank <sup>(a)</sup> | —             | —                            | —                     |
| System DF                             | 10            | 20                           | 10 <sup>2</sup>       |

(a) For noble gases, a value of 0.25 is built into the GALE code for the y parameter for the case of continuous VCT purging.


Chemical and Volume Control  
System

#### CALLAWAY PLANT

Figure 11.1A-2  
(Sheet 1)

System Decontamination  
Factors

HISTORICAL

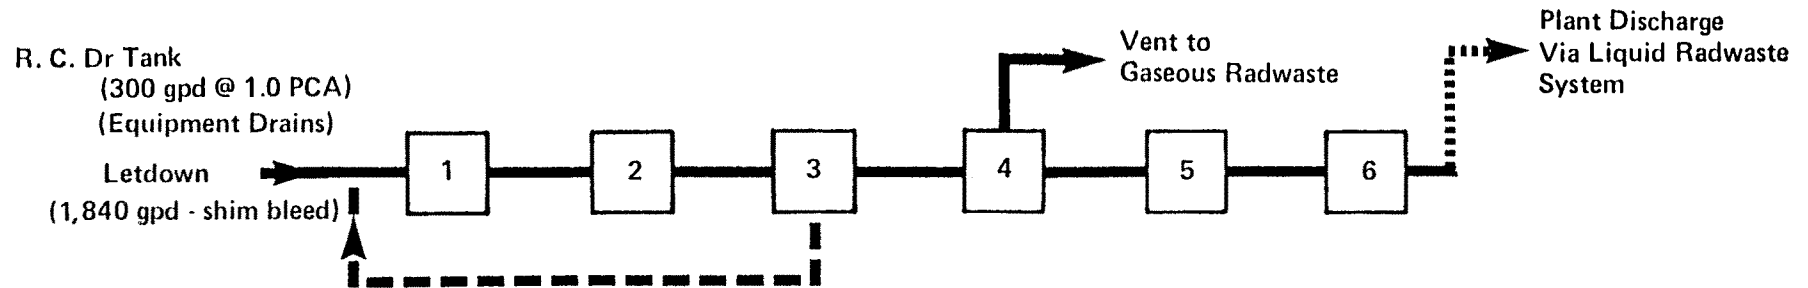

#### DECONTAMINATION FACTORS

|                                                    | Iodine | Cesium & Rubidium | Other Nuclides |
|----------------------------------------------------|--------|-------------------|----------------|
| 1. Recycle Evaporator Demineralizer (a)            | 10     | 2                 | 10             |
| 2. Recycle Evaporator Feed Filter                  | 1      | 1                 | 1              |
| 3. Recycle Holdup Tank                             | —      | —                 | —              |
| 4. Recycle Evaporator                              | $10^2$ | $10^3$            | $10^3$         |
| 5. Recycle Evaporator Condensate Demineralizer (b) |        |                   |                |
| Anion Bed                                          | $10^2$ | 1                 | 1              |
| Mixed Bed                                          | 10     | 10                | 10             |
| 6. Recycle Evaporator Condensate Filter            | 1      | 1                 | 1              |
| System DF (with anion bed in item 5)               | $10^5$ | $2 \times 10^3$   | $10^4$         |
| (with mixed bed in item 6)                         | $10^4$ | $2 \times 10^4$   | $10^5$         |

#### Decay Time

Boron Recycle Holdup Tank #2, Collection Time

$$T_c = \frac{0.8 \times 56,000}{2,140} = 20.9 \text{ days}$$

Recycle Process Time

$$T_p = \frac{0.8 \times 56,000}{21,600} = 2 \text{ days}$$

Boron Recycle System

#### CALLAWAY PLANT


Figure 11.1A-2  
(Sheet 2)

System Decontamination Factors

a. Mixed Bed

b. Anion Bed or Mixed Bed Optional. See Chapter 11.0 of Each Site Addendum.

HISTORICAL

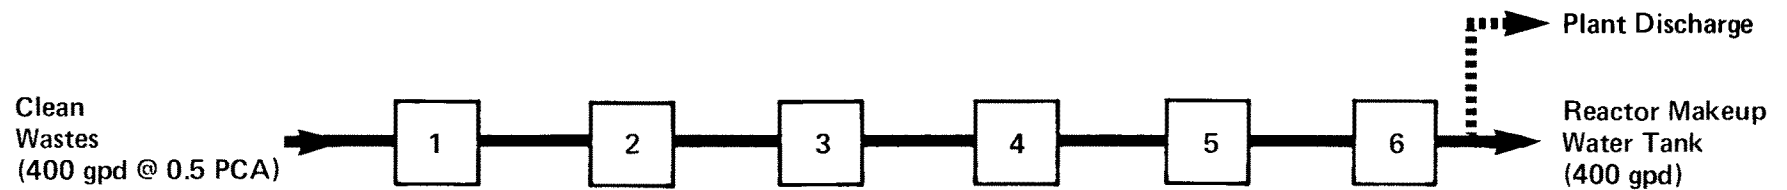

#### DECONTAMINATION FACTORS

|                                              | <u>Iodine</u> | <u>Cesium &amp;<br/>Rubidium</u> | <u>Other<br/>Nuclides</u> |
|----------------------------------------------|---------------|----------------------------------|---------------------------|
| 1. Waste Holdup Tank                         |               |                                  |                           |
| 2. Waste Evaporator Feed Filter              | 1             | 1                                | 1                         |
| 3. Waste Evaporator                          | $10^3$        | $10^4$                           | $10^4$                    |
| 4. Liquid Waste Charcoal Adsorber            | 1             | 1                                | 1                         |
| 5. Waste Evaporator Condensate Demineralizer | 10            | 10                               | 10                        |
| 6. Waste Evaporator Condensate Filter        | <u>1</u>      | <u>1</u>                         | <u>1</u>                  |
| System DF                                    | $10^4$        | $10^5$                           | $10^5$                    |

#### Decay Time

Waste Holdup Tank #1  
Collection Time

$$T_c = \frac{0.4 \times 10,000}{400} = 10 \text{ days}$$

Waste Process  
Time

$$T_p = \frac{0.4 \times 10,000}{21,600} = 0.185 \text{ day}$$


Liquid Radwaste  
Train "A" - Clear Waste

#### CALLAWAY PLANT

Figure 11.1A-2  
(Sheet 3)

System Decontamination Factors

HISTORICAL

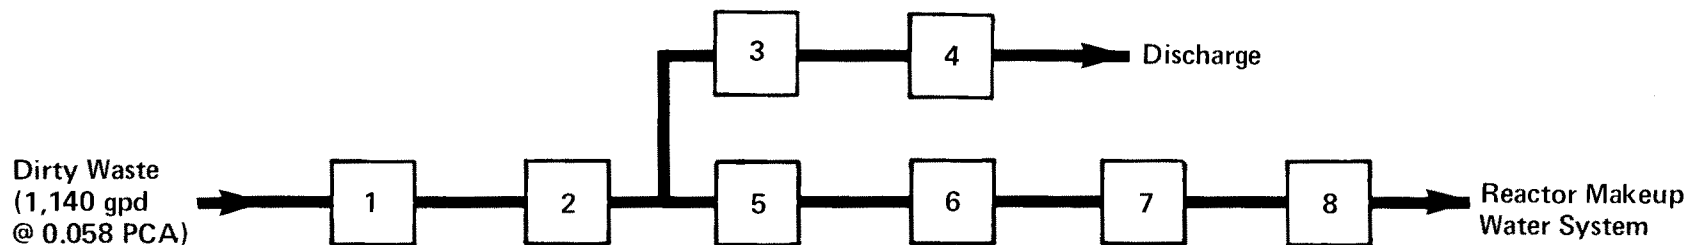

#### DECONTAMINATION FACTORS

|                                              | <u>Iodine</u>   | <u>Cesium &amp;<br/>Rubidium</u> | <u>Other<br/>Nuclides</u> |
|----------------------------------------------|-----------------|----------------------------------|---------------------------|
| 1. Floor Drain Tank                          | —               | —                                | —                         |
| 2. Floor Drain Tank Filter                   | 1               | 1                                | 1                         |
| 3. Waste Monitor Tank Demineralizer (a)      | —               | —                                | —                         |
| 4. Waste Monitor Tank Filter (a)             | 1               | 1                                | 1                         |
| 5. Waste Evaporator (b)                      | 10 <sup>3</sup> | 10 <sup>4</sup>                  | 10 <sup>4</sup>           |
| 6. Liquid Waste Charcoal Adsorber            | 1               | 1                                | 1                         |
| 7. Waste Evaporator Condensate Demineralizer | 10              | 10                               | 10                        |
| 8. Waste Evaporator Condensate Filter        | <u>1</u>        | <u>1</u>                         | <u>1</u>                  |
| System DF (c)                                | 10 <sup>4</sup> | 10 <sup>5</sup>                  | 10 <sup>5</sup>           |

#### Decay Times

Floor Drain Tank #2,  
Collection Time

$$T_c = \frac{0.8 \times 10,000}{1,140} = 7 \text{ days}$$

Waste Processing Time

$$T_p = \frac{0.8 \times 10,000}{21,600} = 0.37 \text{ day}$$

a) Used only when influent activity < 10<sup>-5</sup>  $\mu$ Ci/cc

b) Used when influent activity  $\geq$  10<sup>-5</sup>  $\mu$ Ci/cc

c) Assumes evaporator path

Liquid Radwaste  
Train "B" - Dirty Waste


#### CALLAWAY PLANT

Figure 11.1A-2  
(Sheet 4)

System Decontamination Factors

HISTORICAL

**Figure 11.1A-2 Sheet 5 is deleted.**

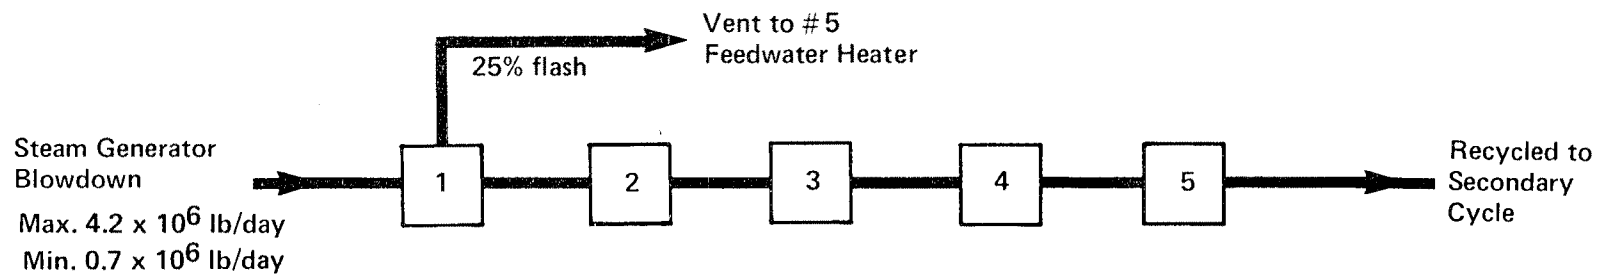

#### DECONTAMINATION FACTORS

|                                                         | <u>Iodine</u>             | <u>Cesium &amp;<br/>Rubidium</u> | <u>Other<br/>Nuclides</u> |
|---------------------------------------------------------|---------------------------|----------------------------------|---------------------------|
| 1. Steam Generator Blowdown Flashtank                   | —                         | —                                | —                         |
| 2. Steam Generator Blowdown Regenerative Heat Exchanger | —                         | —                                | —                         |
| 3. S.G. Blowdown Nonregenerative Heat Exchanger         | —                         | —                                | —                         |
| 4. S.G. Blowdown Filters                                | 1                         | 1                                | 1                         |
| 5. S.G. Blowdown Demineralizers                         | <u>10<sup>2</sup>(10)</u> | <u>10(10)</u>                    | <u>10<sup>2</sup>(10)</u> |
| System DF                                               | 10 <sup>3</sup>           | 10 <sup>2</sup>                  | 10 <sup>3</sup>           |


Steam Generator  
Blowdown

#### CALLAWAY PLANT

Figure 11.1A-2  
(Sheet 6)

System Decontamination Factors

HISTORICAL

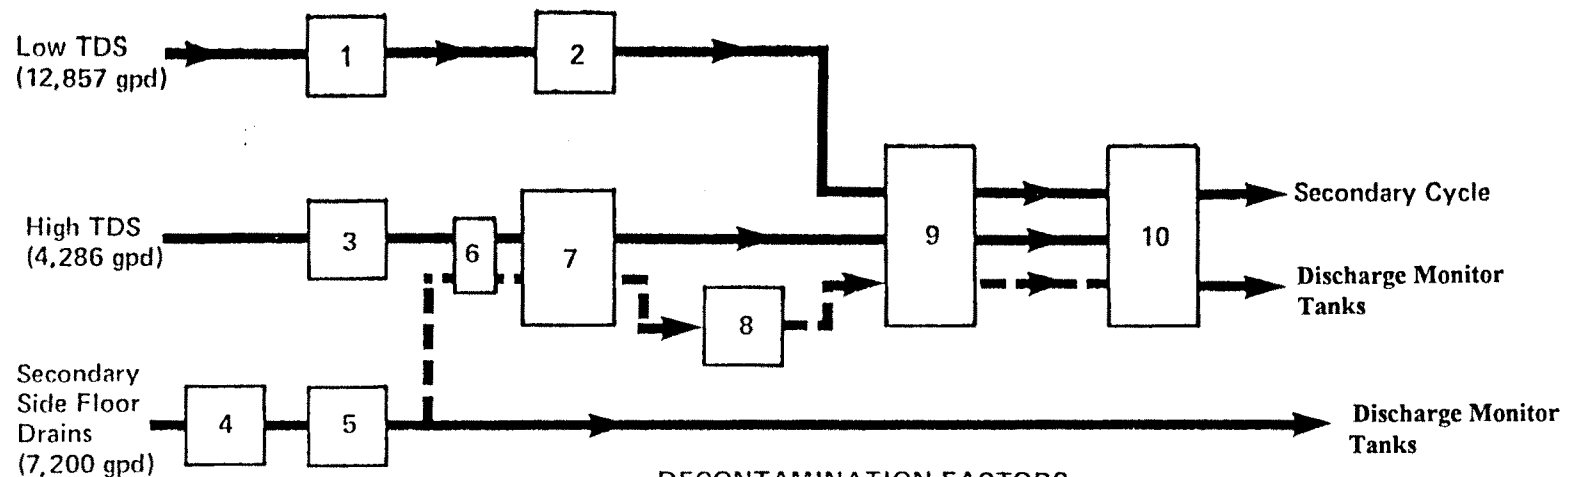

#### DECONTAMINATION FACTORS


|                                                 | <u>Iodine</u> | <u>Cesium &amp;<br/>Rubidium</u> | <u>Other<br/>Nuclides</u> |
|-------------------------------------------------|---------------|----------------------------------|---------------------------|
| 1. Low TDS Collector Tank                       | —             | —                                | —                         |
| 2. Low TDS Filter                               | 1             | 1                                | 1                         |
| 3. High TDS Collector Tank                      | —             | —                                | —                         |
| 4. Oil Interceptor                              | —             | —                                | —                         |
| 5. SLW Drain Collector Tank                     | —             | —                                | —                         |
| 6. SLW Filter                                   | 1             | 1                                | 1                         |
| 7. SLW Evaporator (available only for high TDS) | $10^3$        | $10^4$                           | $10^4$                    |
| 8. SLW Charcoal Adsorber                        | —             | —                                | —                         |
| 9. SLW Demineralizer (C)                        | $10(10^2)$    | $10(2)$                          | $10(10^2)$                |
| 10. SLW Monitor Tank (Low TDS)                  | —             | —                                | —                         |
| System DF - High TDS                            | $10^4$        | $10^5$                           | $10^5$                    |
| Low TDS                                         | $10^2$        | 2                                | $10^2$                    |

Secondary Liquid  
Waste System

- (a) Processing will be subject to chemistry requirements.  
 (b) No credit is taken for collection and processing times.  
 (c) Second number indicates Low TDS DF.

| CALLAWAY PLANT                 |
|--------------------------------|
| Figure 11.1A-2<br>(Sheet 7)    |
| System Decontamination Factors |


HISTORICAL

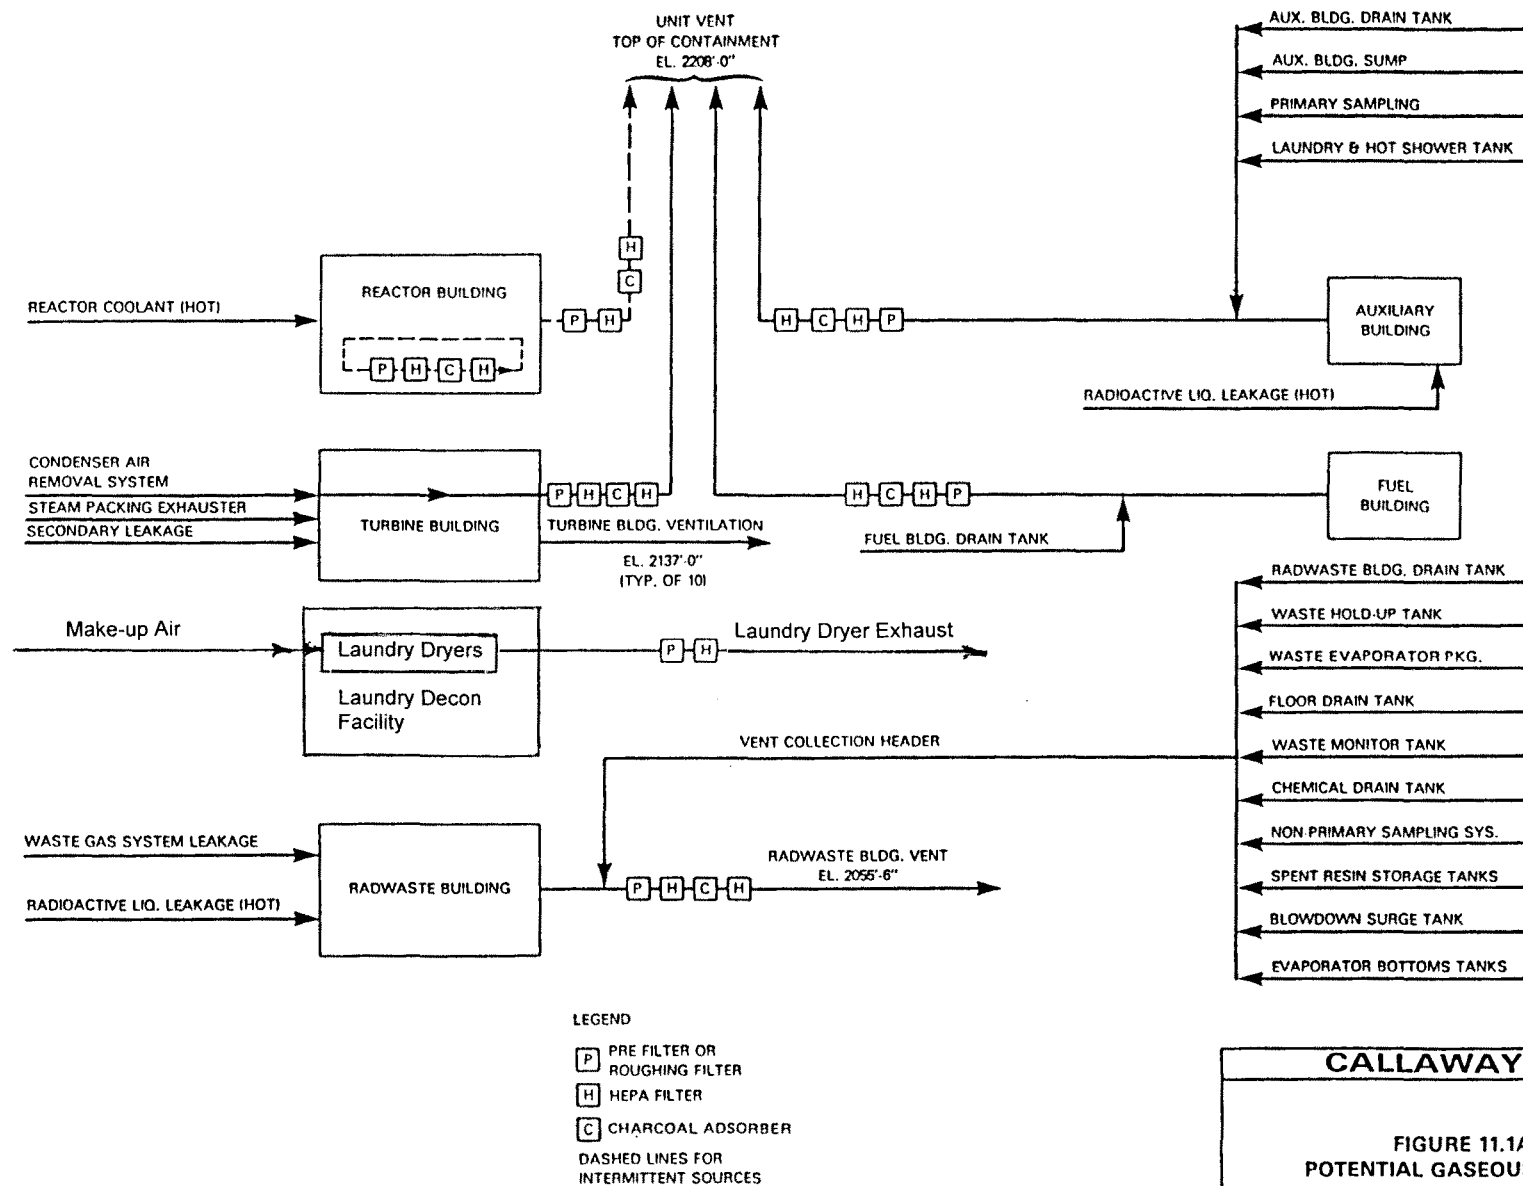

**CALLAWAY PLANT**


**FIGURE 11.1A-3**  
**POTENTIAL GASEOUS RELEASE**

HISTORICAL

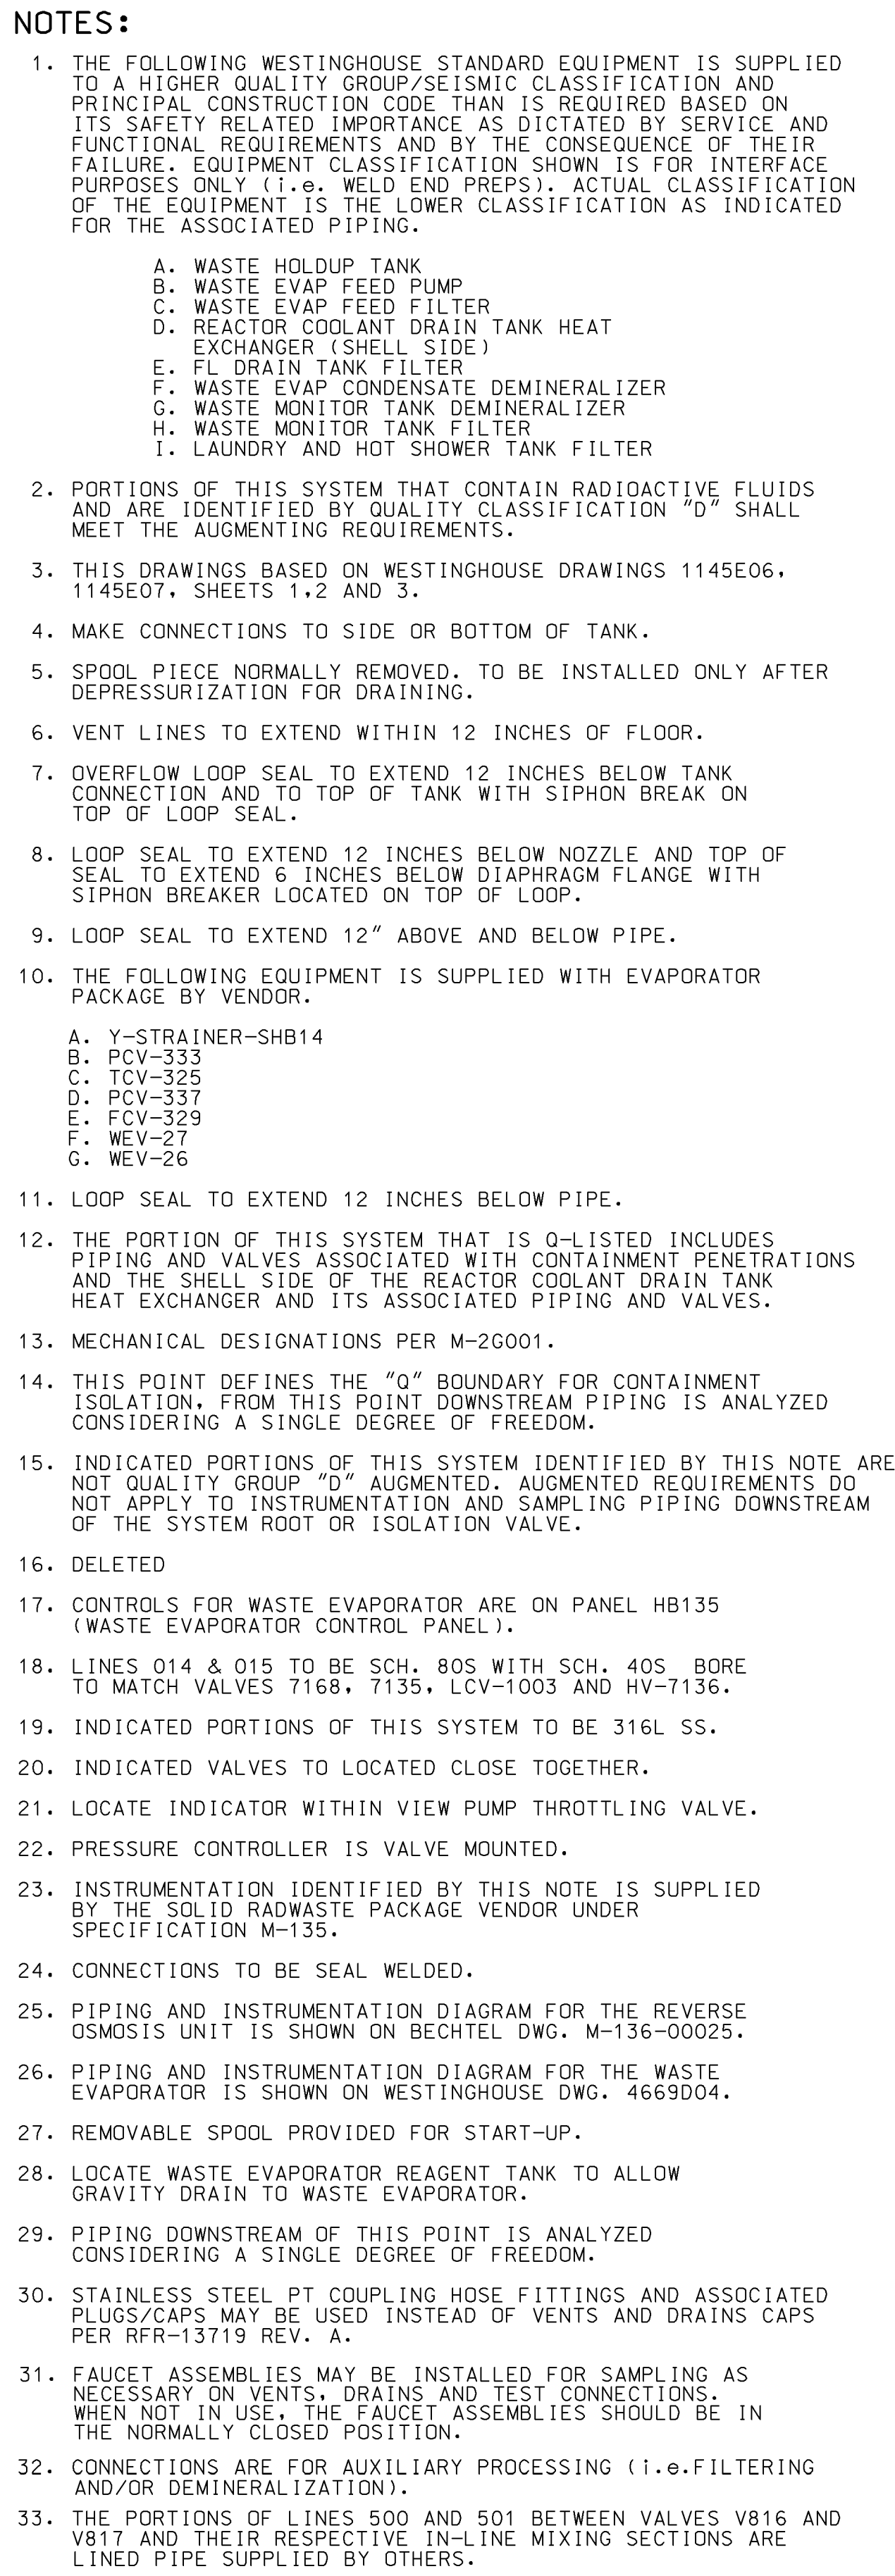

REV. DATE  
32 111105  
DRAIN CHKD, SUPV  
RLW EWM SKC  
INCORPORATE  
MP 89-1035A  
(PARTIAL)  
REV. DATE  
33 030507  
DRAIN CHKD, SUPV  
RLW EWM SKC  
INCORPORATE  
MP 89-1035A  
(PARTIAL)  
REV. DATE  
34 040407  
DRAIN CHKD, SUPV  
RLW EWM TWS  
INCORPORATE  
MP 89-1035A  
(PARTIAL)  
REV. DATE  
35 022208  
DRAIN CHKD, SUPV  
RLW EWM TWS  
INCORPORATE  
CAR 20010405  
CAR 20081353  
REV. DATE  
36 102808  
DRAIN CHKD, SUPV  
RLW TJC LMR  
INCORPORATE  
MP 89-1035A  
(PARTIAL)  
REV. DATE  
37 022908  
DRAIN CHKD, SUPV  
RLW EWM LMR  
INCORPORATE  
MP 89-1035A  
(PARTIAL)  
REV. DATE  
38 042610  
DRAIN CHKD, SUPV  
RLW TJC LMR  
INCORPORATE  
MP 89-1035A  
(PARTIAL)  
REV. DATE  
39 030109  
DRAIN CHKD, SUPV  
MAL TJC LMP  
INCORP.  
CAR 20100434


|                                         |        |                                                                                            |                |  |        |
|-----------------------------------------|--------|--------------------------------------------------------------------------------------------|----------------|--|--------|
| DESIGN                                  | (DATE) | PIPING AND INSTRUMENTATION DIAGRAM<br>LIQUID RADWASTE SYSTEM<br>FSAR FIGURE 11.2-1 SHEET 1 |                |  |        |
| CHKD.                                   | (DATE) |                                                                                            |                |  |        |
| SUPV.                                   | (DATE) |                                                                                            |                |  |        |
| APPR.                                   | (DATE) |                                                                                            |                |  |        |
| N/A                                     |        | LOCATION                                                                                   | CALLAWAY PLANT |  | CLASS  |
| UNION ELECTRIC COMPANY<br>ST. LOUIS, MO |        |                                                                                            | M-22HB01(Q)    |  | REV 39 |

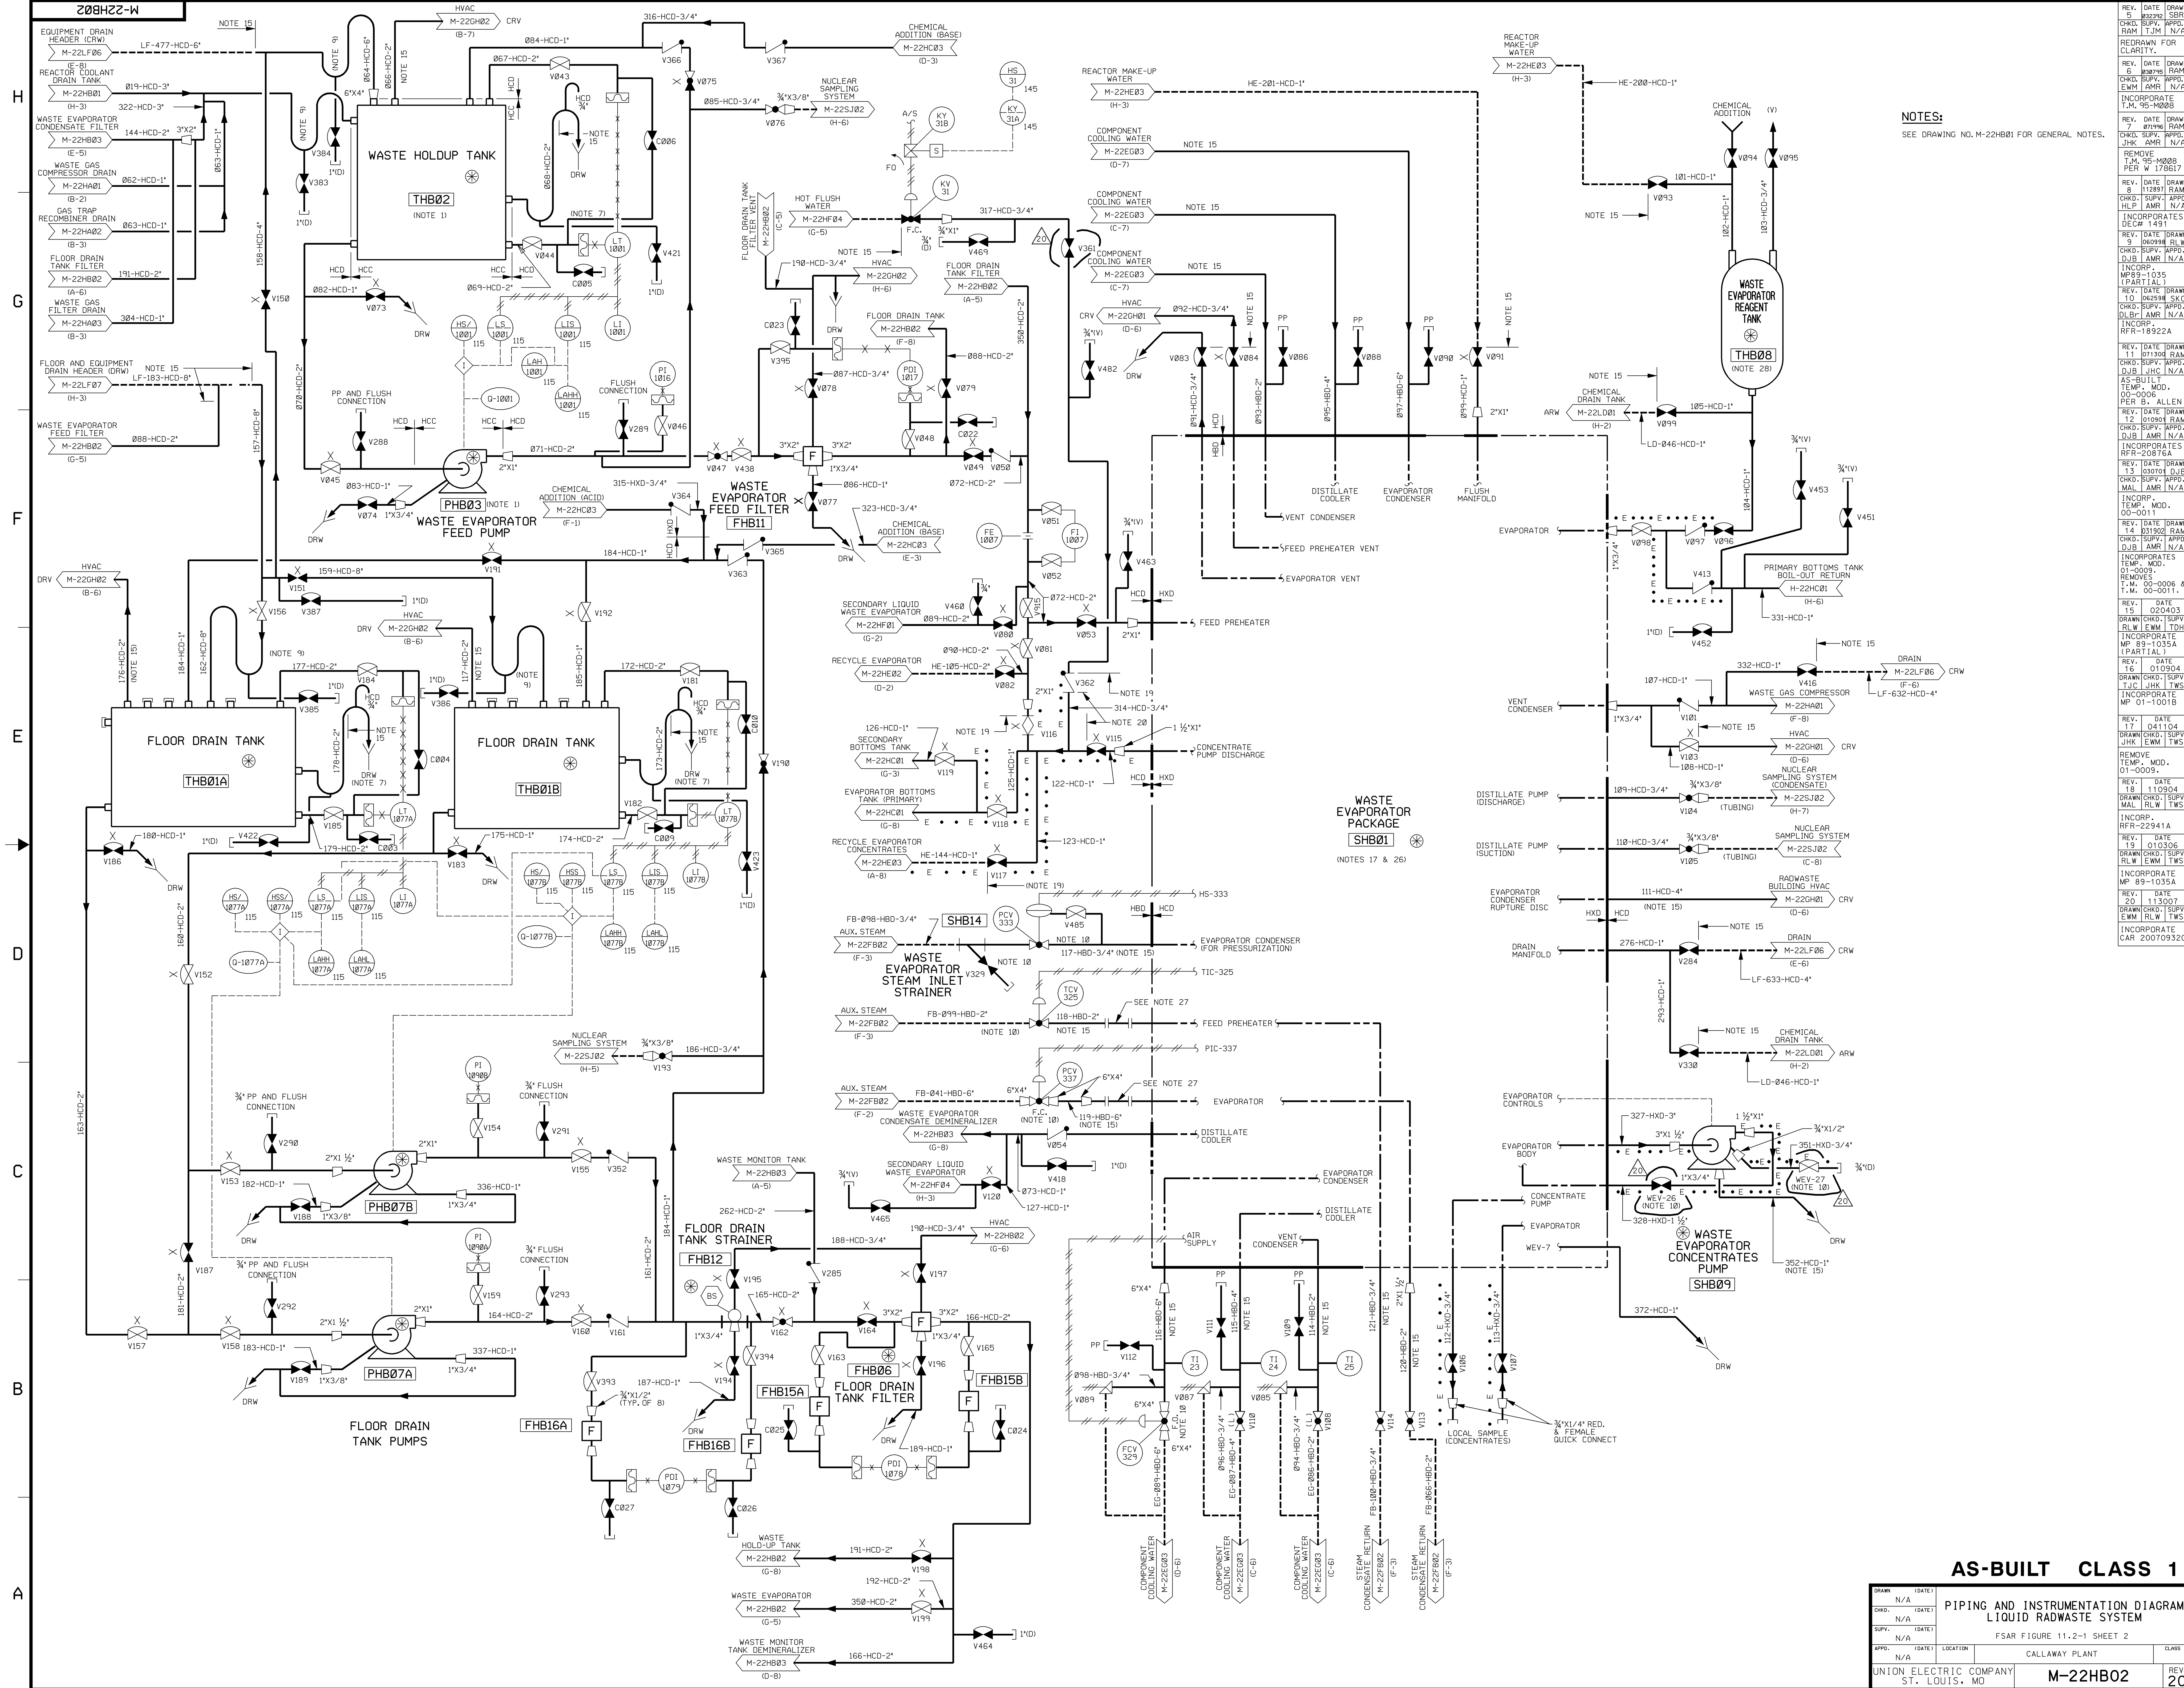


NOTES:  
SEE DRAWING NO. M-22HB01 FOR GENERAL NOTES.

AS-BUILT CLASS 1


| DRAWING                                 |     |      |  | PIPING AND INSTRUMENTATION DIAGRAM |  |      |    |
|-----------------------------------------|-----|------|--|------------------------------------|--|------|----|
| CHD.                                    | N/A | DATE |  | LIQUID RADWASTE SYSTEM             |  |      |    |
| SUPV.                                   | N/A | DATE |  | FSAR FIGURE 11.2-1 SHEET 2         |  |      |    |
| APP.                                    | N/A | DATE |  | CALLAWAY PLANT                     |  |      |    |
| UNION ELECTRIC COMPANY<br>ST. LOUIS, MO |     |      |  | M-22HB02                           |  | REV. | 20 |

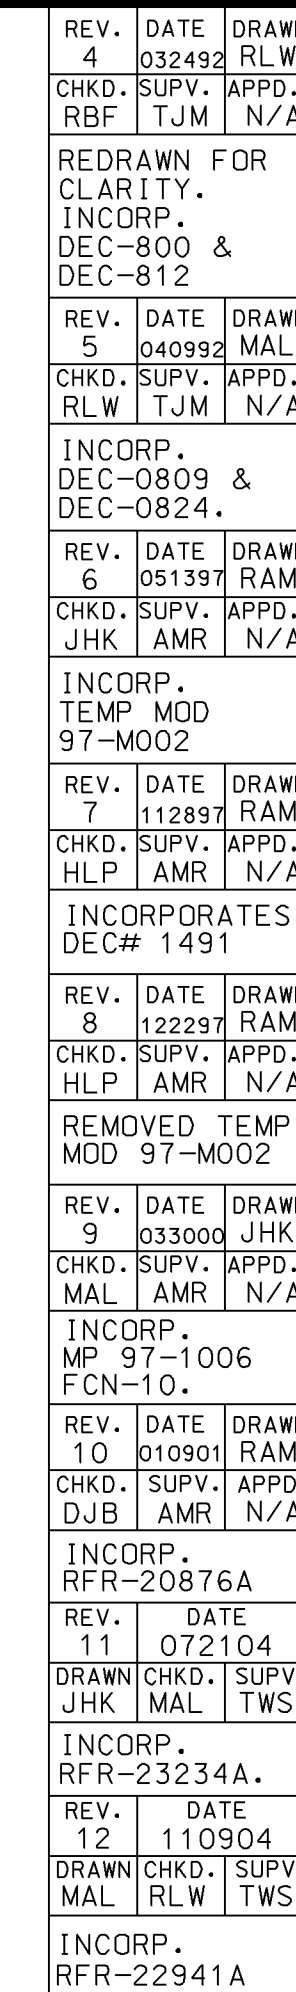

|                                         |          |                |                                                                                                                                                                                                                                                                                                                                                                  |  |           |
|-----------------------------------------|----------|----------------|------------------------------------------------------------------------------------------------------------------------------------------------------------------------------------------------------------------------------------------------------------------------------------------------------------------------------------------------------------------|--|-----------|
| DESIGN                                  | N/A      |                | PIPING & INSTRUMENTATION DIAGRAM<br>LIQUID RADWASTE SYSTEM<br><div style="border: 1px solid black; border-radius: 50%; padding: 5px; display: inline-block;">           FSAR FIGURE 11.2-1 SHEET 3         </div> <div style="border: 1px solid black; border-radius: 50%; padding: 5px; display: inline-block; margin-left: 10px;">           12         </div> |  |           |
| CHKD.                                   | N/A      |                |                                                                                                                                                                                                                                                                                                                                                                  |  |           |
| SUPV.                                   | N/A      |                |                                                                                                                                                                                                                                                                                                                                                                  |  |           |
| APPR.                                   | N/A      |                |                                                                                                                                                                                                                                                                                                                                                                  |  |           |
|                                         | LOCATION | CALLAWAY PLANT |                                                                                                                                                                                                                                                                                                                                                                  |  | CLASS     |
| UNION ELECTRIC COMPANY<br>ST. LOUIS, MO |          |                | M-22HB03                                                                                                                                                                                                                                                                                                                                                         |  | REV<br>12 |

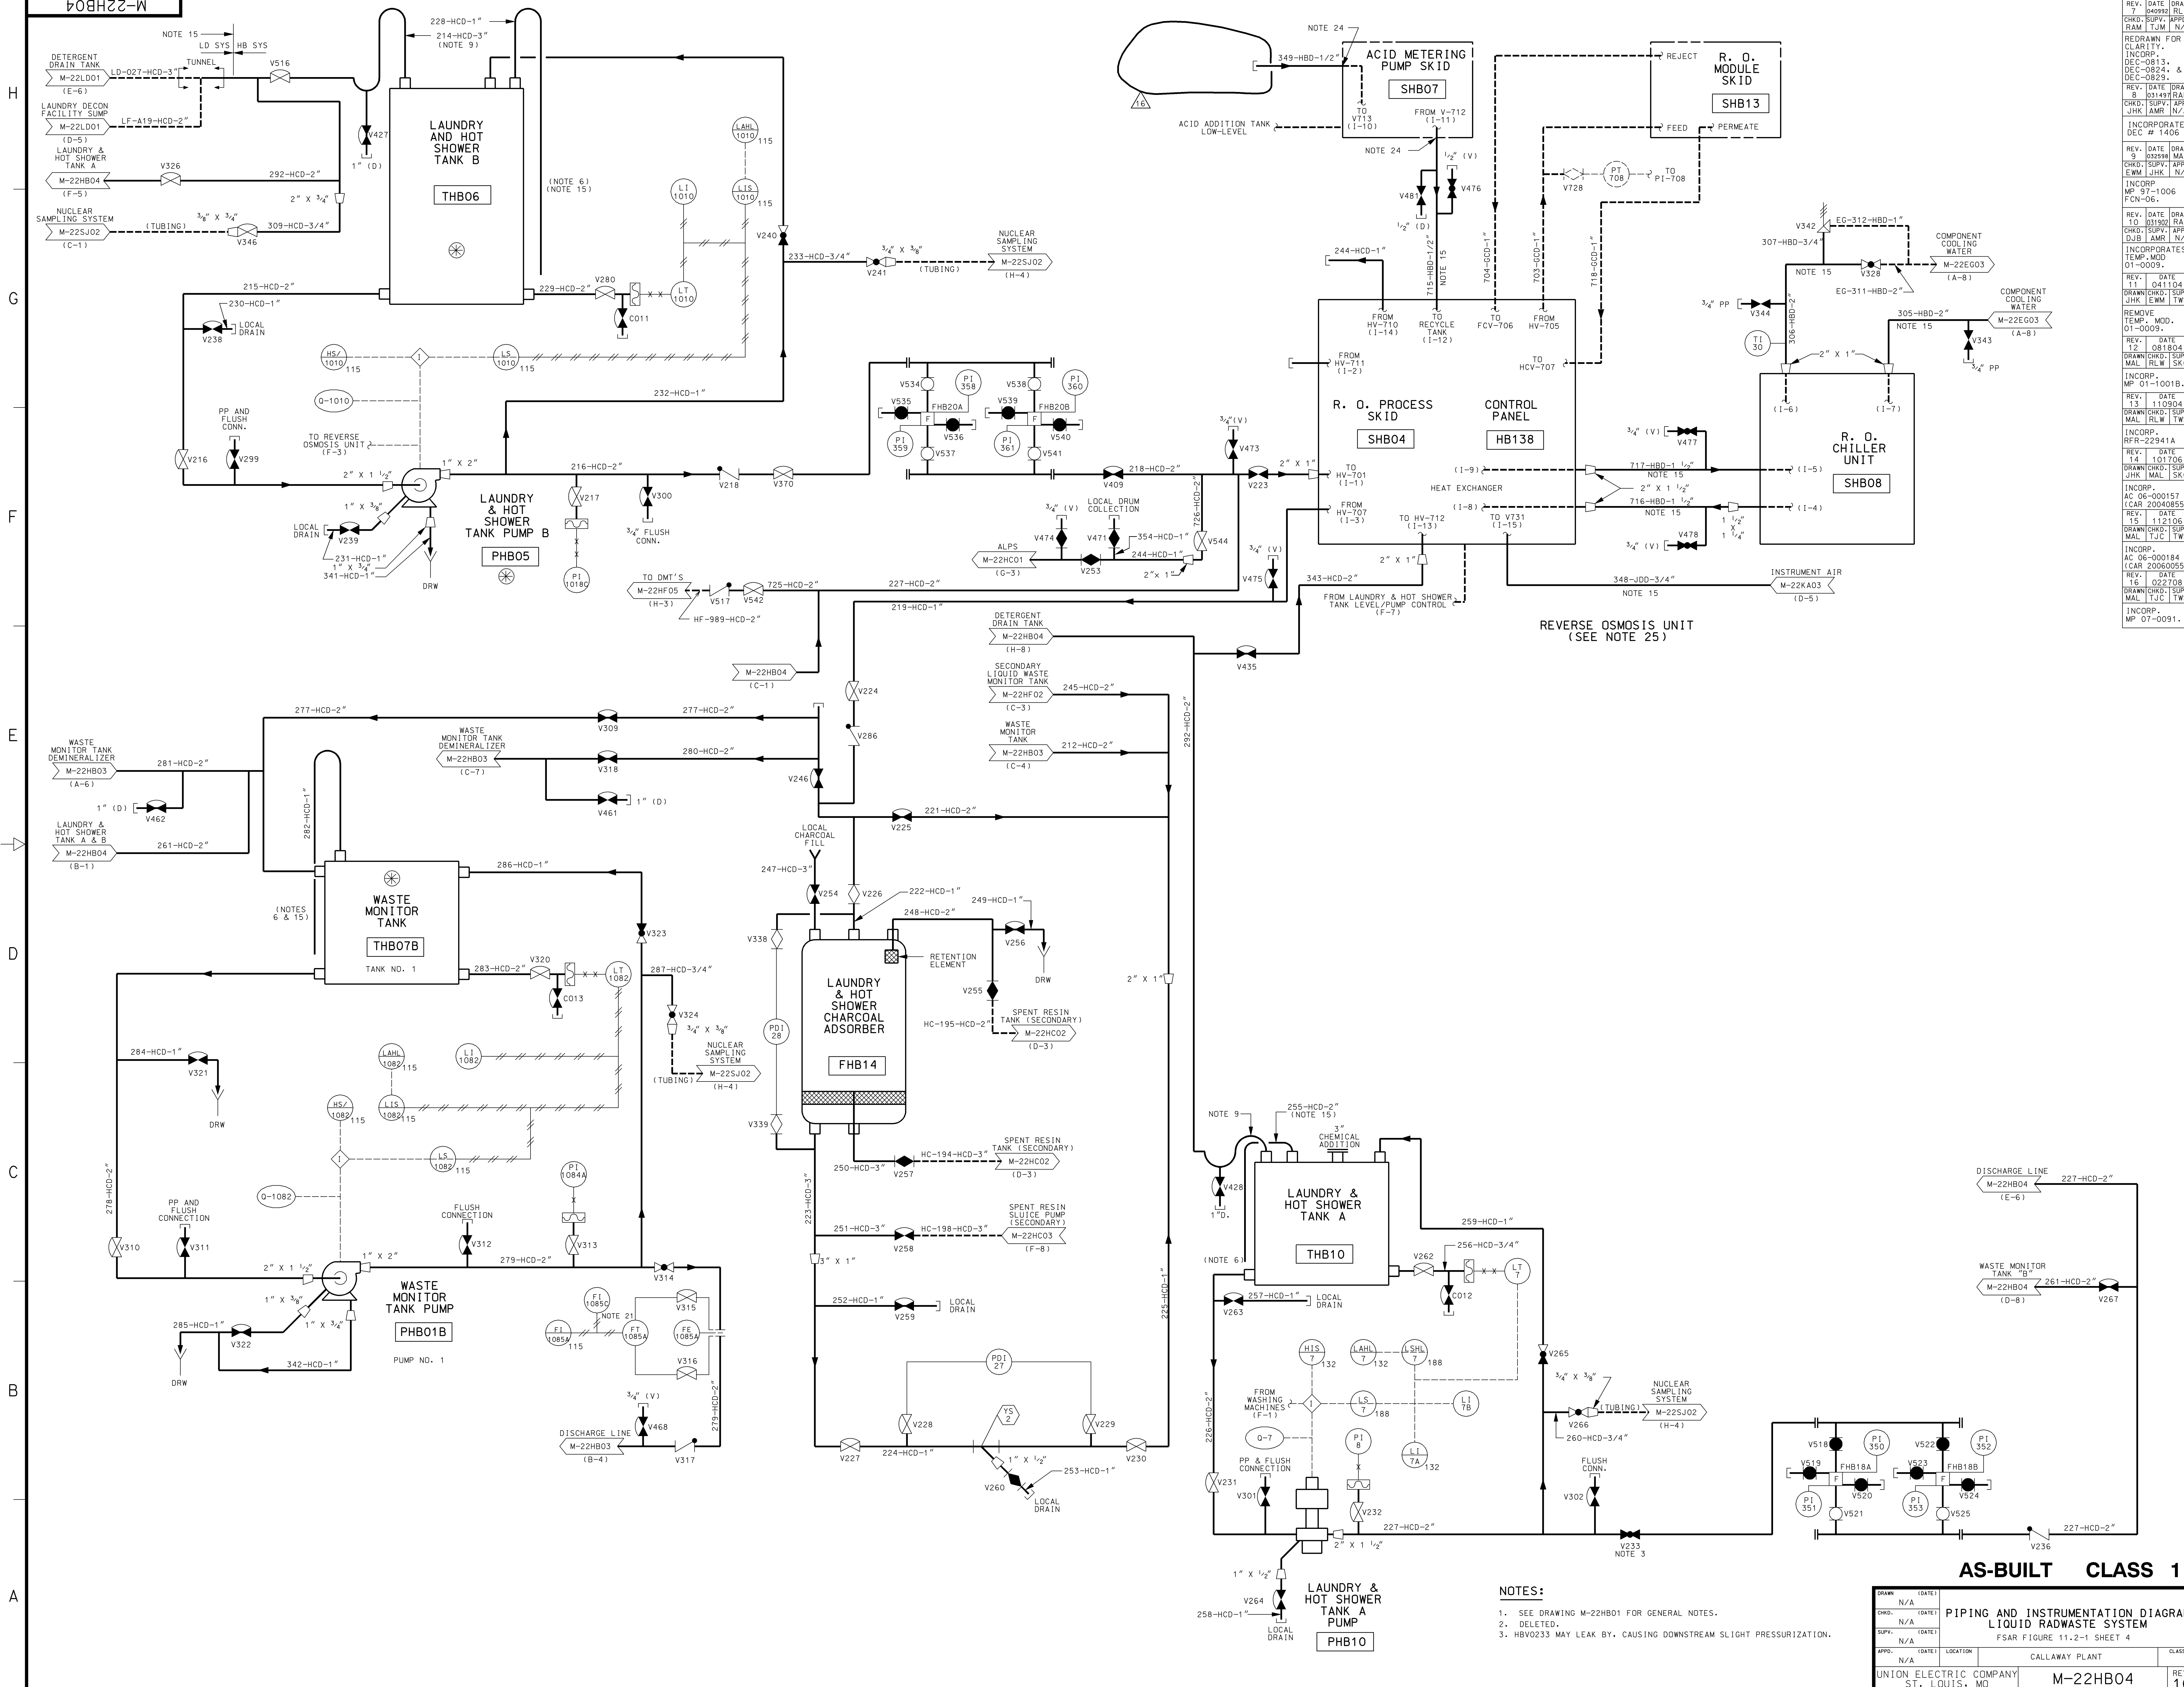

| REV. | DATE | DRAWN   | CHKD. | SUPV. | APPR. | RAM | TJM | N/A |
|------|------|---------|-------|-------|-------|-----|-----|-----|
| 1    | 0813 | INCORP. |       |       |       |     |     |     |
| 2    | 0824 | INCORP. |       |       |       |     |     |     |
| 3    | 0829 | INCORP. |       |       |       |     |     |     |
| 4    | 0829 | INCORP. |       |       |       |     |     |     |
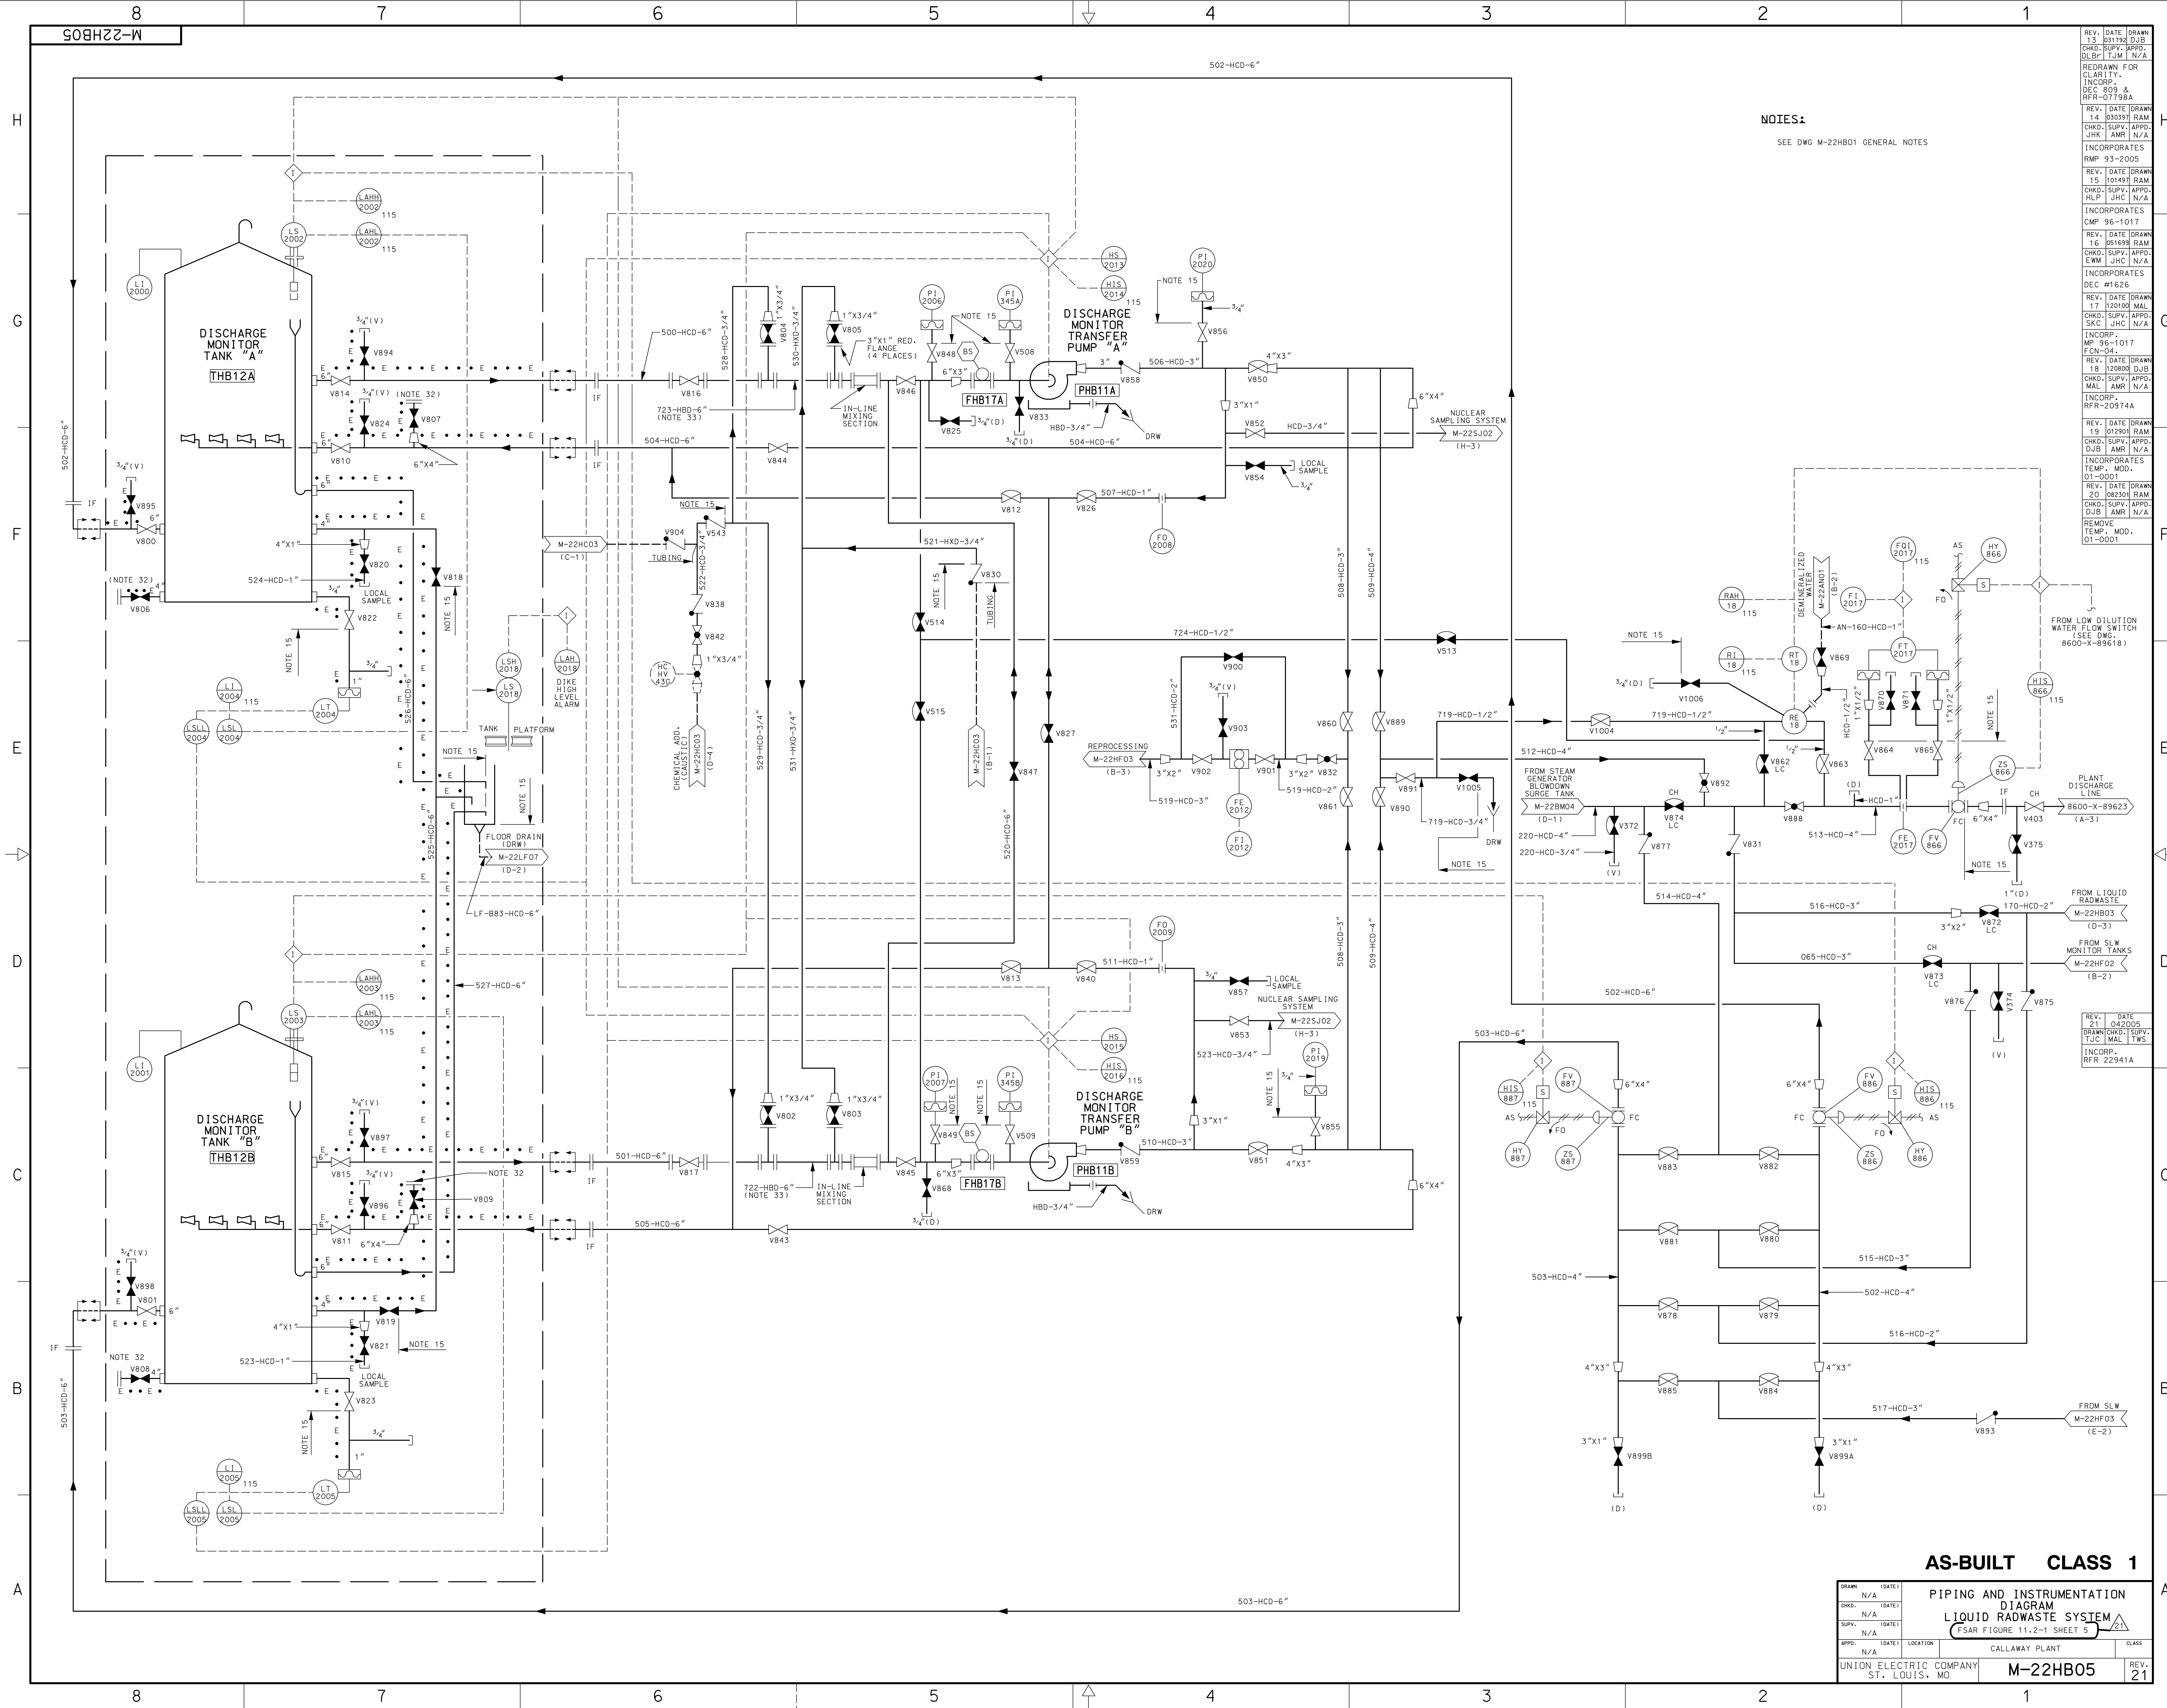

NOTES:


SEE DWG M-22HB01 GENERAL NOTES

| REV.                            | DATE   | DRAWN | CHKD. | SUPV. | APPD. | DLB | TJM | N/A |
|---------------------------------|--------|-------|-------|-------|-------|-----|-----|-----|
| 13                              | 031792 | DJB   |       |       |       |     |     |     |
| REDRAWN FOR CLARITY.            |        |       |       |       |       |     |     |     |
| INCORP. DEC 805 & RFR-07798A    |        |       |       |       |       |     |     |     |
| REV.                            | DATE   | DRAWN | CHKD. | SUPV. | APPD. | DLB | TJM | N/A |
| 14                              | 030397 | RAM   |       |       |       |     |     |     |
| INCORPORATES RMP 93-2005        |        |       |       |       |       |     |     |     |
| REV.                            | DATE   | DRAWN | CHKD. | SUPV. | APPD. | DLB | TJM | N/A |
| 15                              | 101497 | RAM   |       |       |       |     |     |     |
| INCORPORATES RMP 96-1017        |        |       |       |       |       |     |     |     |
| REV.                            | DATE   | DRAWN | CHKD. | SUPV. | APPD. | DLB | TJM | N/A |
| 16                              | 051699 | RAM   |       |       |       |     |     |     |
| INCORPORATES DEC #1626          |        |       |       |       |       |     |     |     |
| REV.                            | DATE   | DRAWN | CHKD. | SUPV. | APPD. | DLB | TJM | N/A |
| 17                              | 120100 | MAL   |       |       |       |     |     |     |
| INCORP. RFR-20974A              |        |       |       |       |       |     |     |     |
| REV.                            | DATE   | DRAWN | CHKD. | SUPV. | APPD. | DLB | TJM | N/A |
| 18                              | 120800 | DJB   |       |       |       |     |     |     |
| INCORPORATES TEMP. MOD. 01-0001 |        |       |       |       |       |     |     |     |
| REV.                            | DATE   | DRAWN | CHKD. | SUPV. | APPD. | DLB | TJM | N/A |
| 19                              | 012901 | RAM   |       |       |       |     |     |     |
| INCORPORATES TEMP. MOD. 01-0001 |        |       |       |       |       |     |     |     |
| REV.                            | DATE   | DRAWN | CHKD. | SUPV. | APPD. | DLB | TJM | N/A |
| 20                              | 082301 | RAM   |       |       |       |     |     |     |
| REMOVE TEMP. MOD. 01-0001       |        |       |       |       |       |     |     |     |

| REV.               | DATE   | DRAWN | CHKD. | SUPV. | APPD. | DLB | TJM | N/A |
|--------------------|--------|-------|-------|-------|-------|-----|-----|-----|
| 21                 | 042005 | MAL   |       |       |       |     |     |     |
| INCORP. RFR 22941A |        |       |       |       |       |     |     |     |


AS-BUILT CLASS 1

| DIAGN.                               | N/A | (DATE) | PIPING AND INSTRUMENTATION DIAGRAM | CLASS          |
|--------------------------------------|-----|--------|------------------------------------|----------------|
| CHKD.                                | N/A | (DATE) | LIQUID RADWASTE SYSTEM             |                |
| SUPV.                                | N/A | (DATE) | FSAR FIGURE 11.2-1 SHEET 5         |                |
| APPD.                                | N/A | (DATE) | LOCATION                           | CALLAWAY PLANT |
| UNION ELECTRIC COMPANY ST. LOUIS, MO |     |        |                                    | M-22HB05       |
|                                      |     |        |                                    | REV. 21        |

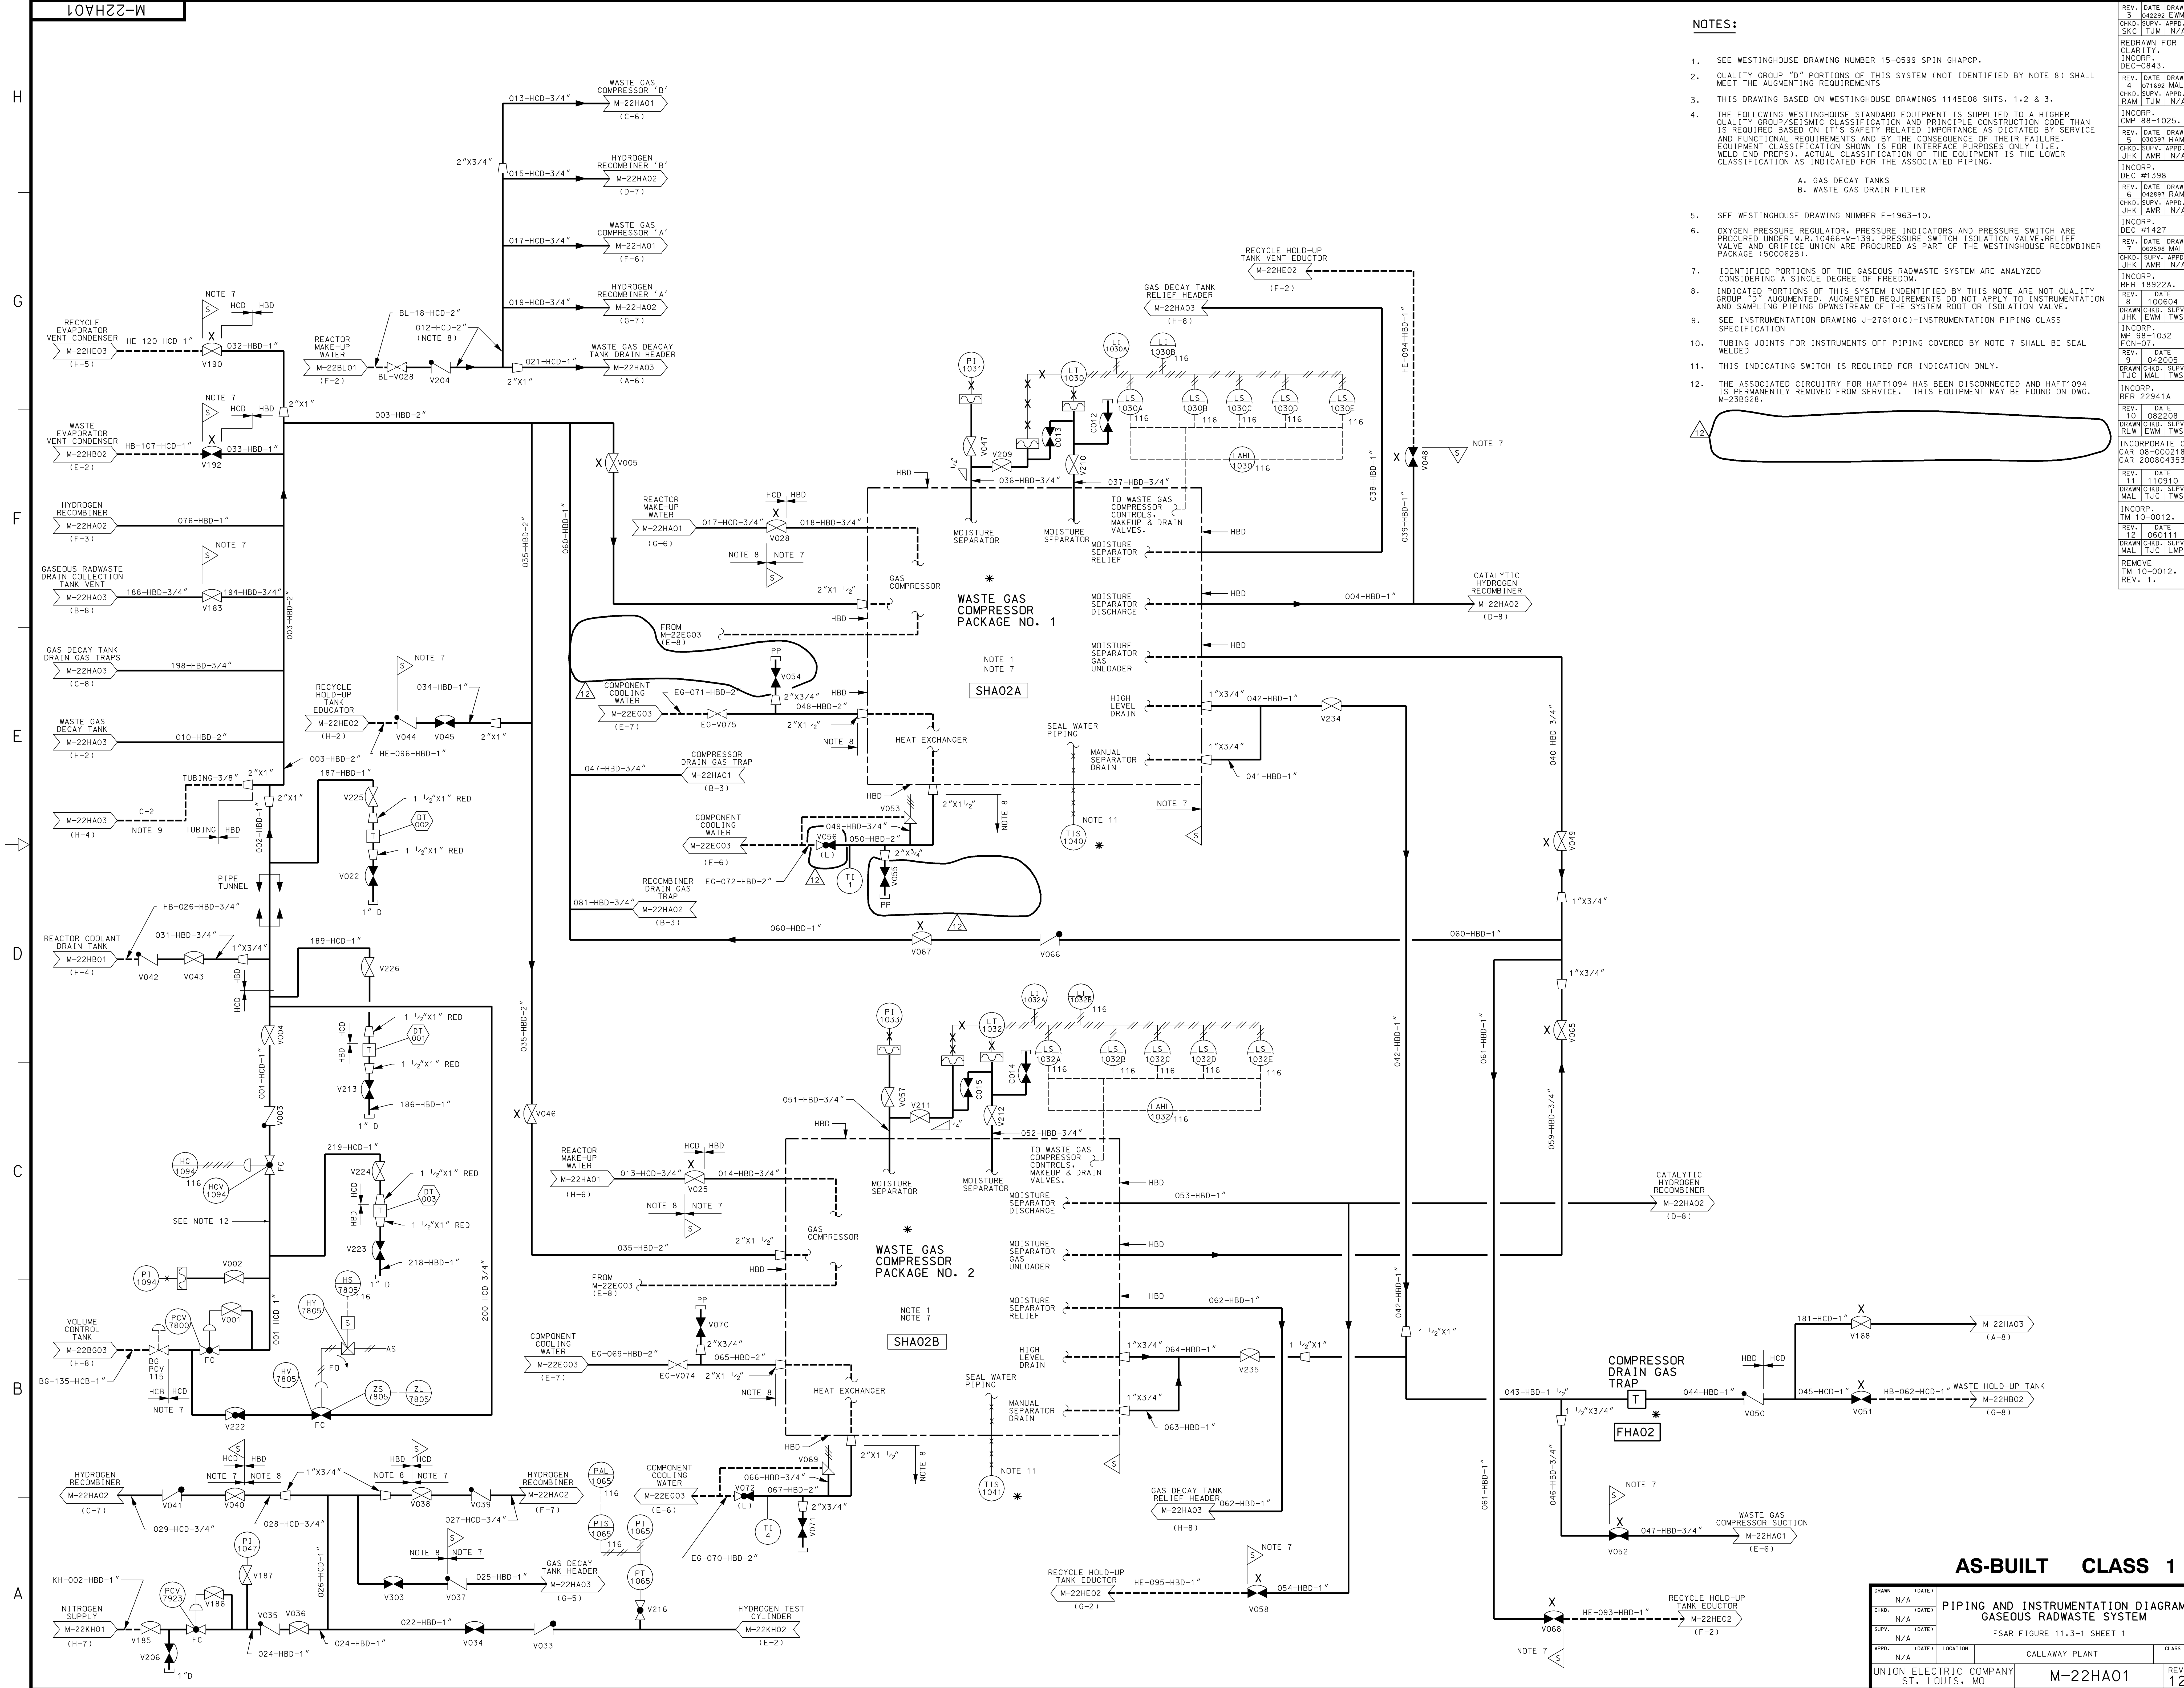


- NOTES:
- SEE WESTINGHOUSE DRAWING NUMBER 15-0999 SPIN GHAPCP.
  - QUALITY GROUP "D" PORTIONS OF THIS SYSTEM (NOT IDENTIFIED BY NOTE 8) SHALL MEET THE AUGMENTING REQUIREMENTS.
  - THIS DRAWING BASED ON WESTINGHOUSE DRAWINGS 1145E08 SHTS. 1,2 & 3.
  - THE FOLLOWING WESTINGHOUSE STANDARD EQUIPMENT IS SUPPLIED TO A HIGHER QUALITY GROUP/SEISMIC CLASSIFICATION AND PRINCIPLE CONSTRUCTION CODE THAN IS REQUIRED BASED ON IT'S SAFETY RELATED IMPORTANCE AS DICTATED BY SERVICE AND FUNCTIONAL REQUIREMENTS AND BY THE CONSEQUENCE OF THEIR FAILURE. EQUIPMENT CLASSIFICATION SHOWN IS FOR INTERFACE PURPOSES ONLY (I.E. WELD END PREPS). ACTUAL CLASSIFICATION OF THE EQUIPMENT IS THE LOWER CLASSIFICATION AS INDICATED FOR THE ASSOCIATED PIPING.
    - A. GAS DECAY TANKS
    - B. WASTE GAS DRAIN FILTER
  - SEE WESTINGHOUSE DRAWING NUMBER F-1963-10.
  - OXYGEN PRESSURE REGULATOR, PRESSURE INDICATORS AND PRESSURE SWITCH ARE PROCURED UNDER M.R.10466-M-139. PRESSURE SWITCH ISOLATION VALVE,RELIEF VALVE AND ORIFICE UNION ARE PROCURED AS PART OF THE WESTINGHOUSE RECOMBINER PACKAGE (500062B).
  - IDENTIFIED PORTIONS OF THE GASEOUS RADWASTE SYSTEM ARE ANALYZED CONSIDERING A SINGLE DEGREE OF FREEDOM.
  - INDICATED PORTIONS OF THIS SYSTEM IDENTIFIED BY THIS NOTE ARE NOT QUALITY GROUP "D" AUGMENTED. AUGMENTED REQUIREMENTS DO NOT APPLY TO INSTRUMENTATION AND SAMPLING PIPING DOWNSTREAM OF THE SYSTEM ROOT OR ISOLATION VALVE.
  - SEE INSTRUMENTATION DRAWING J-27G10(Q)-INSTRUMENTATION PIPING CLASS SPECIFICATION
  - TUBING JOINTS FOR INSTRUMENTS OFF PIPING COVERED BY NOTE 7 SHALL BE SEAL WELDED
  - THIS INDICATING SWITCH IS REQUIRED FOR INDICATION ONLY.
  - THE ASSOCIATED CIRCUITRY FOR HAF1094 HAS BEEN DISCONNECTED AND HAF1094 IS PERMANENTLY REMOVED FROM SERVICE. THIS EQUIPMENT MAY BE FOUND ON DWG. M-23B628.


| AS-BUILT CLASS 1       |  |        |  |                                                                                             |  |
|------------------------|--|--------|--|---------------------------------------------------------------------------------------------|--|
| DRAWN                  |  | (DATE) |  | PIPING AND INSTRUMENTATION DIAGRAM<br>GASEOUS RADWASTE SYSTEM<br>FSAR FIGURE 11.3-1 SHEET 1 |  |
| N/A                    |  |        |  |                                                                                             |  |
| CHKD.                  |  | (DATE) |  |                                                                                             |  |
| N/A                    |  |        |  |                                                                                             |  |
| SUPV.                  |  | (DATE) |  |                                                                                             |  |
| N/A                    |  |        |  |                                                                                             |  |
| APPD.                  |  | (DATE) |  | LOCATION                                                                                    |  |
| N/A                    |  |        |  | CALLAWAY PLANT                                                                              |  |
| UNION ELECTRIC COMPANY |  |        |  | CLASS                                                                                       |  |
| ST. LOUIS, MO          |  |        |  | REV                                                                                         |  |
| M-22HA01               |  |        |  | 12                                                                                          |  |

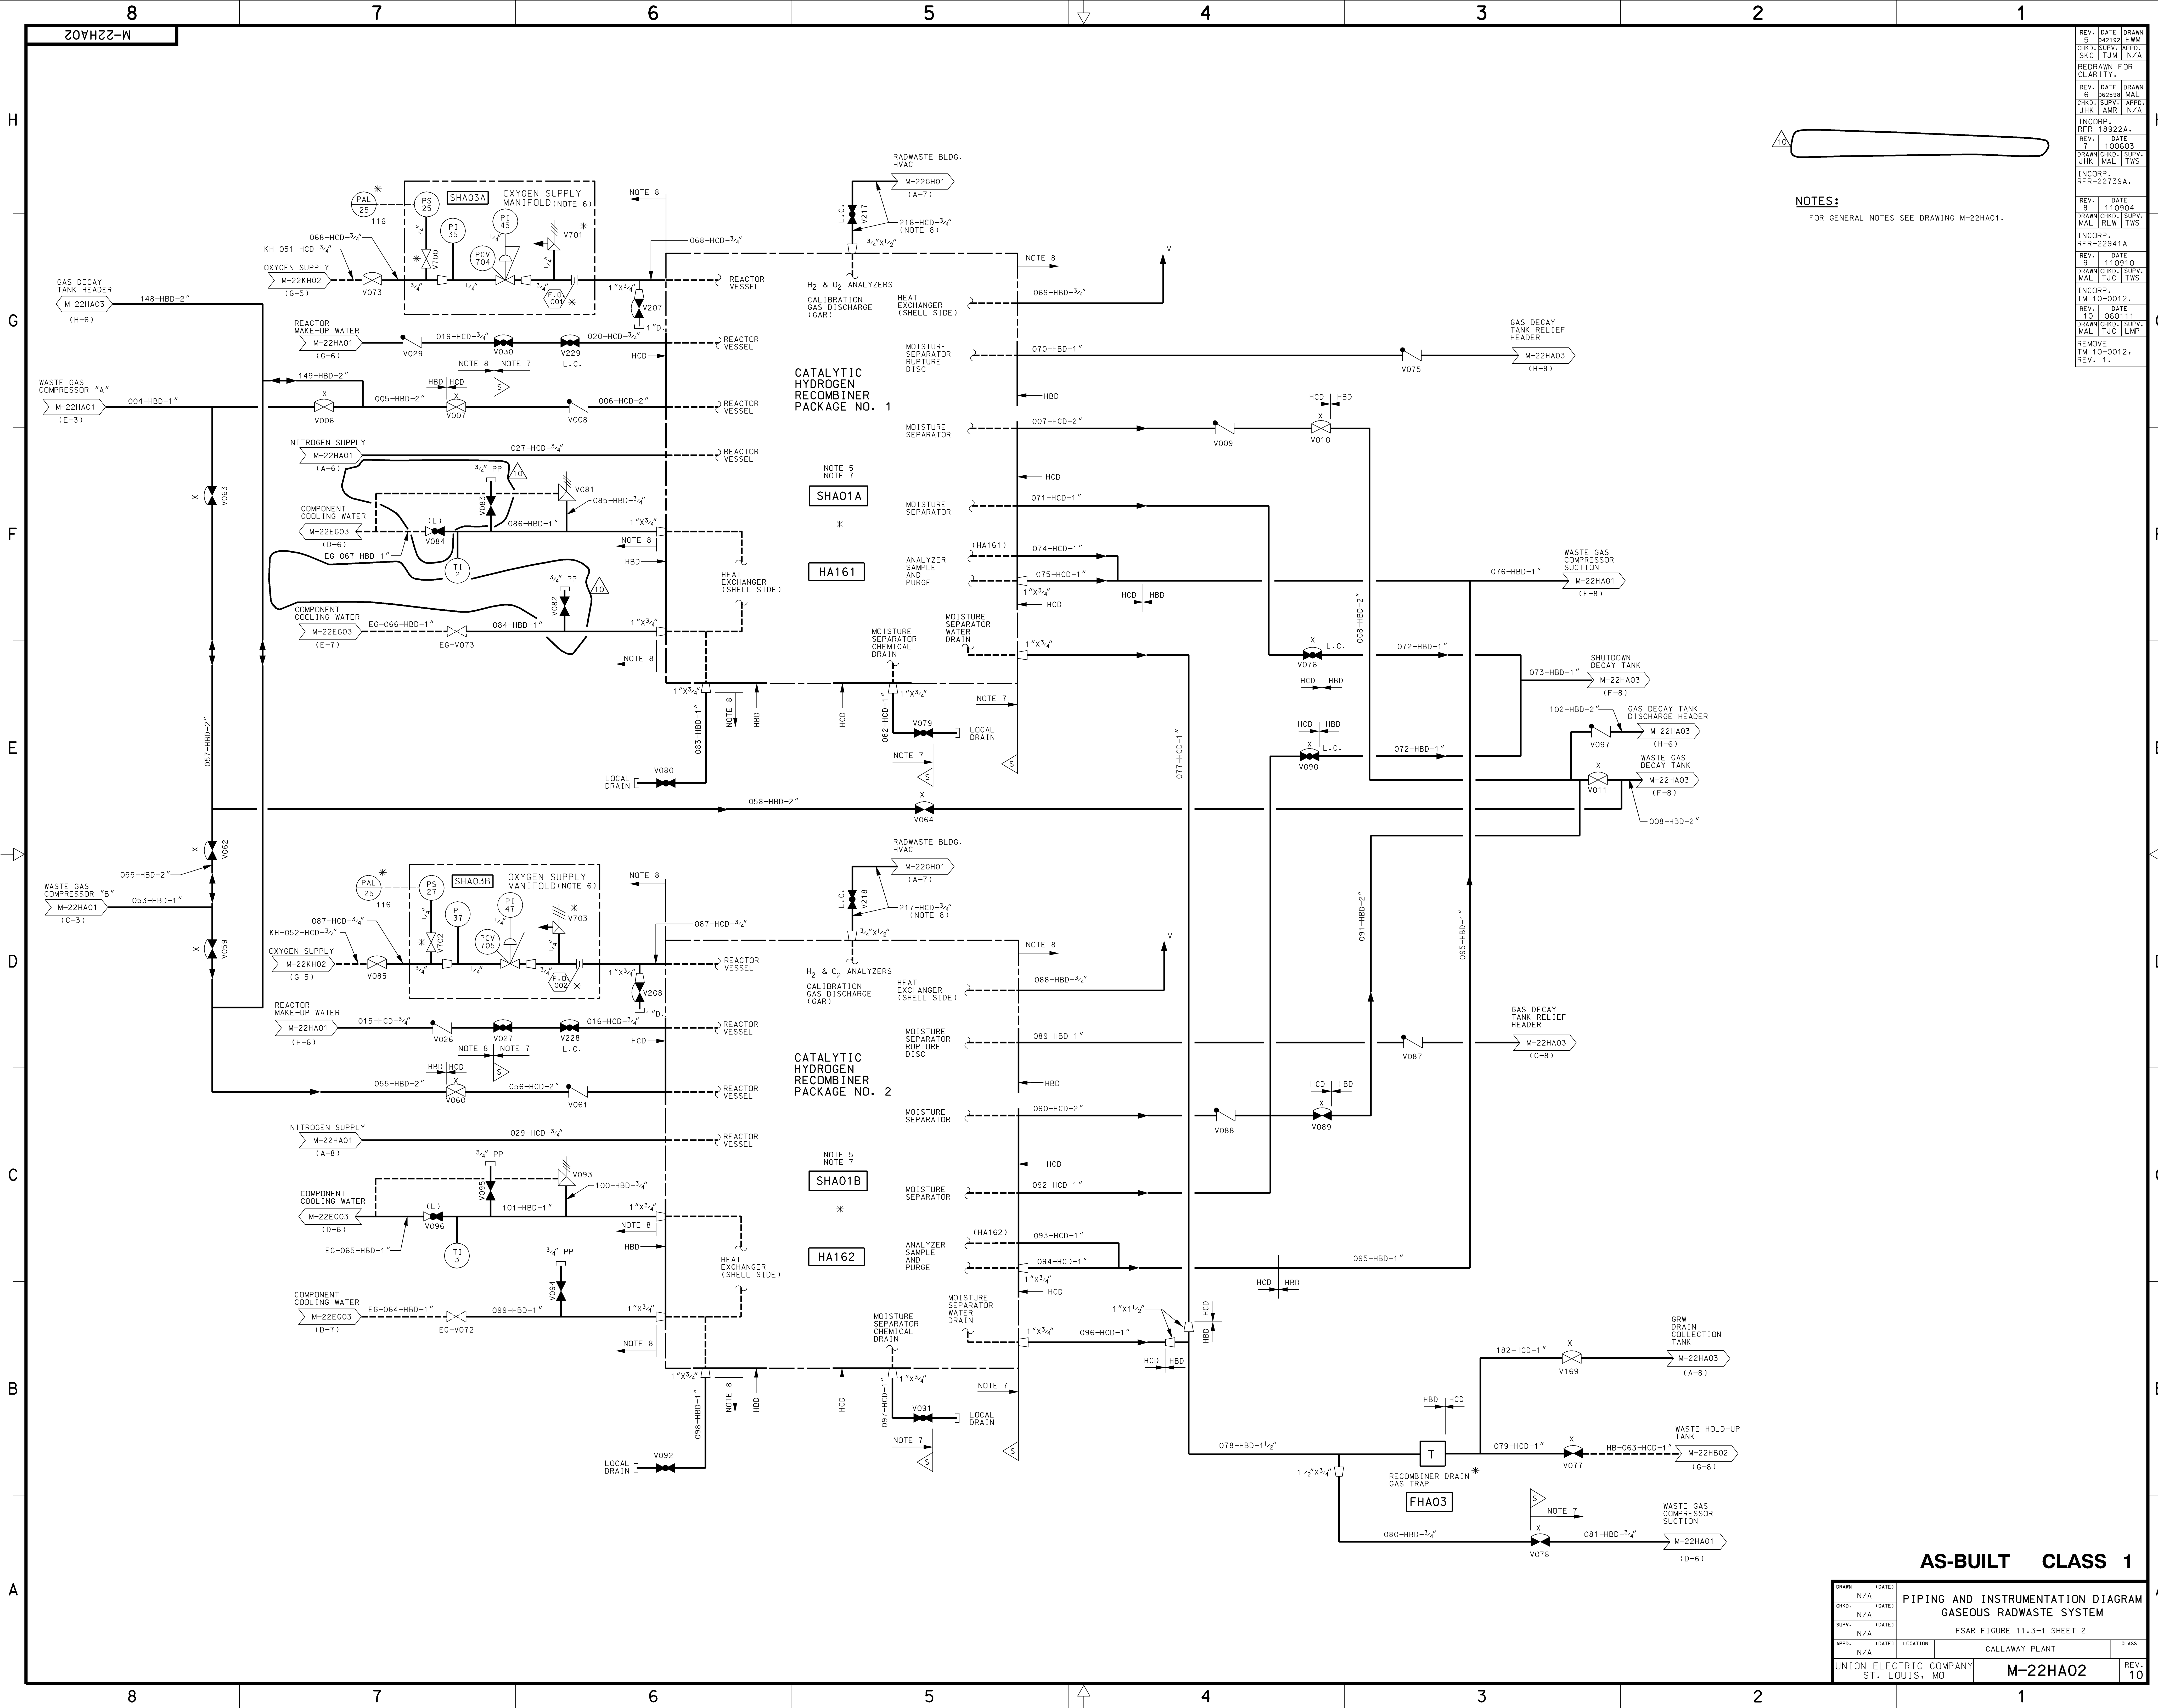

NOTES:  
FOR GENERAL NOTES SEE DRAWING M-22HA01.

| AS-BUILT CLASS 1           |  | DRAWING                 |  | DATE                               |  |
|----------------------------|--|-------------------------|--|------------------------------------|--|
| DRAWN                      |  | N/A                     |  | (DATE)                             |  |
| CHKD.                      |  | N/A                     |  | (DATE)                             |  |
| SURV.                      |  | N/A                     |  | (DATE)                             |  |
| APPR.                      |  | N/A                     |  | (DATE)                             |  |
| UNION ELECTRIC COMPANY     |  | ST. LOUIS, MO           |  | REV. 10                            |  |
| M-22HA02                   |  | CALLAWAY PLANT          |  | CLASS                              |  |
| FSAR FIGURE 11.3-1 SHEET 2 |  | GASEOUS RADWASTE SYSTEM |  | Piping and Instrumentation Diagram |  |

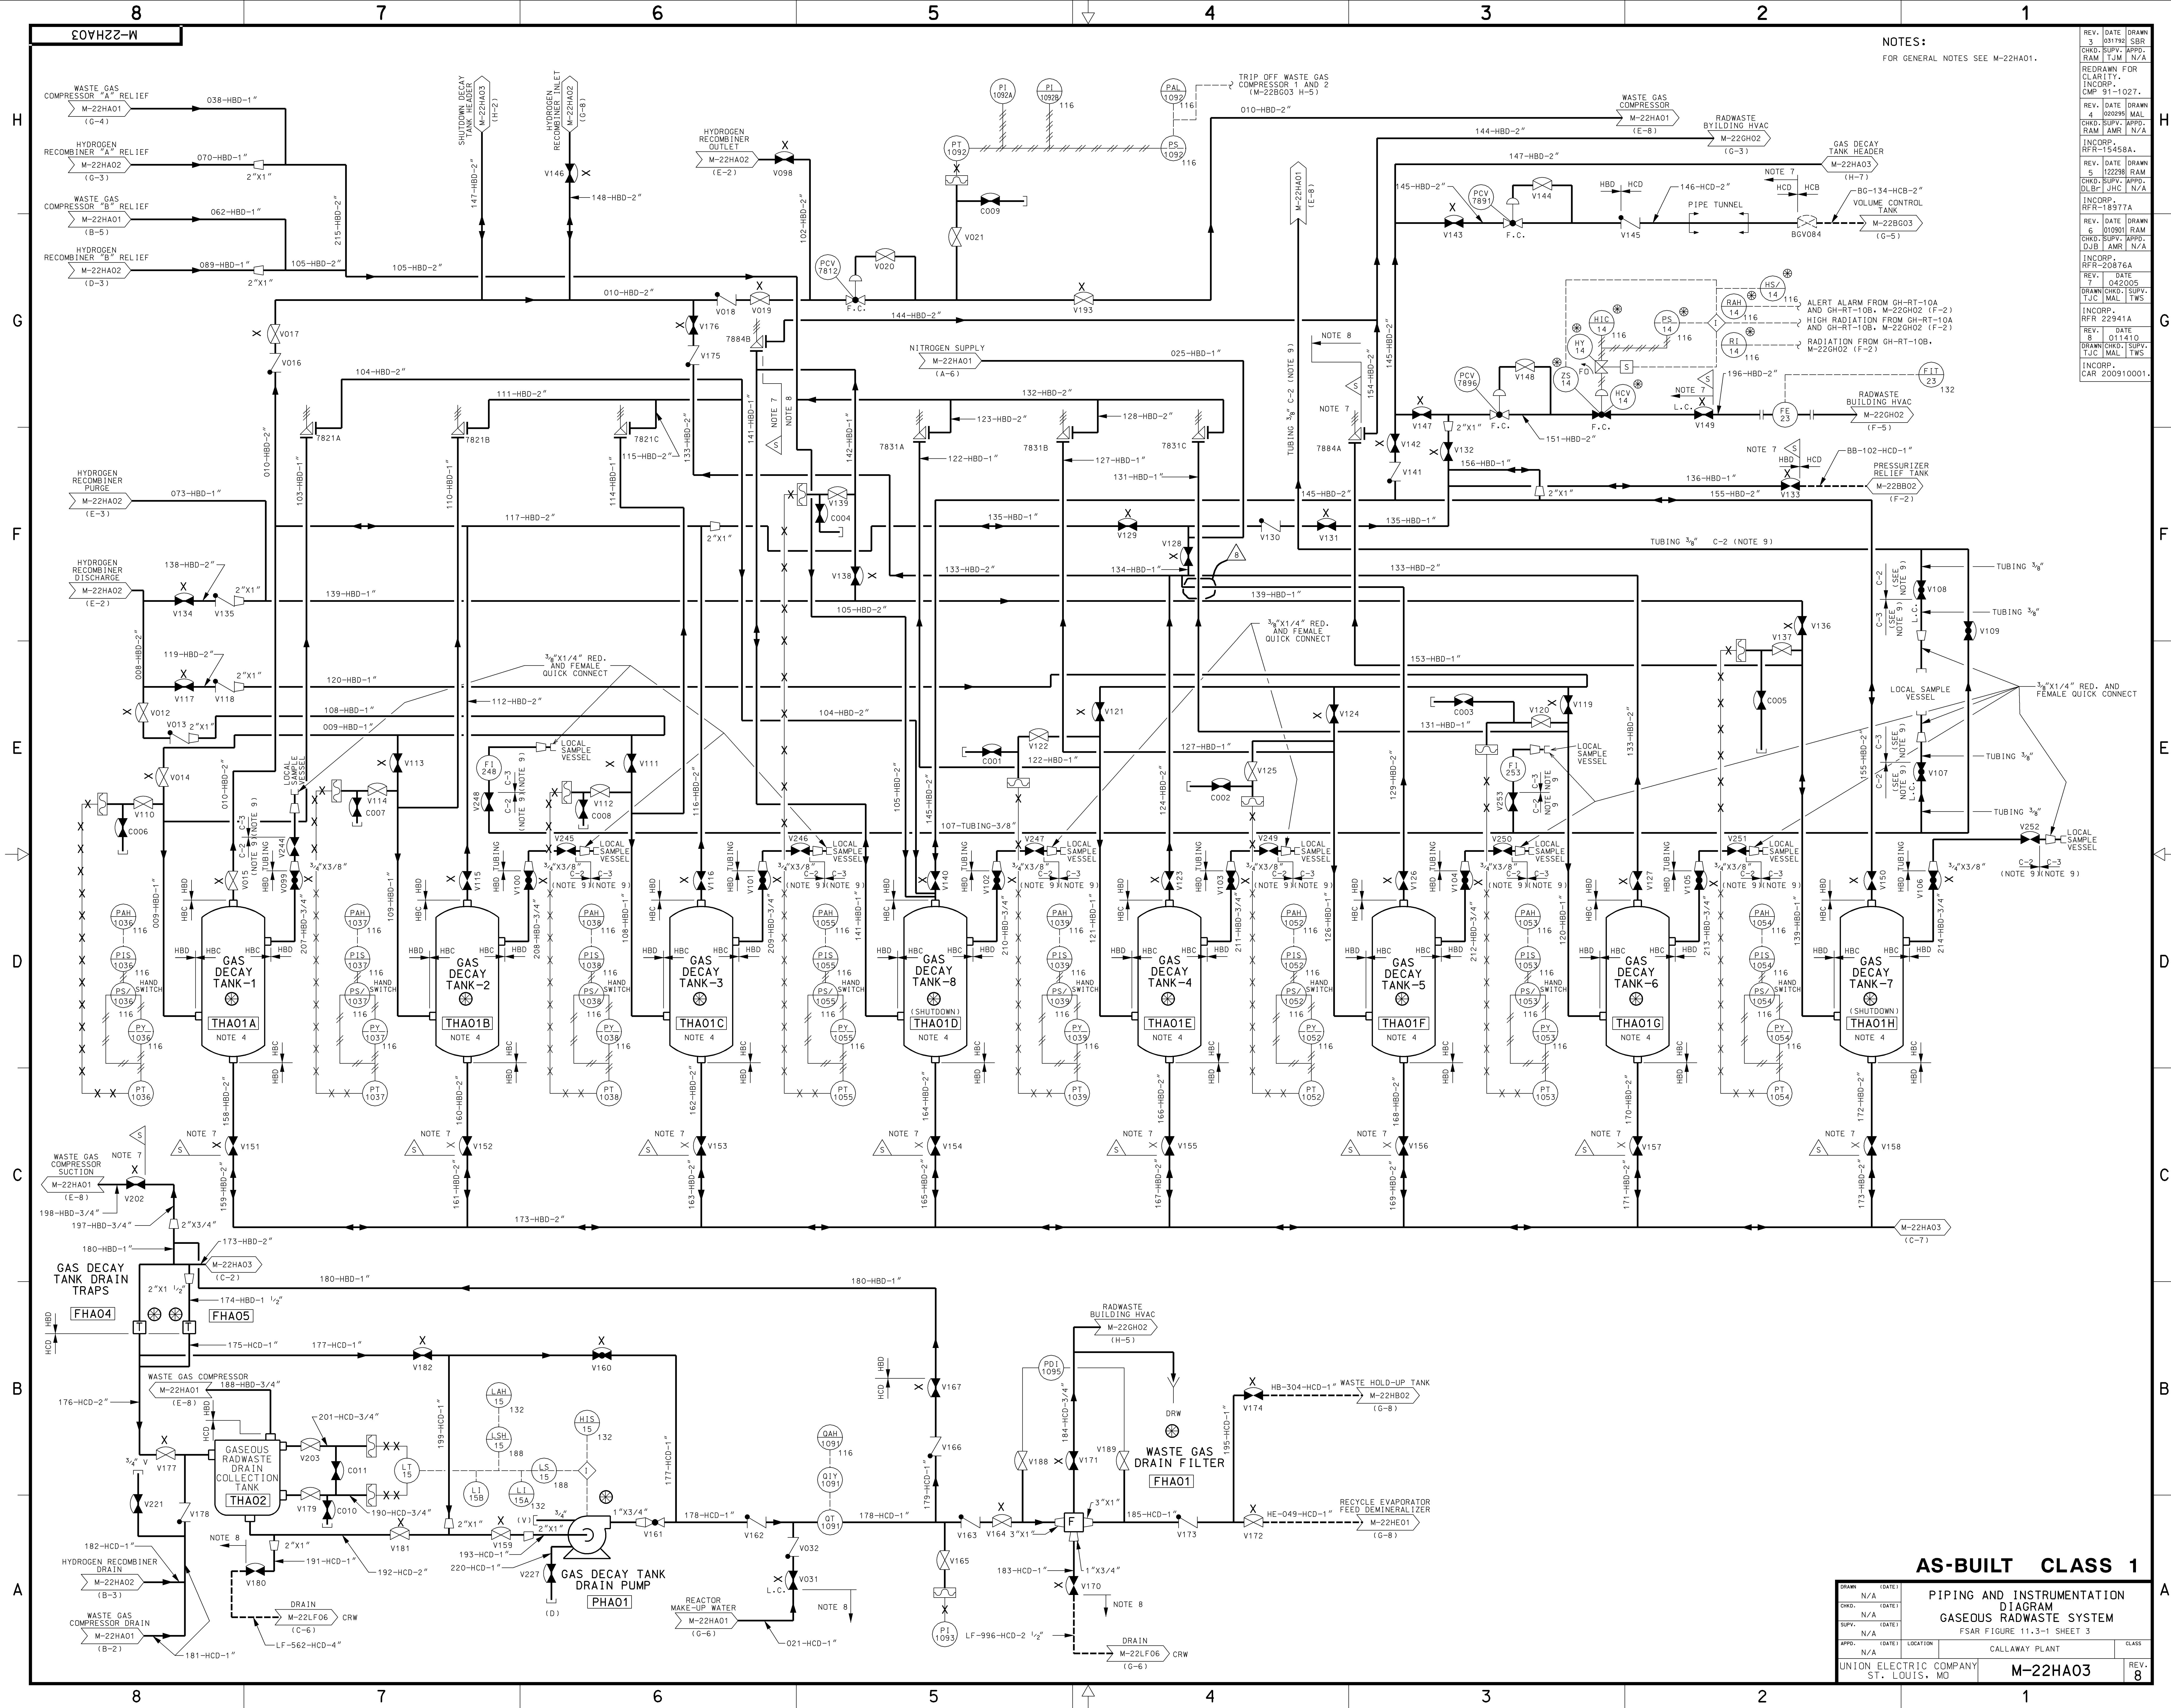


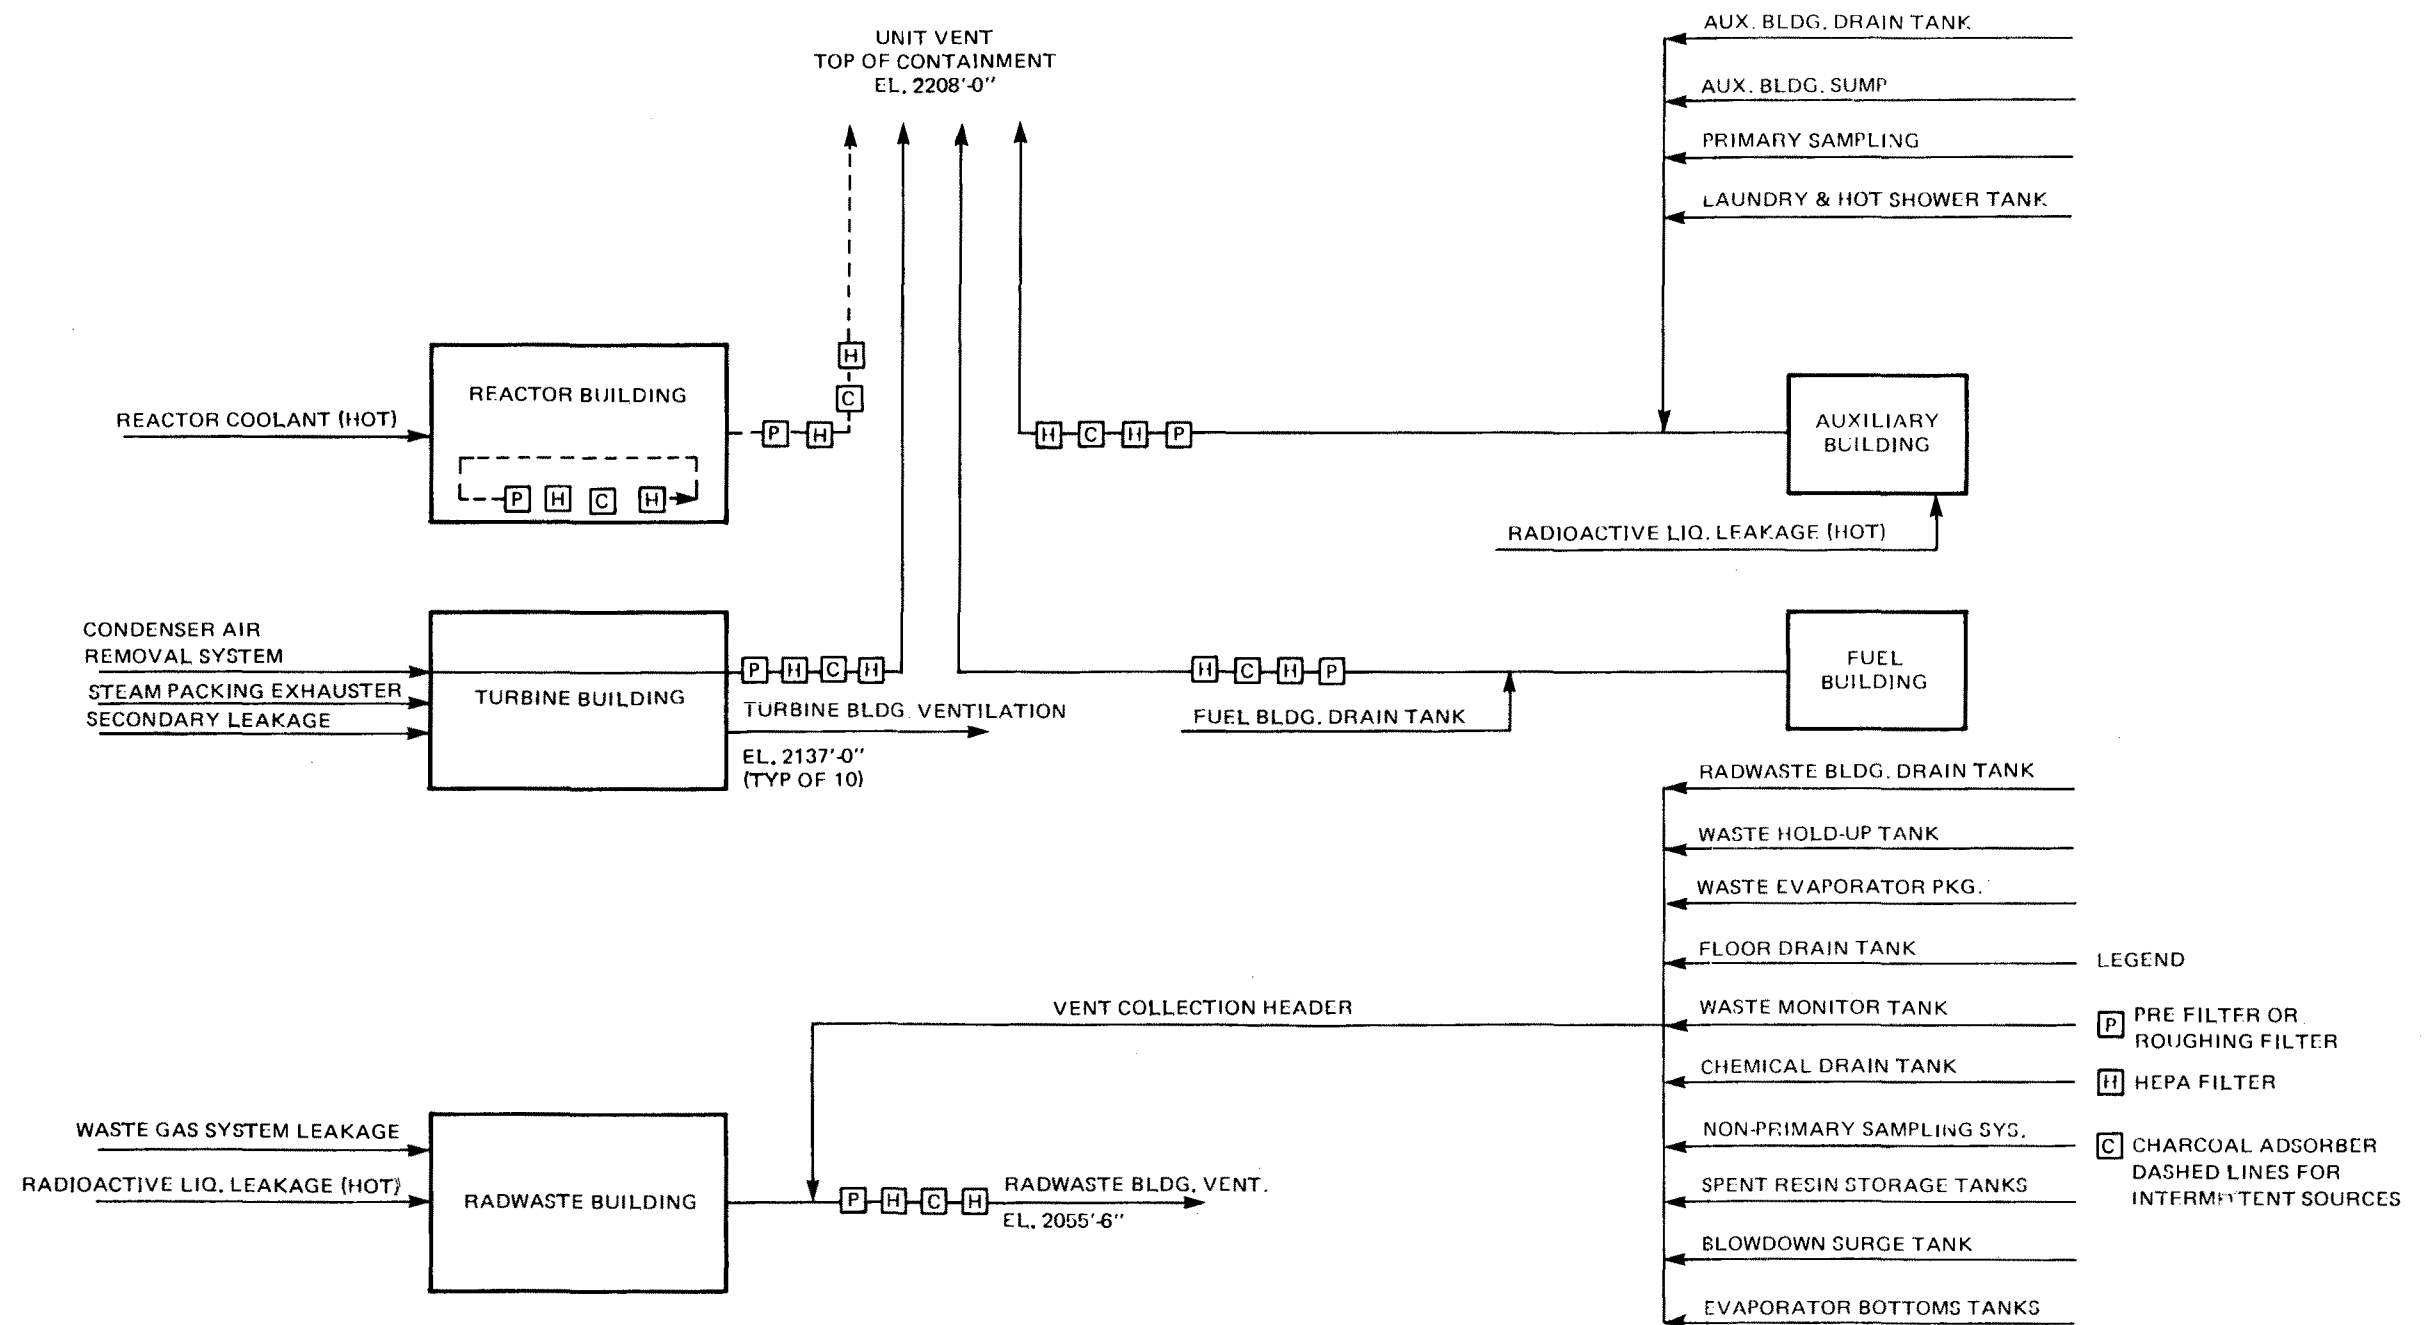

Rev. OL-0  
6/86

## CALLAWAY PLANT


FIGURE 11.3-2  
POTENTIAL GASEOUS RELEASE

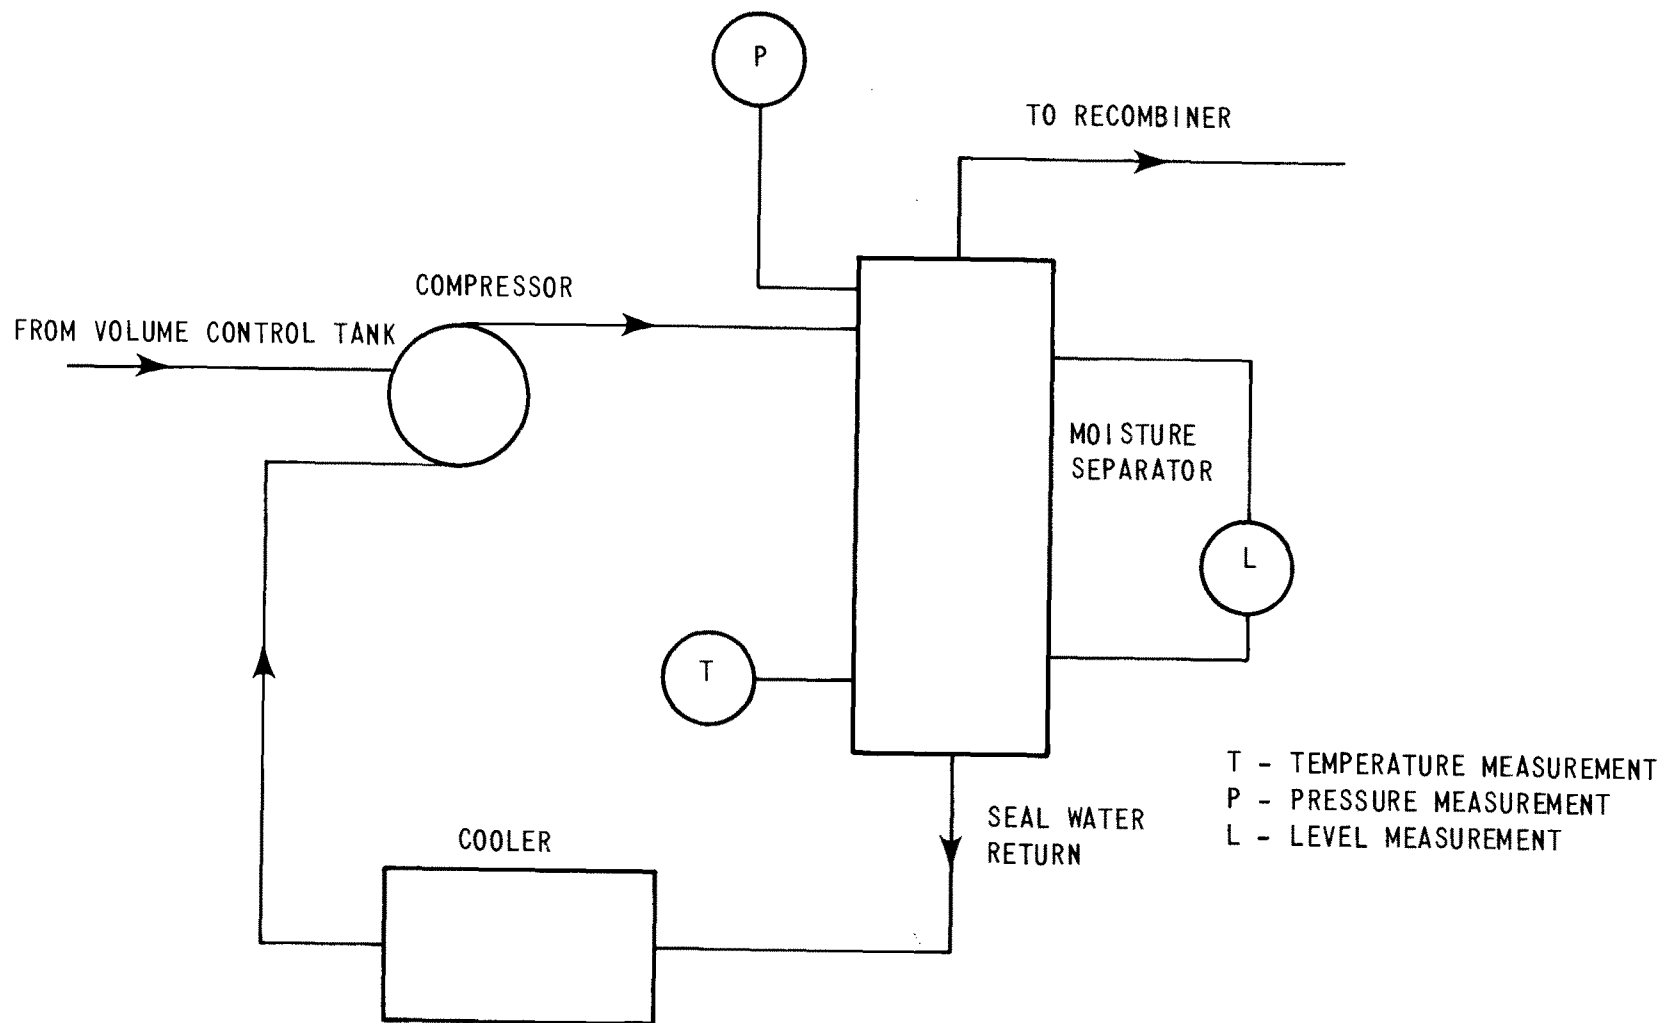

Rev. OL-0  
6/86

### CALLAWAY PLANT


FIGURE 11.3-3  
COMPRESSOR PACKAGE INSTRUMENTS

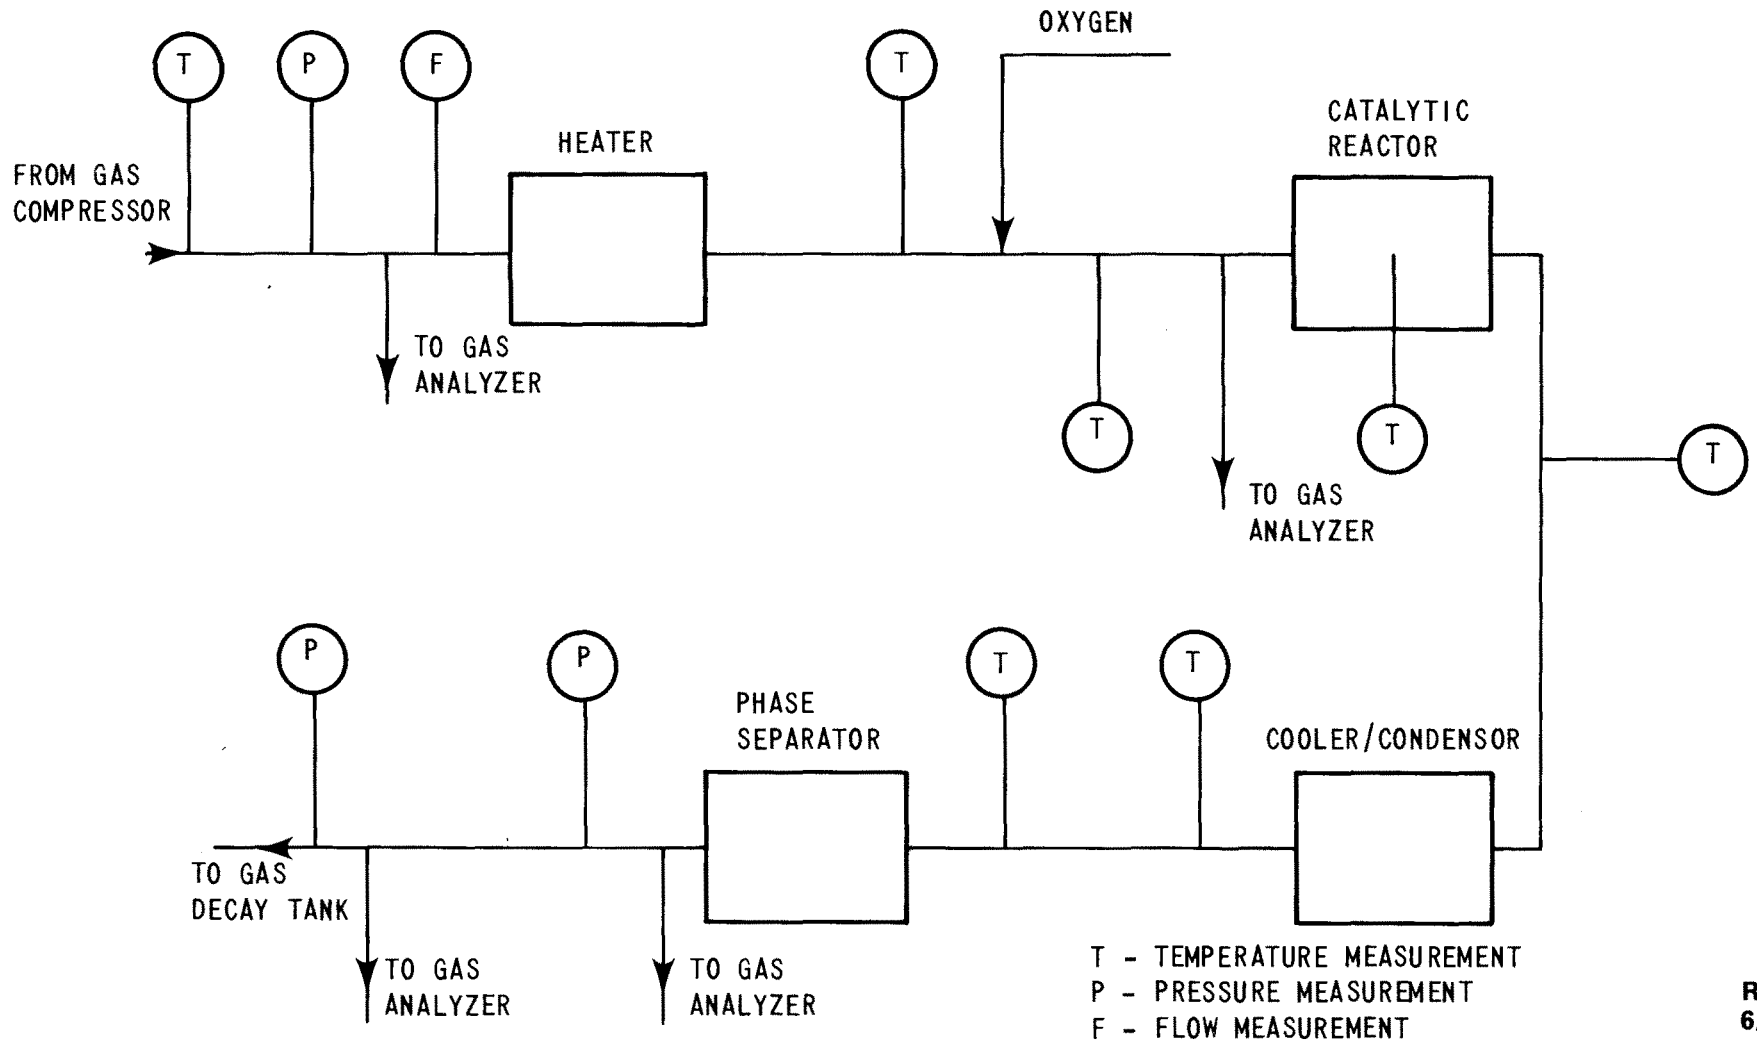

Rev. OL-0  
6/86

### CALLAWAY PLANT

FIGURE 11.3-4  
HYDROGEN RECOMBINER INSTRUMENTS

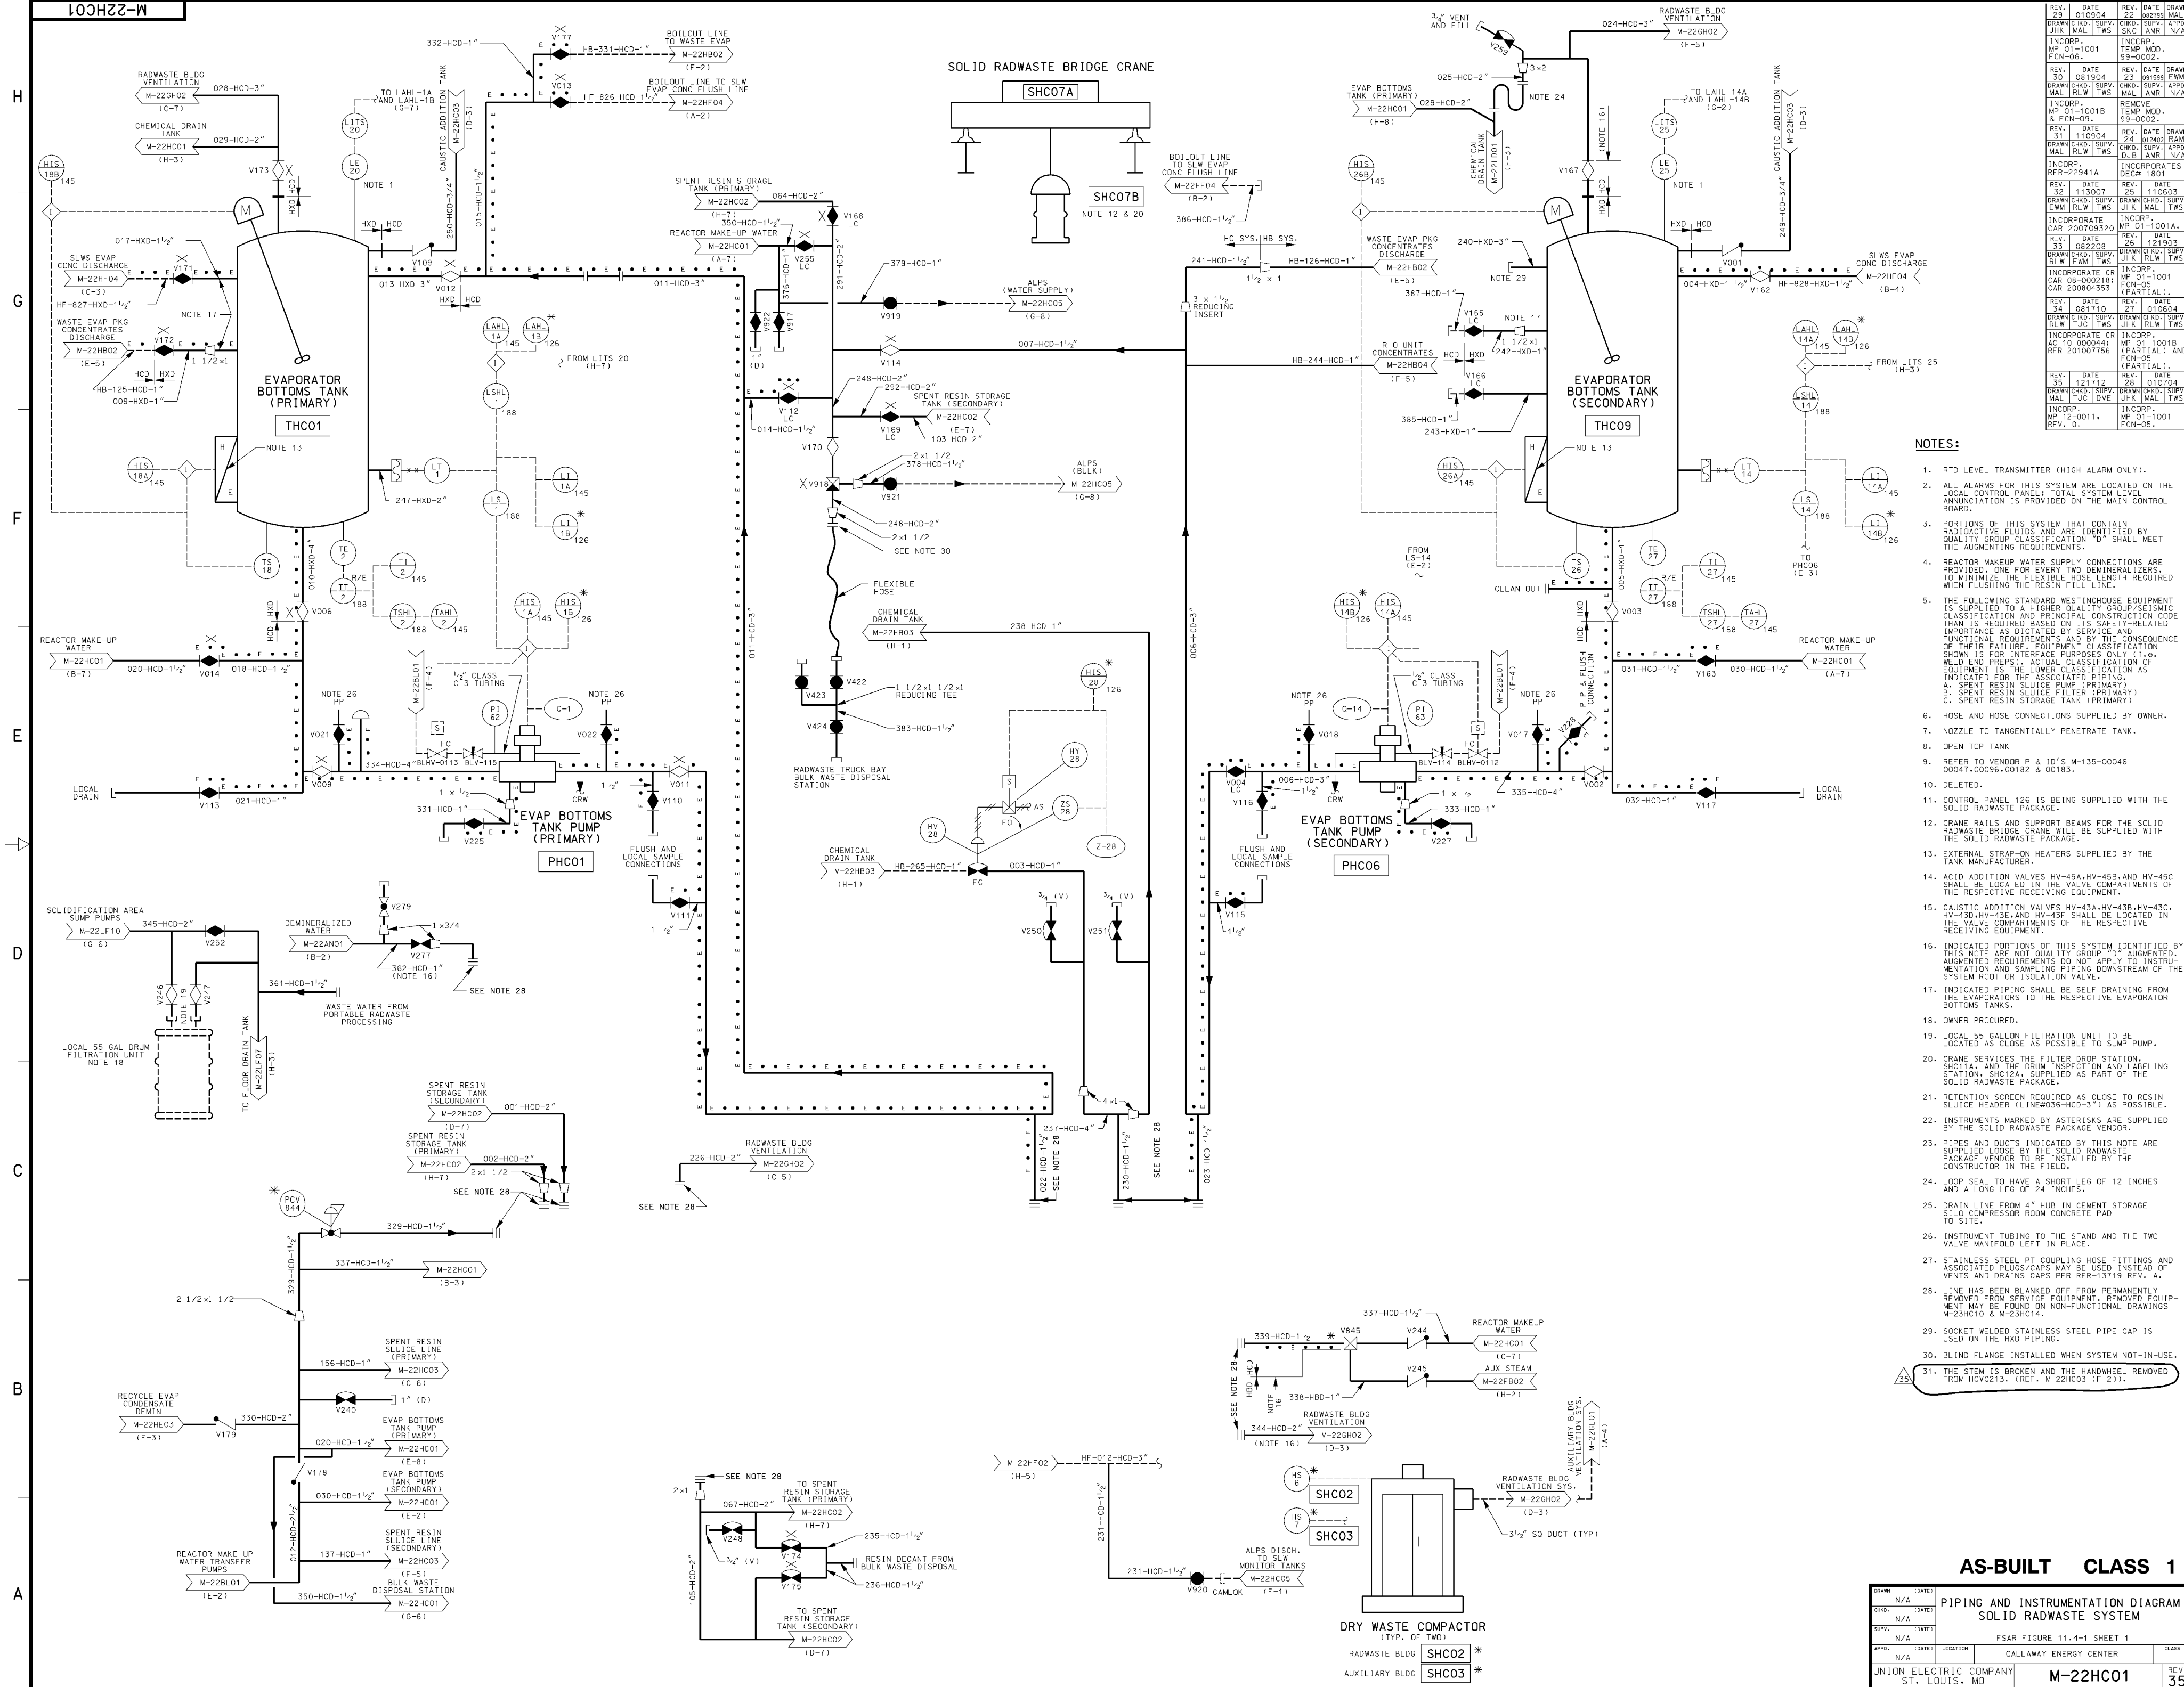


- NOTES:**
- RTD LEVEL TRANSMITTER (HIGH ALARM ONLY).
  - ALL ALARMS FOR THIS SYSTEM ARE LOCATED ON THE LOCAL CONTROL PANEL; TOTAL SYSTEM LEVEL ANNUNCIATION IS PROVIDED ON THE MAIN CONTROL BOARD.
  - PORTIONS OF THIS SYSTEM THAT CONTAIN RADIOACTIVE FLUIDS AND ARE IDENTIFIED BY QUALITY GROUP CLASSIFICATION "D" SHALL MEET THE AUGMENTED REQUIREMENTS.
  - REACTOR MAKEUP WATER SUPPLY CONNECTIONS ARE PROVIDED, ONE FOR EVERY TWO DEMINERALIZERS, TO MINIMIZE THE FLEXIBLE HOSE LENGTH REQUIRED WHEN FLUSHING THE RESIN FILL LINE.
  - THE FOLLOWING STANDARD WESTINGHOUSE EQUIPMENT IS SUPPLIED TO A HIGHER QUALITY GROUP/SEISMIC CLASSIFICATION AND PRINCIPAL CONSTRUCTION CODE THAN IS REQUIRED BASED ON ITS SAFETY RELATED IMPORTANCE AS DICTATED BY SERVICE AND FUNCTIONAL REQUIREMENTS AND BY THE CONSEQUENCE OF THEIR FAILURE. EQUIPMENT CLASSIFICATION SHOWN IS FOR INTERFACE PURPOSES ONLY (I.e. WELD END PREPS). ACTUAL CLASSIFICATION OF EQUIPMENT IS THE LOWER CLASSIFICATION AS INDICATED FOR THE APPLICABLE RECEIVING EQUIPMENT:  
A. SPENT RESIN SLUICE PUMP (PRIMARY)  
B. SPENT RESIN SLUICE FILTER (PRIMARY)  
C. SPENT RESIN STORAGE TANK (PRIMARY)
  - HOSE AND HOSE CONNECTIONS SUPPLIED BY OWNER.
  - NOZZLE TO TANGENTIALLY PENETRATE TANK.
  - OPEN TOP TANK.
  - REFER TO VENDOR P & ID'S M-135-00046 00047, 00096, 00182 & 00183.
  - DELETED.
  - CONTROL PANEL 126 IS BEING SUPPLIED WITH THE SOLID RADWASTE PACKAGE.
  - CRANE RAILS AND SUPPORT BEAMS FOR THE SOLID RADWASTE BRIDGE CRANE WILL BE SUPPLIED WITH THE SOLID RADWASTE PACKAGE.
  - EXTERNAL STRAP-ON HEATERS SUPPLIED BY THE TANK MANUFACTURER.
  - ACID ADDITION VALVES HV-45A, HV-45B, AND HV-45C SHALL BE LOCATED IN THE VALVE COMPARTMENTS OF THE RESPECTIVE RECEIVING EQUIPMENT.
  - CAUSTIC ADDITION VALVES HV-43A, HV-43B, HV-43C, HV-43D, HV-43E, AND HV-43F SHALL BE LOCATED IN THE VALVE COMPARTMENTS OF THE RESPECTIVE RECEIVING EQUIPMENT.
  - INDICATED PORTIONS OF THIS SYSTEM IDENTIFIED BY THIS NOTE ARE NOT QUALITY GROUP "D" AUGMENTED. AUGMENTED REQUIREMENTS DO NOT APPLY TO INSTRUMENTATION AND SAMPLING PIPING DOWNSTREAM OF THE SYSTEM ROOT OR ISOLATION VALVE.
  - INDICATED PIPING SHALL BE SELF DRAINING FROM THE EVAPORATORS TO THE RESPECTIVE EVAPORATOR BOTTOMS TANKS.
  - OWNER PROCURED.
  - LOCAL 55 GALLON FILTRATION UNIT TO BE LOCATED AS CLOSE AS POSSIBLE TO SUMP PUMP.
  - CRANE SERVICES THE FILTER DROP STATION, SHC11A, AND THE DRUM INSPECTION AND LABELING STATION, SHC12A, SUPPLIED AS PART OF THE SOLID RADWASTE PACKAGE.
  - RETENTION SCREEN REQUIRED AS CLOSE TO RESIN SLUICE HEADER (LINE#036-HCD-3") AS POSSIBLE.
  - INSTRUMENTS MARKED BY ASTERISKS ARE SUPPLIED BY THE SOLID RADWASTE PACKAGE VENDOR.
  - PIPES AND DUCTS INDICATED BY THIS NOTE ARE SUPPLIED LOOSE BY THE SOLID RADWASTE PACKAGE VENDOR TO BE INSTALLED BY THE CONSTRUCTOR IN THE FIELD.
  - LOOP SEAL TO HAVE A SHORT LEG OF 12 INCHES AND A LONG LEG OF 24 INCHES.
  - DRAIN LINE FROM 4" HUB IN CEMENT STORAGE SILD COMPRESSOR ROOM CONCRETE PAD TO SITE.
  - INSTRUMENT TUBING TO THE STAND AND THE TWO VALVE MANIFOLD LEFT IN PLACE.
  - STAINLESS STEEL PT. COUPLING HOSE FITTINGS AND ASSOCIATED PLUGS/CAPS MAY BE USED INSTEAD OF VENTS AND DRAINS CAPS PER RFR-13719 REV. 4.
  - LINE HAS BEEN BLANKED OFF FROM PERMANENTLY REMOVED FROM SERVICE EQUIPMENT. REMOVED EQUIPMENT MAY BE FOUND ON NON-FUNCTIONAL DRAWINGS M-22HC10 & M-22HC14.
  - SOCKET WELDED STAINLESS STEEL PIPE CAP IS USED ON THE HXD PIPING.
  - BLIND FLANGE INSTALLED WHEN SYSTEM NOT-IN-USE.
  - THE STEM IS BROKEN AND THE HANDWHEEL REMOVED FROM HCD0213. (REF. M-22HC03 IF-21).

|            |                |             |             |            |
|------------|----------------|-------------|-------------|------------|
| REV. 29    | DATE 010304    | REV. 22     | DATE 082993 | DRWN MAJ   |
| DRAWN: JHK | CRD: SUPV. JHK | MAJ TWS     | SKC AMR     | N/TA       |
| INCRP.     | MP 01-1001     | TEMP MOD.   | 99-0002.    |            |
| FCN-06.    |                |             |             |            |
| REV. 30    | DATE 081304    | REV. 23     | DATE 091593 | DRWN EWM   |
| DRAWN: JHK | CRD: SUPV. MAL | RLW TWS     | MAJ AMR     | N/TA       |
| INCRP.     | MP 01-1001A    | REMOVE      |             |            |
| FCN-09.    |                | TEMP MOD.   | 99-0002.    |            |
| REV. 31    | DATE 111004    | REV. 24     | DATE 010204 | DRWN RAM   |
| DRAWN: JHK | CRD: SUPV. MAL | RLW TWS     | DJ3 AMR     | N/TA       |
| INCRP.     | MP 01-1001A    | INCRPORATES |             |            |
| FCN-09.    |                | DECF 1801   |             |            |
| REV. 32    | DATE 130007    | REV. 25     | DATE 110603 | DRWN JHK   |
| DRAWN: JHK | CRD: SUPV. EWM | RLW TWS     |             |            |
| INCRP.     | MP 01-1001A.   |             |             |            |
| FCN-09.    |                |             |             |            |
| REV. 33    | DATE 082208    | REV. 26     | DATE 121903 | DRWN JHK   |
| DRAWN: JHK | CRD: SUPV. EWM | RLW TWS     |             |            |
| INCRP.     | MP 01-1001     |             |             |            |
| FCN-05.    |                |             |             |            |
| REV. 34    | DATE 081710    | REV. 27     | DATE 010604 | DRAWN: JHK |
| DRAWN: JHK | CRD: SUPV. RLW | TWS TWS     |             |            |
| INCRP.     | MP 01-1001B    |             |             |            |
| FCN-05.    |                |             |             |            |
| REV. 35    | DATE 121712    | REV. 28     | DATE 010704 | DRAWN: JHK |
| DRAWN: JHK | CRD: SUPV. MAL | TWS DNE     |             |            |
| INCRP.     | MP 12-0011.    |             |             |            |
| FCN-05.    |                |             |             |            |

SLWS EVAP  
C/D DISCHARGE  
A-22HF04  
(B-4)

FROM LITS 25  
(H-3)

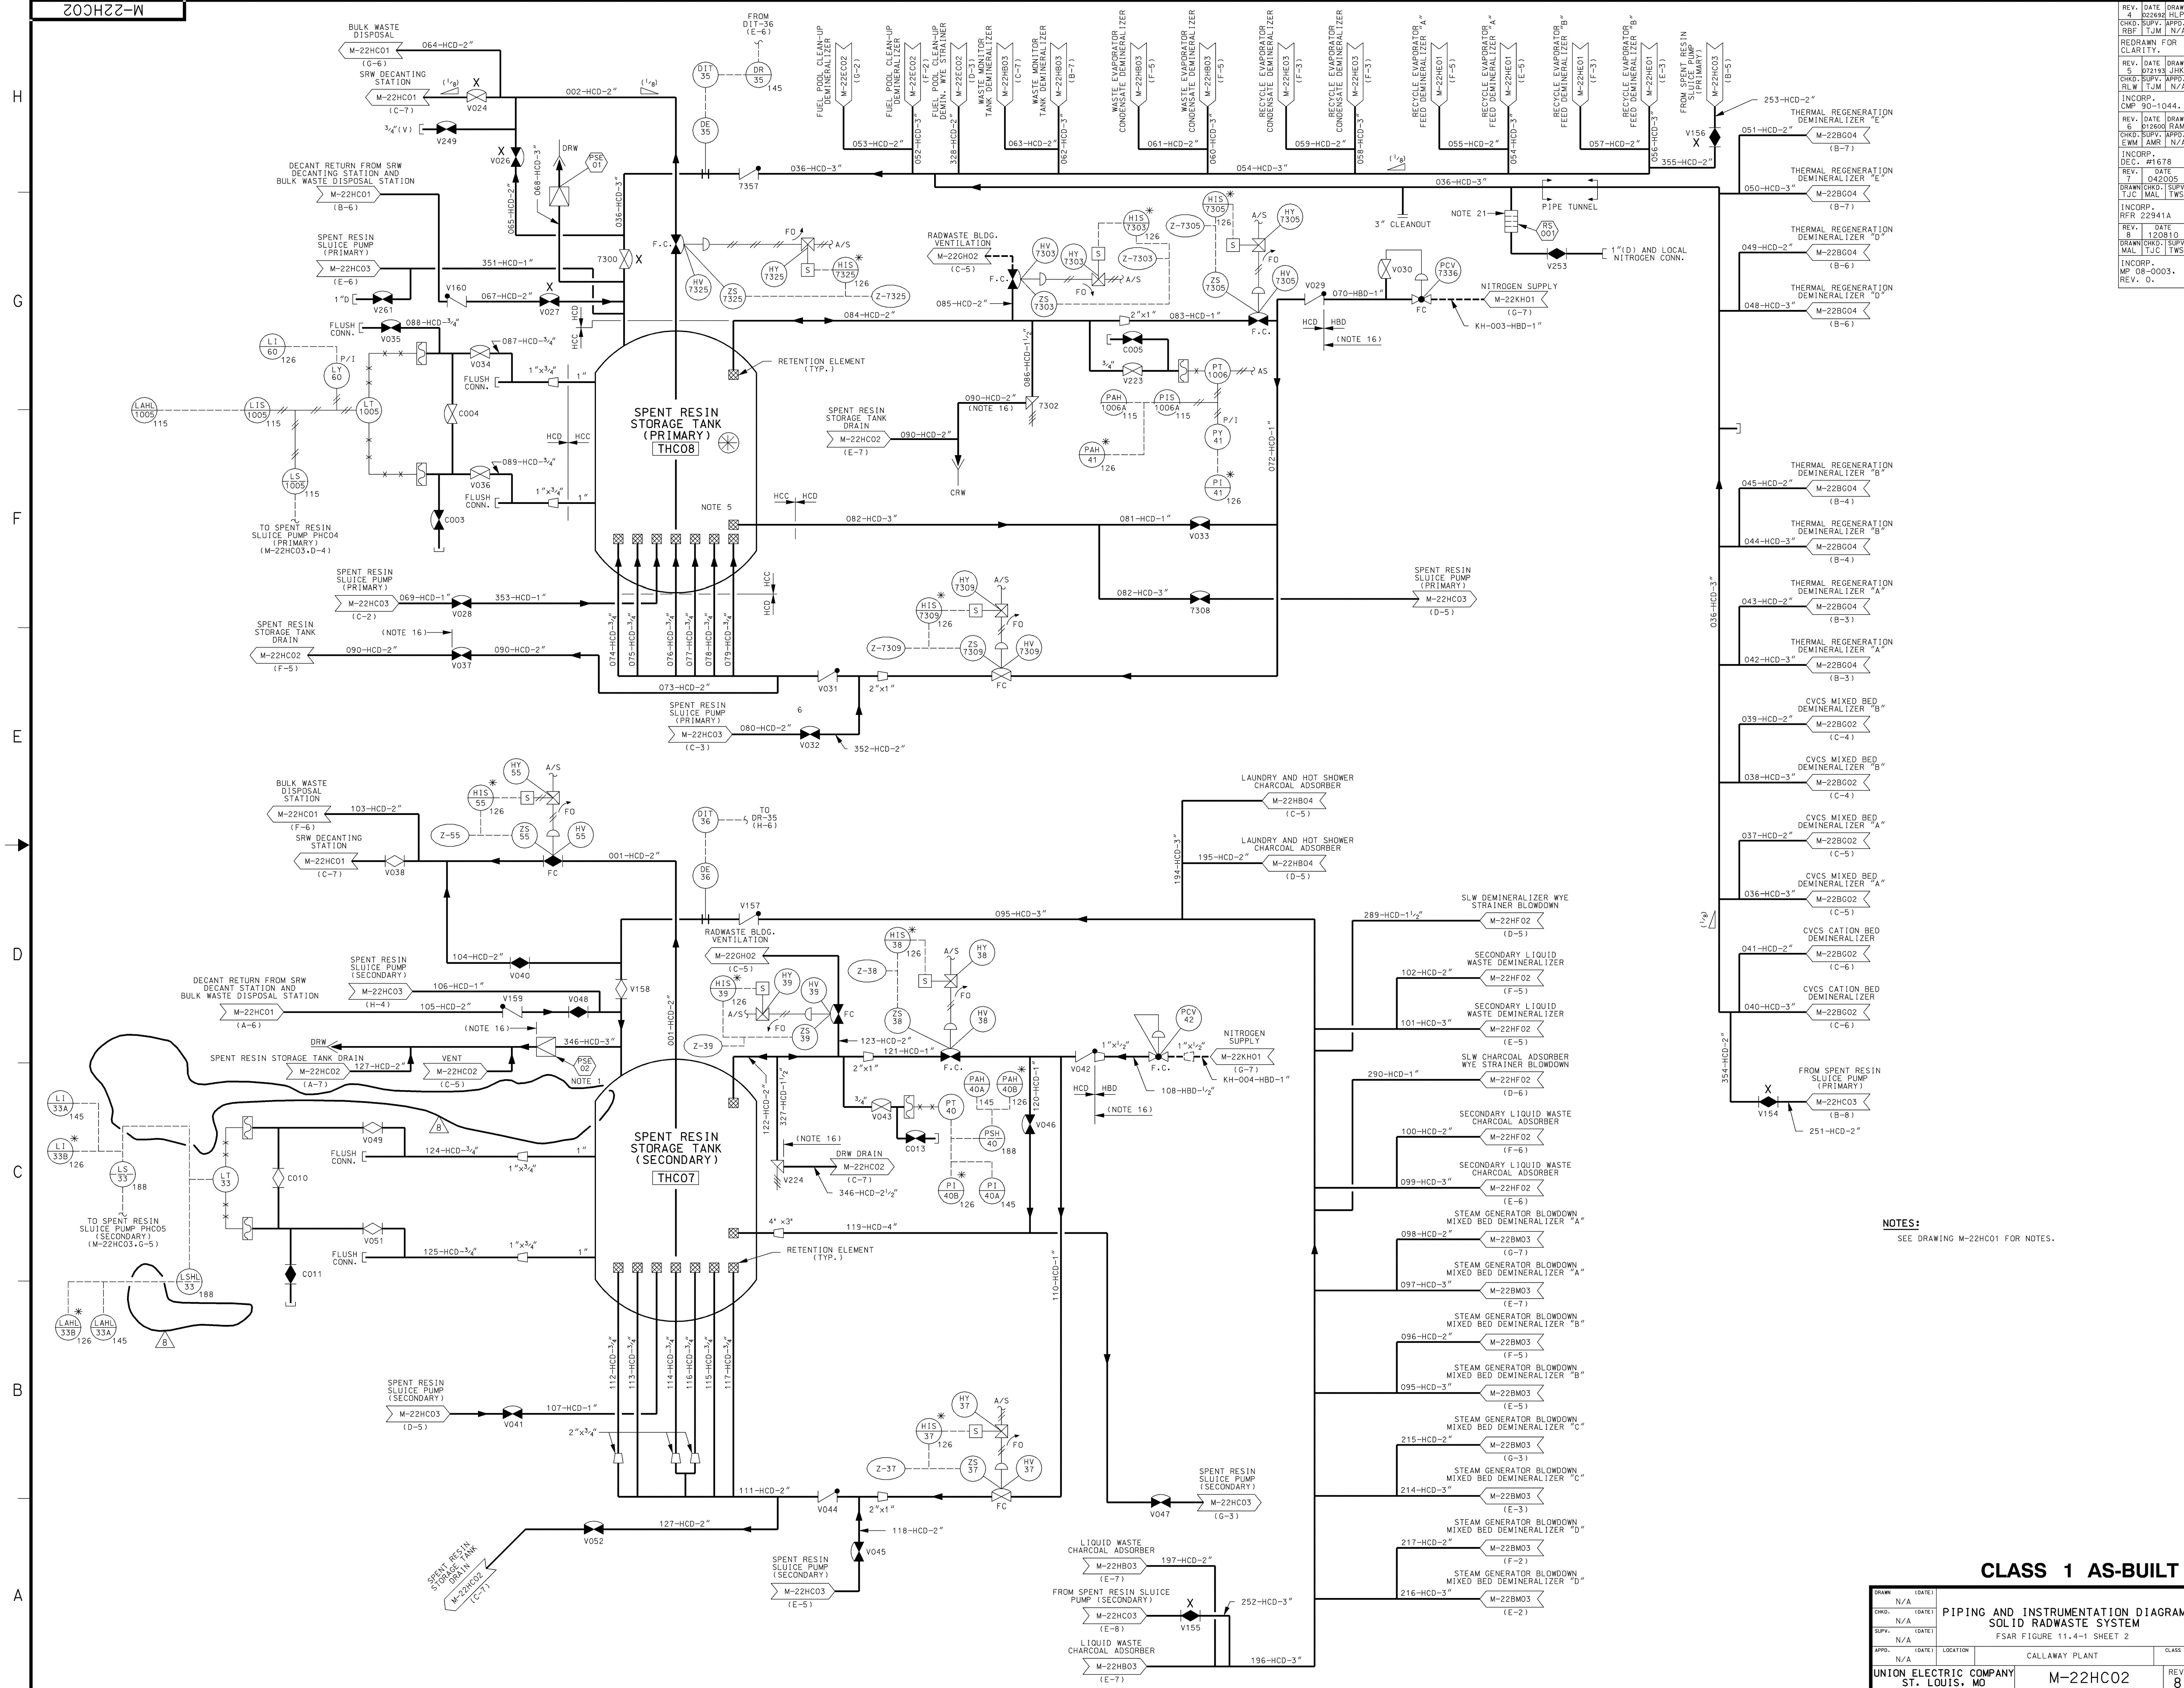

NOTES:  
SEE DRAWING M-22HC01 FOR NOTES.

CLASS 1 AS-BUILT

|                        |                |          |        |
|------------------------|----------------|----------|--------|
| DRAWN                  | N/A            | DATE     |        |
| CHD.                   | N/A            | DATE     |        |
| SUPV.                  | N/A            | DATE     |        |
| APPD.                  | N/A            | DATE     |        |
| LOCATION               | CALLAWAY PLANT |          | CLASS  |
| UNION ELECTRIC COMPANY |                | M-22HC02 | REV. 8 |
| ST. LOUIS, MO          |                |          |        |



PIPING AND INSTRUMENTATION DIAGRAM

SOLID RADWASTE SYSTEM

FSAR FIGURE 11.4-1 SHEET 2

REV. DATE DRAWN 2 022892 JHK  
CHD. SUPV. APPD. RBF TJM N/A  
REDRAWN FOR CLARITY.  
REV. DATE DRAWN 5 072193 JHK  
CHD. SUPV. APPD. RBF TJM N/A  
INCORP. CMP 90-1044.  
REV. DATE DRAWN 7 042005  
CHD. SUPV. APPD. EWM JMR N/A  
INCORP. DEC. #1678  
REV. DATE DRAWN 1 042005  
CHD. SUPV. APPD. TJC MAL TWS  
INCORP. RFR 22941A  
REV. DATE DRAWN 6 120810  
CHD. SUPV. APPD. TJC MAL TWS  
INCORP. MP 08-0003.  
REV. 0.



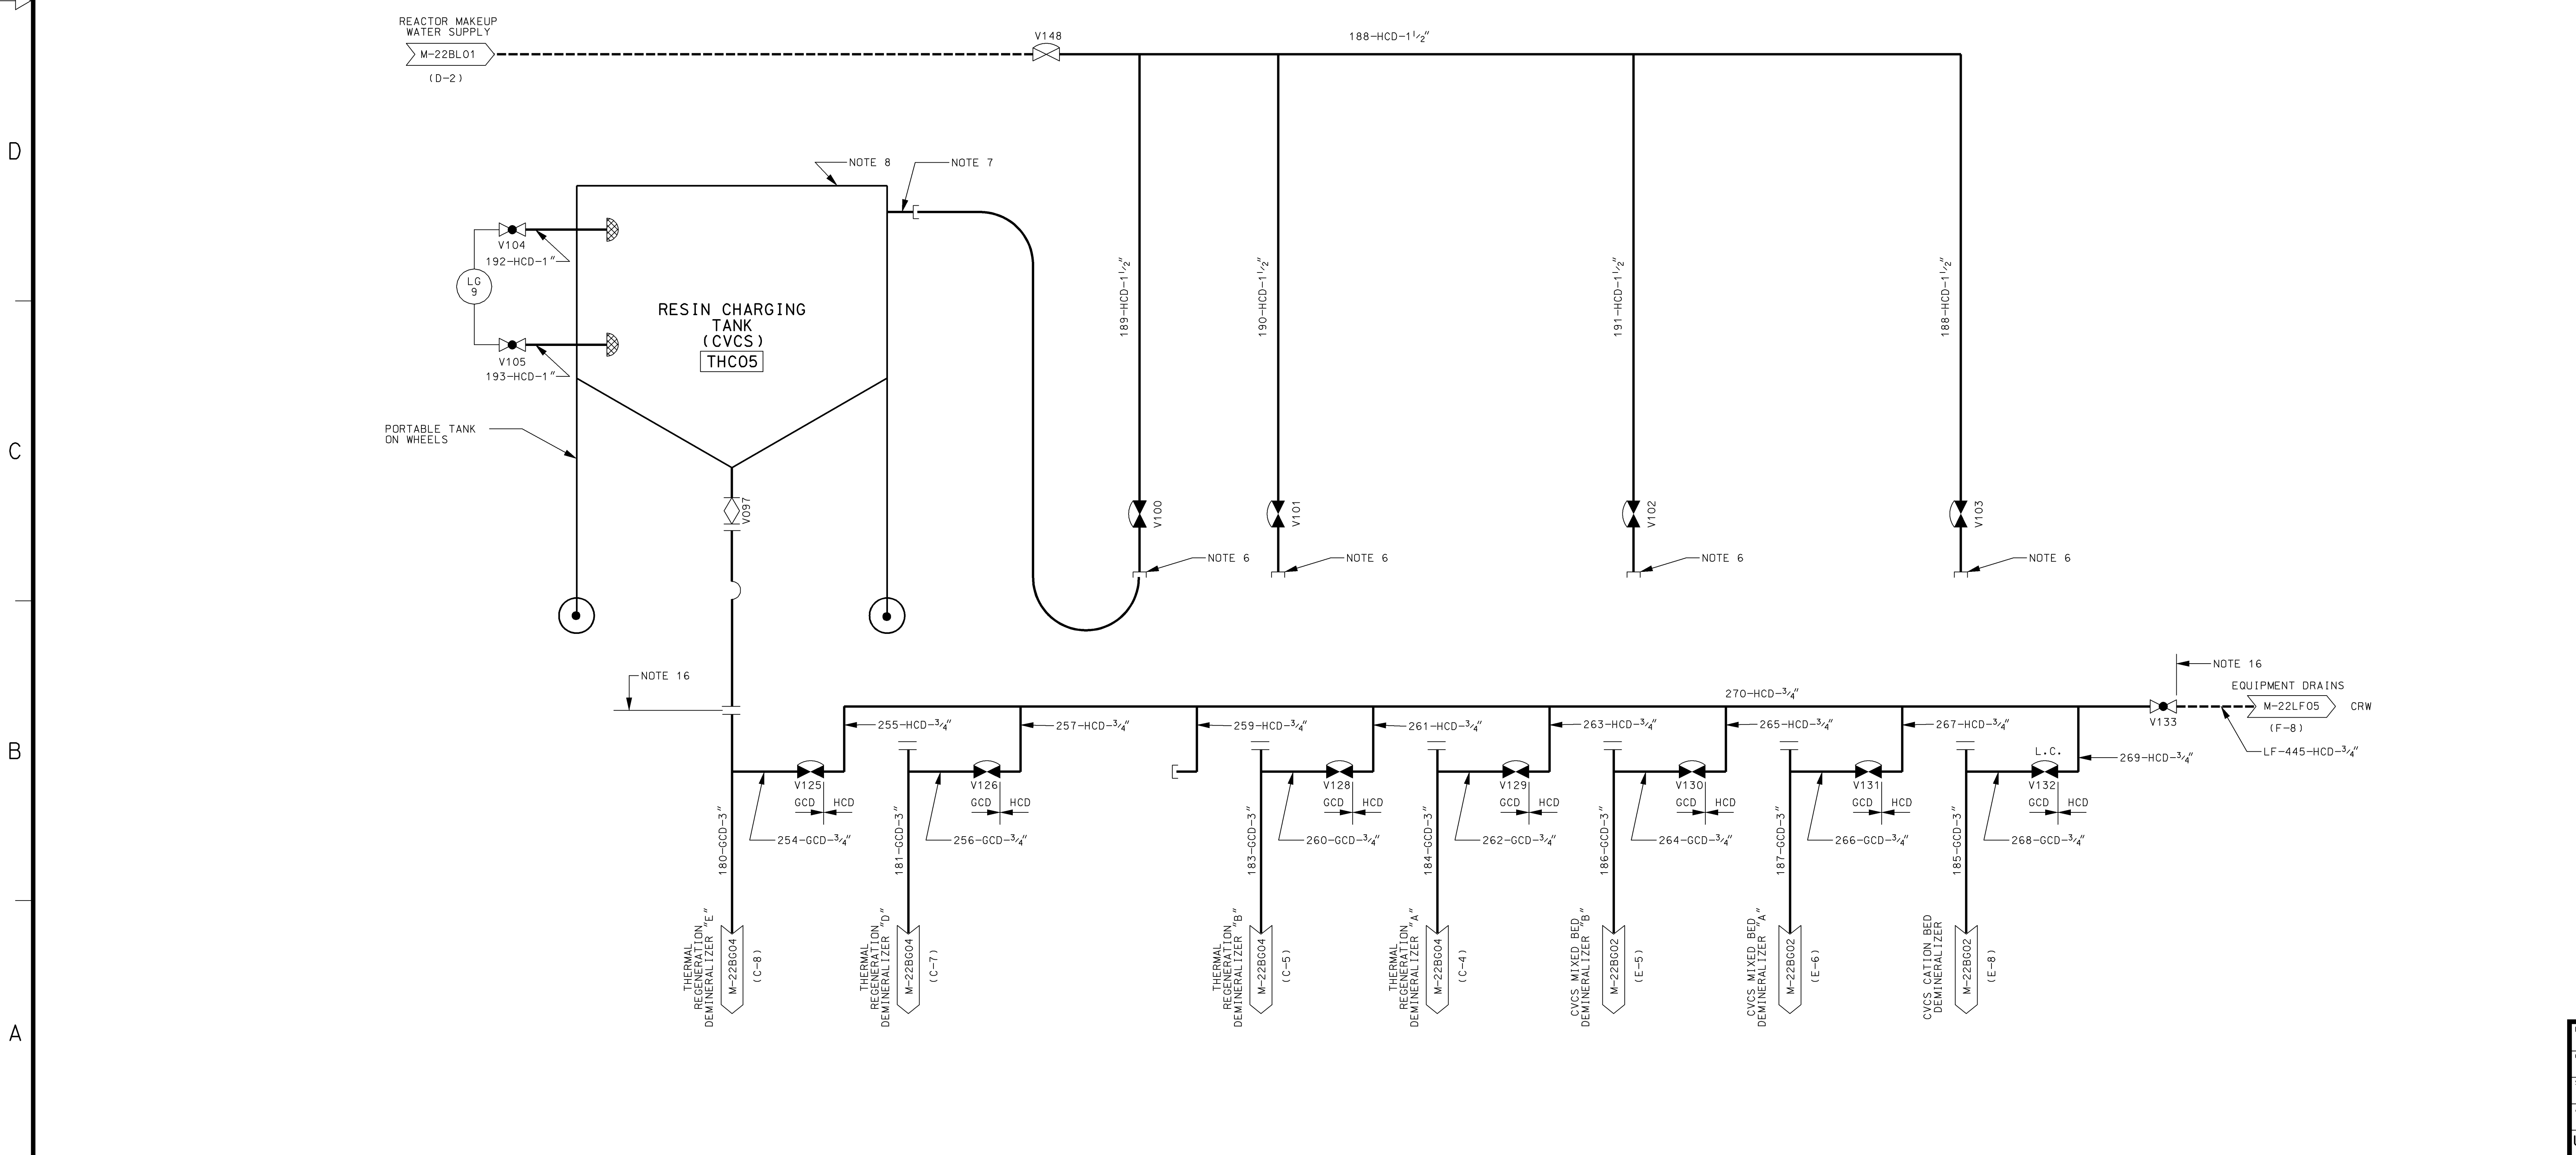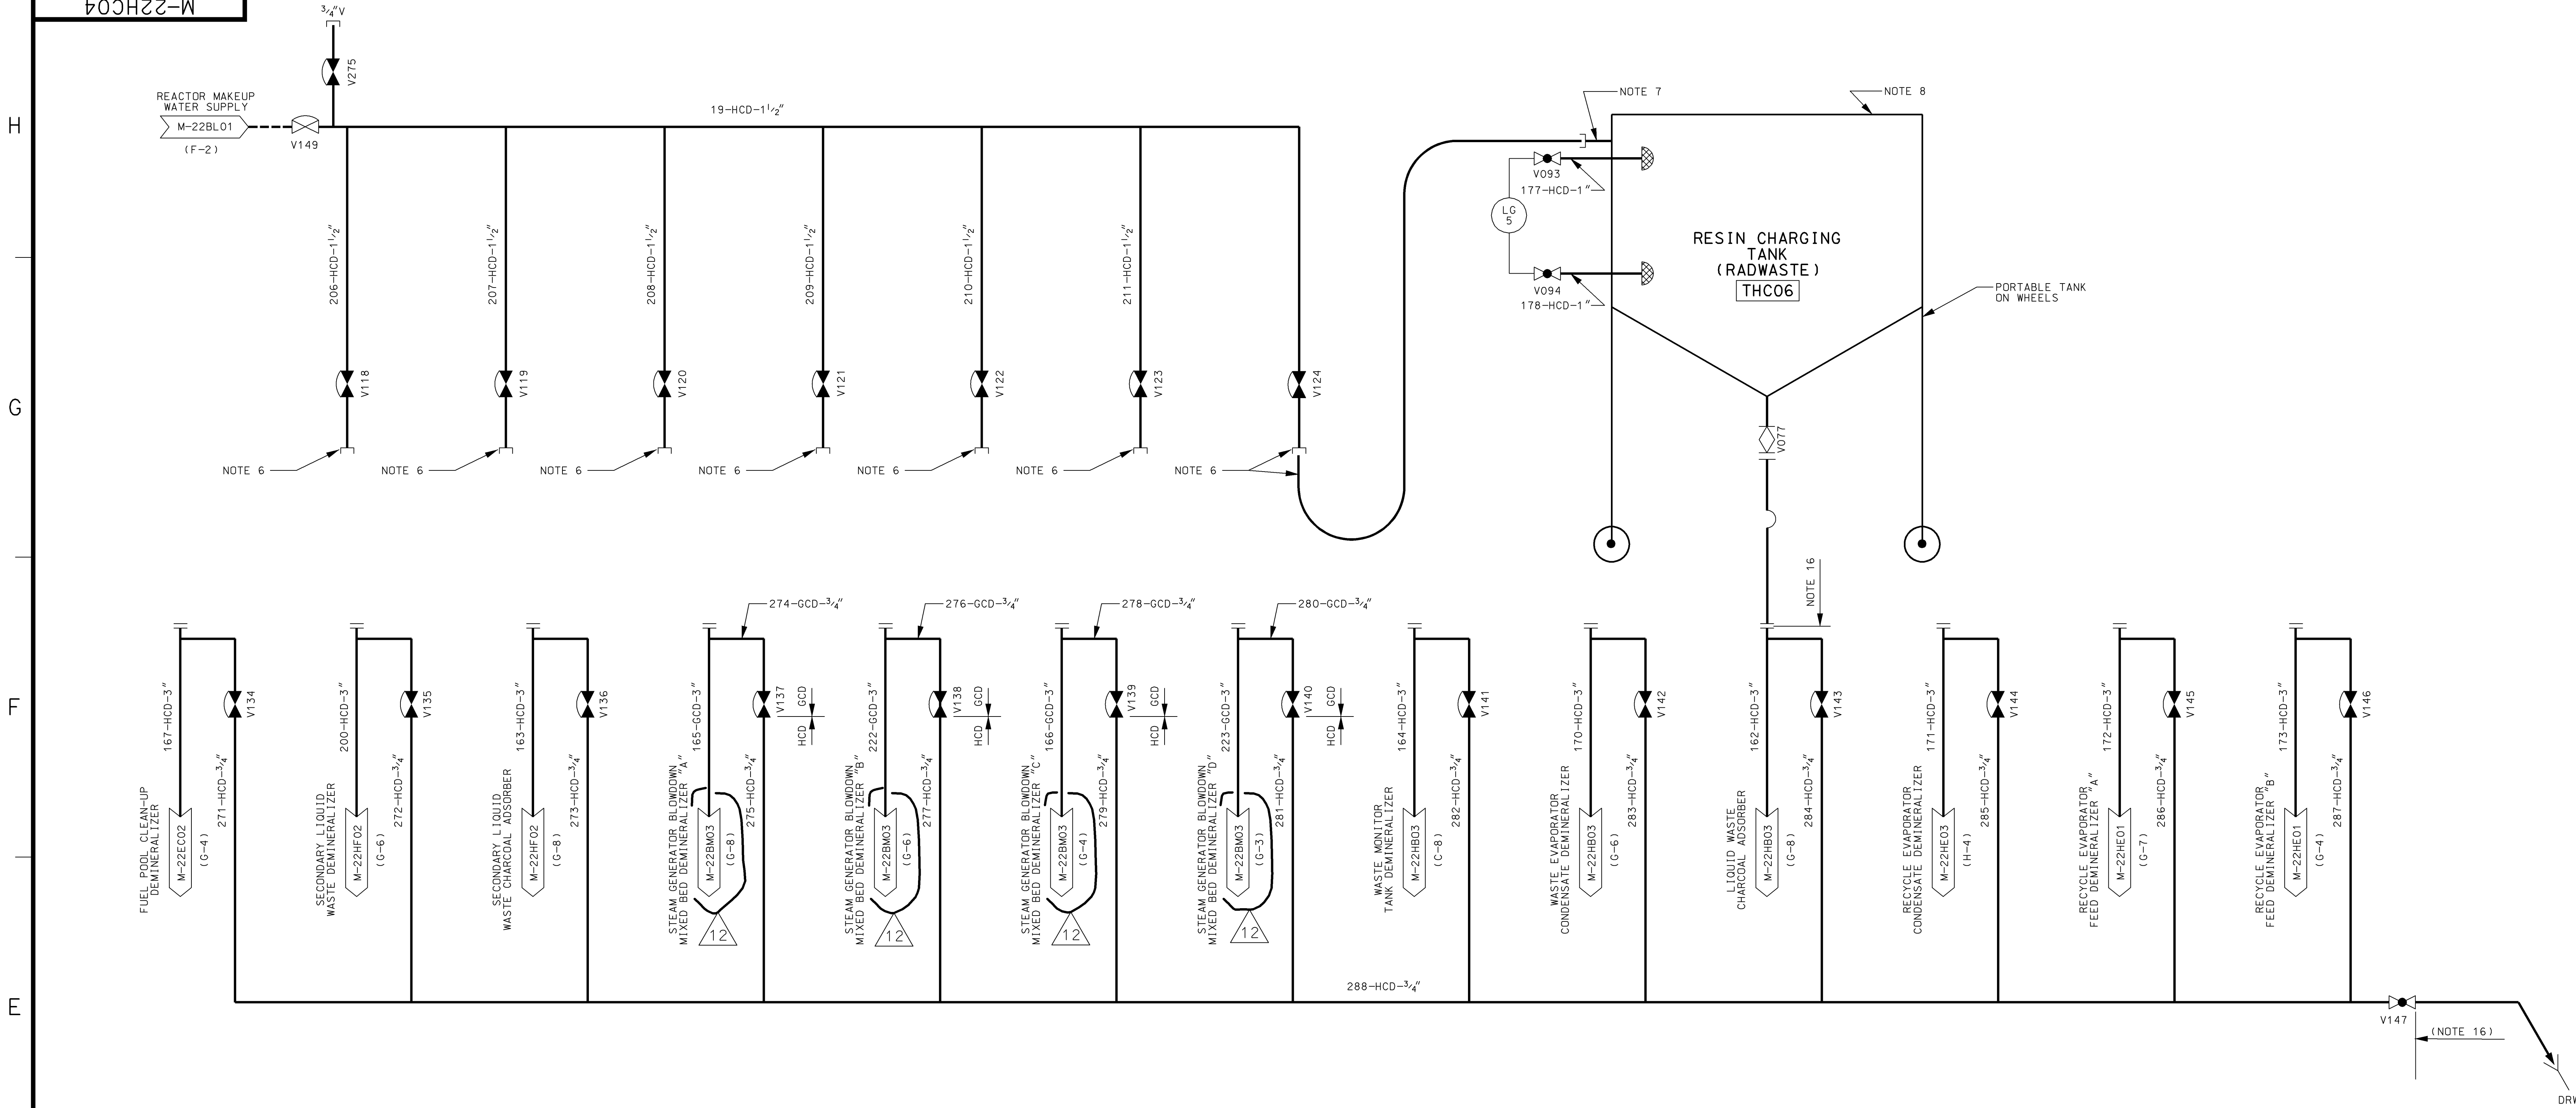

NOTES:  
FOR NOTES SEE DRAWING M-22HC01.

| AS-BUILT CLASS 1       |     |               |         |
|------------------------|-----|---------------|---------|
| DRAWN                  | N/A | DATE          | 1       |
| CHKD.                  | N/A | DATE          | 1       |
| SUPV.                  | N/A | DATE          | 1       |
| APPD.                  | N/A | DATE          | 1       |
| UNION ELECTRIC COMPANY |     | ST. LOUIS, MO | REV. 12 |
| M-22HC04               |     | REV. 12       |         |

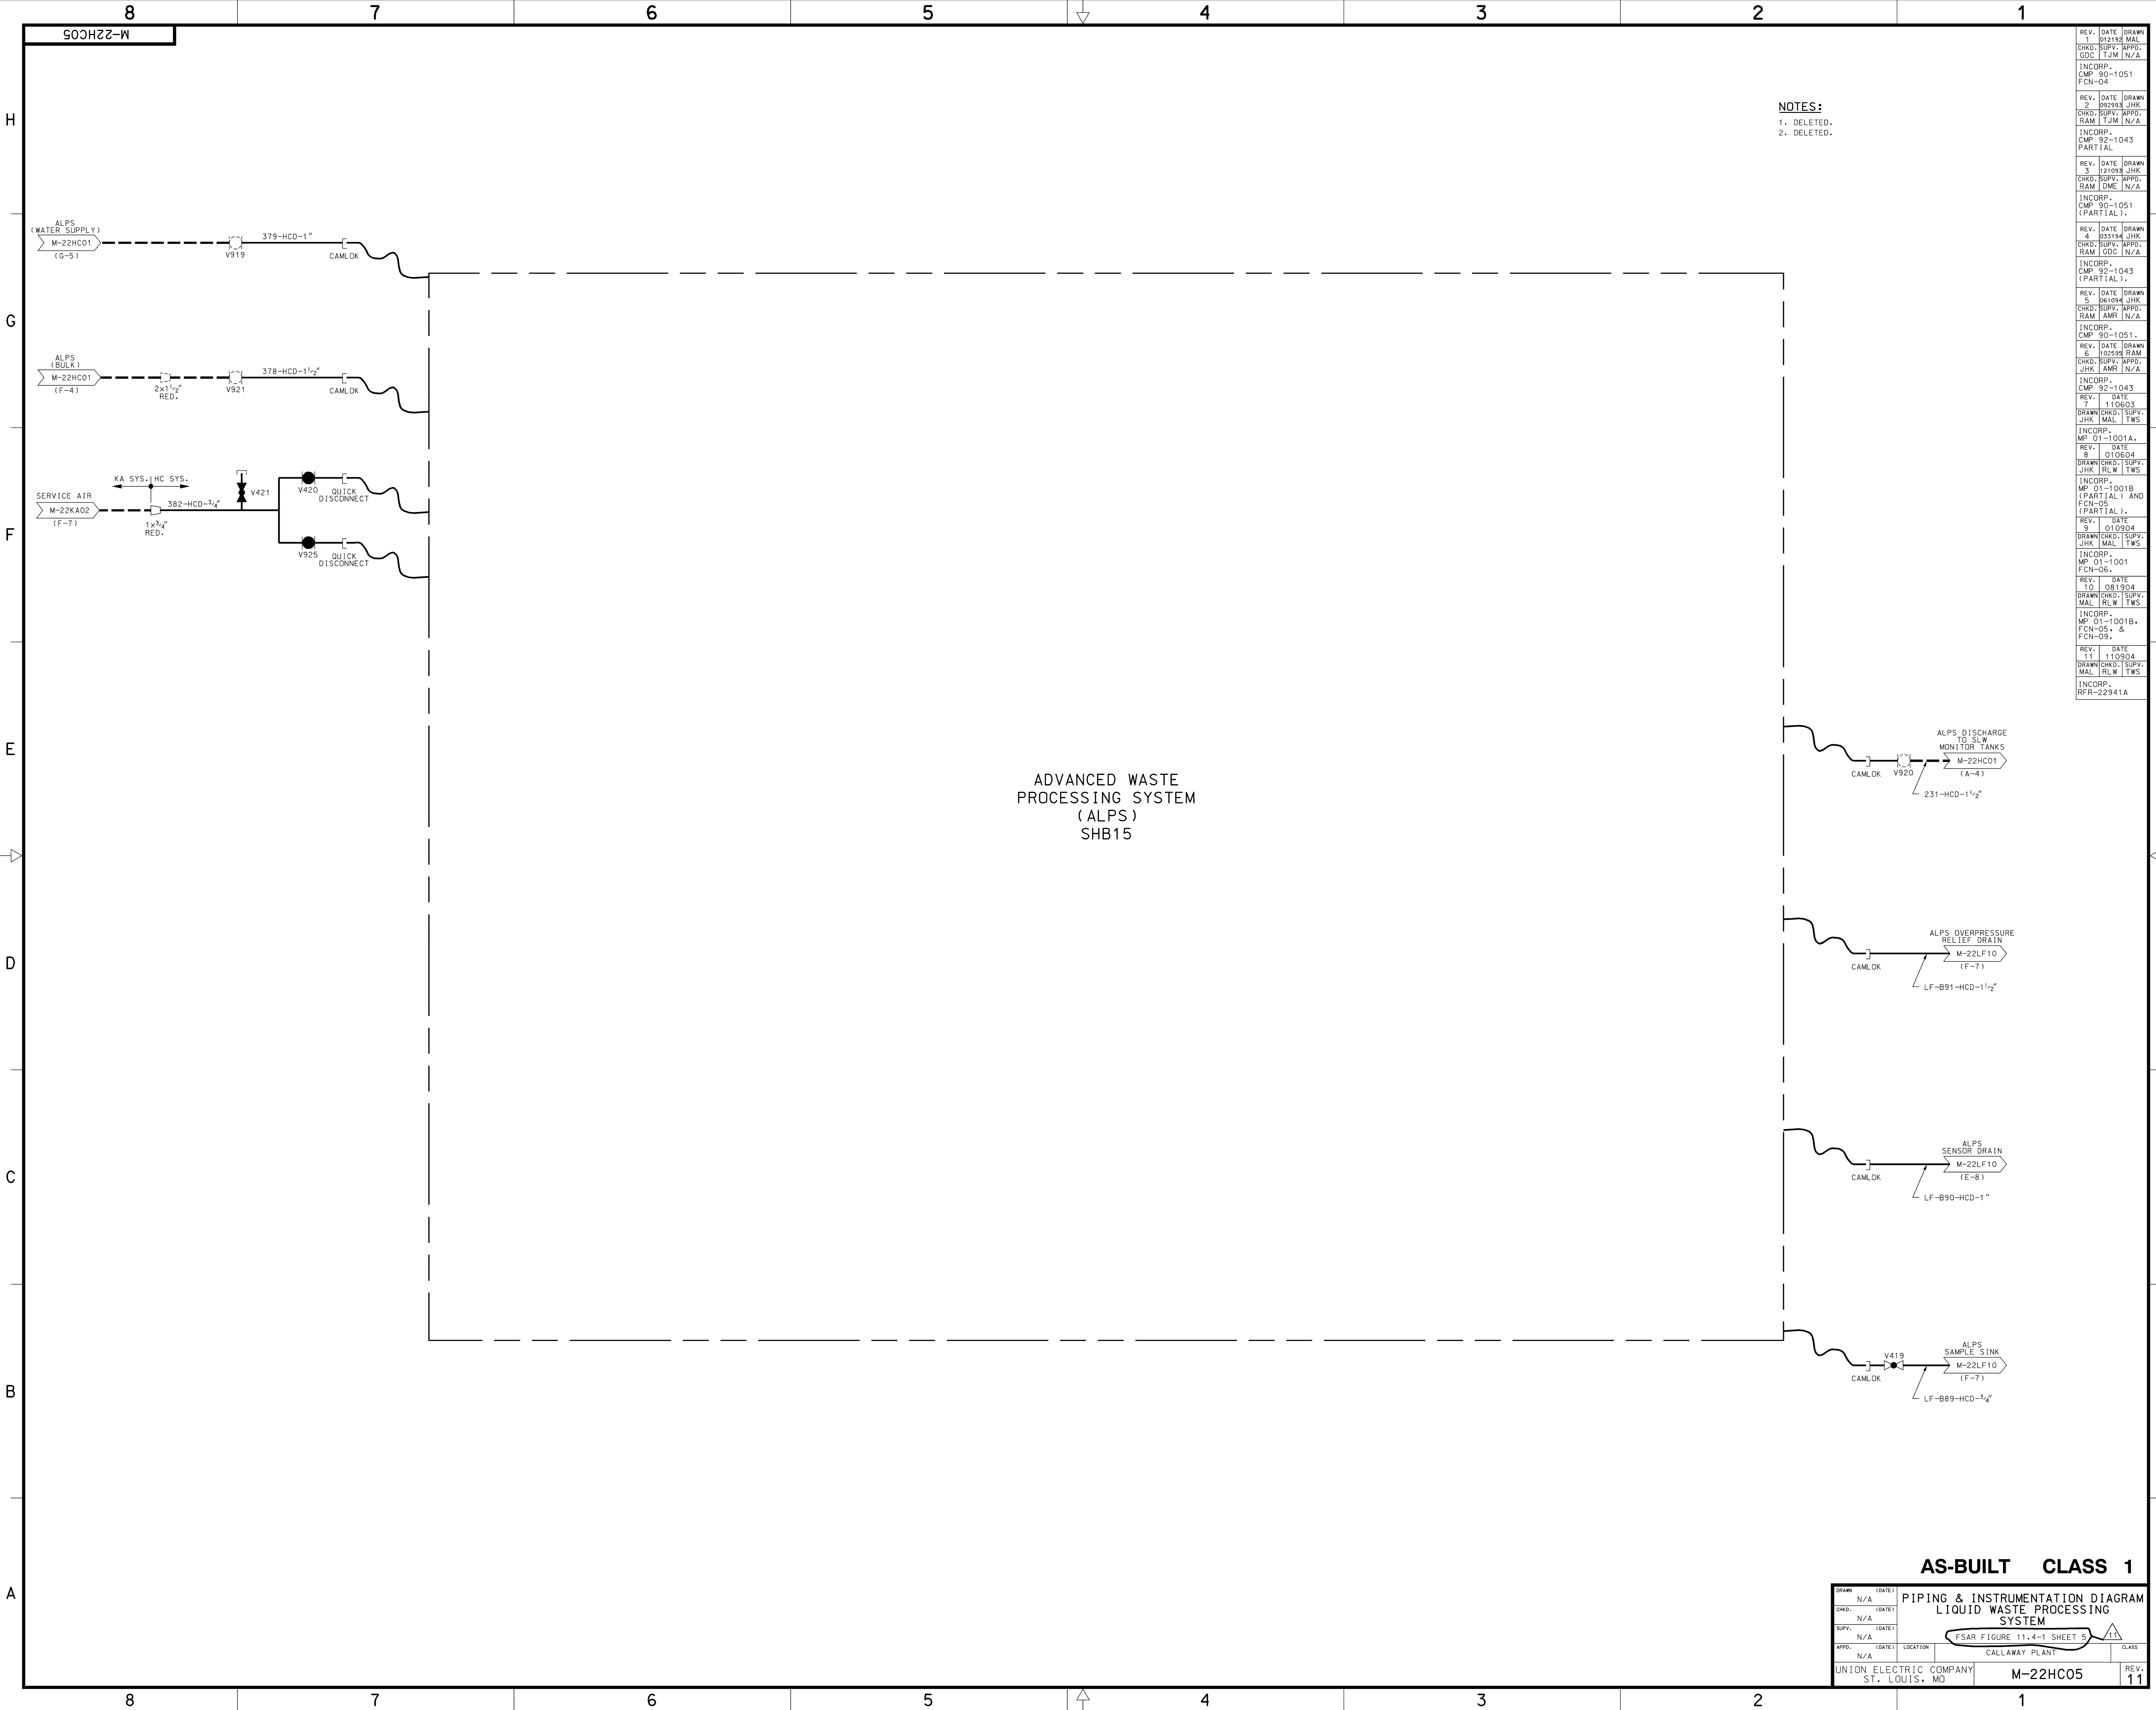


Figure 11.4-2 has been deleted.