


SUPERVISOR: *[Signature]* JAN 78 CAMERA OPERATOR: *[Signature]*

This drawing and the design it represents is the property of the Utilities which are participating in the SNUPPS project. It is loaned to the borrower for the purpose of design, construction, and operation. It shall not be reproduced, distributed, or used except in the limited manner and without the written consent given by the Utilities to the borrower.

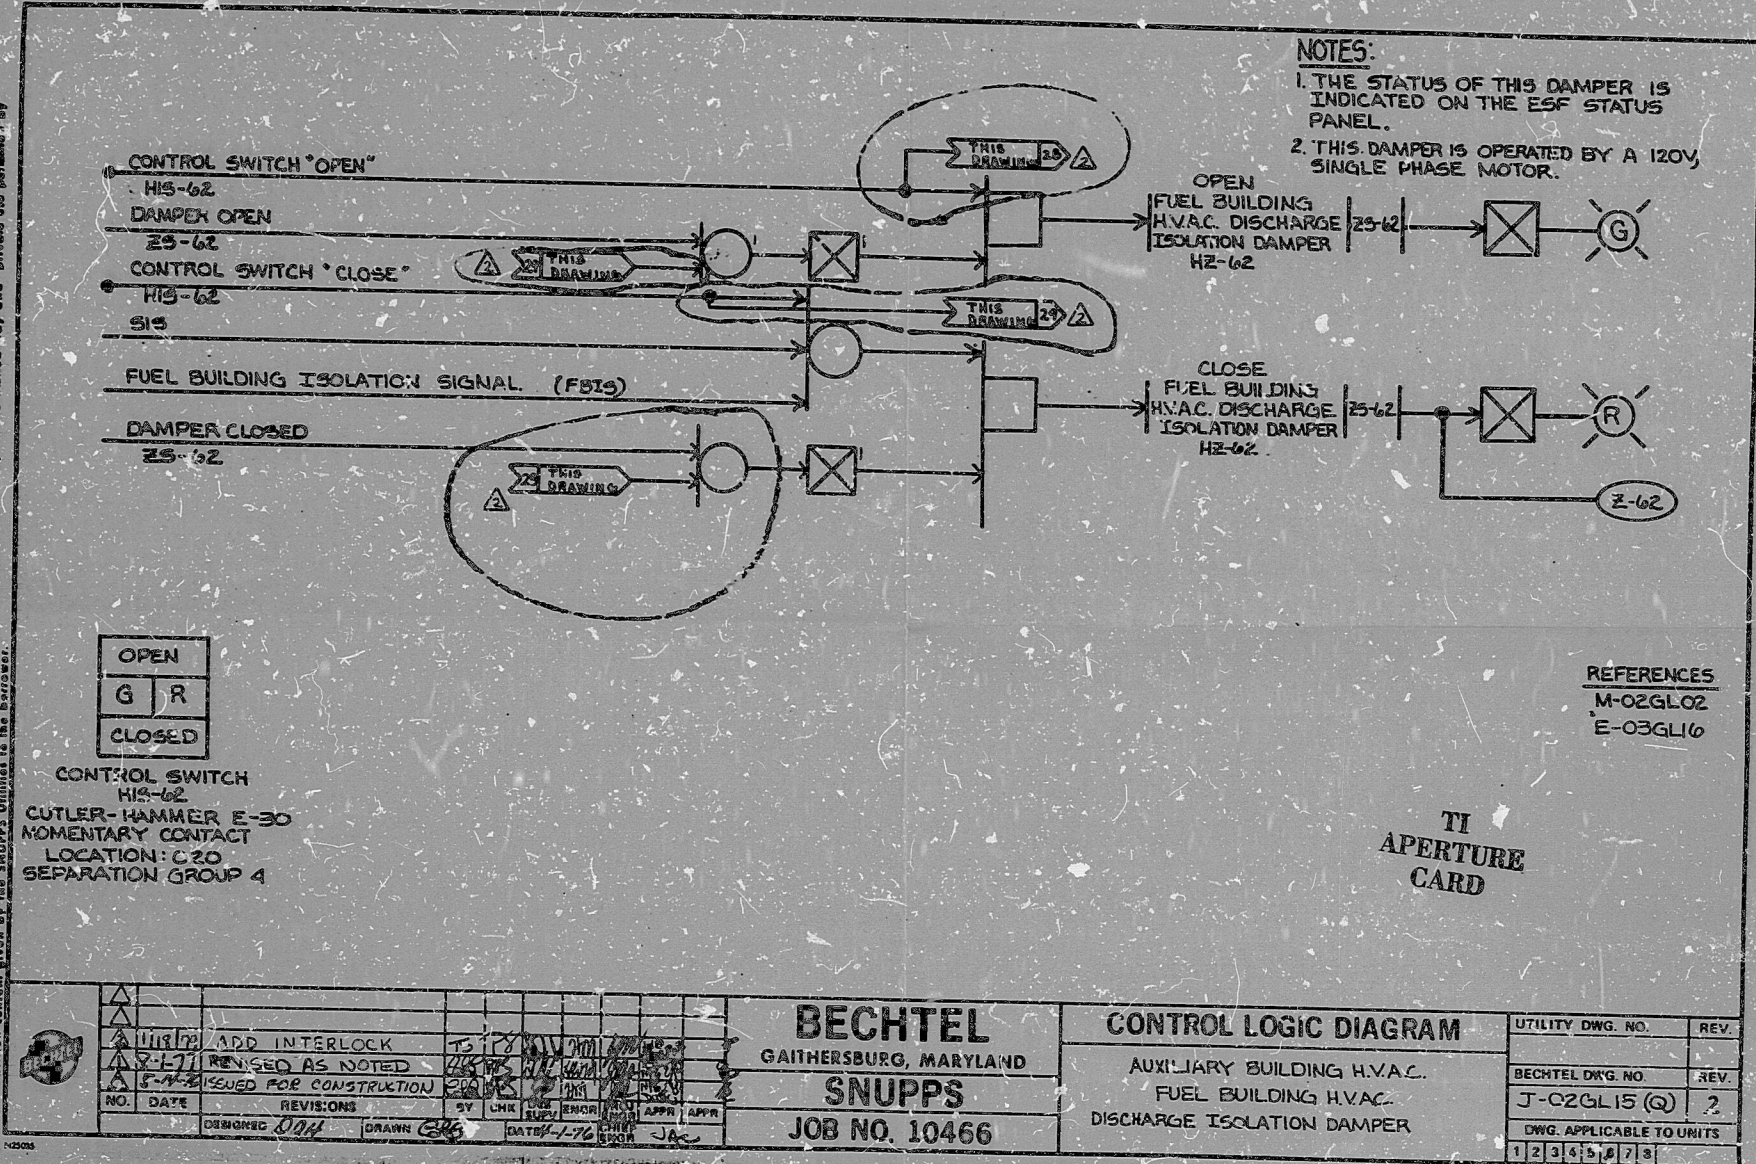

**NOTES:**  
 1. THE STATUS OF THIS DAMPER IS INDICATED ON THE ESF STATUS PANEL.  
 2. THIS DAMPER IS OPERATED BY A 120V SINGLE PHASE MOTOR.

OPEN  
 G | R  
 CLOSED

CONTROL SWITCH  
 HIS-62  
 CUTLER-HAMMER E-30  
 MOMENTARY CONTACT  
 LOCATION: C 20  
 SEPARATION GROUP 4

REFERENCES  
 M-02GL02  
 E-03GL16

TI  
 APERTURE  
 CARD

BECHTEL GAITHERSBURG, MARYLAND SNUPPS JOB NO. 10466		CONTROL LOGIC DIAGRAM AUXILIARY BUILDING H.V.A.C. FUEL BUILDING H.V.A.C. DISCHARGE ISOLATION DAMPER		UTILITY DWG. NO. BECHTEL DWG. NO. J-02GL15 (Q)	REV. ? 1 2 3 4 5 6 7 8
--	--	--	--	--	------------------------------

16X

PDR RIDS

8410030204

