


| | | | | | | | | | |
|-----------------------|-------|------------|-------|-------|-----------------------|---------|-------|----|----|
| 3 | NR | NR | NR | NR | NR | NR | NR | NR | NR |
| REV. NO. | DESC. | CORR. SVS. | ESCH. | CIVIL | PD LAYOUT | PD ENG. | ARCH. | | |
| COORDINATION SIGN-OFF | | | | | DOCUMENT ID: J-026503 | | | | |

- NOTES:**
1. THESE VALVES ALL FAIL CLOSED.
 2. AUXILIARY RELAY REQUIRED FOR SEAL-IN
 3. THE STATUS OF THESE VALVES IS SHOWN ON THE ESF STATUS PANEL.

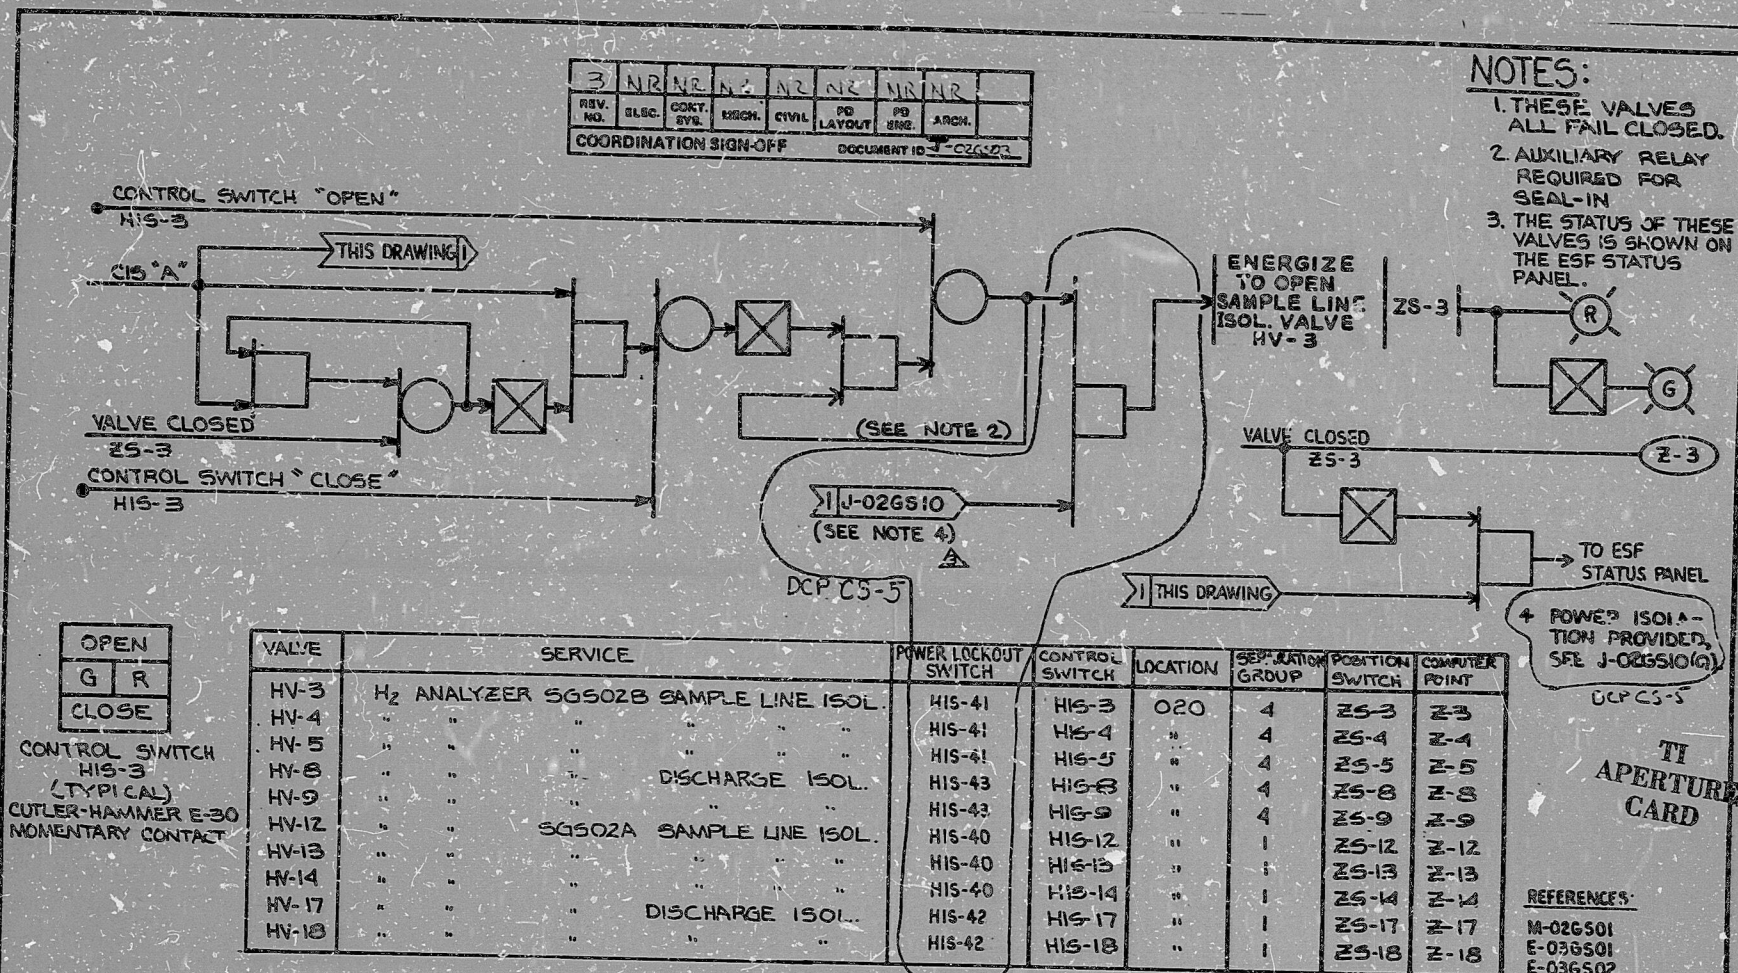

OPEN
G R
CLOSE

CONTROL SWITCH HIS-3 (TYPICAL) CUTLER-HAMMER E-30 MOMENTARY CONTACT

| VALVE | SERVICE | POWER LOCKOUT SWITCH | CONTROL SWITCH | LOCATION | SEPARATION GROUP | POSITION SWITCH | COMPUTER POINT |
|-------|--|----------------------|----------------|----------|------------------|-----------------|----------------|
| HV-3 | H ₂ ANALYZER SCS02B SAMPLE LINE ISOL. | HIS-41 | HIS-3 | O2O | 4 | ZS-3 | Z-3 |
| HV-4 | " " " " " " " " | HIS-41 | HIS-4 | " | 4 | ZS-4 | Z-4 |
| HV-5 | " " " " " " " " | HIS-41 | HIS-5 | " | 4 | ZS-5 | Z-5 |
| HV-8 | " " " " " DISCHARGE ISOL. | HIS-43 | HIS-8 | " | 4 | ZS-8 | Z-8 |
| HV-9 | " " " " " " " " | HIS-43 | HIS-9 | " | 4 | ZS-9 | Z-9 |
| HV-12 | " " " " " SCS02A SAMPLE LINE ISOL. | HIS-40 | HIS-12 | " | 1 | ZS-12 | Z-12 |
| HV-13 | " " " " " " " " | HIS-40 | HIS-13 | " | 1 | ZS-13 | Z-13 |
| HV-14 | " " " " " " " " | HIS-40 | HIS-14 | " | 1 | ZS-14 | Z-14 |
| HV-17 | " " " " " DISCHARGE ISOL. | HIS-42 | HIS-17 | " | 1 | ZS-17 | Z-17 |
| HV-18 | " " " " " " " " | HIS-42 | HIS-18 | " | 1 | ZS-18 | Z-18 |

TO ESF STATUS PANEL

+ POWER ISOLATION PROVIDED, SEE J-026510 (Q)

DCP CS-5

TI APERTURE CARD

REFERENCES:
M-026501
E-036501
E-036502
J-026510 (Q)

This drawing and the design it covers is the property of the Utilities which are participating in the SNUPPS Project. It is loaned to the borrower's express agreement that it will not be reproduced, copied, loaned, exhibited, or used except in the limited way and purpose as permitted by the written consent given by the SNUPPS Utilities to the borrower.

| | | | | | | |
|-----|---------|-------------------------|-----|-----|-----|------|
| NO. | DATE | REVISIONS | BY | CHK | APP | DATE |
| 1 | 6-17-81 | ADDED DCP IDENT. | JV | OP | CA | |
| 2 | 7-1-81 | REVISED AS NOTED | REC | BY | CA | |
| 3 | 7-1-81 | REVISED AS NOTED | GF | BY | CA | |
| 4 | 7-27-81 | ISSUED FOR CONSTRUCTION | CA | BY | CA | |

BECHTEL
GAITHERSBURG, MARYLAND
SNUPPS
JOB NO. 10466

| | |
|------------------------|------|
| UTILITY DRWG. NO. | REV. |
| BECHTEL DRWG. NO. | REV. |
| J-026503 (Q) | 3 |
| DRG. APPLICABLE TO URM | |
| 1 2 3 4 5 6 7 8 | |
| REVIEW LEVEL 2 | |

I certify that the image contained on this frame was made in the normal and regular course of business, on the date stated below and that it is an accurate reproduction of the document(s) submitted to Micrographics.
DATE 6-17-81 OPERATOR Kelly Bickel SUPERVISOR [Signature]

16X

8410030282

PDR RIDS

