

17


11

8.5

8.5

11

17

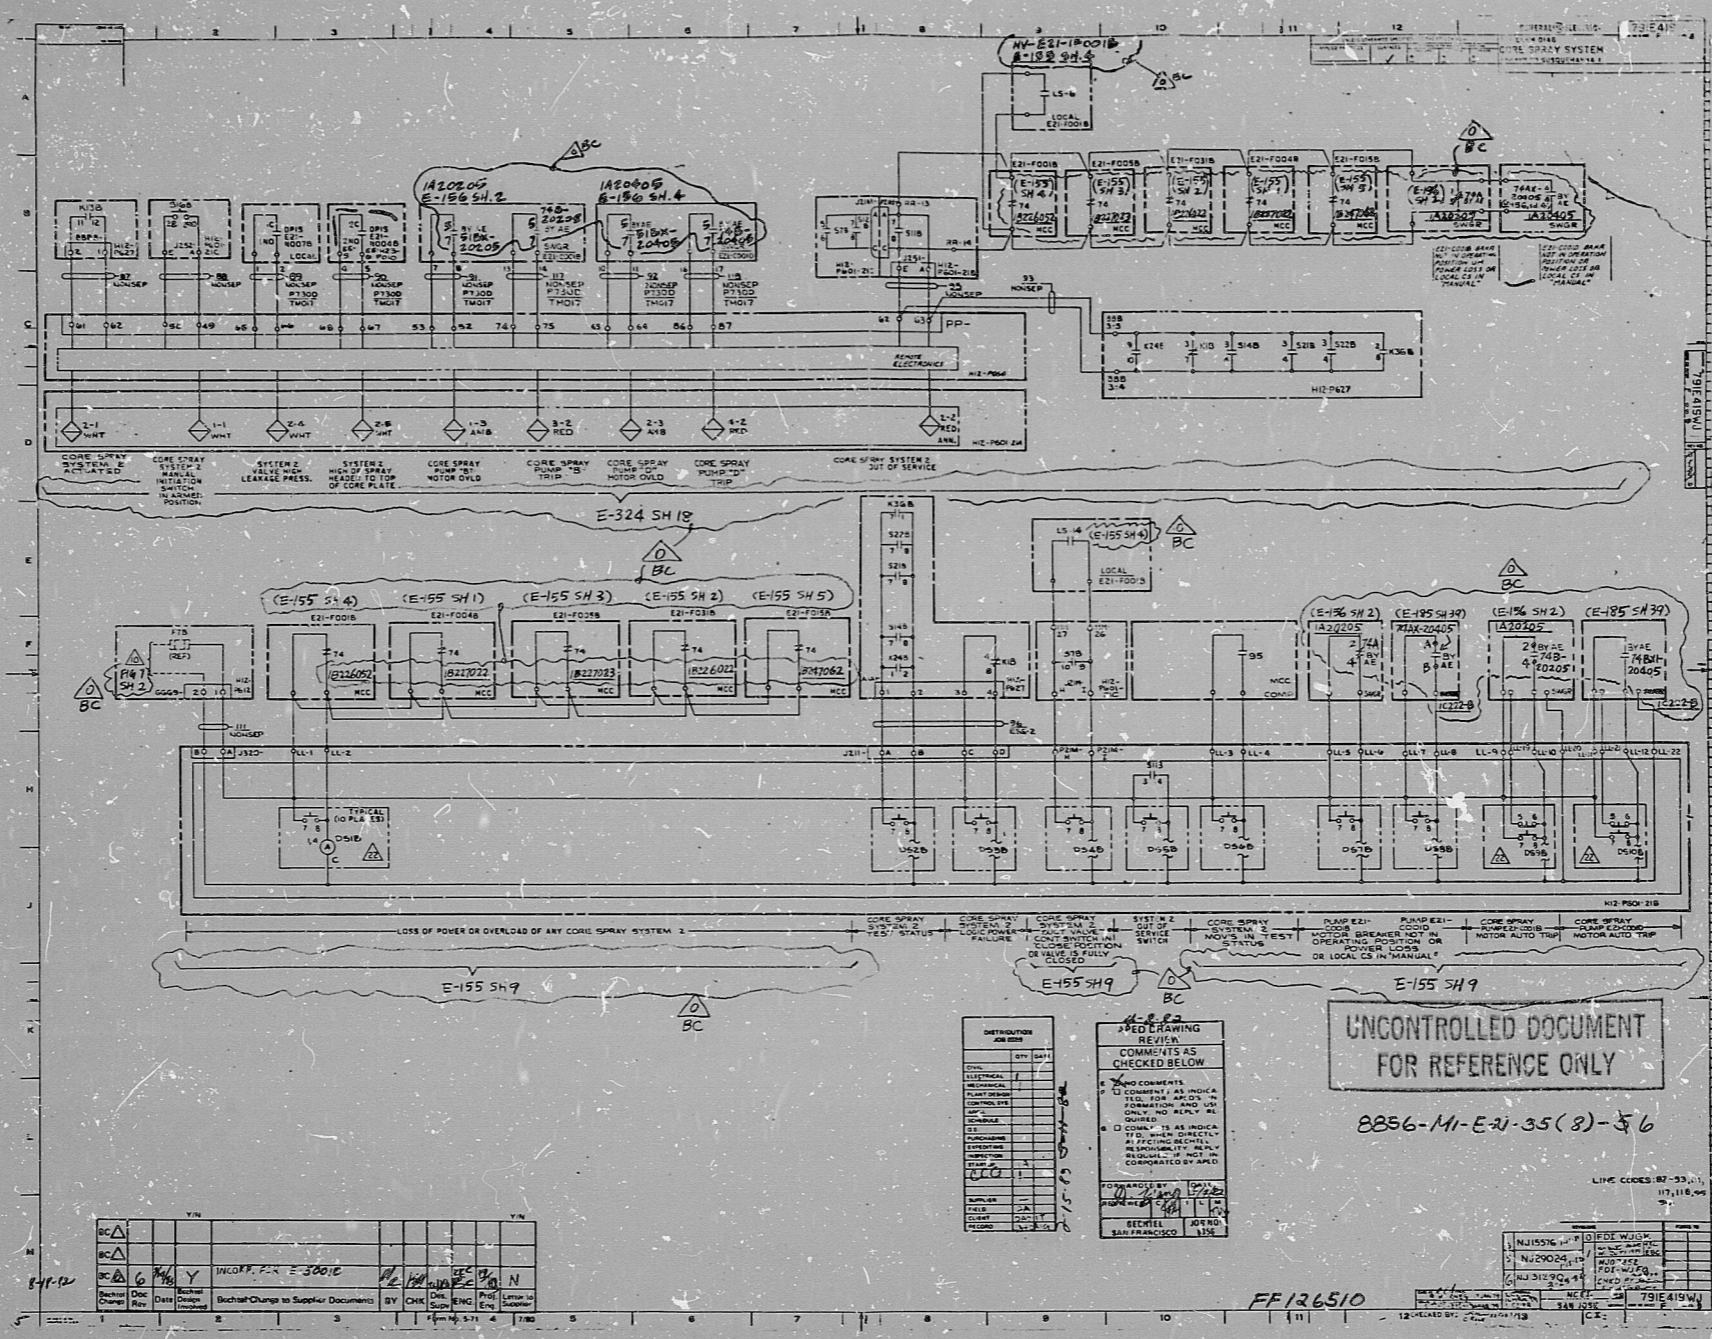

24X

I certify that the microfilm image contained on this microform were made in the normal and regular course of business. This is done, full, correct and complete reproduction and replacement for and/or in lieu of any past documents and/or records. Each set of microform contains a complete set of documents.

Date: 11/19/82 Camera Type: 3500 L

PRC APERTURE CARD

RIDS

8305250042

