
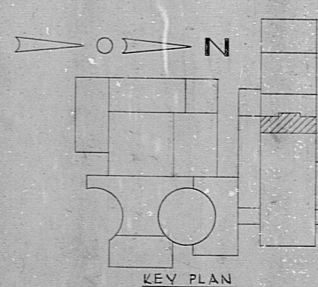


CHART 'A'

- WEST TO EAST
- IR33F1X-1 (465)
  - IR33F1X-2 (773)
  - IR33F1X-3 (773)
  - IR33F1X-4 (773)
  - IR33F1X-100 (773)

- NOTES:
1. FOR LEGEND, NOTES, REFERENCES, STANDARD DETAILS, SEE DWG. E-215-001.
  2. CONDUITS CONTINUED UP, SEE DWG. D-215-044.
  3. CONDUITS CONTINUED DOWN, SEE DWG. D-215-024.

REV	DATE	BY	CHKD	DESCRIPTION
A				REVISED AS INDICATED
B				REVISED AS INDICATED
C				REVISED AS INDICATED
D				REVISED AS INDICATED
E				REVISED AS INDICATED
F				REVISED AS INDICATED
G				REVISED AS INDICATED
H				REVISED AS INDICATED
I				REVISED AS INDICATED
J				REVISED AS INDICATED
K				REVISED AS INDICATED

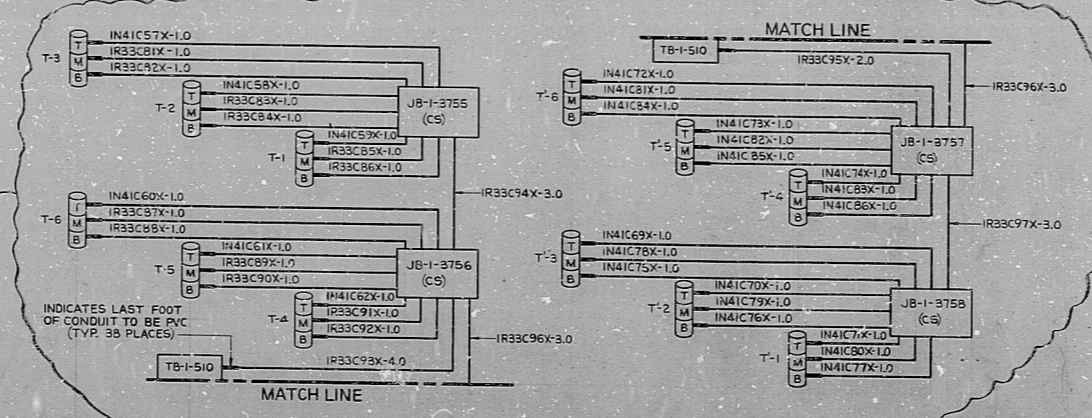

NUCLEAR SAFETY RELATED

TERA APERTURE CARD

DATE	RELEASED FOR	ENGR.

THE CLEVELAND ELECTRIC ILLUMINATING COMPANY  
PERRY NUCLEAR POWER PLANT UNIT 1  
ELECTRICAL  
CONDUIT LAYOUT  
TURBINE BUILDING - EL. 624'-6"

GILBERT ASSOCIATES, INC.  
ENGINEERS AND CONSULTANTS

NO.	DATE	BY	CHKD.	DESCRIPTION
1				
2				
3				
04 4549 D-215-034 H  
DRAWING NUMBER

RIDS

8112030243

