

17


11

98

85

11

17

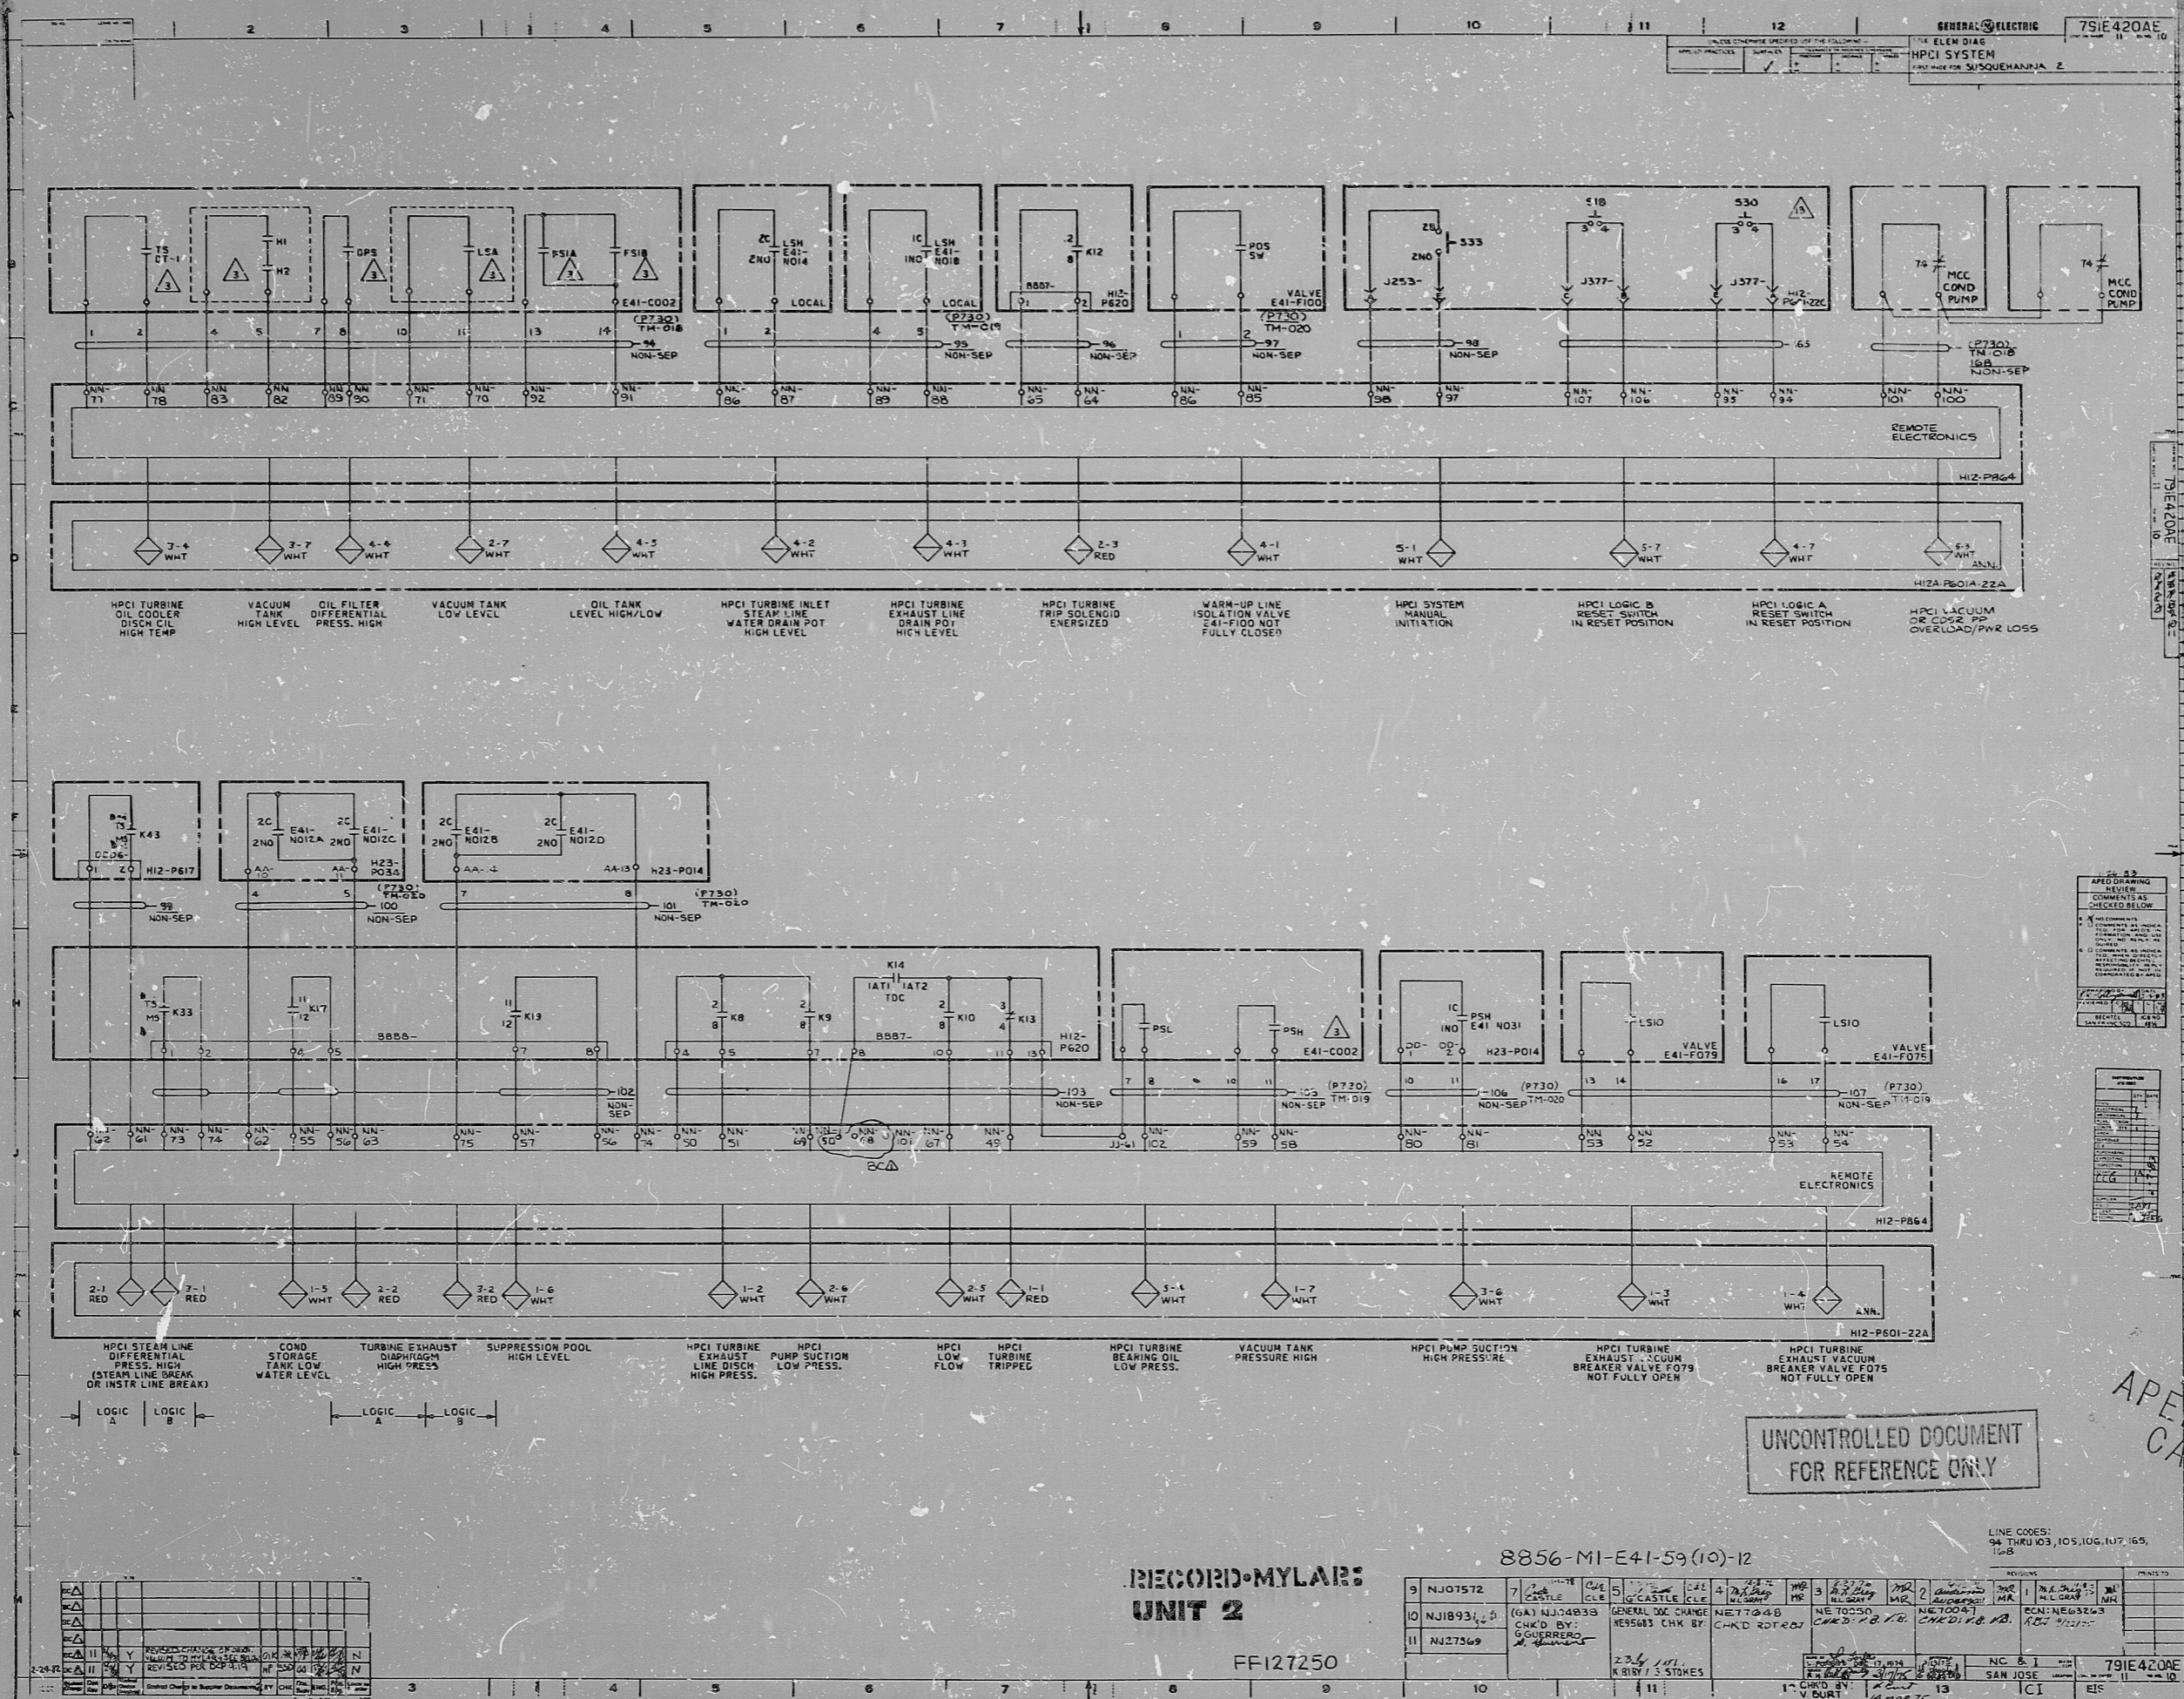

UNCONTROLLED DOCUMENT FOR REFERENCE ONLY

APERTURE CARD

RECORD-MYLAR UNIT 2 FF127250

8856-MI-E41-59(10)-12

NO.	DATE	BY	REVISION
1			
2			
3			
4			
5			
6			
7			
8			
9			
10			
11			
12			

9	NJ07572	7	CASTLE	5	CASTLE	4	CASTLE	3	CASTLE	2	CASTLE	1	CASTLE
10	NJ18931	6	CASTLE	4	CASTLE	3	CASTLE	2	CASTLE	1	CASTLE		
11	NJ27569	5	CASTLE	3	CASTLE	2	CASTLE	1	CASTLE				

LINE CODES: 94 THRU 103, 105, 106, 107, 165, 168

791E420AE

30X



RIDS

8305259053

