

17


11

8.5

8.5

11

17

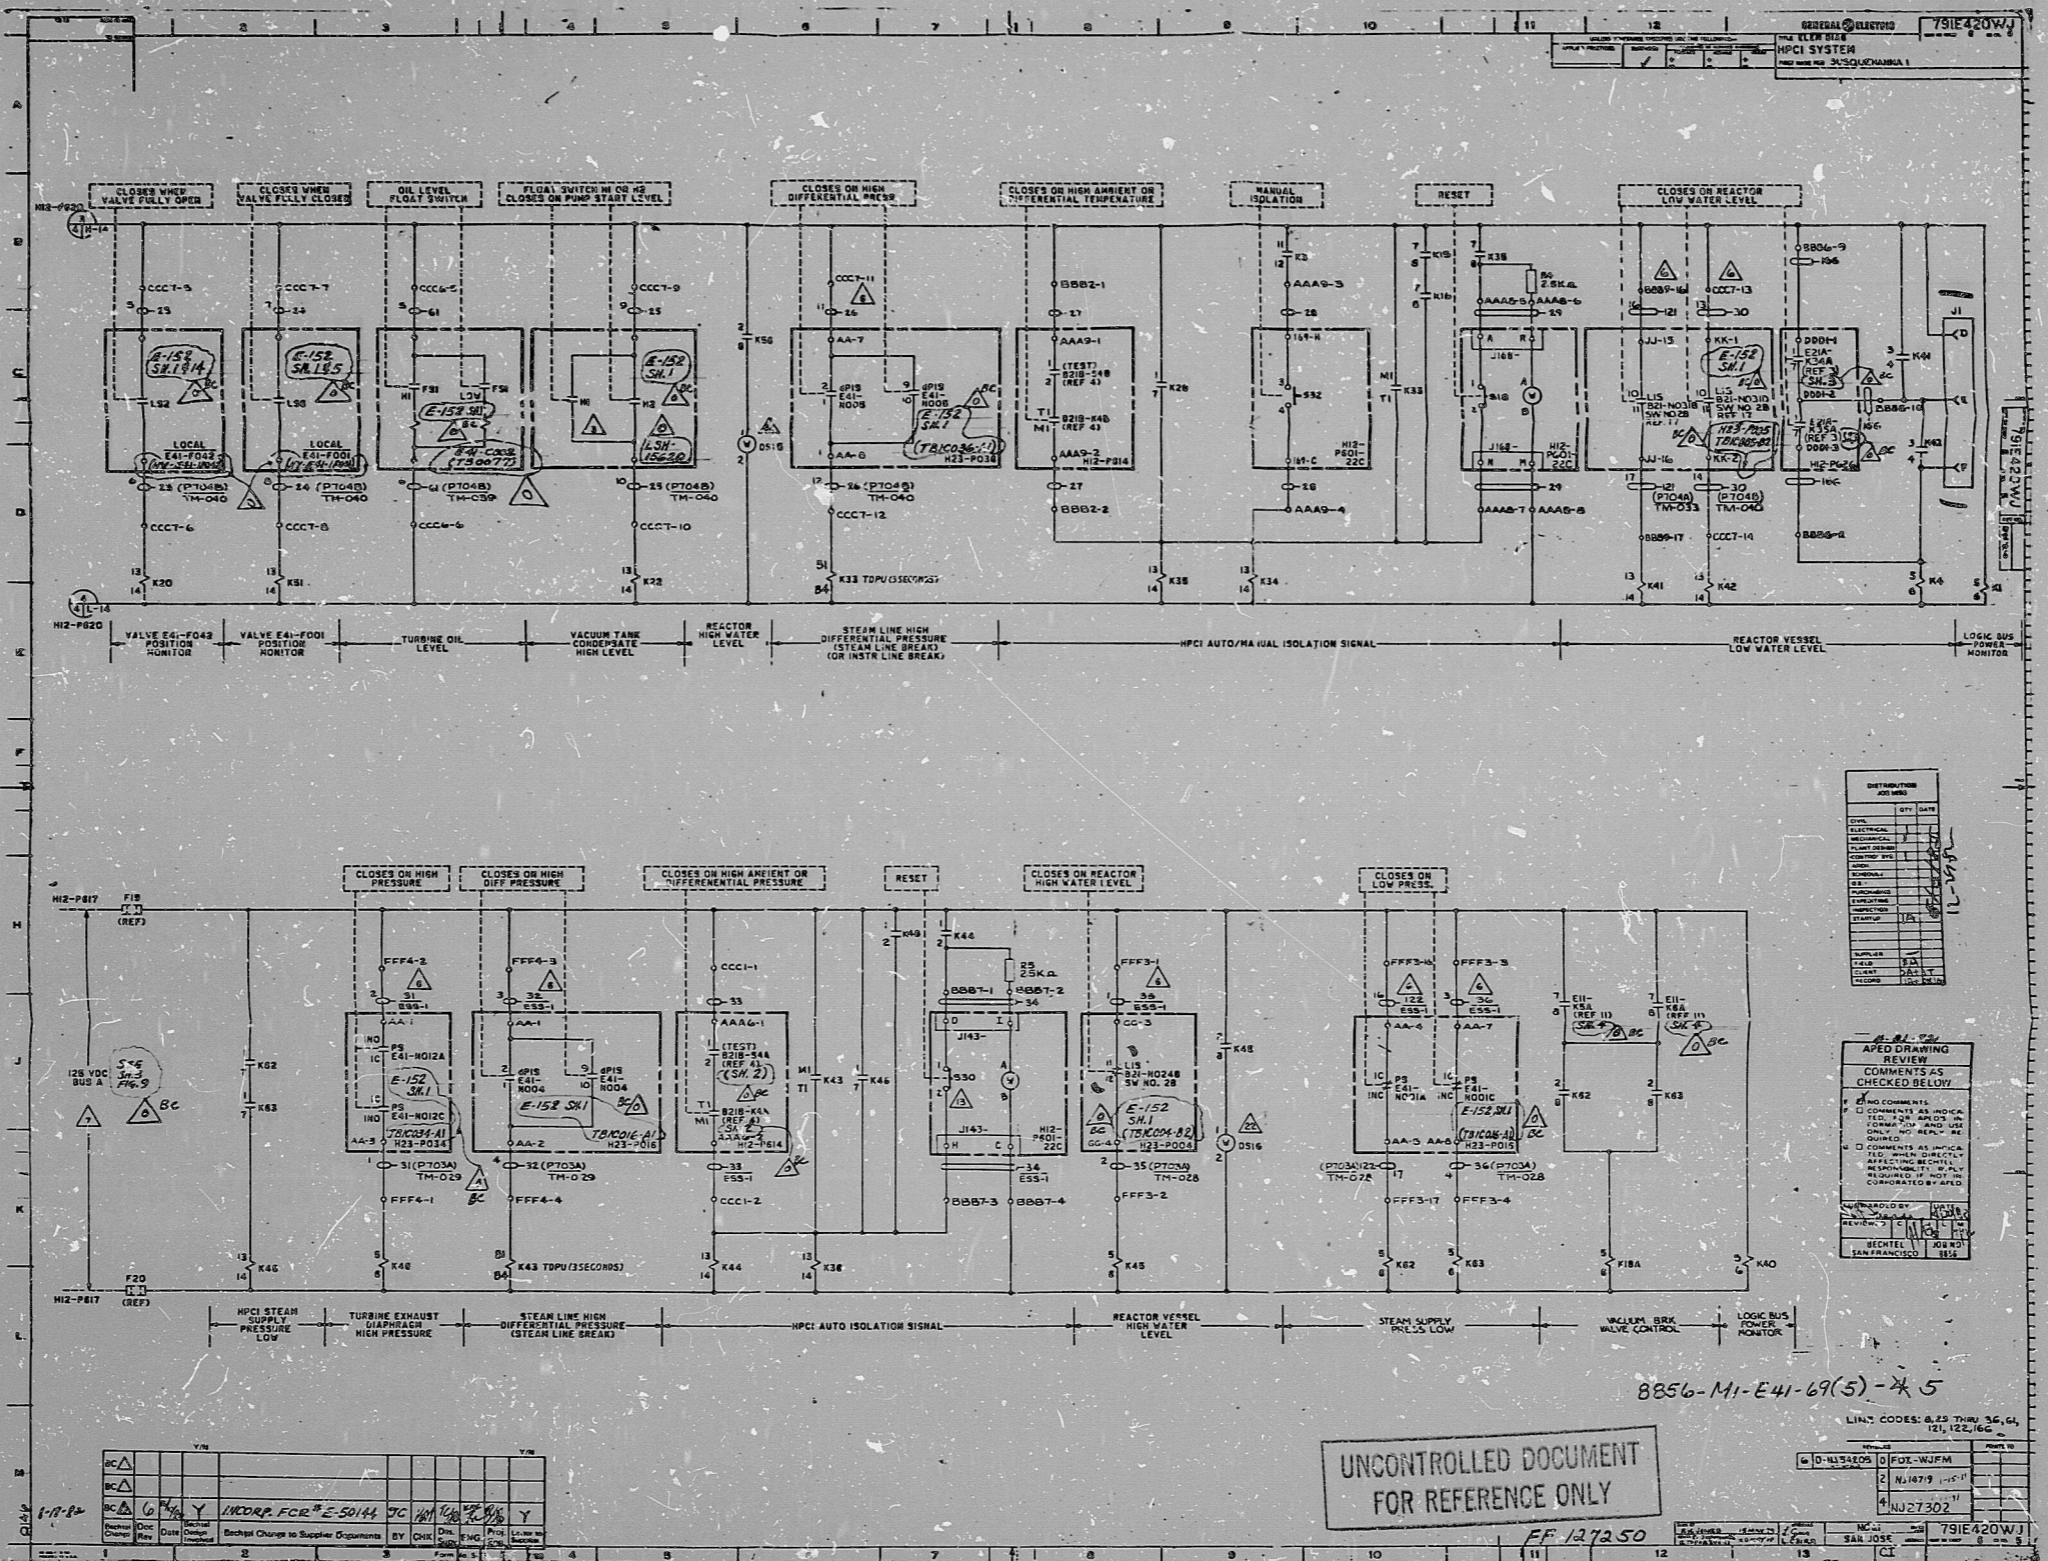

DATE	BY	REVISION

NO.	DATE	BY	REVISION

8856-M1-E41-69(5)-X 5

LINE CODES: 8, 25, THRU 36, 64, 121, 122, 166

NO.	DATE	BY	REVISION

UNCONTROLLED DOCUMENT
FOR REFERENCE ONLY

FF 127250

NO.	DATE	BY	REVISION

24X

I certify that the microfilm image contained on this microform was made in the normal and regular course of business. This is a true, full, correct and complete reproduction and replacement for and/or in lieu of original documents generated by the original group of computers.

Operator Date 1-10-82 Camera Type MRGI

PRC
APERTURE
CARD

88

11

8.5

8.5

11

17

RIDS

805259064

