
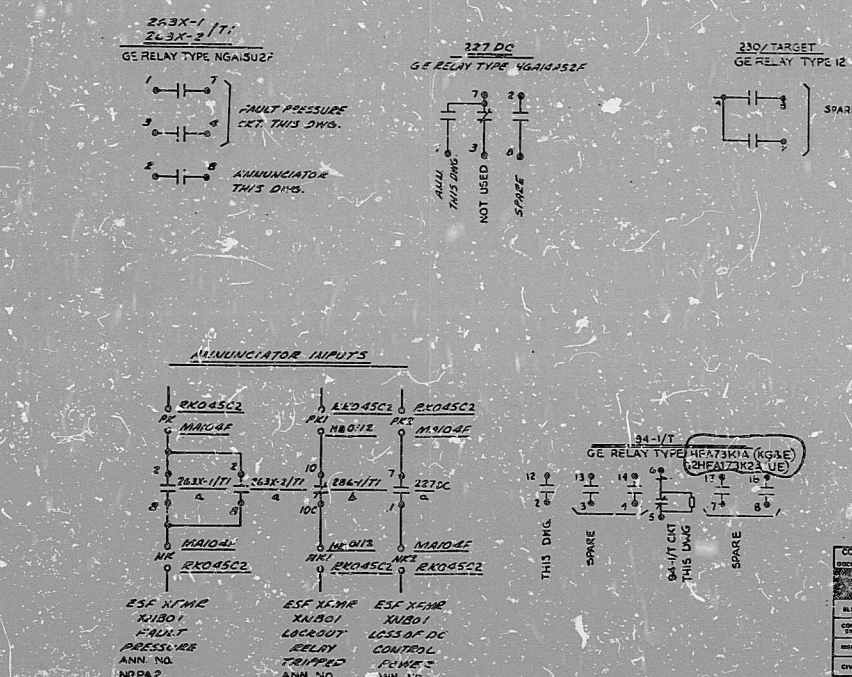


- REFERENCE DRAWINGS
- 10466-E-01801
  - 10466-E-020301
  - 10466-E-030812
  - 10466-E-030812
  - 10466-E-030812
  - 10-10444-J-108-0059(ANN. REF)
- NOTES:
- ALL CABLE PULLS TO SWITCHYARD WILL BE MADE BY SITE.
  - DISCONNECTS WITHIN POWER BLOCK BUILDINGS WILL BE PROVIDED BY BECHTEL FOR THIS.
  - JUMPEES ARE PROVIDED FOR REMOVAL FOR SITE WHICH DO NOT REQUIRE THE ABOVE SCHEME FOR TAPPING. BETWEEN PLANT AND SWTD, CONTACTS FROM LOCKOUT RELAY(S) MAY BE USED TO TRIP SWTD IF GROUNDING RELAYS WILL BE GE TYPE H2473A1A.
  - TARGET RELY TYPE 12 HAA15A4F

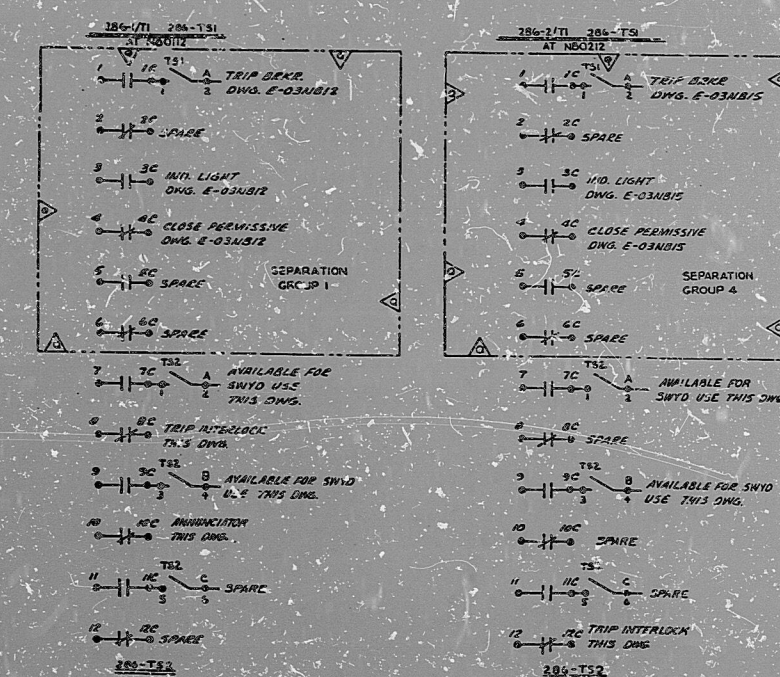

TI APERTURE CARD

NO.	DATE	BY	REVISIONS
1	10/11/8	...	...
2	...	...	...
3	...	...	...
4	...	...	...
5	...	...	...
6	...	...	...
7	...	...	...
8	...	...	...
9	...	...	...
10	...	...	...
11	...	...	...
12	...	...	...

COORDINATION SHEET FOR SCHEMATIC OF E-03NB10

NO.	DATE	BY	REVISIONS
1	10/11/8	...	...
2	...	...	...
3	...	...	...
4	...	...	...
5	...	...	...
6	...	...	...
7	...	...	...
8	...	...	...
9	...	...	...
10	...	...	...
11	...	...	...
12	...	...	...

BECHTEL  
GARHERING, WISCONSIN

SCHEMATIC DIAGRAM  
13.8 KV XN501 XFMR FEEDER

10466 E-03NB10 (C) 11



21516

8410040857

PDR RIDS

