


UNCONTROLLED DOCUMENT
FOR REFERENCE ONLY

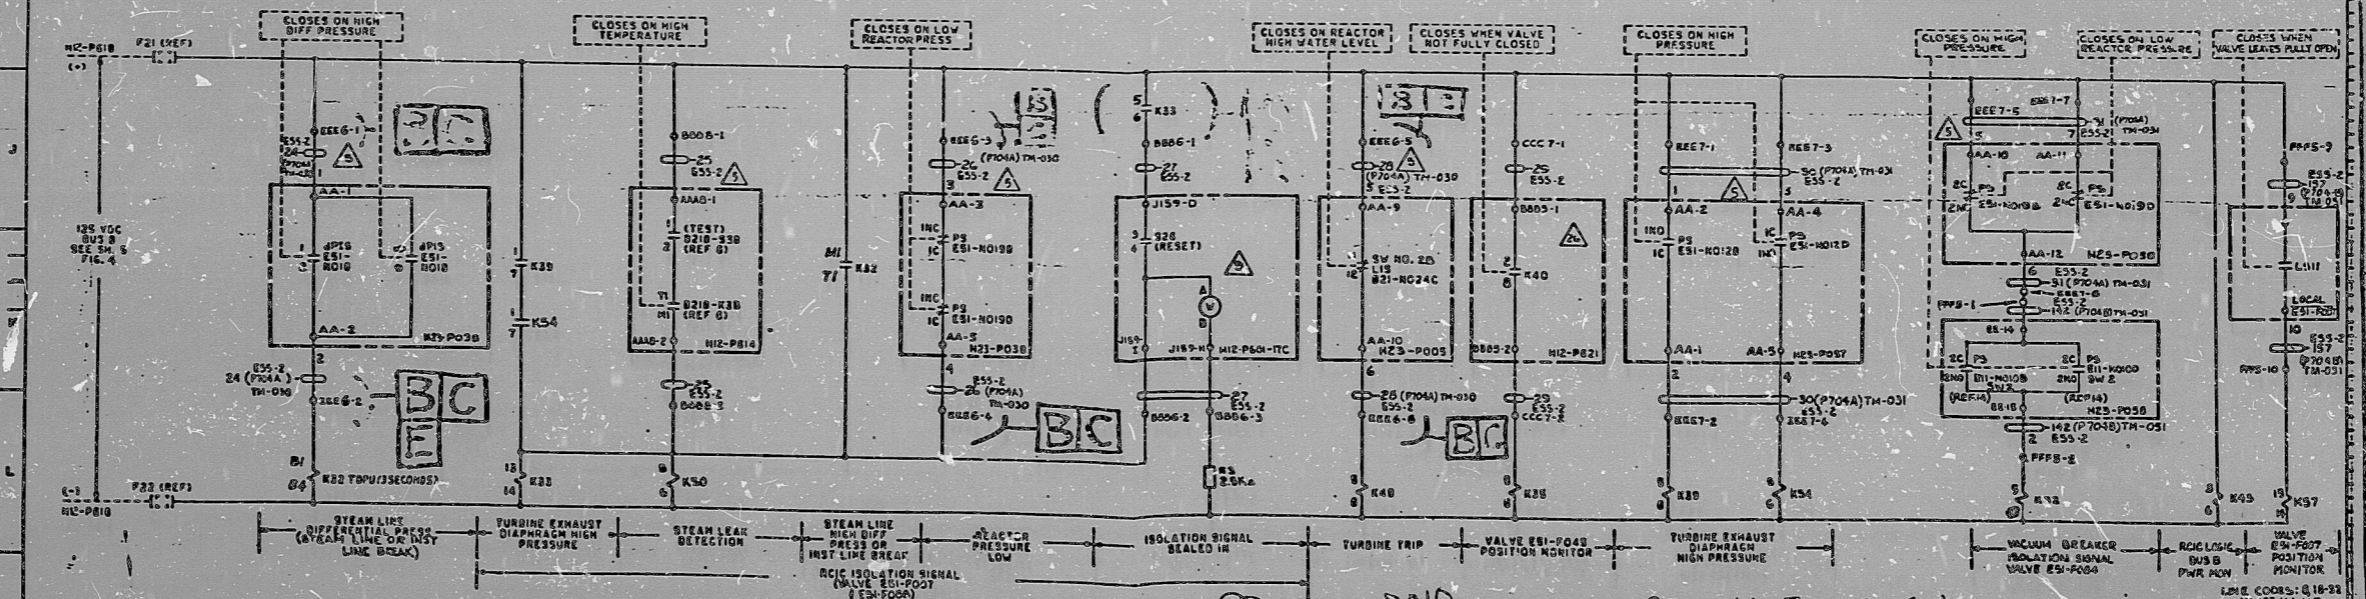

FF 12910
SK 9004
Rev. 10
RECEIVED
JAN 4 1982
NUCLEAR REG. SYS.
FF 12910

8856-MI-E51-90(4)-10

NO.	REV.	DATE	BY	DESCRIPTION
1	1	11/14/78
2	2	11/14/78
3	3	11/14/78
4	4	11/14/78
5	5	11/14/78
6	6	11/14/78
7	7	11/14/78
8	8	11/14/78
9	9	11/14/78
10	10	11/14/78

15X

I CERTIFY THAT THE IMAGE CONTAINED ON THIS FRAME WAS MADE IN THE NORMAL AND REGULAR COURSE OF BUSINESS, ON THE DATE STATED BELOW, AND THAT IT IS AN ACCURATE REPRODUCTION OF THE DOCUMENT SUBMITTED TO MICROGRAPHICS.

PRO
APERTURE
CARD

RIDS

8305250079

