

17"

17"

11"

11"

8.5"

8.5"

8.5"


8.5"

11"

11"

17"

17"

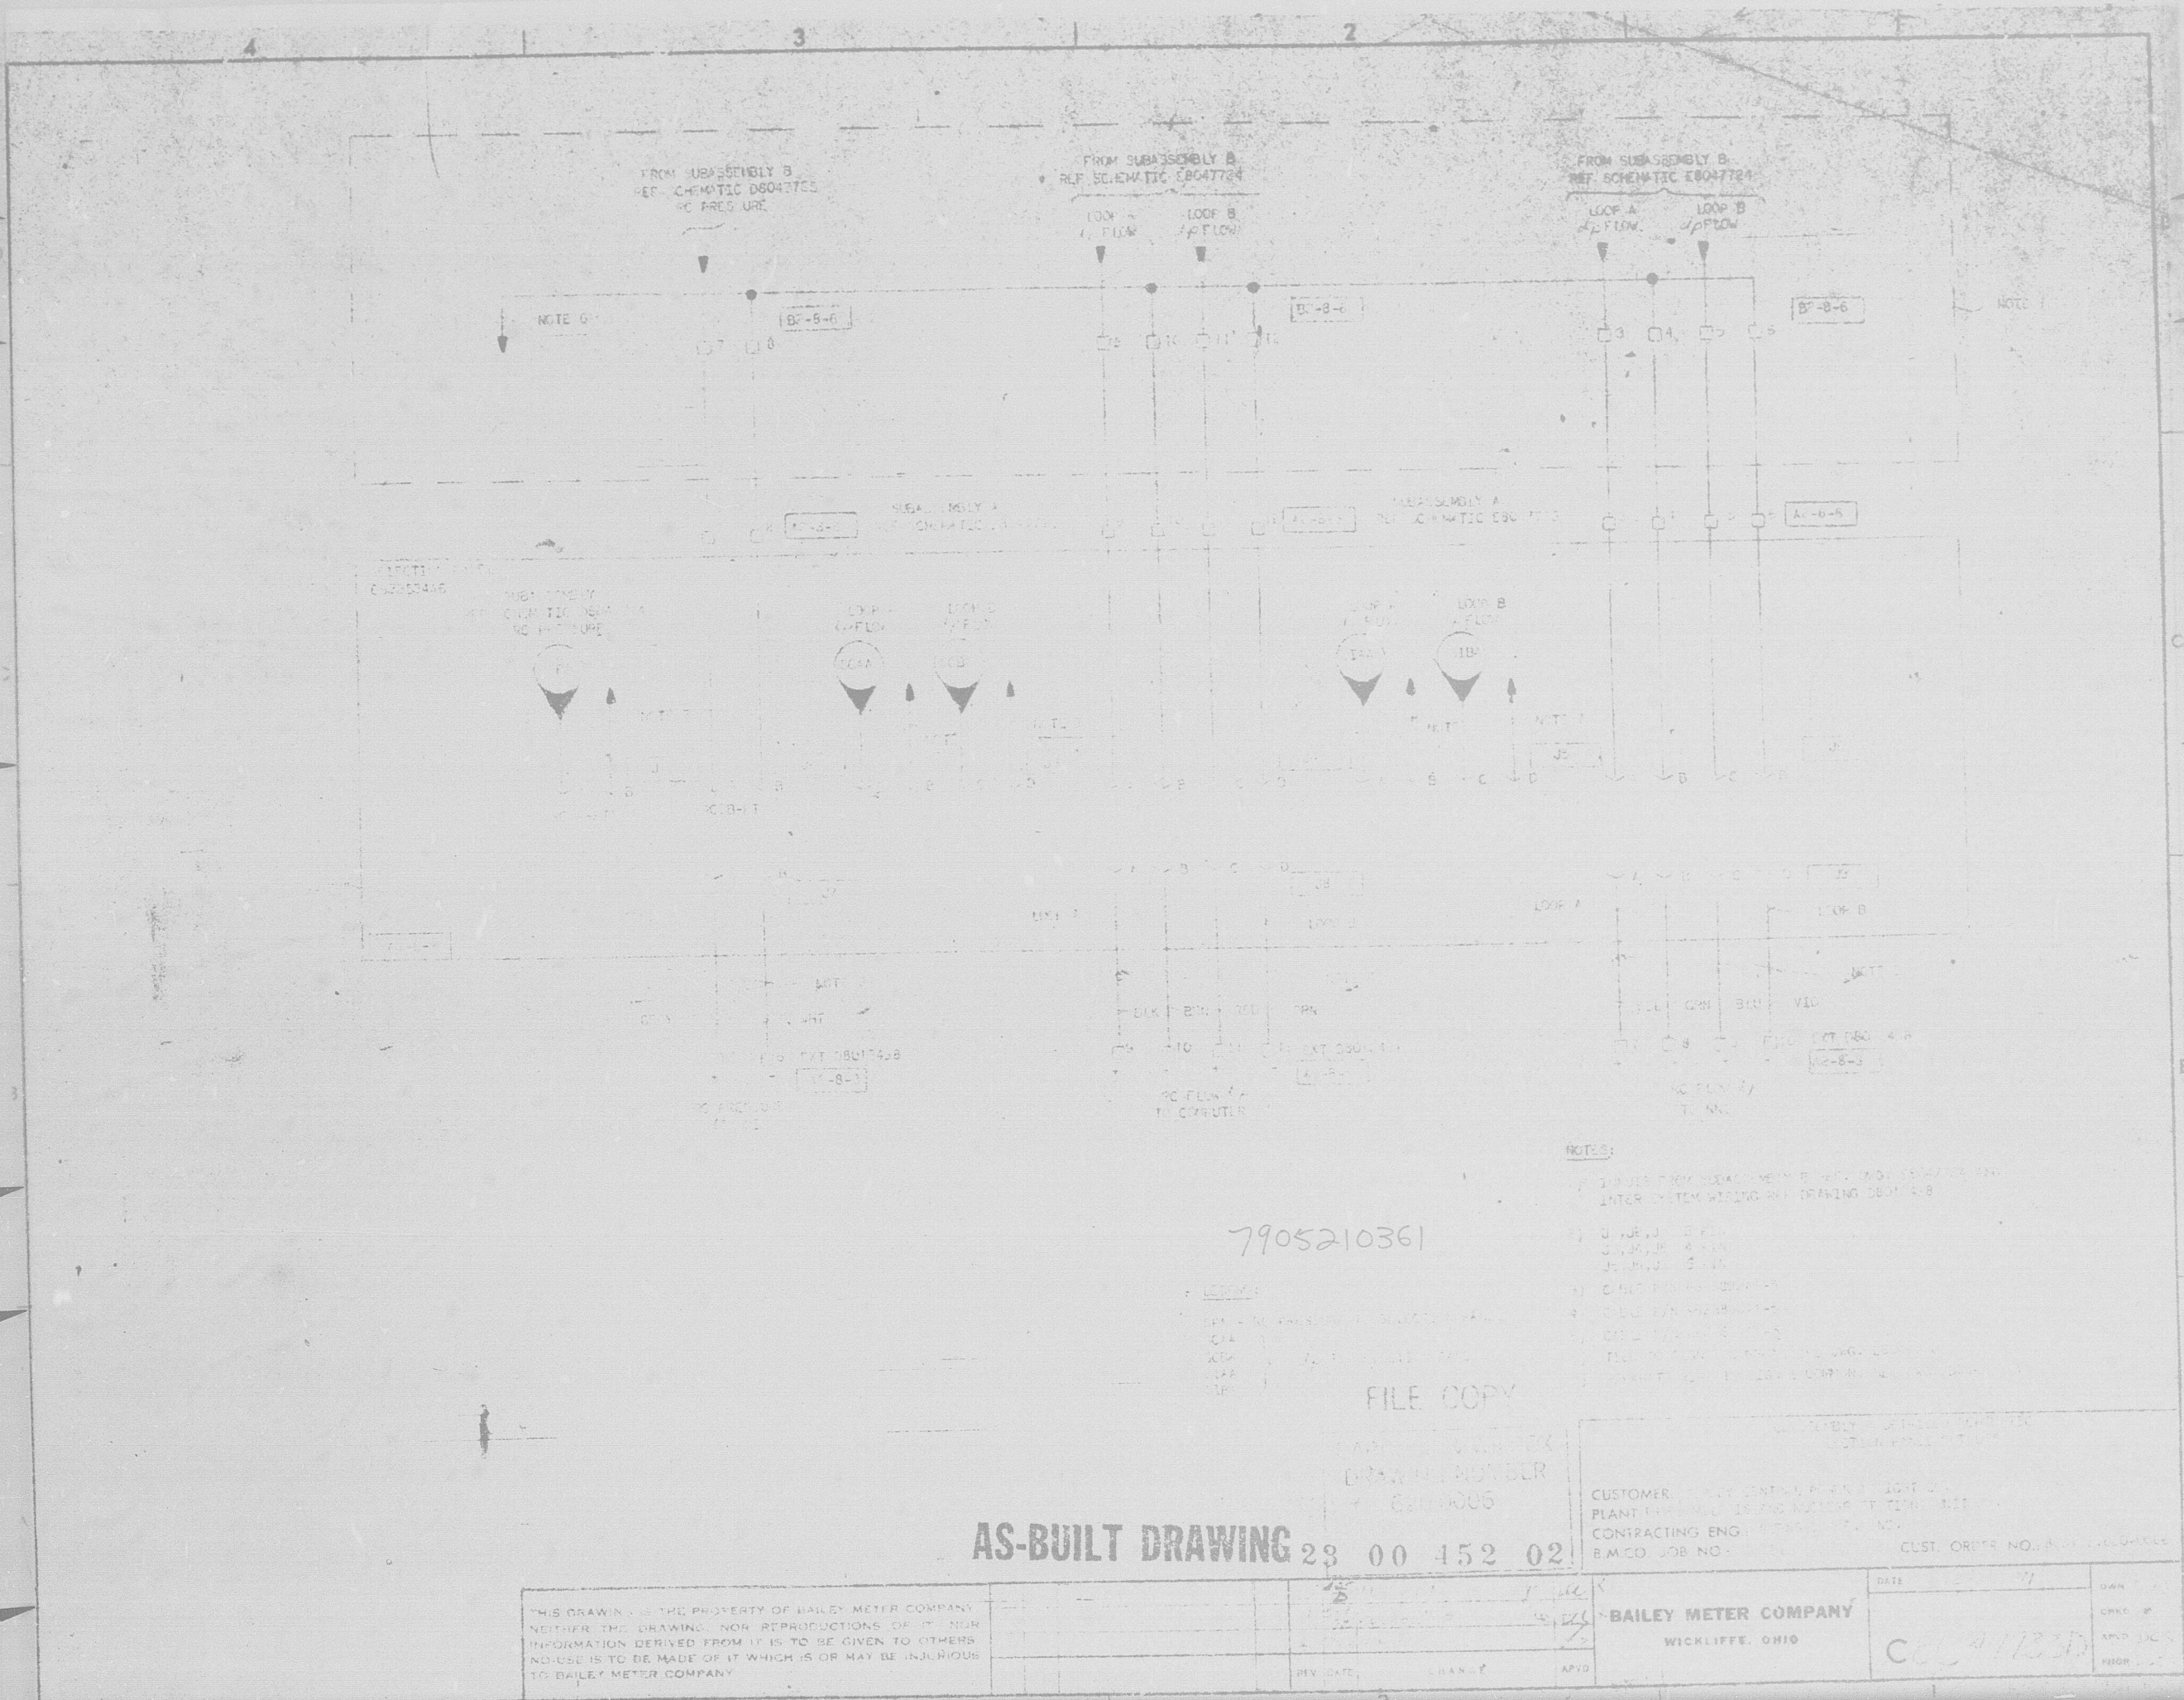

7905210361

FILE COPY

AS-BUILT DRAWING 28 00 452 02

THIS DRAWING IS THE PROPERTY OF BAILEY METER COMPANY. NEITHER THE DRAWING, NOR REPRODUCTIONS OF IT, NOR INFORMATION DERIVED FROM IT IS TO BE GIVEN TO OTHERS. NO USE IS TO BE MADE OF IT WHICH IS OR MAY BE INJURIOUS TO BAILEY METER COMPANY.

BAILEY METER COMPANY
WICKLIFFE, OHIO

DATE	11/13/80	DWN	C.B.
CHKD		APPROVED	
REGR			

7905210361

7905210361

