


This drawing and its contents shall not be reproduced, copied, loaned, exhibited, or used except in the limited way and provide use permitted by written consent given by the SAFPS Utilites to the borrower.

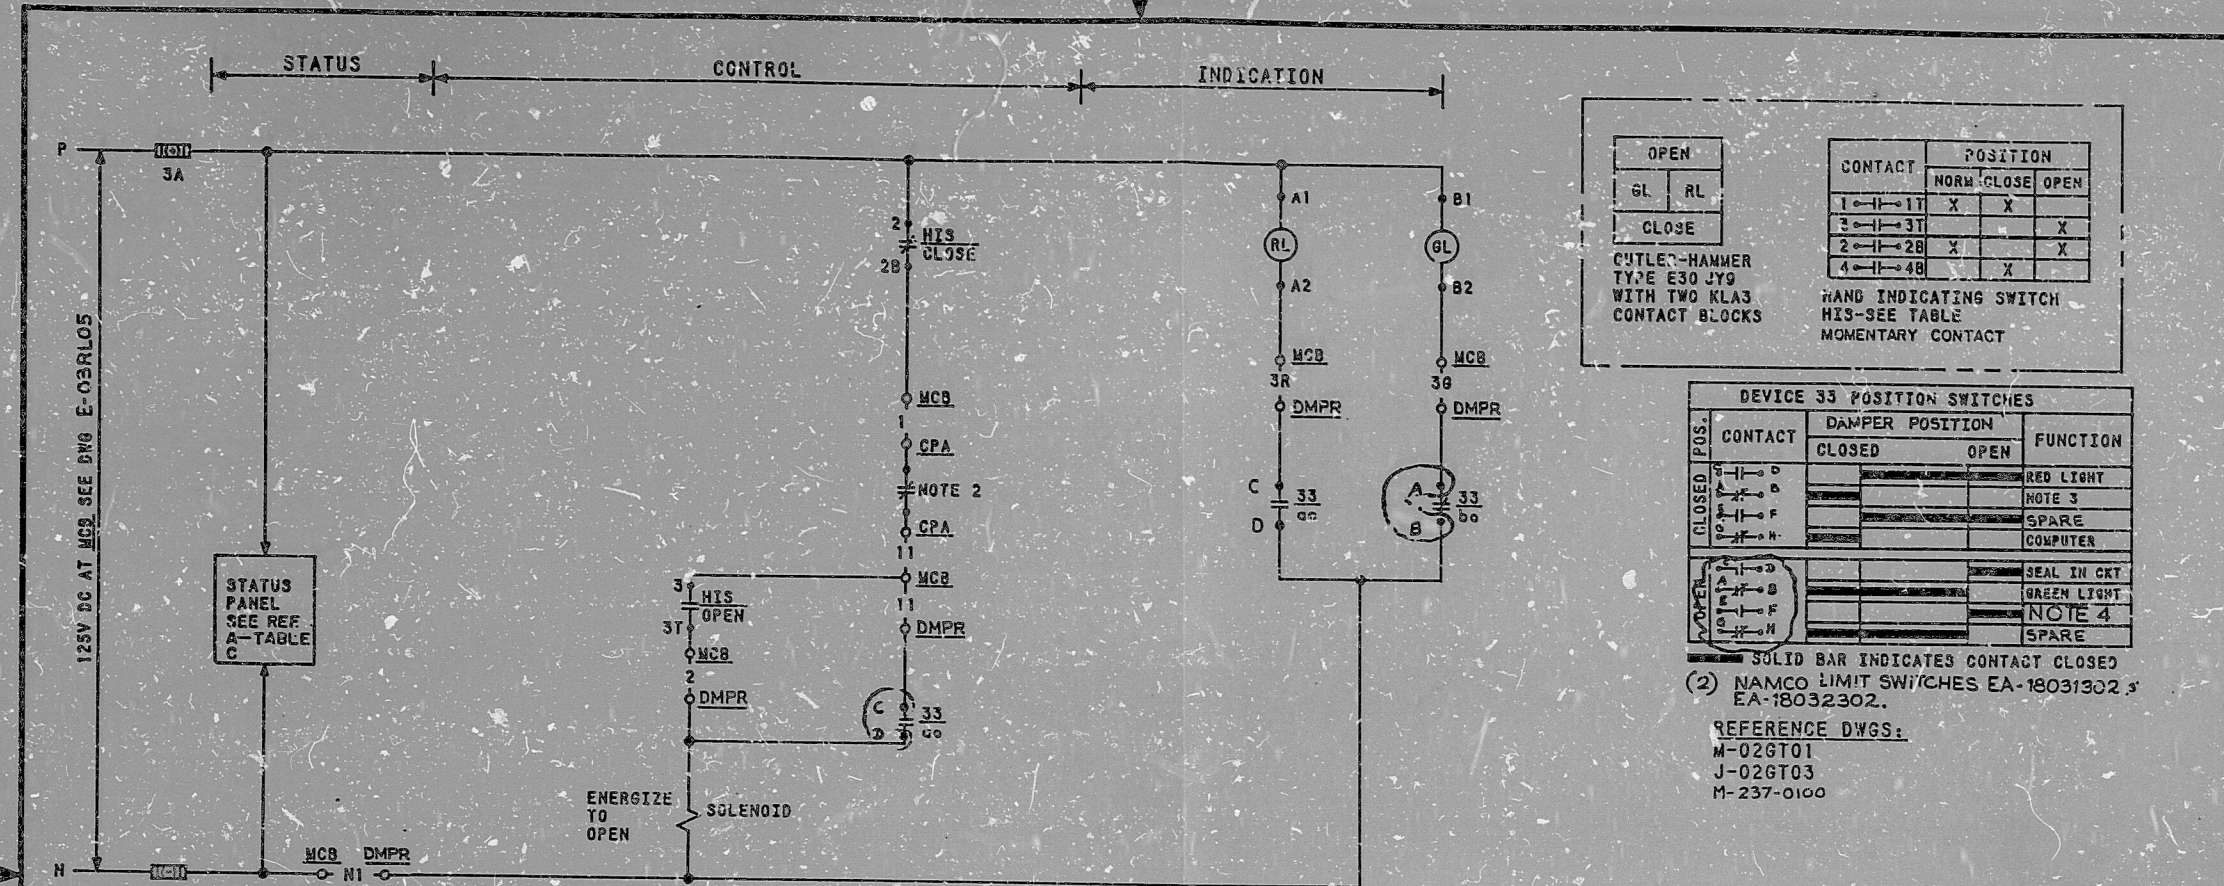

OPEN		CONTACT		POSITION		
GL	RL			NORM	CLOSE	OPEN
		1	1-17	X	X	
		3	1-31			X
		2	1-28	X		X
		4	1-48		X	X

CUTLER-HAMMER
 TYPE E30 JY9
 WITH TWO K1A3
 CONTACT BLOCKS

HAND INDICATING SWITCH
 HIS-SEE TABLE
 MOMENTARY CONTACT

DEVICE 33 POSITION SWITCHES			
CONTACT	DAMPER POSITION		FUNCTION
	CLOSED	OPEN	
A			RED LIGHT
B			NOTE 3
F			SPARE
H			COMPUTER
A			SEAL IN CKT
B			GREEN LIGHT
F			NOTE 4
H			SPARE

(2) NAMCO LIMIT SWITCHES EA-18031302, EA-18032302.
 REFERENCE DWGS:
 M-026T01
 J-026T03
 M-237-0100

- DAMPER SHOWN IN FULL CLOSED POSITION.
- CONTACT USED TO INTLK. WITH GTRV22 A & B. REFER TO DWG. E-036T13 (C). THIS ONLY APPLIES TO GTHZ 3 CONTACT IS SPARE FOR DAMPERS GTHZ 9, 6, & 12.
- TO STATUS PANEL - SEE REF B, TABLE C.
- CONTACT OPENS ON CONTAINMENT PURGE ISOLATION SIGNAL. SEE BECHTEL V.P. NO. J-104-0034 & J-104-0012.

NOTES:

REV'D	REV'D	REV'D	REV'D	REV'D	REV'D	REV'D	REV'D	REV'D	REV'D
1/10/72	1/10/72	1/10/72	1/10/72	1/10/72	1/10/72	1/10/72	1/10/72	1/10/72	1/10/72
REV'D	REV'D	REV'D	REV'D	REV'D	REV'D	REV'D	REV'D	REV'D	REV'D
NOTE 4	ADDED	REV'D	NOTE 2	ADDED	REV'D	NOTE 1	ADDED	REV'D	NOTE 3
REV'D	NOTE 2	ADDED	REV'D	NOTE 1	ADDED	REV'D	NOTE 3	ADDED	REV'D
REV'D	NOTE 1	ADDED	REV'D	NOTE 3	ADDED	REV'D	NOTE 4	ADDED	REV'D
REV'D	NOTE 3	ADDED	REV'D	NOTE 4	ADDED	REV'D	NOTE 5	ADDED	REV'D
REV'D	NOTE 4	ADDED	REV'D	NOTE 5	ADDED	REV'D	NOTE 6	ADDED	REV'D
REV'D	NOTE 5	ADDED	REV'D	NOTE 6	ADDED	REV'D	NOTE 7	ADDED	REV'D
REV'D	NOTE 98	ADDED	REV'D	NOTE 99	ADDED	REV'D	NOTE 100	ADDED	REV'D

BECHTEL
 GAITHERSBURG, MARYLAND
 SNUPPS
 SCHEMATIC DIAGRAM
 SHUTDOWN PURGE SYSTEM CONTAINMENT
 ISOLATION DAMPERS

SCALE	DESIGNED	DRAWN	CAD	CHECK
1/1"	EJD			
DATE	REVISION	BY	CHK	DESIGNED
JOB NO.	BECHTEL DRAWING NO.	REV.		
10406	E-036T04 (0)	3		
DRAWING APPLICABLE TO SHEETS	1	2	3	4

TABLE C

STATUS PNL REF B	E-035A17	E-035A18	E-035A17	E-035A18
STATUS PNL REF A	E-035A20	E-035A19	E-035A20	E-035A19

TABLE B

REFER COMP DWG	J-106-0115	J-106-0115	J-106-0115	J-106-0115
BECHTEL V.P. NO.				
COMPUTER POINT	6TZ6	6TZ12	6TZ4	6TZ9
COMPUTER LOCATION-PC	RJ100A	RJ159A	RJ100A	RJ159A
DMPR LOCATION-DMPR	6THZ6	6THZ12	6THZ4	6THZ9
COMPUTER SCHEME NO.	49TR04A	16TR04B	49TR04C	16TR04D

ESAS RELAY CONTACT NO.	K102	K104	K101	K103
HIS NUMBER	6THIS6	6THIS12	6THIS4	6THIS9
HIS LOCATION-MCB	RL020	RL020	R020	RL020
LOCATION-CPA	SA038B	SA033A	SA038B	SA038A
DMPR NO.-DMPR	6THZ6	6THZ12	6THZ4	6THZ9
SCHEME NO.	49TK04A	16TK04B	49TK04C	16TK04D

8410040109

PDR RIDS

