

This drawing and the design it covers is the property of the Utilities which are participating in the SNUPPS Project. It is loaned to the borrower's express agreement that it will not be reproduced, copied, loaned, exhibited, or used except in the limited way and private use permitted by written consent given by the SNUPPS Utilities to the borrower.

TABLE A

SCHEME NO.	CP LOCATION	CPA LOCATION	CABLE CODE	COND. NOS.	DESCRIPTION
1NFY01A	NO109	NF039A	G2A	X,U	AC POWER
1NFY01B	NO106	NF039B	G2A	X,U	AC POWER
2NFY01C	NO206	NF039A	G2A	X,U	AC POWER
2NFY01D	NO209	NF039B	G2A	X,U	AC POWER
3NFY01E	NO309	NF039A	G2A	X,U	AC POWER
3NFY01F	NO303	NF039B	G2A	X,U	AC POWER
4NFY01G	NO407	NF039A	G2A	X,U	AC POWER
4NFY01H	NO409	NF039B	G2A	X,U	AC POWER
1NFK01A	NK4117	NF039C	G2B	P,H	DC POWER
4NFK01A	NK4112	NF039C	G2B	P,H	DC POWER
1NFK01C	NO101	NF039A	CO2	AAS,AASR	UV RELAY INPUT
1NFK01D	NO210	NF039B	CO2	AAS,AASR	UV RELAY INPUT
2NFK01C	NO113	NF039A	CO2	BBS,BBSR	UV RELAY INPUT
2NFK01D	NO216	NF039B	CO2	BBS,BBSR	UV RELAY INPUT
3NFK01C	NO117	NF039A	CO2	CCS,CCSR	UV RELAY INPUT
3NFK01D	NO217	NF039B	CO2	CCS,CCSR	UV RELAY INPUT
4NFK01C	NO116	NF039A	CO2	DDS,DDSR	UV RELAY INPUT
4NFK01D	NO201	NF039B	CO2	DDS,DDSR	UV RELAY INPUT
1NFY01E	NO101	NF039A	CO2	AAA,AAAR	PT INPUT
1NFY01F	NO210	NF039B	CO2	AAA,AAAR	PT INPUT
2NFY01E	NO113	NF039A	CO2	BBA,BBAR	PT INPUT
2NFY01F	NO216	NF039B	CO2	BBA,BBAR	PT INPUT
3NFY01G	NO117	NF039A	CO2	CCA,CCAR	PT INPUT
3NFY01H	NO217	NF039B	CO2	CCA,CCAR	PT INPUT
4NFY01E	NO116	NF039A	CO2	DDA,DDAR	PT INPUT
4NFY01F	NO201	NF039B	CO2	DDA,DDAR	PT INPUT

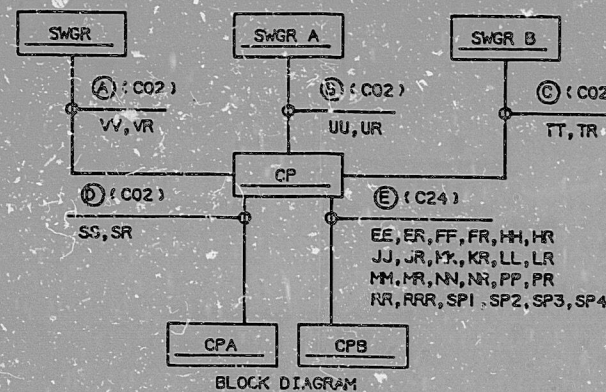
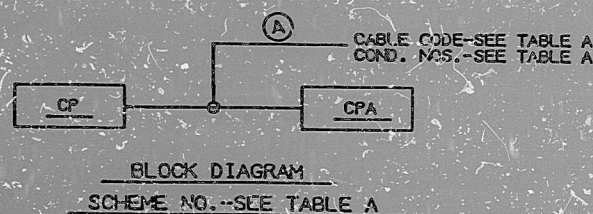


TABLE B

SWGR B LOCATION	NO112	NO212	OFFSITE BRKR POS.
SWGR A LOCATION	NO109	NO209	OFFSITE BRKR POS.
SWGR C LOCATION	NO111	NO211	DB BRKR POS.
CPB LOCATION	SB239C	SB320C	SSPS INPUTS (SIS,CSAS)
CPA LOCATION	SA038A	SA038B	ESFAS INPUT (CRVIS)
CP LOCATION	NF039A	NF039B	SAI,GAZ
SCHEME NO.	1NFK01G	4NFK01H	

INPUT SIGNAL DESCRIPTION

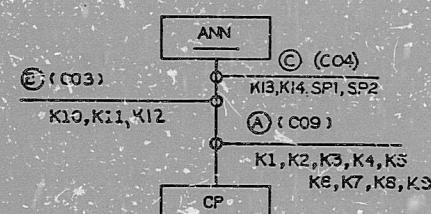


TABLE C

ANNUNCIATOR PT.	NEOAI	NEOAI	NEOAI
ANN REF DWG.	J-108-0039	J-108-0024	J-108-0024
BECHTEL V.R. NO.	J-108-0041	J-108-0061	J-108-0062
ANN LOCATION	RMO43C2	RMO43C4	
CP LOCATION	NF039A	NF039B	
SCHEME NO.	5NFK01A	6NFK01B	

ANNUNCIATOR INPUTS

TABLE E

OUTPUT SIGNAL DESCRIPTION	BLACKOUT SEP GRP1	BLACKOUT SEP GRP4
CPA LOCATION	SA038A	SA038B
LOAD SHED RELAY CONTACT NO.	K108 4,5	K4108 4,5
CP LOCATION	NF039C	NF039C
SCHEME NO.	1NFK01J	4NFK01K

REVIEW LEVEL 3

TABLE D

CABLE ID	REFER SEQUENCED DEVICE	COND. NOS.	INPUT RELAY
E	DPEFOIA, B	EE, ER	K601/4,10
E	LOCN SHLD	FF, FR	K702/13,19
E	(SPARE)	HH, HR	K609/13,14
E	DPEFOIA, B, C, D	JJ, JR	K609/13,14
E	DPEFOIA, B/DPEFOIA, B, C, D	KK, KR	K610/1,2
E	DPEFOIA, B/DPEFOIA, B, C, D	LL, LR	K615/1,2
E	DPEFOIA, B/DPEFOIA, B, C, D	MM, MR	K616/1,2
E	DPEFOIA, B	NN, NR	K603/11,12
E	DPEFOIA, B	PP, PR	K643/9,10
E	LOCN. SEQ	RR, RR	K645/7,8
E		SP1, SP2, SP3, SP4	K121/6,7
D	SAI, GAZ	SS, SR	K131/6,7

SEQUENCER INPUTS

SEE TABLE D FOR CONDUCTOR ASSIGNMENTS

REFER. DWG.:

E-02NFOI

TI
APERTURE
CARD

I. REFER. VENDOR DWG. J-104-0043 & 44

NOTES:

REV'D TABLE D & E RE: AS BUILT AND INC. SPS'S 2-NF-035A + 2-NF-035B	REV'D TABLE A TO INCORP. SPS'S 2-NF-000A	REV'D TABLE C & D	ISSUED FOR CONSTRUCTION
NO. 1	NO. 2	NO. 3	NO. 4
DATE	DATE	DATE	DATE
DESIGNED EJC	DRAWN DWB	CHECKED	APPROVED
BECHTEL GAITHERSBURG, MARYLAND			
SNUPPS			
SCHEMATIC DIAGRAM LOAD SHEDDER/EMERGENCY LOAD SEQUENCER			
UTILITY DRAWING NO.		REV	
JOB NO.		BECHTEL DRAWING NO.	
10466		E-03NFO1(Q)	
DRAWING APPLICABLE TO UNITS		REV	

I certify that the image contained on this frame was made in the normal and regular course of business, on the date stated below and that it is an accurate reproduction of the document(s) submitted to Micrographics.
DATE 5/19/84 OPERATOR M. L. LAMOND

2-10-56
PDR RIDS

8410040126

