

11


11

5.8

8.5"

11"

17

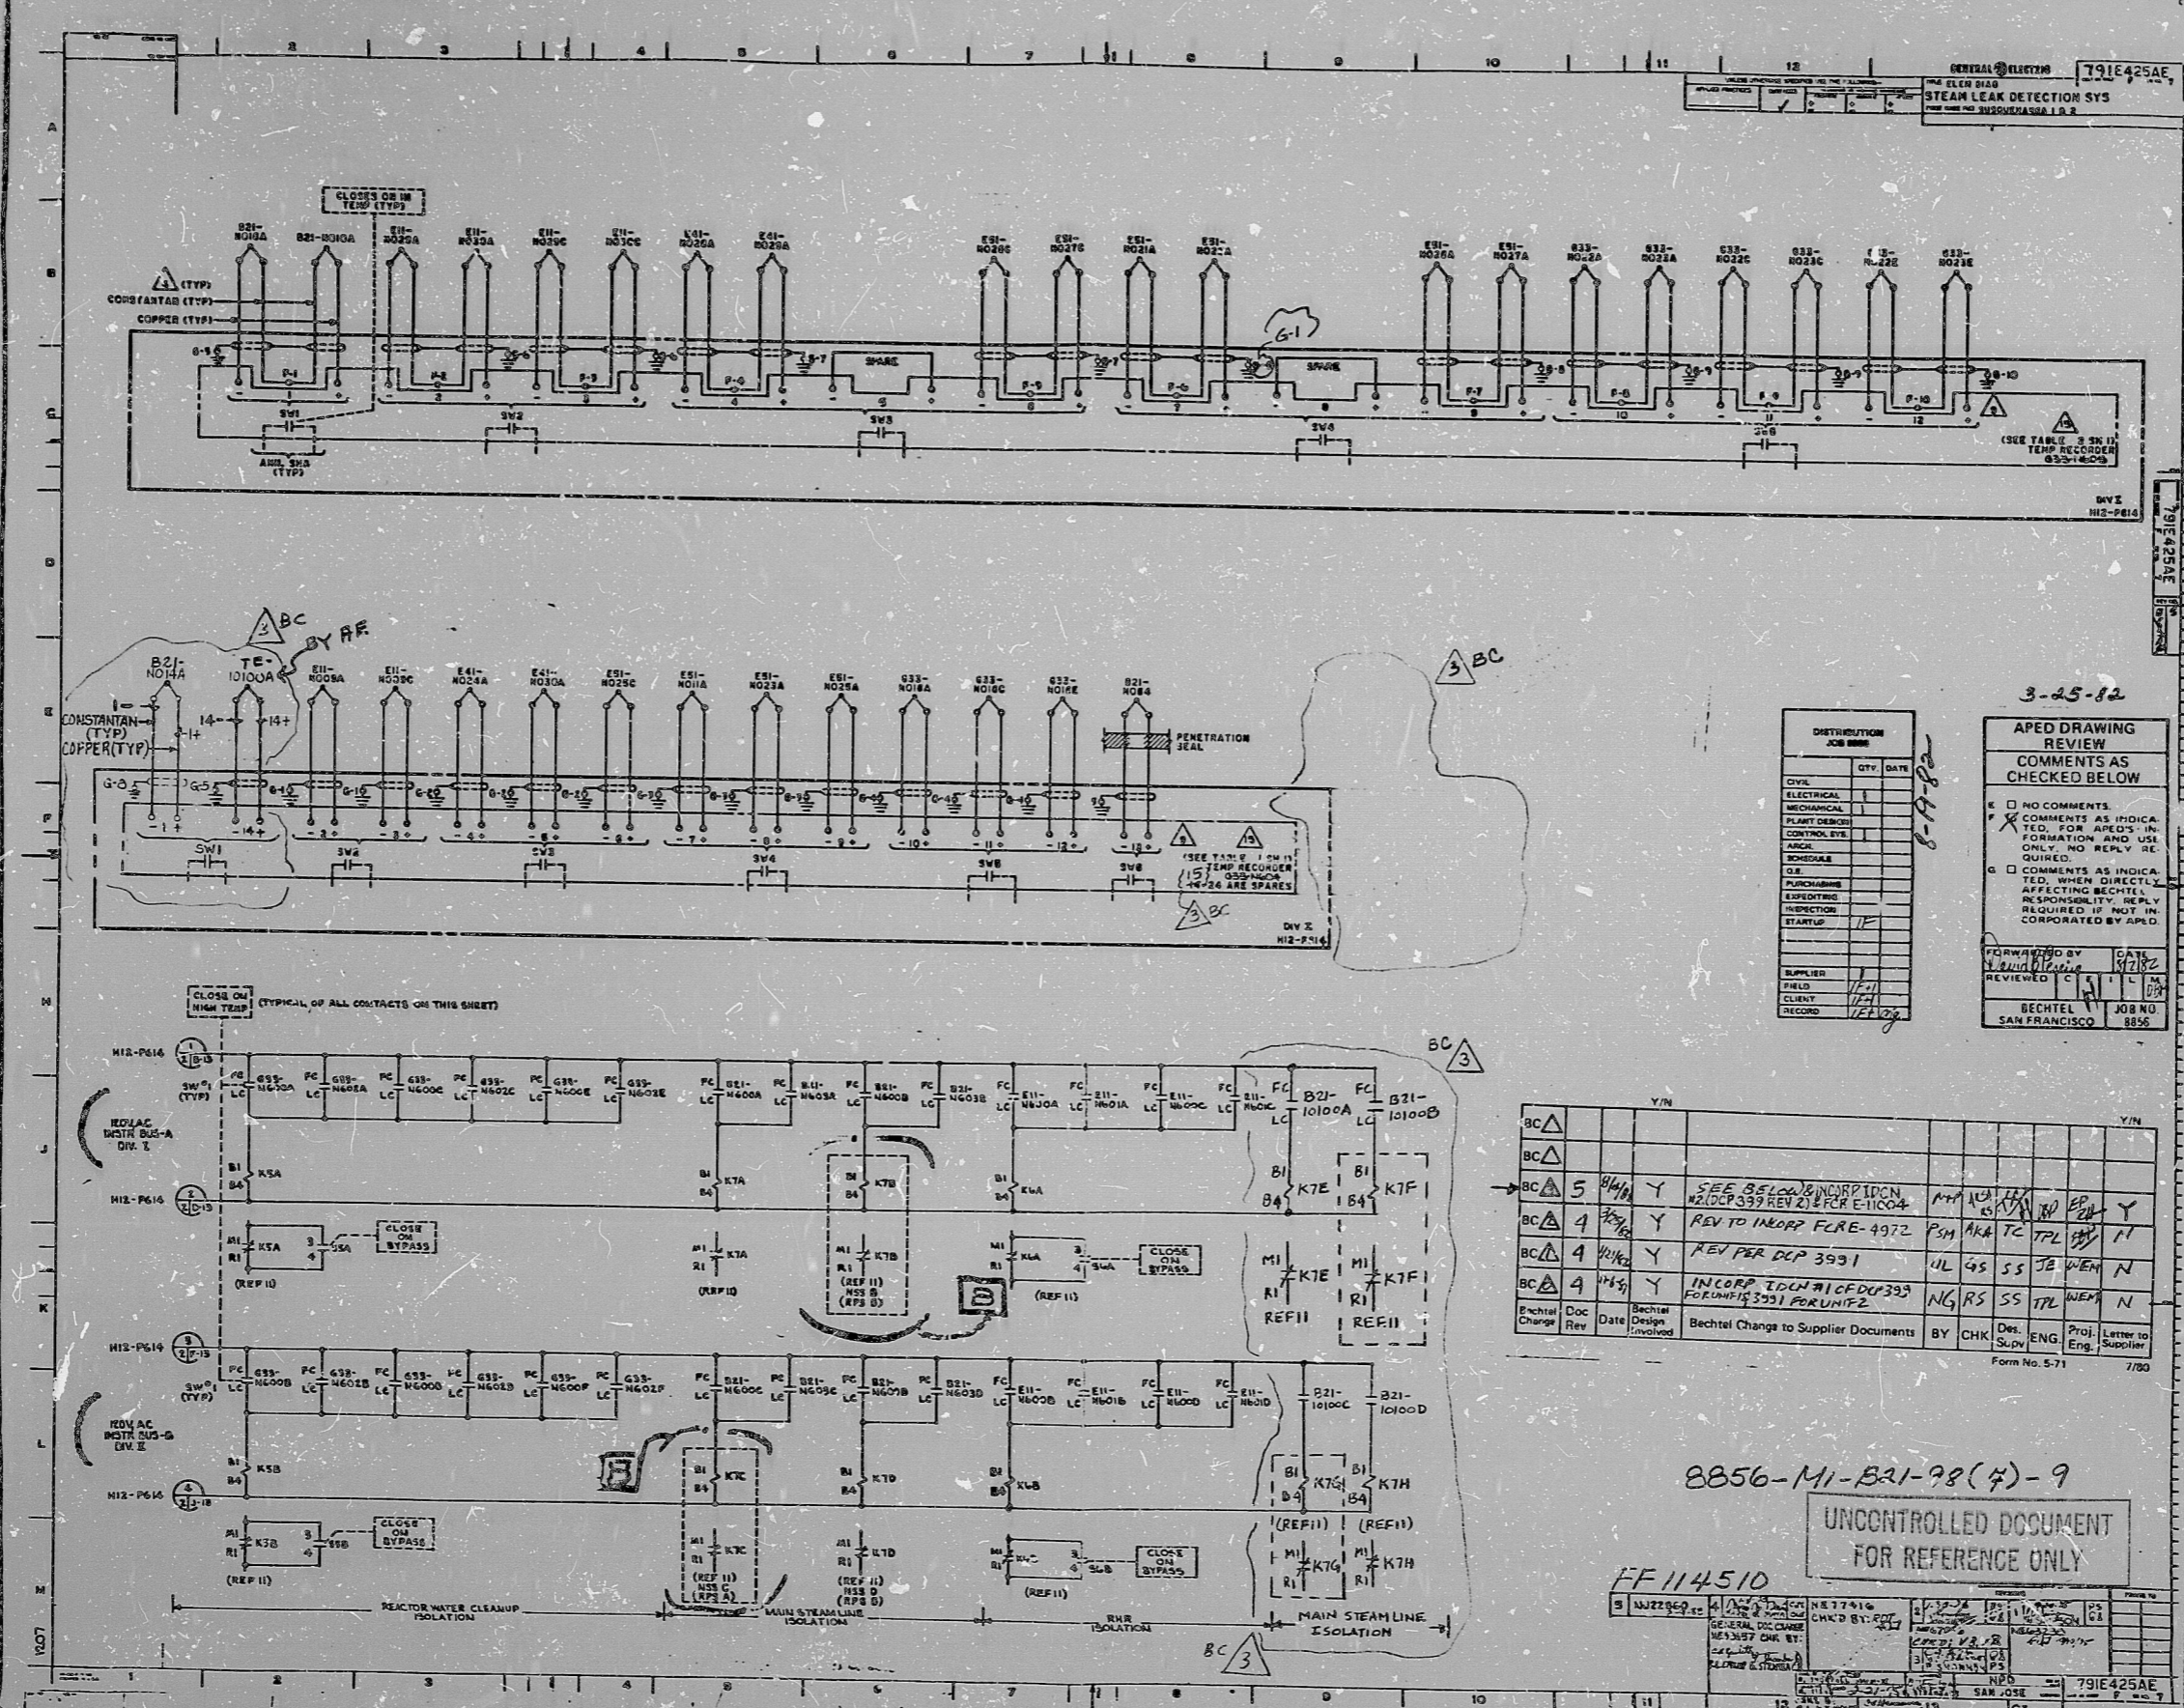

DISTRIBUTION		QTY	DATE
CIVIL			
ELECTRICAL			
MECHANICAL			
PLANT DESIGN			
CONTROL SYSTEMS			
LABOR			
SCHEDULE			
O.R.			
PURCHASING			
EXPEDITING			
INSPECTION			
STARTUP			
SUPPLIER			
FIELD			
CLIENT			
RECORD			

3-25-82

APED DRAWING REVIEW COMMENTS AS CHECKED BELOW

NO COMMENTS

COMMENTS AS INDICATED FOR APED'S INFORMATION AND USE ONLY. NO REPLY REQUIRED.

COMMENTS AS INDICATED WHEN DIRECTLY AFFECTING BECTEL RESPONSIBILITY. REPLY REQUIRED IF NOT INCORPORATED BY APED.

FORWARDED BY: *[Signature]* DATE: 3/25/82

REVIEWED BY: *[Signature]* DATE: 3/25/82

BECTEL JOB NO. 8856
SAN FRANCISCO

Y/N	Y/N	Y/N	Y/N	Y/N	Y/N	Y/N	Y/N	Y/N	Y/N	
BC	5	4/1/82	Y	SEE BELOW INCORPORATION	MP	AL	HK	RD	EP	Y
BC	4	3/27/82	Y	REV TO MODIF FLRE-4972	PM	AK	TC	TP	W	N
BC	4	4/14/82	Y	REV PER DCP 3991	UL	GS	SS	JB	WEM	N
BC	4	4/15/82	Y	INCORP IDEN MFCDCP 3991	NG	RS	SS	TP	WEM	N

Bechtel Change to Supplier Documents BY CHK Des. Supv. Eng. Proj. Eng. Letter to Supplier

Form No. 5-71 7/80

8856-MI-B21-98(4)-9

UNCONTROLLED DOCUMENT FOR REFERENCE ONLY


Rev	Date	By	Checked By	Checked Date
1	3/25/82	CHK	CHK	3/25/82

791E425AE

PRC APERTURE CARD

certify that the microfilm image contained on this microfilm were made from a true and correct copy of the original document. This is a true, fair, correct and complete reproduction and replacement for and/or in lieu of original documents. Bechtel Group, Inc.

DANNY 8-24-82 MRG I

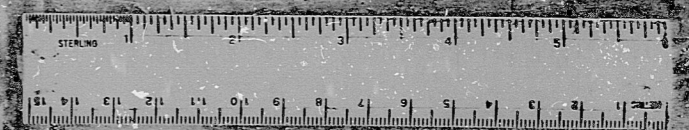

RIDS

8305250123

