

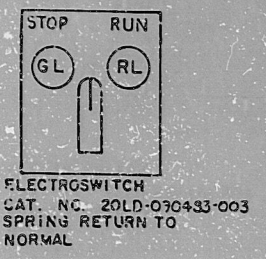
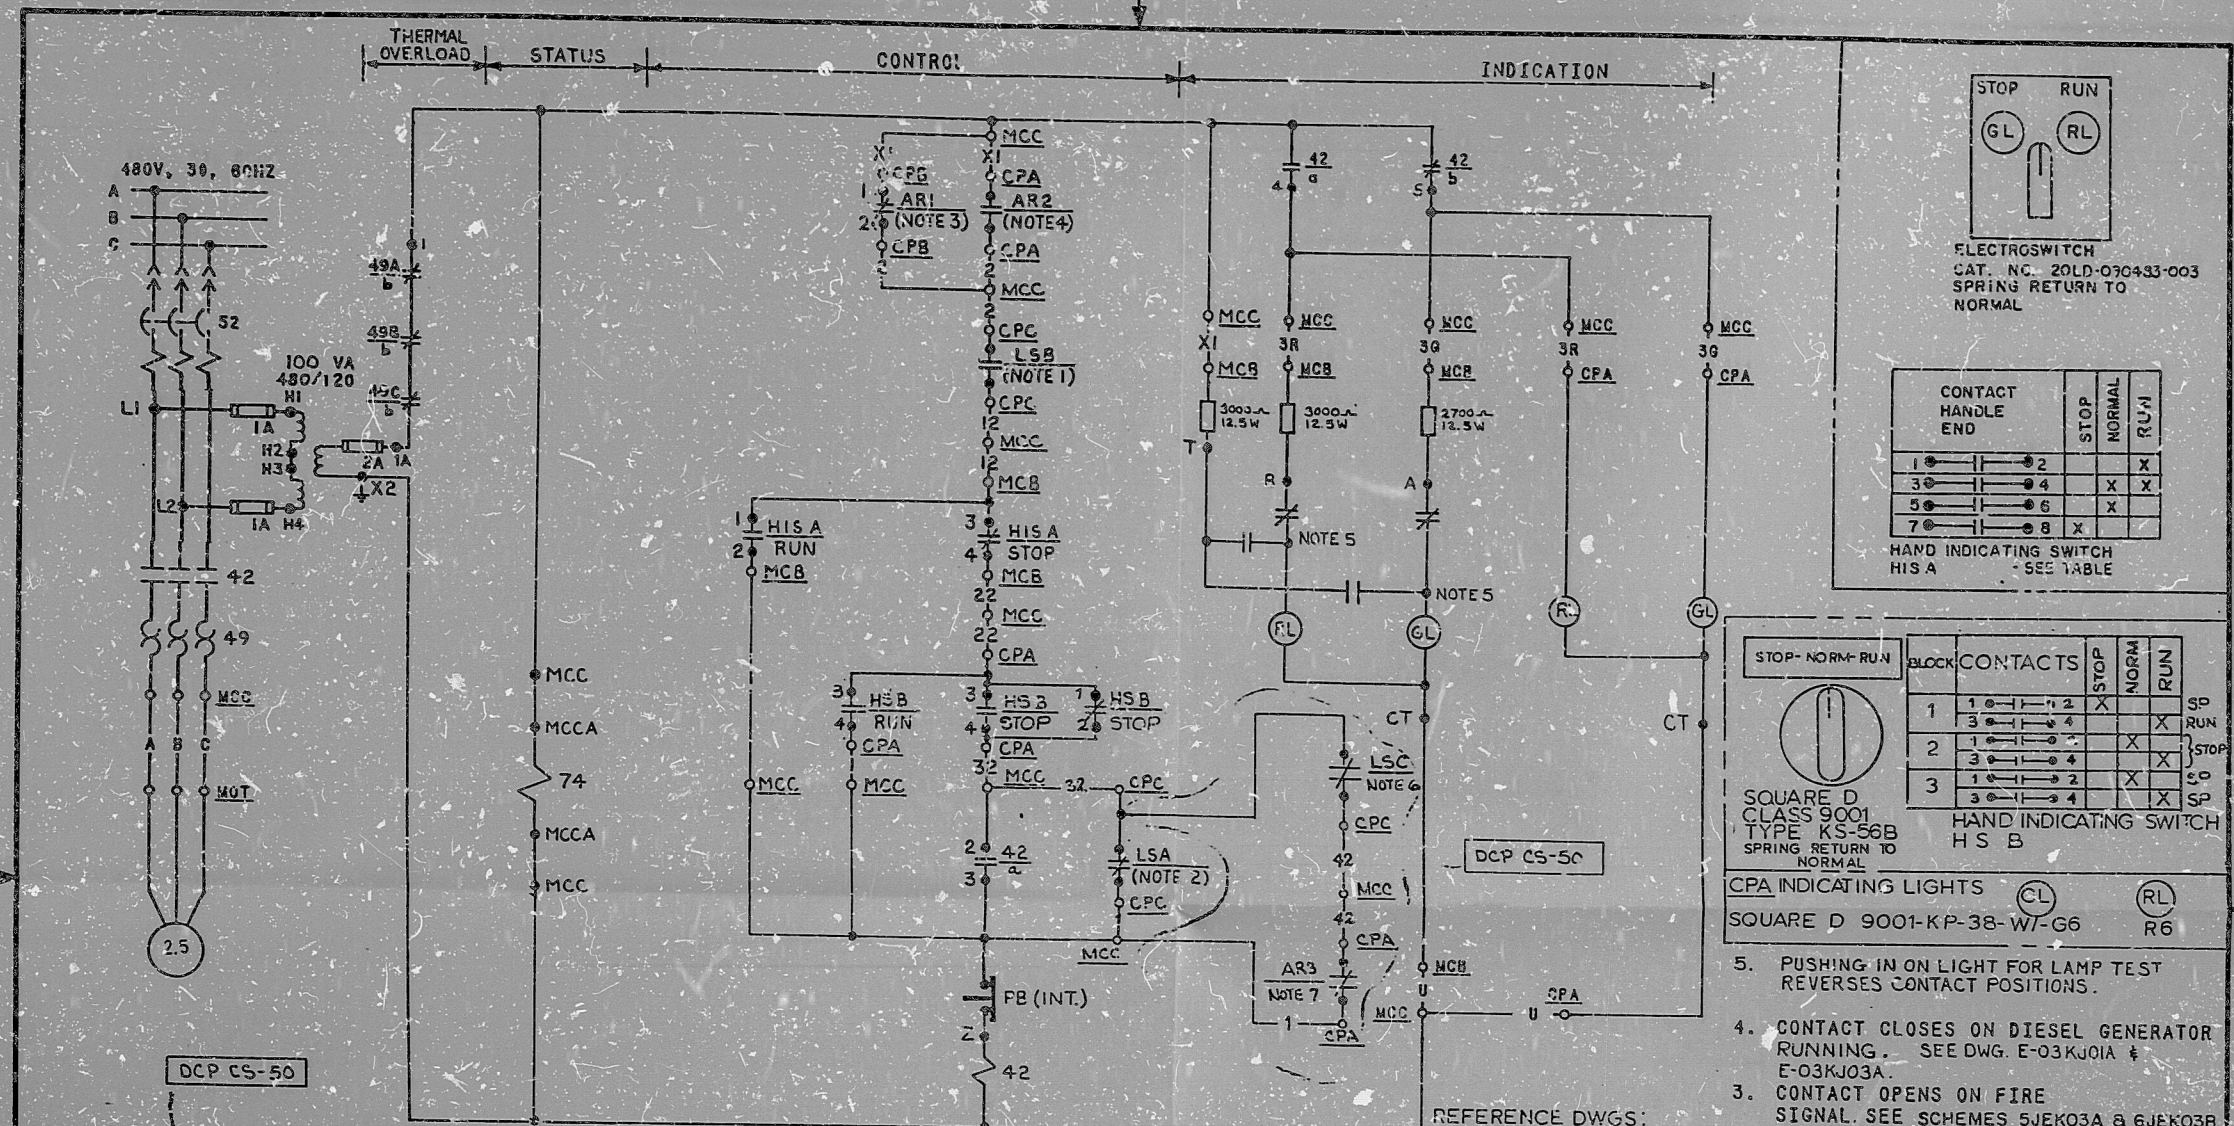


This drawing and the design it covers is the property of the utilities which are participating in the SNPPS Project. It is loaned to the borrower's express agreement that it will not be reproduced, copied, loaned, exhibited, or used except in the limited way and for the limited purpose permitted by written consent given by the SNPPS utilities to the borrower.

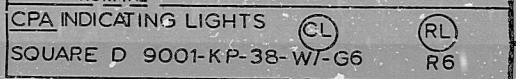

CONTACT HANDLE END		STOP	NORMAL	RUN
1	2	X		X
3	4		X	X
5	6	X		X
7	8	X	X	


HAND INDICATING SWITCH HIS A - SEE TABLE

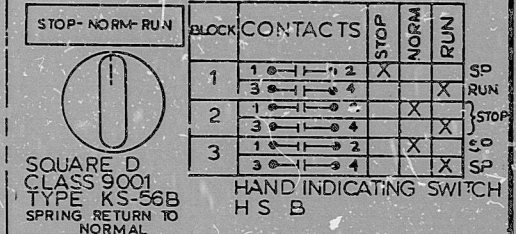

5. PUSHING IN ON LIGHT FOR LAMP TEST REVERSES CONTACT POSITIONS.
4. CONTACT CLOSES ON DIESEL GENERATOR RUNNING. SEE DWG. E-03KJ01A & E-03KJ03A.
3. CONTACT OPENS ON FIRE SIGNAL. SEE SCHEMES 5JEK03A & 6JEK03B, DWG. E-03JE03.
2. LSA CLOSURES ON LOW DAY TANK LEVEL. SEE SCHEMES 1JEI04A & 4JEI04B, DWG. E-03JE04.
1. LSB OPENS ON HIGH DAY TANK LEVEL. SEE SCHEMES 1JEI04A & 4JEI04B, DWG. E-03JE04.

TABLE A

DESCRIPTION	ASR	ASR
AUXILIARY RELAY AR3	45XJE1	45XJE2
LEVEL SWITCH LSC	JELSLIC	JELSL2IC
STATUS PNL. REF. DWG.	E-03KJ02	E-03KT04
MCC A LOCATION - MCCA	NG02DF4	NG04DF1
AUXILIARY RELAY AR1	45XJE1	45XJE2
ARI LOCATION - CPB	RP330	RP331
LEVEL SWITCH LSB	JELSH1B	JELSH21B
LEVEL SWITCH LSA	JELSL1A	JELSL21A
LSA, LSB, LSC LOCATION - CPC	RPO33AC	RPO33BC
AUXILIARY RELAY AR2	H5R	H5R
CPA INDICATING LIGHT NOS.	JEZ11B	JEZ121B
HS B NO.	JEH51B	JEH521B
HS B AR2/AR3 LOCATION - CPA	KJ121	KJ122
HIS A NO.	JEH151A	JEH1521A
HIS A LOCATION - MCB	RLO24	RLO24
MCC LOCATION - MCC	NG03DF4	NG04DF3
MOTOR NO. - MOT	DPJE1A	DPJE1B
SCHEME NO.	1JEG01A	4JEG01B

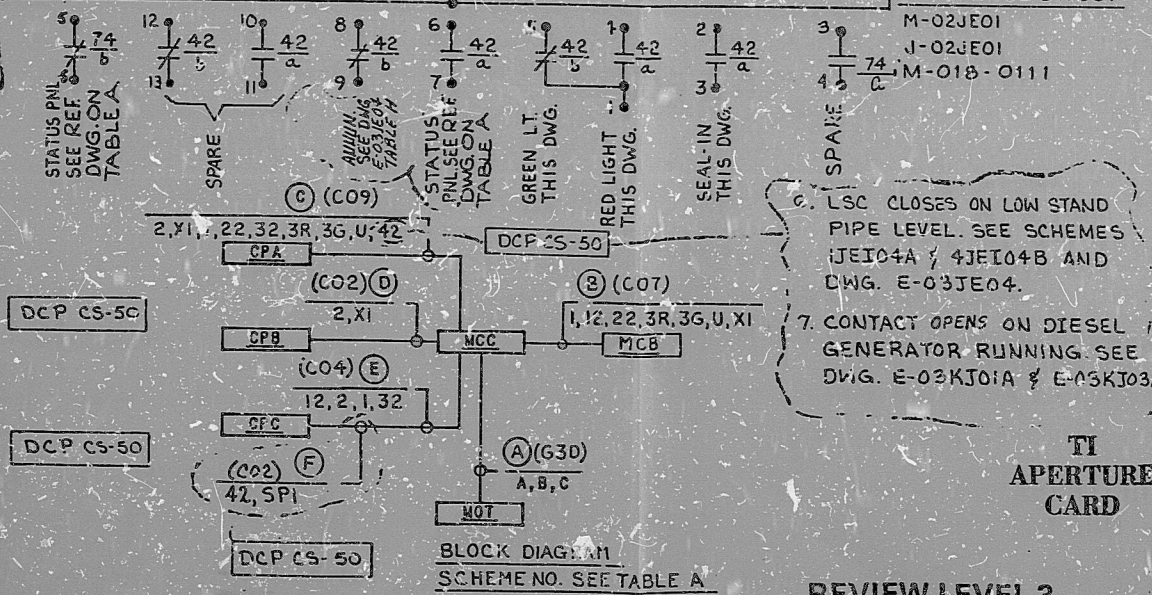

NOTES:

REV'D	SCH. TABLE F B/LK	DATE	BY	CHKD	APP'D
1	DIAG. ADDED NOTE C17				
2	TO INCORP. DCP CS-50				
3	ISSUED FOR CONST.				
4	ISSUED FOR CONST.				

SCALE: 1" = 8"

BECHTEL  
GAITHERSBURG, MARYLAND

SHUPPS

SCHEMATIC DIAGRAM  
EMERGENCY FUEL OIL  
TRANSFER PUMPS

NO.	DATE	REVISIONS	BY	CHKD	APP'D
1					
2					
3					
4					
5					

UTILITY DRAWING NO. REV.

JOB NO. 10488

SCHEMATIC DRAWING NO. E-03JE01 (Q)

DATE 7-27-77 OPERATOR *[Signature]* SUPERVISOR *[Signature]*

TI APERTURE CARD

I certify that the image contained on this frame was made in the normal and regular course of business, on the date stated below and that it is an accurate reproduction of the document(s) submitted to Micrographics.  
DATE 7-27-77 OPERATOR *[Signature]* SUPERVISOR *[Signature]*



8410040144

PDR RIDS

