

11


11

5.8

8.5

11

17

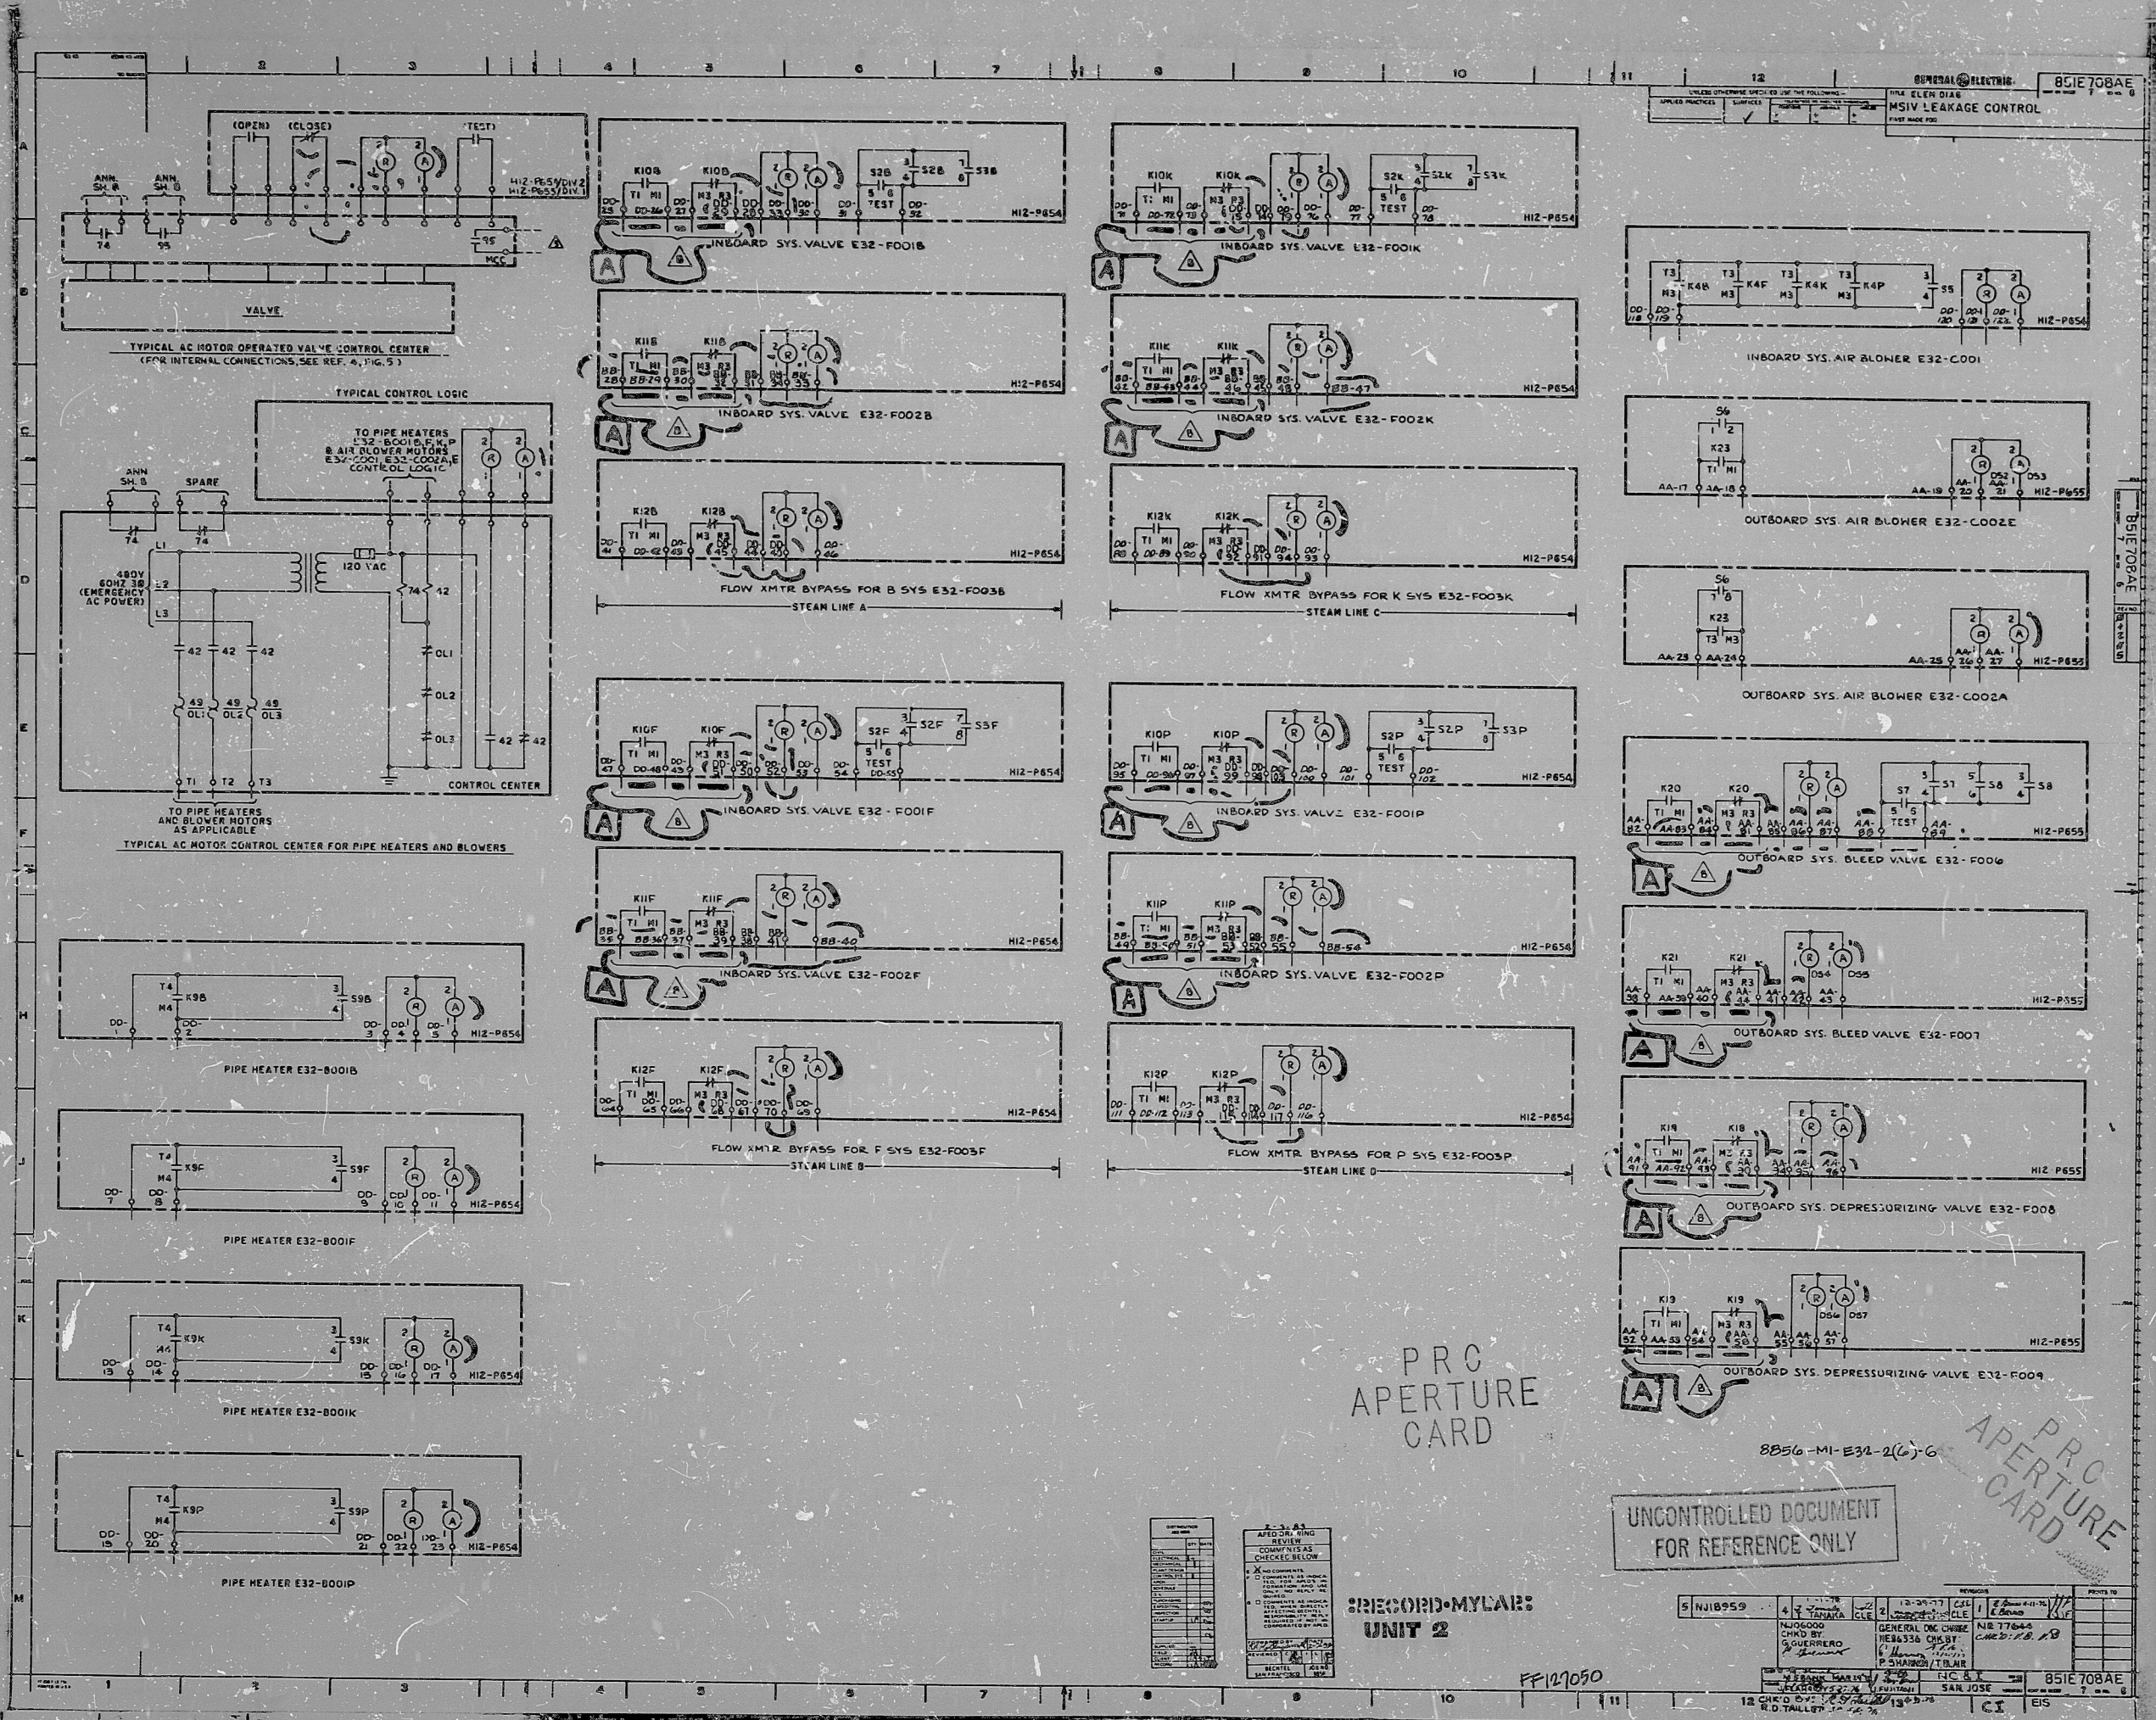

GENERAL ELECTRIC 851E708AE
 THIS ELEMENT IS AN MSIV LEAKAGE CONTROL
 FIRST MADE P22

PRC APERTURE CARD

8B56-MI-E32-2(G)-G
 UNCONTROLLED DOCUMENT FOR REFERENCE ONLY
 PRC APERTURE CARD

1	2	3	4	5	6	7	8	9	10	11	12

RECORD-MYLAR: UNIT 2

FF127050

5	NI18959	4	YANARA	12-30-77	CEL	1	851E708AE	1	1	1	1

3-01-X

RIDS

8305250146

