

22

17


11

8.5"

11"

17"

22"

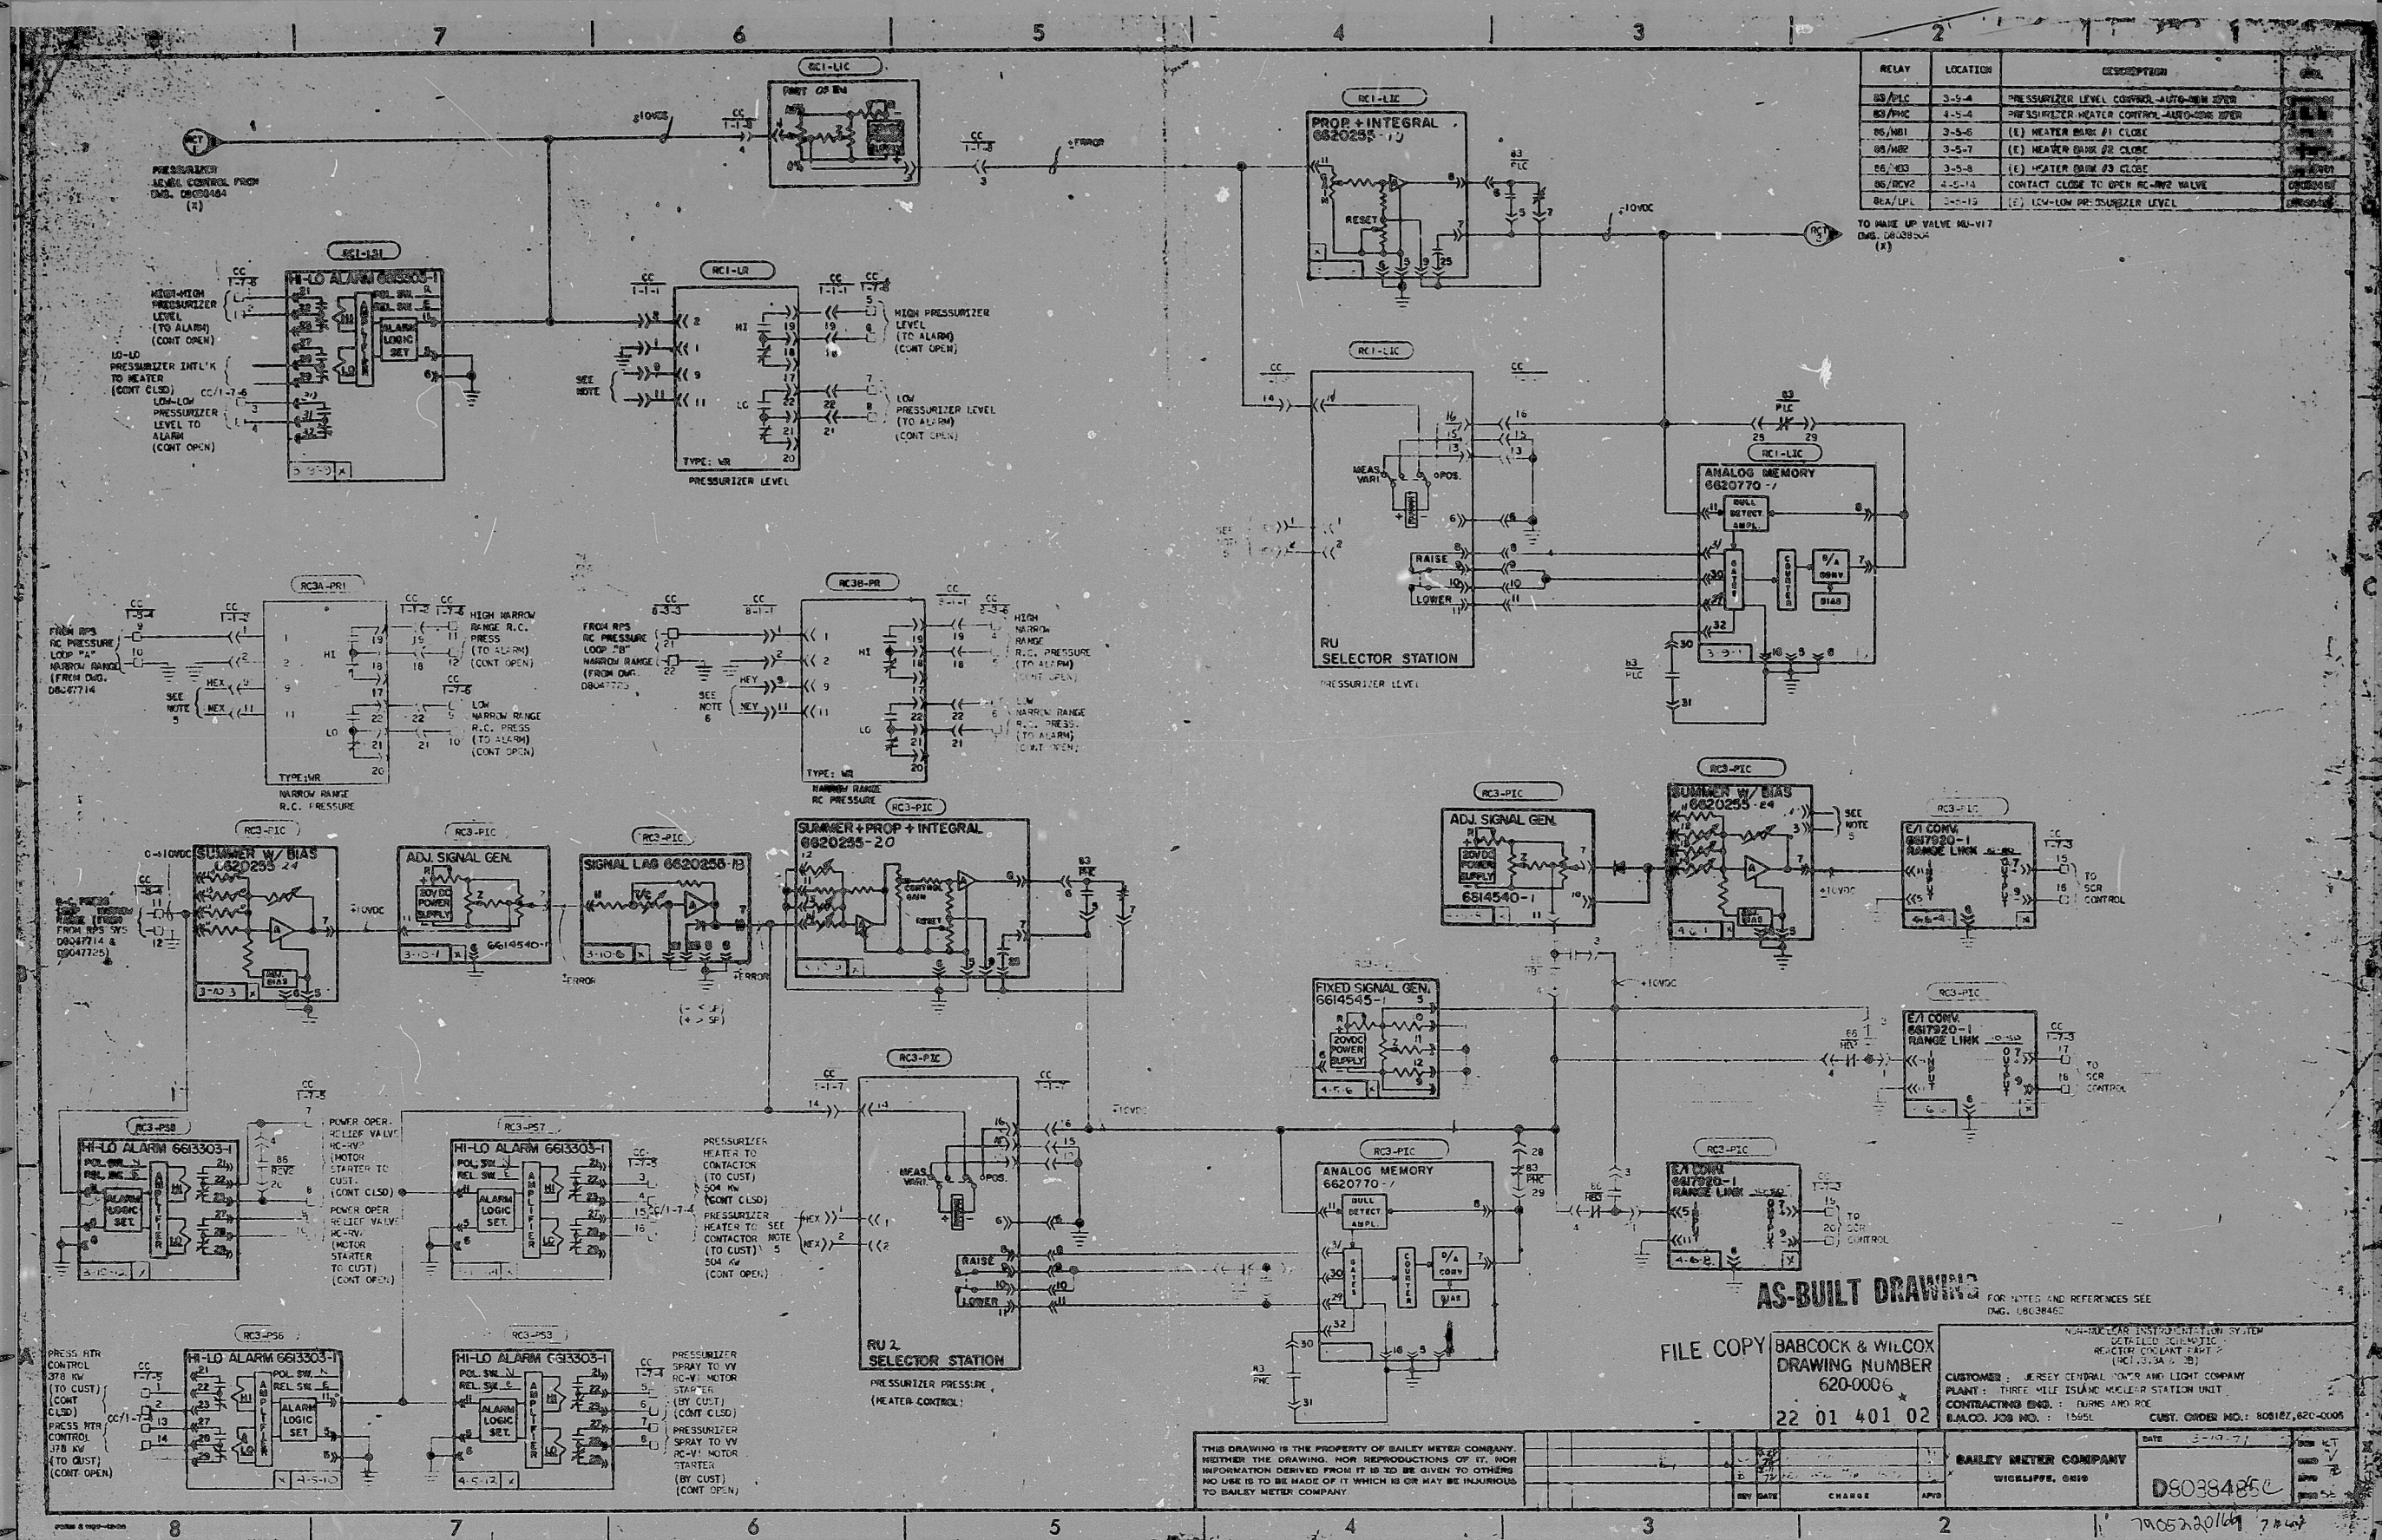

RELAY	LOCATION	DESCRIPTION	NOTE
85/PLC	3-5-4	PRESSURIZER LEVEL CONTROL-AUTO-HEAT OPEN	
85/PMC	4-5-4	PRESSURIZER HEATER CONTROL-AUTO-HEAT OPEN	
85/MB1	3-5-6	(E) HEATER BURN #1 CLOSE	
85/MB2	3-5-7	(E) HEATER BURN #2 CLOSE	
85/MB3	3-5-8	(E) HEATER BURN #3 CLOSE	
85/MB4	4-5-14	CONTACT CLOSE TO OPEN RC-VI VALVE	
85/LPL	3-5-12	(E) LOW-LOW PRESSURIZER LEVEL	

TO MAKE UP VALVE MU-VI7
DMS-1603004
(A)

AS-BUILT DRAWING

FILE COPY
BABCOCK & WILCOX
DRAWING NUMBER
620-0006
22 01 401 02

FOR NOTES AND REFERENCES SEE
DMS-1603004
NON-NUCLEAR INSTRUMENTATION SYSTEM
REACTOR COOLANT PUMP
(REF. 3-5-10)
CUSTOMER: JERSEY CENTRAL POWER AND LIGHT COMPANY
PLANT: THREE MILE ISLAND NUCLEAR STATION UNIT
CONTRACTING ENG.: BURNS AND ROE
BALCOO JOB NO.: 15591
CUST. ORDER NO.: 806187, 820-0006

THIS DRAWING IS THE PROPERTY OF BAILEY METER COMPANY.
NEITHER THE DRAWING, NOR REPRODUCTIONS OF IT, NOR
INFORMATION DERIVED FROM IT IS TO BE GIVEN TO OTHERS
NO USE IS TO BE MADE OF IT WHICH IS OR MAY BE INJURIOUS
TO BAILEY METER COMPANY

BAILEY METER COMPANY
WICKLIFFE, OHIO

D5038485
7005290169 7004

7905220166

7905220166

