


SERVICE	AUX BOILER	SUC BOILER	AUX BOILER	AUX BOILER FEED PUMP
FIELD LOCATION	M-121	M-121	M-121	M-121
ANALYSIS NOZZLE NO.	AN-0202A-B			AN-0207
PIPE CLASS AND LINE NO. DATA	4" GBC-2	1" GBD	1" GBD	1" GBD-1
PRESS. PSIG MAX	110	270	270	120
NORM.	110	270	270	120
TEMP °F MAX	400	400	400	312
NORM.	400	400	400	312

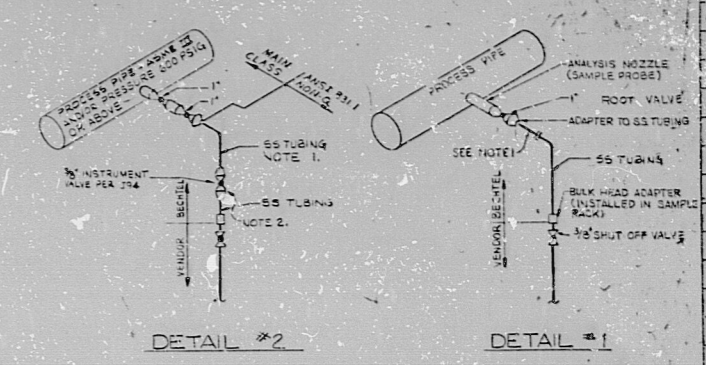

NOTES:

1. TUBING FROM ROOT VALVE TO THE SAMPLE STATION CABINET SHALL BE IN ACCORDANCE WITH PIPING CLASS SPECIFICATION UG-100.
2. ALL LINES WITH A PRIMARY PRESSURE RATING OF 600 PSIG AND HIGHER OR CLASS RATED ASME 'B' CLASS 'J' SHALL HAVE AN ADDITIONAL ISOLATION VALVE (SEE DETAIL #2 ABOVE) LOCATED ABOVE SAMPLE STATION.
3. FOR INSTALLATION OF ANALYSIS NOZZELS REFERENCE DWG 8856 V-1-B3 SHEETS CGG (600-1).
4. DEVICES SHOWN WITH A LINE IN THE BALLOON ARE LOCATED IN THE INSTRUMENT SECTION OF THE SAMPLE STATIONS.
5. SAMPLE TUBING BETWEEN THE PROCESS LINE AND THE SAMPLE STATION SHALL BE STAINLESS STEEL AND SHALL HAVE TUBING 1/2" OR 3/4" IN O.D.
6. LAST VALVE NO. 023-004

UNCONTROLLED DOCUMENT FOR REFERENCE ONLY

PRC APERTURE CARD

REVISED DWG	NO.	DATE
M-121	E-100428	
M-121	E-100428	
M-121	E-100428-1	

NO.	DESCRIPTION	DATE	BY	CHKD
1	REVISED TUBING SIZE	11/28/56	WJ	WJ
2	REVISED PER CHANGE SHEET	11/28/56	WJ	WJ
3	"AS-BUILT"	11/28/56	WJ	WJ
4	REVISED PER CHANGE LIST AND TO WORK	11/28/56	WJ	WJ
5	REVISED PER CHANGE LIST	11/28/56	WJ	WJ
6	REVISED PER CHANGE LIST	11/28/56	WJ	WJ
7	REVISED PER CHANGE LIST	11/28/56	WJ	WJ
8	REVISED PER CHANGE LIST	11/28/56	WJ	WJ
9	REVISED PER CHANGE LIST	11/28/56	WJ	WJ
10	REVISED PER CHANGE LIST	11/28/56	WJ	WJ
11	PRELIMINARY ISSUE	11/28/56	WJ	WJ
12	REVISED PER CHANGE LIST	11/28/56	WJ	WJ

THIS DOCUMENT IS UNDER FINAL ADMINISTRATIVE CONTROL. NO CHANGES CAN BE MADE WITHOUT PRIOR APPROVAL.

PENNSYLVANIA POWER & LIGHT COMPANY
 ALLENTOWN, PENNSYLVANIA
 SARASOPHIA STEAM ELECTRIC STATION - UNIT 1, UNIT 2

BECKETT - SAN FRANCISCO

**P 310 UNITS 1 & 2
 PROCESS SAMPLING**

JOB NO.	8856	DRAWING NO.	M-123	REV.	12
SHEET NO.	12	TITLE	E-100428		

30 X

Identify that the microfilm is contained on this microform were made as the normal and regular course of business. This is a true, full, correct and complete reproduction and replacement for and in lieu of original documents generated by the System group of companies.

RIDS

8309250253

