


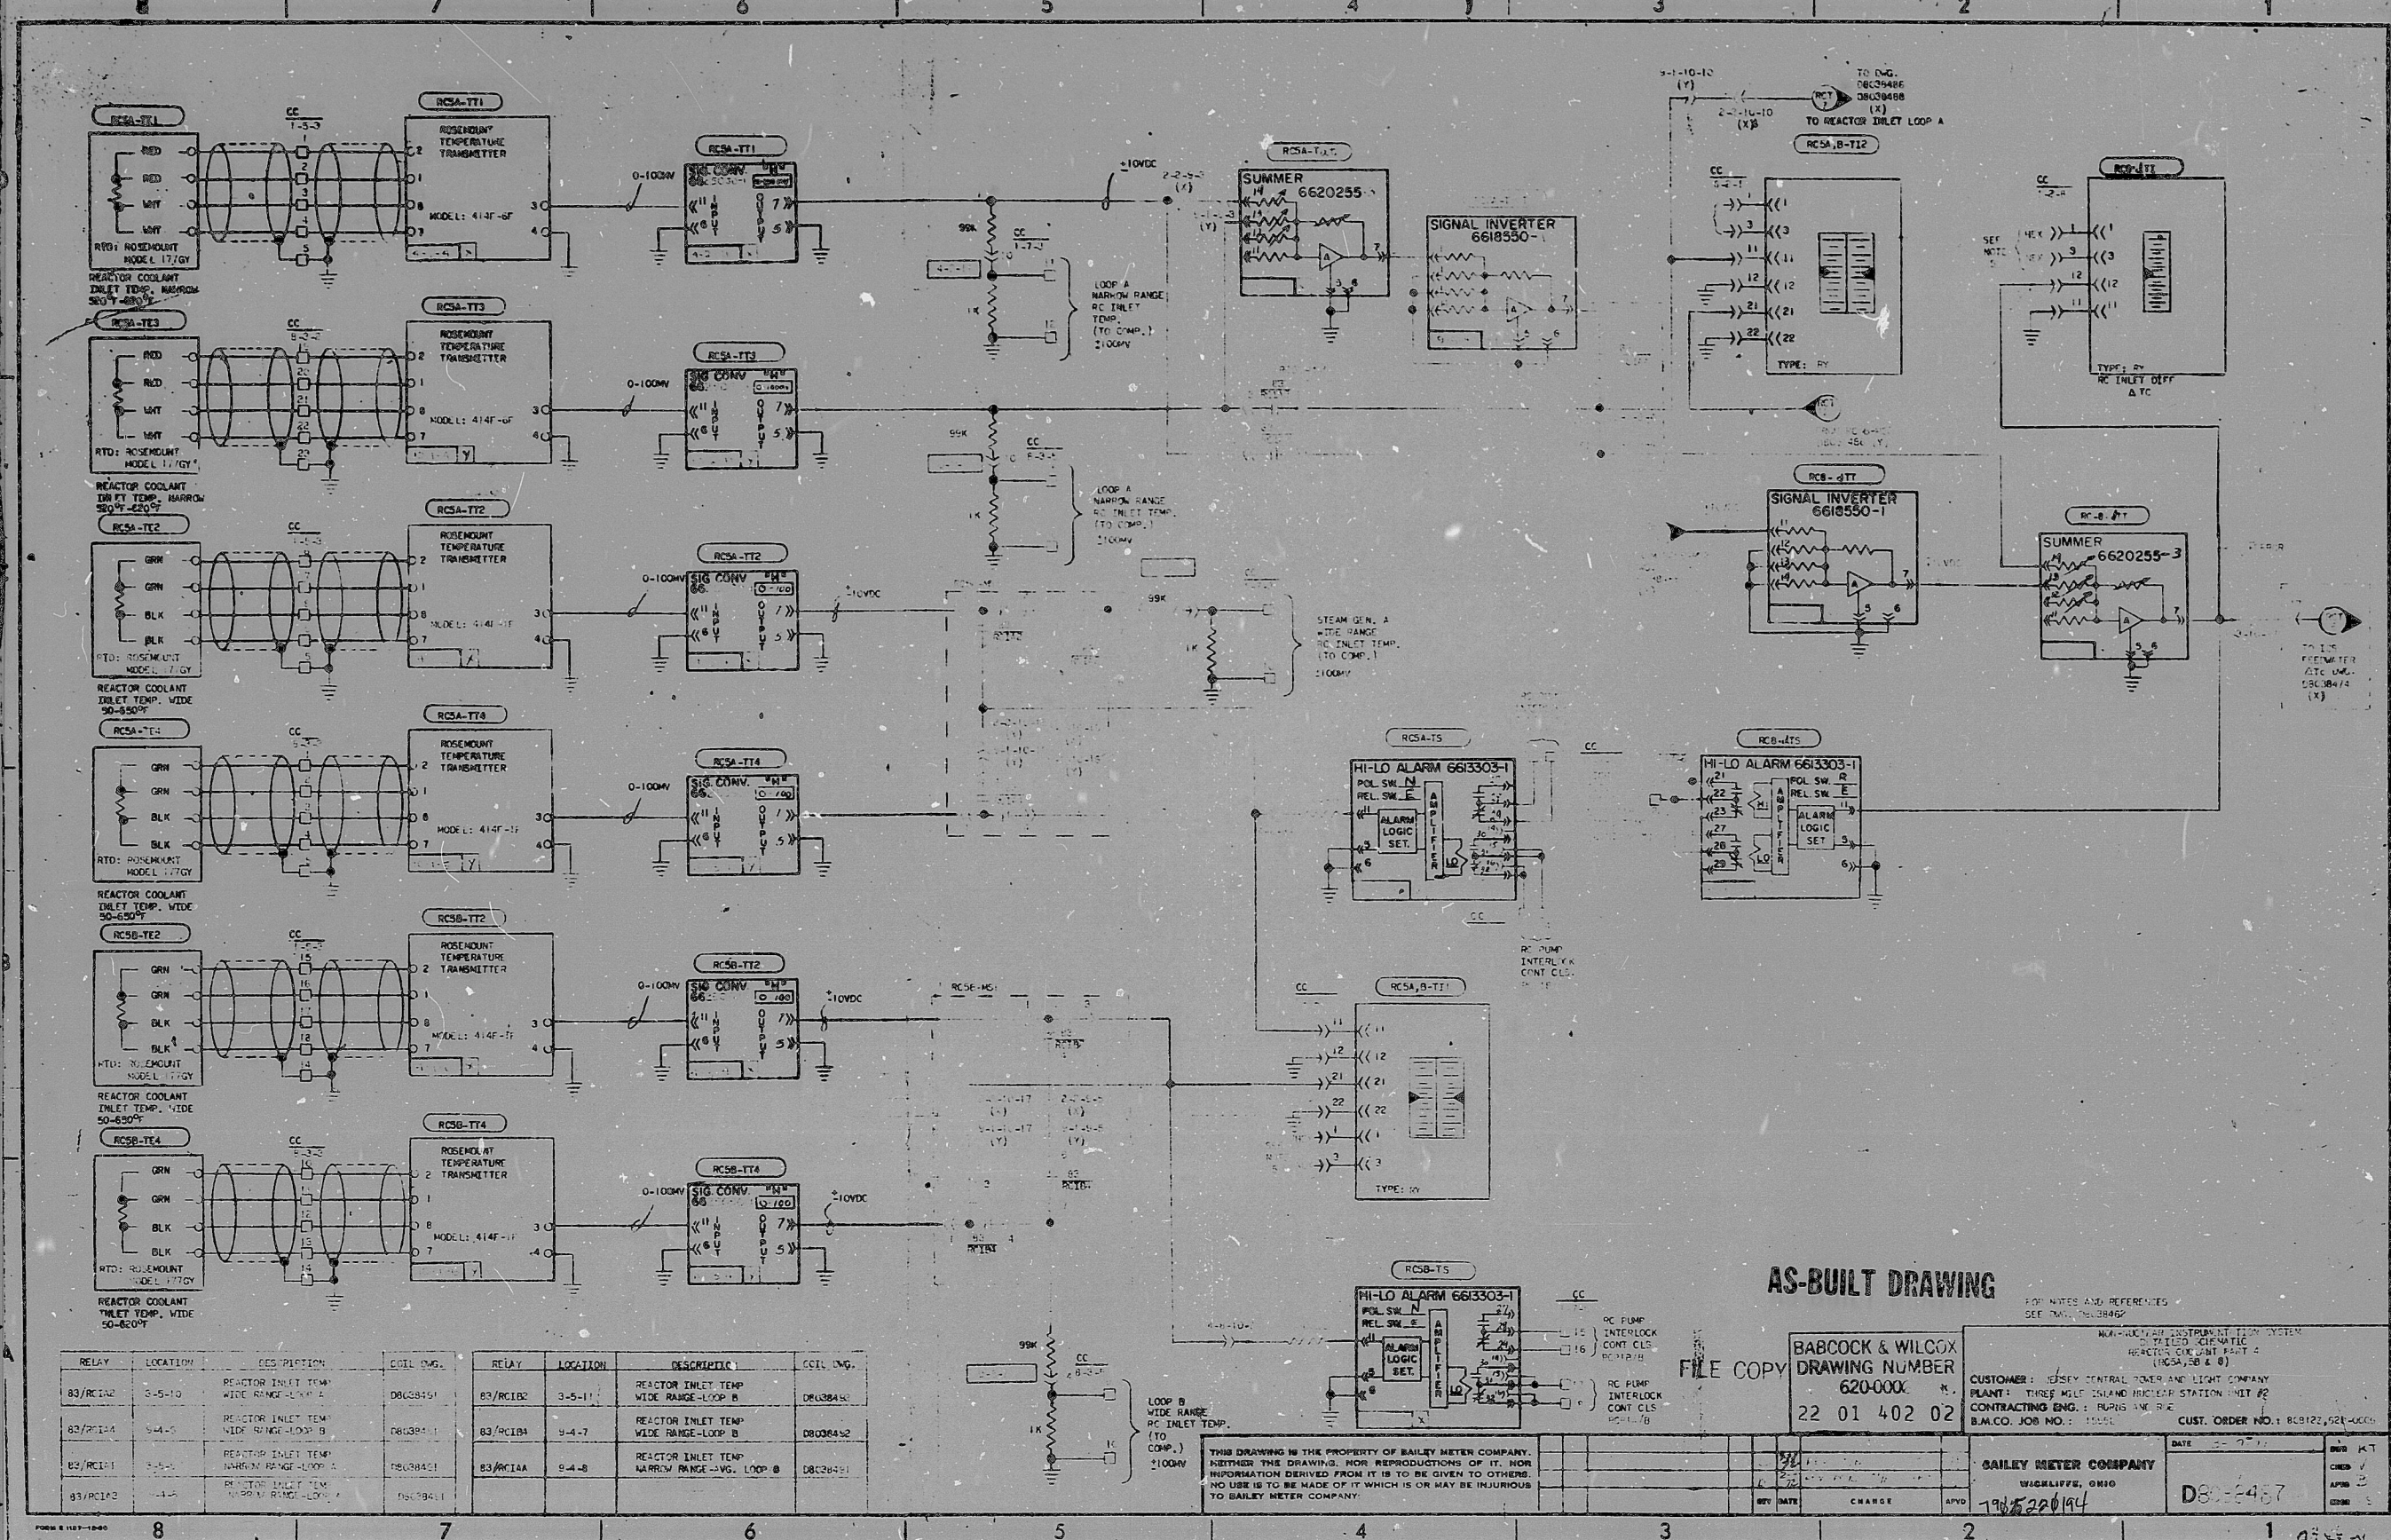

AS-BUILT DRAWING

FILE COPY
BABCOCK & WILCOX
DRAWING NUMBER
620-000X
22 01 402 02

CUSTOMER: JESSE CENTRAL POWER AND LIGHT COMPANY
PLANT: THREE MILE ISLAND NUCLEAR STATION UNIT #2
CONTRACTING ENG.: JAMES W. RICE
B.W.CO. JOB NO.: 10050
CUST. ORDER NO.: 809123, 021-0000

SAILEY METER COMPANY
WICKLIFFE, OHIO
DATE: 10-2-77
D802487

THIS DRAWING IS THE PROPERTY OF SAILEY METER COMPANY. NEITHER THE DRAWING, NOR REPRODUCTIONS OF IT, NOR INFORMATION DERIVED FROM IT IS TO BE GIVEN TO OTHERS. NO USE IS TO BE MADE OF IT WHICH IS OR MAY BE INJURIOUS TO SAILEY METER COMPANY.

7905220194

7905220194

