

8856-M-127

SHEET 2


VACUUM TRIP FOR RPT A (TYP. OF RPT'S B & C)

BECHTEL TAG NO.	DESCRIPTION	LOCATION	COMPUTER	REMARKS
HS 12732A	VACUUM TRIP RESET	1C66B	NA	
PSH12732A	LOW VACUUM TRIP SWITCH ACTIVATED	15-105A	LATER	INDICATING LIGHT
NA	LOW VACUUM TRIP SWITCH ACTIVATED	1C66B	NA	INDICATING LIGHT
PSH12732A	LOW VACUUM TRIP SWITCH ACTIVATED	15-105A	LATER	INDICATING LIGHT
NA	LOW VACUUM TRIP SWITCH ACTIVATED	1C66B	NA	INDICATING LIGHT
PSH12731A	LOW VACUUM PRE-TRIP SWITCH	15-105A	LATER	
PSH12731A	LOW VACUUM PRE-TRIP SWITCH	15-105A	LATER	
NA	LOW VACUUM PRE-TRIP SWITCH	1C66B	NA	FROM ELCC RELAY INDICATING LIGHT


EMERGENCY GOVERNOR TEST & LOCKOUT FOR RPT A (TYP. OF RPT'S B & C)

BECHTEL TAG NO.	DESCRIPTION	LOCATION	COMPUTER	REMARKS
HS 12732A	EMERGENCY GOVERNOR LOCKOUT & TEST	1C66B	NA	KEYLOCKED SWITCH
HS 12733A	EMERGENCY GOVERNOR TEST TRIP & RESET	1C66B	NA	
NA	EMERGENCY GOVERNOR TEST TRIP	1C66B	NA	INDICATING LIGHT
NA	EMERGENCY GOVERNOR TEST TRIP	1C66B	NA	INDICATING LIGHT
PSL 12748A	LOCKOUT VALVE IN NORMAL POSITION	15-105A	LATER	
NA	LOCKOUT VALVE IN NORMAL POSITION	1C66B	NA	INDICATING LIGHT
PSH12747A	LOCKOUT VALVE IN LOCKOUT POSITION	15-105A	LATER	
NA	LOCKOUT VALVE IN LOCKOUT POSITION	1C66B	NA	INDICATING LIGHT
SV 12748A	LOCKOUT VALVE OIL INJECTION	15-105A	LATER	
SV 12740A	EMERGENCY GOVERNOR TEST TRIP	15-105A	LATER	


TURBINE SUPERVISORY INSTRUMENTS FOR RPT A (TYP. OF RPT'S B & C) (SEE NOTE 2)

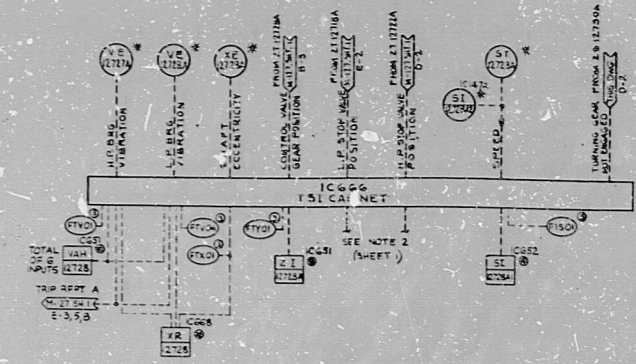

SPEED CONTROL FOR RPT A (TYP. OF RPT'S B & C)

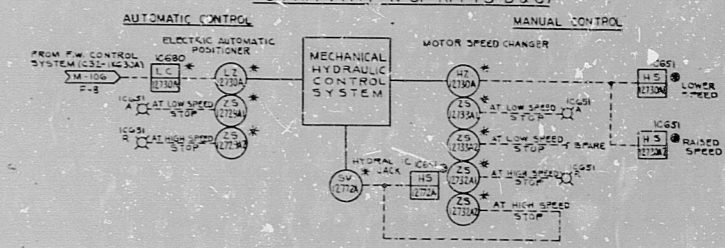

TURNING GEAR FOR RPT A (TYP. OF RPT'S B & C)

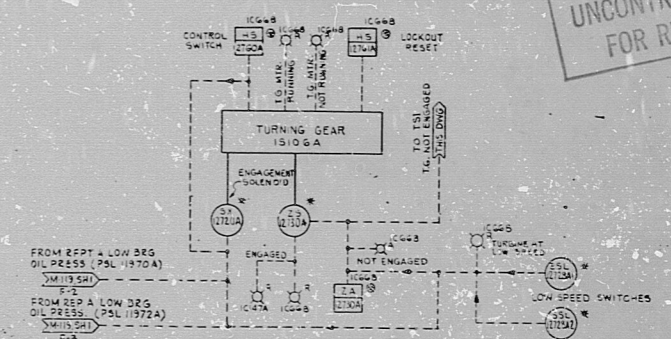

UNCONTROLLED DOCUMENT
FOR REFERENCE ONLY

PRC
APERTURE
CARD

NOTE:
1. SEE SHEET 1 FOR GENERAL NOTES AND REFERENCE DRAWINGS

AS BUILT	55	25	1/27/55
REVISED PER CHANGE LIST AND DCN	55	25	1/27/55
REVISED PER CHANGE SHEET	55	25	1/27/55
ISSUED FOR CONSTRUCTION	55	25	1/27/55

DESIGNED BY: LANTIERER
DRAWN BY: REEB

PENNSYLVANIA POWER & LIGHT COMPANY
ALLIANCE POWER PLANTS
BAYUNN VALLEY STEAM ELECTRIC STATION - UNIT 2 UNIT 3
MCOTEL - SAN FRANCISCO

**P&ID
FEED PUMP TURBINE STEAM**

APP NO.	REVISION	REV.
8856	M-127	3
SHEET 2 OF 2		

E-106232-2

17"

8.5"

8.5"

11"

17"

17"

8.5"

8.5"

11"

17"

30 X

MINOX
MRE

RIDS

8309250321

