


This drawing and the design it covers is the property of the Utilities which are participating in the SNUPPS Project. It is loaned on the borrower's express agreement that it will not be reproduced, copied, loaned, exhibited, or used except in the limited way and private use permitted by written consent given by the SNUPPS Utilities of the borrower.

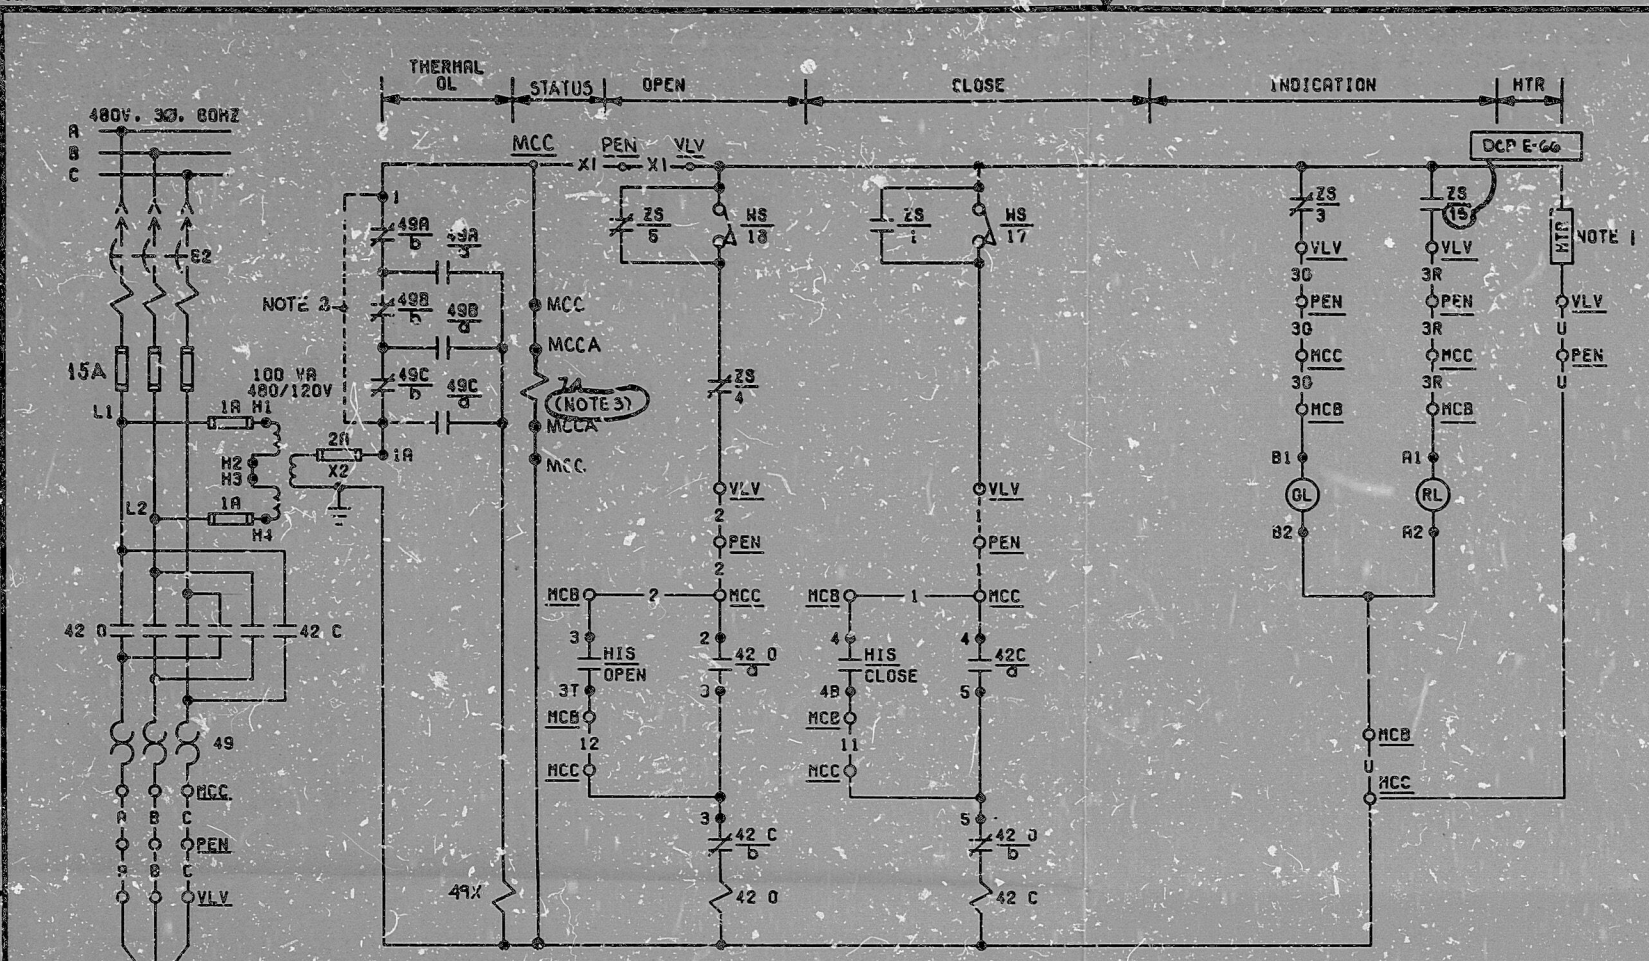

OPEN		POSITION	
OL	RL	CONTACT	NORM
		1-11-01T	X X
		3-11-03T	X X
		2-11-02B	X X
		4-11-04B	X X

CUTLER-HAMMER TYPE E30 JY3 WITH TWO KLAS CONTACT BLOCKS

HAND INDICATING SWITCH HIS-SEE TABLE A MOMENTARY CONTACT

ROTOR CONT	VALVE POSITION		FUNCTION
	FULL OPEN	FULL CLOSE	
1			BYPASS CKT
2			COMPUTER
3			IND LIGHT
4			OPEN CKT
5			BYPASS CKT
6			SPARE
7			SPARE
8			NOT USED
9			SPARE
10			SPARE
11			SPARE
12			SPARE
13			SPARE
14			SPARE
15			IND LIGHT
16			SPARE
17	TORQUE SW OPENS ON HI CLOSING TORQUE		
18	TORQUE SW OPENS ON HI OPENING TORQUE		


SOLID BAR INDICATES CONTACT CLOSED

TABLE B

COMPUTER REF DWG	J-106-0115	J-106-0116
BECHTEL V P NO.	ZNE27B	ZSE233
PENETRATION-PEN	BBZ8037A	BBZ8037B
COMPUTER POINT	RJ159A	RJ160A
COMPUTER LOCATION-PC	BBHV8037A	BBHV8037B
VALVE NO.-VLV	1BB831A	4BB831B

TABLE A

PENETRATION-PEN	ZNE27B	ZSE233
HIS NO.	BBH18037A	BBH18037B
HIS LOCATION-MCB	RL021	RL021
HCC LOCATION-HCC	N00180F1	N00280F1
VALVE NO.-VLV	BBHV8037A	BBHV8037B
MCC LOCATION-MCCA	NG02BFR1	
SCHEME NO.	1DB631A	4DB631B

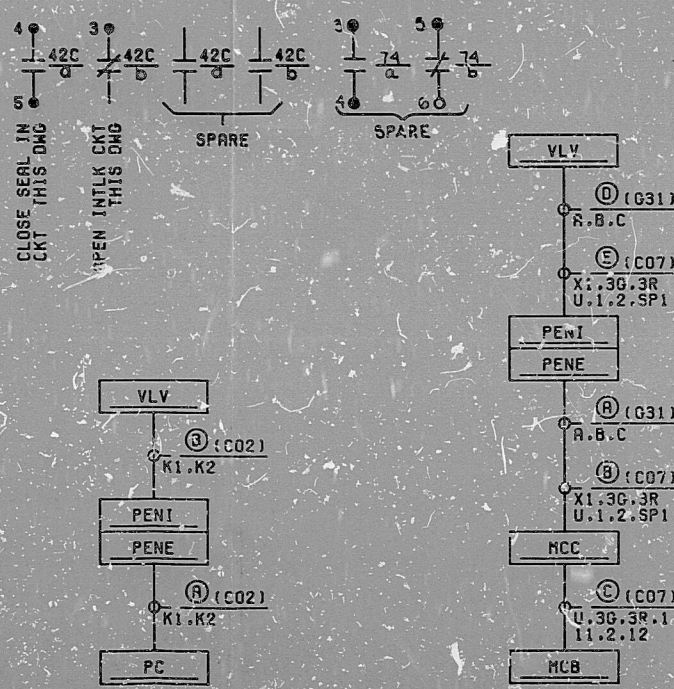

TI APERTURE CARD

REFERENCE DWGS:  
H-028802  
3 STATUS RELAY "74" IS APPLICABLE FOR SCHEME 4BB831B ONLY  
2. JUMPER TO BE INSTALLED PRIOR TO COPE LOADING.  
1. HEATER, 25 WATTS, MFR. TYPE WARD LEONARD P/N 25F750WL.

NOTES:

ADDED STATUS RELAY 74 TO SCHEMATIC	DATE	BY	CHK	DESIGN	DATE	SCALE
ISSUED FOR CONSTRUCTION						
<p>BECHTEL CANTERSBURG, MARYLAND</p> <p>SNUPPS</p> <p>SCHMATIC DIAGRAM PRT TO CONTAINMENT NORMAL SUMP VALVES</p>						
UTILITY DRAWING NO.		REV.				
JOB NO.		BECHTEL DRAWING NO.				
10488		E-038831(Q)				
DRAWING APPLICABLE TO UNIT		1 2 3 4 5 6 7 8 9				

I certify that the image contained on this frame was made in the normal and regular course of business, on the date stated below and that it is an accurate reproduction of the document(s) submitted to Micrographics.  
DATE 11/14/81 OPERATOR Mike Rowland



8410040376

PDR RIDS

