


SNUPPC FORMAT  
REV. 10/13/81

CONTACT	POSITION		
	NORMAL	RESET	BLOCK
1  1T	X	X	
3  3T			X
2  2B	X		X
4  4B		X	


CH TYPE E30AB WITH TWO KLA1 & TWO KLA2 CONTACT BLOCKS.

HAND SWITCH MOMENTARY CONTACT HS-SEHS11 & SEHS12

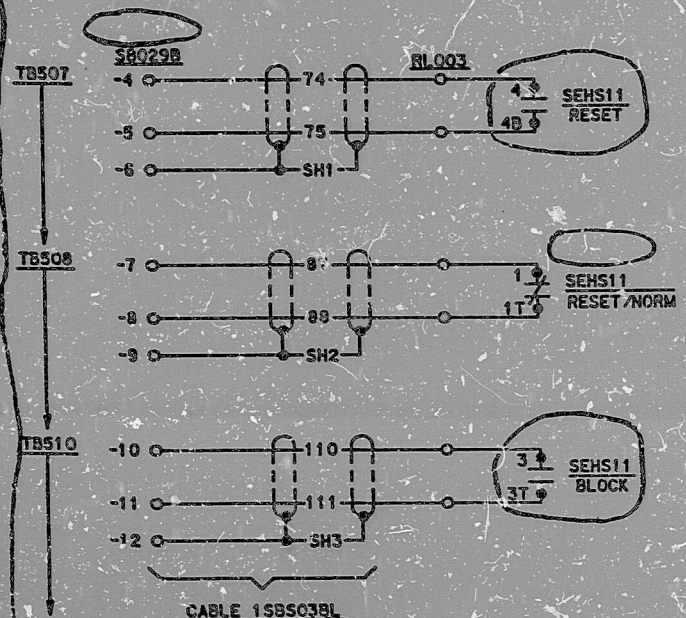

CABLE 1SBS038L  
FOR BLOCK DIAGRAM SEE DWG. E-03SB03(Q)

DCP# M-33

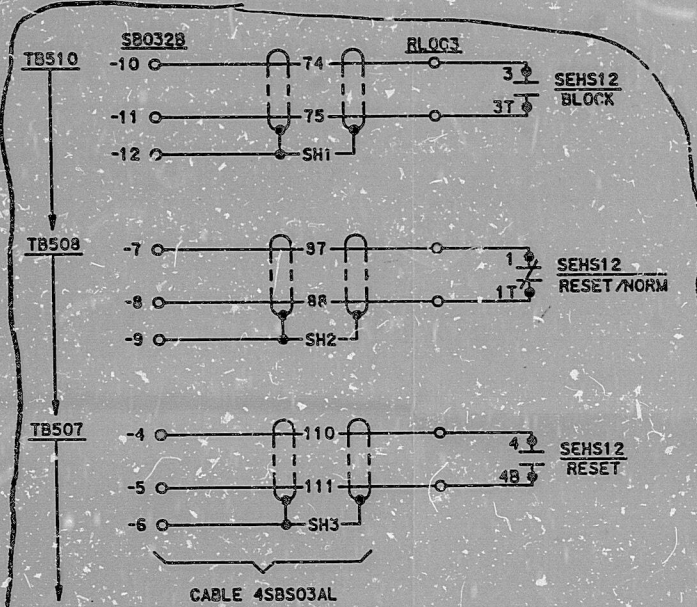

CABLE 4SBS03AL  
FOR BLOCK DIAGRAM SEE DWG. E-03SB03(C)

TI  
APERTURE  
CARD

ISSUED FOR CONSTRUCTION THIS DRAWING SUPERSEDES E-03SB19(Q) REV. 1 FOR CAL- CULATED CHANGES AS CXT- TO INCORP. DCH E-03SB19(Q) 1-CH.		BY		CHK		APP'D		DATE	
NO.	DATE	REVISIONS	BY	CHK	APP'D	DATE	NO.	DATE	NO.
1	5/14/84								
<b>BECHTEL</b> GAITHERSBURG, MARYLAND <b>SNUPPS</b> SCHEMATIC DIAGRAM CONTROL BOARD SWITCHES									
								UTILITY DRAWING NO.	REV
								BECHTEL DRAWING NO.	REV
								10466	E-23SB19(Q) 0

SUPERSEDES DWG. E-03SB19(Q)  
REVIEW LEVEL 2

DFN-  
[54.4] E23SB19 .DGN

I certify that the image contained on this frame was made in the normal and regular course of business, on the data stated below and that it is an accurate reproduction of the document(s) submitted to Micrographics.  
DATE 5/25/84 OPERATOR Mark Arnold

84100500 47

PDR RIDS

