


- NOTES:**
1. ALL GATE VALVES WITH ALARMS ON THIS DRAWING WILL ALARM WHEN CLOSED.
 2. (S) INDICATES FIXED WATER SPRAY SYSTEM.
 3. ALL HOSE CABINETS HC WILL BE FED FROM LEFT HAND SIDE.
 4. PIPING MATERIAL BY OTHERS TO BE IN ACCORDANCE WITH ISHWM & ROOT SPEC. W.M.
 5. ALL INSTRUMENTS ON THIS DIAGRAM ARE PREFIXED BY THE UNIT NUMBER UNLESS OTHERWISE NOTED.
 6. PRESSURE GAUGE TO BE INSTALLED AT THE HIGH POINT OF THE LINE.
 7. ALL FP VALVES ARE TO BE REQUESTED BY MECHANICAL B.O.P. ENGINEERING IN ACCORDANCE WITH SPECIFICATION NOS. 50270MS045, 50270MS047, 50270MS052, 50270MS054.
 8. ALL ANNUNCIATORS SHALL BE SHOWN IN THE CONTROL ROOM BY THE PLANT (COMPUTER) AND ON THE LOCAL FIRE PANELS.
 9. H.R. HOSE REEL
 10. DELUGE VALVES NORMALLY CLOSED.
 11. PIPING, VALVES & COMPONENTS IDENTIFIED AS SAFETY CLASS 1, 2, OR 3 ARE SEISMICALLY DESIGNED. CLASS 7, 8, OR 9 ITEMS ARE NON-SEISMICALLY DESIGNED.

INFORMATION
THIS DOCUMENT IS
SUBJECT TO REVISION
WITHOUT NOTIFICATION
TO THE USER OF THIS
COPY

**TERA
APERTURE
CARD**

E 01/78 REVISED AS CIRCLED D 03/77 REVISED AS CIRCLED C 8/27/77 REDRAWN & FUEL HANDLING BLDG. ADDED B 01/77 A 01/77 17 89	PKG. NO. 056 SUFF. 10/102 CONTRACT NO. SCALE CR-0241 NONE DRAWING NO. 5027 I-F-5047-E
--	---

BROWN & ROOT INC.
MICROFILM SERVICES
HOUSTON, TEXAS
MONDAY, OCT. 28 1978

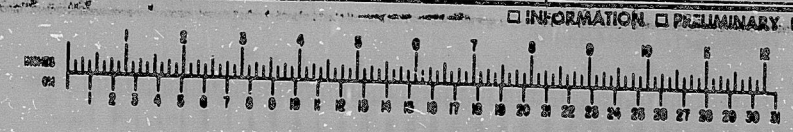

17 89

17 89

RIDS

8112040659

