

INFORMATION
 THIS DOCUMENT IS
 SUBJECT TO REVISION
 WITHOUT NOTIFICATION
 TO THE USER OF THIS
 COPY


NOTES:

1. FOR P&ID OF REFRIGERATION & WATER REMOVAL SKID SEE DWG. I-F-5035
2. THE GUARD BED, CHARCOAL BED AD1 & AD2, ARE SEISMIC CATEGORY I. ALL OTHER COMPONENTS ARE NON-SEISMIC.
3. PRING VALVES AND COMPONENTS IDENTIFIED AS SAFETY CLASS 1, 2, OR 3 ARE SEISMICALLY DESIGNED. CLASS 7, 8, OR 9 ITEMS ARE NON-SEISMICALLY DESIGNED.
4. HYDRO VENTS AND DRAINS TO BE LOCATED ON FAB 150'S ONLY.
5. SAMPLE LOOP VENTS TO BE LOCATED ON LEC INSTALLATION DETAILS ONLY.

E 3/18/80 REVISIONS CIRCLED D 8/5/80 CIRCLED AREA INDICATES LATEST REVISION C 3/12/79 ADDITION		PKG. NO. 012 SUFF. 102 CONTRACT NO. SCALE CR-0241 NONE DRAWING NO. 7R-31 I-F-5043-E	
Brown & Root, Inc. Houston, Texas		SOUTH TEXAS PROJECT PIPING DIAGRAM GASEOUS WASTE PROCESSING SYSTEM SHEET NO. 1 OF 2	

INFORMATION
 PRELIMINARY
 REVIEW
 USE
 CONSTRUCTION

BROWN & ROOT INC.
 MICROFILM SERVICES
 THURSDAY, MAR. 6 1980

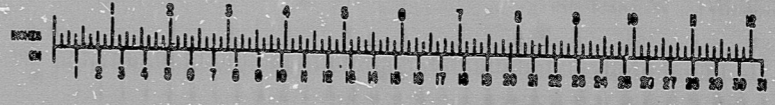

17" 11" 8.5" 11" 17" 17" 11" 8.5" 11" 17"

R:DS

8112040661

