


This drawing and the design it covers is the property of the Utilities which are participating in the SNUPPS Project. It is loaned on the borrower's express agreement that it will not be reproduced, copied, loaned, exhibited, or used except in the limited way and for the purposes permitted by written consent given by the SNUPPS Utilities to the borrower.

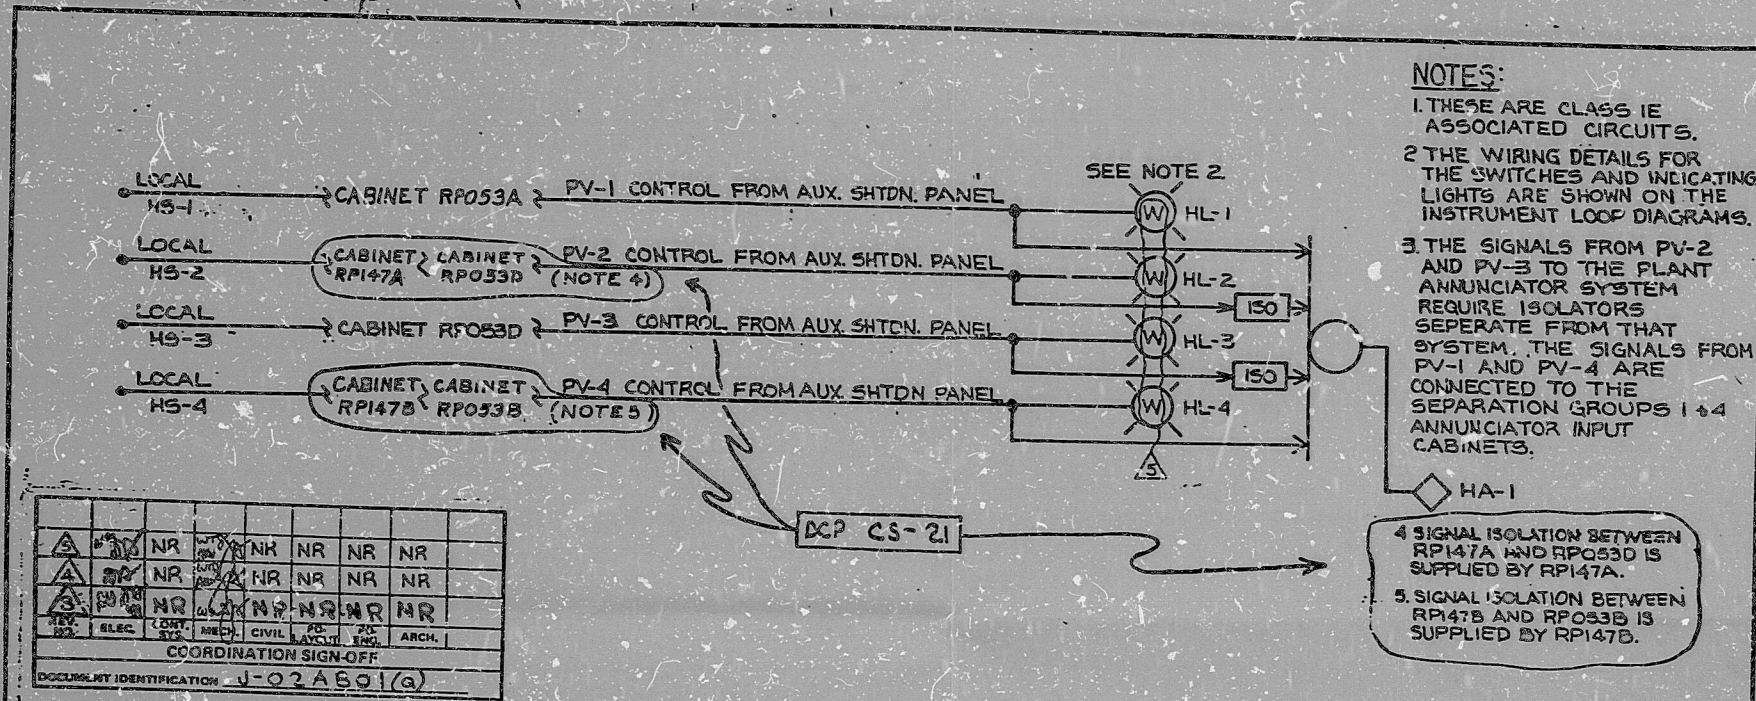

- NOTES:**
1. THESE ARE CLASS I.E. ASSOCIATED CIRCUITS.
  2. THE WIRING DETAILS FOR THE SWITCHES AND INDICATING LIGHTS ARE SHOWN ON THE INSTRUMENT LOOP DIAGRAMS.
  3. THE SIGNALS FROM PV-2 AND PV-3 TO THE PLANT ANNUNCIATOR SYSTEM REQUIRE ISOLATORS SEPERATE FROM THAT SYSTEM. THE SIGNALS FROM PV-1 AND PV-4 ARE CONNECTED TO THE SEPARATION GROUPS 1 & 4 ANNUNCIATOR INPUT CABINETS.
  4. SIGNAL ISOLATION BETWEEN RP147A AND RP033D IS SUPPLIED BY RP147A.
  5. SIGNAL ISOLATION BETWEEN RP147B AND RP033B IS SUPPLIED BY RP147B.

△	NR	NR	NR	NR	NR	NR	NR	NR	NR
△	NR	NR	NR	NR	NR	NR	NR	NR	NR
△	NR	NR	NR	NR	NR	NR	NR	NR	NR
REV.	ELEC.	COND. SYS.	MED.	CIVIL	MECH.	IND. ENG.	ARCH.	INS.	PLANT
COORDINATION SIGN-OFF									
DOCUMENT IDENTIFICATION: J-02AB01(a)									

**SELECTOR SWITCH HS-1 (TYPICAL)**  
ELECTROSWITCH E-20  
MAINTAINED CONTACT

VALVE	SERVICE	IND. LIGHT	LOCATION	SELECTOR SWITCH	LOCATION	ALARM	LOCATION	SEPARATION GROUP	REFERENCES
PV-1	MAIN STEAMLINE "A" ATMOSPHERIC VENT	HL-1*	006	HS-1*	118	HA-1	024	1	M-02AB01(Q)
PV-2	" " "B" " "	HL-2*	"	HS-2*	"			2	
PV-3	" " "C" " "	HL-3*	"	HS-3*	"			3	
PV-4	" " "D" " "	HL-4*	"	HS-4*	"			4	

\* SEE NOTE 2

△	9-13-83	UPGRADE DWG TO Q STATUS	SEE 10466	NR	NR	NR	NR	NR	NR
△	5-13-83	REVISED PER DCP CS-21	NR	NR	NR	NR	NR	NR	NR
△	3-1-74	REVISED AS NOTED	NR	NR	NR	NR	NR	NR	NR
△	5-13-84	REVISED AS NOTED	NR	NR	NR	NR	NR	NR	NR
△	5-13-84	ISSUED FOR CONSTRUCTION	NR	NR	NR	NR	NR	NR	NR
NO.	DATE	REVISIONS	BY	CHK	APP	DATE	CHK	APP	DATE

**BECHTEL**  
GAITHERSBURG, MARYLAND  
**SNUPPS**  
JOB NO. 10466

<b>CONTROL LOGIC DIAGRAM</b>	UTILITY DWG. NO.	REV.
MAIN STEAM SYSTEM ATMOS. DUMP VALVES CONTROL TRANSFER INDICATING LIGHTS AND ALARMS	BECHTEL DWG. NO.	REV.
	J-02AB01(Q)	5
	DWG. APPLICABLE TO UNITS	
	1 2 3 4 5 6 7 8	

TI  
APERTURE  
CARD

I certify that the image contained on this frame was made in the normal and regular course of business, on the date stated below and that it is an accurate reproduction of the document(s) submitted to Micrographix.  
DATE 5-21-84 OPERATOR *Bill Koney*

16X

8410050170

PDR RIDS

