


INFORMATION
 THIS DOCUMENT IS
 SUBJECT TO REVISION
 WITHOUT NOTIFICATION
 TO THE USER OF THIS
 COPY

- NOTES:**
1. THE ESSENTIAL COOLING WATER SYSTEM INCLUDING SCREEN WASH SYSTEM IS SAFETY CLASS 3
 2. PARTS OF THIS DWG. WERE DELETED FROM DWG. I-F-5038 REV. 'A'
 3. LOCATE VALVES AND HOSE CONNECTIONS IN TRAVELING WATER SCREEN ROOMS.
 4. PIPING, VALVES, AND COMPONENTS IDENTIFIED AS SAFETY CLASS 1, 2, OR 3 ARE SEISMICALLY DESIGNED. CLASS 2, B, OR 9 ITEMS ARE NON-SEISMICALLY DESIGNED.
 5. 1" HYDRO VENTS AND DRAINS TO BE LOCATED ON FAB 100'S ONLY.

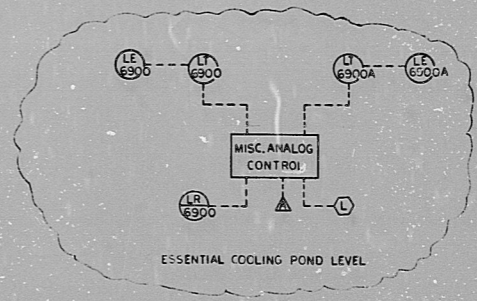


**TERA
 APERTURE
 CARD**

D 12-70 CIRCLED AREAS INDICATE LATEST REVISION C 9-27-71 REVISED AS CIRCLED E THESE CIRCLED AREAS INDICATE LATEST REVISION A 11-11-73 FIRST ISSUE		Brown & Root Inc. Houston, Texas		SOUTH TEXAS PROJECT PIPING DIAGRAM ESSENTIAL COOLING WATER SYSTEM SHEET 2 OF 2		FIG. NO. C10 SUFF. 032 CONTRACT NO. CR-0241 DRAWING NO. 3R-2B I-F-5039-D	
--	--	-------------------------------------	--	---	--	---	--

INFORMATION
 PRELIMINARY
 REVIEW
 USS
 CONSTRUCTION

BROWN & ROOT INC.
 MICROFILM SERVICES
 FRIDAY, FEB. 8 1978

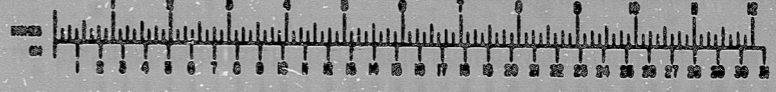

RIPS

8112040664

