

INFORMATION
THIS DOCUMENT IS
SUBJECT TO REVISION
WITHOUT NOTIFICATION
TO THE USER OF THIS
COPY

- NOTES:
1. OVERFLOW LINE TO EXTEND TO FUNNEL IN DRAIN HEADER
 2. LOWER LOOP TO EXTEND 12 INCHES BELOW OVERFLOW CONNECTION AND TOP LOOP TO EXTEND TO TOP OF TANK
 3. SIPHON BREAKER LOCATED TOP OF TOP LOOP
 4. TANK BOTTOM SLOPED
 5. SPRING VALVES AND COMPONENTS IDENTIFIED AS SAFETY CLASS 1, 2, OR 3 ARE SEISMICALLY DESIGNED. CLASS 7 & 8 ITEMS ARE NON-SEISMICALLY DESIGNED.
 6. HYDRO VENTS AND DRAINS TO BE LOCATED ON FAB 150'S ONLY.

TERA
APERTURE
CARD


NO.	DATE	DESCRIPTION	BY	CHKD	APP'D
1	11/10/77	ALL CIRCLED AREAS INDICATE LATEST REVISION
2	11/10/77	ALL CIRCLED AREAS INDICATE LATEST REVISION
3	11/10/77	ALL CIRCLED AREAS INDICATE LATEST REVISION
4	11/10/77	ALL CIRCLED AREAS INDICATE LATEST REVISION
5	11/10/77	ALL CIRCLED AREAS INDICATE LATEST REVISION
6	11/10/77	ALL CIRCLED AREAS INDICATE LATEST REVISION
7	11/10/77	ALL CIRCLED AREAS INDICATE LATEST REVISION
8	11/10/77	ALL CIRCLED AREAS INDICATE LATEST REVISION
9	11/10/77	ALL CIRCLED AREAS INDICATE LATEST REVISION
10	11/10/77	ALL CIRCLED AREAS INDICATE LATEST REVISION

Brown & Root, Inc.
Corporate Headquarters
HOUSTON, TEXAS

SOUTH TEXAS PROJECT		PG. NO. 014 AREA 102
PIPING DIAGRAM		CONTRACT NO. CR-0241
LIQUID WASTE PROCESSING SYSTEM		SCALE NONE
SHEET 2 OF 6		DRAWING NO. 7R-30
		IF-5023-F

INFORMATION PRELIMINARY REVIEW USE CONSTRUCTION

BROWN & ROOT INC.
MEMPHIS, TENN. 38115

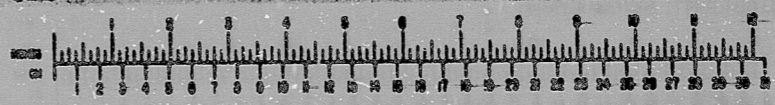

THURSDAY, MARCH 14 1978

RIDS

8112070075

