

INFORMATION
THIS DOCUMENT IS
SUBJECT TO REVISION
WITHOUT NOTIFICATION
TO THE USER OF THIS
COPY

- NOTES:
1. IN SERVICE DURING NORMAL OPERATION.
 2. INLET AND RECIRCULATION CONNECTIONS ARE BELOW NORMAL WATER LEVEL.
 3. BLIND FLANGES NORMALLY INSTALLED. SPLOP PIECE TO BE INSTALLED ONLY AFTER DEPRESSURIZATION.
 4. PIPE LENGTH DOWNSTREAM OF THIS POINT TO BE AS LONG AS PRACTICABLE.
 5. MAKE CONNECTION IN SIDE OR BOTTOM, AS POSSIBLE, TO ISOLATION VALVE. TEST CONNECTION ATTACHED TO BOTTOM OF PIPE TO FACILITATE DRAINING OF LINES.
 6. LOCATE TX CONNECTION AS CLOSE AS POSSIBLE TO ISOLATION VALVE. TEST CONNECTION ATTACHED TO BOTTOM OF PIPE TO FACILITATE DRAINING OF LINES.
 7. PIPING, VALVES, AND COMPONENTS IDENTIFIED AS SAFETY CLASS 1, 2, OR 3 ARE SEISMICALLY DESIGNED CLASS 1, 2, OR 3 ITEMS ARE NON-SEISMICALLY DESIGNED.
 8. HYDRO VENTS AND DRAINS TO BE LOCATED ON FAB 150'S ONLY.

TERA
APERTURE
CARD


NO.	DATE	DESCRIPTION	BY	CHKD.	APP'D.
1	11/17/78	REVISED AS CIRCLED			
2	11/17/78	ISSUED FOR REVIEW AND AS CIRCLED			
3	11/17/78	ALL CIRCLED AREAS INDICATE LATEST REVISION			
4	11/17/78	ALL CIRCLED AREAS INDICATE LATEST REVISION			
5	11/17/78	ALL CIRCLED AREAS INDICATE LATEST REVISION			
6	11/17/78	ALL CIRCLED AREAS INDICATE LATEST REVISION			

Brown & Root, Inc.
SOUTH TEXAS PROJECT
PIPING DIAGRAM
LIQUID WASTE PROCESSING SYSTEM
SHEET 1 OF 6

CONTRACT NO. CR-0241
SCALE N.T.S.
DRAWING NO. 5R-20
I-F-5022-F

PKG. NO. 014 AREA 102

BROWN & ROOT INC.
MONOFILM SERVICES
HOUSTON, TEXAS
WEDNESDAY, MAR. 14 1978

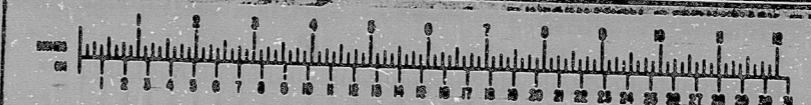

RIDS

8112070076

