


This drawing and the design it covers is the property of the utilities which are participating in the SUPPS Project. It is loaned to the borrower's express agreement that it will not be reproduced, copied, loaned, exhibited, or used except in the limited way and private use permitted by written consent given by the SUPPS Utilities to the borrower.

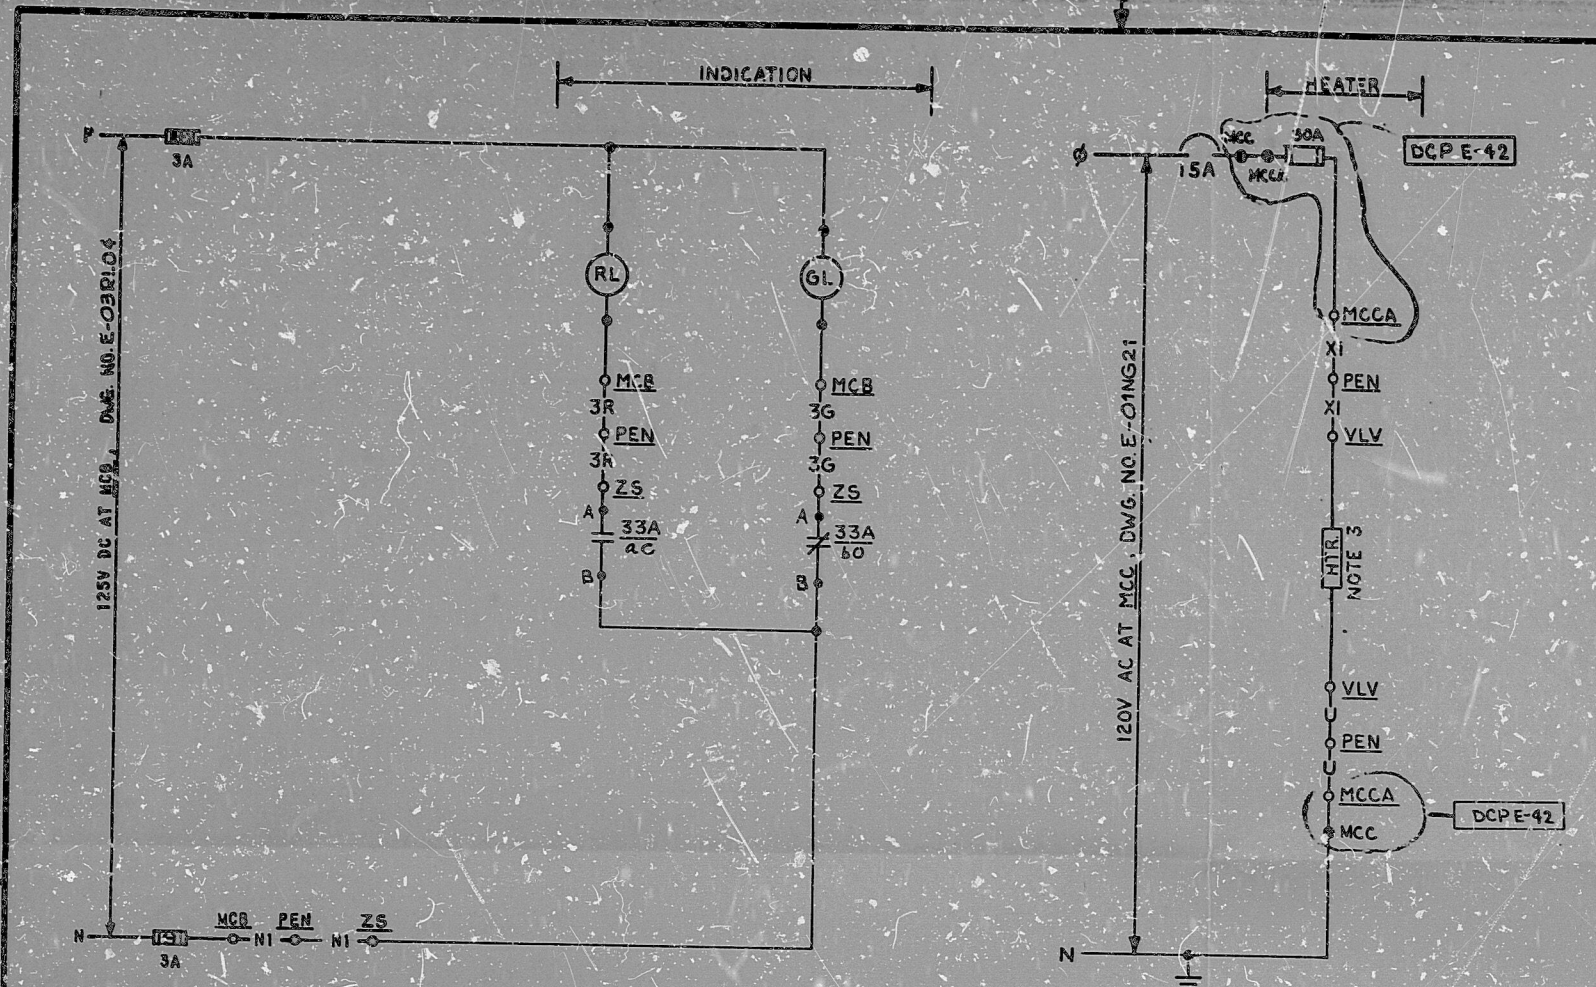


INDICATING LIGHT  
 GE TYPE ET16 MODEL NO. 011686208638  
 FOR 2L NUMBER SEE TABLE  
 SEE TABLE

CONTACT	VALVE POSITION		FUNCTION
	CLOSED	OPEN	
A-1	oo		RED LIGHT
A-2	oo		SPARE
A-3	oo		SPARE
A-4	oo		SPARE
B-1	oo		SPARE
B-2	oo		GREEN LIGHT
B-3	oo		SPARE
B-4	oo		SPARE


SOLID BAR INDICATES CONTACT CLOSED  
 (FOR POSITION SW. NO. - SEE TABLE A)  
 NAMCO EA-170-12302

DEVICE 33 - STEM MOUNTED POSITION SW.A (NAMCO EA170-12302)  
 (FOR NO. SEE TABLE A)

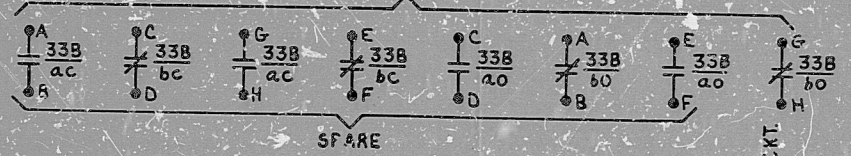

MCC LOC. - MCCA	NG01BER3	NG01BER3	NG02BGR4	NG02BGR4
PENETRATION NO. - PEN	ZNE278	ZNE278	ZSE234	ZSE234
VALVE NO. - VLV	EPHV8808A	EPHV8808C	EPHV8808B	EPHV8808D
MCC LOC. - MCC	NG01BAR16	NG01BAR17	NG02BARI4	NG02BARI5
SCHEME NO.	1EPY02A	1EPY02B	4EPY02C	4EPY02D

POSITION SW. NO. - ZS	EPZ5808AA	EPZ5808CA	EPZ5808BA	EPZ5808DA
INDICATING LIGHT NO.	EPZL8808AA	EPZL8808CA	EPZL8808BA	EPZL8808DA
PENETRATION - PEN	ZSE234	ZSE234	ZNE278	ZNE278
MIS LOCATION - MCB	RL018	RL018	RL018	RL018
VALVE NO.	EPHV8808A	EPHV8808C	EPHV8808B	EPHV8808D
POSITION SW. NO. - ZS	EPZ5808AA	EPZ5808CA	EPZ5808BA	EPZ5808DA
SCHEME NO.	4EPK02A	4EPK02B	1EPK02C	1EPK02D

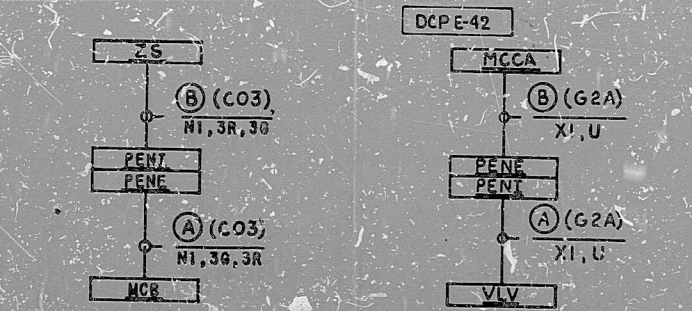

BLOCK DIAGRAM SCHEME NO. - SEE TABLE A  
 BLOCK DIAGRAM SCHEME NO. - SEE TABLE B

REVIEW LEVEL 3

TI APERTURE CARD

- HEATER 25 WATTS MANUFACTURER TYPE WARD LEONARD P/N 25F750VLT.
- FOR CONTROL SCHEME SEE DWG. E-03EP02A
- INTERLOCK SCHEME SEE TABLE A, DWG. E-03EP07

NO.	DATE	REVISIONS	BY	CHK.	DESIGN	ENGR.	TEST
1		ISSUED FOR CONSTRUCTION					
2		ADDED POSITION SW. CONT. NOS. & MFG.					
3		INCORP. DCP E-42, REV'D TABLE A & B POS. SWITCH REF.					

BECHTEL  
 GAITHERSBURG, MARYLAND  
 SHUPPS  
 SCHEMATIC DIAGRAM  
 ACCUMULATOR ISOLATION VALVES

UTILITY DRAWING NO.	REV.
JOB NO.	BECHTEL DRAWING NO.
10400	E-03EP02B (Q)
DATE	REV.
	4

I certify that the image contained on this frame was made in the normal and regular course of business, on the date stated below and that it is an accurate reproduction of the document(s) submitted to Micrographics.  
 DATE 4/18/83 OPERATOR Mike Leonard SUPERVISOR [Signature]



8410050320

PDR RIDS

