


8758D76 SHEET 33

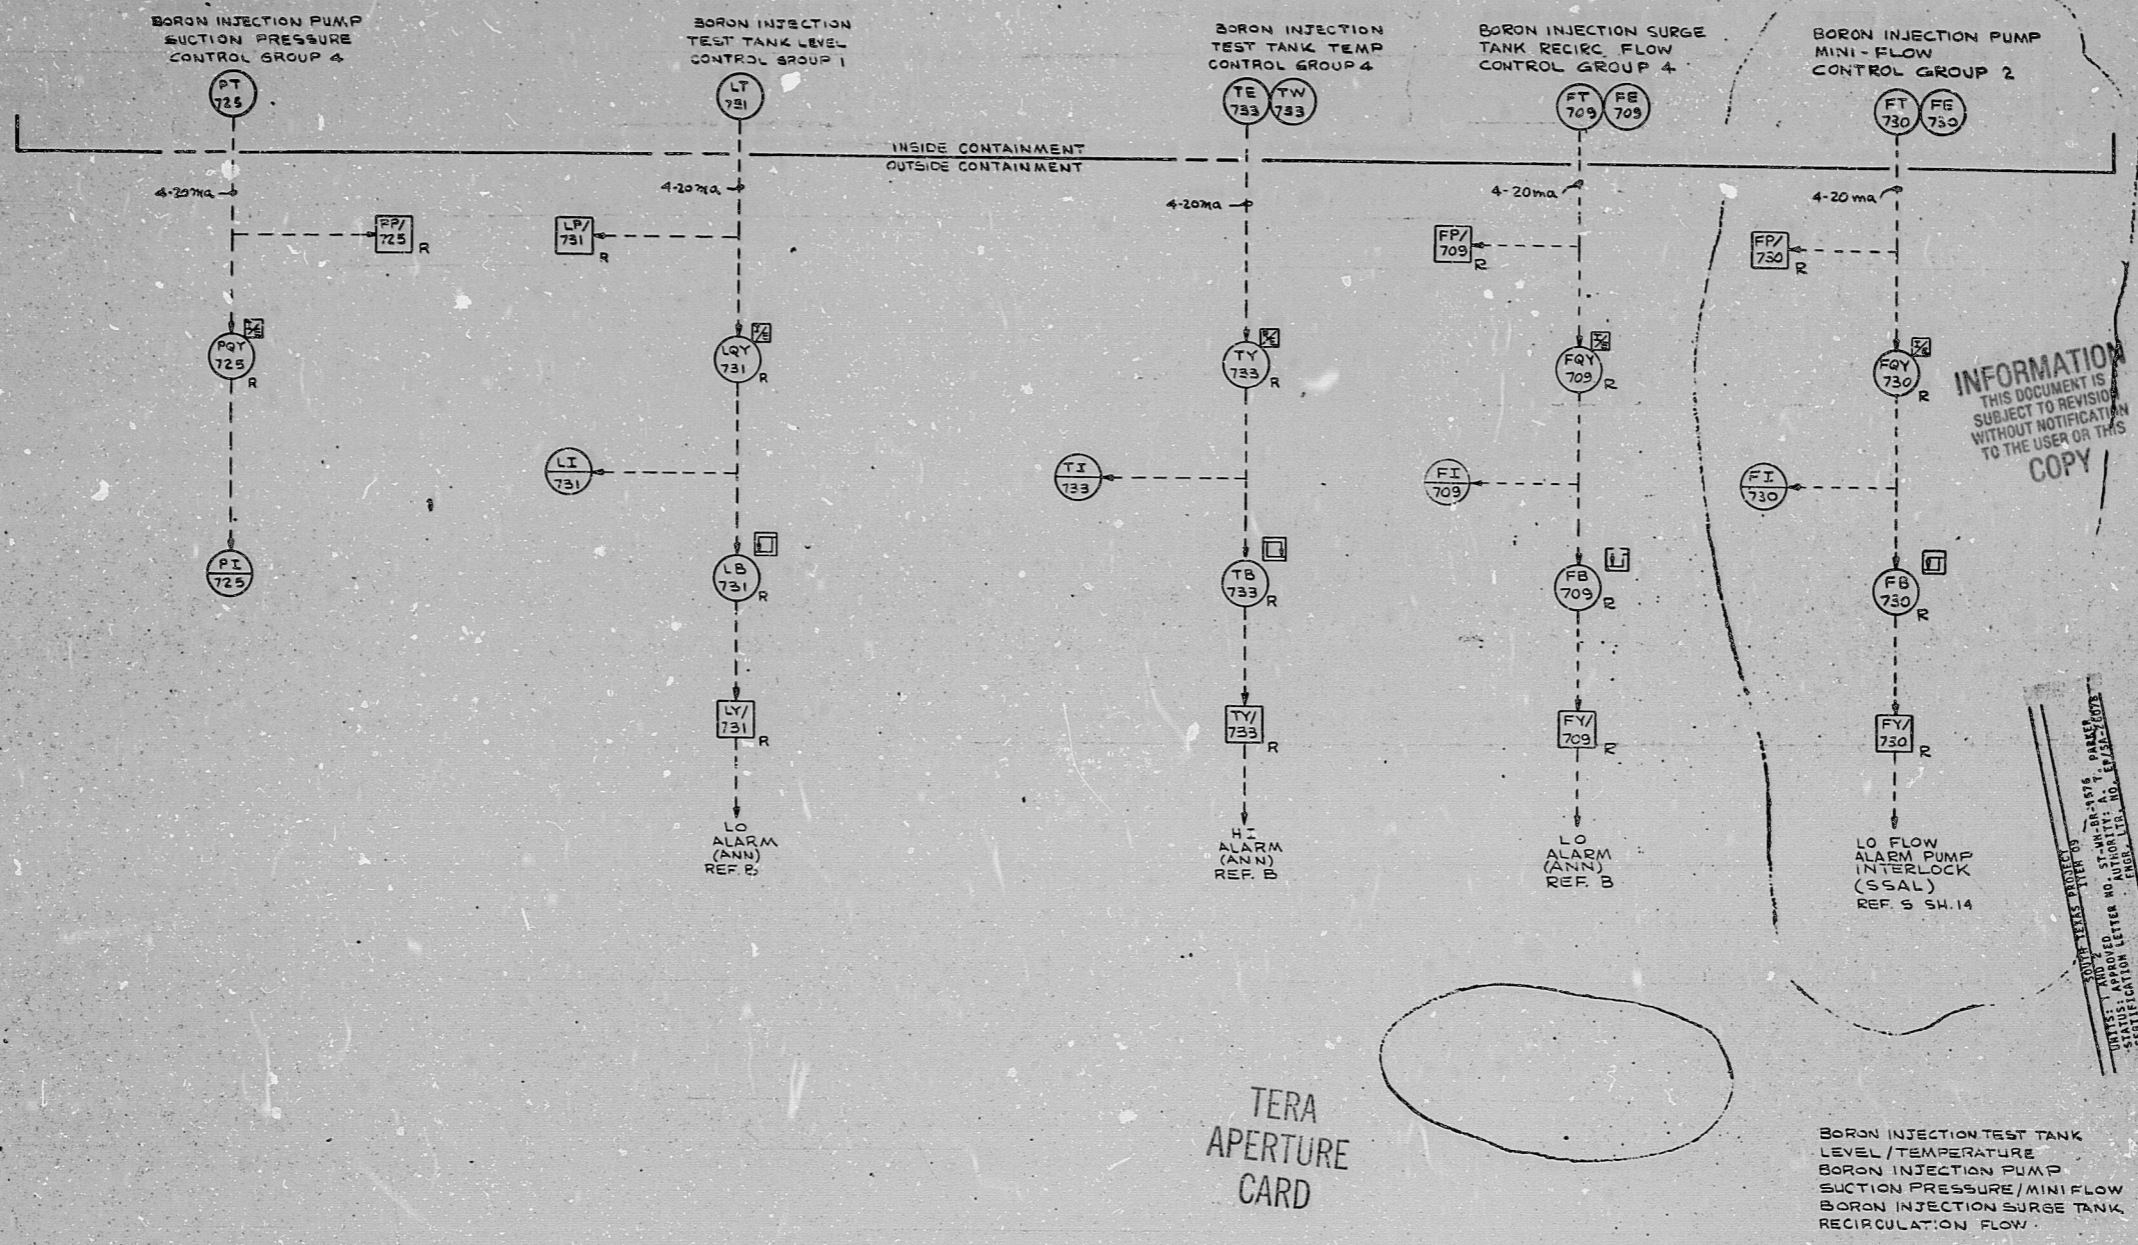

INFORMATION
THIS DOCUMENT IS
SUBJECT TO REVISION
WITHOUT NOTIFICATION
TO THE USER OF THIS
COPY

DO NOT WRITE IN THESE SPACES
TEST APPROVED LETTER NO. ST. GORTT. A. 15-14-1001
CLASSIFICATION
PAGE, LEE, NO. 15-14-1001

TERA
APERTURE
CARD

BORON INJECTION TEST TANK
LEVEL / TEMPERATURE
BORON INJECTION PUMP
SUCTION PRESSURE / MINI FLOW
BORON INJECTION SURGE TANK
RECIRCULATION FLOW

NO.	DATE	DESCRIPTION
1	10/1/68	ISSUED FOR CONSTRUCTION
2	11/1/68	REVISIONS CIRCLED
3	12/1/68	MEANS C-90-78

Richard A. 79

DATE	10/1/68	DESIGNER	W. J. ...
DATE	11/1/68	DRAWN	...
DATE	12/1/68	CHECKED	...
DATE		APPROVED	...
DATE		REVISIONS	...
DATE		TESTING	...
DATE		OPERATION	...
DATE		MAINTENANCE	...
DATE		REPAIR	...
DATE		REWORK	...
DATE		REVISIONS	...
DATE		TESTING	...
DATE		OPERATION	...
DATE		MAINTENANCE	...
DATE		REPAIR	...
DATE		REWORK	...

Westinghouse Electric Corporation
NUCLEAR ENERGY SYSTEMS, PITTSBURGH, PA., U.S.A.
TITLE: TGX/THX PROCESS CONTROL SYSTEMS BLOCK DIAGRAMS
SCALE: 8758D76 SHEET 33
DIMENSIONS IN INCHES
DO NOT SCALE

8.5"

8.5"

11"

11"

17"

17"

7 125X194B/W

R105

812070375

