



8758D76

SPRAY ADDITIVE TANK COVER GAS PRESSURE CONTROL GROUP I

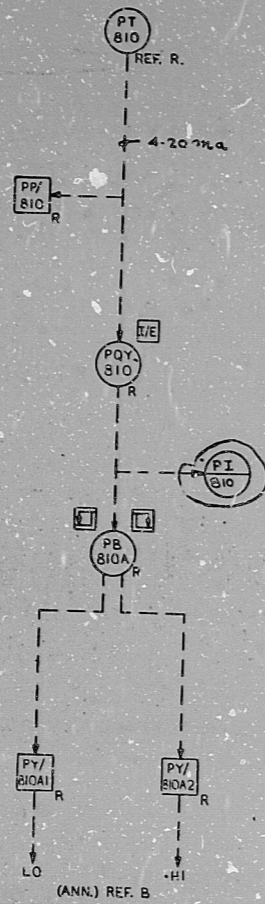


SPRAY ADDITIVE TANK COVER GAS PRESSURE		
CONTROL GROUP	CHANNEL NO.	TANK NO.
1	810	A
3	820	B
4	830	C

SPRAY ADDITIVE TANK LIQUID LEVELS

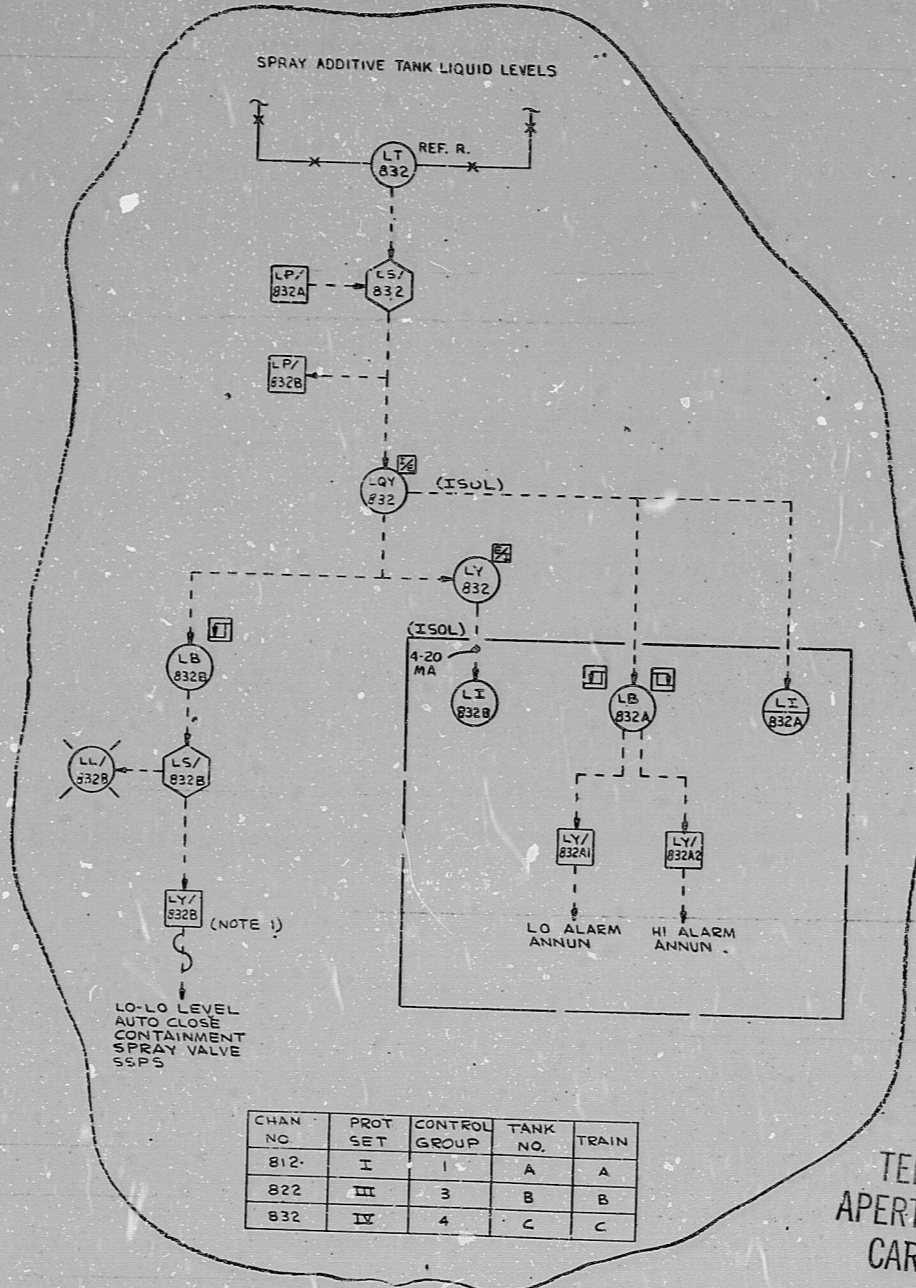

CHAN NO	PROT SET	CONTROL GROUP	TANK NO.	TRAIN
812	I	1	A	A
822	III	3	B	B
832	IV	4	C	C

SPRAY PUMP DISCHARGE FLOW CONTROL GROUP I

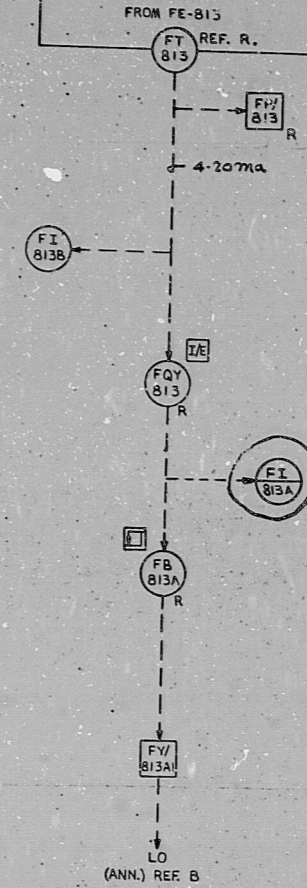

SPRAY PUMP DISCHARGE FLOW		
CONTROL GROUP	CHANNEL NO.	PUMP NO.
1	813	A
3	823	B
4	833	C

INFORMATION
THIS DOCUMENT IS
SUBJECT TO REVISION
WITHOUT NOTIFICATION
TO THE USER OR THIS
COPY

SOLID WEAVERS PROJECT
 DIRECTOR: J. H. ...
 AUTHORITY: ...
 ...

TERA
APERTURE
CARD

NOTES
1. AC RELAY REQUIRED ONLY ON L-832 CHANNEL.

1. TGX/THX-320
 2. 944350/438
 CHANGE
 TGX/THX-320
 ECN: 30819
 REVISIONS CIRCLED
 1. 7/15/76
 2. 8/1/76
 3. 8/1/76
SPRAY ADDITIVE TANK COVER GAS PRESSURE/
SPRAY ADDITIVE TANK LIQUID LEVELS/
SPRAY PUMP DISCHARGE FLOW

DR. D. PETROCELLI	HIG-74	Westinghouse Electric Corporation
CHKR.		NUCLEAR ENERGY SYSTEM, PITTSBURGH, PA., U.S.A.
DES. ENG.	22-76	TITLE: TGX/THX
APP. ENG.		PROCESS CONTROL SYSTEMS
APP.		BLOCK DIAGRAMS
APP.		SCALE: 8758D76
APP.		DIMENSIONS IN INCHES SHEET 32
APP.		DO NOT SCALE SUB PZ 3

17" 11" 8.5" 8.5" 17"

17" 11" 8.5" 8.5" 17"

11 C B A A O W A V B C I 24 36 21 11 36

2125x14630wn

RIDS

8112080069

