

17"

17"

11"

11"

8.5"

8.5"

22"

22"

11"

11"

8.5"

8.5"

8.5"

8.5"

11"

11"

8.5"


8.5"

17"

17"

22"

22"

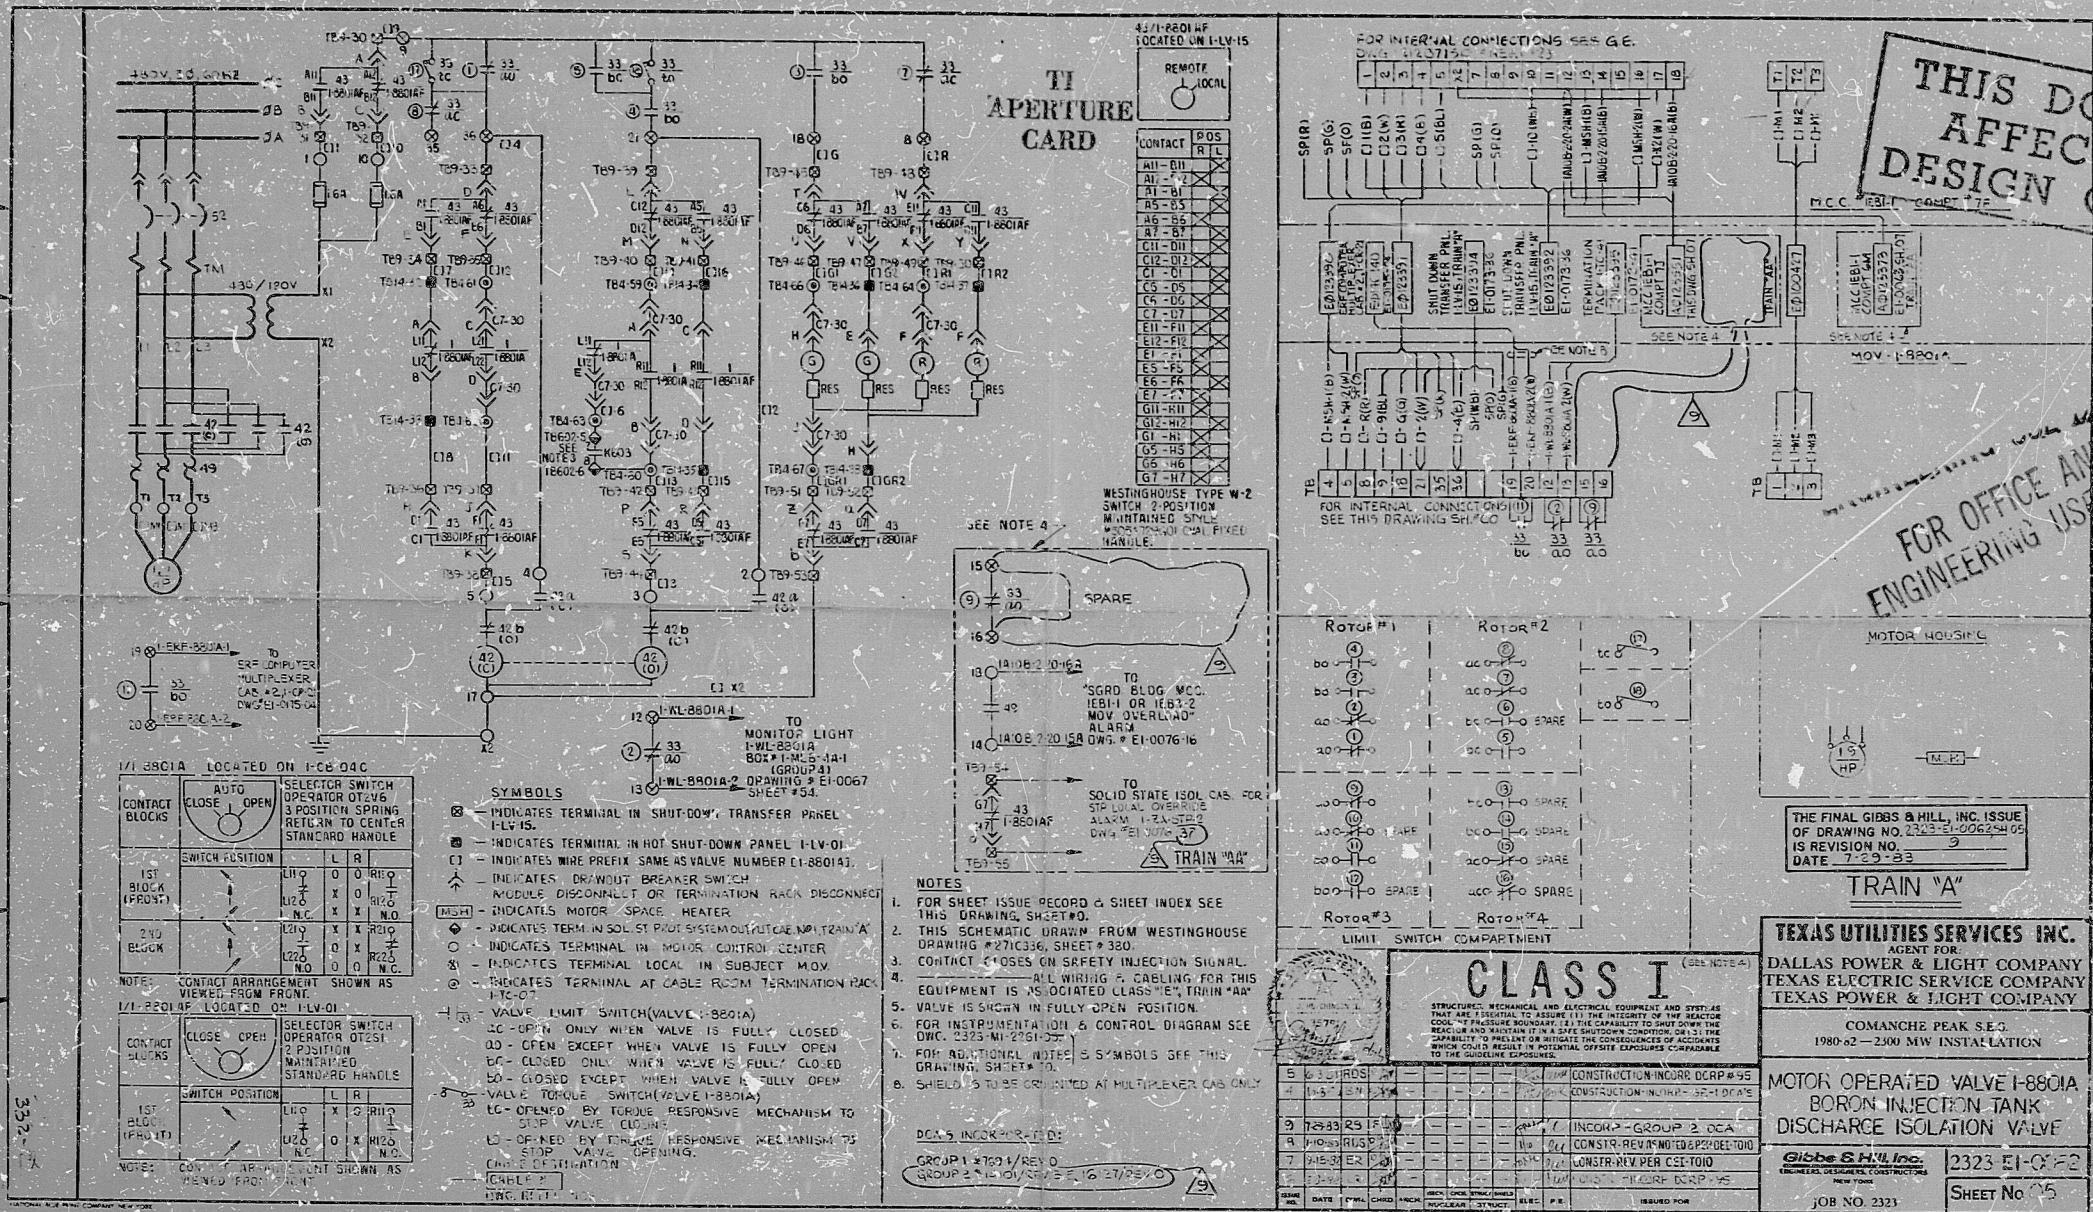

17"

17"

PDR RIDS

8410050457

